


# **DISCLAIMER:**

**This unrecorded Record of Survey was donated to the City of Tucson. The City of Tucson provides this data for your personal use "as is." Additionally, the City of Tucson provides this information with the understanding that it is not guaranteed to be accurate, correct or complete and conclusions drawn from such information are the responsibility of the user.**

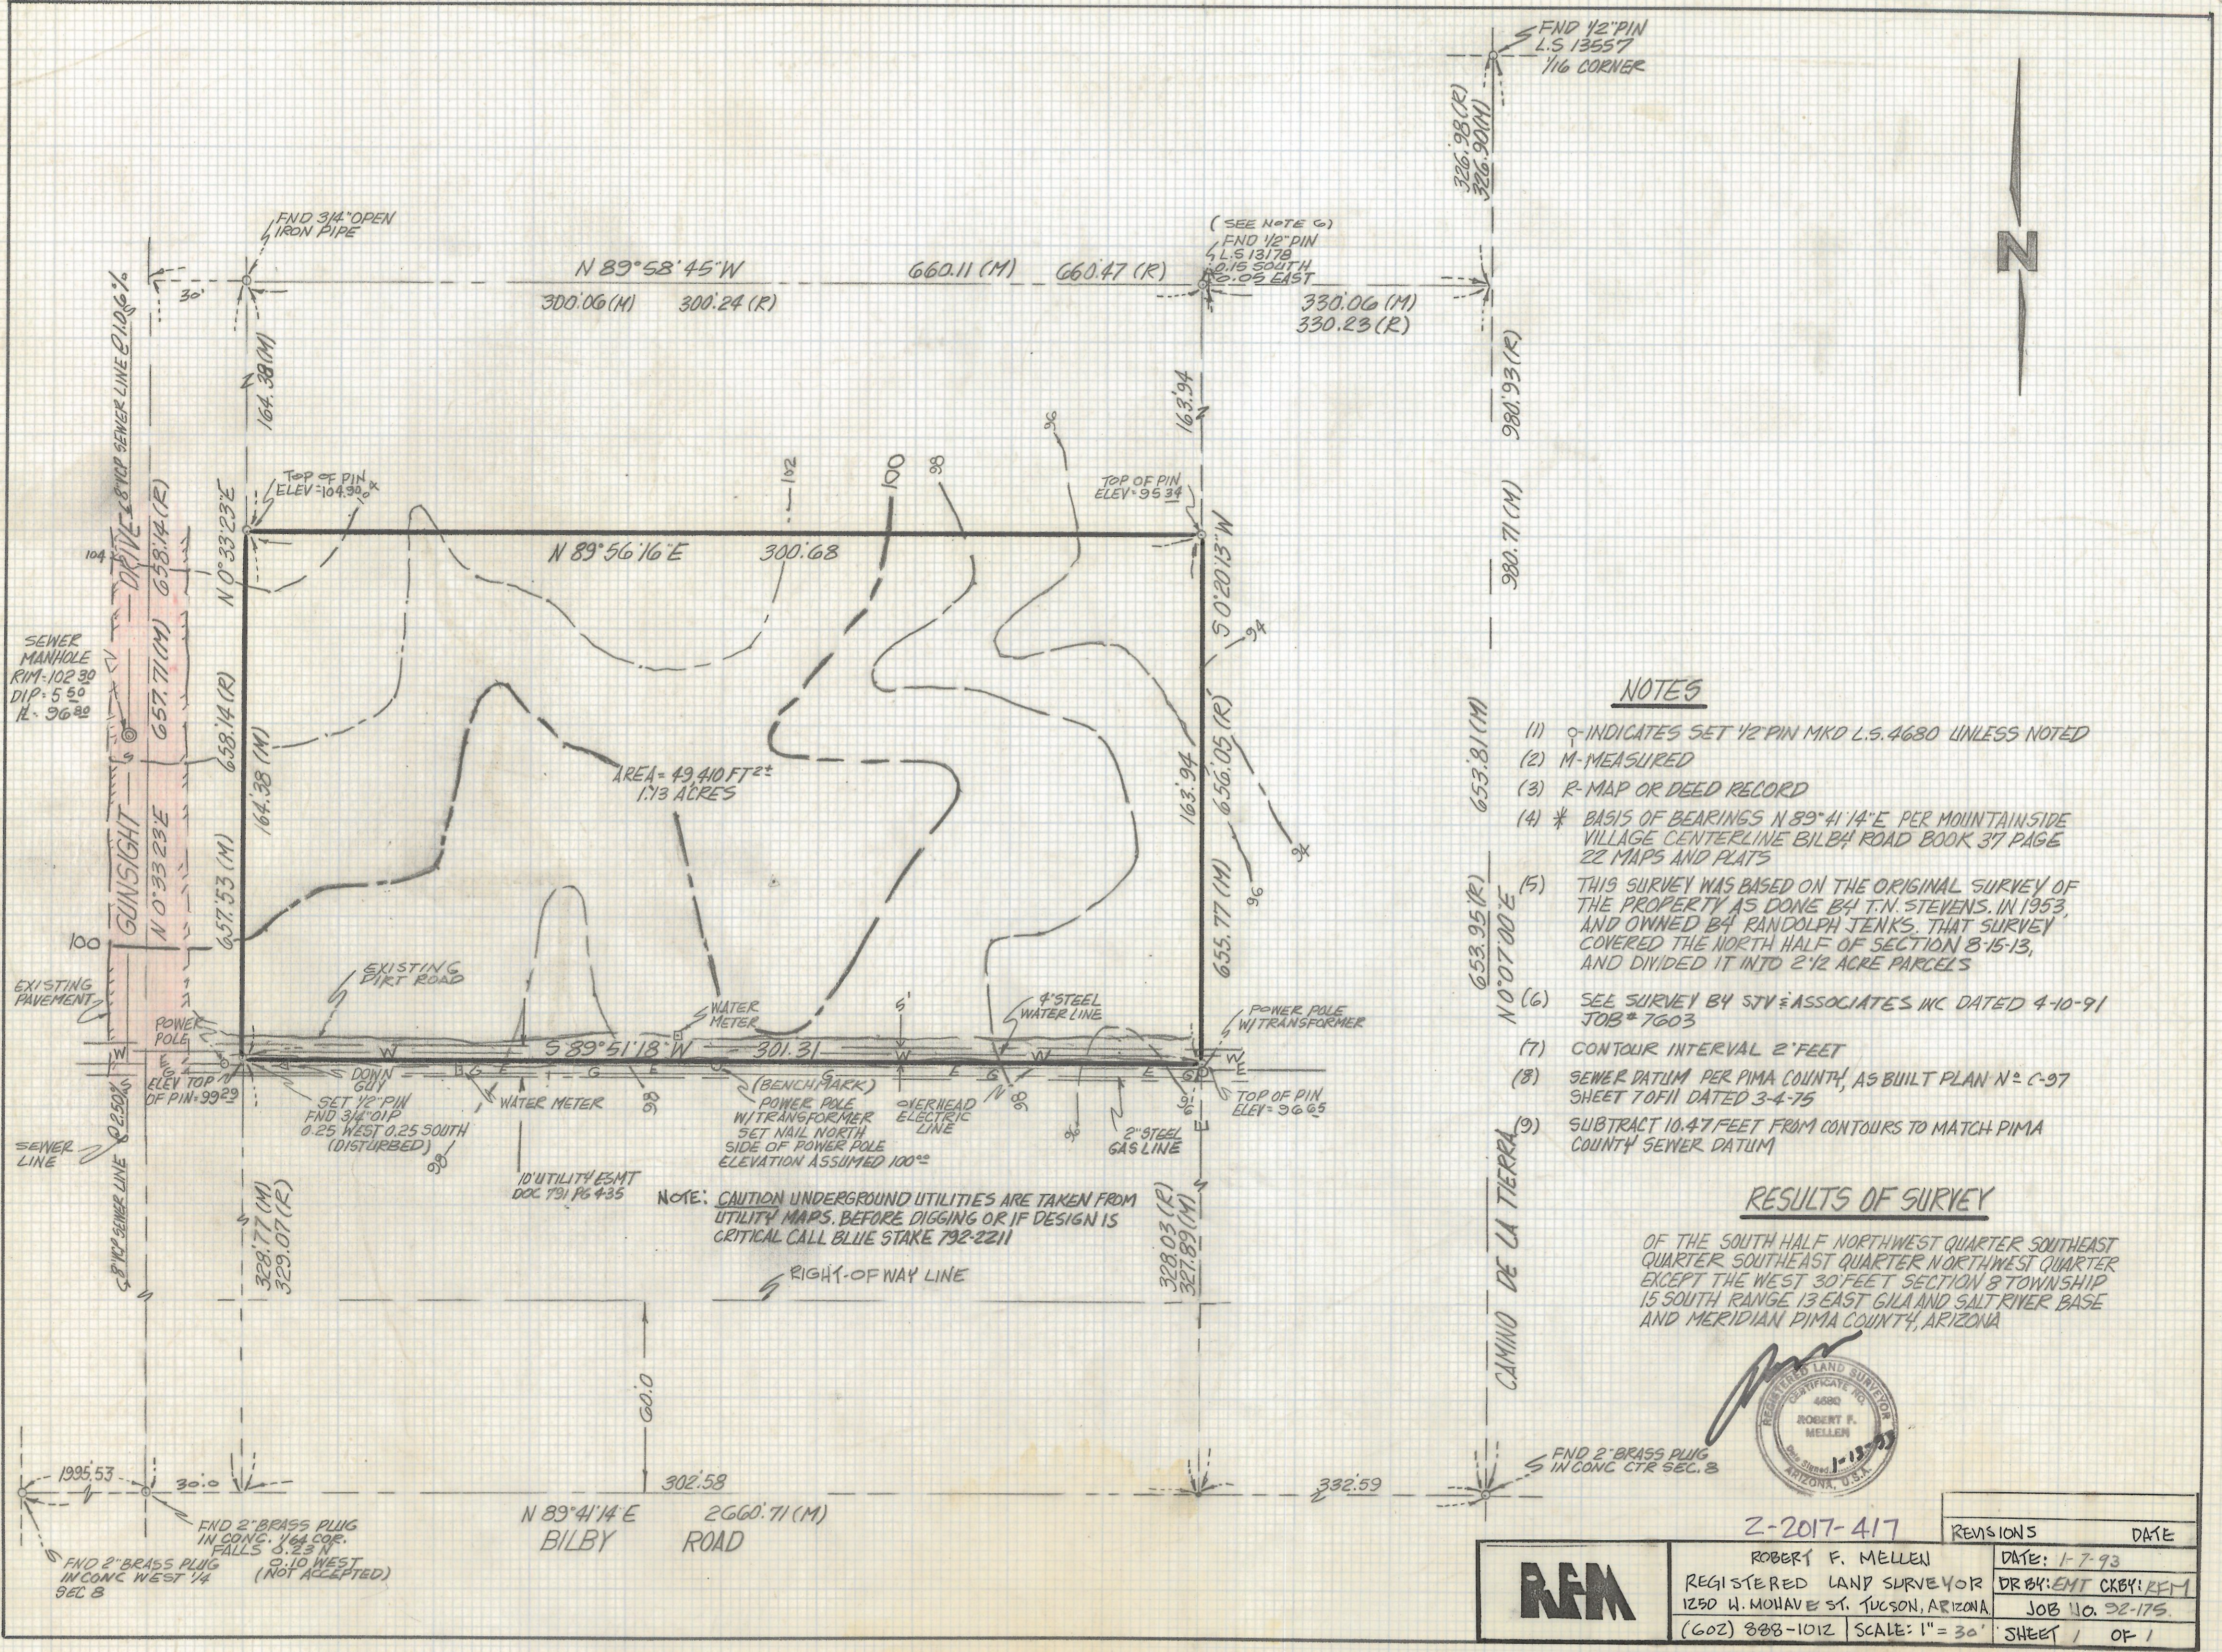

**NOTES**

- (1) ♀ INDICATES SET 1/2" PIN MKD L.S. 4680 UNLESS NOTED
- (2) M-MEASURED
- (3) R-MAP OR DEED RECORD
- (4) \* BASIS OF BEARINGS N 89° 41' 14" E PER MOUNTAIN SIDE VILLAGE CENTERLINE BILBY ROAD BOOK 37 PAGE 22 MAPS AND PLATS
- (5) THIS SURVEY WAS BASED ON THE ORIGINAL SURVEY OF THE PROPERTY AS DONE BY T.N. STEVENS, IN 1953, AND OWNED BY RANDOLPH JENKS, THAT SURVEY COVERED THE NORTH HALF OF SECTION 8-15-13, AND DIVIDED IT INTO 2 1/2 ACRE PARCELS
- (6) SEE SURVEY BY STV ASSOCIATES INC DATED 4-10-91 JOB # 7603
- (7) CONTOUR INTERVAL 2 FEET
- (8) SEWER DATUM PER PIMA COUNTY, AS BUILT PLAN N° C-97 SHEET 7 OF 11 DATED 3-4-75
- (9) SUBTRACT 10.47 FEET FROM CONTOURS TO MATCH PIMA COUNTY SEWER DATUM

**RESULTS OF SURVEY**

OF THE SOUTH HALF NORTHWEST QUARTER SOUTHEAST QUARTER SOUTHEAST QUARTER NORTHWEST QUARTER EXCEPT THE WEST 30 FEET SECTION 8 TOWNSHIP 15 SOUTH RANGE 13 EAST GILA AND SALTRIVER BASE AND MERIDIAN PIMA COUNTY, ARIZONA



<b>RFM</b>	Z-2017-417		REVISIONS	DATE
	ROBERT F. MELLEN			DATE: 1-7-93
	REGISTERED LAND SURVEYOR			DR BY: EMT CKB: RFM
	1250 W. MOHAVE ST. TUCSON, ARIZONA			JOB NO. 92-175
(602) 888-1012		SCALE: 1" = 30'	SHEET 1 OF 1	

NOTE: CAUTION UNDERGROUND UTILITIES ARE TAKEN FROM UTILITY MAPS. BEFORE DIGGING OR IF DESIGN IS CRITICAL CALL BLUE STAKE 792-2211

FND 2" BRASS PLUG IN CONC CTR SEC. 8

FND 2" BRASS PLUG IN CONC. 1/4" COP. FALLS 0.23 N. 0.10 WEST (NOT ACCEPTED)

FND 2" BRASS PLUG IN CONC WEST 1/4 SEC 8