

DISCLAIMER:

This unrecorded Record of Survey was donated to the City of Tucson. The City of Tucson provides this data for your personal use "as is." Additionally, the City of Tucson provides this information with the understanding that it is not guaranteed to be accurate, correct or complete and conclusions drawn from such information are the responsibility of the user.



CERTIFICATION

I ROBERT F. MELLEN HEREBY CERTIFY THAT ON 3/23/83 THIS MAP OF SURVEY CORRECTLY SHOWS THE LOCATION OF ALL BUILDINGS SITUATED ON THE ABOVE PREMISES; AND THAT, EXCEPT AS SHOWN, THERE ARE NO VISIBLE EASEMENTS OR RIGHT-OF-WAYS ACROSS SAID PREMISES OR ANY OTHER EASEMENTS OR RIGHT-OF-WAYS OF WHICH THE UNDERSIGNED HAS BEEN ADVISED. NO PARTY WALLS, NO ENCRoACHMENTS ON ADJOINING PREMISES, STREETS OR ALLEYS BY ANY OF SAID BUILDINGS, STRUCTURES OR OTHER IMPROVEMENTS, AND NO ENCRoACHMENTS ON SAID PREMISES BY BUILDINGS, STRUCTURES OR OTHER IMPROVEMENTS SITUATED ON ADJOINING PREMISES.


RF Mellen
 ROBERT F. MELLEN
 REGISTERED LAND SURVEYOR
 #4680 ARIZONA

NOTES

- (1) THIS SURVEY PARTIALLY BASED ON JOBS # 71-78 AND 81-124
- (2) THE BLOCK WALL ON THE WEST PROPERTY LINE HAS WEEP HOLES APPROXIMATELY EVERY 10 FEET WHICH DRAIN TO ADJACENT PROPERTY
- (3) THERE MAY BE EASEMENTS ON THIS PROPERTY FOR ELECTRIC TELEPHONE AND OR T.V. CABLE OF WHICH THE UNDERSIGNED HAS NOT BEEN ADVISED
- (4) OVERHEAD ELECTRIC EASEMENT DOC 5556 PAGE 748 *EXISTING IN THIS AREA*
- (5) TO ACCURATELY LOCATE THE SIDEWALKS IN THIS PROJECT WOULD NOT BE ECONOMICALLY FEASIBLE. HOWEVER ALL SIDEWALKS ARE APPROXIMATELY AS SHOWN AND ALL ARE WITHIN THE PROJECT

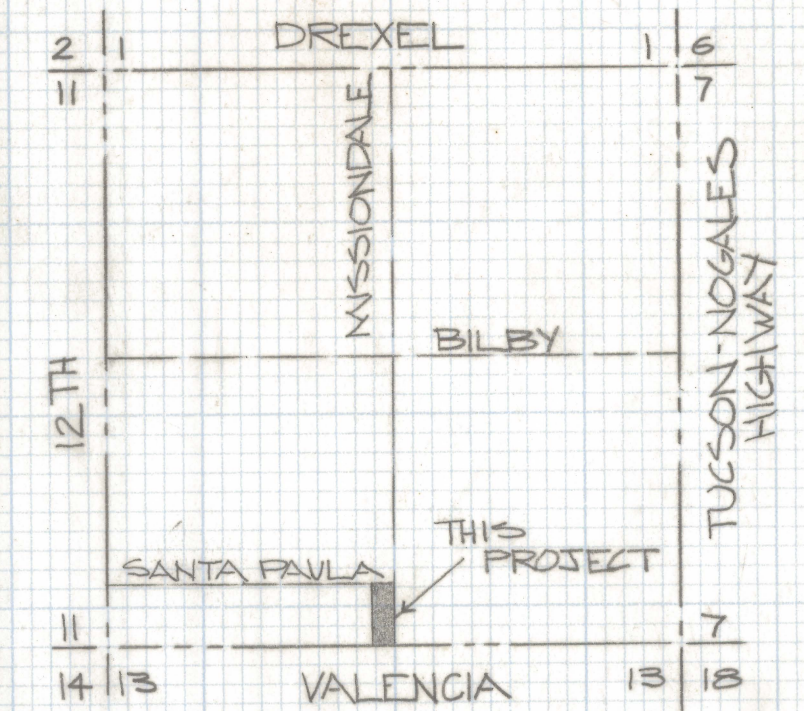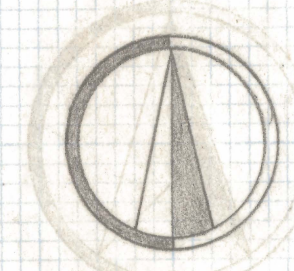

LOCATION MAP
 SCALE 3"=1 MILE
 SECTION 12, T15S R13E
 PIMA COUNTY, ARIZONA

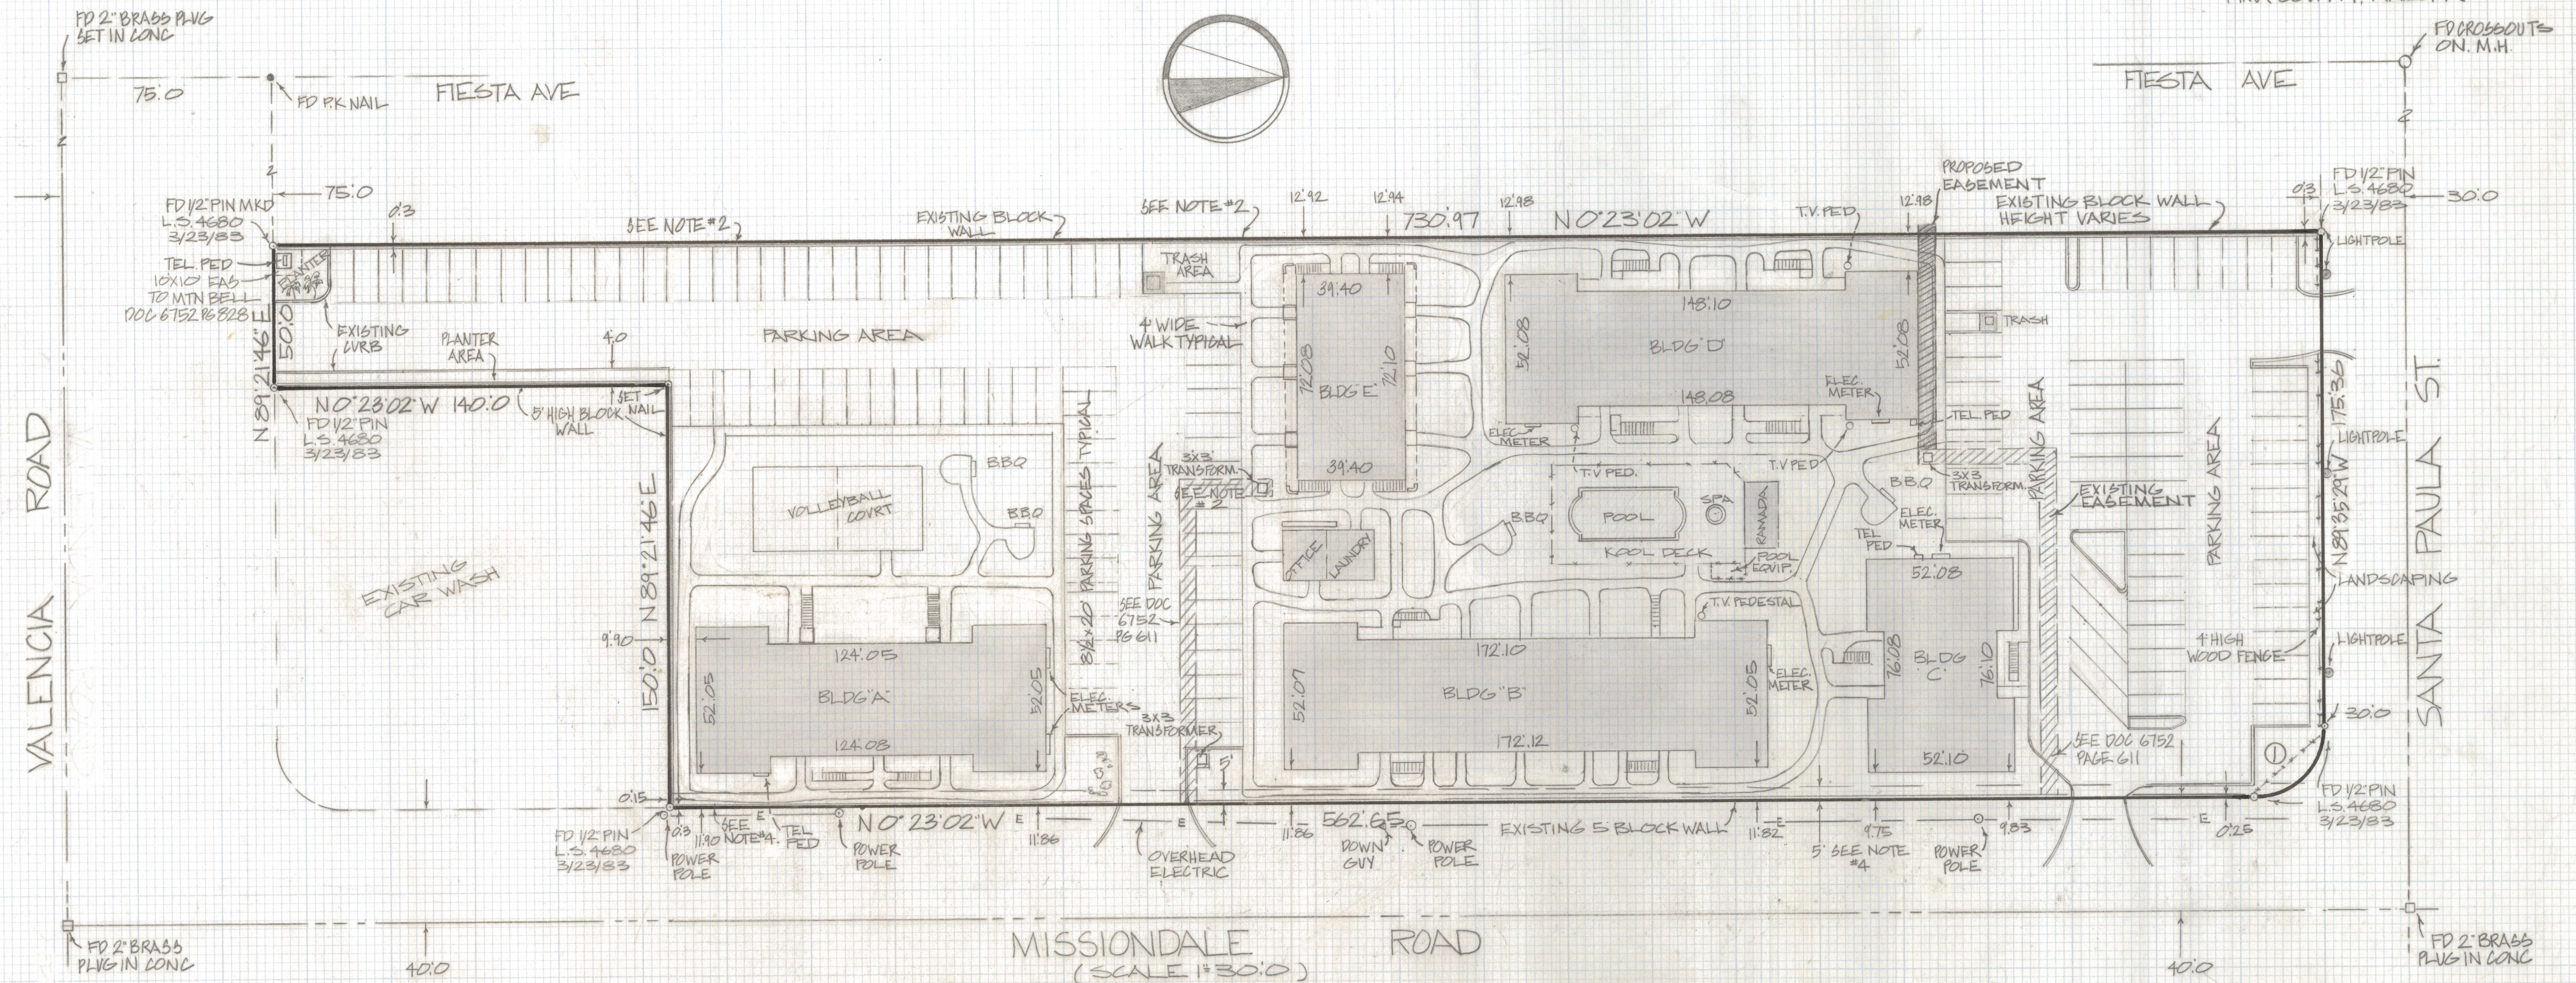

CURVE DATA				
N°	RADIUS	DELTA	TANGENT	LENGTH CHORD
1	25.0	89°12'27"	24.66	38.92 35.11

AS BUILT SURVEY

THE EAST 200.0 FEET OF LOT 472 IN FIESTA PARK, A SUBDIVISION OF PIMA COUNTY, ARIZONA ACCORDING TO THE OFFICIAL MAP OR PLAT THEREOF OF RECORD IN THE OFFICE OF THE PIMA COUNTY RECORDER IN BOOK 15 OF MAPS AND PLATS AT PAGE 100 THEREOF, EXCEPT THE EAST 150.0 FEET OF THE SOUTH 140.0 FEET



ROBERT F. MELLEN
 REGISTERED LAND SURVEYOR
 TUCSON, ARIZONA
 JOB # 83-39