


DISCLAIMER:

This unrecorded Record of Survey was donated to the City of Tucson. The City of Tucson provides this data for your personal use "as is." Additionally, the City of Tucson provides this information with the understanding that it is not guaranteed to be accurate, correct or complete and conclusions drawn from such information are the responsibility of the user.

AREAS

A	114,020	SQ. FT.	CHIP SEAL
B	7,180	"	"
C	13,810	"	"
D	1,940	"	"
E	8,520	"	"
F	86,790	"	"
G	209,150	"	"
H	97,500	"	"
I	8,420	"	"
J	6,170	"	"
K	10,150	"	"
L	7,870	"	"
L	10,160	"	ASPHALT PAVING
M	17,200	"	"
TOTAL = 593,940 SQ. FT. ±			
TOTAL = 27,360 SQ. FT. ±			
OR 126 CU. YD. @ 1 1/2" THICKNESS			

NOTES:
 (1) STADIA METHOD USED FOR LOCATION OF CULTURE
 (2) AREAS CALCULATED BY PLANIMETER, SERIAL NO. 28413

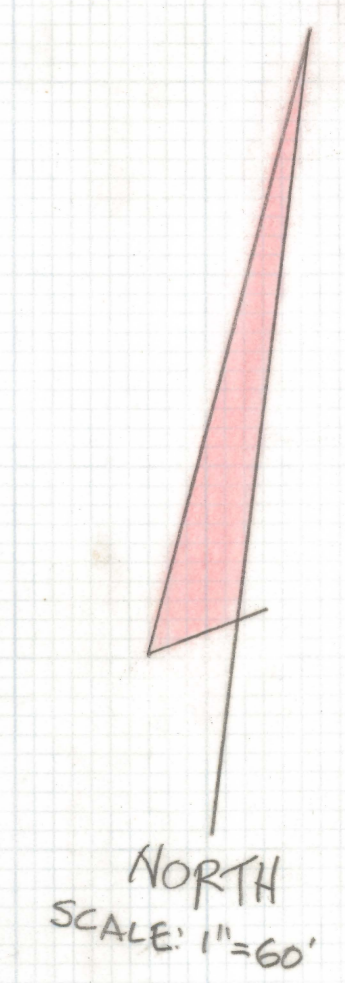

RESULTS OF SURVEY
 OF A PORTION OF THE RILLITO DOWNS RACE TRACK LOCATED IN THE NORTHWEST QUARTER OF SECTION 19 TOWNSHIP 13 SOUTH OF RANGE 14 EAST, GILA AND SALT RIVER BASE AND MERIDIAN, PIMA COUNTY, ARIZONA.

RILLITO RIVER

AREAS OF ASPHALT & ASPHALT REVISION DATE BY	GA	BY	AS-BUILT OF PARKING AREA - RILLITO DOWNS RACE TRACK
	GA	BY	
		ROBERT P. MELLEN REGISTERED LAND SURVEYOR 1250 W. MOHAVE ST TUCSON, ARIZONA 85705 (602) 888-1012	
DRAWN BY: GNM JOB NO: 88-120		CK BY: RPM DATE: 10-7-88 SHEET 1 OF 1	