



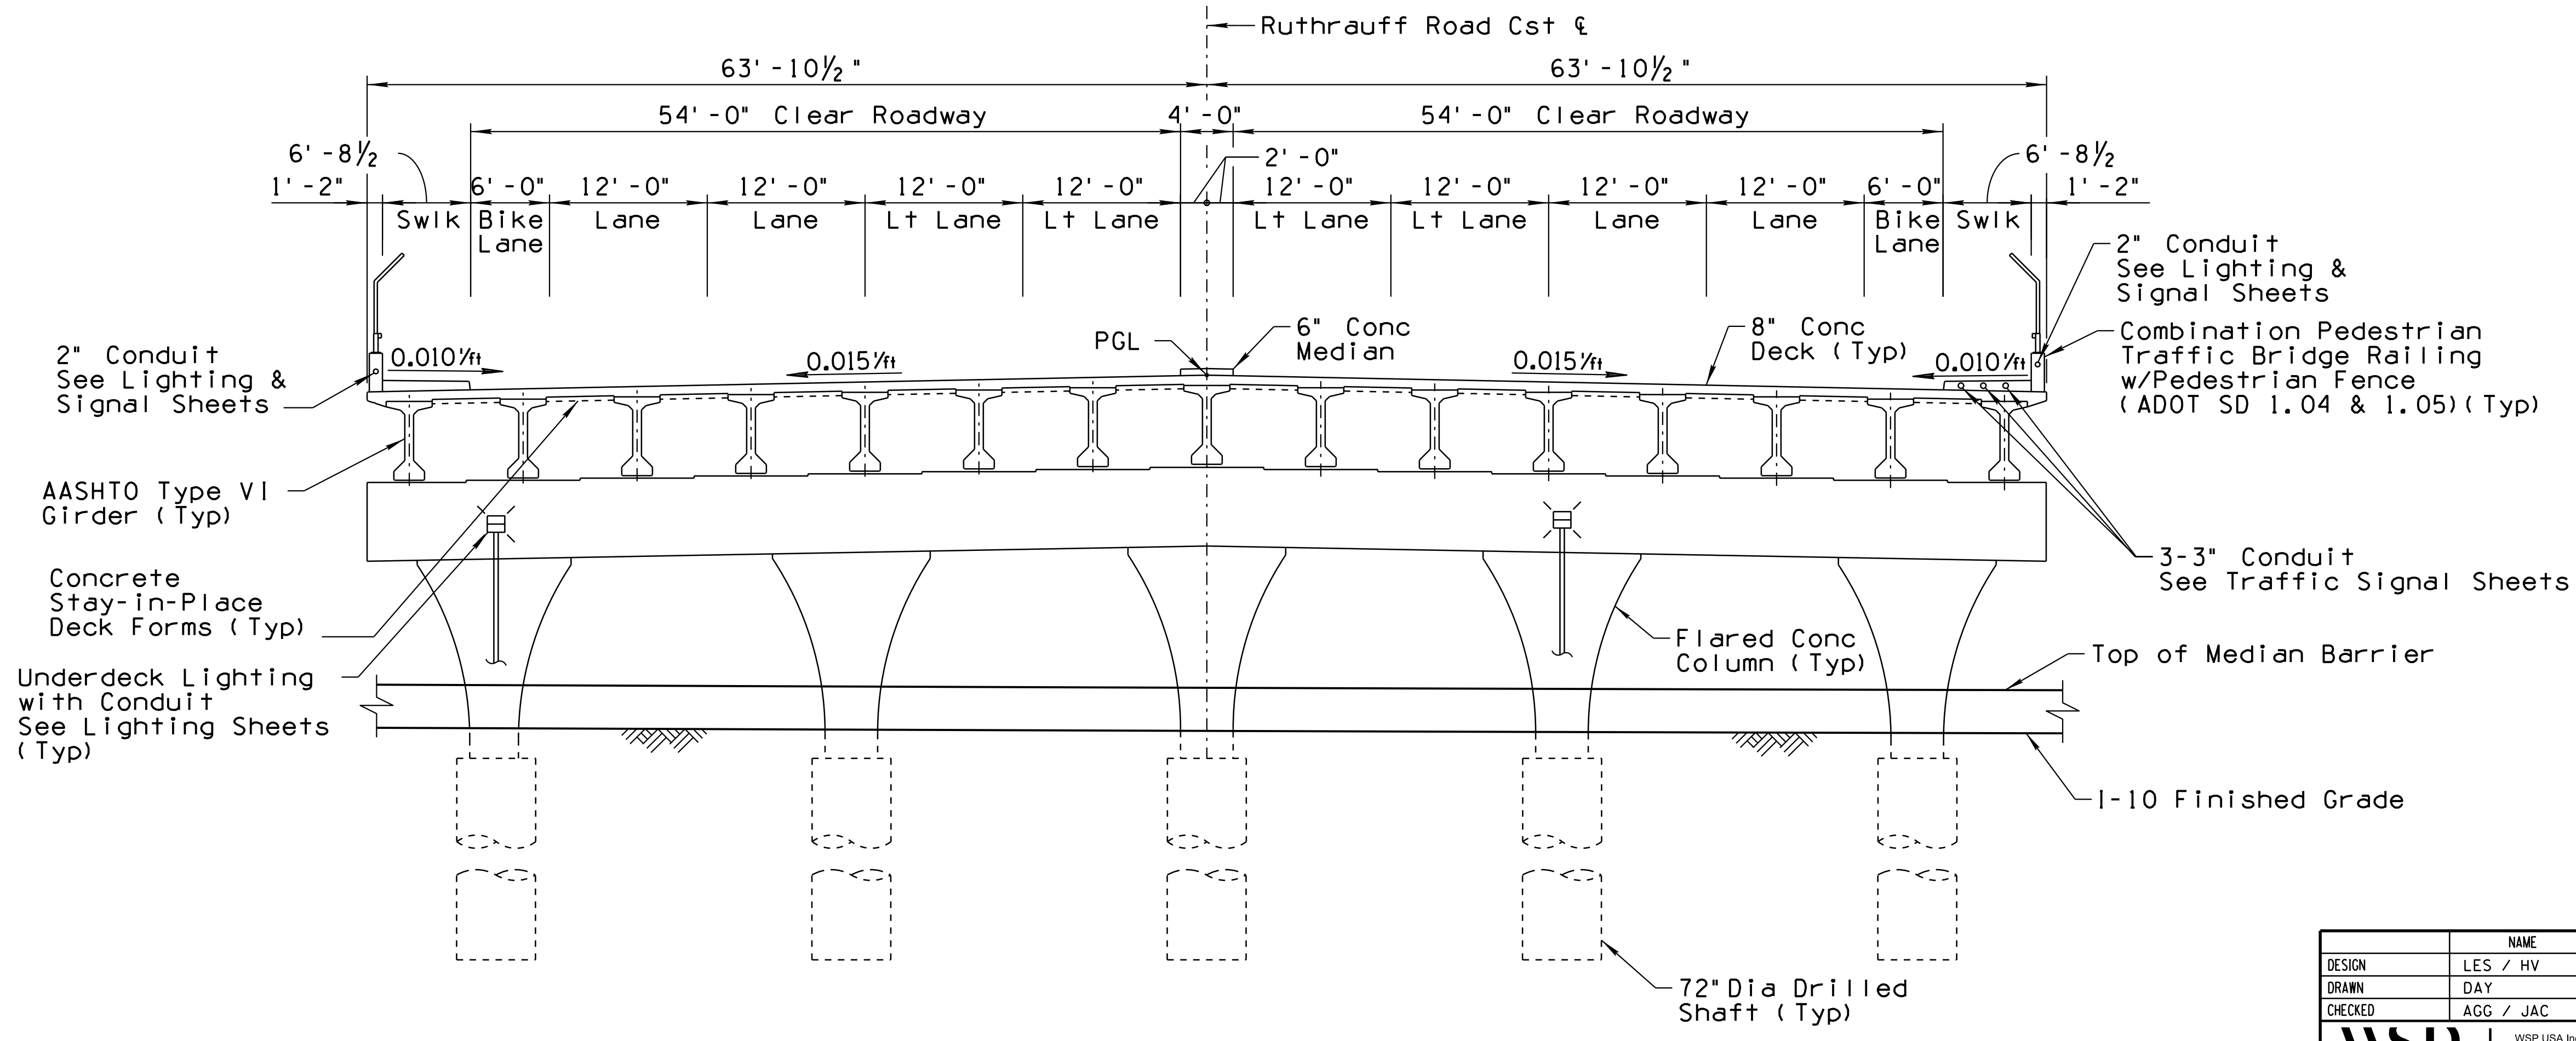


F.H.W.A. REGION	STATE	PROJECT NO.	SHEET NO.	TOTAL SHEETS	RECORD DRAWING
9	ARIZ.	010-D(213)S	615	849	

010 PM 252

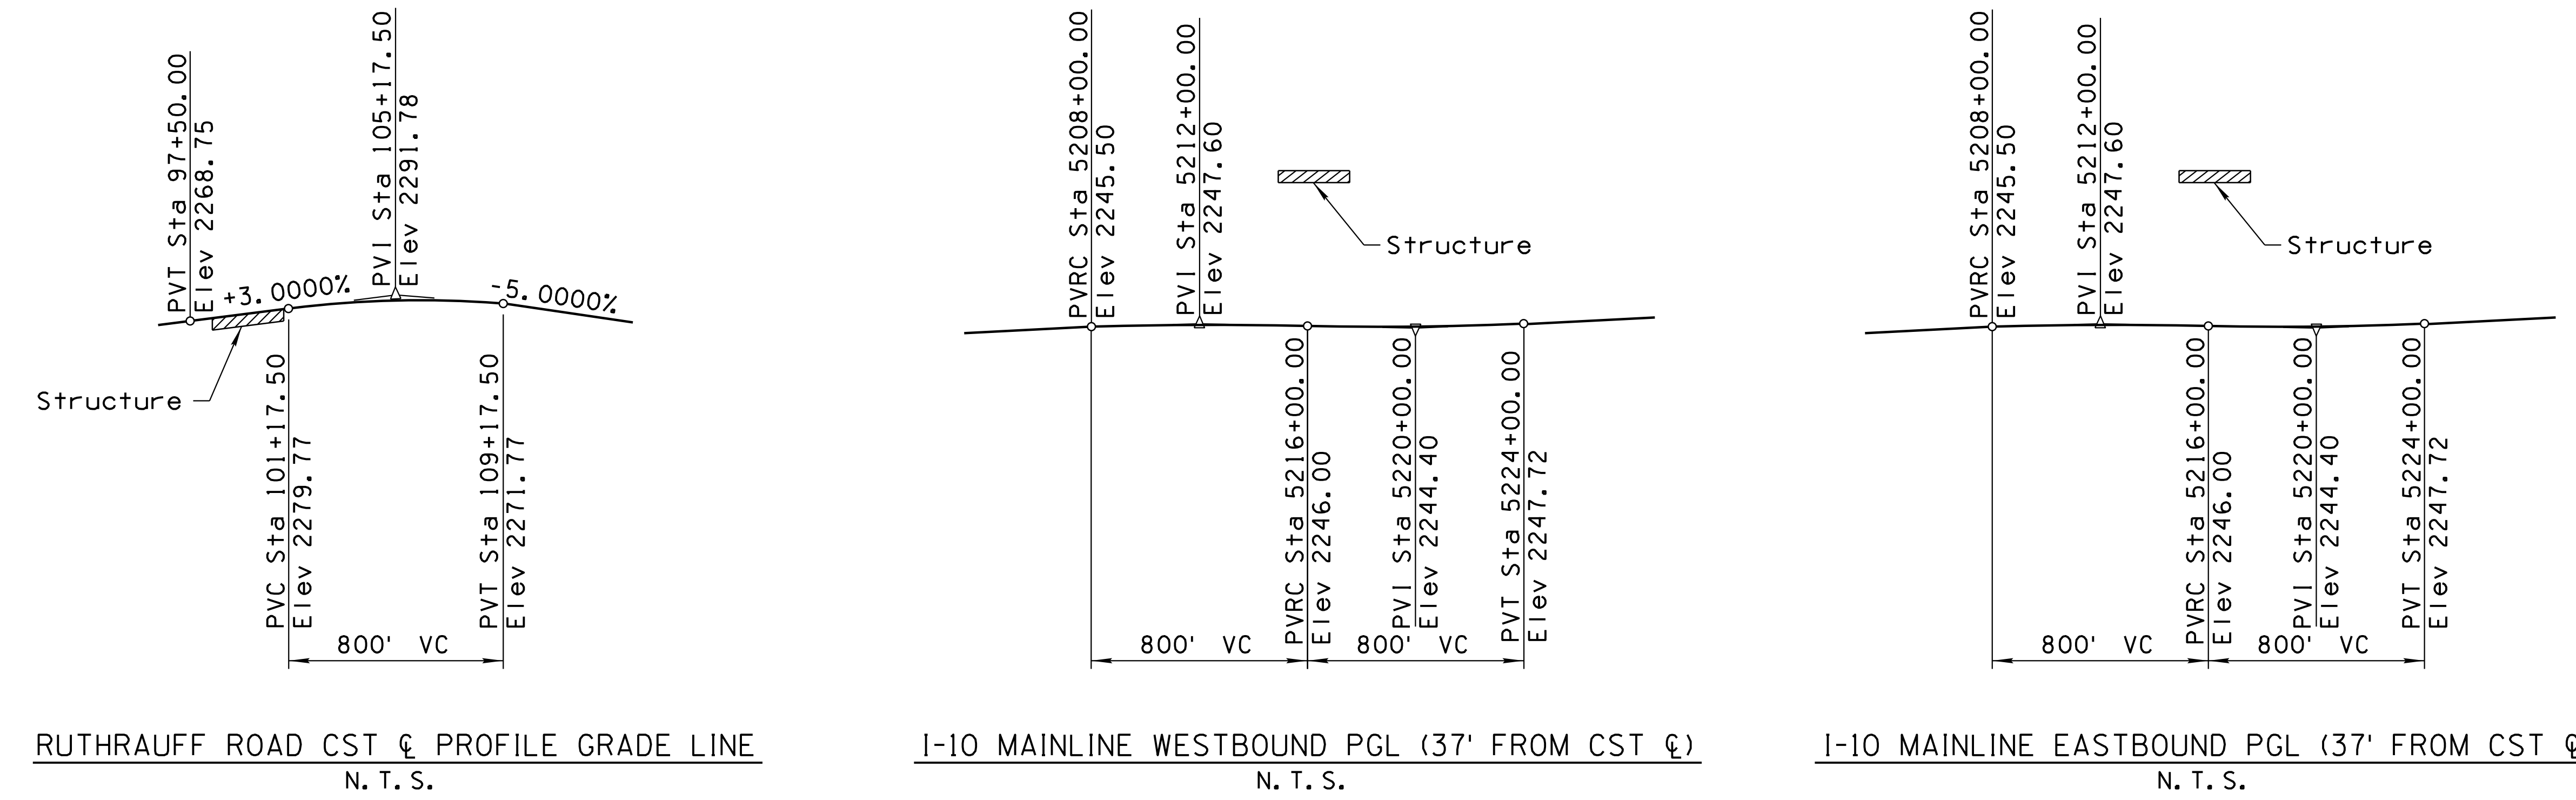

TYPICAL SECTION  
Looking Ahead Station  
Scale: 1/8" = 1' -0"

DESIGN	NAME	DATE	ARIZONA DEPARTMENT OF TRANSPORTATION INFRASTRUCTURE DELIVERY AND OPERATIONS DIVISION BRIDGE GROUP
DRAWN	LES / HV	3-19	
CHECKED	DAY	3-19	
WSP			STA 99+ RUTHRAUFF ROAD T.I. UNDERPASS TYPICAL SECTION
WSP USA Inc. 177 N. Church Avenue Suite 1105 Tucson, AZ 85701			
I-10 ROUTE	252.00 MILEPOST	20159 STRUCTURE NO.	LOCATION RUTHRAUFF ROAD T.I.
TRACS NO. H 8480 OIC			DWG NO. S-1.02

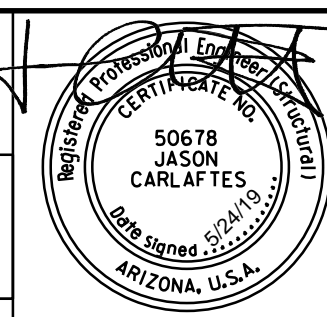

DATE: \_\_\_\_\_ LOCATION: \_\_\_\_\_ REVISIONS: \_\_\_\_\_ SURVEY NO.: \_\_\_\_\_ DATE: \_\_\_\_\_ LOCATION: \_\_\_\_\_ REVISIONS: \_\_\_\_\_ SURVEY NO.: \_\_\_\_\_



**GENERAL NOTES:**

**Construction Specification**

Arizona Department of Transportation Standard Specifications for Road and Bridge Construction, Edition of 2008 and Special Provisions.

**Design Specifications**

AASHTO LRFD Bridge Design Specifications, 7th Edition 2014, with 2015 and 2016 interim revisions.

**Dead Load**

Dead Load includes allowance of 25 pounds per square foot for Future Wearing Surface (FWS). The Bridge Design has an assumed dead load of 15 psf for stay-in-place deck panels and the associated additional non-structural concrete.

**Live Load**

Loading Class = HL-93

**Seismic**

Bridge Site is classified as Seismic Zone 1, Site Class D with Peak Ground Acceleration (PGA)  $A_s = 0.120g$  and Spectral Acceleration at 0.2 sec.  $S_{ps} = 0.278g$  and at 1.0 sec.  $S_{p1} = 0.118g$  as modified by the appropriate Site Factors.

**Inventory and Operating**

Ratings for HL-93 are in accordance with the AASHTO Manual for Bridge Evaluation, 2nd Edition with Interim Revisions through 2016 and in accordance with the Load and Resistance Factor Rating (LRFR) method.

Inventory Load Rating 1.20 (LRFR)  
Operating Load Rating 2.09 (LRFR)

**Concrete**

All concrete shall be ADOT Class "S" unless noted otherwise.

**Reinforcing Steel**

Reinforcing steel shall conform to ASTM Specification A615 (AASHTO M31). All reinforcing shall be furnished as Grade 60.

All bends and hooks shall meet the requirements of AASHTO Article 5.10.2 unless noted otherwise. All bend dimensions for reinforcing steel shall be out-to-out of bars. All placement dimensions for reinforcing steel shall be to center of bars unless noted otherwise.

All reinforcing steel shall have 2" clear cover unless noted otherwise.

All mechanical splices shall conform to the requirements for mechanical connections in Section 605-3.02 of the Standard Specifications.

**Prestressing**

Steel strands shall conform to ASTM A416 (AASHTO M203), Grade 270, Low Relaxation Strands.

Transformed sections for prestressing strands was used for girder analysis.

**Construction Joints**

All construction joints shall be intentionally roughened to an amplitude of  $\frac{1}{4}$ " unless noted otherwise, and be cleared of dirt, oil and otherwise deleterious debris.

Mechanical Splices may be used at all construction joints and formed joints where reinforcing must pass between pours, unless noted otherwise.

**Barriers**

Shall be constructed after spans have taken dead load deflection. Barriers shall not be slip formed.

**Chamfer**

All exposed corners  $\frac{3}{4}$ " unless noted otherwise.

**Dimensions**

Dimensions shall not be scaled from the drawings.

**GENERAL NOTES (CONTINUED):**

**Rustication and Paint**

Bridge shall be rusticated and painted in accordance with the Architectural Treatment Details, the Construction Specifications, and the Special Provisions.

Fencing shall be installed with decorative metalwork. See the Architectural Treatment Details, the Construction Specifications, and the Special Provisions.

**Material strengths (unless noted otherwise)**

Precast Prestressed Beams ...  $f'_{ci}$  = See Girder Detail Sheets  
 $f'_{c}$  = See Girder Detail Sheets  
Deck and Diaphragms ...  $f'_{c}$  = 4.5 ksi  
Parapet, Sidewalk & Median ...  $f'_{c}$  = 4.0 ksi  
Abutments, Pier, and Drilled Shafts ...  $f'_{c}$  = 3.5 ksi  
All other Class "S" Concrete ...  $f'_{c}$  = 3.5 ksi  
Grade 60 transverse deck reinforcement ...  $f_s$  = 24.0 ksi  
All other Grade 60 reinforcement ...  $f_y$  = 60.0 ksi  
Prestressing Steel ...  $f_{pu}$  = 270.0 ksi  
(0.6" dia 7-wire Low Relaxation Strand)

**Welds**

All welding shall conform to the requirements of the American Welding Society, ANSI/AASHTO/AWS D1.5 Bridge Welding code, 2015.



**Electrical**

Lighting and ITS conduit and fixture mounting details and locations shall be in accordance with the Lighting and ITS Drawings.

**Standard List**

ADOT Bridge Group Structure Detail (SD)  
Drawings: 1.01, 1.04, 1.05, 1.11, 2.01, 2.03, 3.02, 5.01, and 5.02


**Legend**

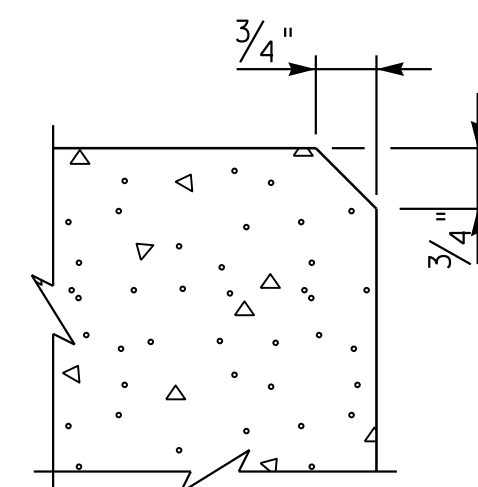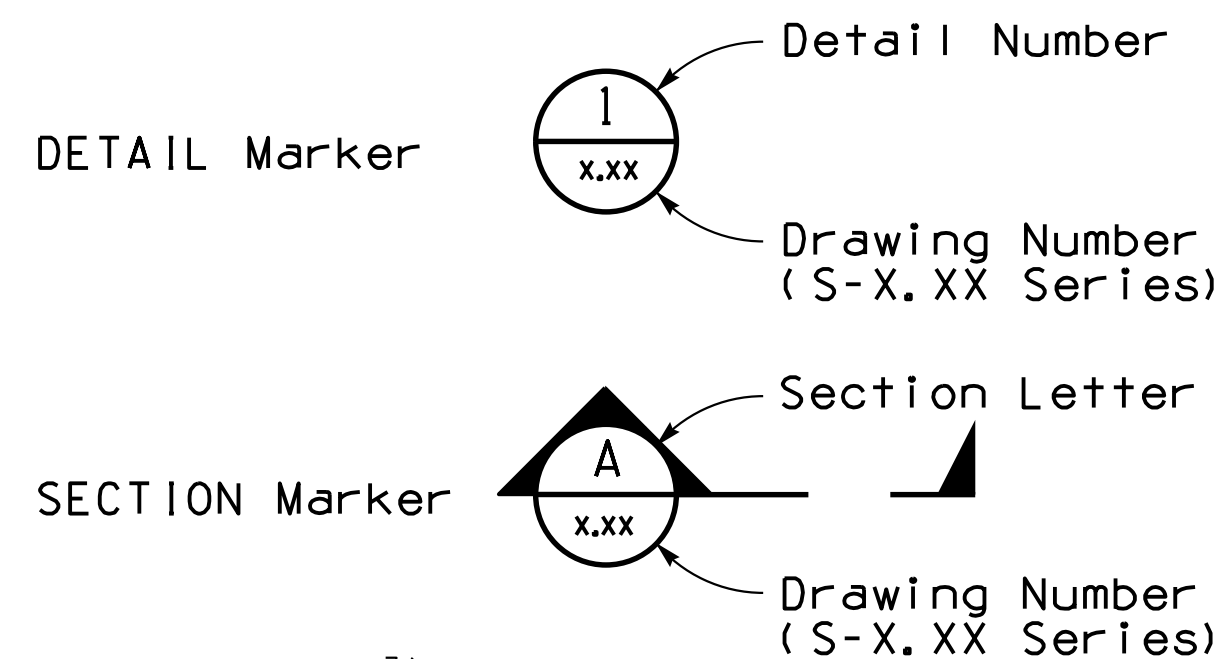

CHAMFER DETAIL 1  
No Scale

F.H.W.A. REGION	STATE	PROJECT NO.	SHEET NO.	TOTAL SHEETS	RECORD DRAWING
9	ARIZ.	010-D(213)S	616	849	

010 PM 252

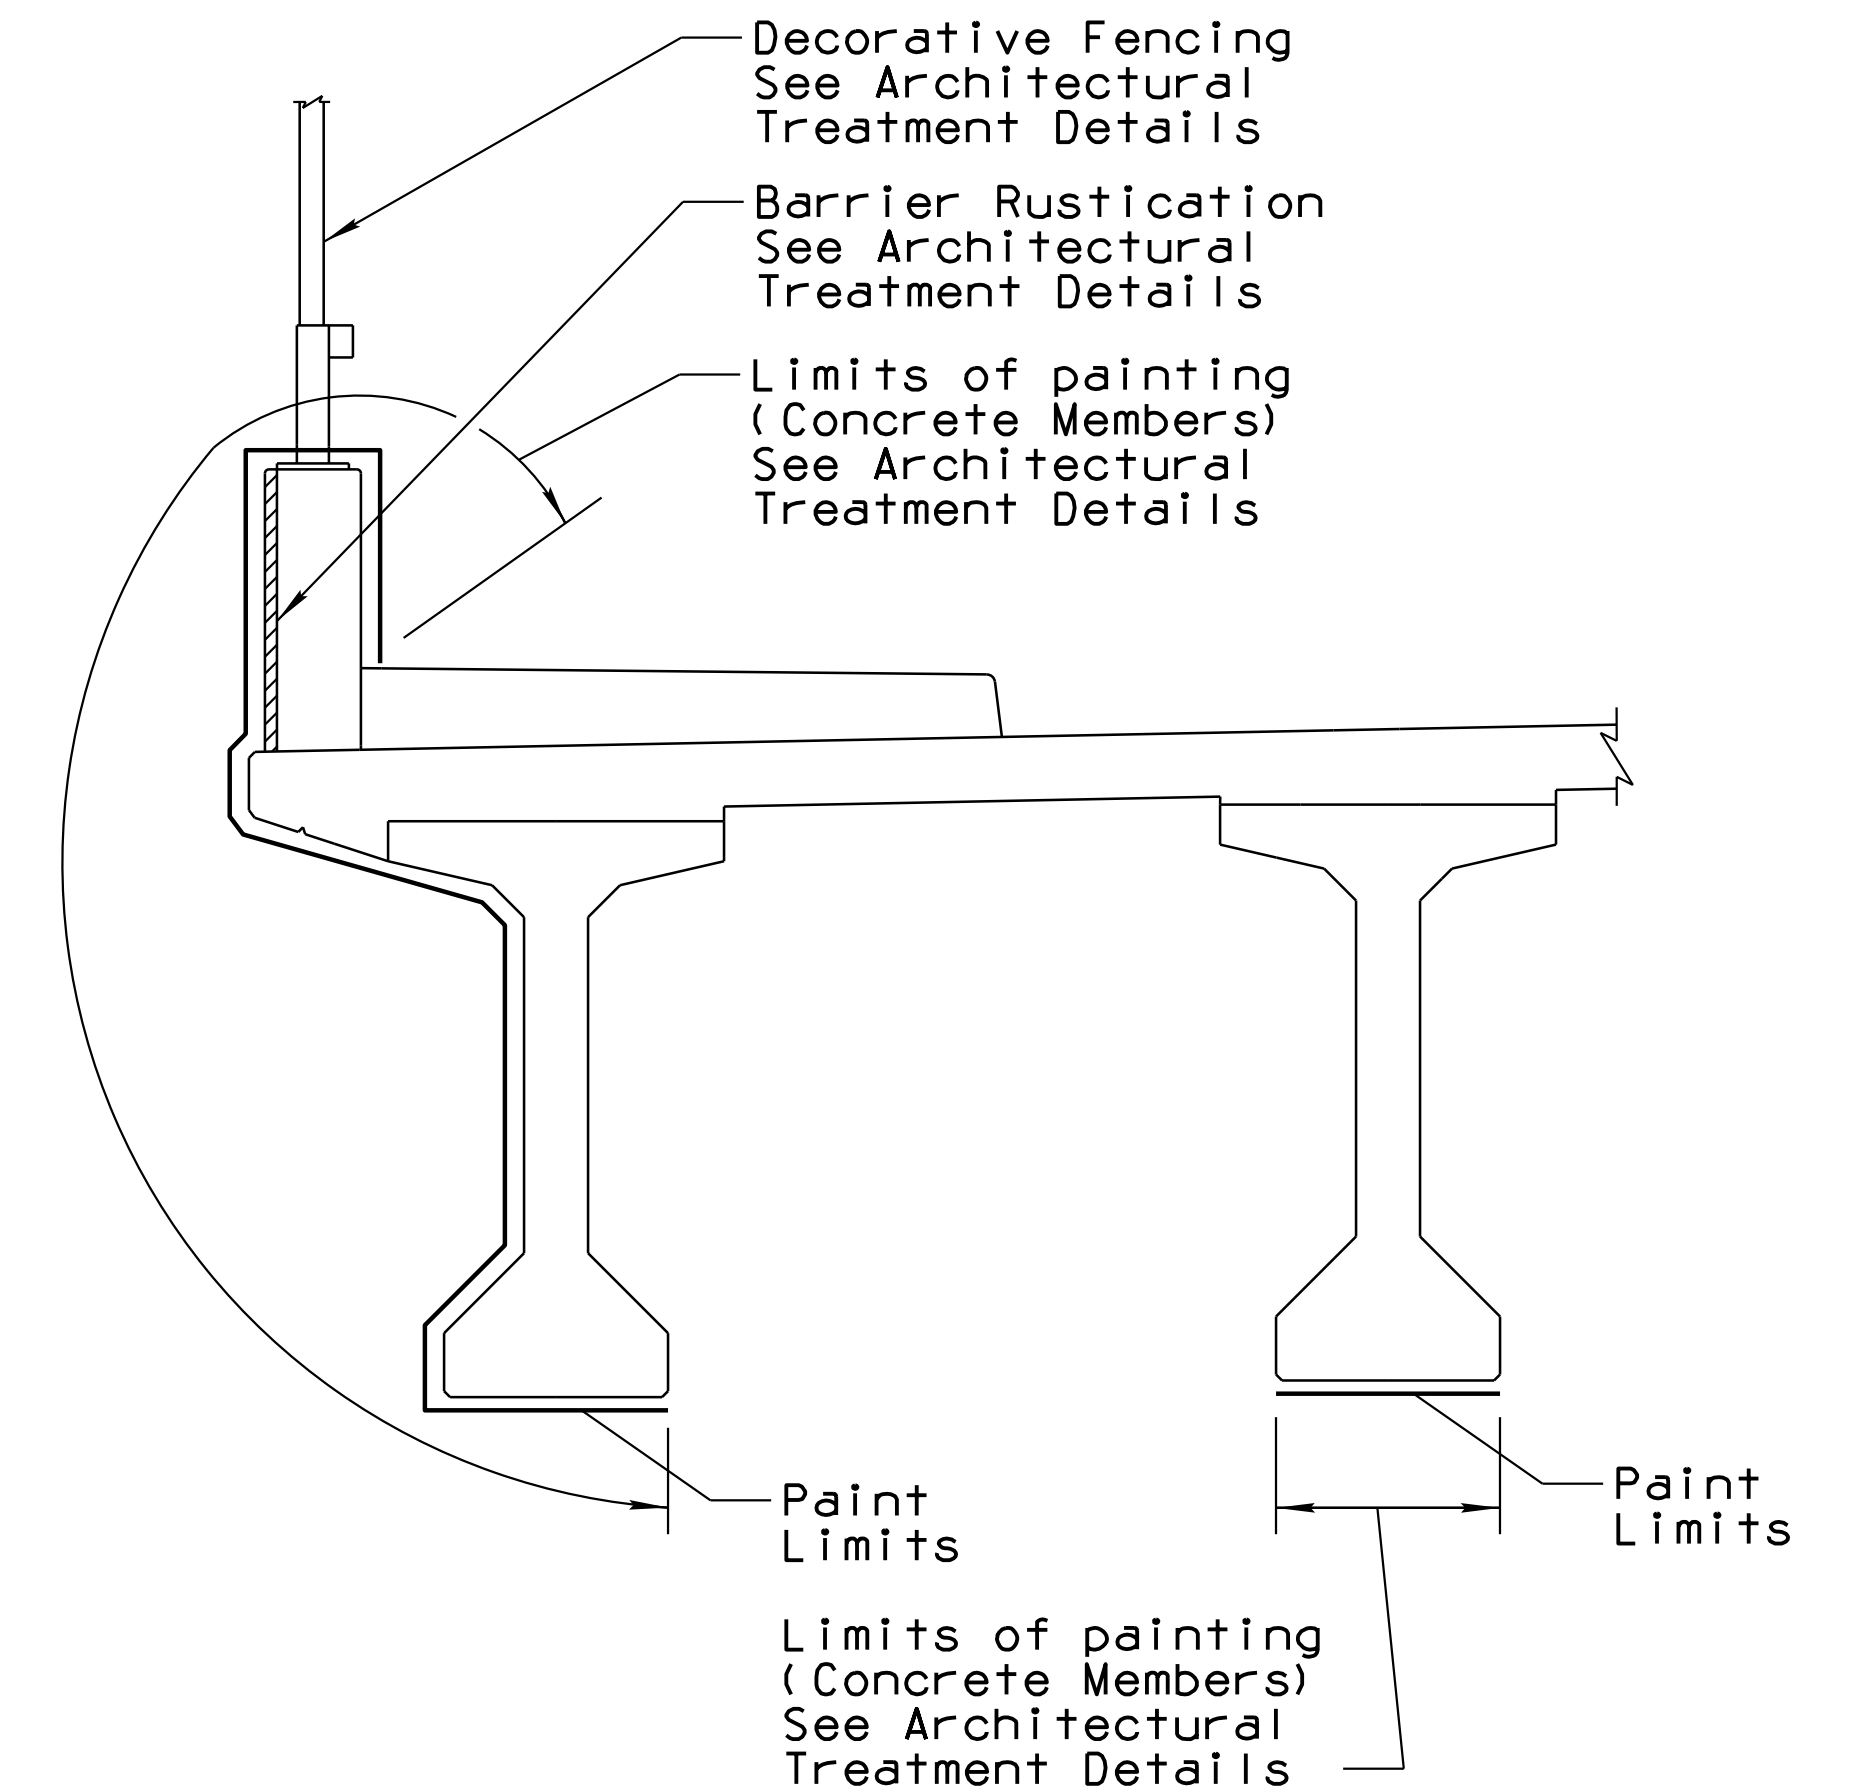


Aesthetic Details  
No Scale


DESIGN	LES / HV	DATE	3-19	ARIZONA DEPARTMENT OF TRANSPORTATION INFRASTRUCTURE DELIVERY AND OPERATIONS DIVISION BRIDGE GROUP	
DRAWN	DAY	DATE	3-19		
CHECKED	AGG / JAC	DATE	3-19		
		WSP USA Inc. 177 N. Church Avenue Suite 1105 Tucson, AZ 85701		STA 99+ RUTHRAUFF ROAD T.I. UNDERPASS GENERAL NOTES	
I-10	252.00	20159	LOCATION	RUTHRAUFF ROAD T.I.	EXPIRES 3/31/2019
ROUTE	MILEPOST	STRUCTURE NO.			DWG NO. S-1.03
TRACS NO. H 8480 OIC			010-D(213)S		OF


F.H.W.A. REGION	STATE	PROJECT NO.	SHEET NO.	TOTAL SHEETS	RECORD DRAWING
9	ARIZ.	010-D(213)S	617	849	

010 PM 252

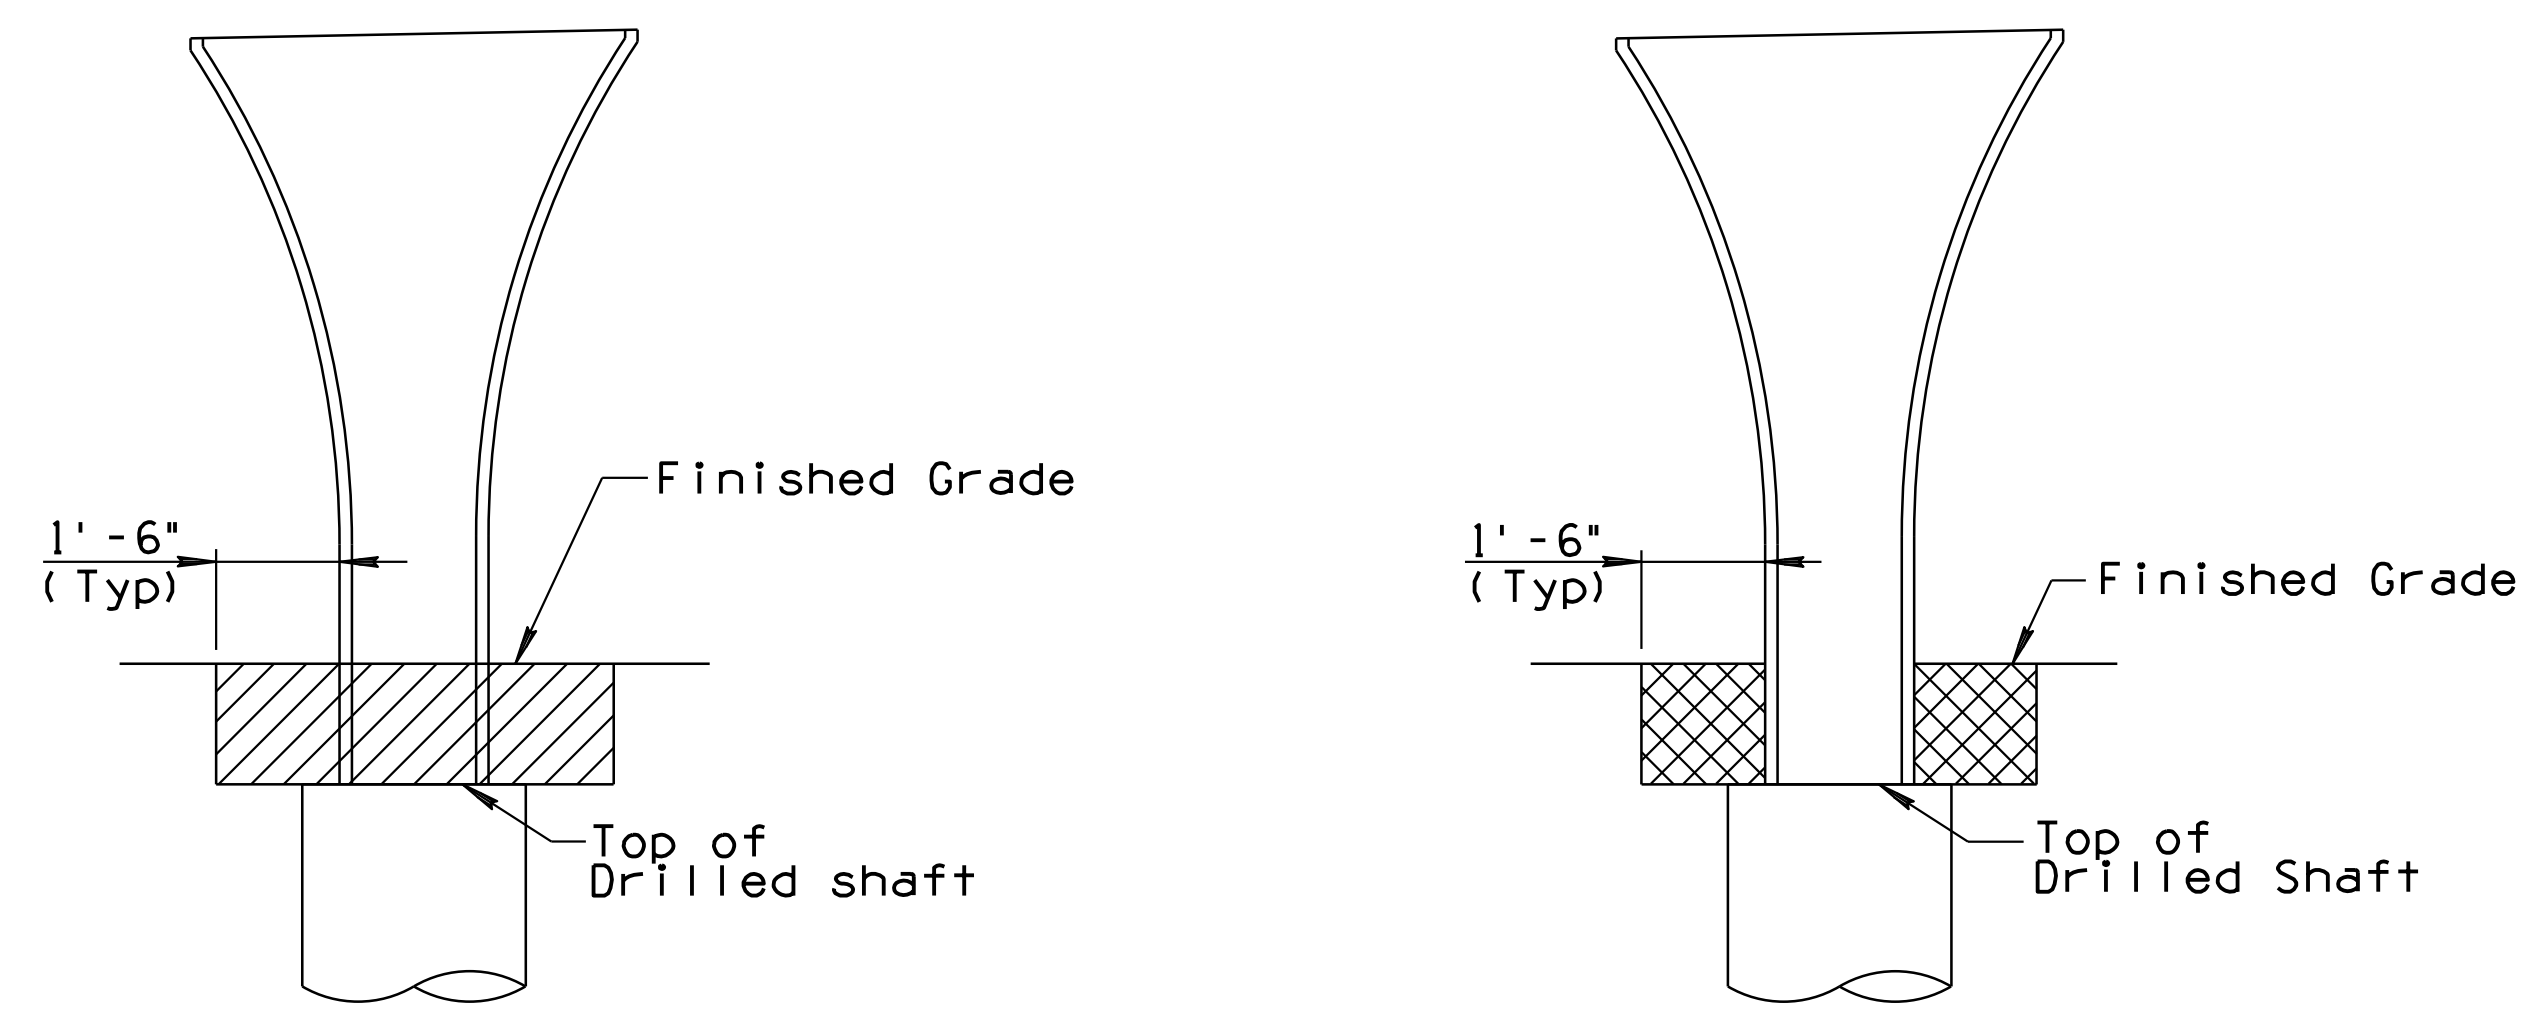

**LEGEND**

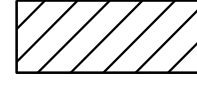 Structural Excavation

 Structure Backfill

STRUCTURAL EXCAVATION PAYMENT LIMITS


STRUCTURE BACKFILL PAYMENT LIMITS

RUTHRAUFF ROAD APPROXIMATE QUANTITIES											
ITEM	STRUCT EXC	STRUCT BACKFILL	CLASS "S" CONCRETE			RE INFORCING STEEL	AASHTO TYPE VI GIRDERS	DRILLED SHAFTS			
			f' <sub>c</sub> =3,500psi	f' <sub>c</sub> =4,000psi	f' <sub>c</sub> =4,500psi			60" φ		72" φ	
UNIT	CY	CY	CY	CY	CY	LB	LF	NO.	LF	NO.	LF
Abutment 1	50	30	296			66,442		6	540		
Pier	55	35	332			102,808				5	475
Abutment 2	50	35	378			82,294		6	540		
Superstructure				18	1644	357,009	4144				
Total	155	100	1006	18	1644	608,553	4144	12	1080	5	475
As-Built Total											

Deck Joint Assembly (Strip Seal Joint).....	164	LF
Combination Pedestrian-Traffic Bridge Railing.....	621	LF
Pedestrian Fence for Combination Pedestrian-Traffic Bridge Railing....	597	LF
Approach Slab (SD 2.01).....	6597	SF
Anchor Slab (Type 2)(SD2.03).....	3240	SF
Restrainers, Vertical Earthquake (Expansion).....	28	EA
Restrainers Vertical Earthquake (Fixed).....	28	EA
Remove Bridge (NB & SB I-10 OVER RUTHRAUFF RD).....	1	L. Sum
Underdeck Lighting (Ruthrauff Road T.I. Underpass).....	1	L. Sum

**NOTES:**

1. An additional 3/4" of deck concrete for stay-in-place forms is included in Class "S" Concrete f'<sub>c</sub>=4500 psi (9.4 psf applied over the area of the deck between girder flanges). The cost of stay-in-place forms is included with the cost of the deck concrete and will not be paid for separately.
2. Cost of temporary shoring is included with the cost of other bridge contract items. No separate payment will be made for temporary shoring.
3. The cost for lighting is not included with the cost of the structure. See Lighting Sheets.


DESIGN	LES / HV	DATE	3-19	ARIZONA DEPARTMENT OF TRANSPORTATION INFRASTRUCTURE DELIVERY AND OPERATIONS DIVISION BRIDGE GROUP
DRAWN	DAY	DATE	3-19	
CHECKED	AGG / JAC	DATE	3-19	
<b>wsp</b>		WSP USA Inc. 177 N. Church Avenue Suite 1105 Tucson, AZ 85701		
RUTHRAUFF ROAD T.I. UNDERPASS EXCAVATION, BACKFILL & QUANTITIES				
I-10	252.00	20159	LOCATION	RUTHRAUFF ROAD T.I.
ROUTE	MILEPOST	STRUCTURE NO.		DWG NO. S-1.04
TRACS NO. H 8480 OIC				010-D(213)S
				OF

DATE- LOCATION- REVISIONS- FINISHED PLANS- SURVEY NO. DATE- LOCATION- REVISIONS- FINISHED PLANS- SURVEY NO.




F.H.W.A. REGION	STATE	PROJECT NO.	SHEET NO.	TOTAL SHEETS	RECORD DRAWING
9	ARIZ.	010-D(213)S	618	849	

010 PM 252

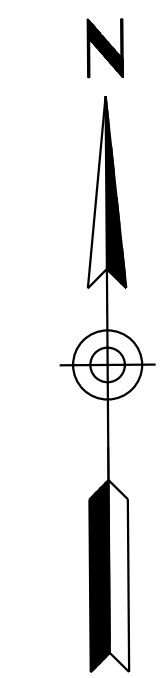

**NOTES:**

- 1 indicates drilled shaft foundation identification number.
- The Contractor shall select one 72" Dia drilled shaft as a confirmation shaft per Section 609 of the Standard Specifications. The selected shaft shall be indicated in the Contractor's drilled shaft installation plan.
- For Project Geotechnical Information, see the Final Geotechnical Report by NCS Consultants, Inc. dated March 31, 2015.
- Contractor shall submit a plan detailing the drilling construction procedures for approval in the Drilled Shaft Installation Plan prior to starting drilled shaft construction.
- Temporary Support of Steel Casing (if needed) is the Contractor's responsibility and is considered included in the drilled shaft pay item.
- See Utility Relocation Plans for additional information and details.
- It is anticipated that the shafts will be installed after I-10 roadway embankment. The Contractor shall wait 5 days after the embankment is placed before constructing any shafts. If a different construction sequence is used, notify the engineer prior to construction for approval.

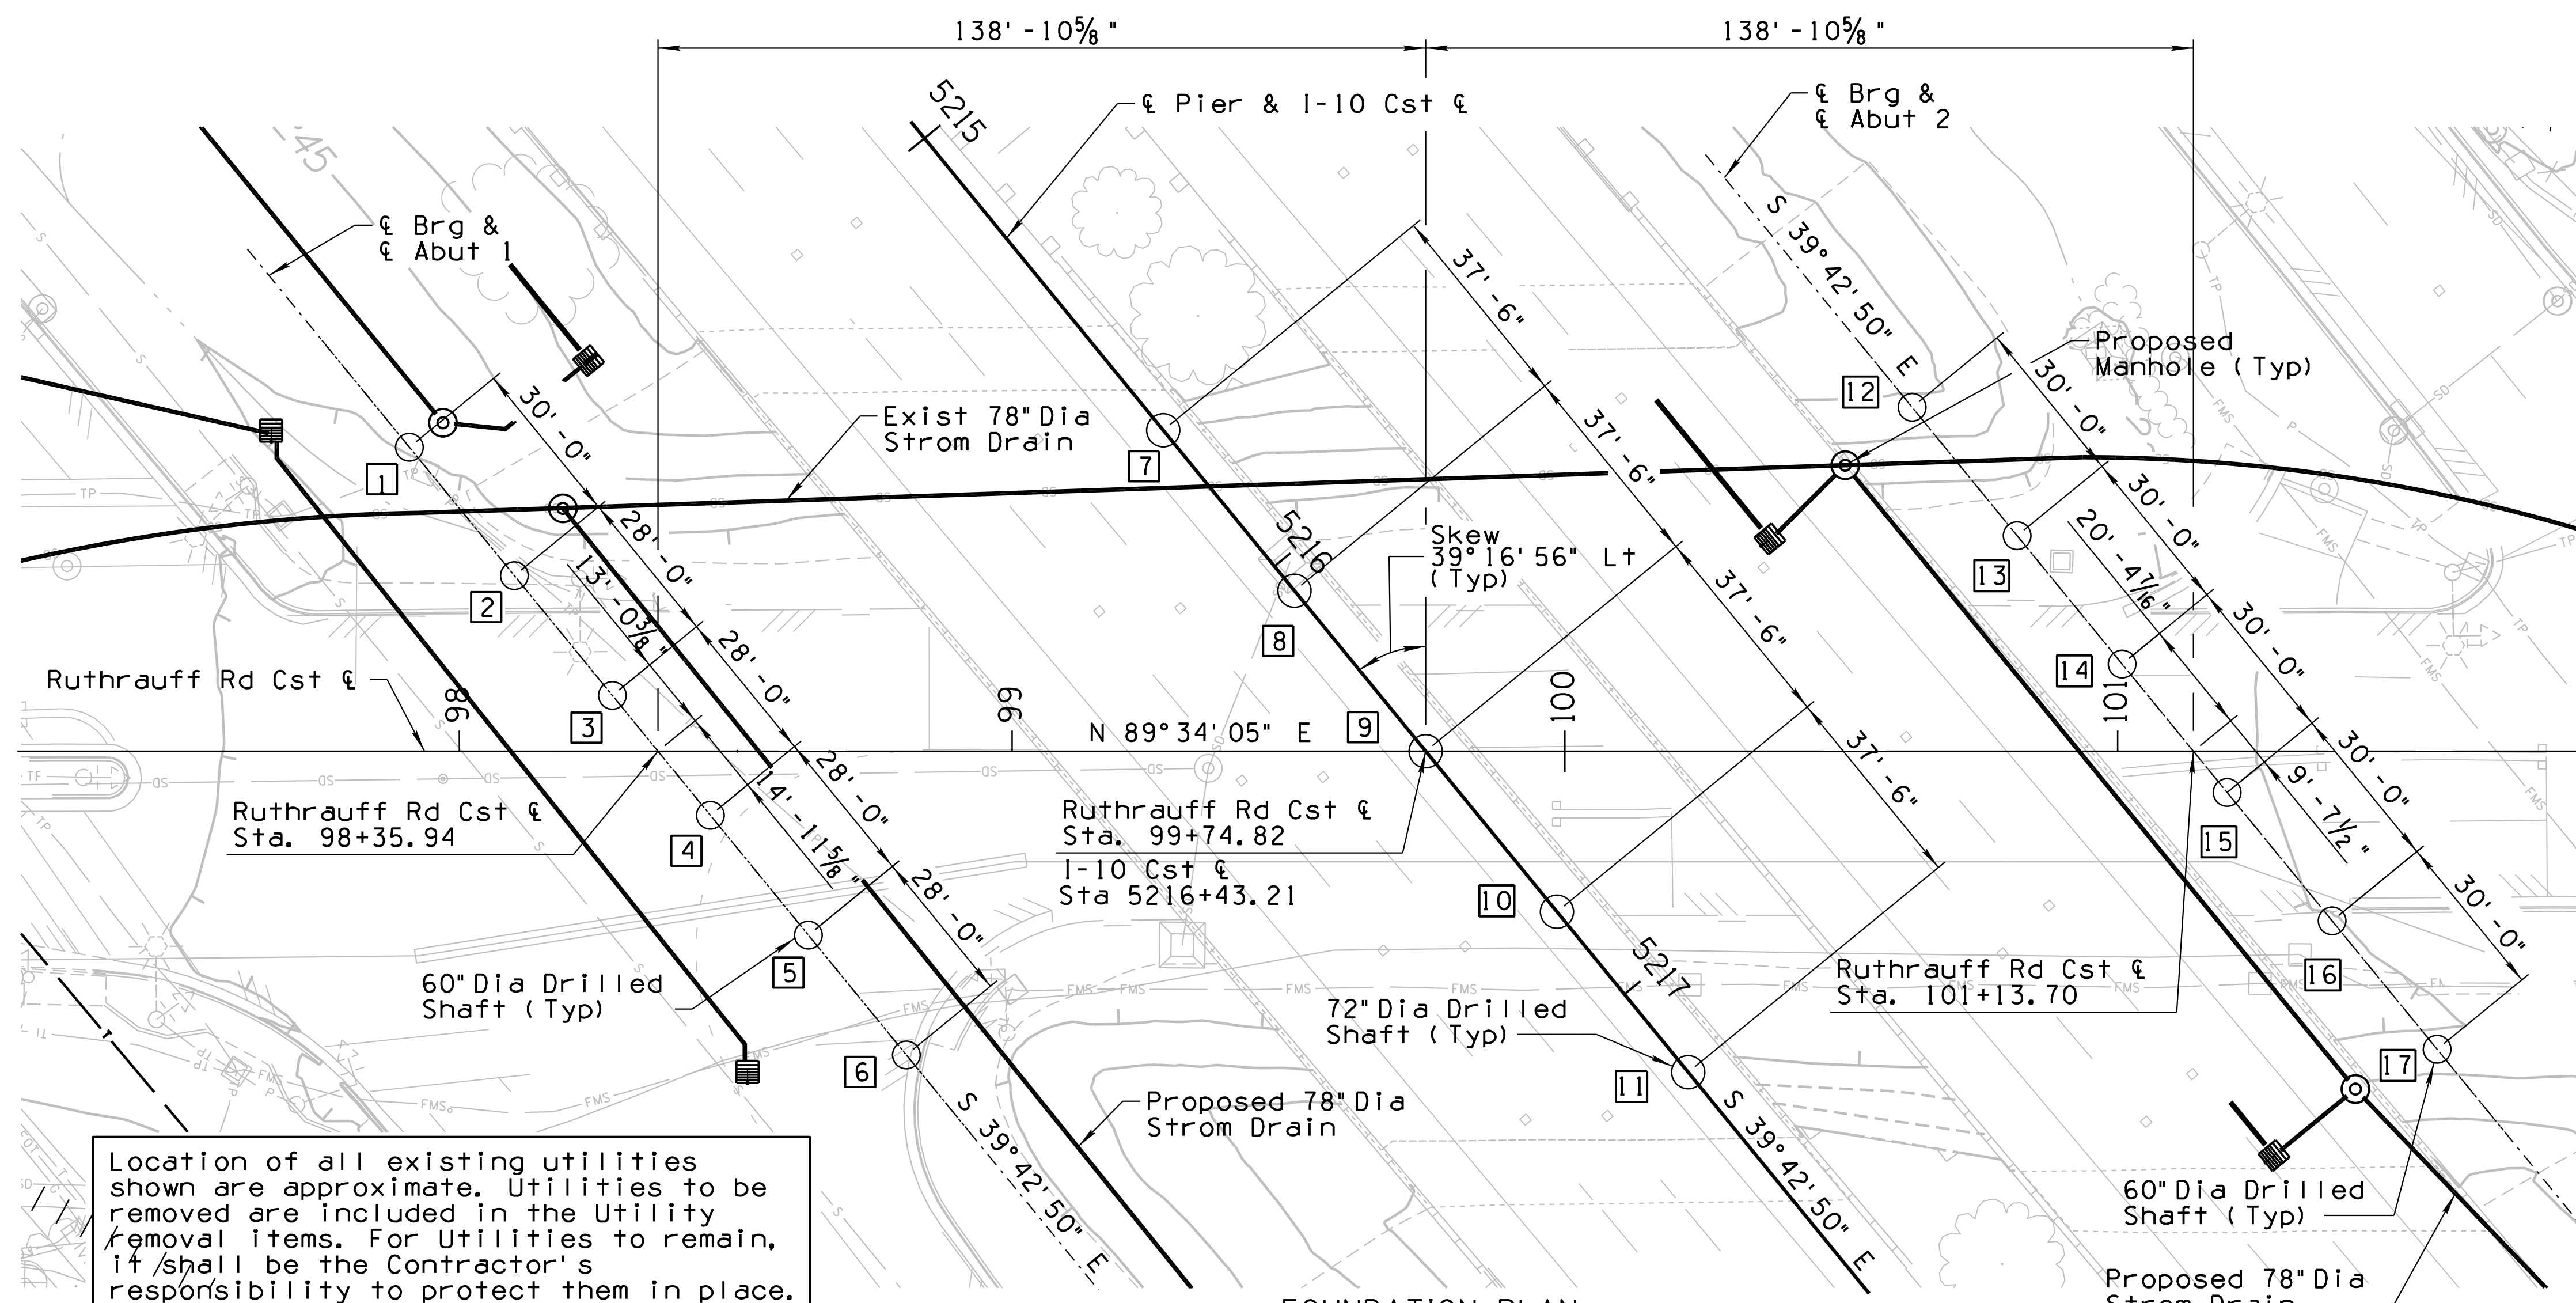

Location of all existing utilities shown are approximate. Utilities to be removed are included in the Utility Removal items. For Utilities to remain, it shall be the Contractor's responsibility to protect them in place.

**FOUNDATION PLAN**  
1' Contour Interval  
Scale: 1"=20'

Location	Shaft No	Ruthrauff Rd Cst &		I-10 Cst &	
		Station	Offset	Station	Offset
Abut 1	1	97+90.97	54.98 Lt	5214+85.25	107.50 Rt
	2	98+09.96	31.76 Lt	5215+14.25	107.50 Rt
	3	98+27.69	10.09 Lt	5215+42.25	107.50 Rt
	4	98+45.42	11.59 Rt	5215+70.25	107.50 Rt
	5	98+63.14	33.26 Rt	5215+98.25	107.50 Rt
	6	98+80.87	54.93 Rt	5216+26.25	107.50 Rt
Pier	7	99+27.34	58.05 Lt	5215+68.21	--
	8	99+51.08	29.03 Lt	5216+05.71	--
	9	99+74.82	--	5216+43.21	--
	10	99+98.56	29.03 Rt	5216+80.71	--
	11	100+22.31	58.05 Rt	5217+18.21	--
Abut 2	12	100+62.82	62.21 Lt	5216+50.78	107.50 Lt
	13	100+81.81	38.99 Lt	5216+80.78	107.50 Lt
	14	101+00.81	15.77 Lt	5217+10.78	107.50 Lt
	15	101+19.80	7.45 Rt	5217+40.78	107.50 Lt
	16	101+38.79	30.68 Rt	5217+70.78	107.50 Lt
	17	101+57.79	53.90 Rt	5218+00.78	107.50 Lt


DRILLED SHAFT DATA								
	Top of Shaft (Elev.)	Bottom of Shaft (Elev.)	Shaft Diameter (In)	Shaft Length (Ft)	Service Limit State (Kips)	Strength Limit State (Kips)	Estimated Design Settlement (In)	Unfactored Down Drag Load (Kips)
Abut 1	2246.00	2156.00	60"	90'	2201	3340	0.20"	1000
Pier	2245.00	2150.00	72"	95'	2103	2799	0.20"	--
Abut 2	2245.00	2155.00	60"	90'	2201	3340	0.20"	1000

Loads are modified for non-redundant and/or group effects. Estimated design settlement is the total settlement that occurs after construction of the shaft.


DESIGN	LES / HV	DATE	3-19	ARIZONA DEPARTMENT OF TRANSPORTATION INFRASTRUCTURE DELIVERY AND OPERATIONS DIVISION BRIDGE GROUP <b>STA 99+          RUTHRAUFF ROAD T.I. UNDERPASS          FOUNDATION PLAN</b>	
DRAWN	DAY	DATE	3-19		
CHECKED	AGG / JAC	DATE	3-19		
		WSP USA Inc. 177 N. Church Avenue Suite 1105 Tucson, AZ 85701		LOCATION <b>RUTHRAUFF ROAD T.I.</b>	EXPIRES 3/31/2019 DWG NO. S-1.05
I-10 ROUTE	252.00 MILEPOST	20159 STRUCTURE NO.	TRACS NO. H 8480 OIC		
			010-D(213)S		
			OF		

F.H.W.A. REGION	STATE	PROJECT NO.	SHEET NO.	TOTAL SHEETS	RECORD DRAWING
9	ARIZ.	010-D(213)S	619	849	


010 PM 252

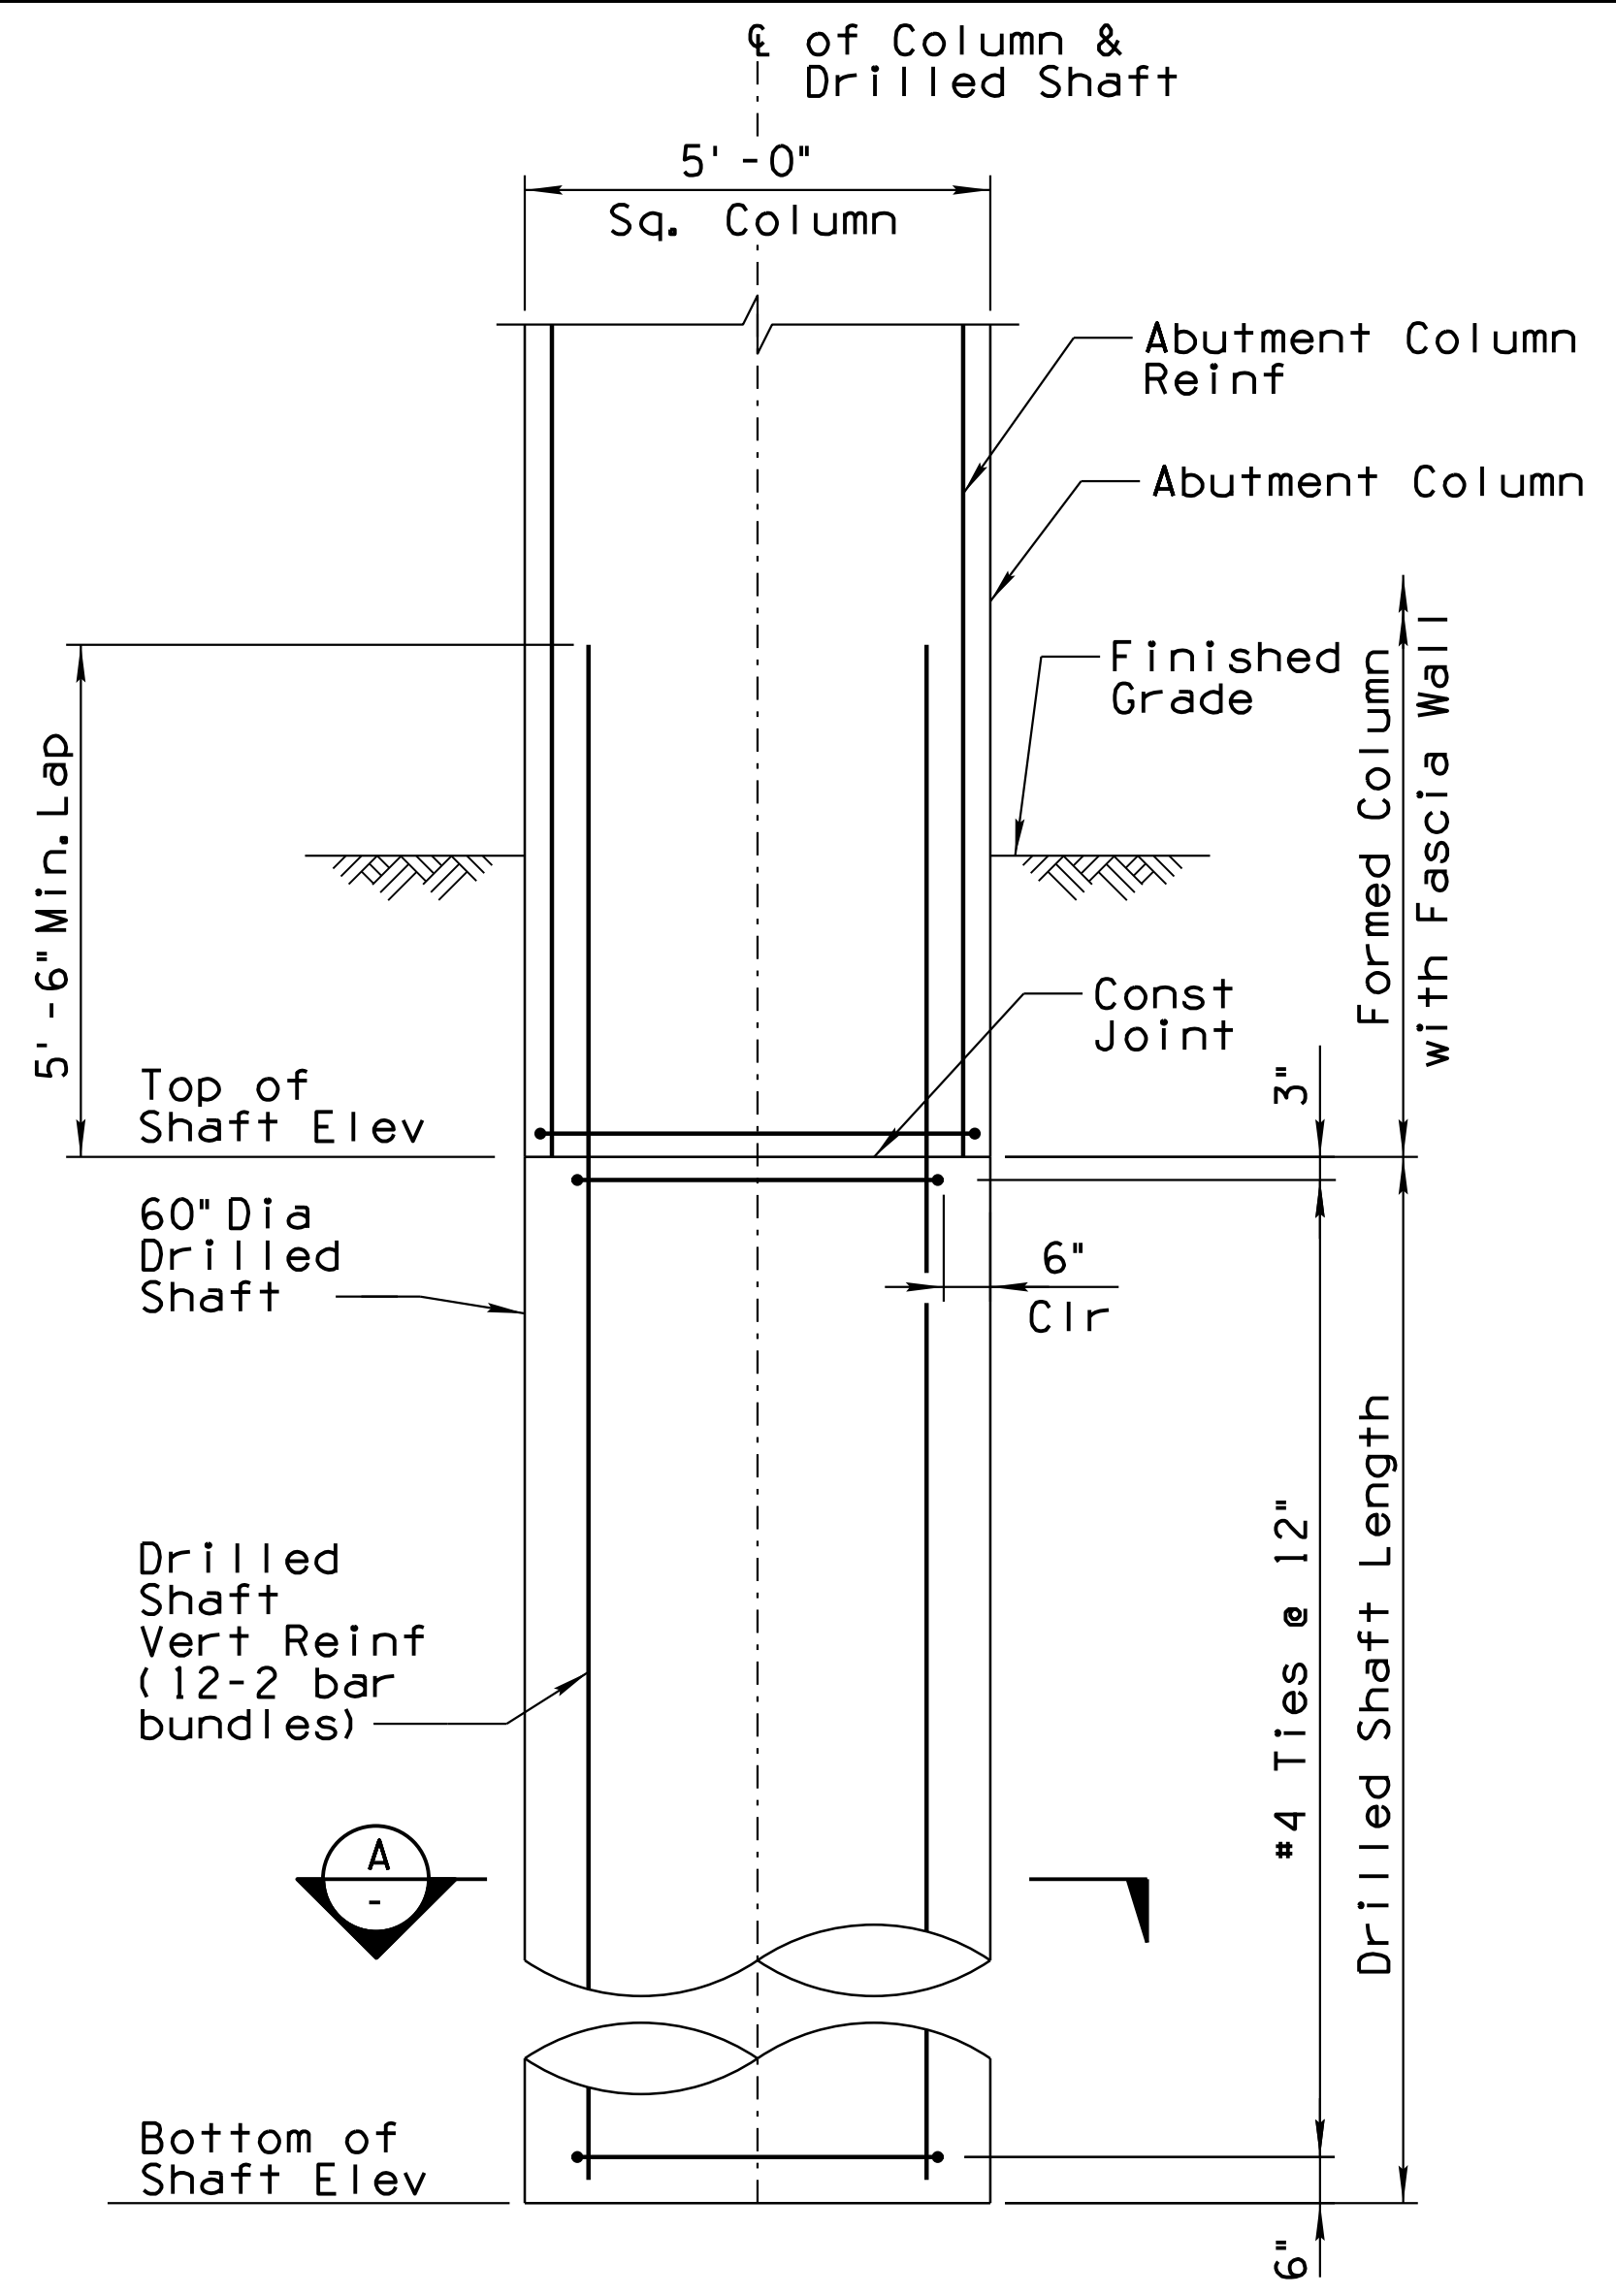

**ABUTMENT DRILLED SHAFT DETAIL**  
Scale: 1/2" = 1'-0"

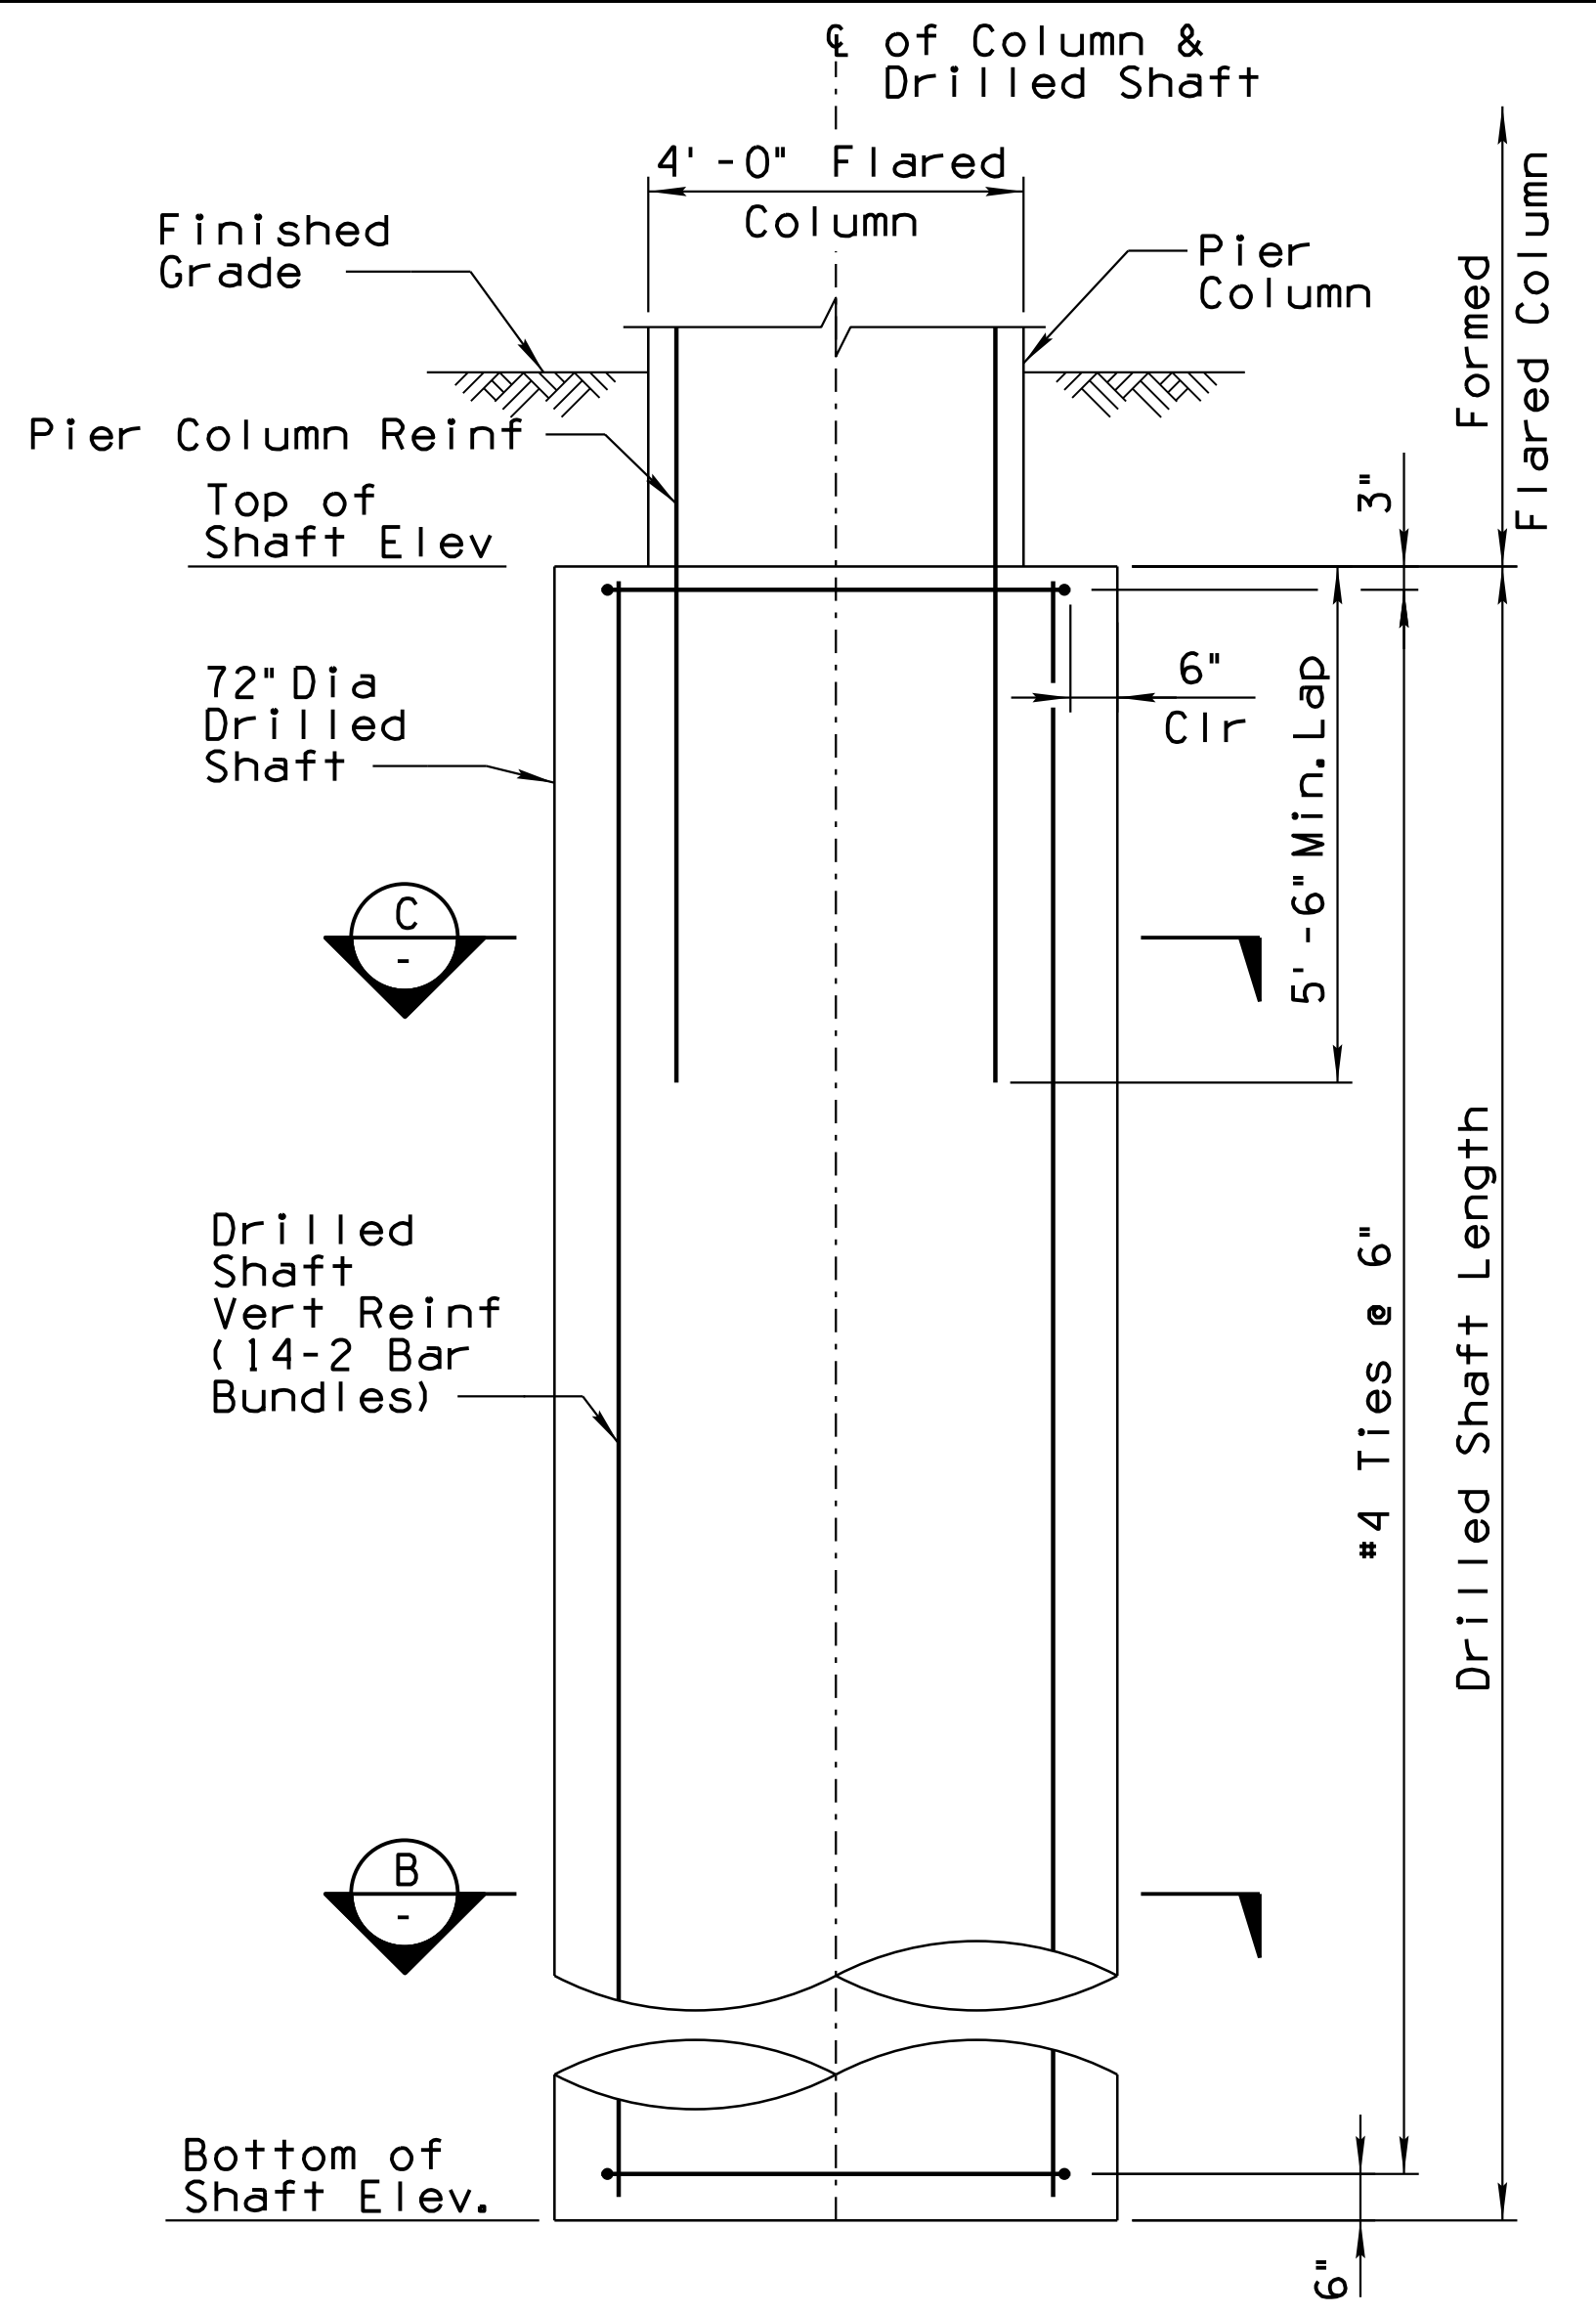


**PIER DRILLED SHAFT DETAIL**  
Scale: 1/2" = 1'-0"

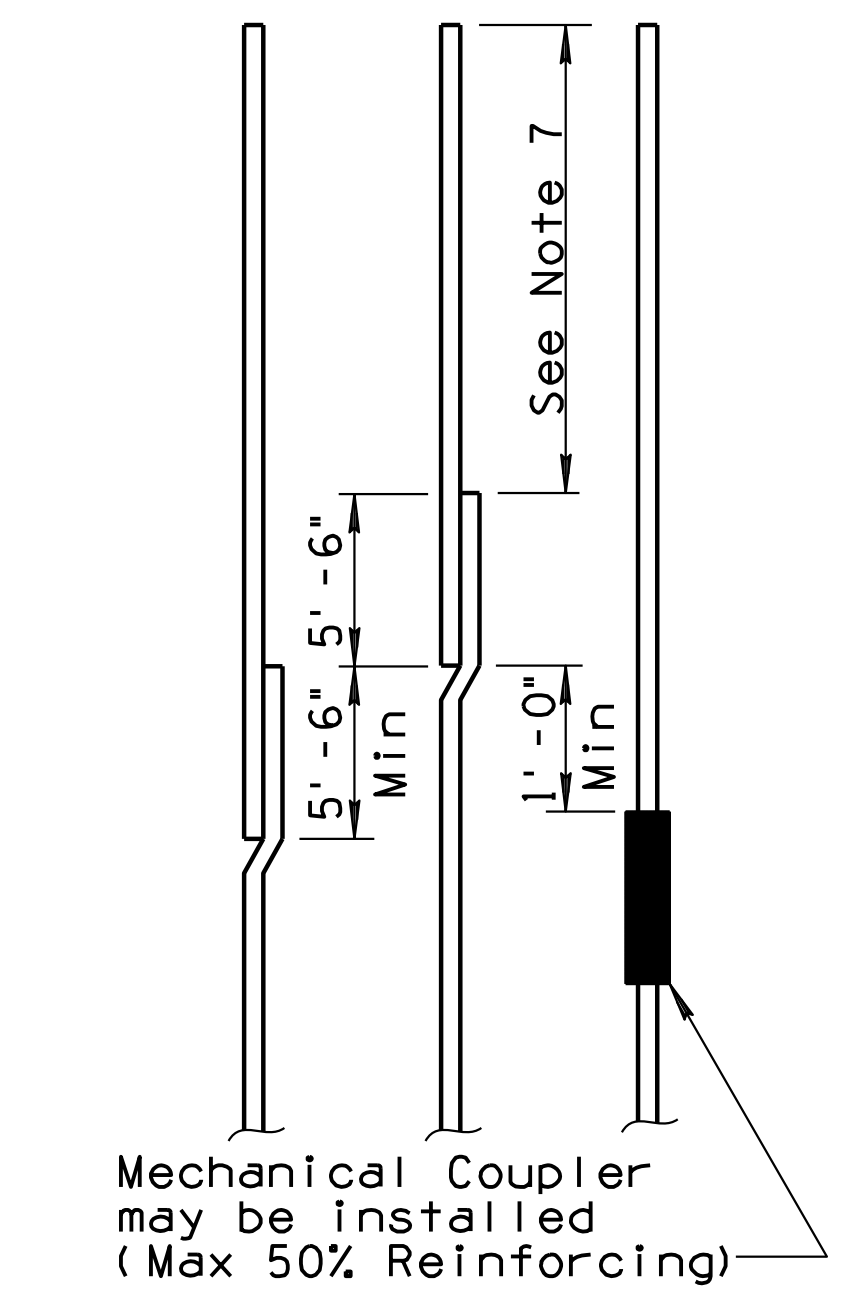


**RESTRICTION ON SPLICE AT DRILLED SHAFTS**  
N. T. S.

**DRILLED SHAFT NOTES:**


1. Drilled Shafts shall be constructed into existing grade and/or compacted roadway embankment.
2. Shaft concrete shall be placed within 24 hours after the excavation has been completed and the reinforcing cage placed in position.
3. Drilled shaft excavation will not be permitted until the concrete of any adjacent drilled shaft has been in place a minimum of 48 hours. An adjacent drilled shaft is any drilled shaft within 4 diameters measured from center to center.
4. Construction joints not shown on the project plans shall require the approval of the Engineer prior to construction.
5. In the event of a weak layer (silt, clay, loose sand, etc) at the recommended tip elevation, the shaft shall be extended to bear on firm soil as determined by the Engineer.
6. The contractor shall orient the drilled shaft reinforcing cage to minimize conflict with the reinforcing in the columns.
7. Drilled shaft reinforcing shall not be spliced in the upper 1/3 of the shaft. Lap splices shall be staggered as far as possible below this region.
8. Integrity Testing Tubes shall be installed in all shafts. The size, type, and details of tubes shall be per the Standard Specifications and the Special Provisions. Tubes shall not be attached to vertical reinforcing.
9. The Integrity Testing Tubes shall be extended to within 6" of the completed tip elevation. If the tip elevation is greater than 3'-0" below plan, support reinforcing for the tubes shall be installed to provide a maximum unsupported length of 3'-0".
10. The cost of drilled shaft vertical reinforcing projection above top elevation, any mechanical couplers, any casings and any additional concrete required for oversized casings shall be considered incidental to the drilled shaft pay item.
11. Shaft cage shall be held in position during placement of shaft concrete.
12. Payment for any and all work required below the tip elevation shown shall be based on the unit price per linear foot for the drilled shaft pay item.
13. See Standard Specifications and Special Provisions for additional requirements.

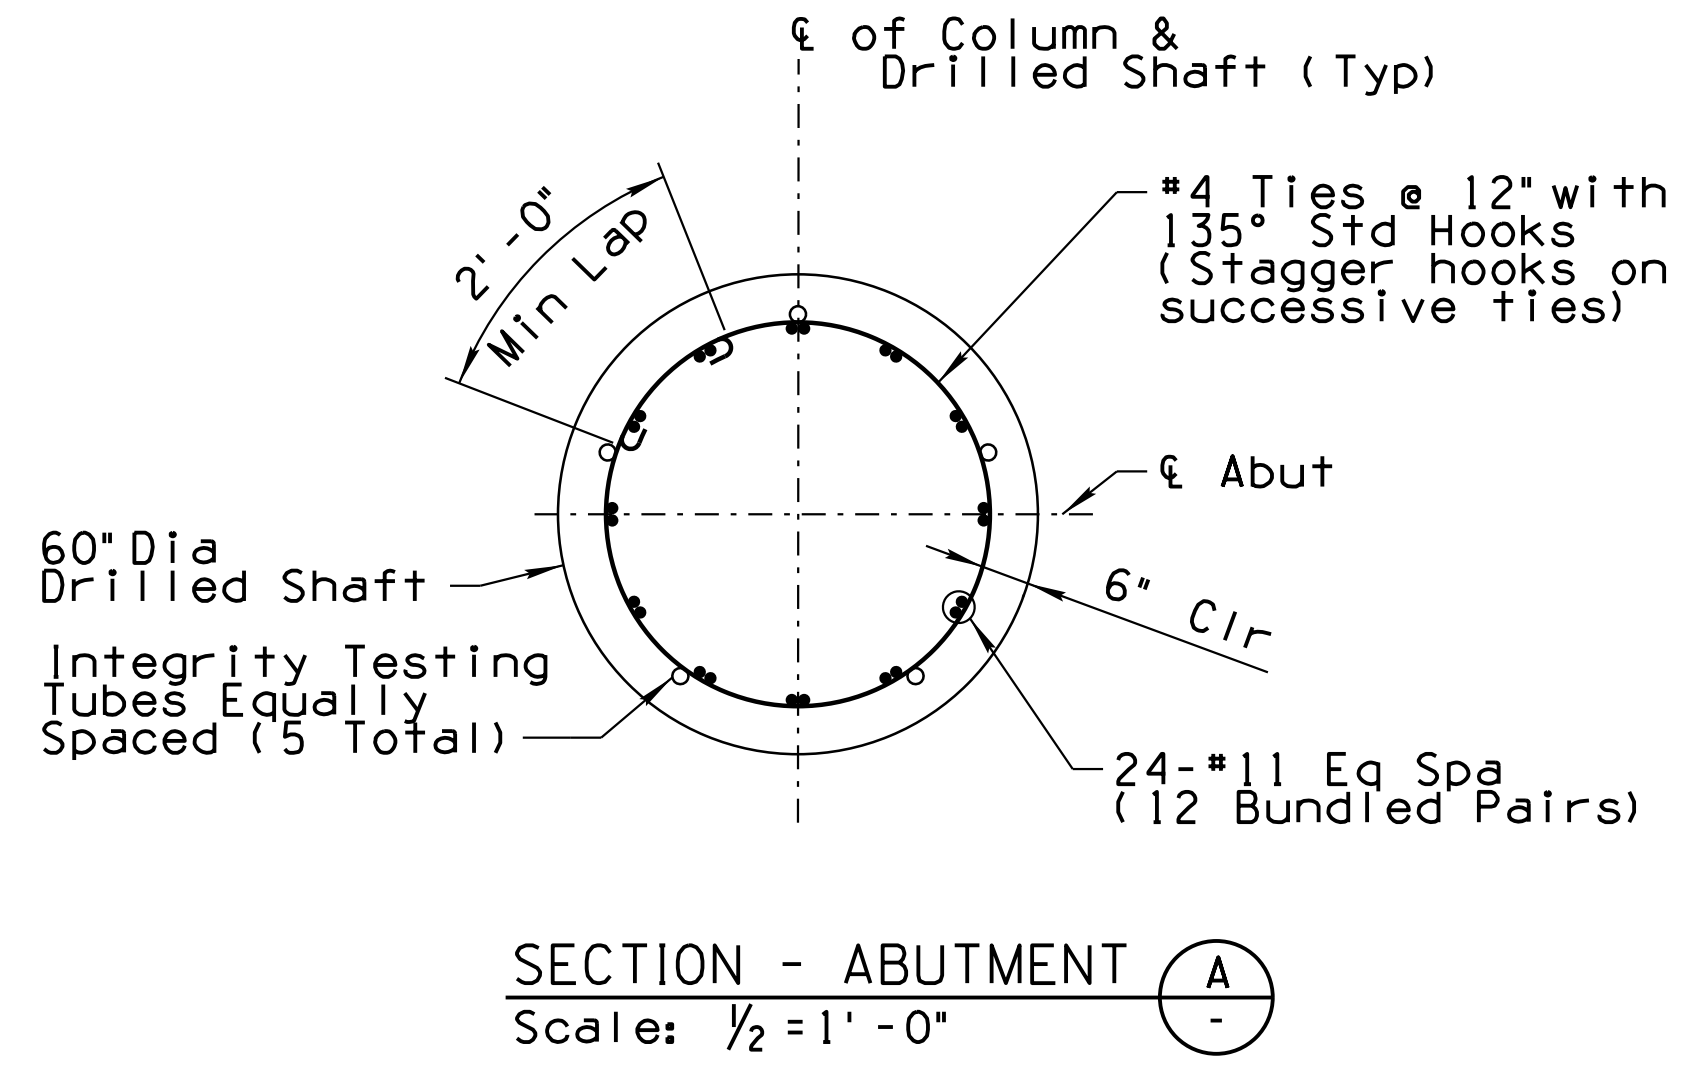

**SECTION - ABUTMENT (A)**  
Scale: 1/2" = 1'-0"

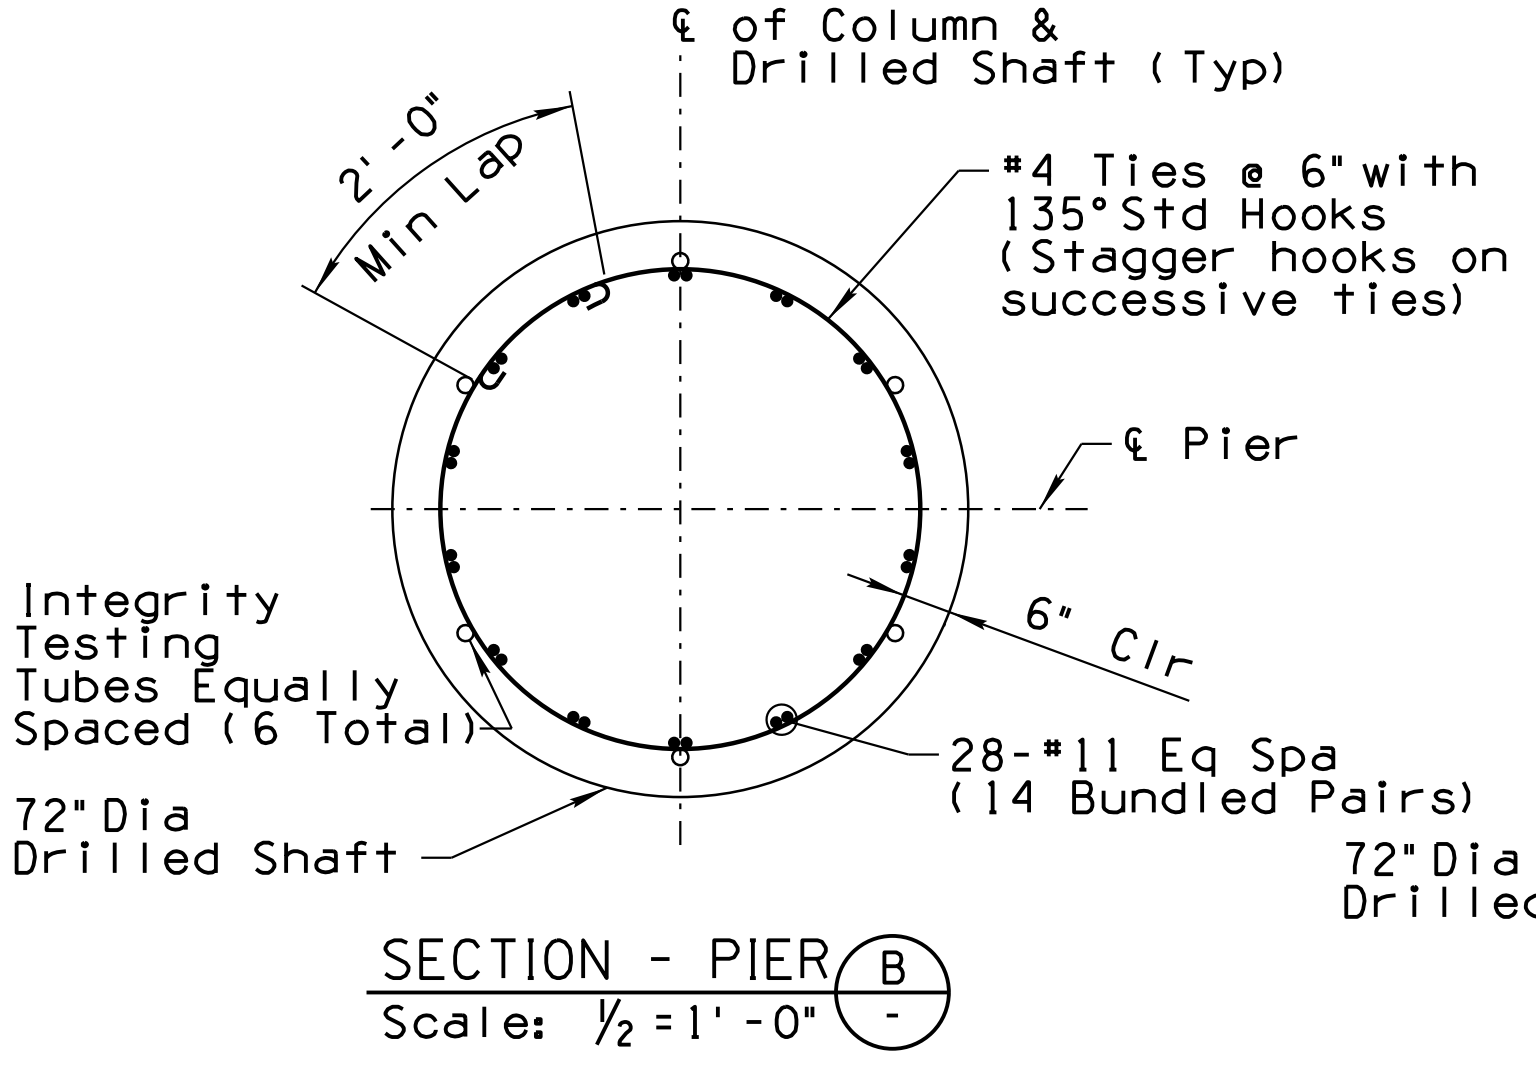

**SECTION - PIER (B)**  
Scale: 1/2" = 1'-0"

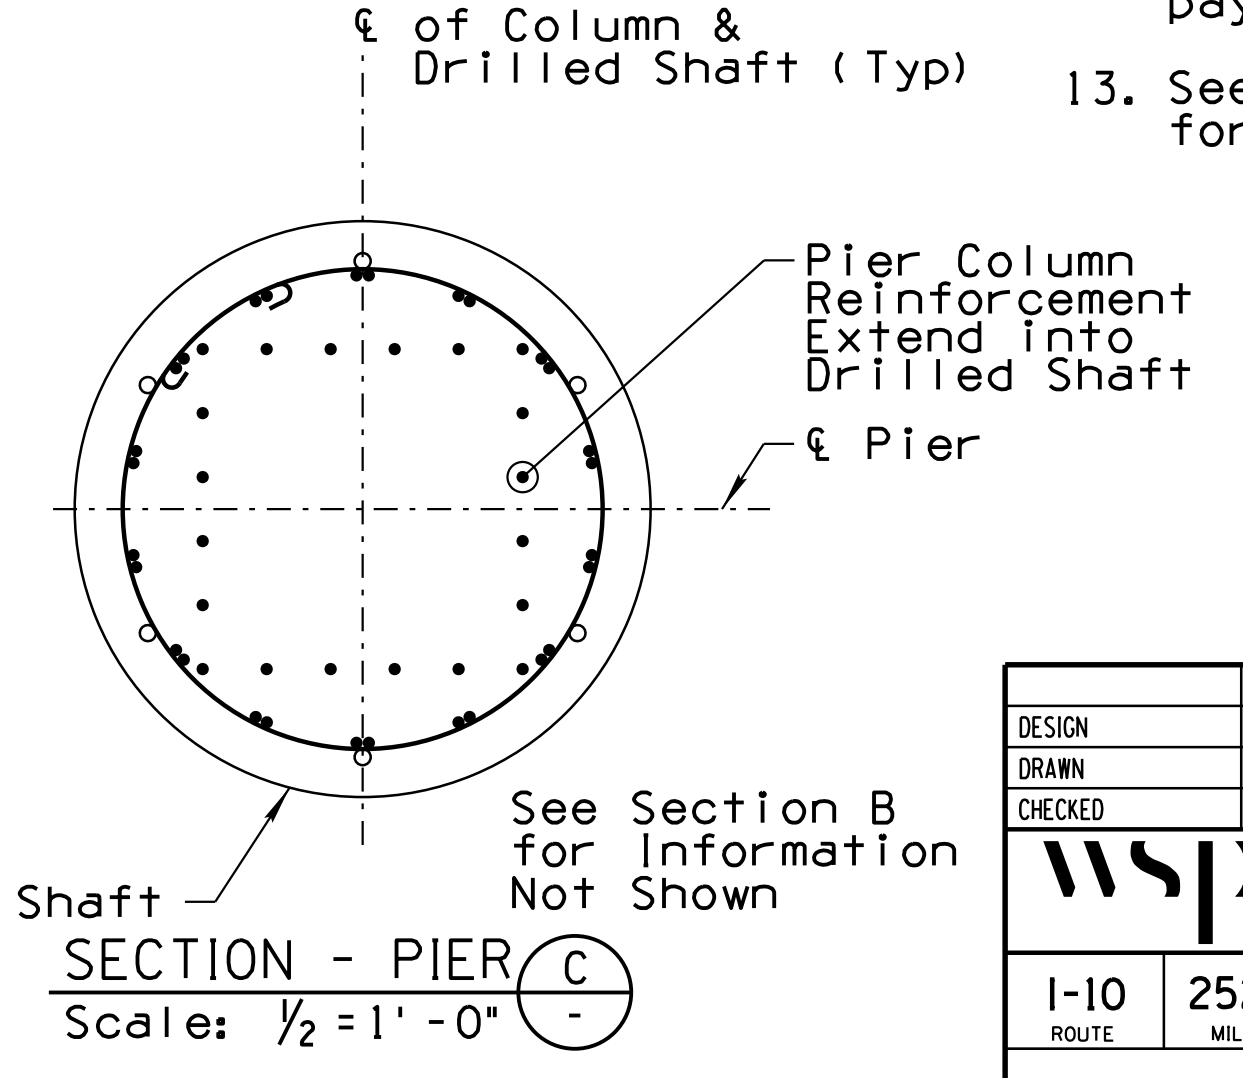


**SECTION - PIER (C)**  
Scale: 1/2" = 1'-0"

DESIGN	LES / HV	DATE	3-19	ARIZONA DEPARTMENT OF TRANSPORTATION INFRASTRUCTURE DELIVERY AND OPERATIONS DIVISION <b>BRIDGE GROUP</b> STA 99+ <b>RUTHRAUFF ROAD T.I. UNDERPASS          DRILLED SHAFT DETAILS</b>	
DRAWN	DAY	DATE	3-19		
CHECKED	AGG / JAC	DATE	3-19		
WSP	WSP USA Inc. 177 N. Church Avenue Suite 1105 Tucson, AZ 85701			LOCATION <b>RUTHRAUFF ROAD T.I.</b>	DWG NO. S-1.06
I-10	252.00	20159		TRACS NO. H 8480 OIC	010-D(213)S




F.H.W.A. REGION	STATE	PROJECT NO.	SHEET NO.	TOTAL SHEETS	RECORD DRAWING
9	ARIZ.	010-D(213)S	620	849	


010 PM 252

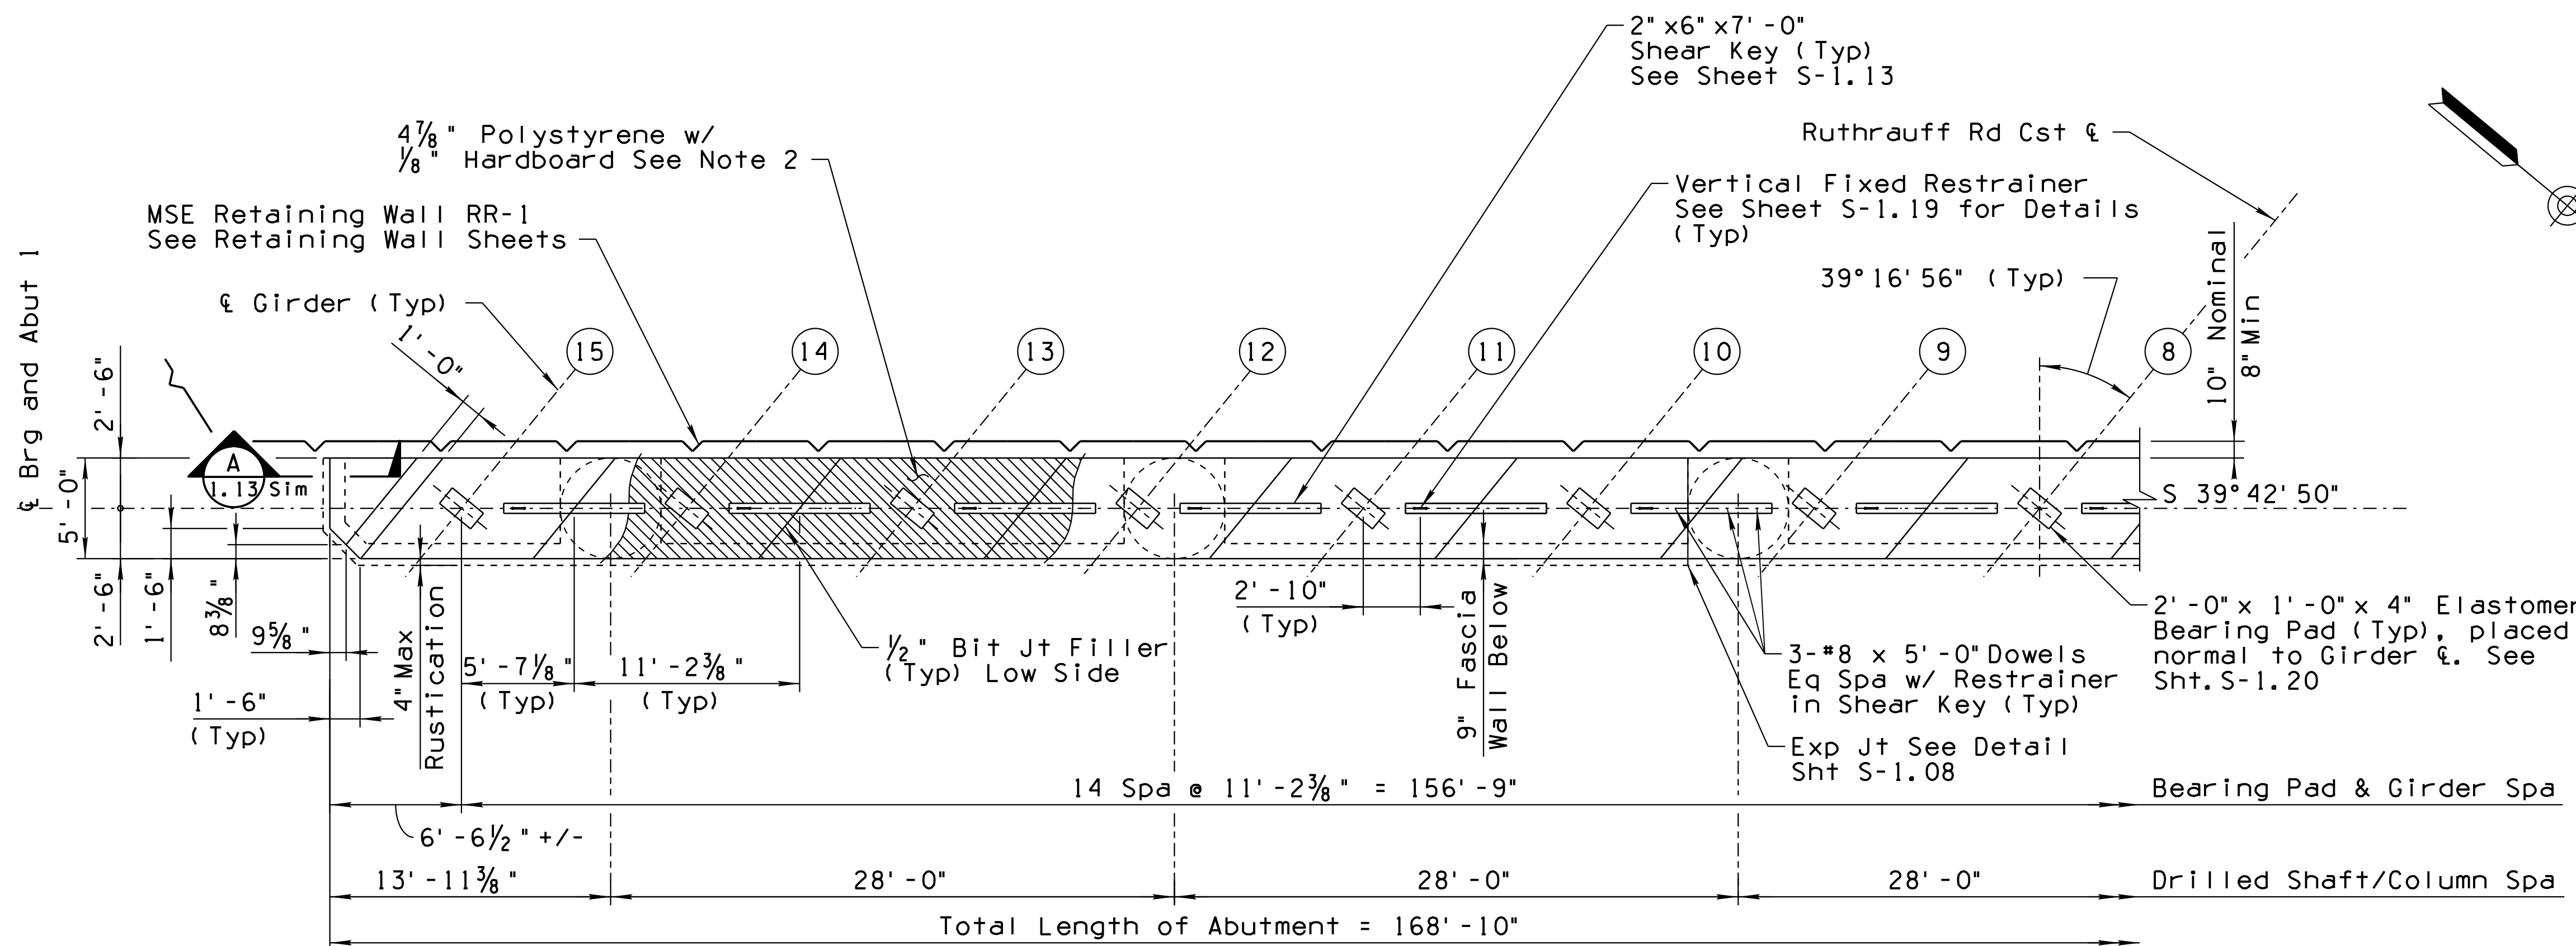

**PLAN**  
Looking Back Station  
Scale: 1/4" = 1'-0"

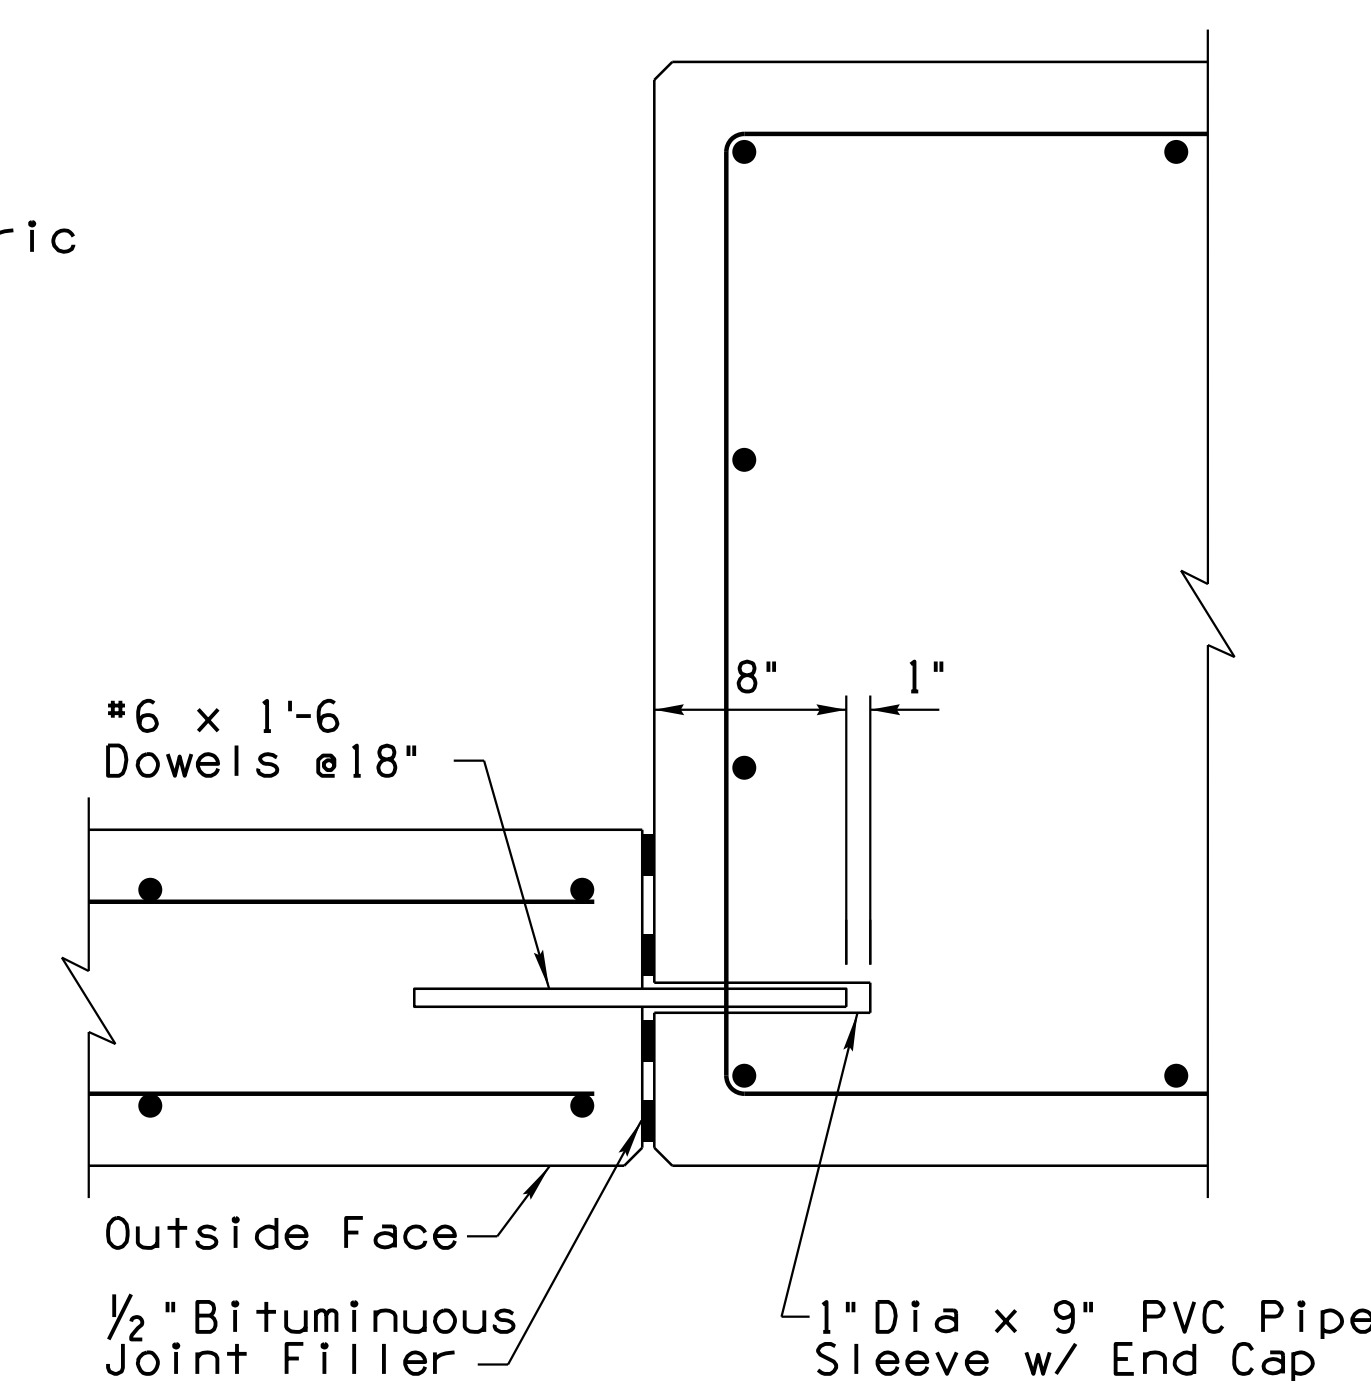


**EXPANSION JOINT DETAIL - FASCIA WALL**

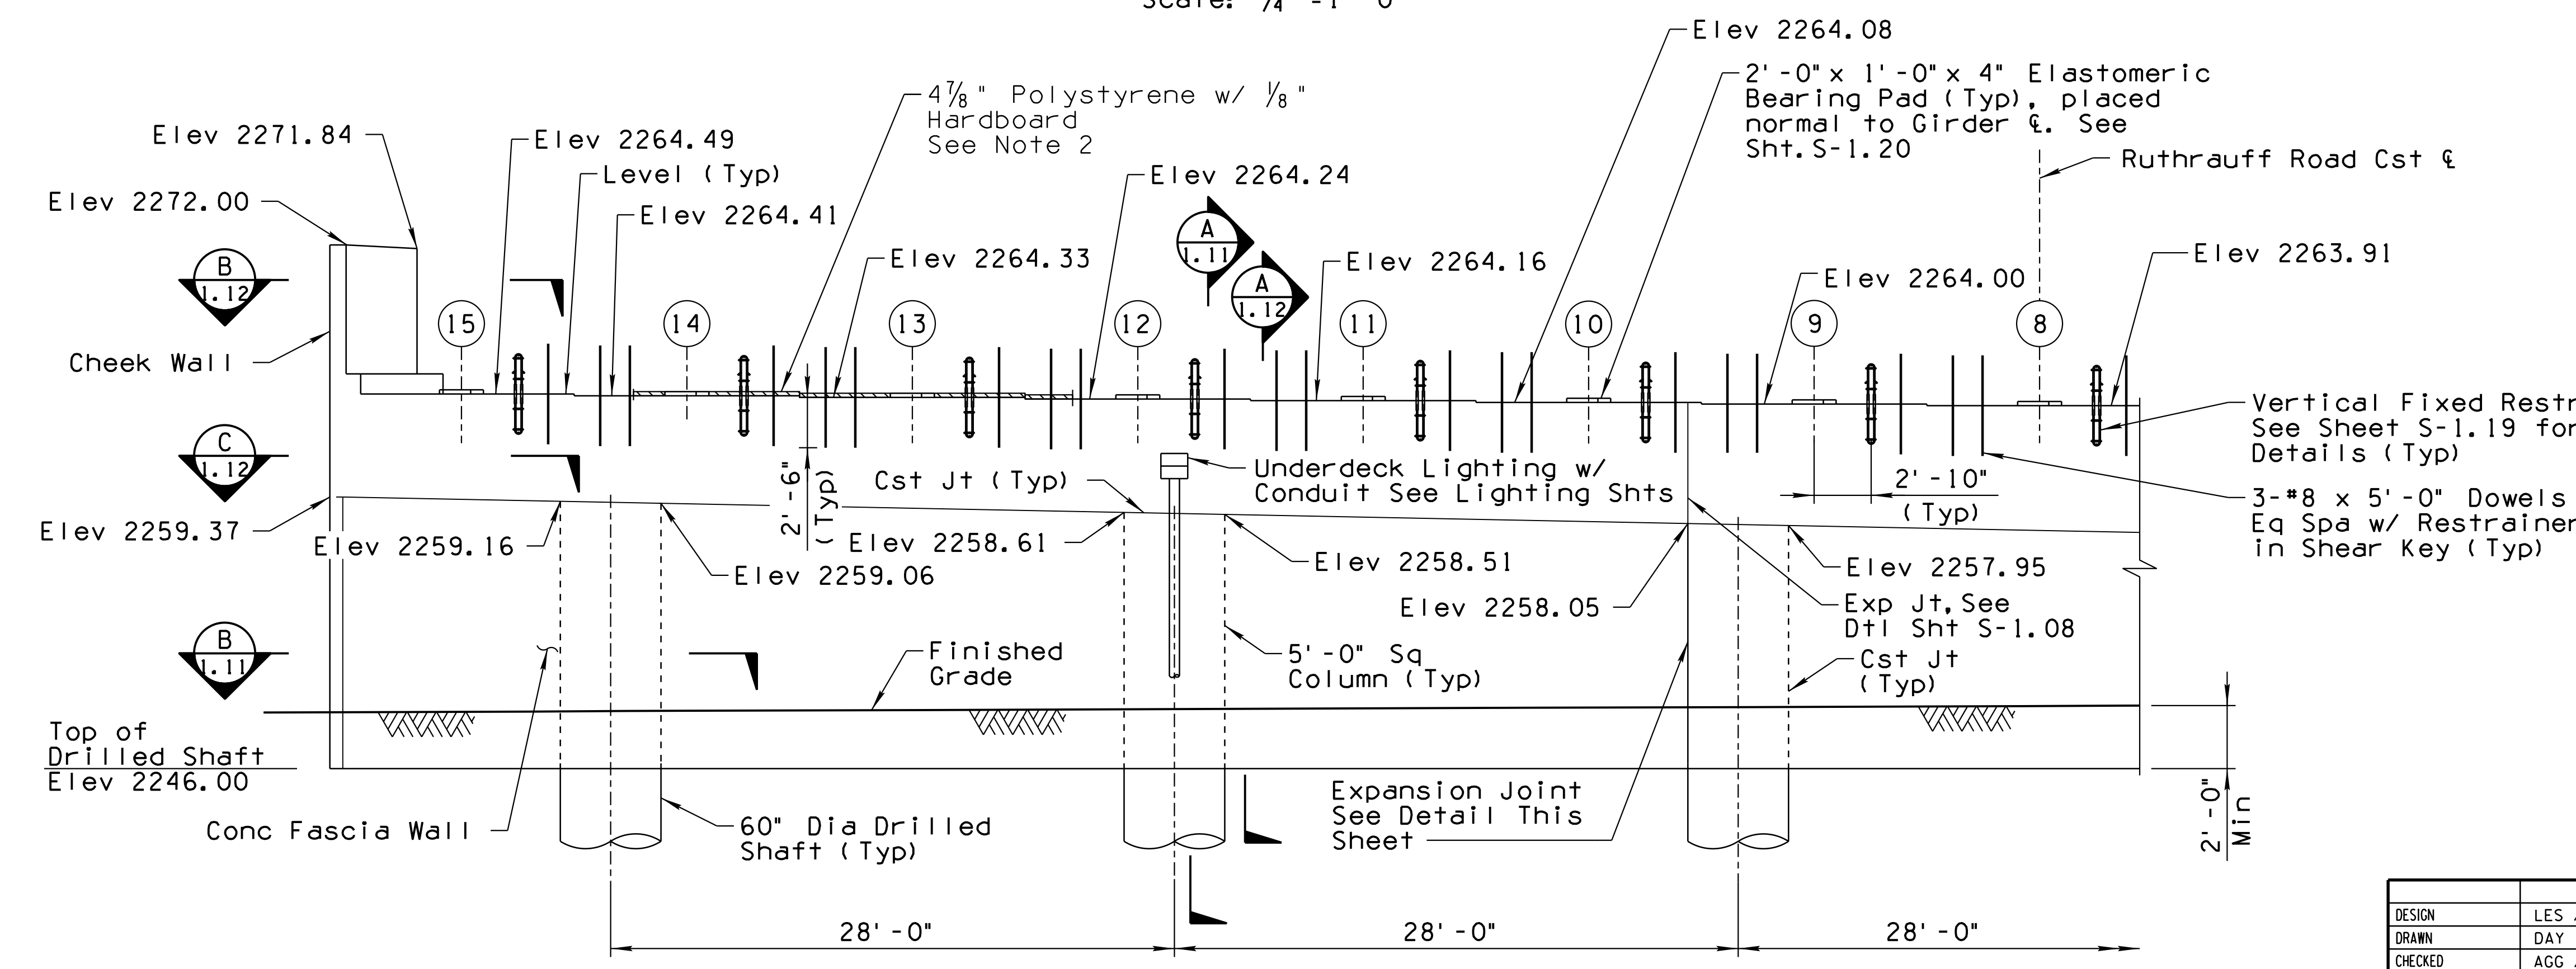

**ELEVATION**  
Looking Back Station  
Scale: 1/4" = 1'-0"

- Notes:**
1. Verify all bridge seats elevations prior the erection of the girders.
  2. Polystyrene + Hardboard thickness accounts for the 1" Bevel  $\rho$  thickness at  $\epsilon$  Brg


DESIGN	NAME	DATE	ARIZONA DEPARTMENT OF TRANSPORTATION INFRASTRUCTURE DELIVERY AND OPERATIONS DIVISION BRIDGE GROUP
DESIGN	LES / HV	3-19	
DRAWN	DAY	3-19	
CHECKED	AGG / JAC	3-19	
			<b>STA 99+ RUTHRAUFF ROAD T.I. UNDERPASS ABUTMENT I PLAN &amp; ELEVATION I</b>
<small>WSP USA Inc. 177 N. Church Avenue Suite 1105 Tucson, AZ 85701</small>			
I-10	252.00	20159	LOCATION <b>RUTHRAUFF ROAD T.I.</b>
TRACS NO. H 8480 OIC			DWG NO. S-1.07

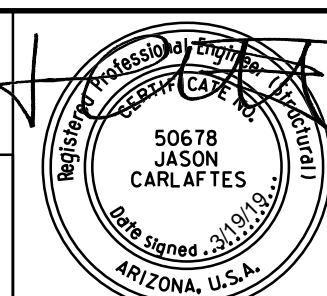



DATE: LOCATION: REVISIONS: FINISHED PLANS: SURVEY NO. DATE: LOCATION: REVISIONS: FINISHED PLANS: SURVEY NO.

F.H.W.A. REGION	STATE	PROJECT NO.	SHEET NO.	TOTAL SHEETS	RECORD DRAWING
9	ARIZ.	010-D(213)S	621	849	


010 PM 252

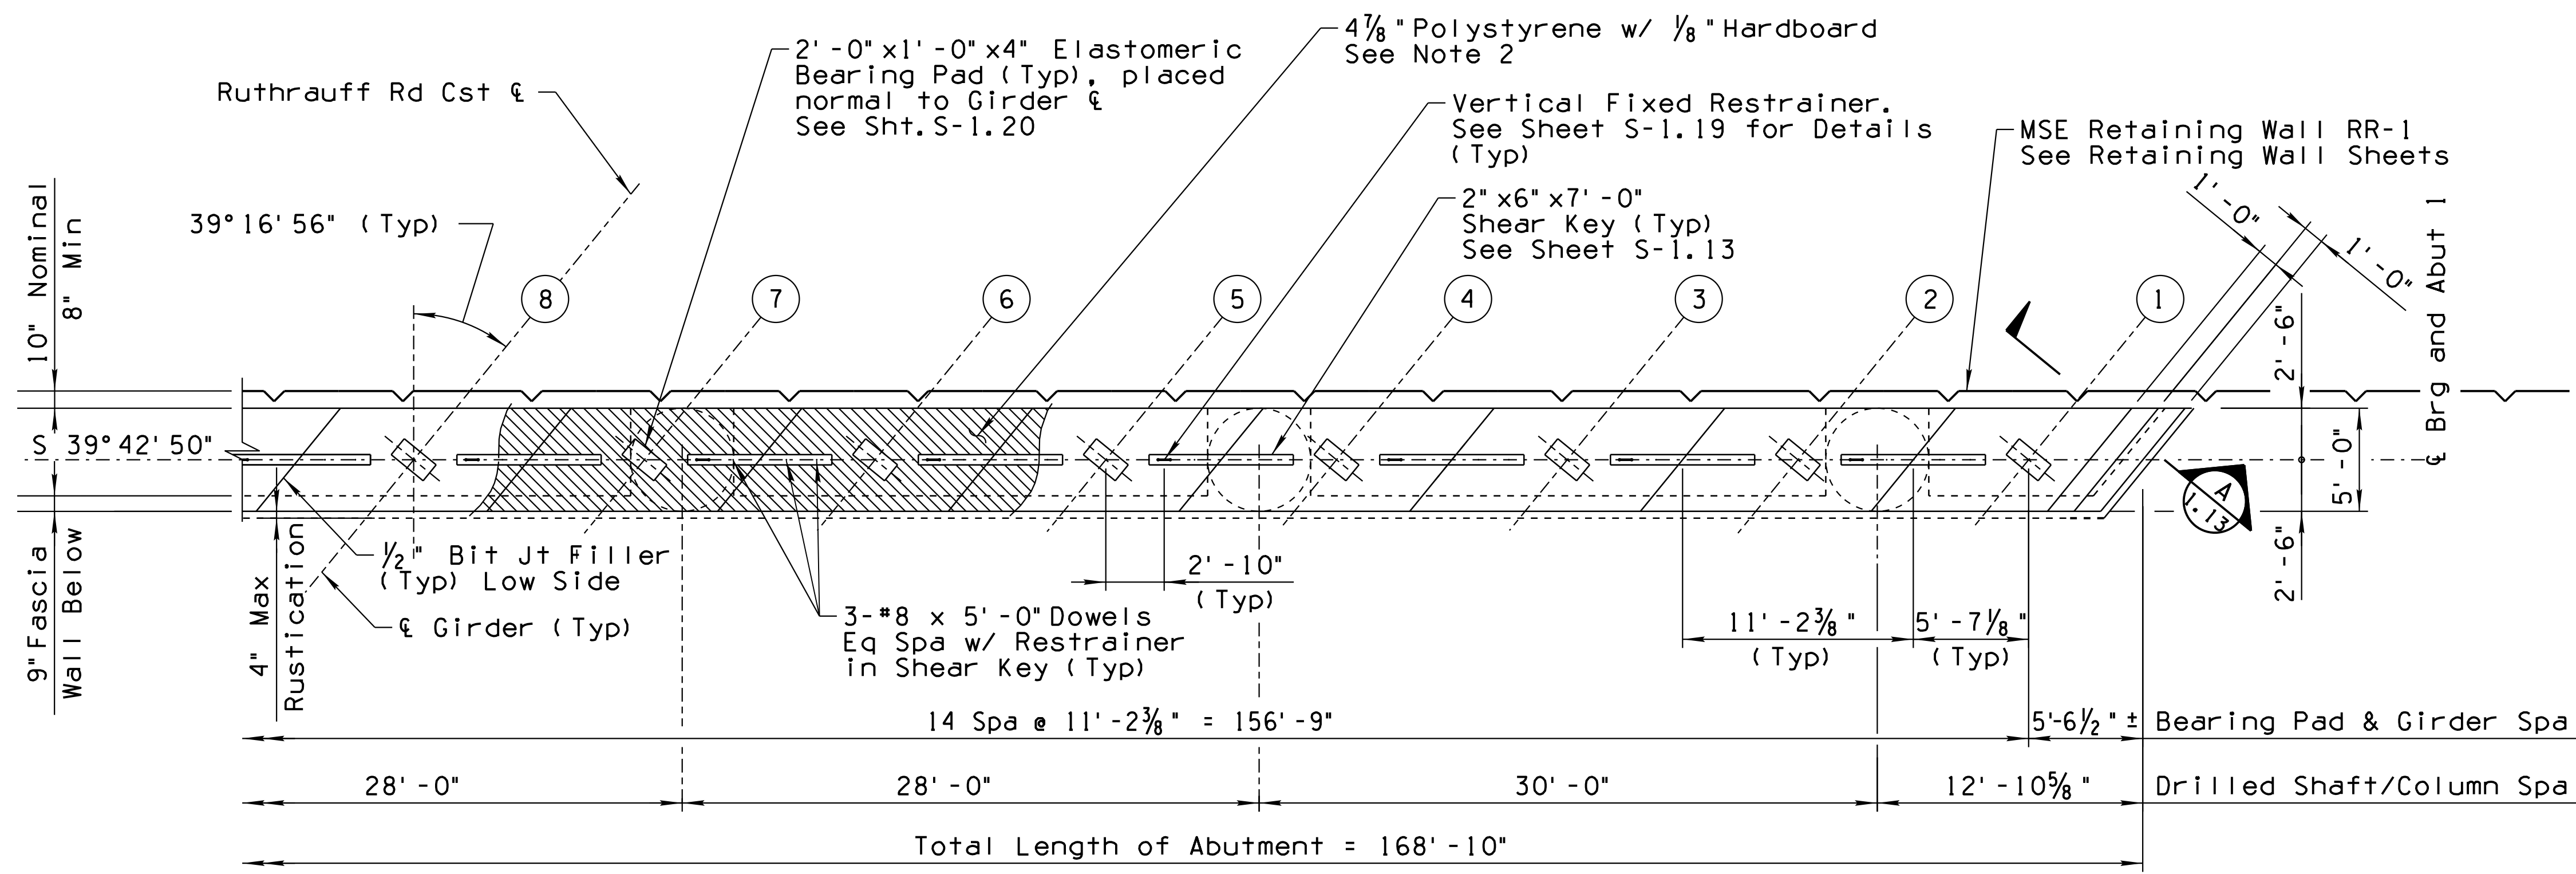

**PLAN**  
Looking Back Station  
Scale: 1/4" = 1'-0"

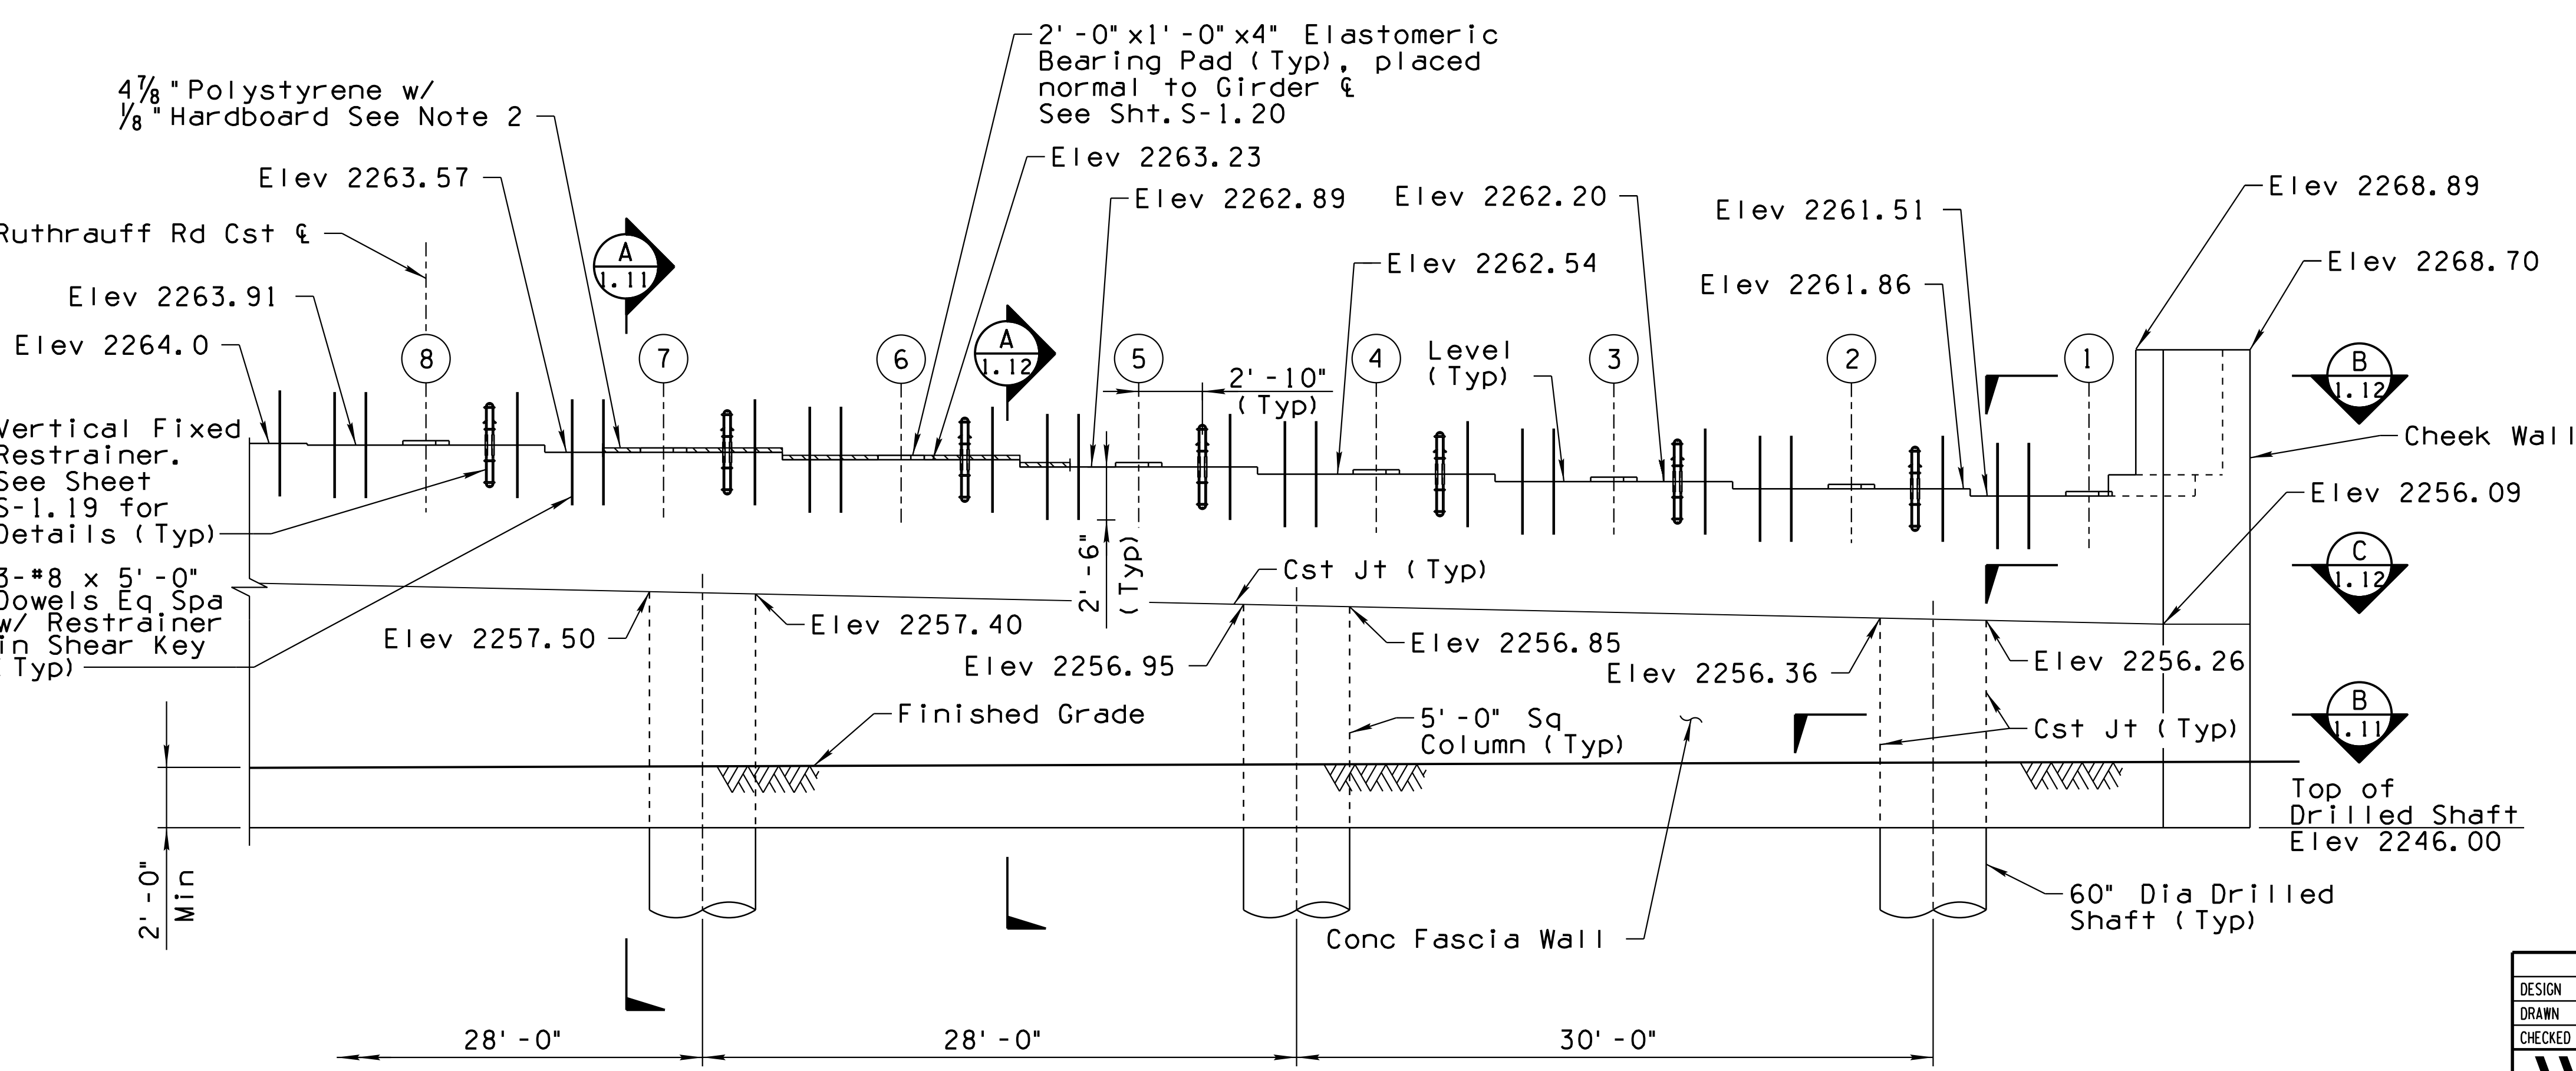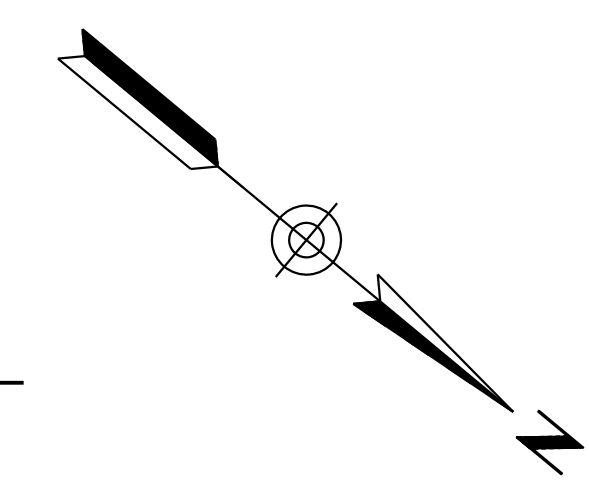


**ELEVATION**  
Looking Back Station  
Scale: 1/4" = 1'-0"

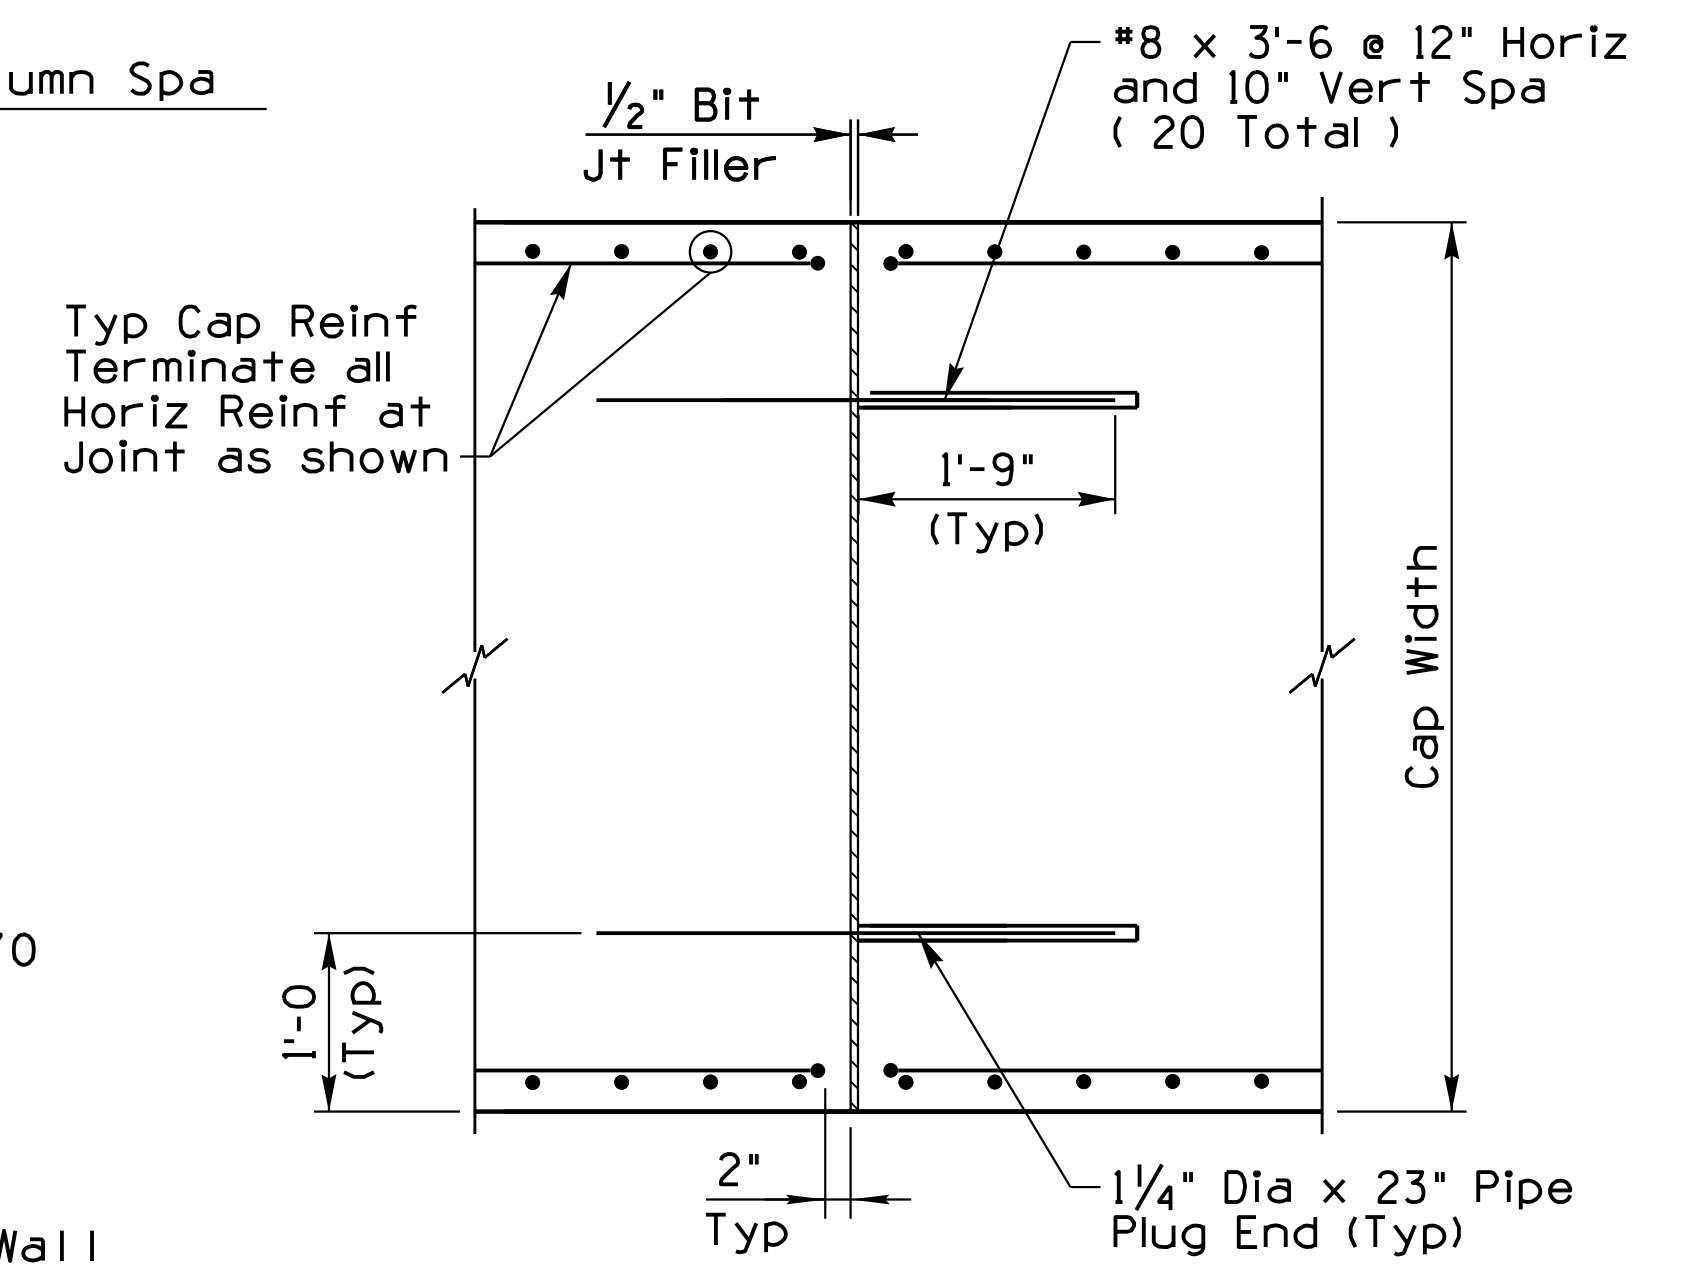

**EXPANSION JOINT DETAIL - ABUTMENT CAP**  
No Scale

- NOTES:**
1. Verify all bridge seats elevations prior to the erection of the girders.
  2. Polystyrene + Hardboard thickness accounts for the 1" Bevel R thickness at & Brg

DESIGN	NAME	DATE	ARIZONA DEPARTMENT OF TRANSPORTATION INFRASTRUCTURE DELIVERY AND OPERATIONS DIVISION BRIDGE GROUP
DESIGN	LES / HV	3-19	
DRAWN	DAY	3-19	
CHECKED	AGG / JAC	3-19	
			<b>STA 99+ RUTHRAUFF ROAD T.I. UNDERPASS ABUTMENT 1 PLAN &amp; ELEVATION 2</b>
I-10	252.00	20159	
ROUTE	MILEPOST	STRUCTURE NO.	LOCATION <b>RUTHRAUFF ROAD T.I.</b>
TRACS NO. H 8480 OIC			010-D(213)S
			DWG NO. S-1.08

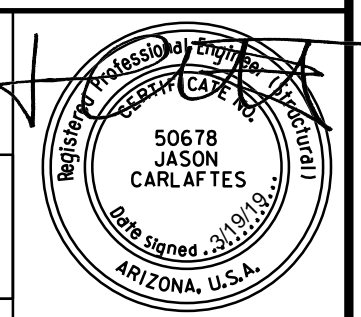


SURVEY NO. FINISHED PLANS DATE REVISIONS LOCATION DATE FINISHED PLANS SURVEY NO.




F.H.W.A. REGION	STATE	PROJECT NO.	SHEET NO.	TOTAL SHEETS	RECORD DRAWING
9	ARIZ.	010-D(213)S	622	849	

010 PM 252

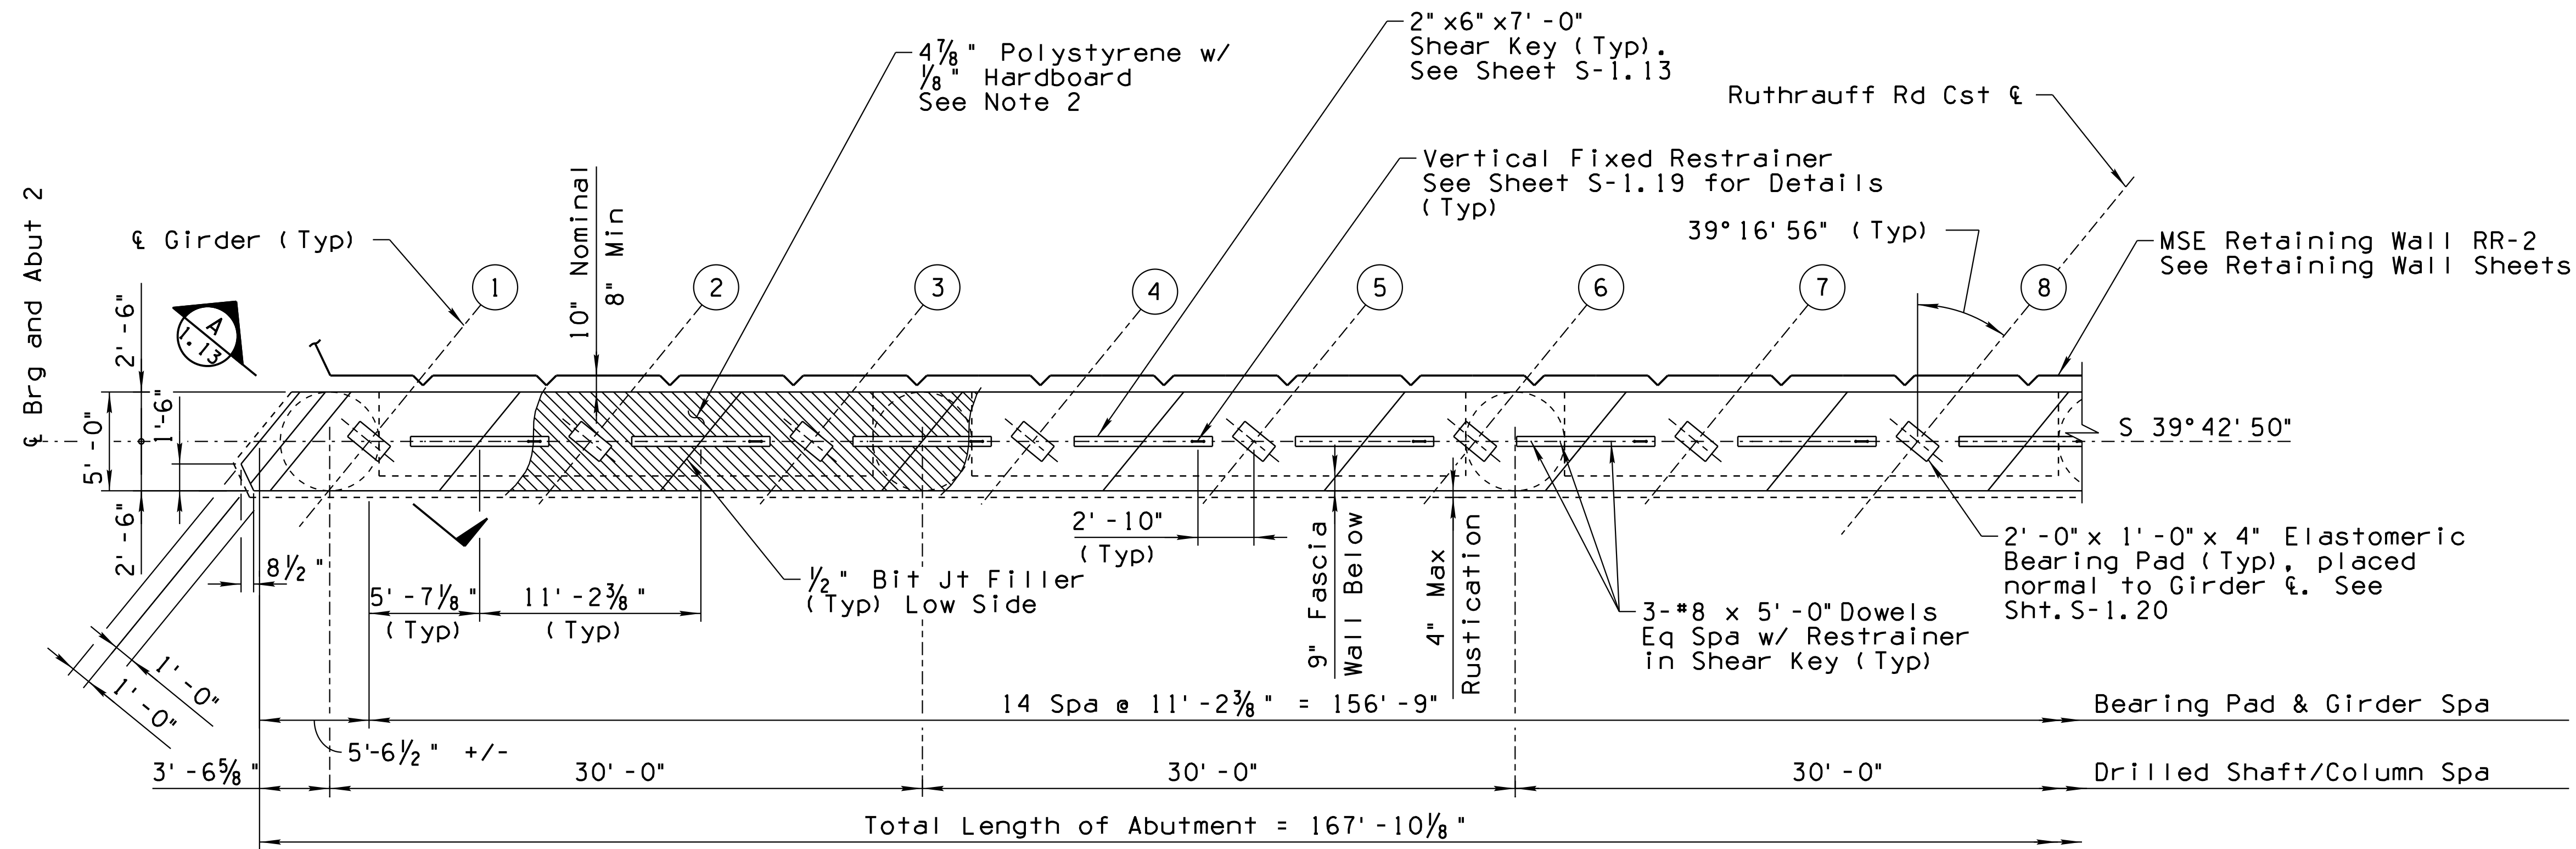

**PLAN**

Looking Ahead Station  
Scale: 1/4" = 1'-0"

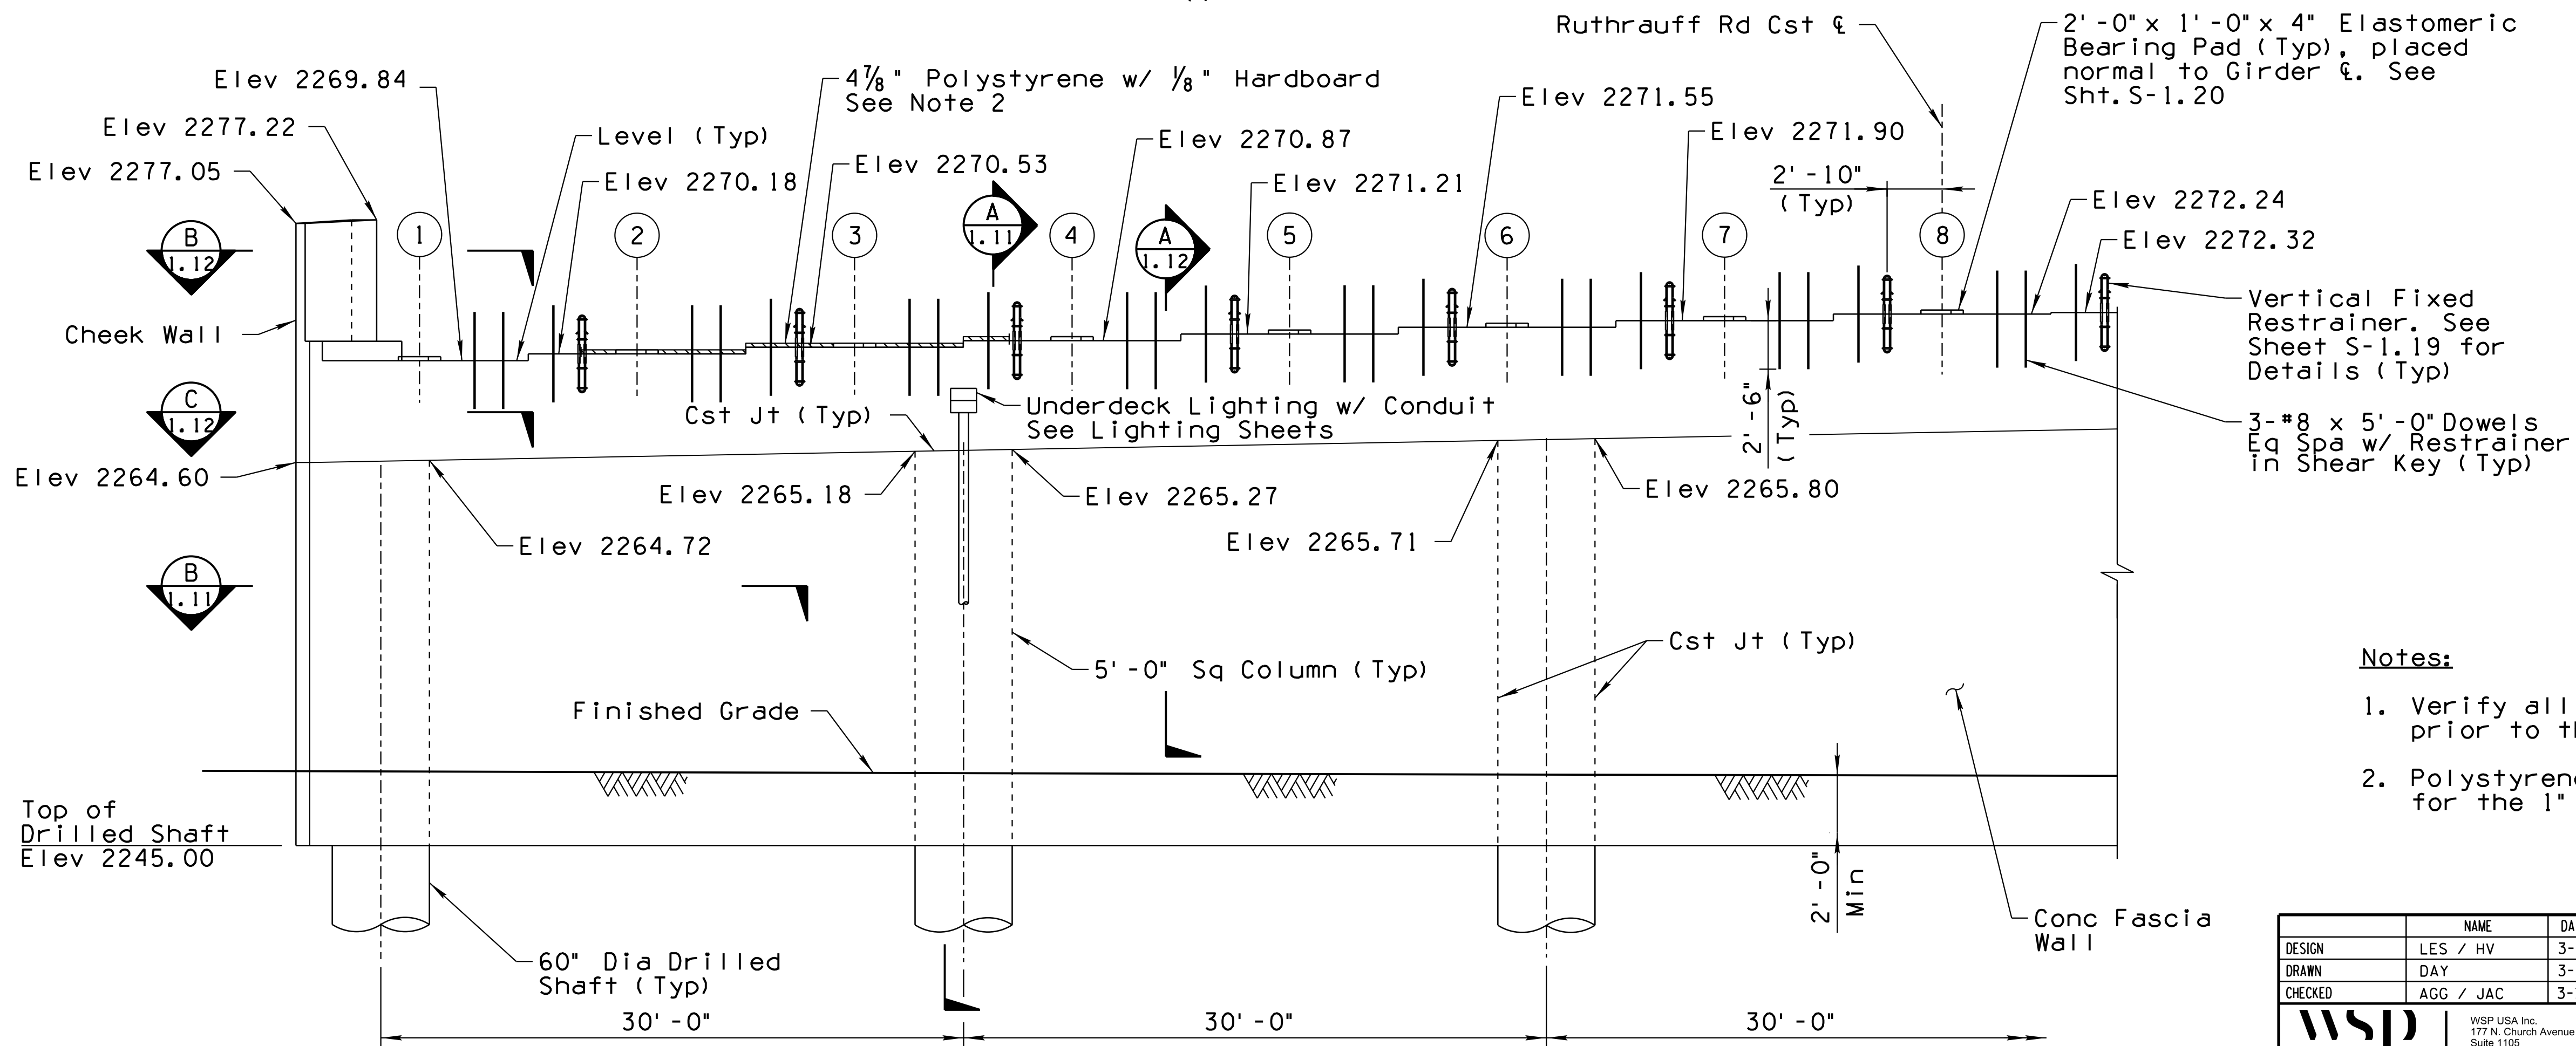


**ELEVATION**

Looking Ahead Station  
Scale: 1/4" = 1'-0"

**Notes:**



1. Verify all bridge seat elevations prior to the erection of the girders.
2. Polystyrene + Hardboard thickness accounts for the 1" Bevel thickness at Girder.

DESIGN	LES / HV	DATE	3-19	ARIZONA DEPARTMENT OF TRANSPORTATION INFRASTRUCTURE DELIVERY AND OPERATIONS DIVISION BRIDGE GROUP
DRAWN	DAY	DATE	3-19	
CHECKED	AGG / JAC	DATE	3-19	
				STA 99+ RUTHRAUFF ROAD T.I. UNDERPASS ABUTMENT 2 PLAN & ELEVATION 1
I-10	252.00	20159	LOCATION	
ROUTE	MILEPOST	STRUCTURE NO.	RUTHRAUFF ROAD T.I.	EXP. 3/31/2019
TRACS NO. H 8480 OIC			010-D(213)S	DWG NO. S-1.09

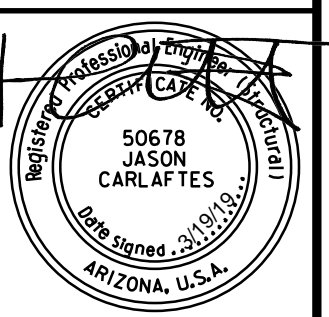


F.H.W.A. REGION	STATE	PROJECT NO.	SHEET NO.	TOTAL SHEETS	RECORD DRAWING
9	ARIZ.	010-D(213)S	623	849	

010 PM 252

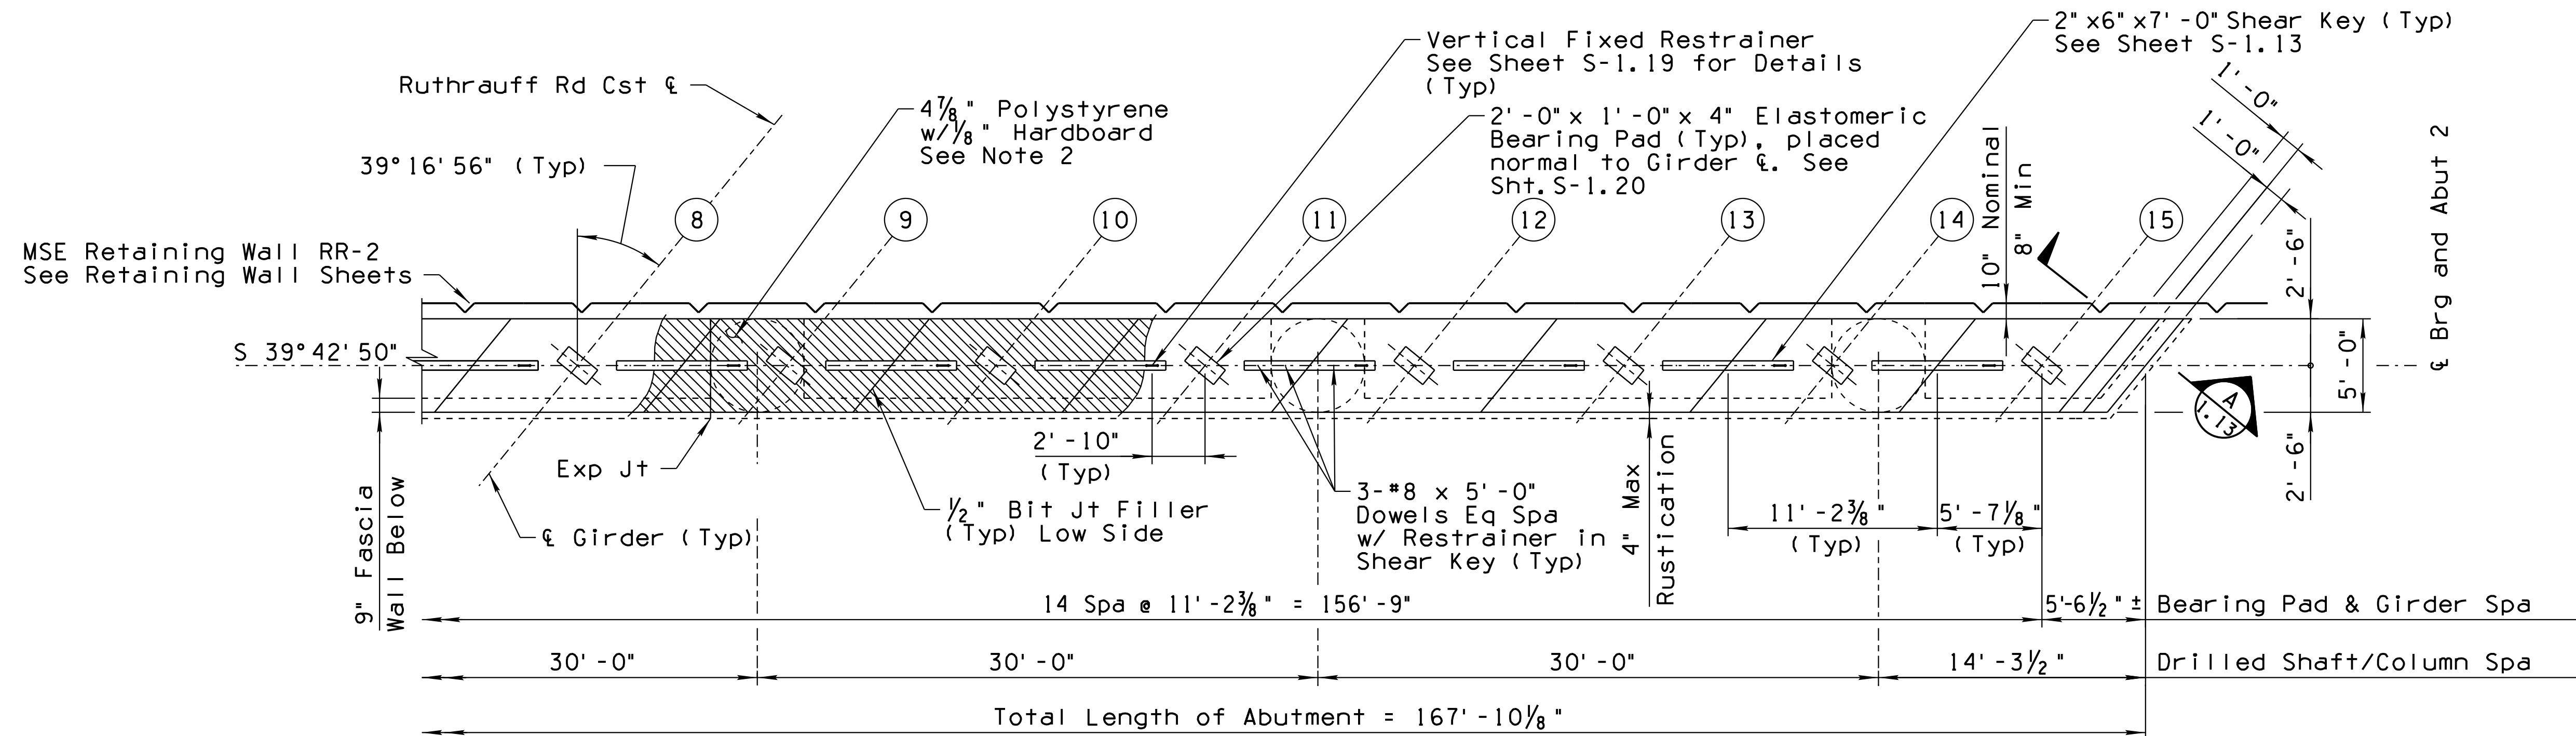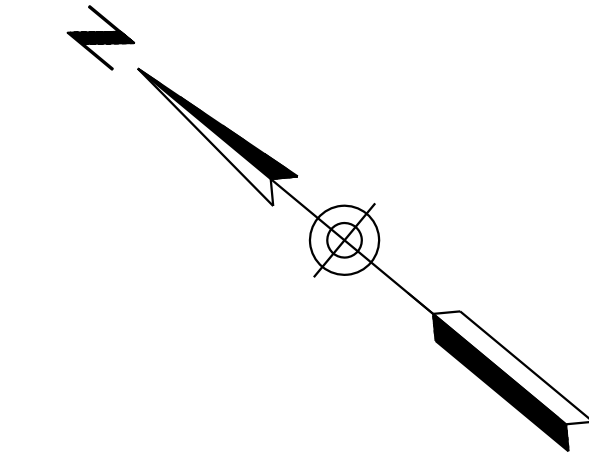

**PLAN**  
Looking Ahead Station  
Scale: 1/4" = 1' - 0"

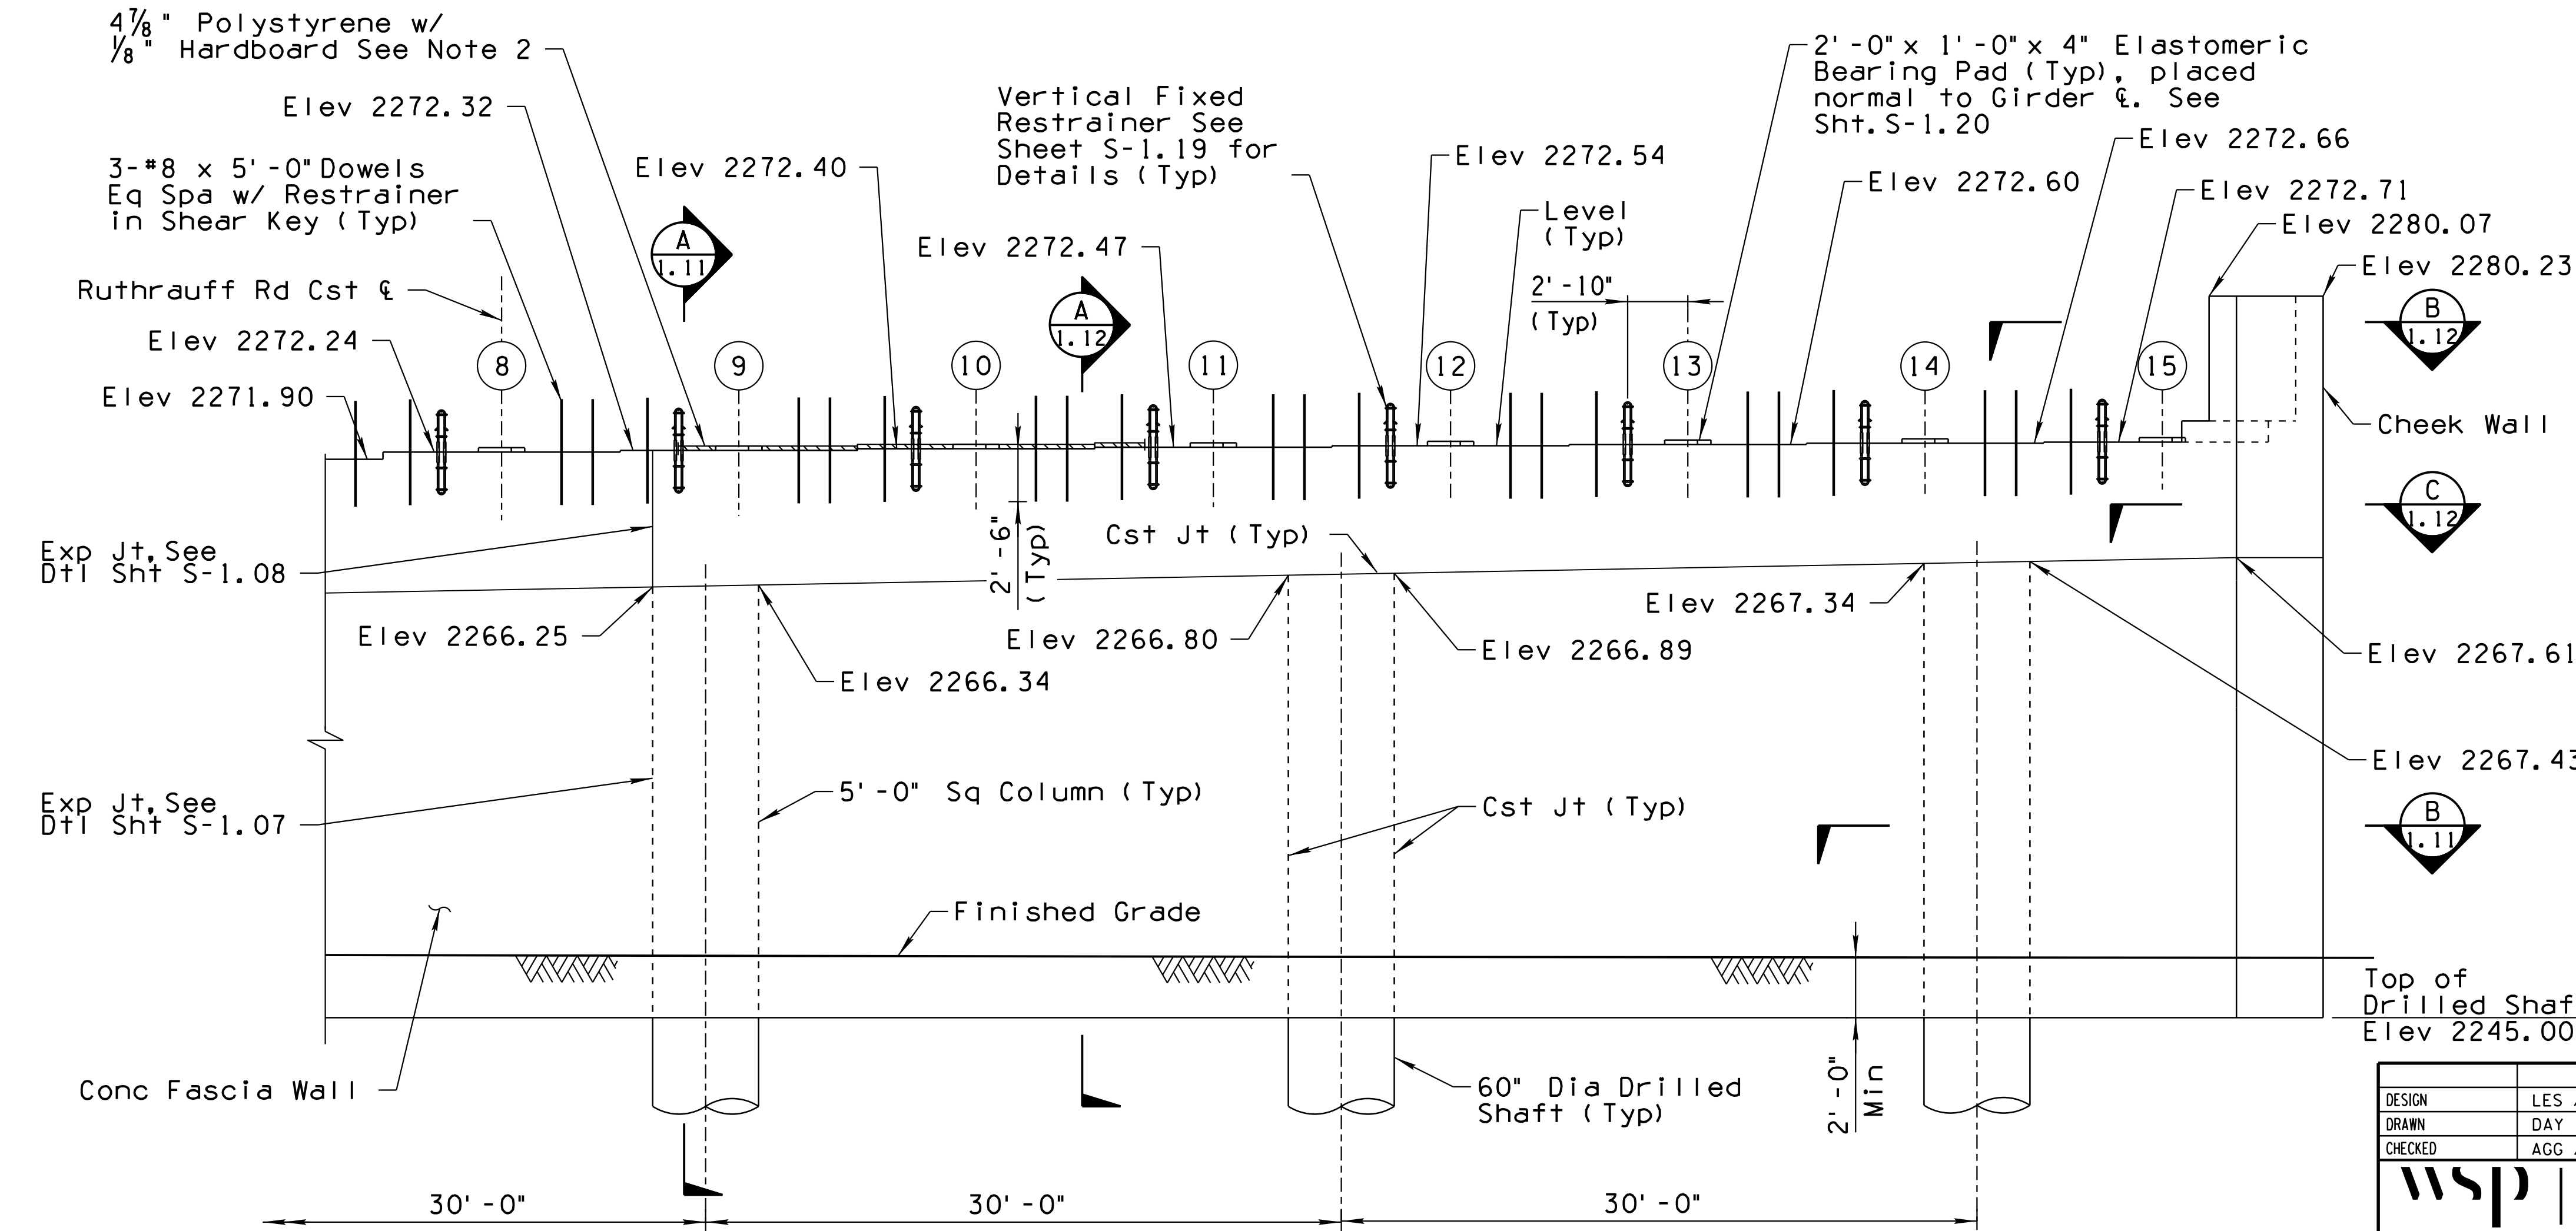

**ELEVATION**  
Looking Ahead Station  
Scale: 1/4" = 1' - 0"

**Notes:**

1. Verify all Bridge seats elevations prior to the erection of the girders.
2. Polystyrene + Hardboard thickness accounts for the 1" Bevel & thickness at & Brg

DESIGN	NAME	DATE
LES / HV		3-19
DRAWN	NAME	DATE
DAY		3-19
CHECKED	NAME	DATE
AGG / JAC		3-19

ARIZONA DEPARTMENT OF TRANSPORTATION  
INFRASTRUCTURE DELIVERY AND OPERATIONS DIVISION  
**BRIDGE GROUP**


**STA 99+  
RUTHRAUFF ROAD T.I. UNDERPASS  
ABUTMENT 2 PLAN & ELEVATION 2**

ROUTE	MILEPOST	STRUCTURE NO.
I-10	252.00	20159

LOCATION  
**RUTHRAUFF ROAD T.I.**

TRACS NO. H 8480 OIC

010-D(213)S

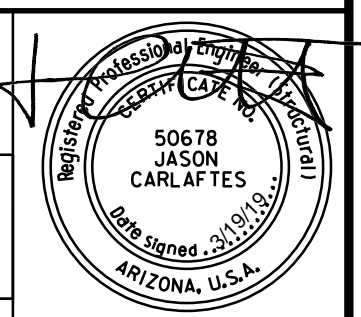

DWG NO. S-1.10


OF







F.H.W.A. REGION	STATE	PROJECT NO.	SHEET NO.	TOTAL SHEETS	RECORD DRAWING
9	ARIZ.	010-D(213)S	625	849	

010 PM 252

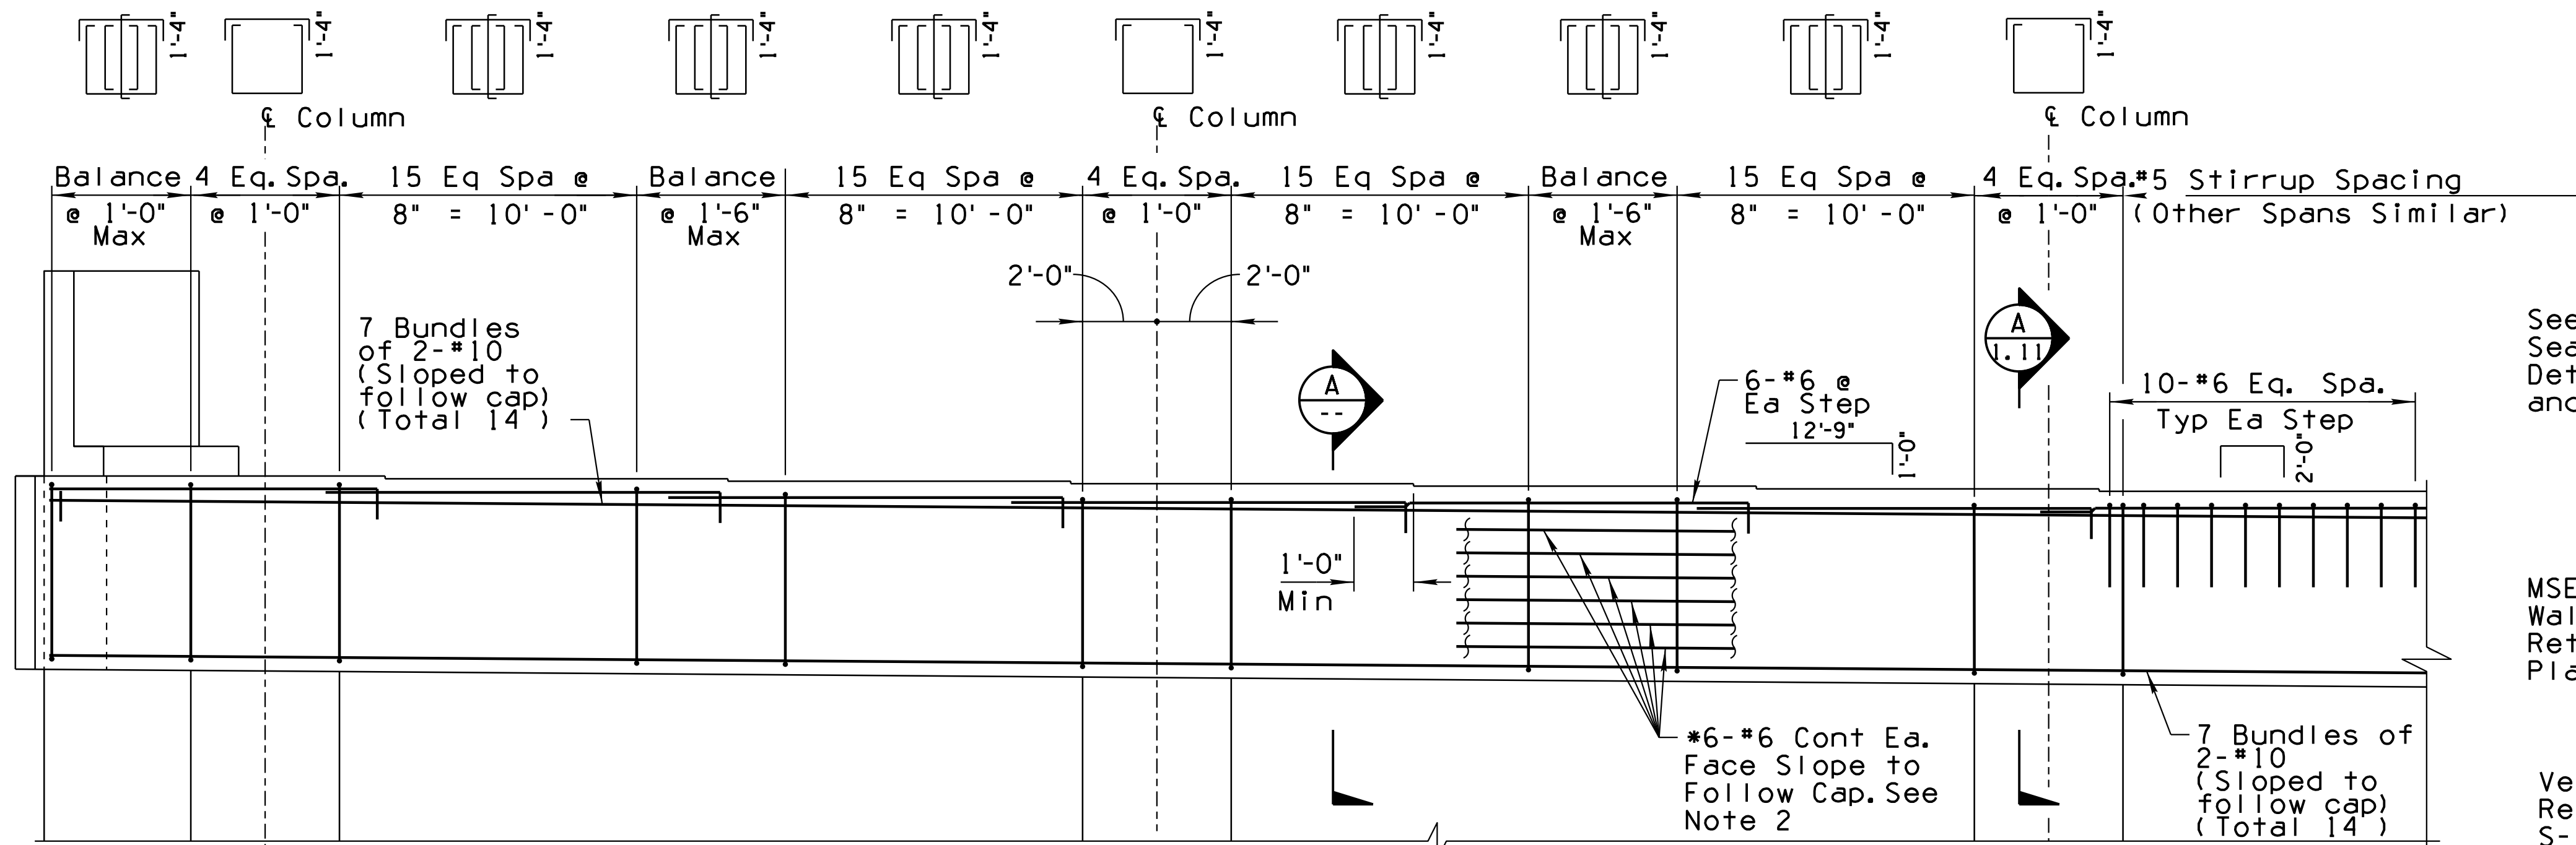


TYPICAL ABUTMENT CAP REINFORCING

Looking Ahead Station  
 Abutment 2 Shown, Abutment 1 Similar  
 Scale: 1/4" = 1'-0"

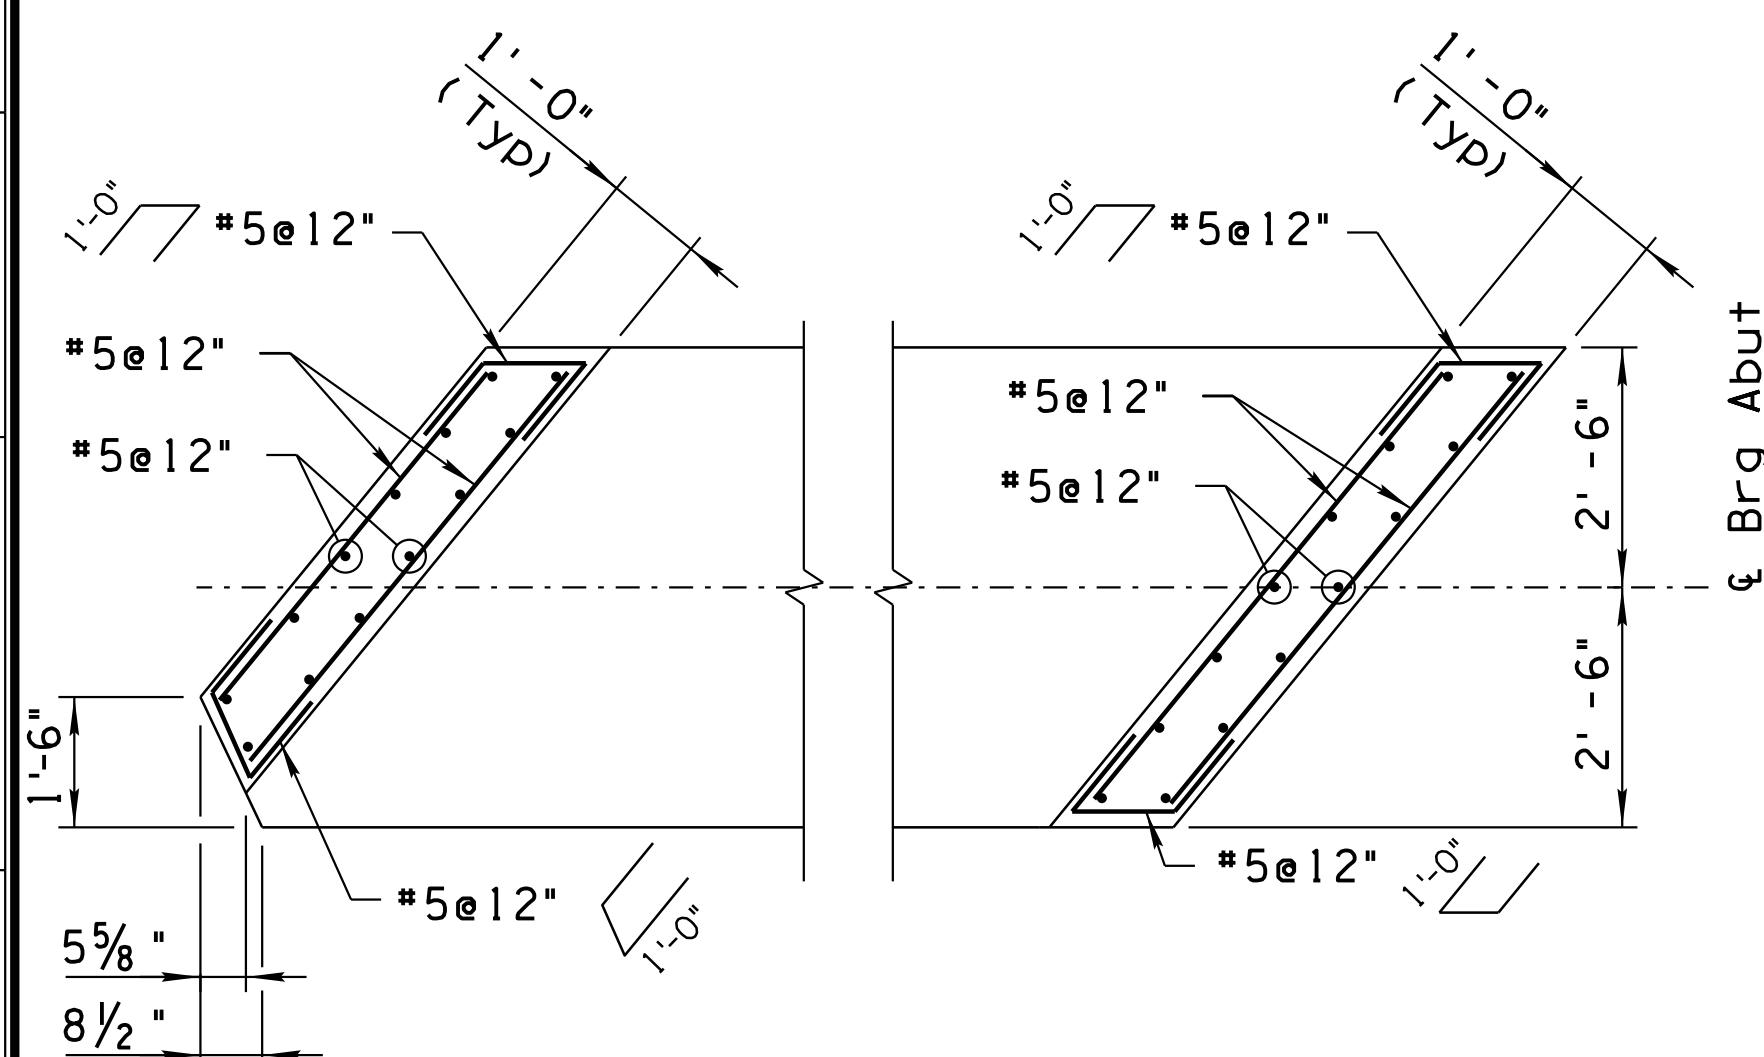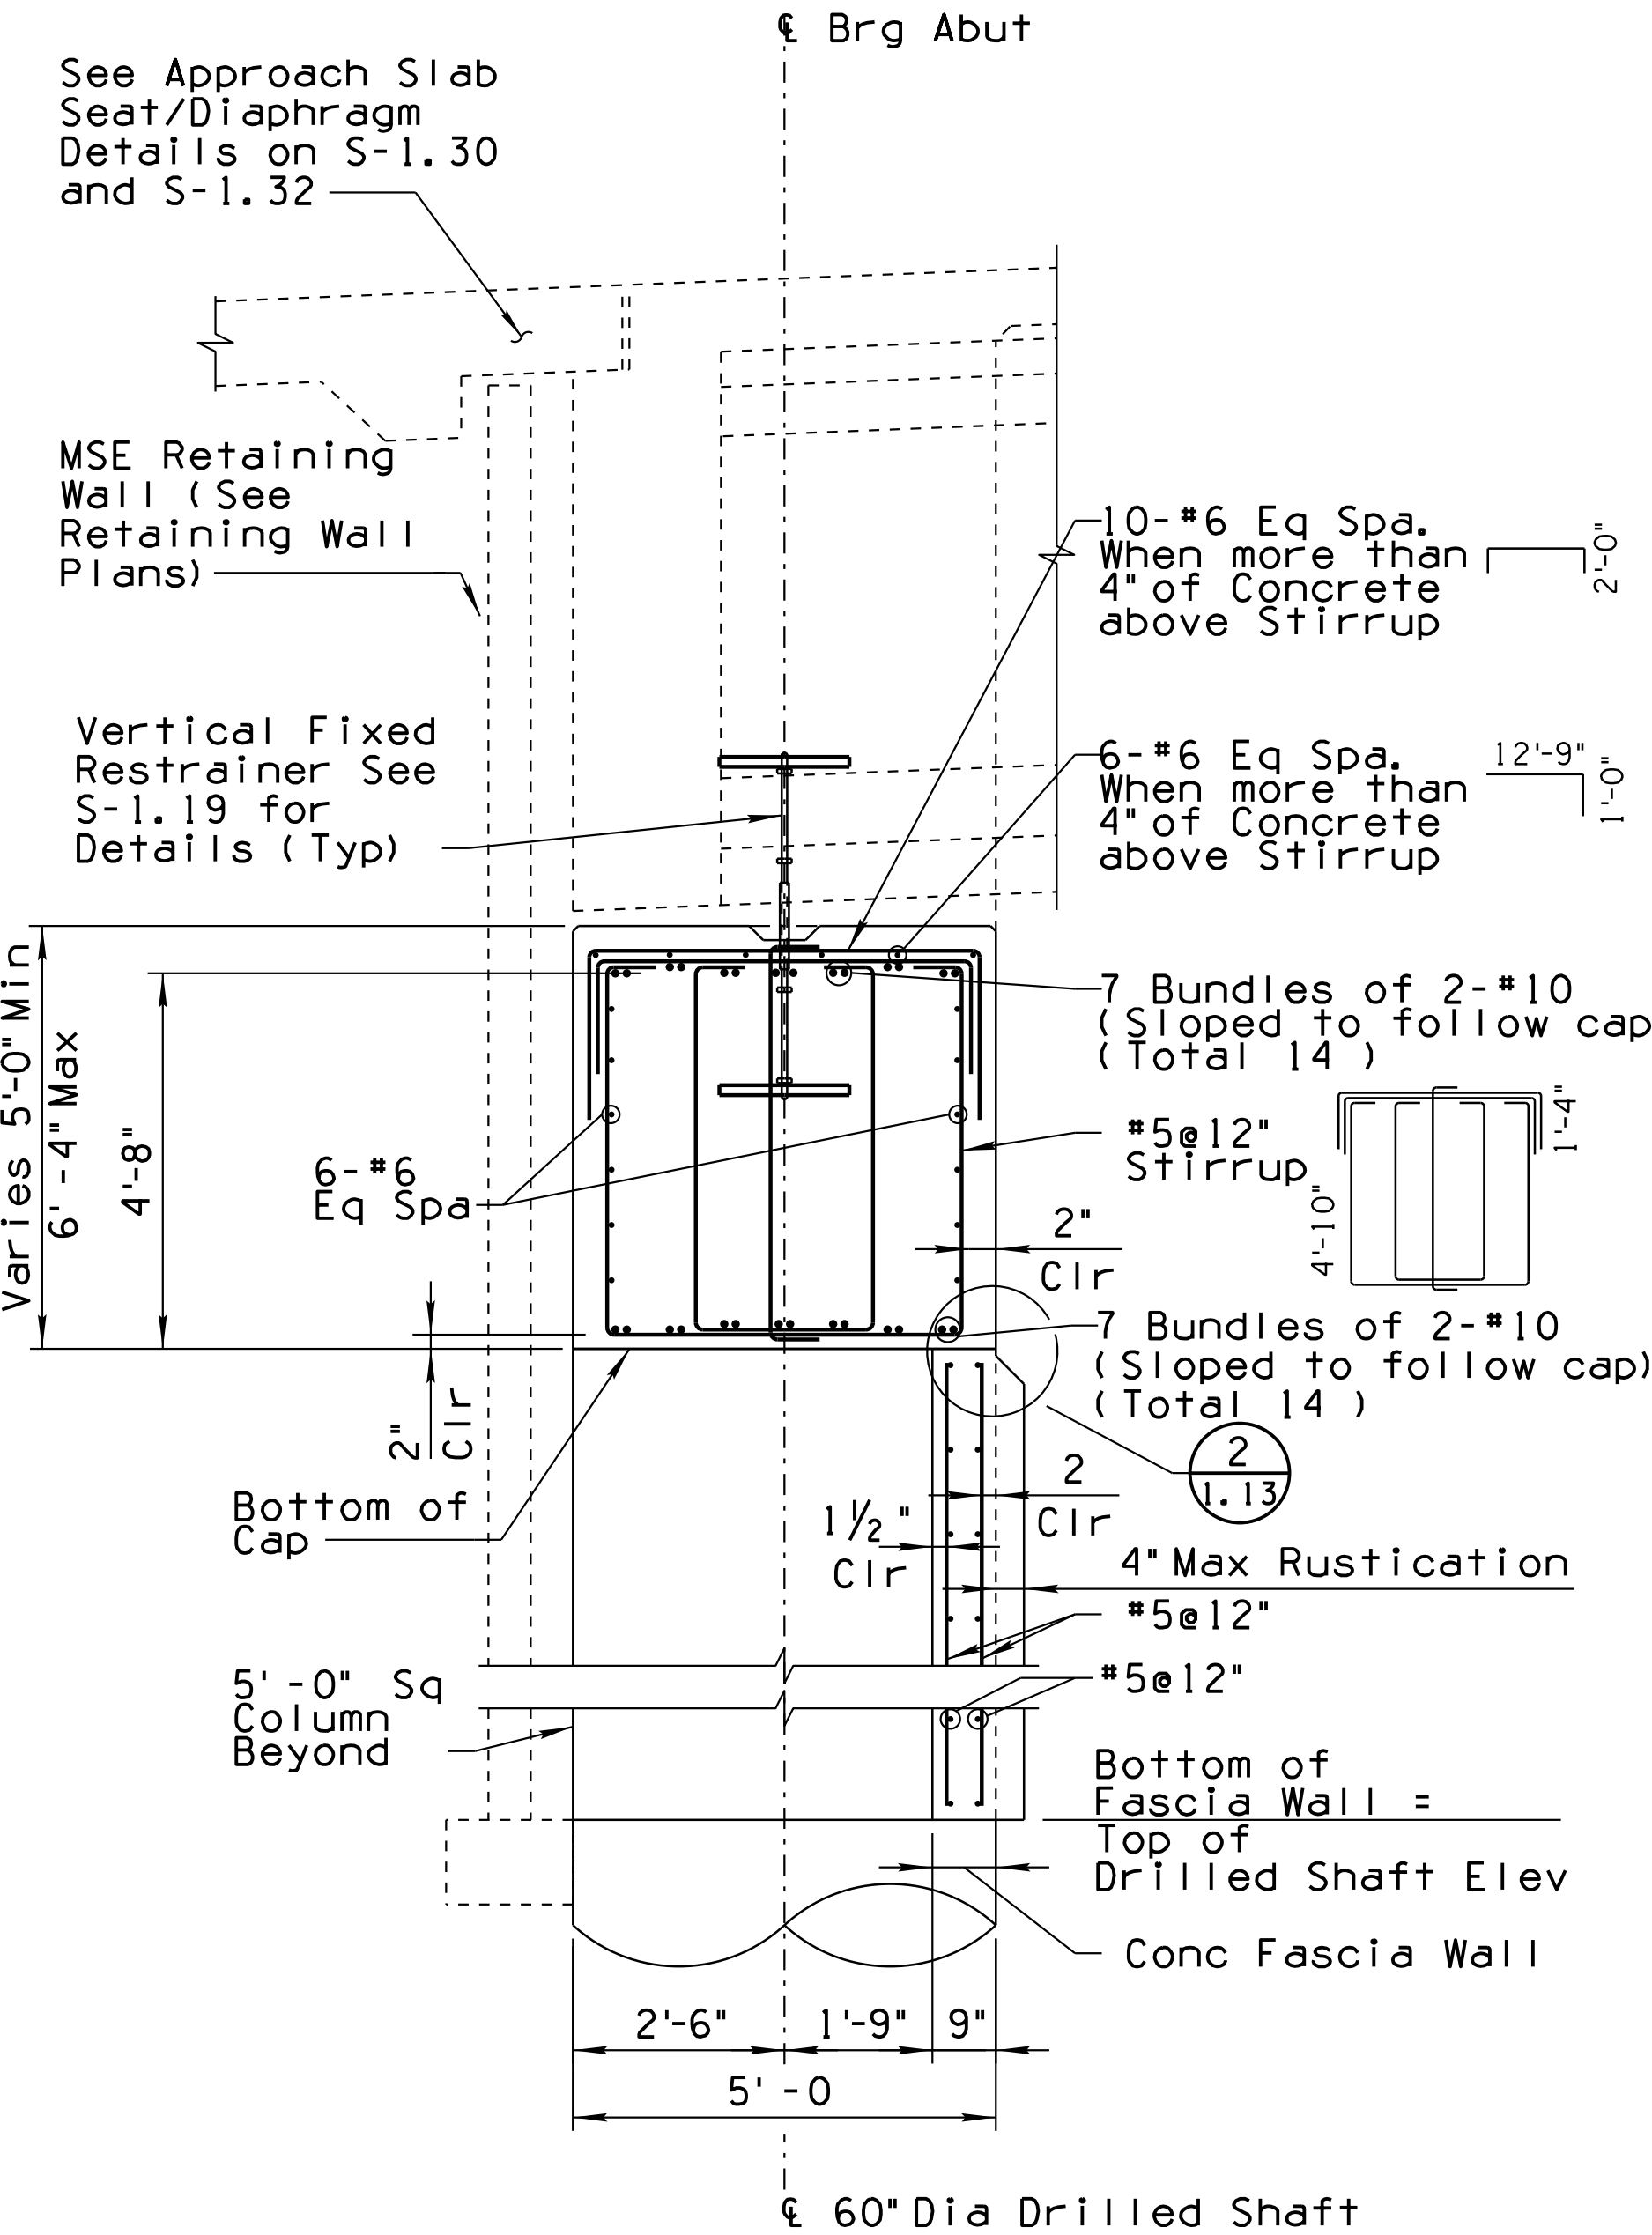

SECTION - CHEEK WALL (B, B, B, B)

Scale: 1/2" = 1'-0"  
 Abutment 2 shown, Abutment 1 Similar

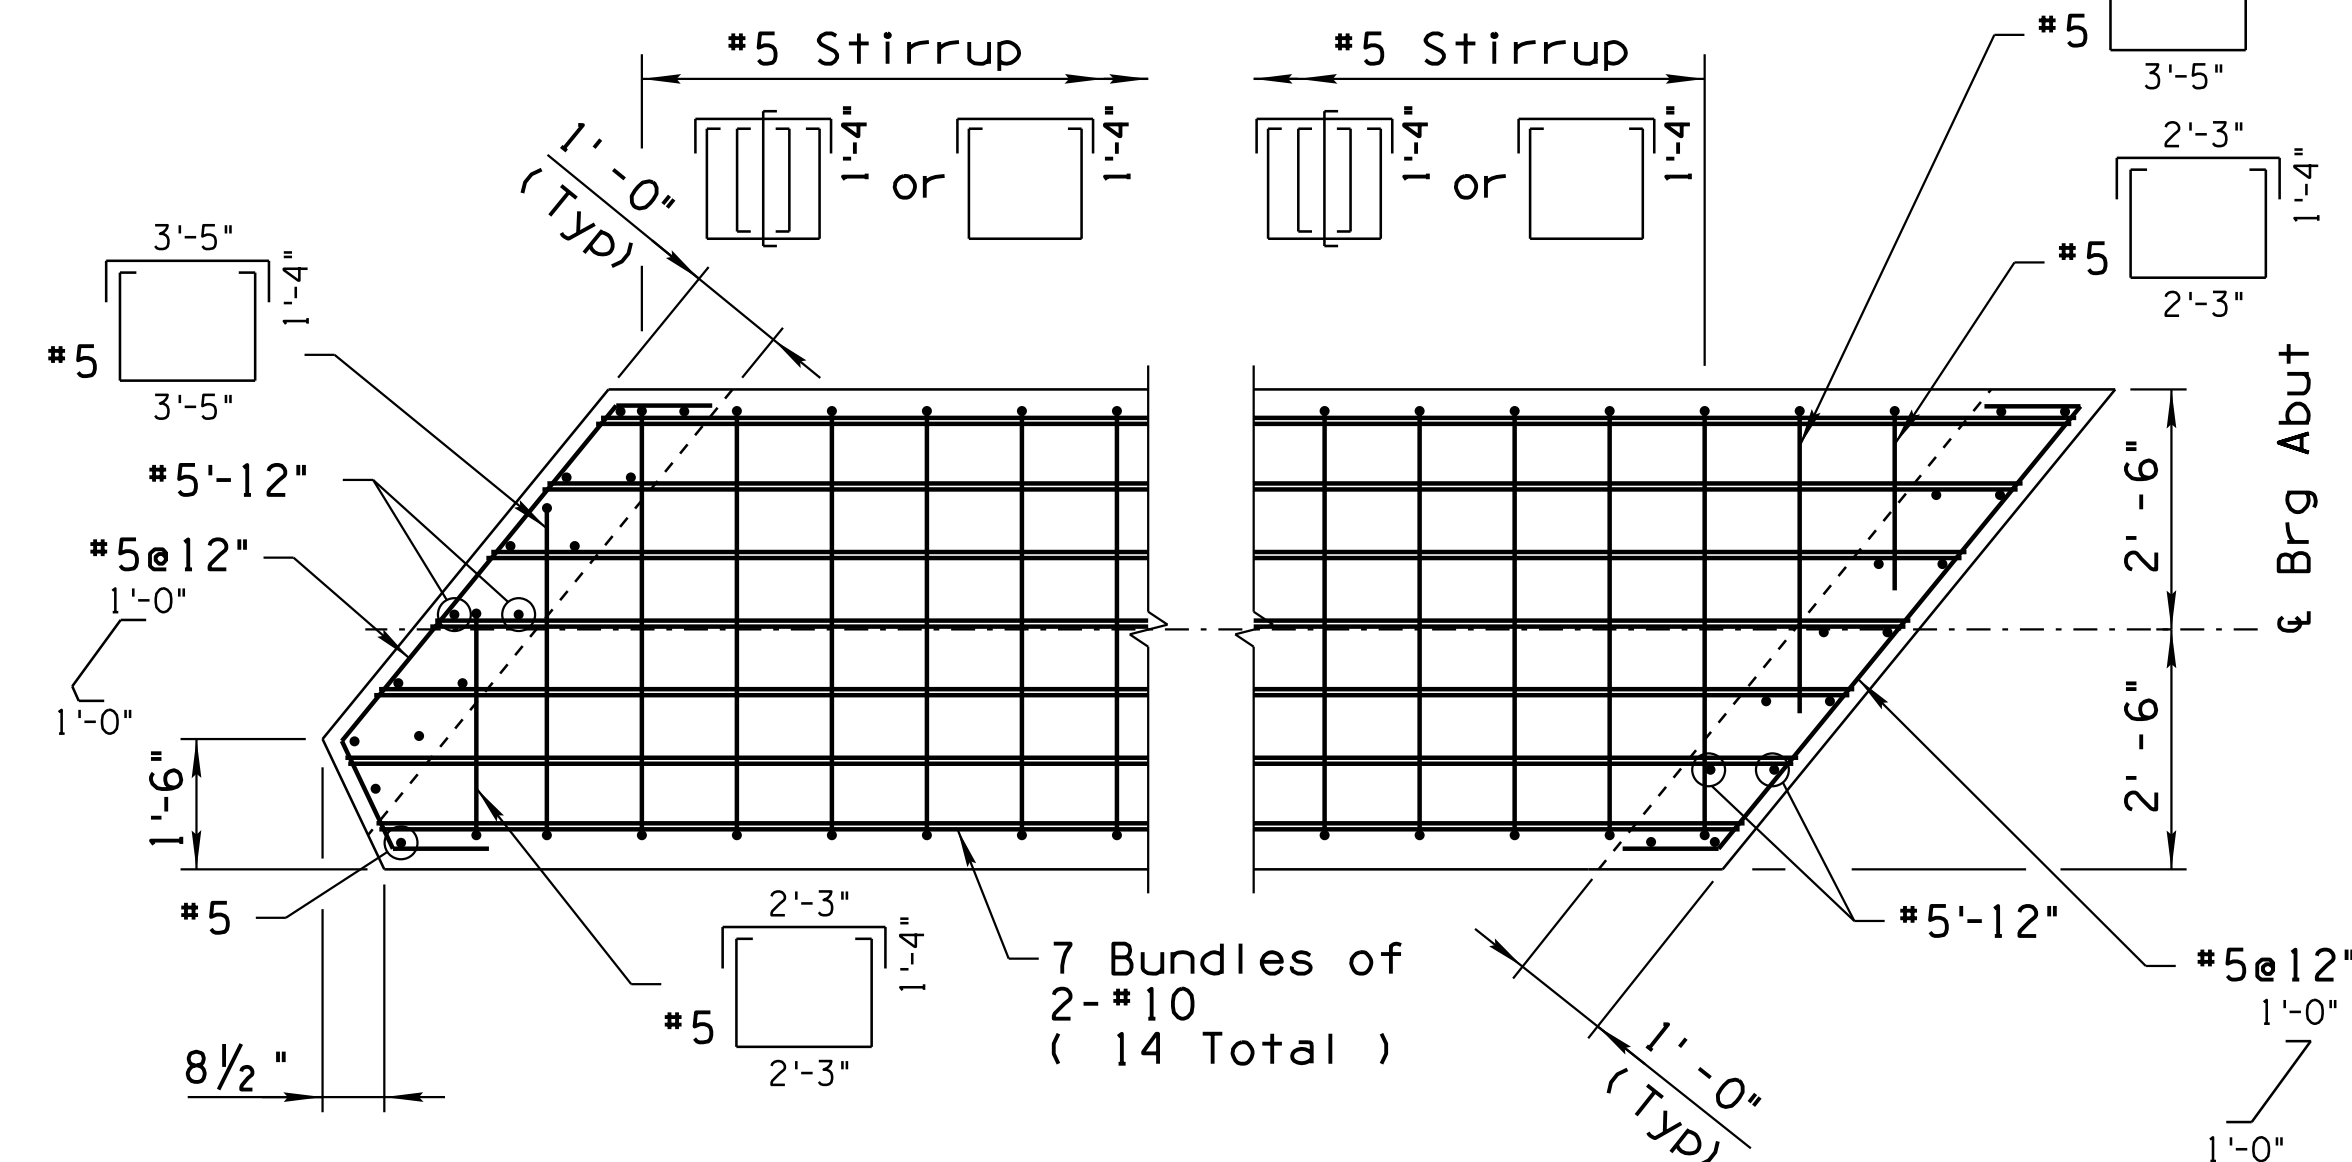

SECTION - CAP (C, C, C, C)

Scale: 1/2" = 1'-0"  
 Abutment 2 shown, Abutment 1 Similar

SECTION - ABUTMENT AT WALL (A, A, A, A)

Scale: 1/2" = 1'-0"


Notes:

- See Dwg No. S-1.13 for Abutment Cap Reinforcing lap splice details.
- #6 bars shall be spliced 2'-3 min. as required. Adjacent bars shall not be spliced at the same location and shall be staggered.

DESIGN	LES / HV	DATE	3-19	ARIZONA DEPARTMENT OF TRANSPORTATION INFRASTRUCTURE DELIVERY AND OPERATIONS DIVISION BRIDGE GROUP STA 99+ RUTHRAUFF ROAD T.I. UNDERPASS ABUTMENT DETAILS 2	
DRAWN	DAY	DATE	3-19		
CHECKED	AGG / JAC	DATE	3-19		
ROUTE	252.00	STRUCTURE NO.	20159	LOCATION	RUTHRAUFF ROAD T.I.
TRACS NO. H 8480 OIC				010-D(213)S	


F.H.W.A. REGION	STATE	PROJECT NO.	SHEET NO.	TOTAL SHEETS	RECORD DRAWING
9	ARIZ.	010-D(213)S	626	849	

010 PM 252

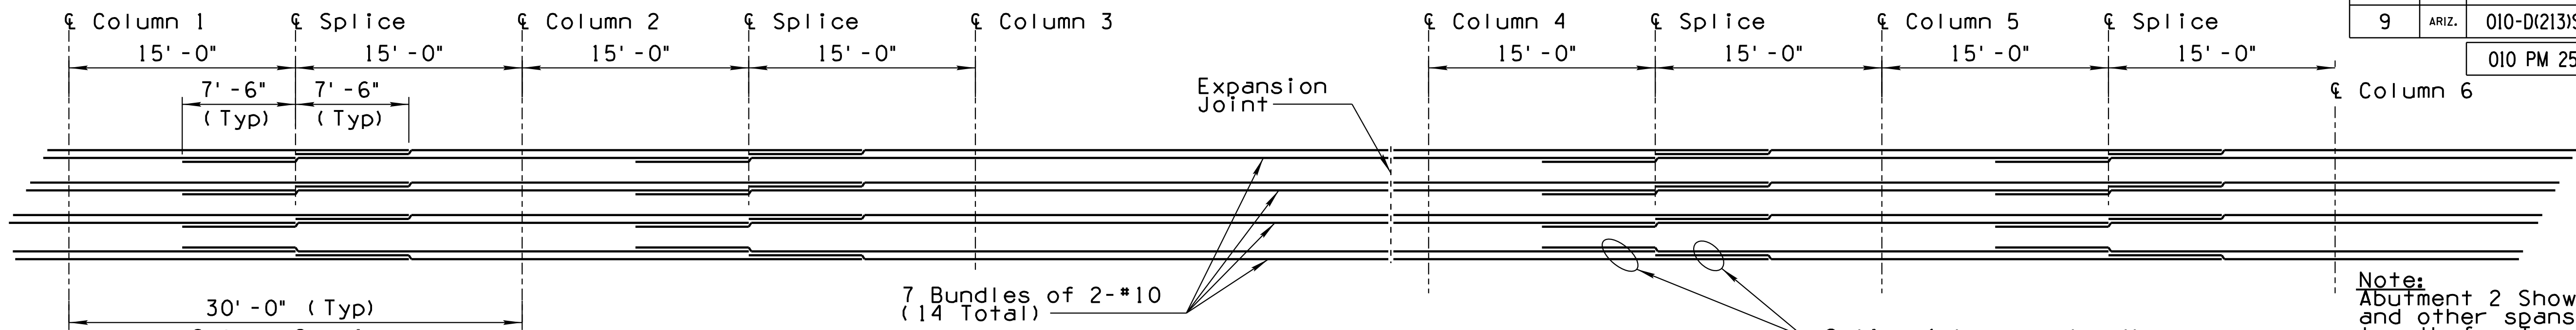


LAP SPlice DETAIL TOP OF ABUTMENT CAP (SCHEMATIC)  
No Scale

Note: Abutment 2 Shown. Abutment 1 and other spans similar. Max bar length for Top of Abutment Cap Reinforcing is 49'-10". Not all bars are shown

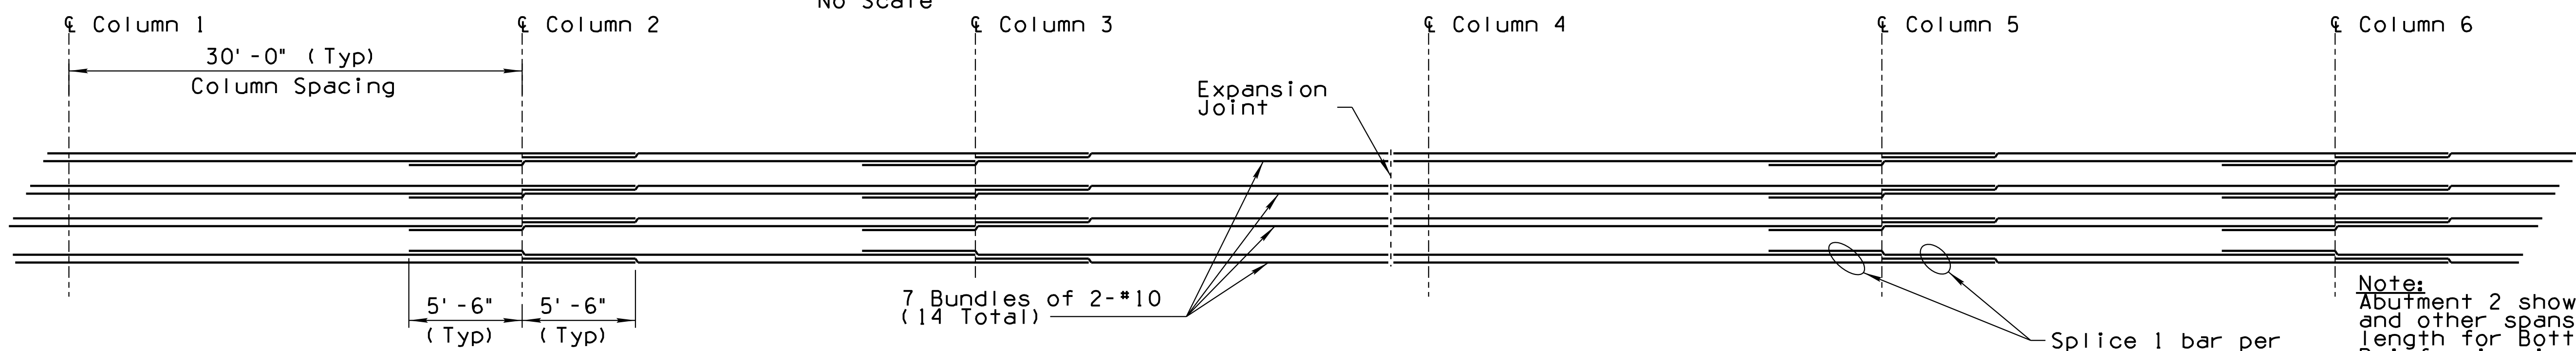


LAP SPlice DETAIL BOTTOM OF ABUTMENT CAP (SCHEMATIC)  
No Scale


Note: Abutment 2 shown. Abutment 1 and other spans similar. Max bar length for Bottom of Abutment Cap Reinforcing is 37'-10". Not all bars are shown

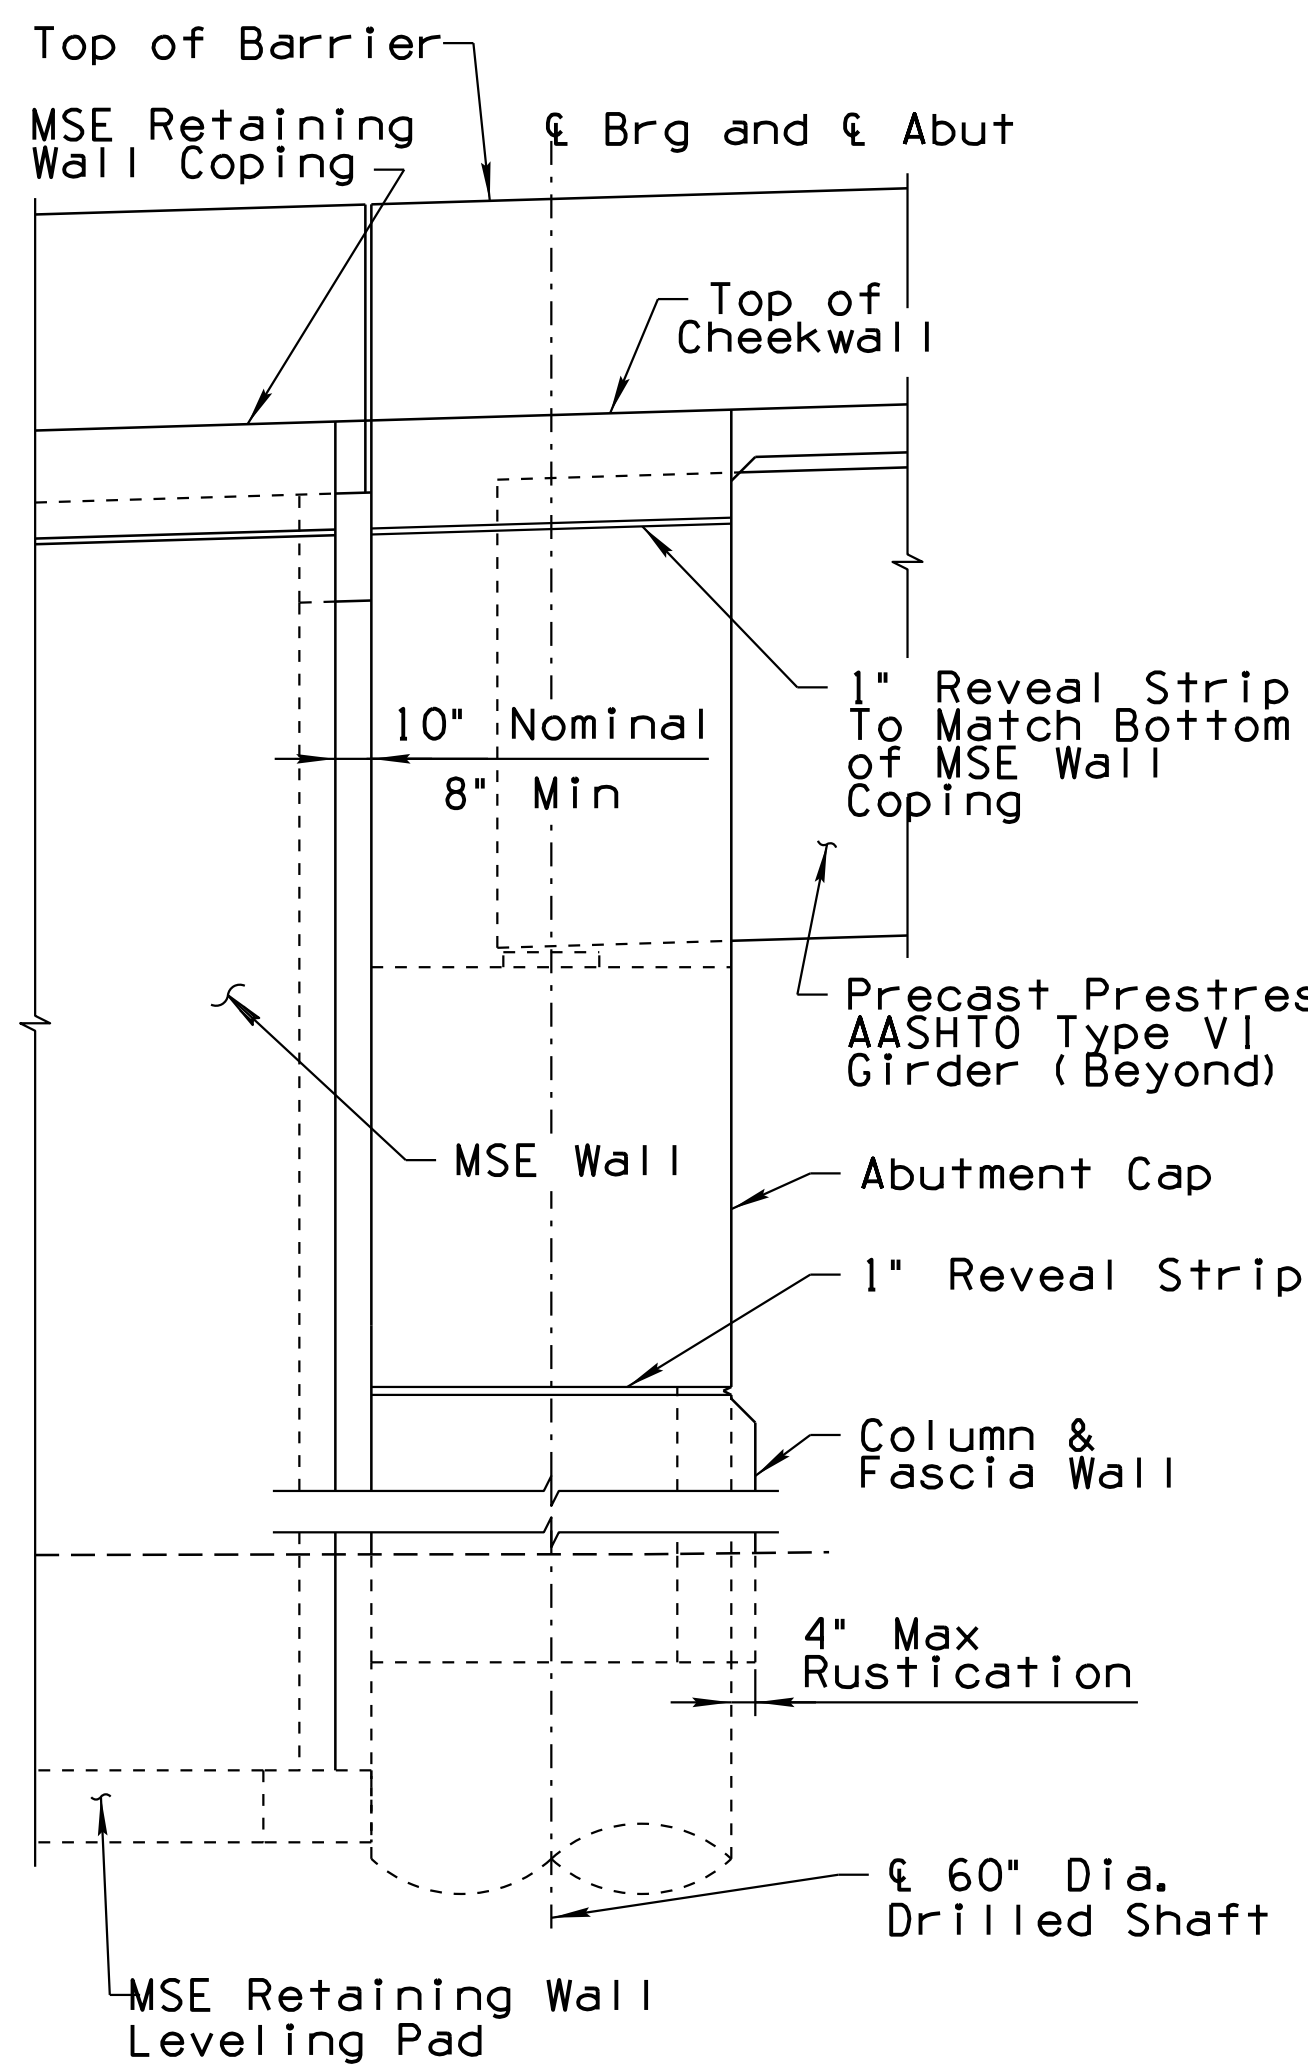


DETAIL - AESTHETICS  
No Scale

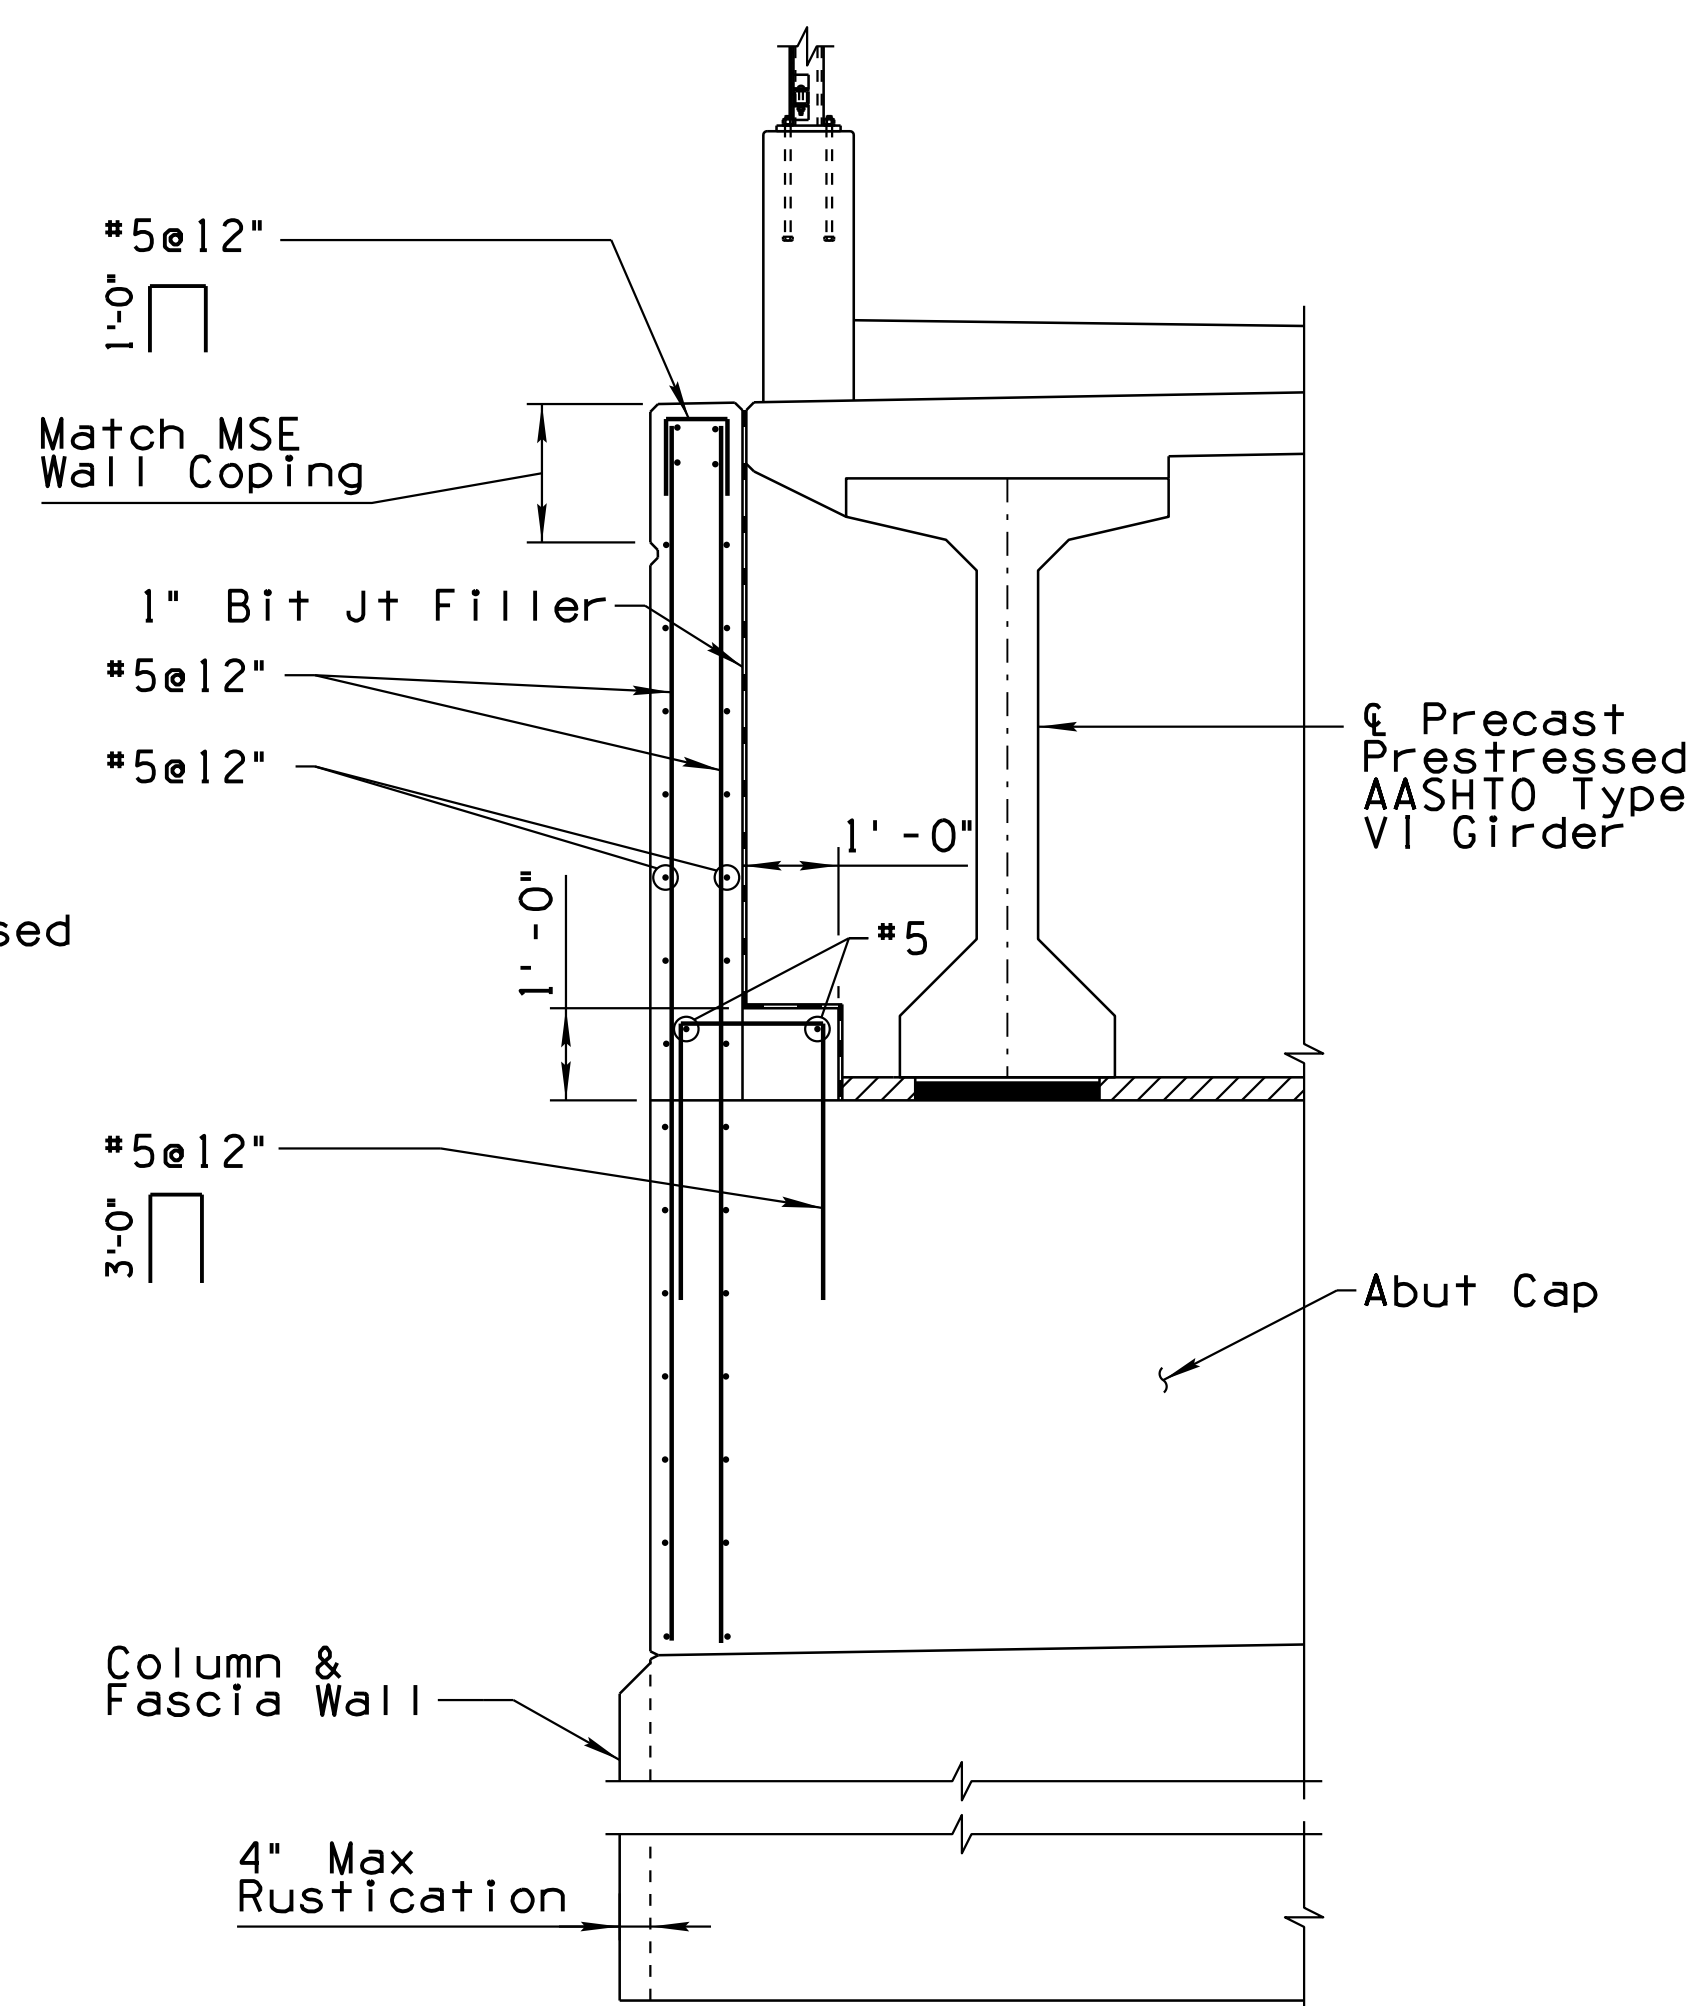

SECTION  
Scale: 1/2" = 1'-0"

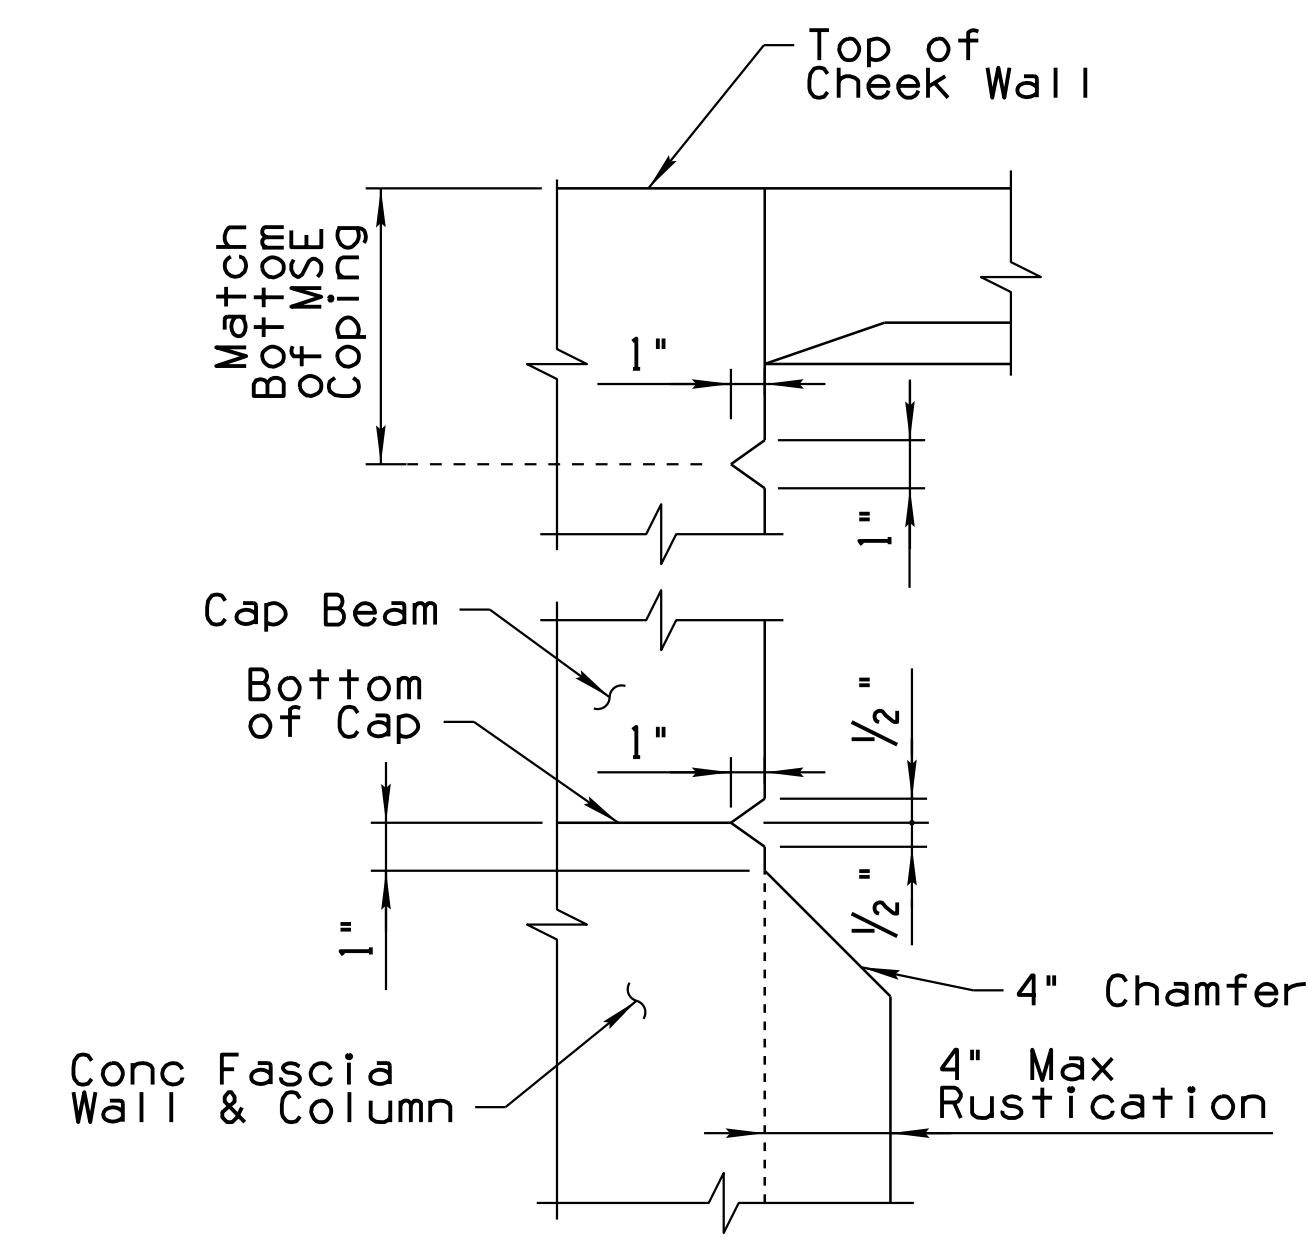


DETAIL - REVEAL  
No Scale

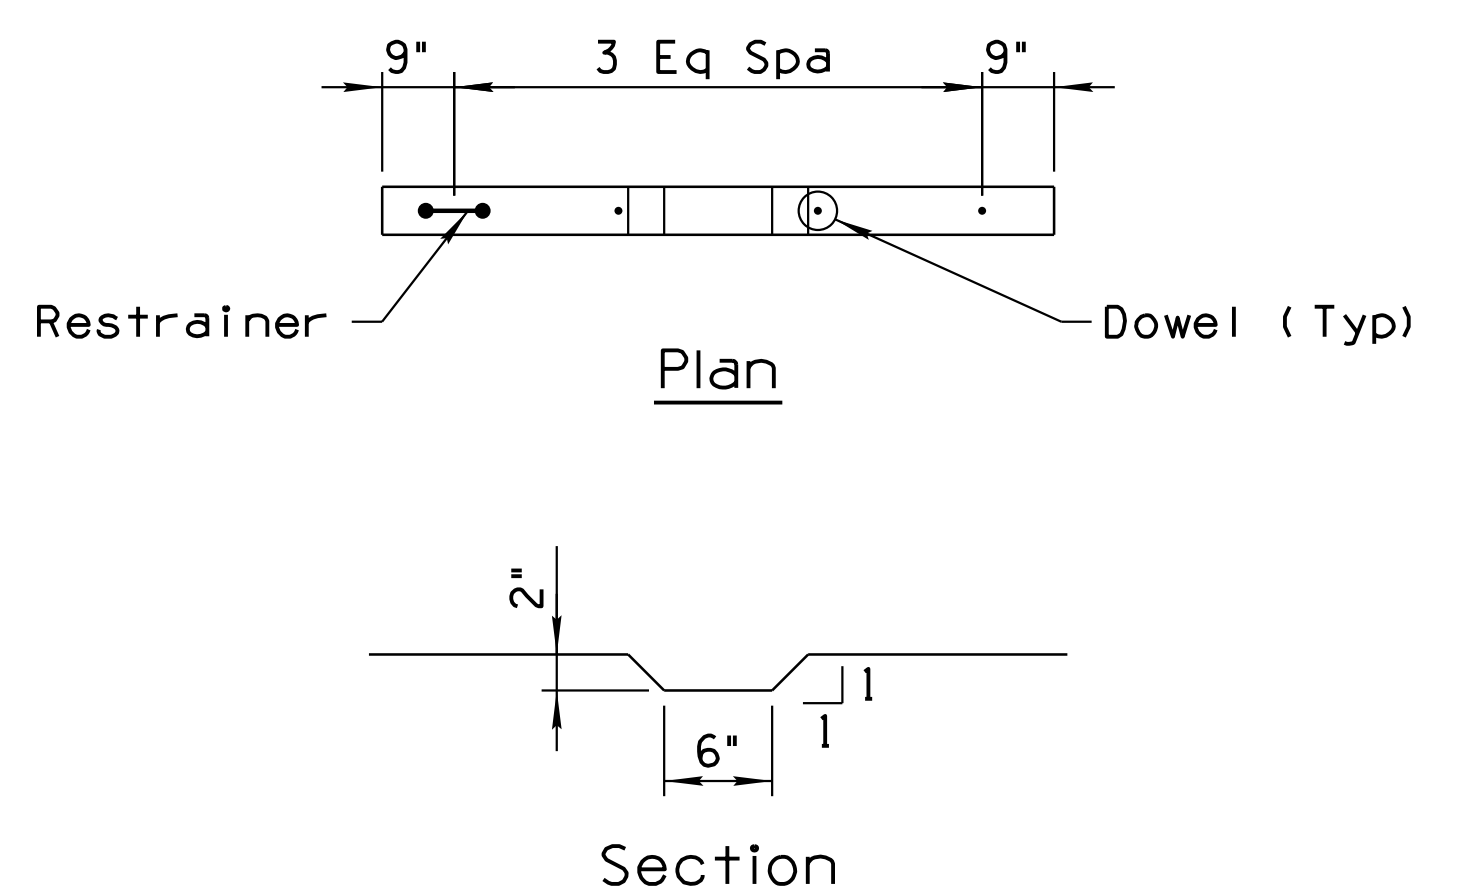

DETAIL - SHEAR KEY DETAIL  
No Scale




DESIGN	LES / HV	3-19	ARIZONA DEPARTMENT OF TRANSPORTATION INFRASTRUCTURE DELIVERY AND OPERATIONS DIVISION BRIDGE GROUP
DRAWN	DAY	3-19	
CHECKED	AGG / JAC	3-19	
			STA 99+ RUTHRAUFF ROAD T.I. UNDERPASS ABUTMENT DETAILS 3
I-10	252.00	20159	
TRACS NO. H 8480 OIC			010-D(213)S

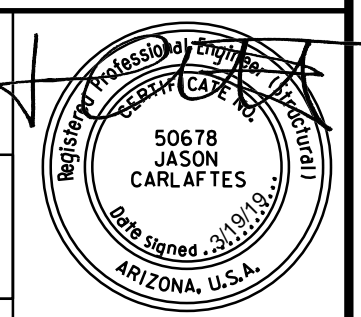



F.H.W.A. REGION	STATE	PROJECT NO.	SHEET NO.	TOTAL SHEETS	RECORD DRAWING
9	ARIZ.	010-D(213)S	627	849	

010 PM 252

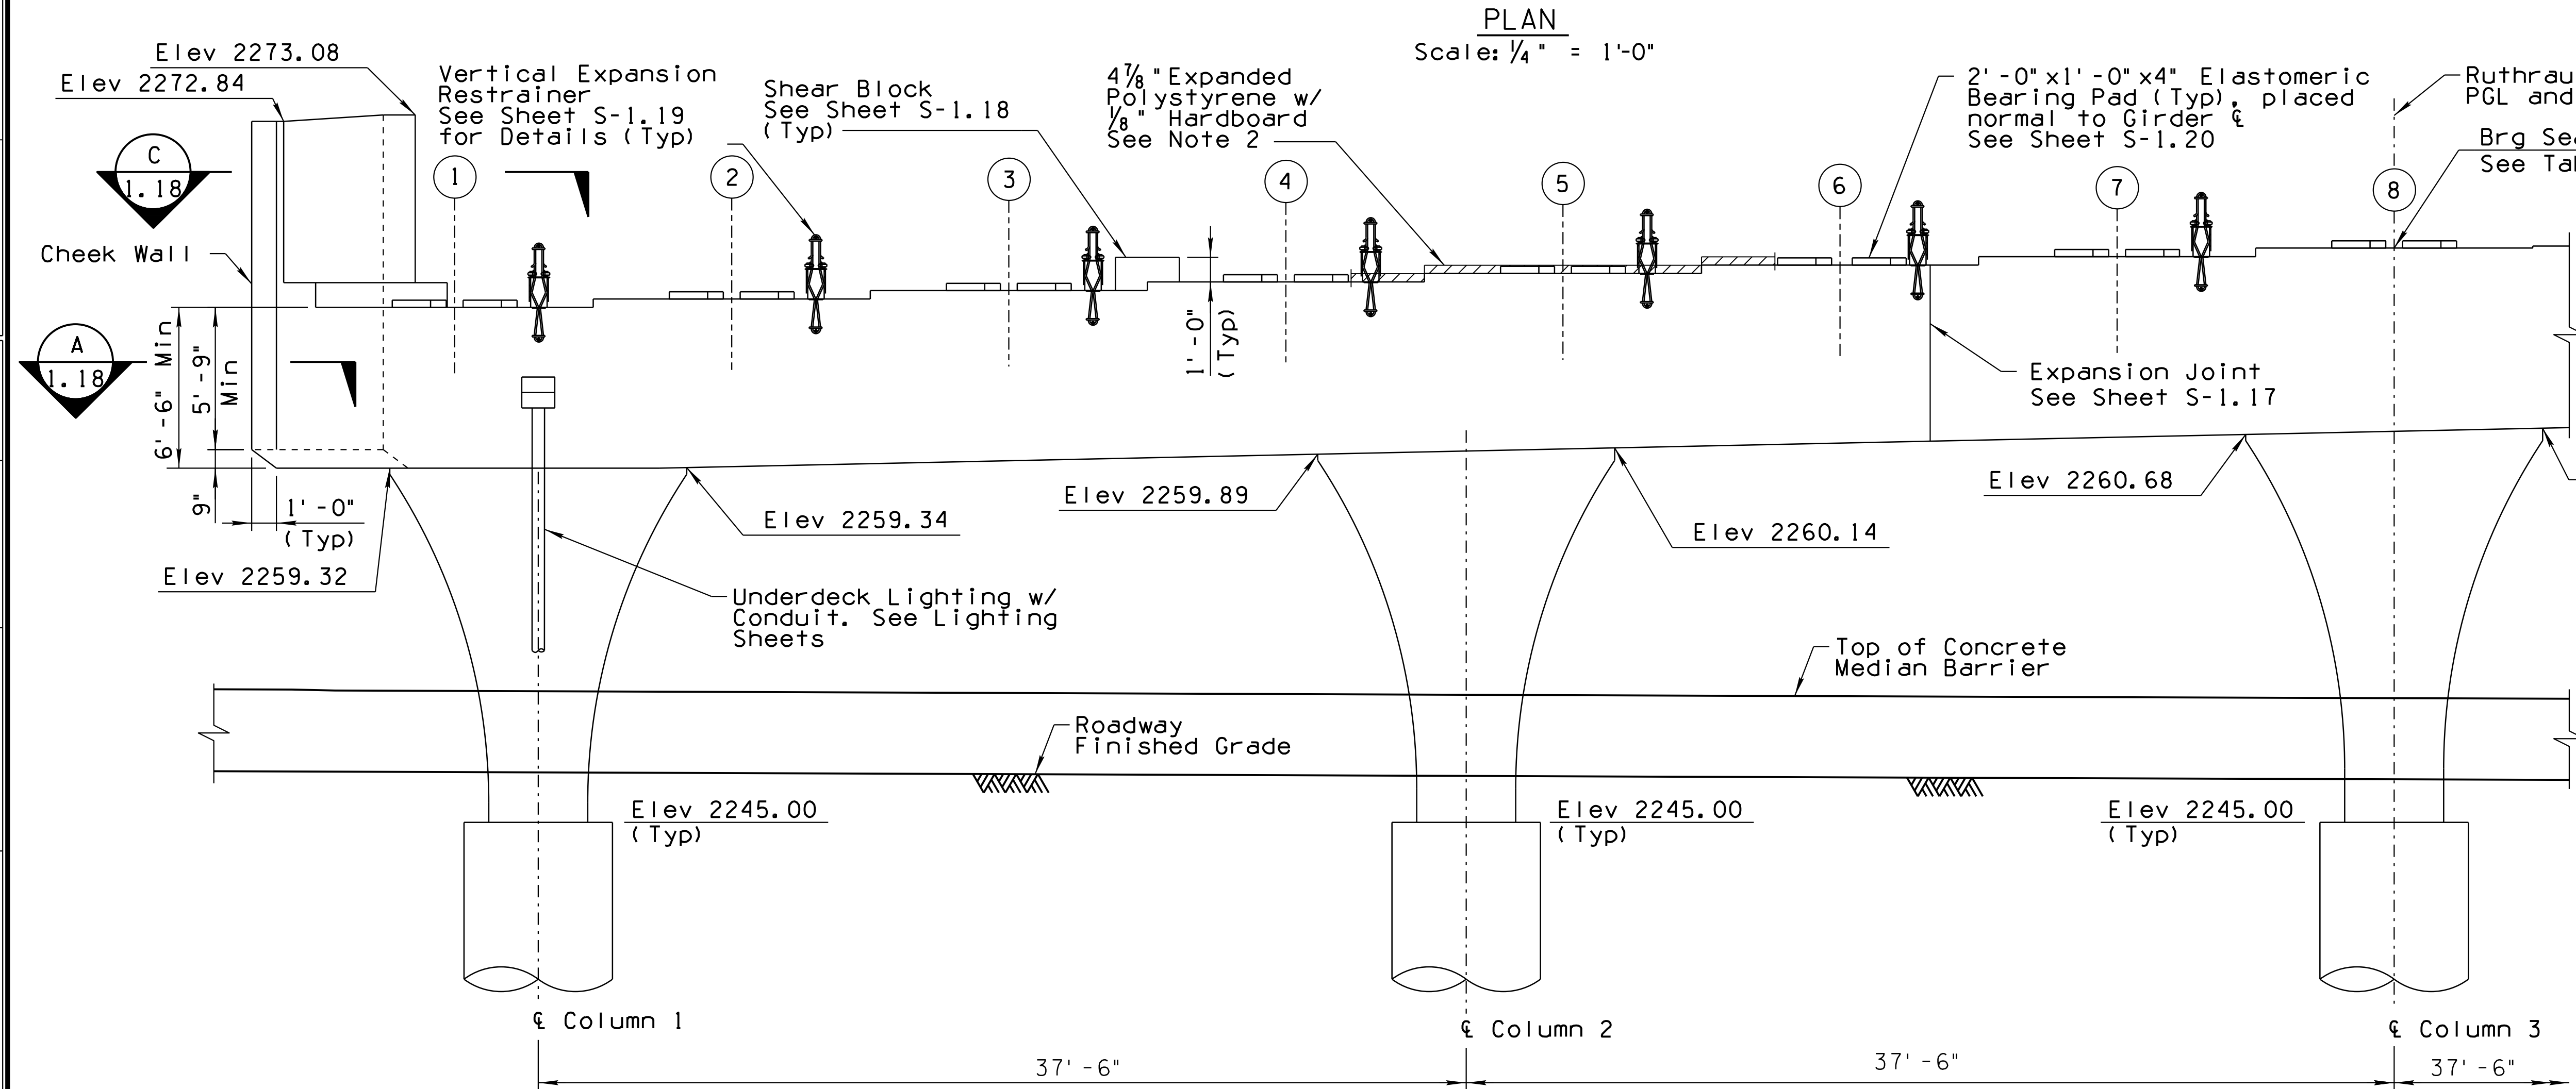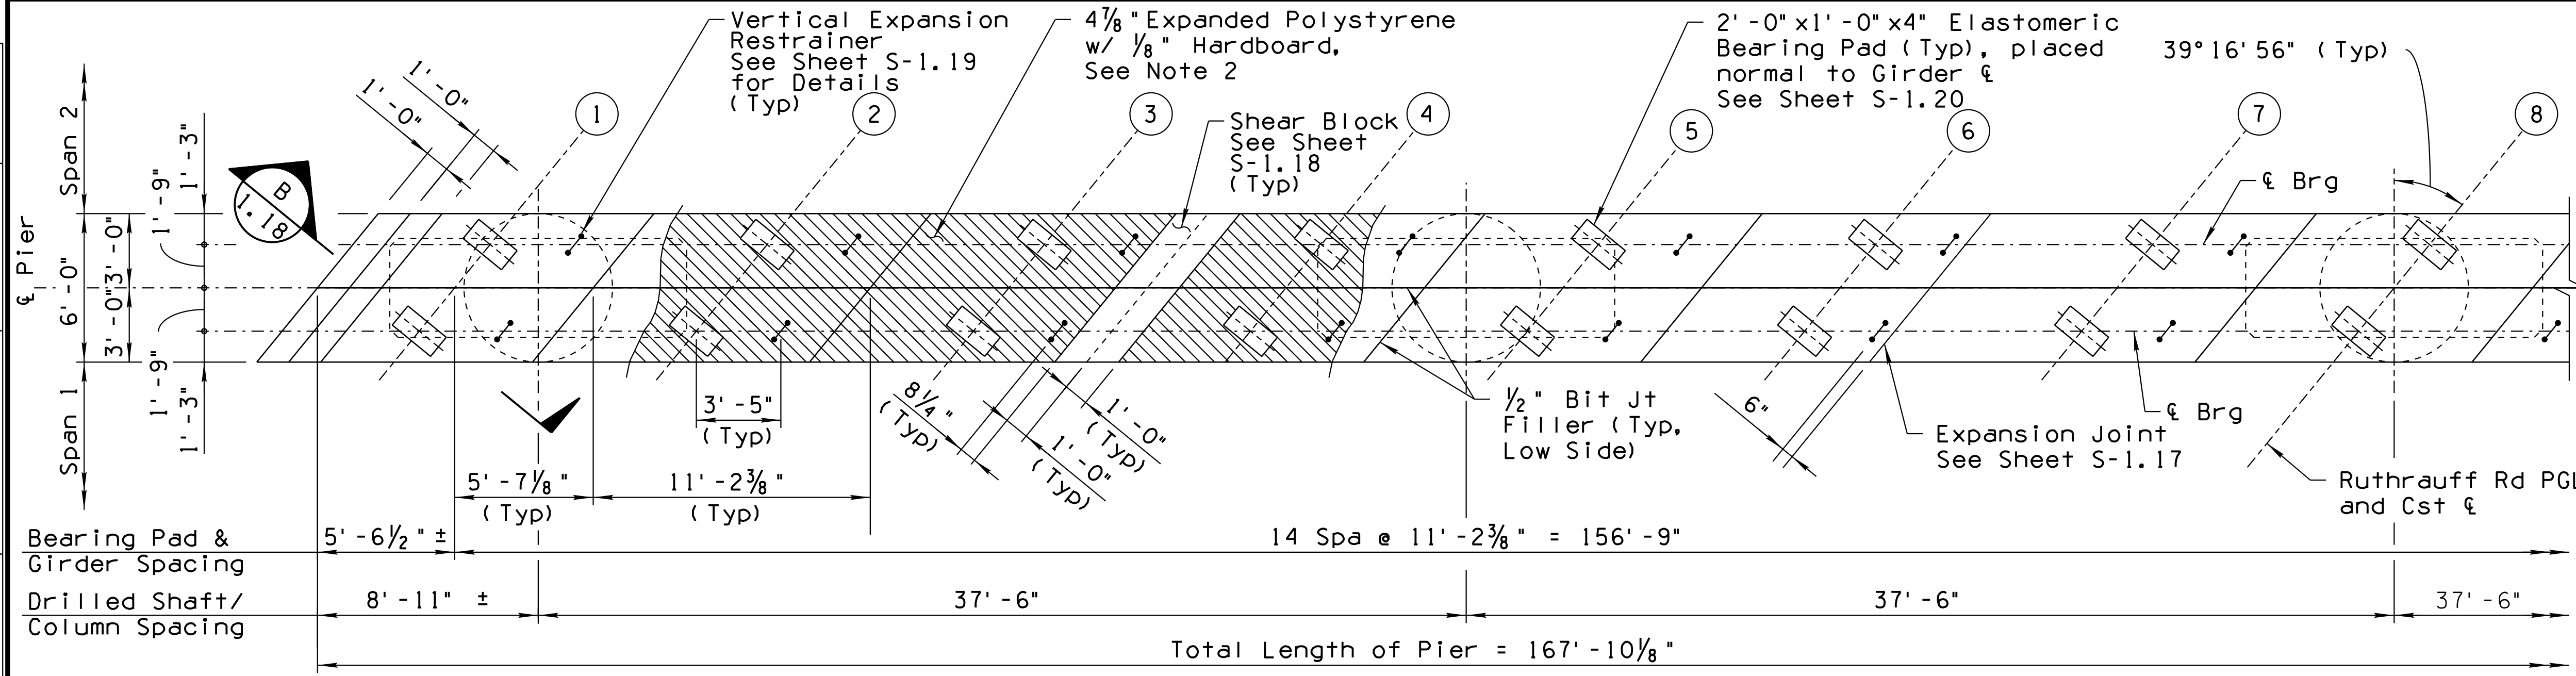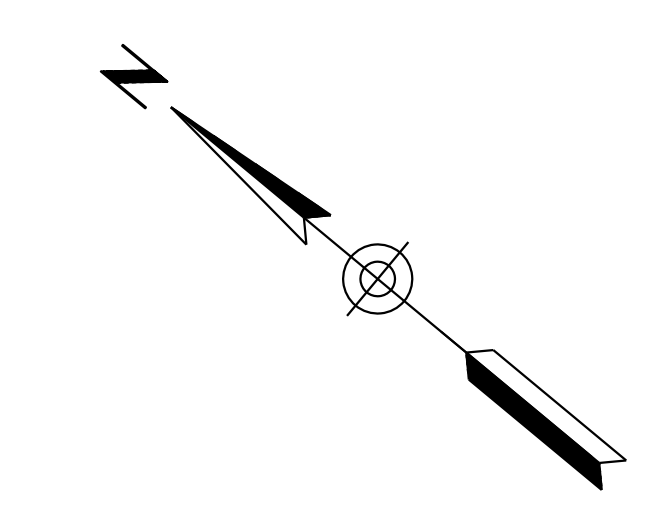



Girder	Span 1 (Back Sta)	Span 2 (Ahead Sta)
1	2265.61	2265.74
2	2265.95	2266.08
3	2266.29	2266.43
4	2266.63	2266.77
5	2266.98	2267.11
6	2267.32	2267.46
7	2267.66	2267.80
8	2268.01	2268.14

- Notes:**
1. Verify all Bridge seats elevations prior erection of the girders.
  2. Polystyrene + Hardboard Thickness accounts for the 1" Bevel & Thickness @ & Brg.


DESIGN	NAME	DATE	ARIZONA DEPARTMENT OF TRANSPORTATION INFRASTRUCTURE DELIVERY AND OPERATIONS DIVISION BRIDGE GROUP  STA 99+ RUTHRAUFF ROAD T.I. UNDERPASS PIER PLAN & ELEVATION 1
DRAWN	LES / HV	3-19	
CHECKED	DAY	3-19	
WSP WSP USA Inc. 177 N. Church Avenue Suite 1105 Tucson, AZ 85701			LOCATION RUTHRAUFF ROAD T.I.
I-10	252.00	20159	
ROUTE MILEPOST STRUCTURE NO.			DWG NO. S-1.14
TRACS NO. H 8480 OIC			010-D(213)S

F.H.W.A. REGION	STATE	PROJECT NO.	SHEET NO.	TOTAL SHEETS	RECORD DRAWING
9	ARIZ.	010-D(213)S	628	849	

010 PM 252

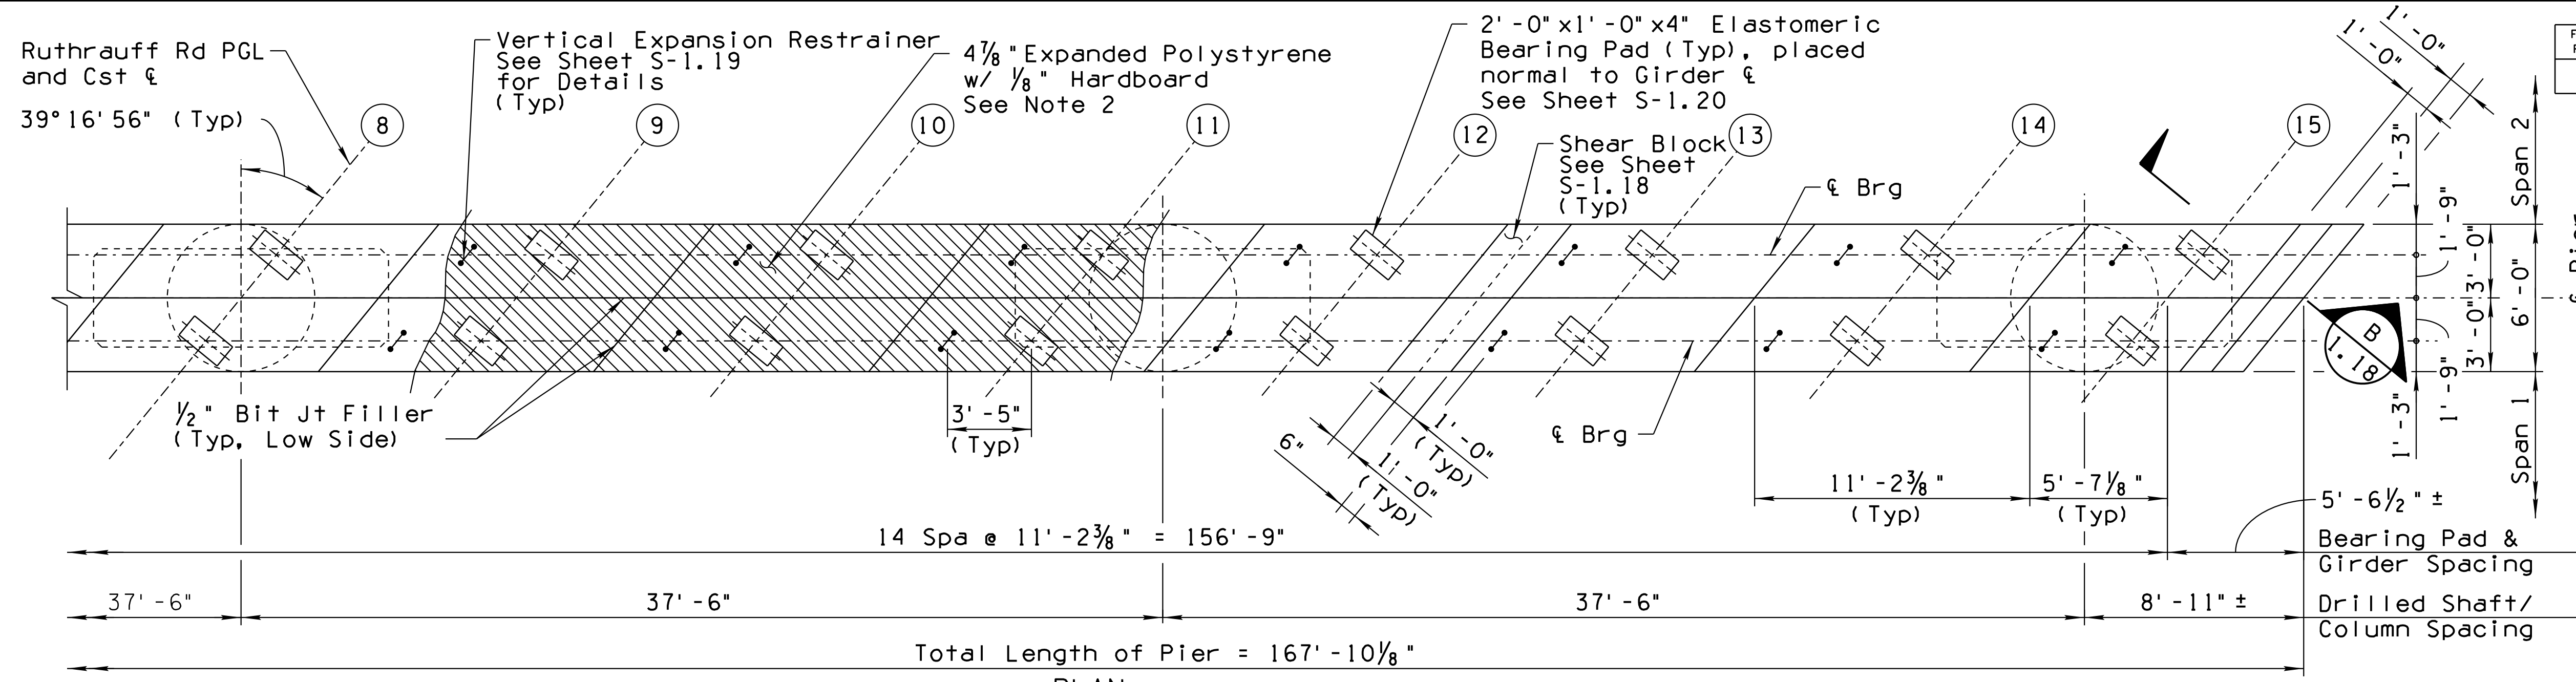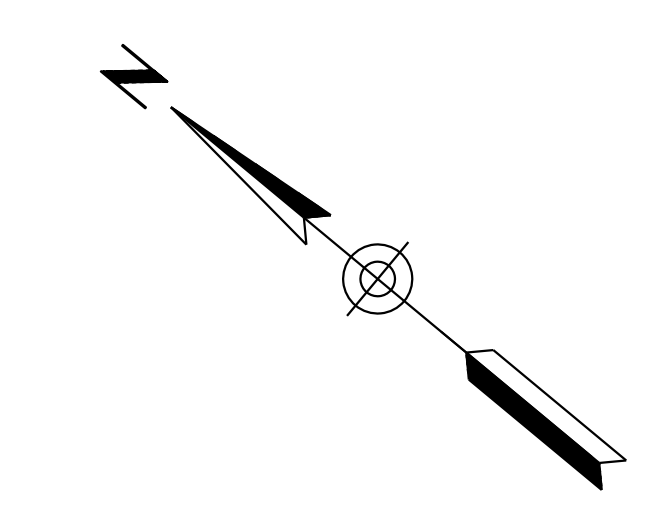

**PLAN**  
Scale: 1/4" = 1'-0"

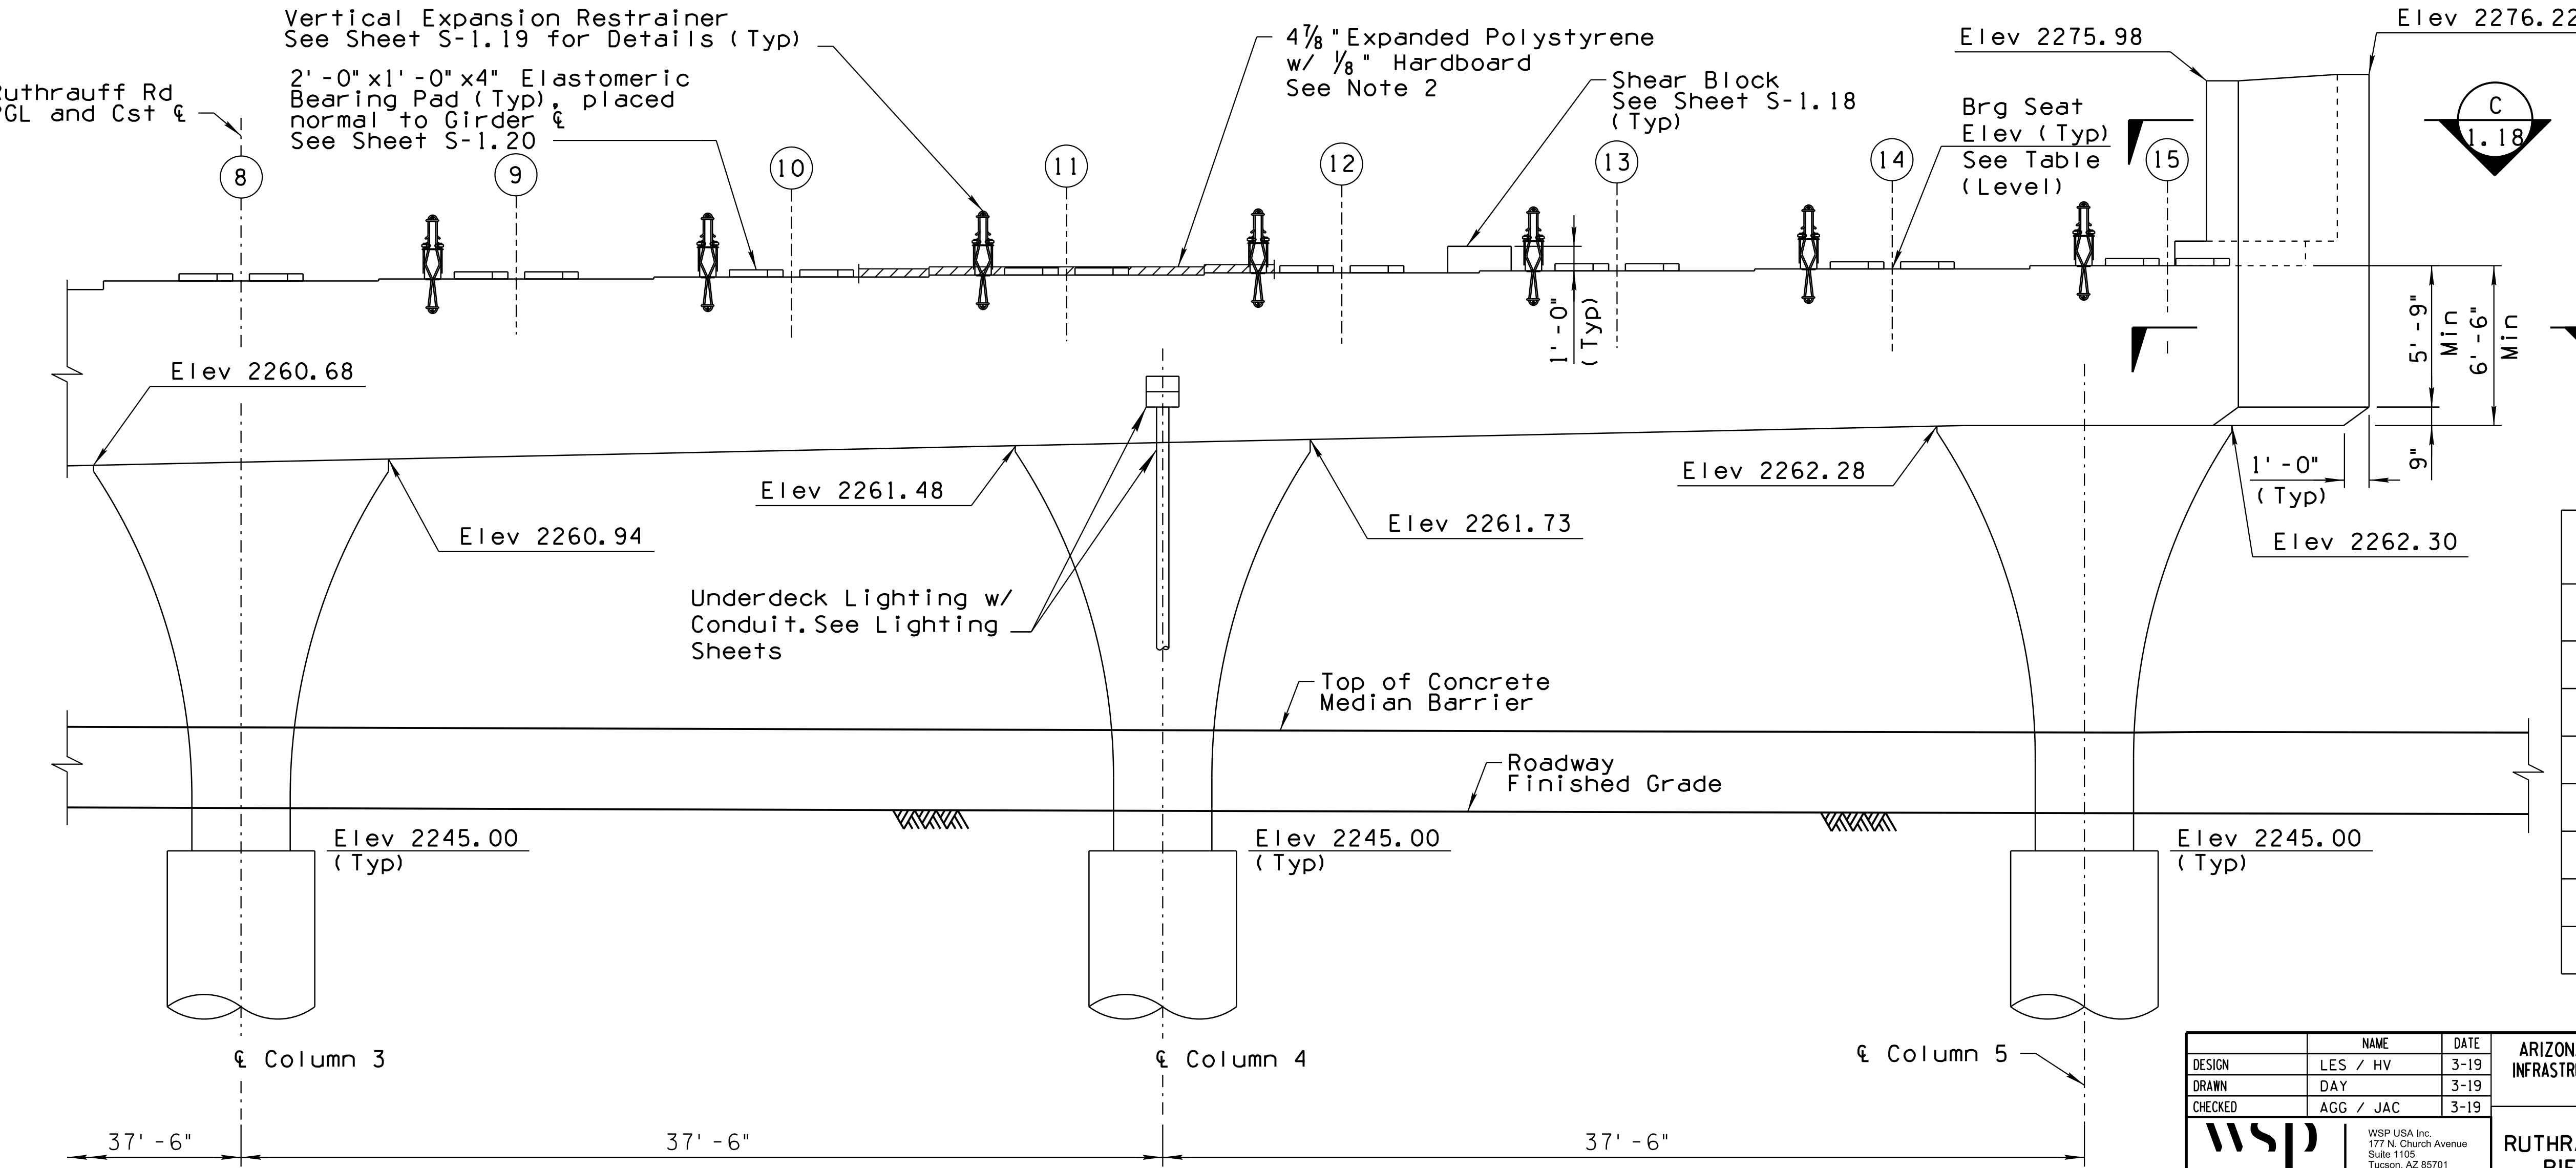

**ELEVATION**  
Scale: 1/4" = 1'-0"  
(Looking Ahead Station)


- Notes:**
1. Verify all Bridge seats elevations prior erection of the girders.
  2. Polystyrene + Hardboard Thickness accounts for the 1" Bevel P Thickness @  $\epsilon$  Brg.

Girder	Span 1 (Back Sta)	Span 2 (Ahead Sta)
9	2268.09	2268.22
10	2268.17	2268.31
11	2268.25	2268.39
12	2268.34	2268.47
13	2268.42	2268.55
14	2268.50	2268.64
15	2268.58	2268.72


DESIGN	LES / HV	DATE	3-19	ARIZONA DEPARTMENT OF TRANSPORTATION INFRASTRUCTURE DELIVERY AND OPERATIONS DIVISION <b>BRIDGE GROUP</b>	
DRAWN	DAY	DATE	3-19		
CHECKED	AGG / JAC	DATE	3-19		
		WSP USA, Inc. 177 N. Church Avenue Suite 1105 Tucson, AZ 85701		STA 99+ <b>RUTHRAUFF ROAD T.I. UNDERPASS</b> <b>PIER PLAN &amp; ELEVATION 2</b>	
I-10	252.00	20159	LOCATION		RUTHRAUFF ROAD T.I.
TRACS NO. H 8480 OIC			010-D(213)S		

F.H.W.A. REGION	STATE	PROJECT NO.	SHEET NO.	TOTAL SHEETS	RECORD DRAWING
9	ARIZ.	010-D(213)S	629	849	


010 PM 252

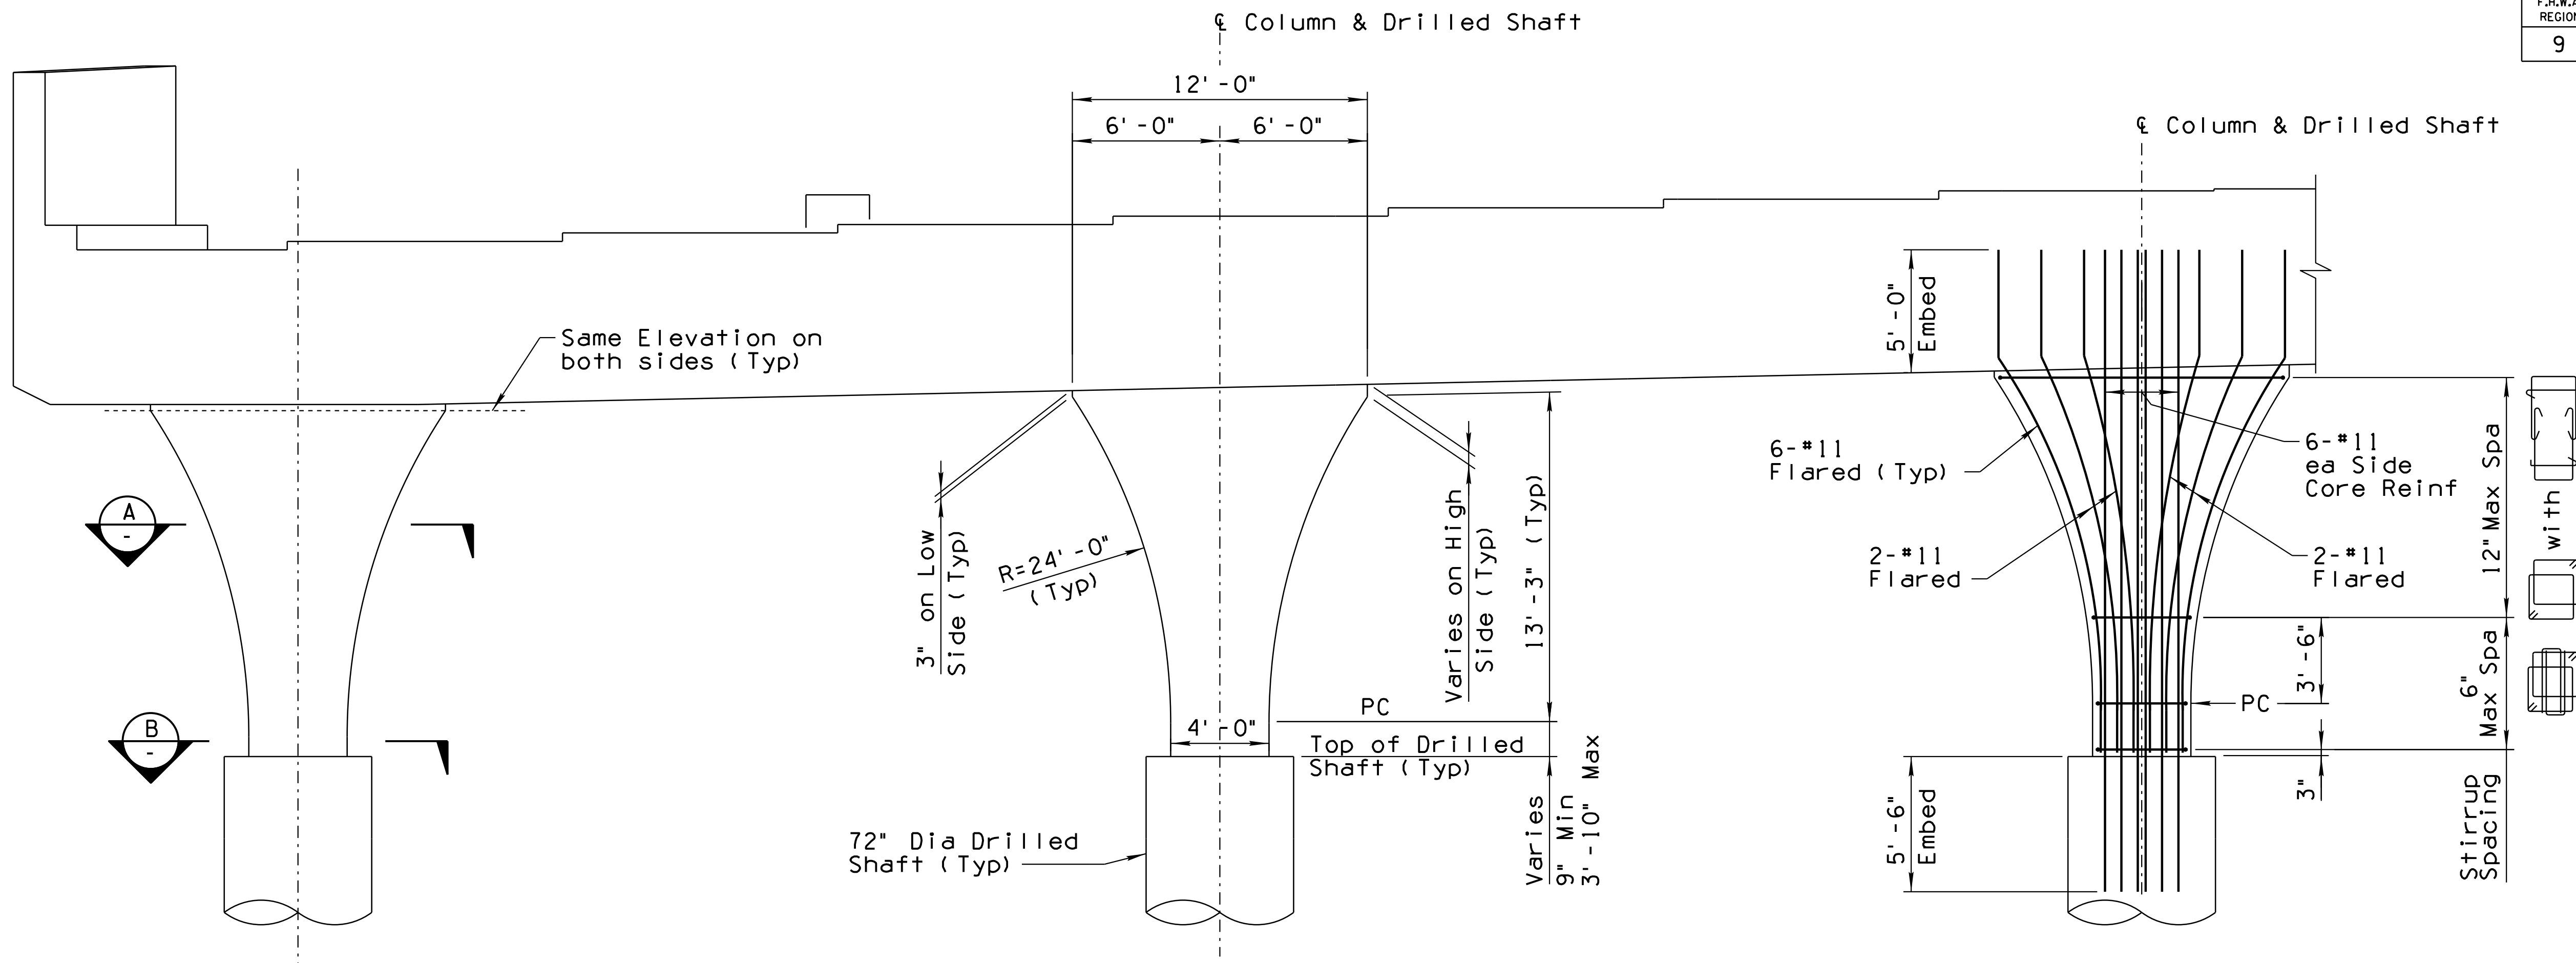


**TYPICAL PIER ELEVATION**  
Scale: 1/4" = 1'-0"

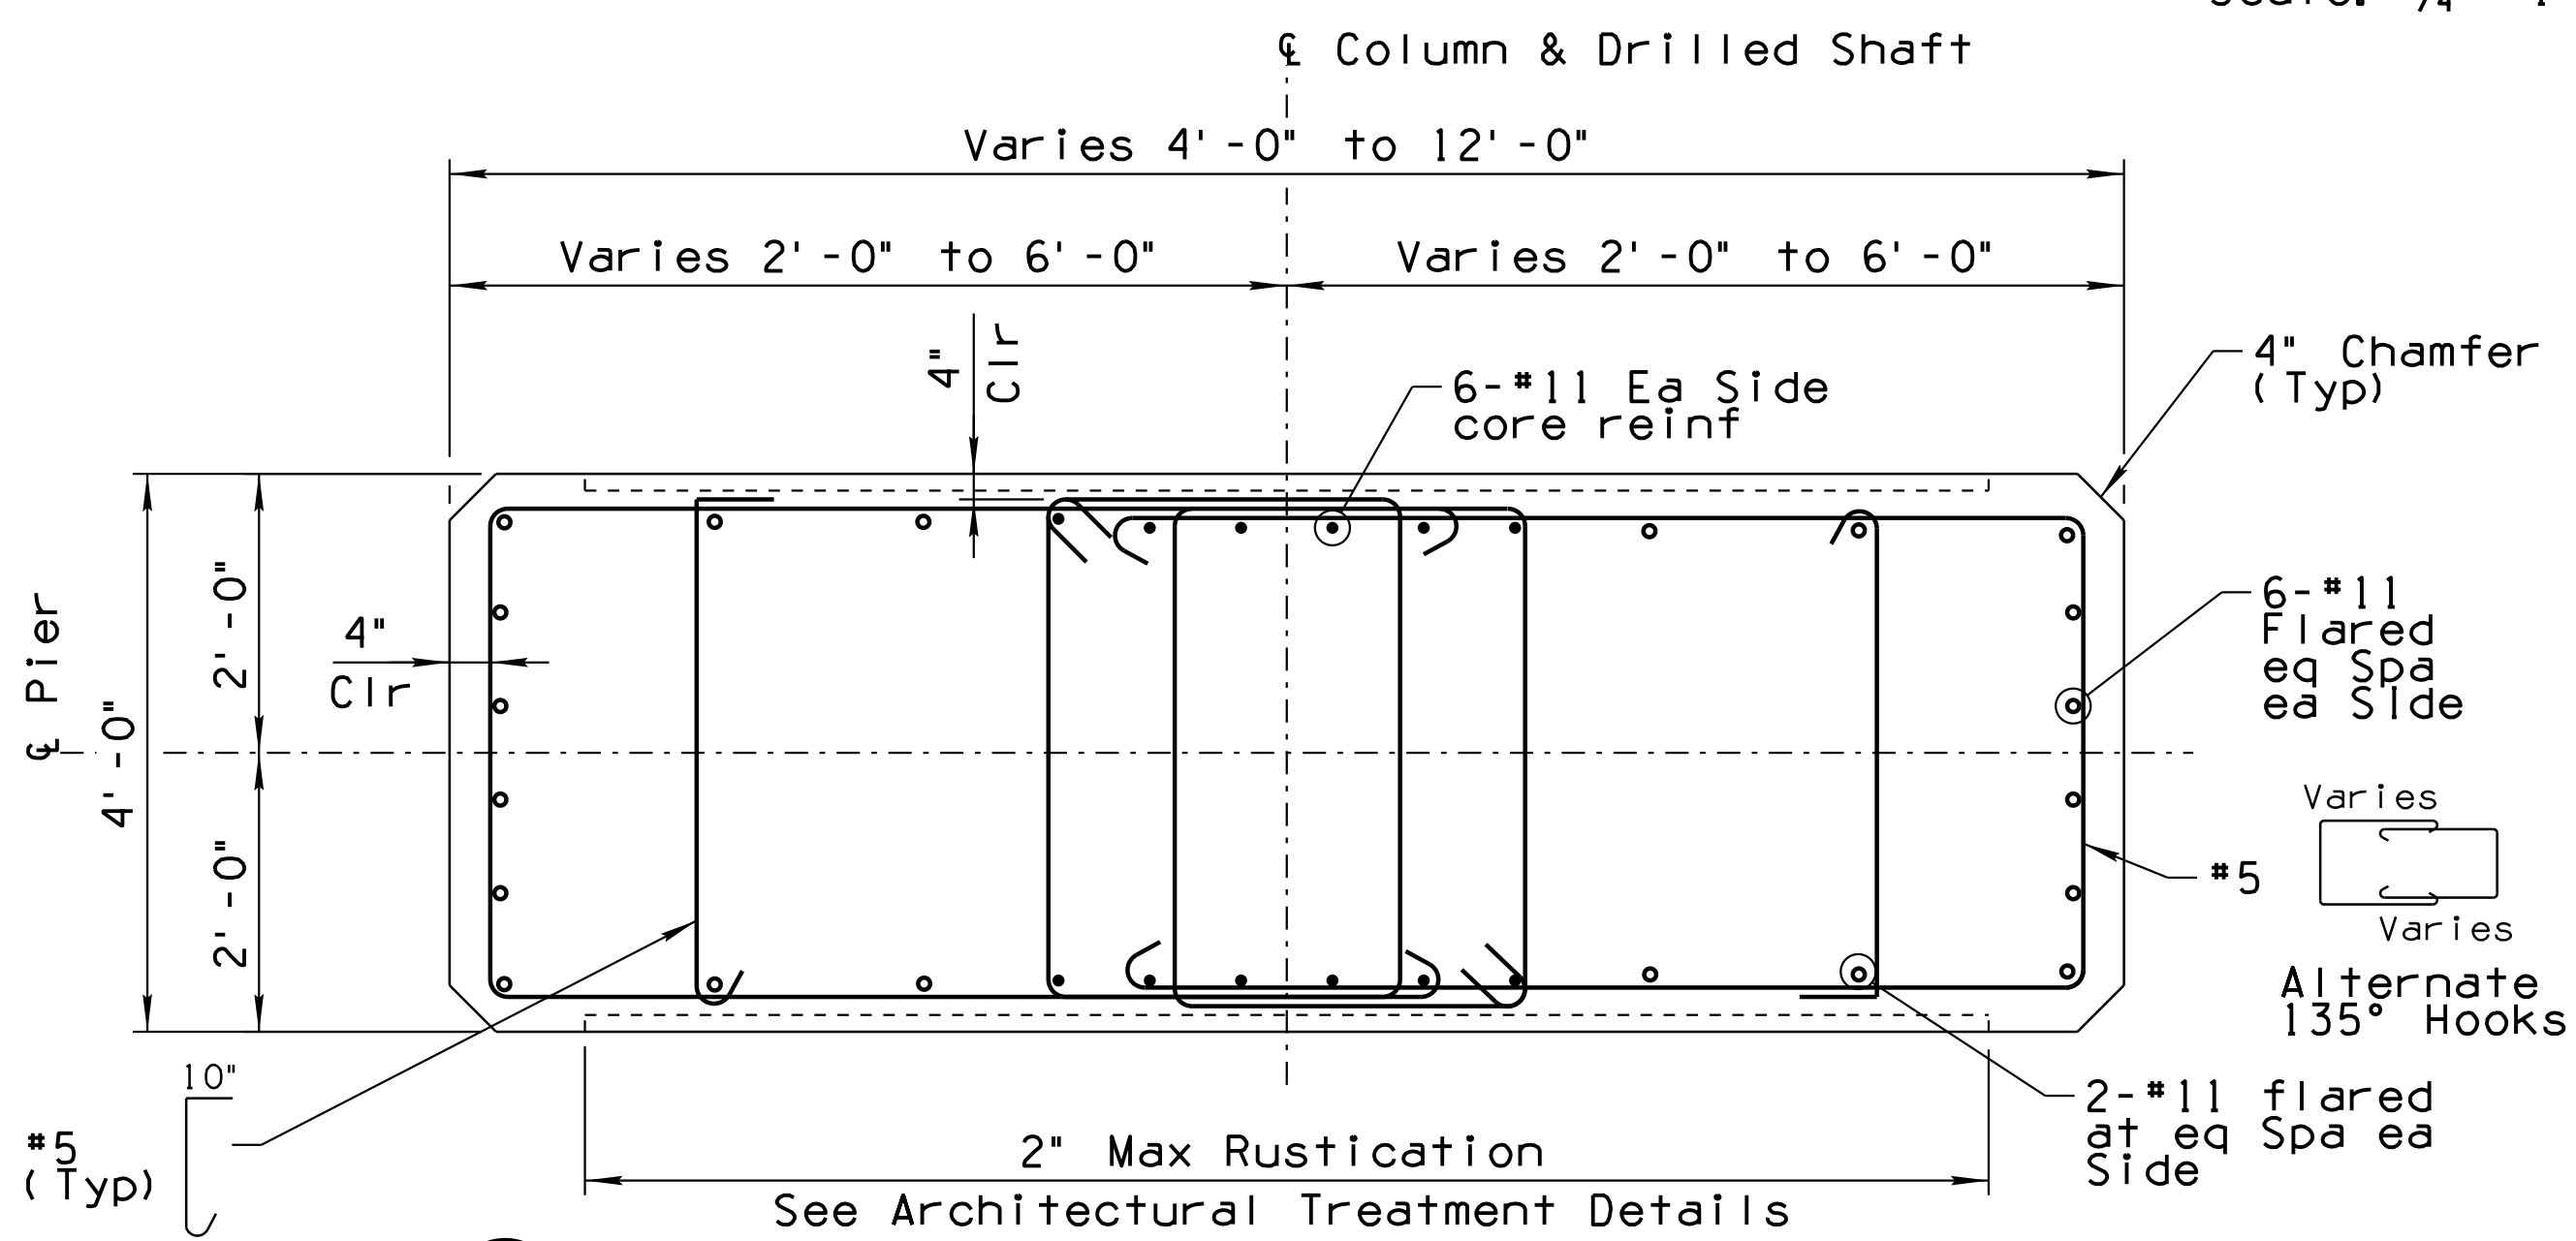

**SECTION A**  
Scale: 3/4" = 1'-0"

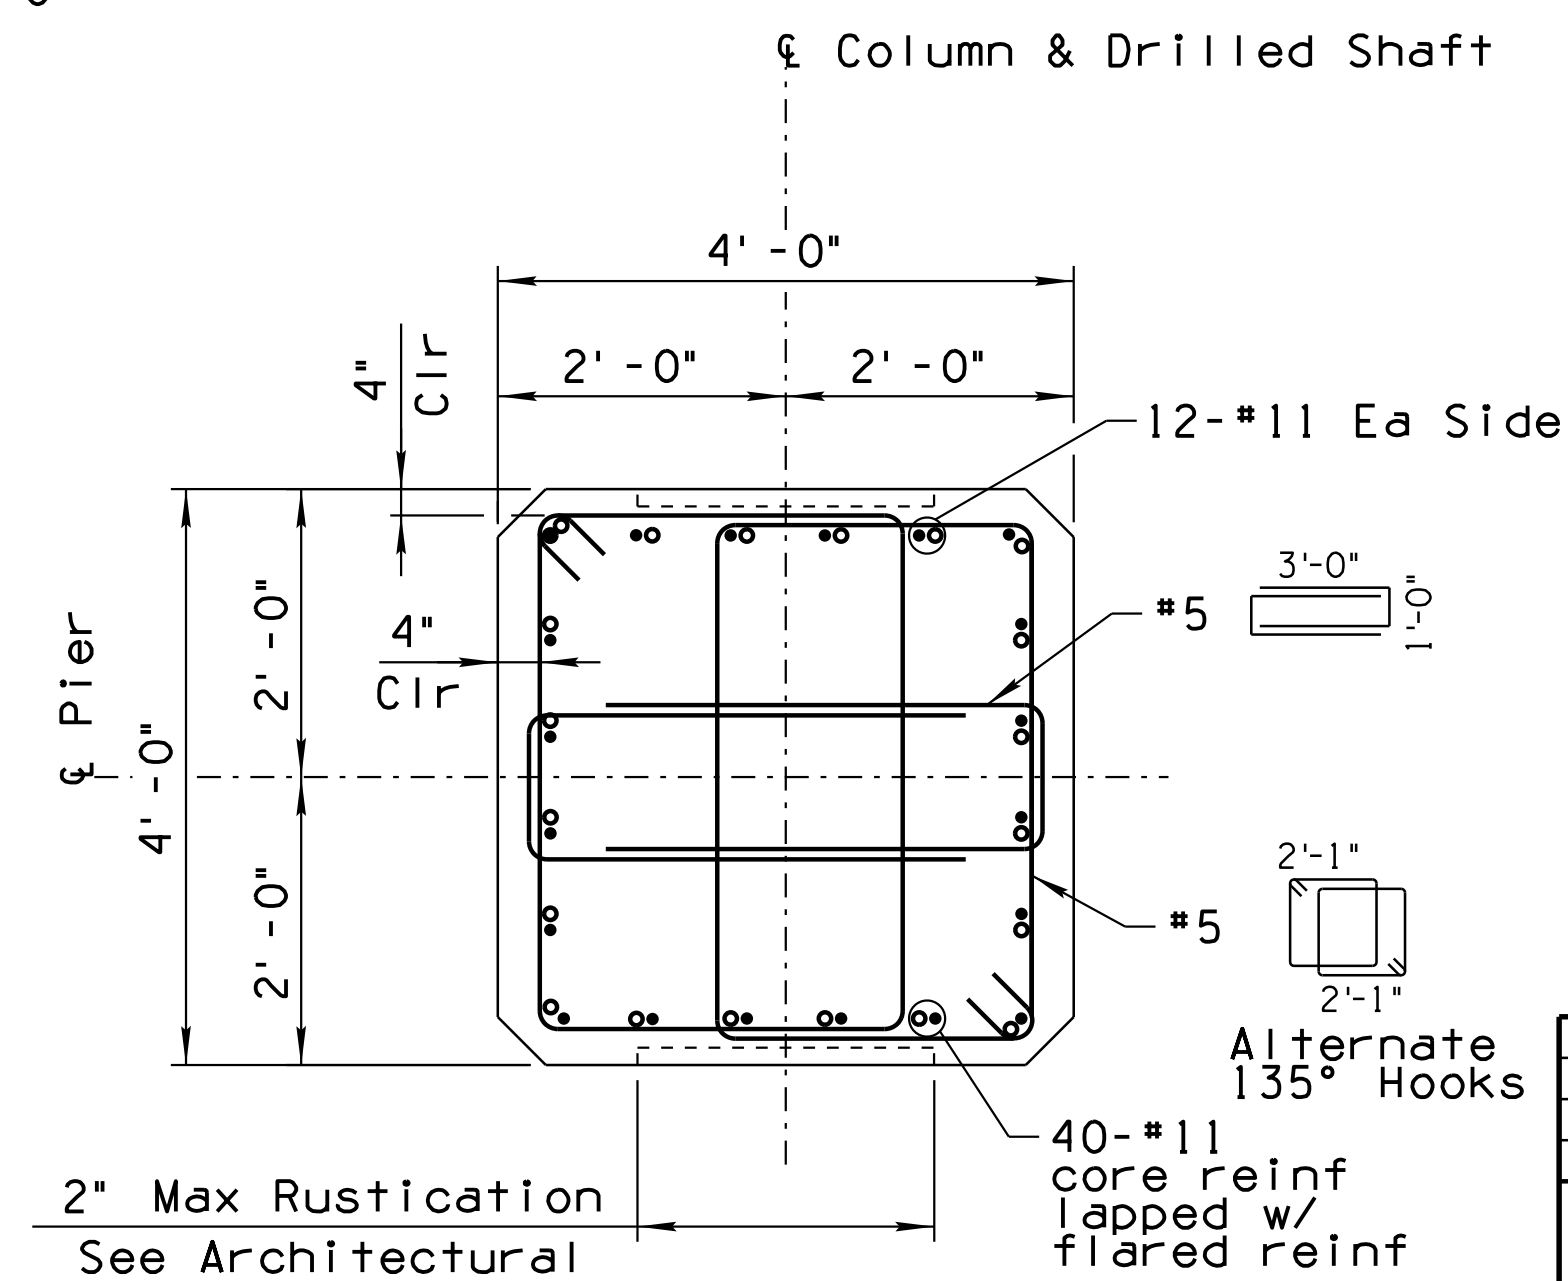

**SECTION B**  
Scale: 3/4" = 1'-0"

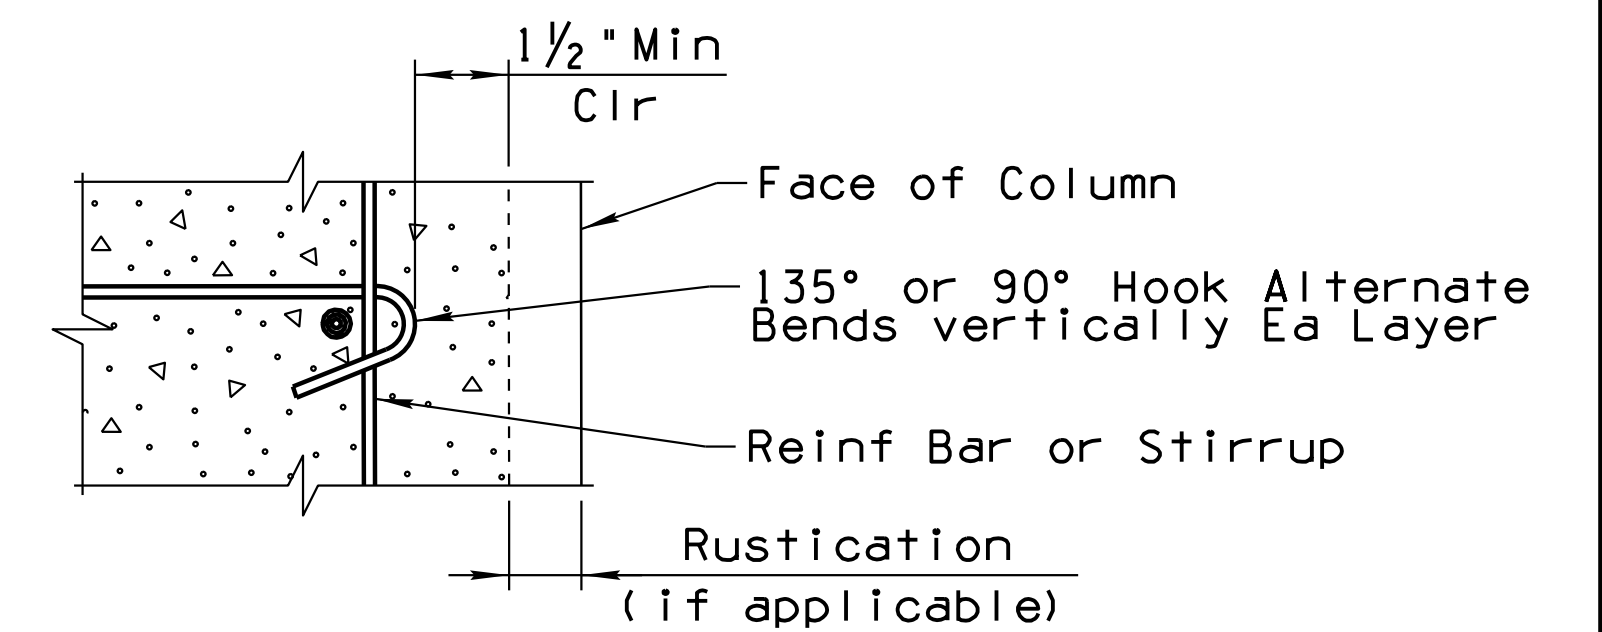


**DETAIL - TIE 1**  
N. T. S.

**LEGEND**

- Straight Bars
- Flared Bars


DESIGN	NAME	DATE	ARIZONA DEPARTMENT OF TRANSPORTATION INFRASTRUCTURE DELIVERY AND OPERATIONS DIVISION BRIDGE GROUP
LES / HV		3-19	
DAY		3-19	
CHECKED	AGG / JAC	3-19	
			<b>STA 99+ RUTHRAUFF ROAD T.I. UNDERPASS PIER DETAILS I</b>
I-10	252.00	20159	
ROUTE	MILEPOST	STRUCTURE NO.	LOCATION RUTHRAUFF ROAD T.I.
TRACS NO. H 8480 OIC			010-D(213)S
			DWG NO. S-1.16

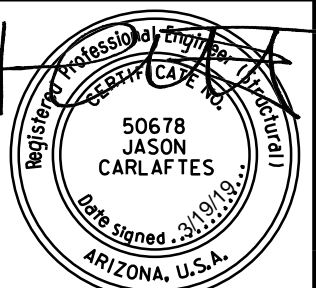




F.H.W.A. REGION	STATE	PROJECT NO.	SHEET NO.	TOTAL SHEETS	RECORD DRAWING
9	ARIZ.	010-D(213)S	630	849	

010 PM 252

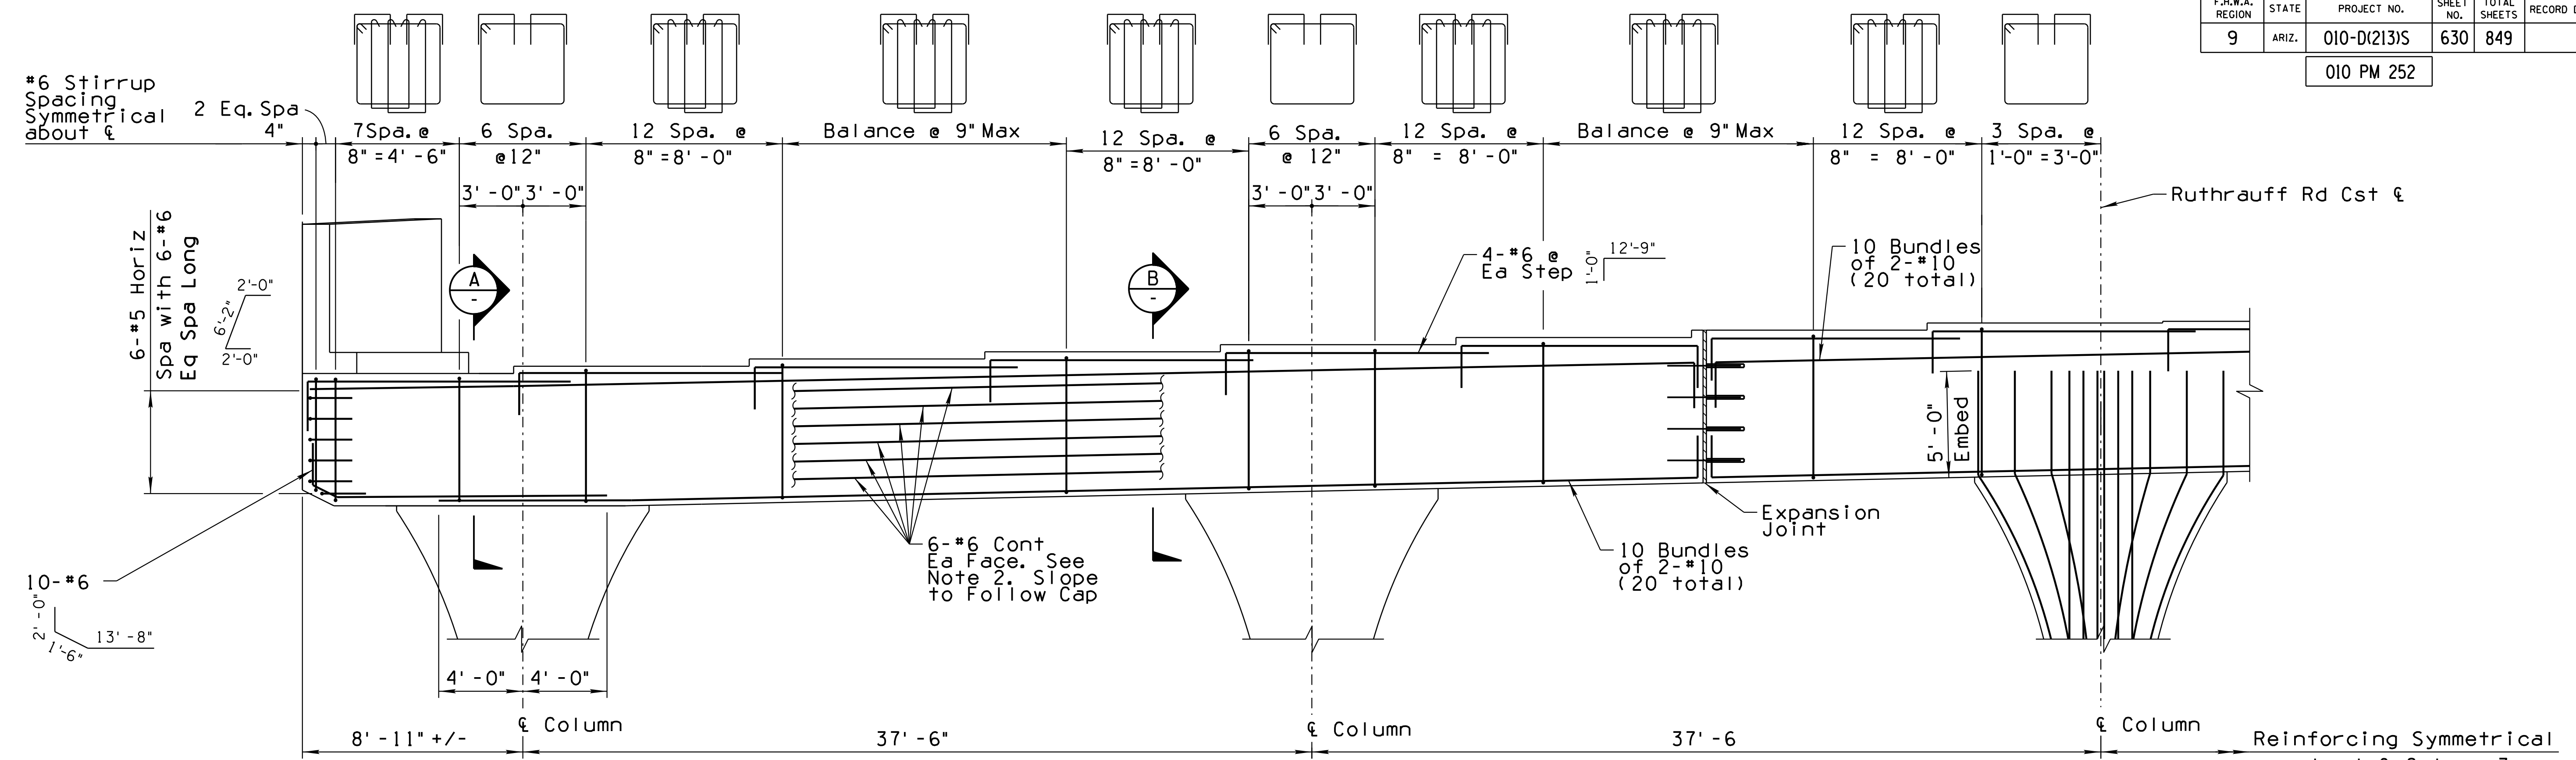


**PARTIAL PIER CAP REINFORCING**


Scale: 1/4" = 1'-0"

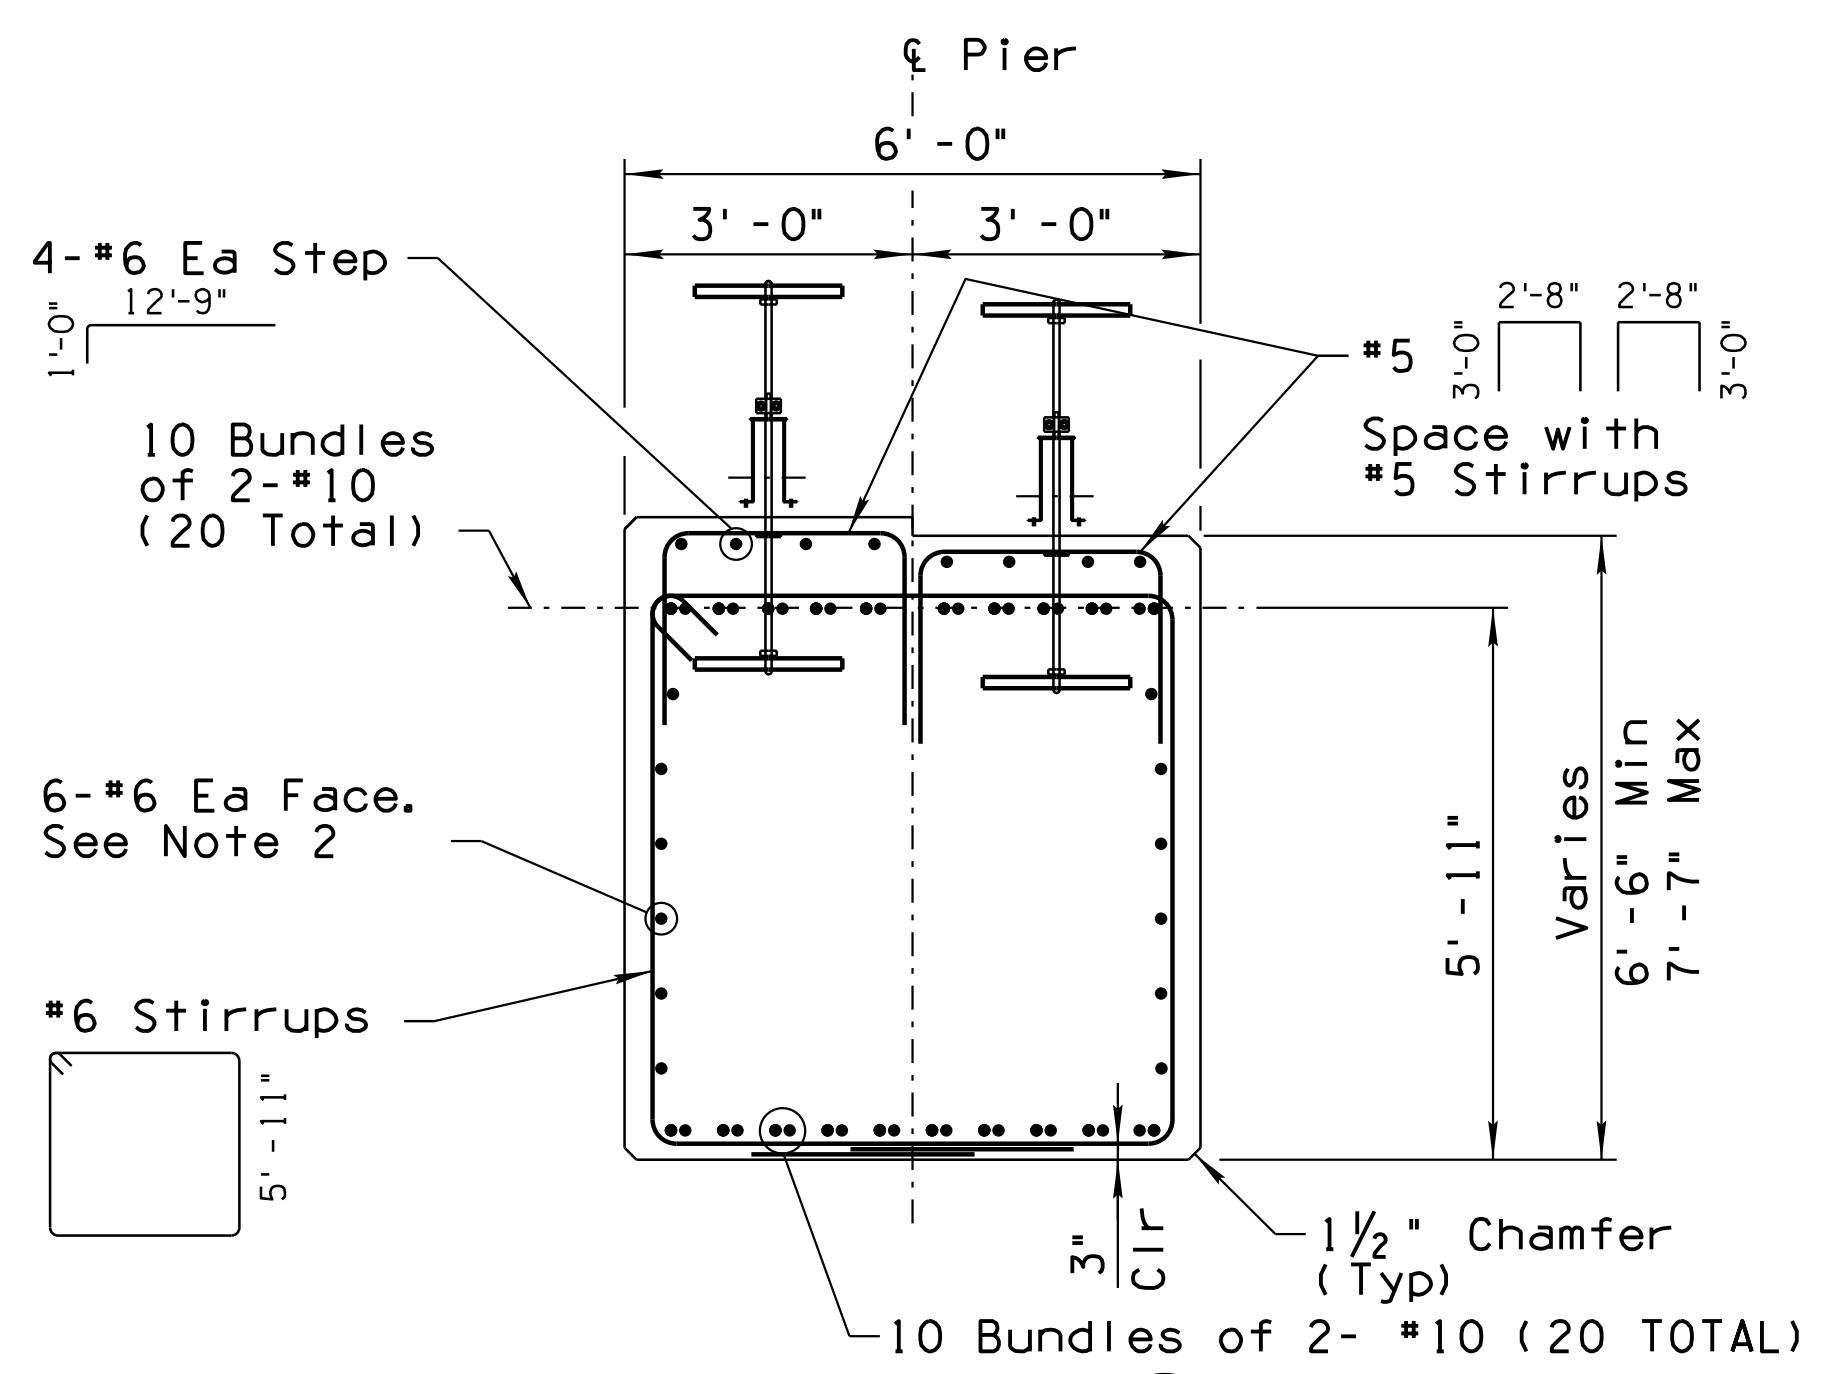

SECTION A  
Scale: 1/2" = 1'-0"

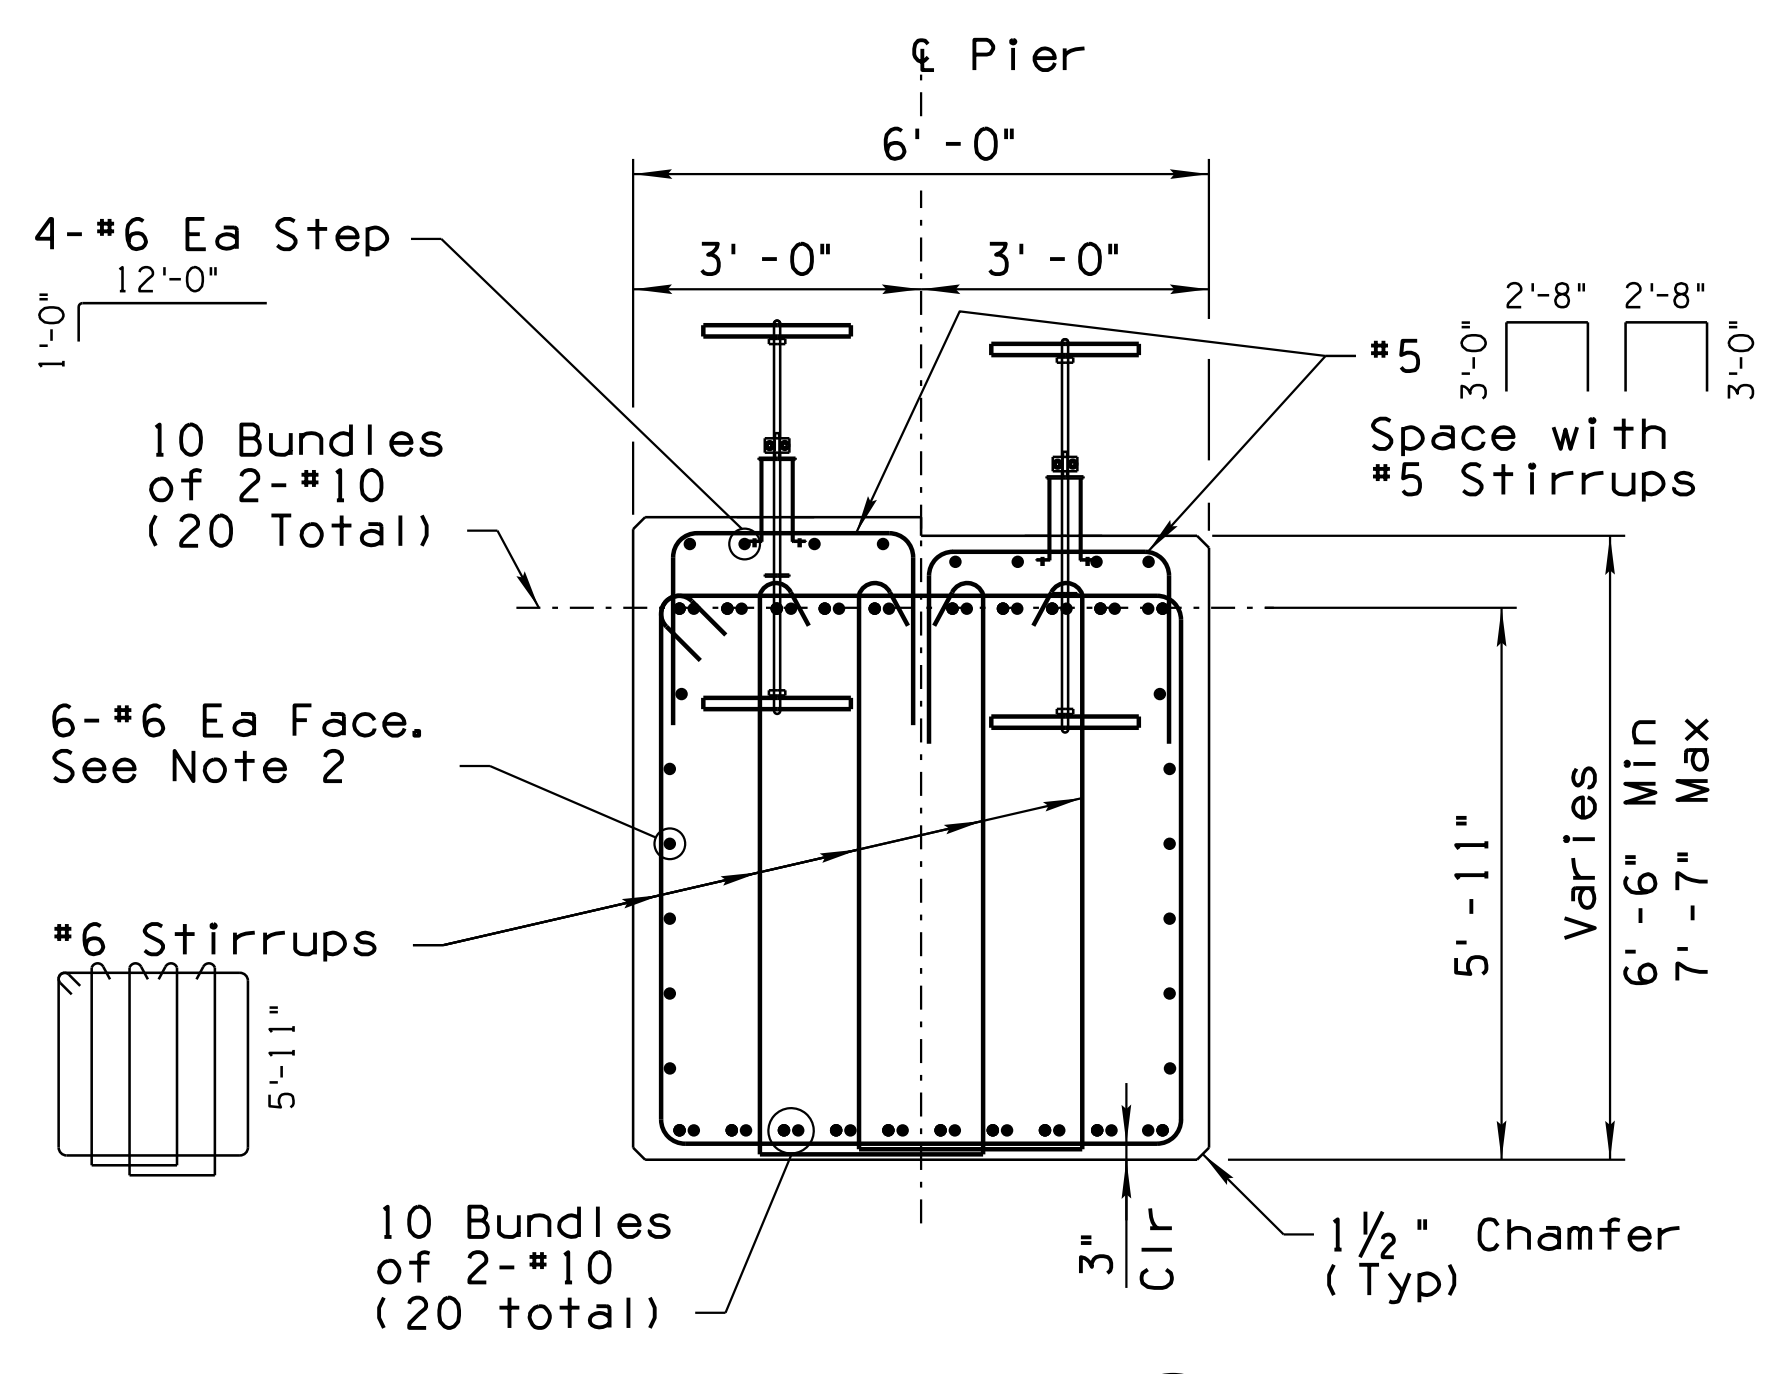

SECTION B  
Scale: 1/2" = 1'-0"

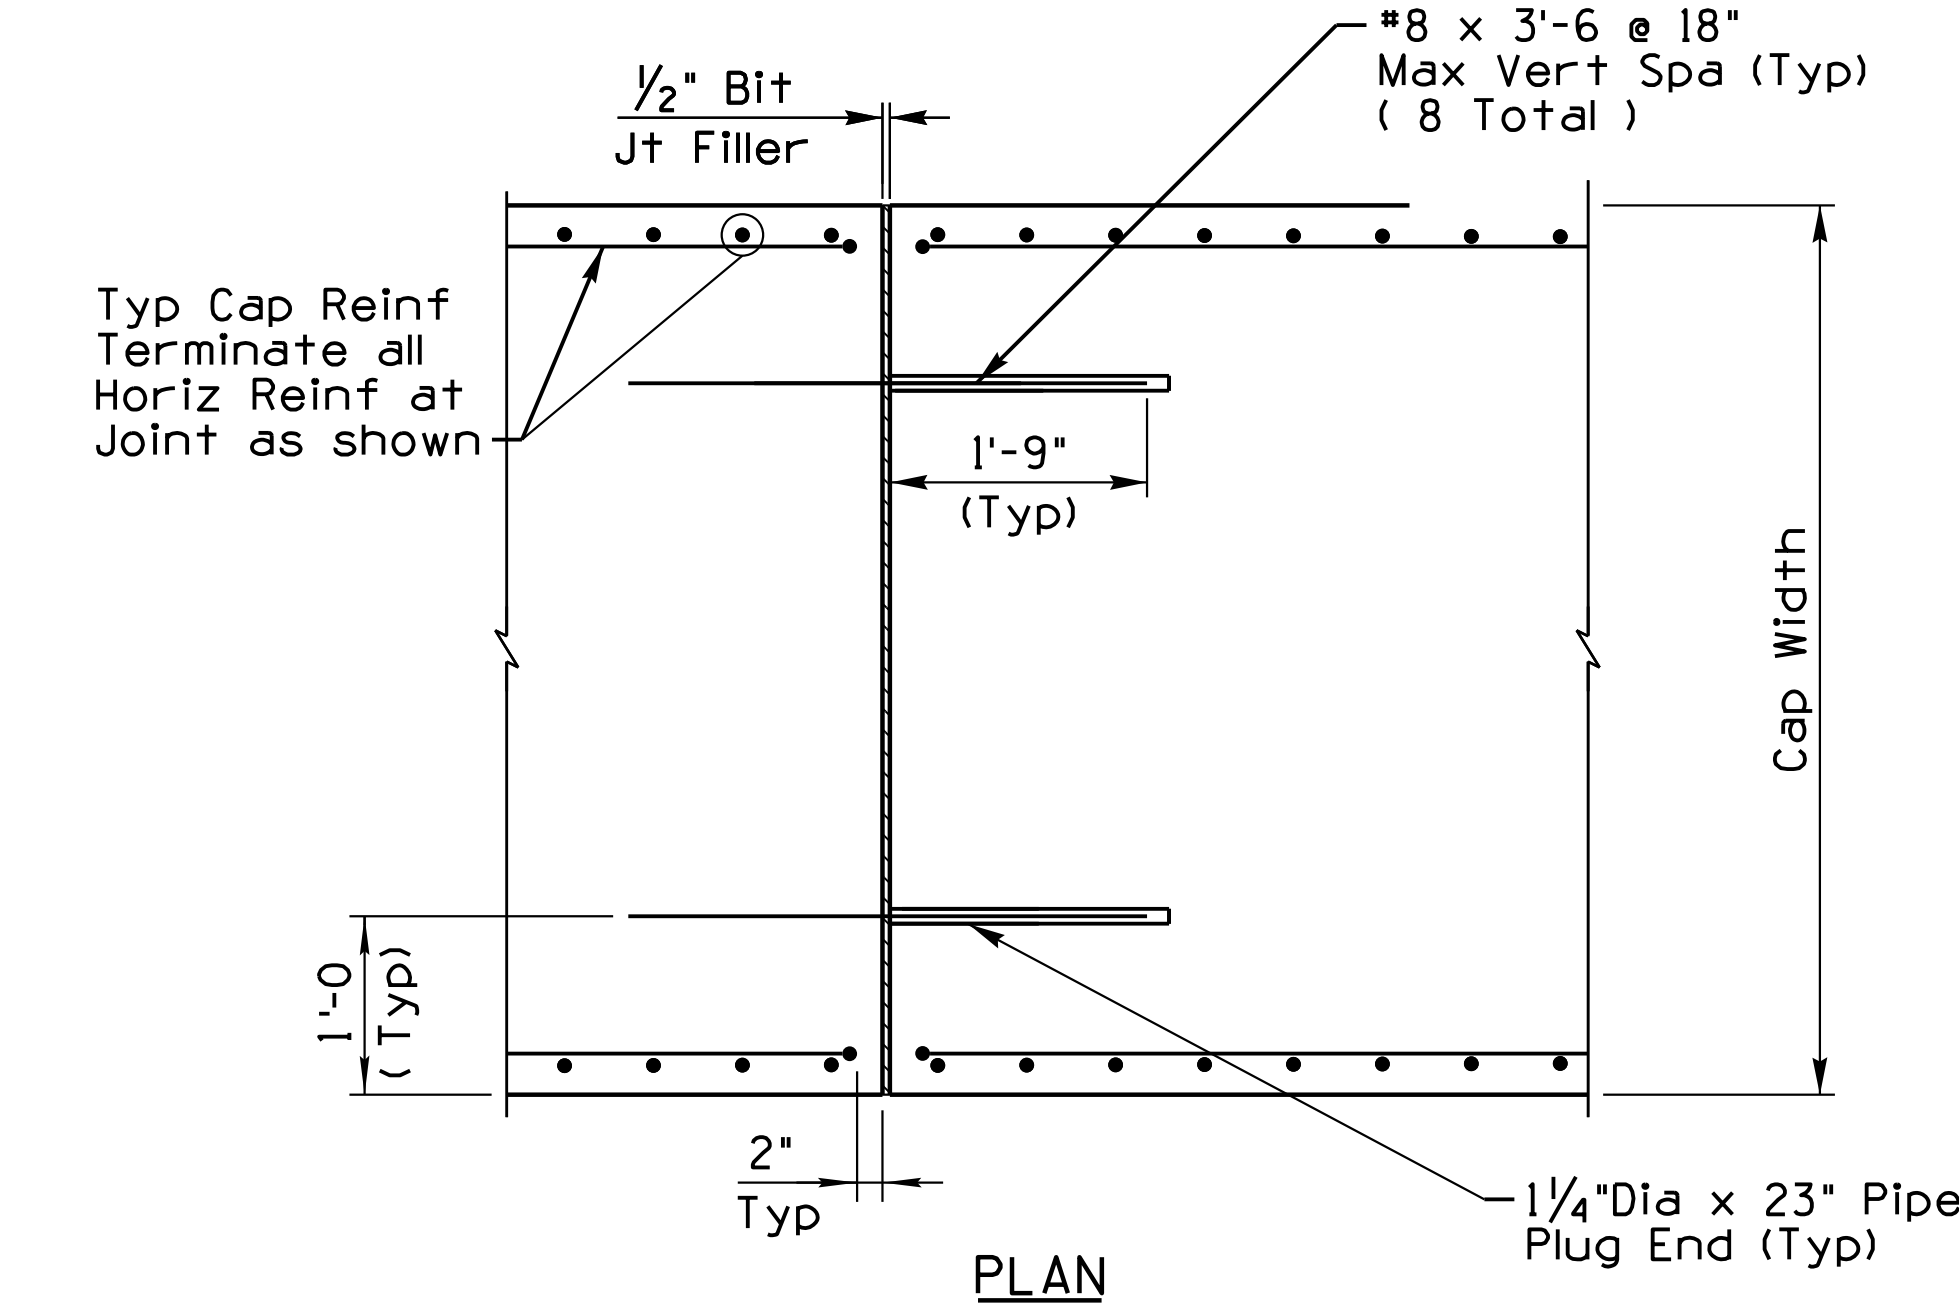

DETAIL - EXPANSION JOINT (1)  
No Scale


**NOTES:**

- See Dwg No. S-1.18 for Pier Cap Reinforcing lap splice details.
- #6 bars shall be spliced 2-3 min as required. Adjacent bars shall not be spliced @ the same location and all splices shall be staggered.

DESIGN	LES / HV	DATE	3-19	ARIZONA DEPARTMENT OF TRANSPORTATION INFRASTRUCTURE DELIVERY AND OPERATIONS DIVISION BRIDGE GROUP STA 99+ RUTHRAUFF ROAD T.I. UNDERPASS PIER DETAILS 2	
DRAWN	DAY	DATE	3-19		
CHECKED	AGG / JAC	DATE	3-19		
<b>wsp</b> WSP USA Inc. 177 N. Church Avenue Suite 1105 Tucson, AZ 85701		LOCATION RUTHRAUFF ROAD T.I.	DWG NO. S-1.17		
I-10	252.00	20159	2019	TRACS NO. H 8480 OIC	010-D(213)S


F.H.W.A. REGION	STATE	PROJECT NO.	SHEET NO.	TOTAL SHEETS	RECORD DRAWING
9	ARIZ.	010-D(213)S	631	849	

010 PM 252

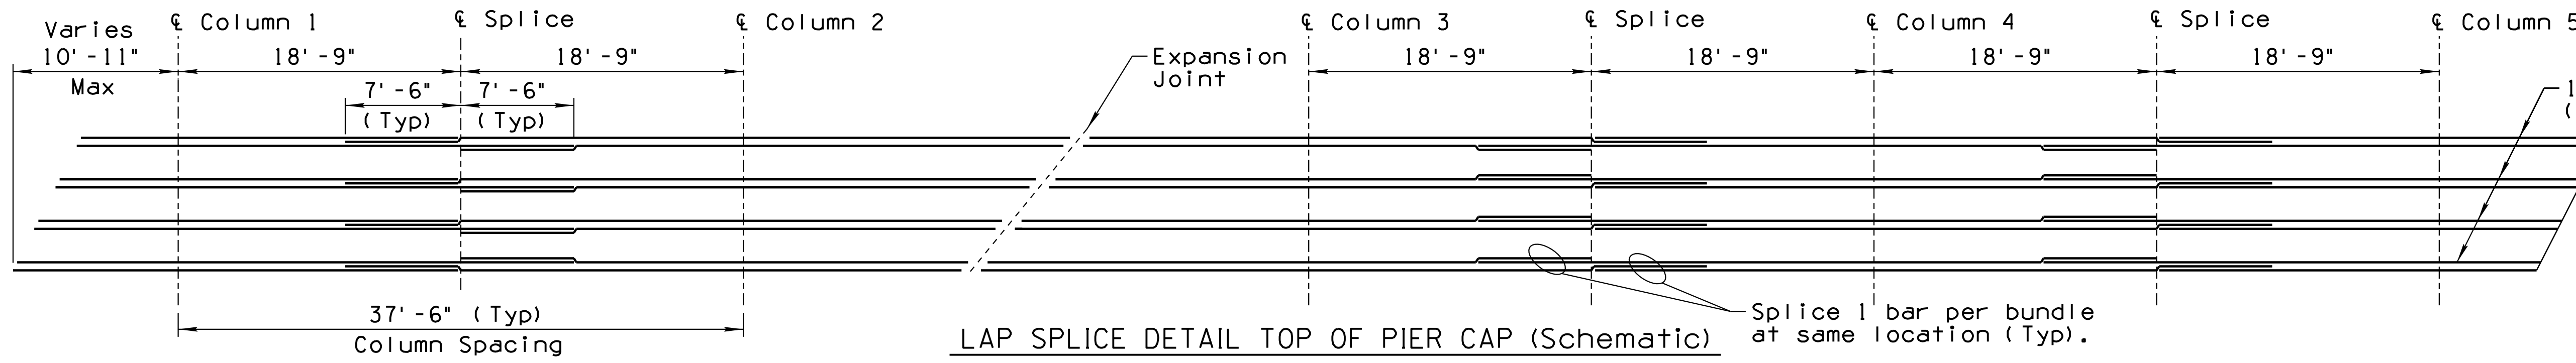





NOTE:  
Max Bar length for Top of Pier Cap Reinforcing is 45'-0"  
Not all bars are shown.

LAP SPLICE DETAIL TOP OF PIER CAP (Schematic)  
No Scale

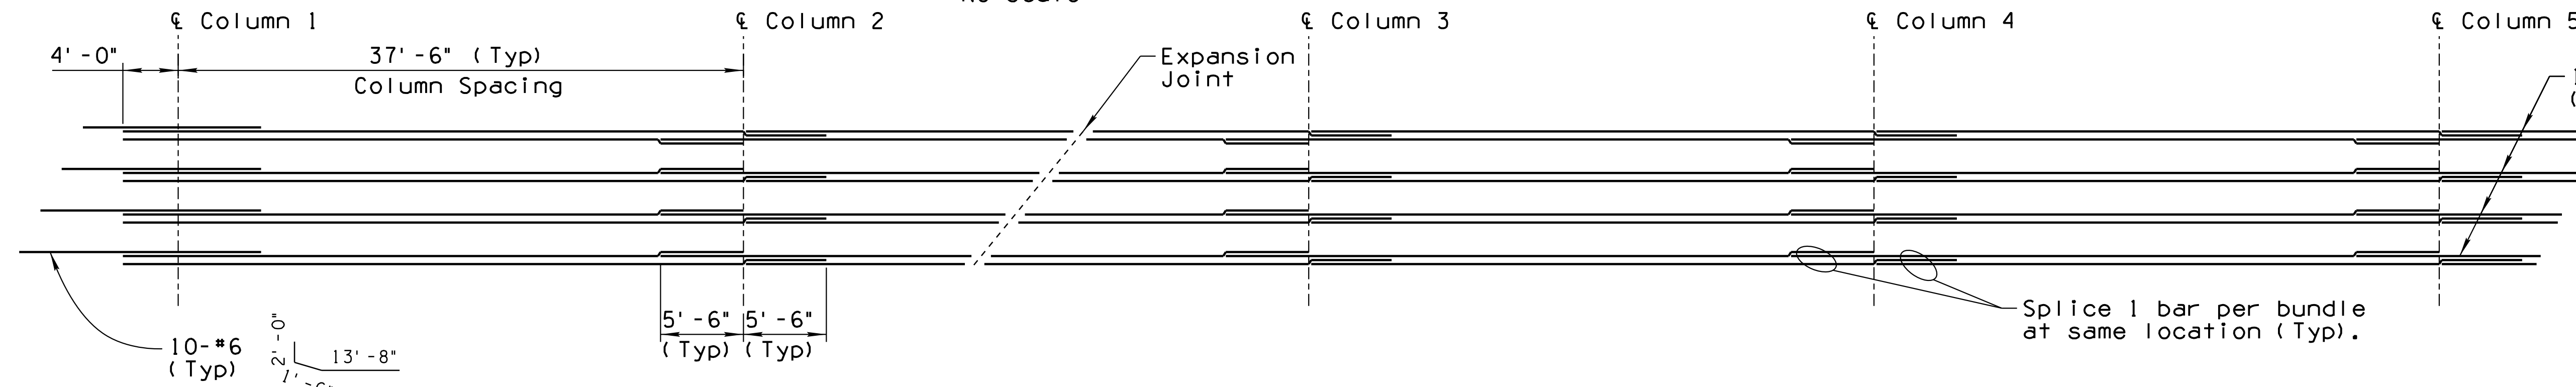

NOTE:  
Max Bar length for Bottom of Pier Cap Reinforcing is 47'-0"  
Not all bars are shown.

LAP SPLICE DETAIL BOTTOM OF PIER CAP (Schematic)  
No Scale

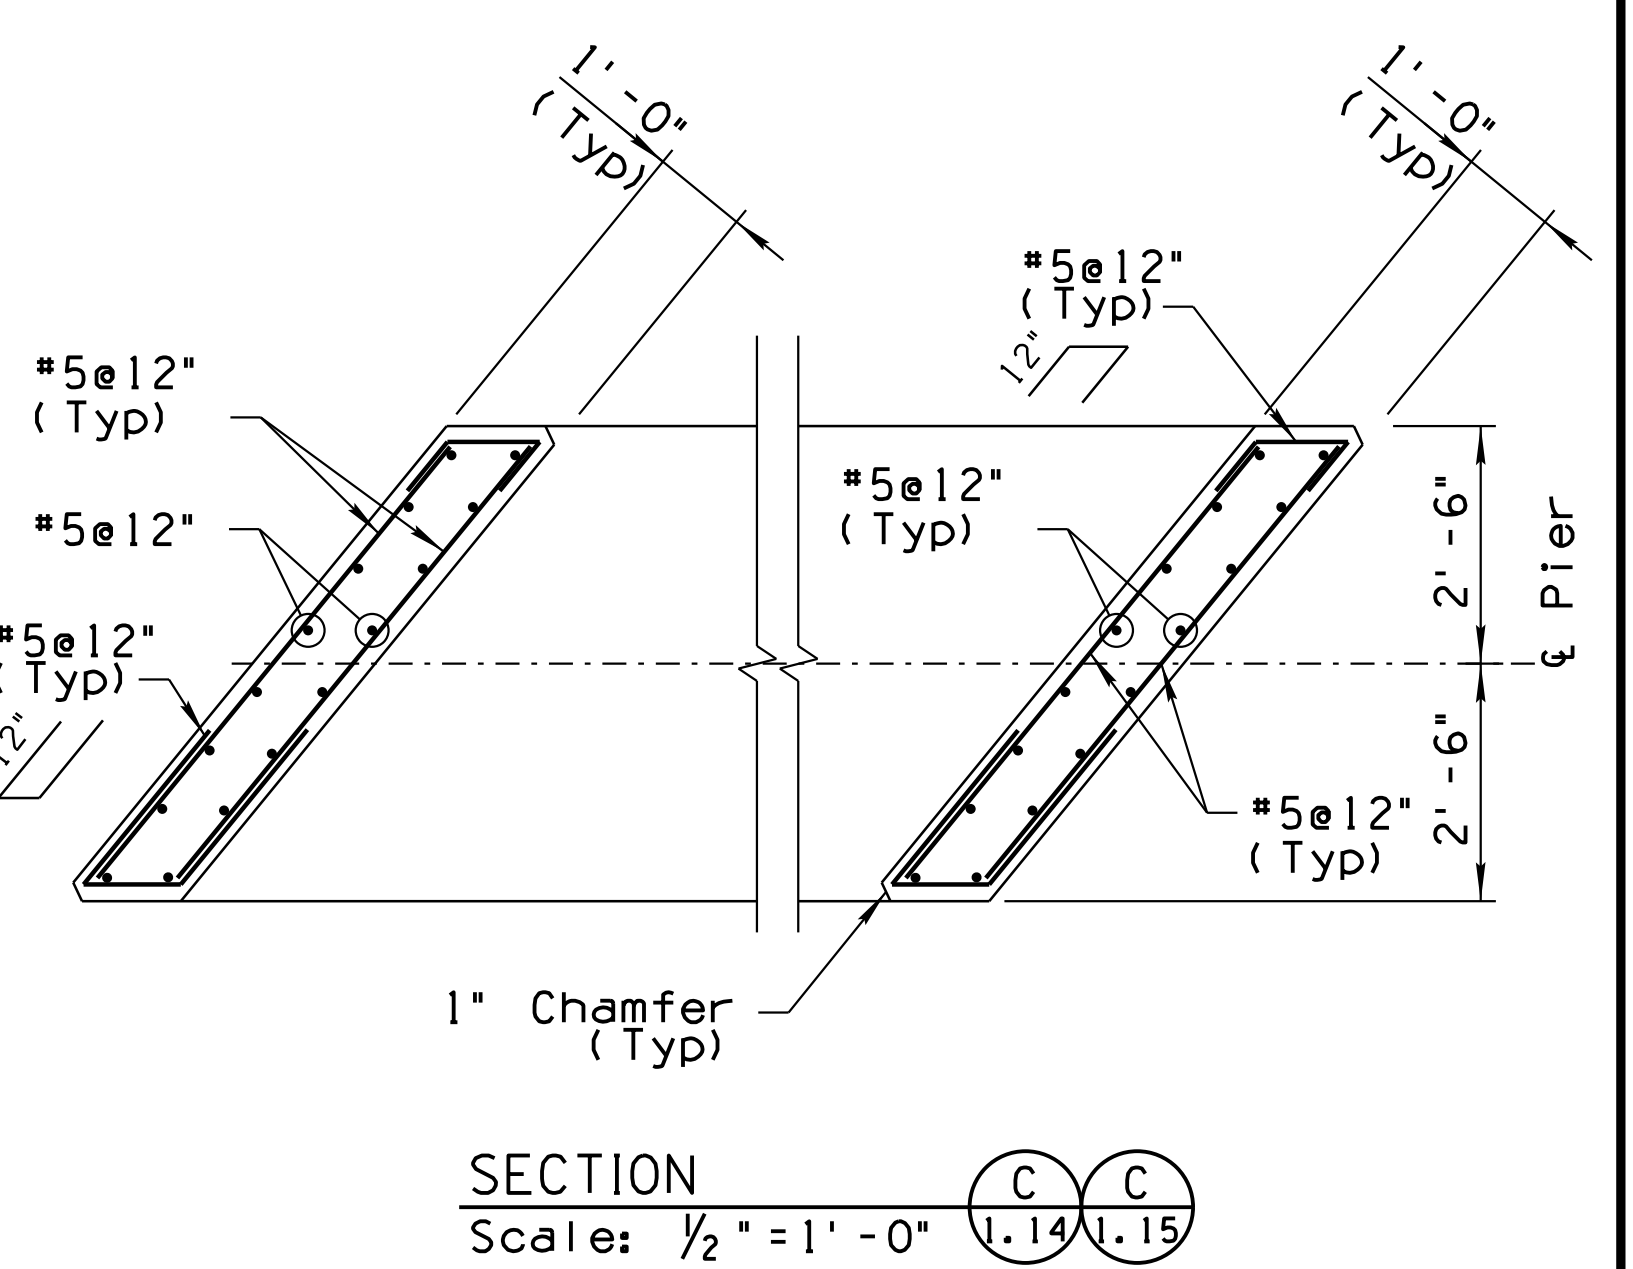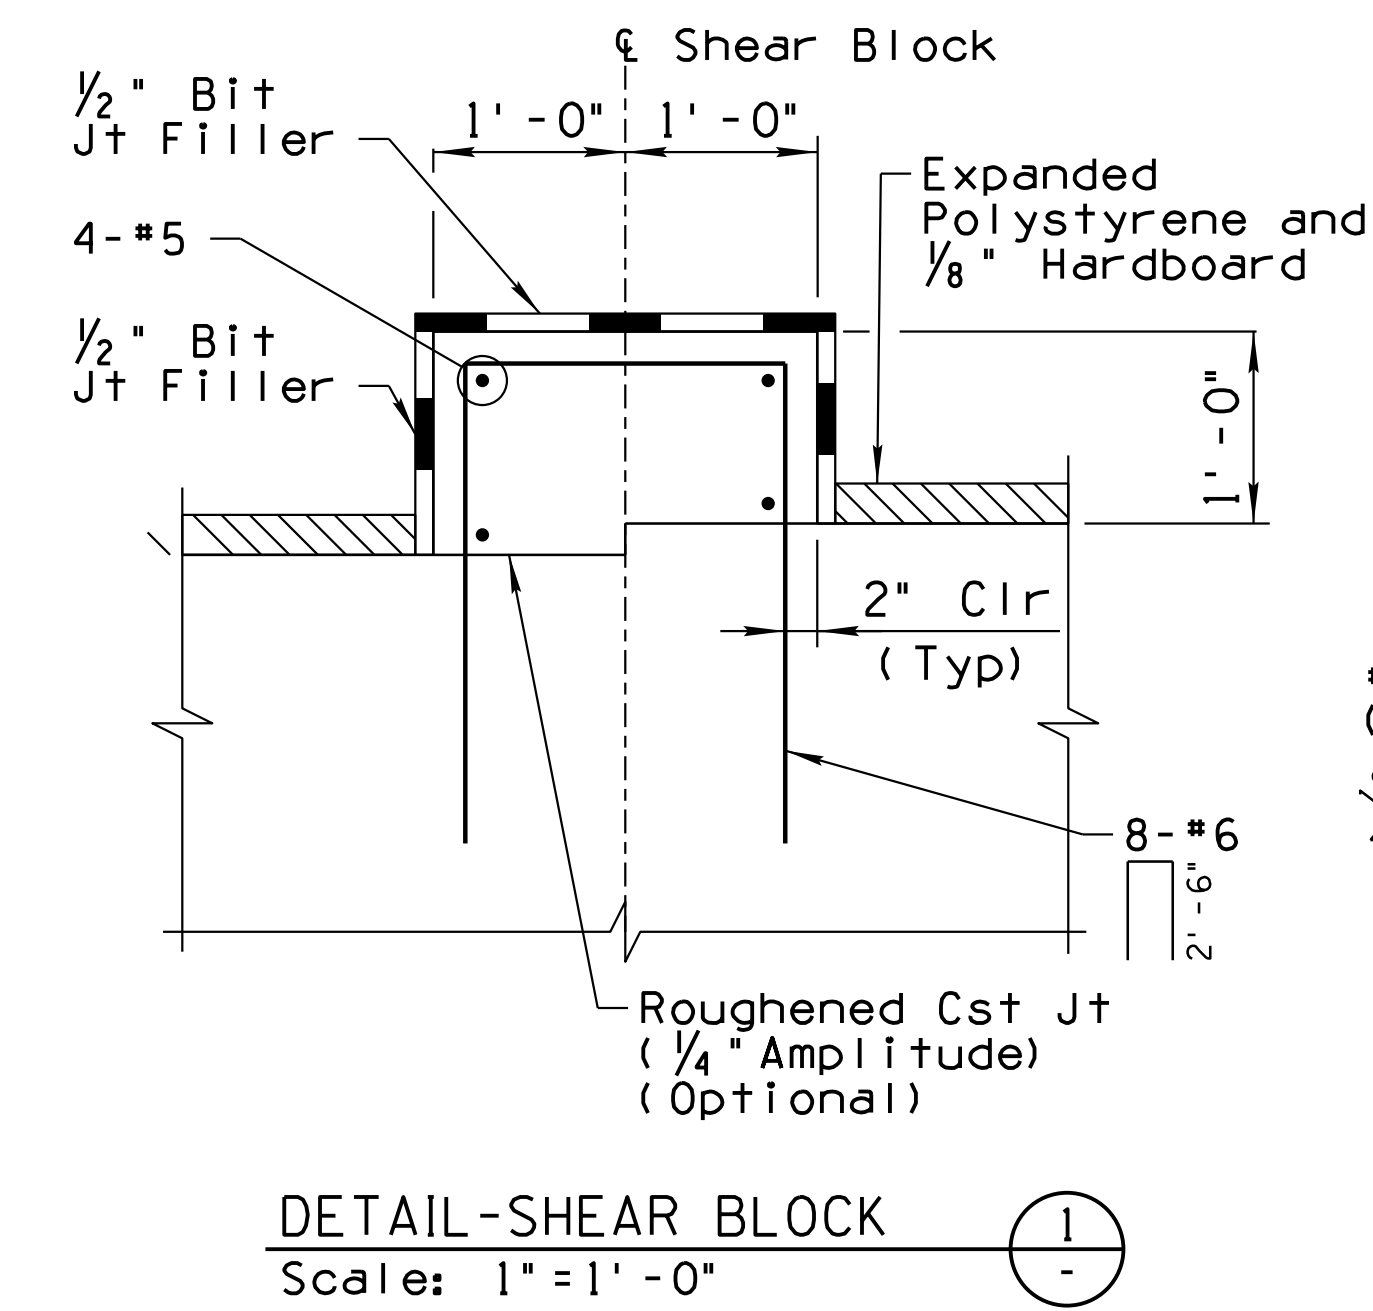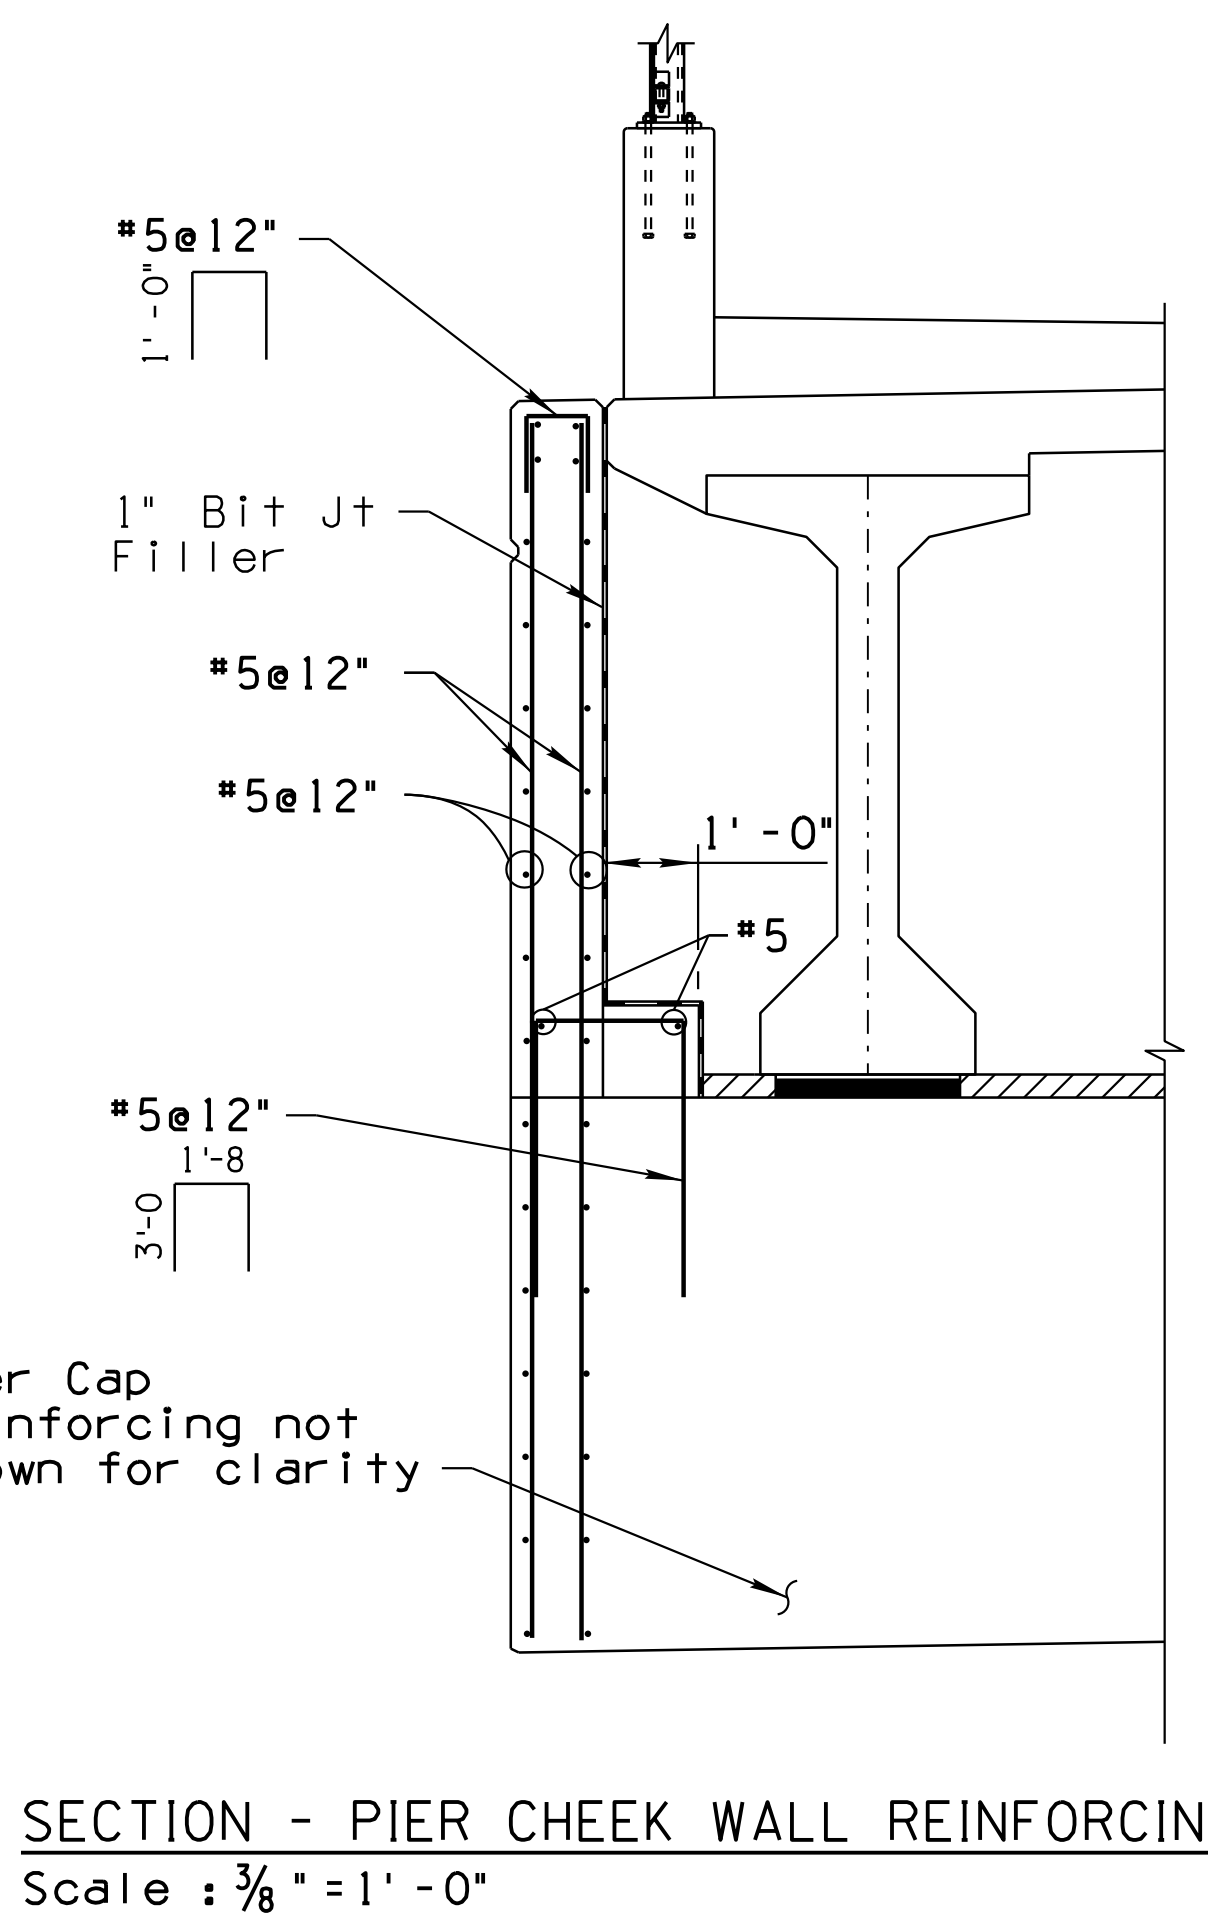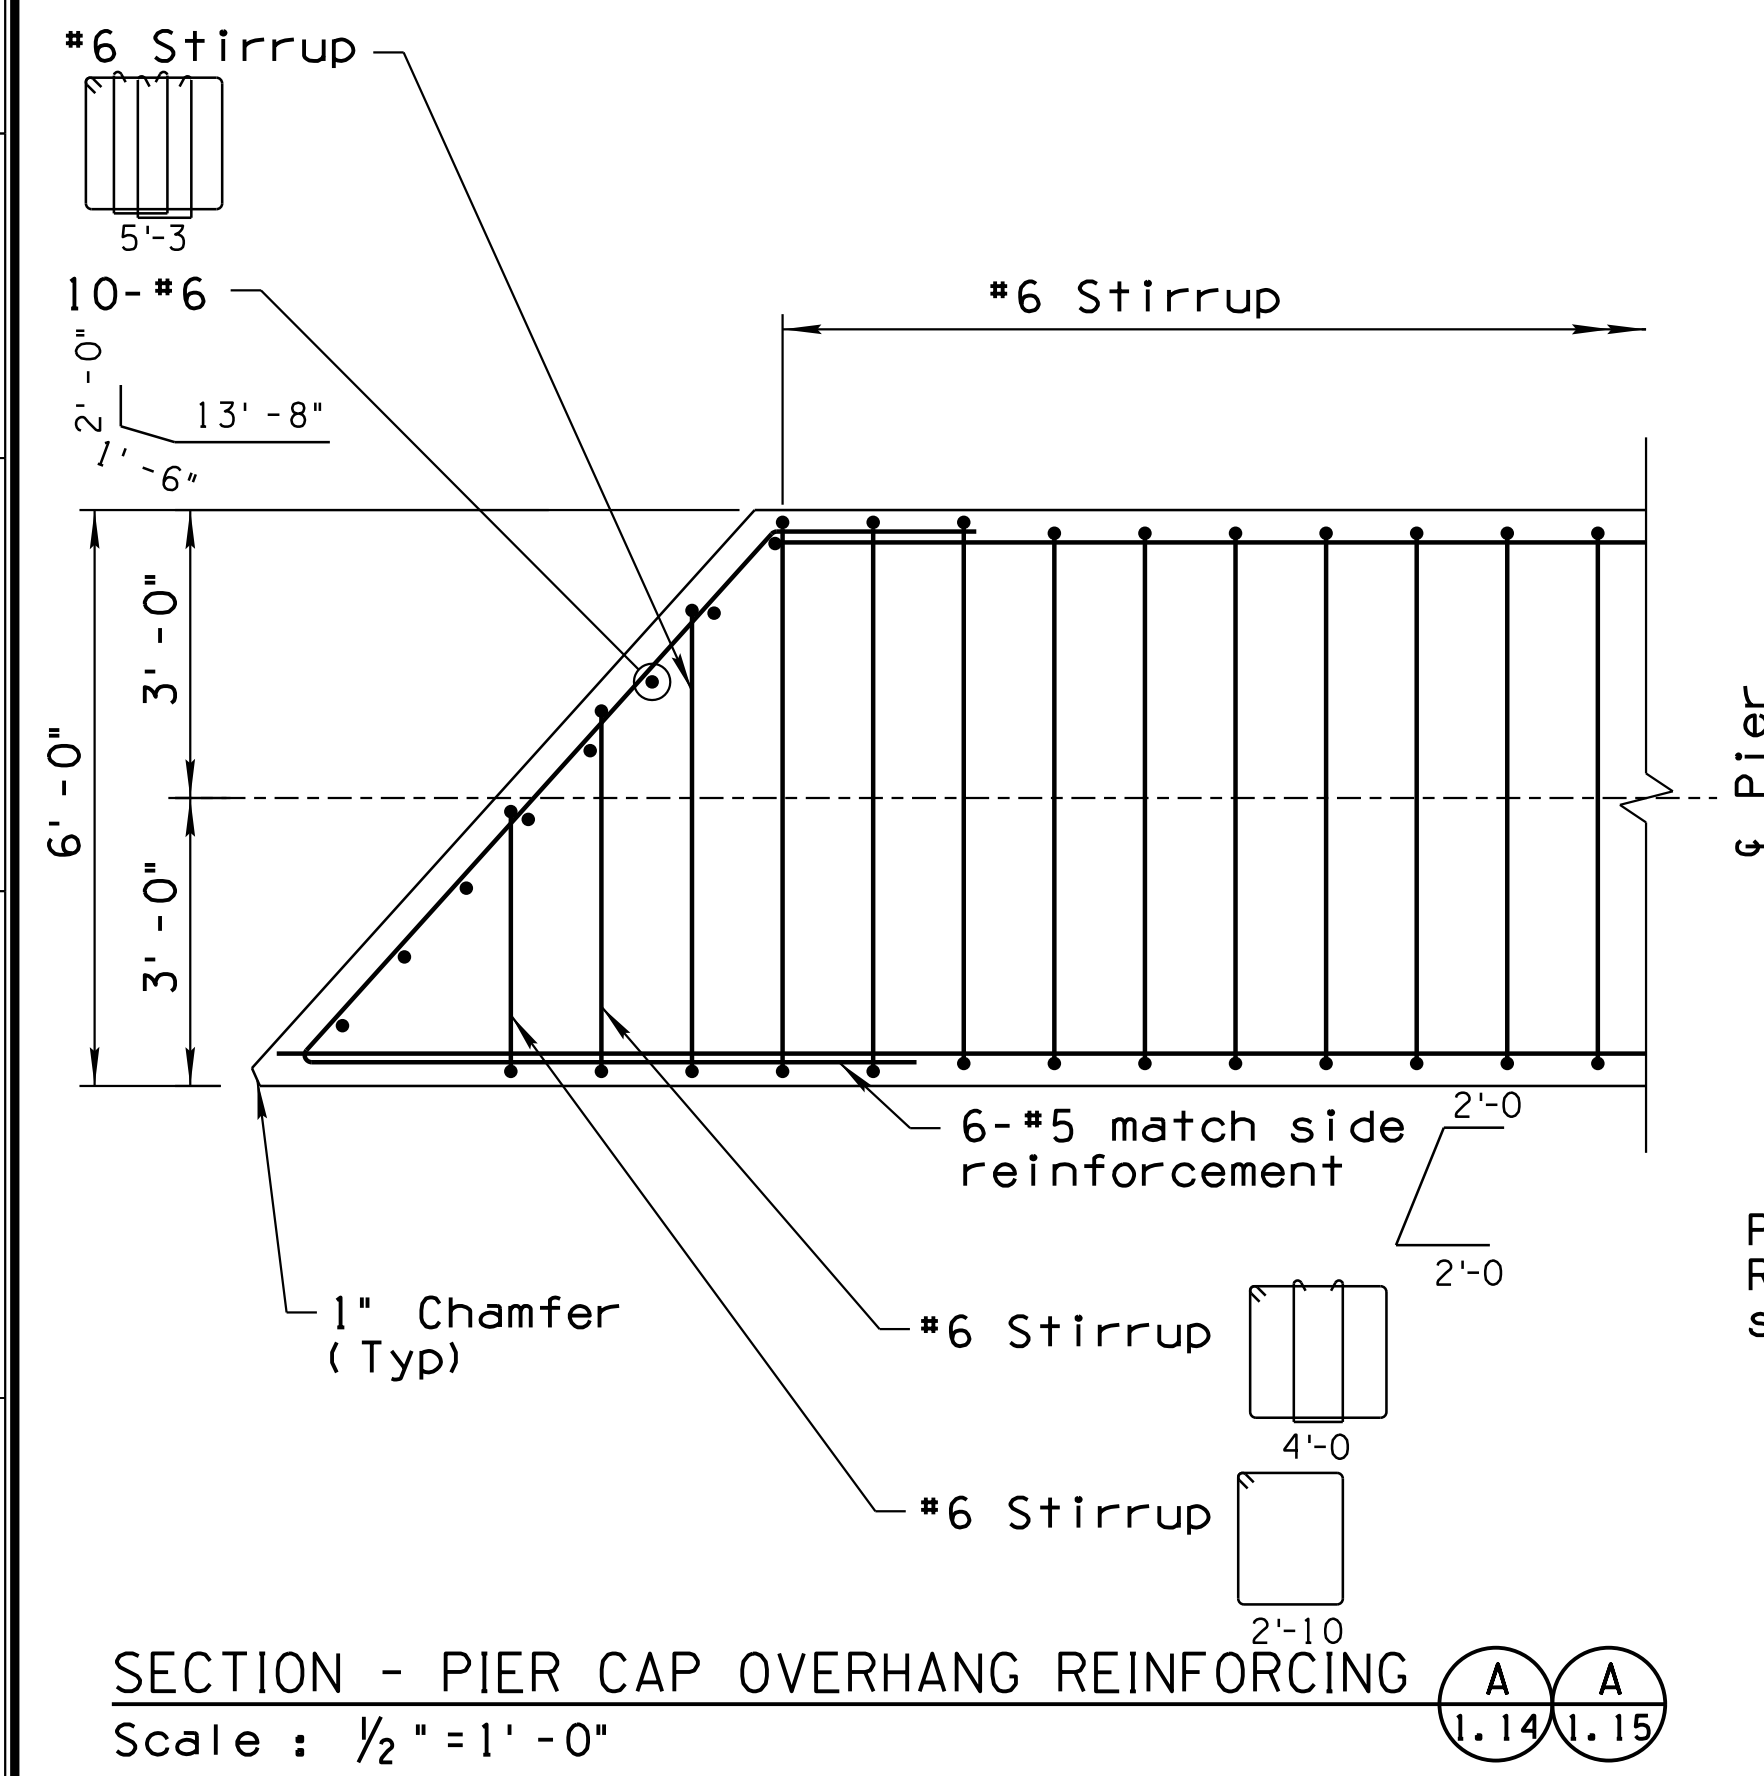


DESIGN	LES / HV	DATE	3-19	ARIZONA DEPARTMENT OF TRANSPORTATION INFRASTRUCTURE DELIVERY AND OPERATIONS DIVISION BRIDGE GROUP STA 99+ RUTHRAUFF ROAD T.I. UNDERPASS PIER DETAILS 3		
DRAWN	DAY	DATE	3-19			
CHECKED	AGG / JAC	DATE	3-19			
ROUTE	252.00	STRUCTURE NO.	20159	LOCATION	RUTHRAUFF ROAD T.I.	
TRACS NO.	H 8480 OIC				010-D(213)S	
					DWG NO.	S-1.18
						OF






F.H.W.A. REGION	STATE	PROJECT NO.	SHEET NO.	TOTAL SHEETS	RECORD DRAWING
9	ARIZ.	010-D(213)S	633	849	

010 PM 252

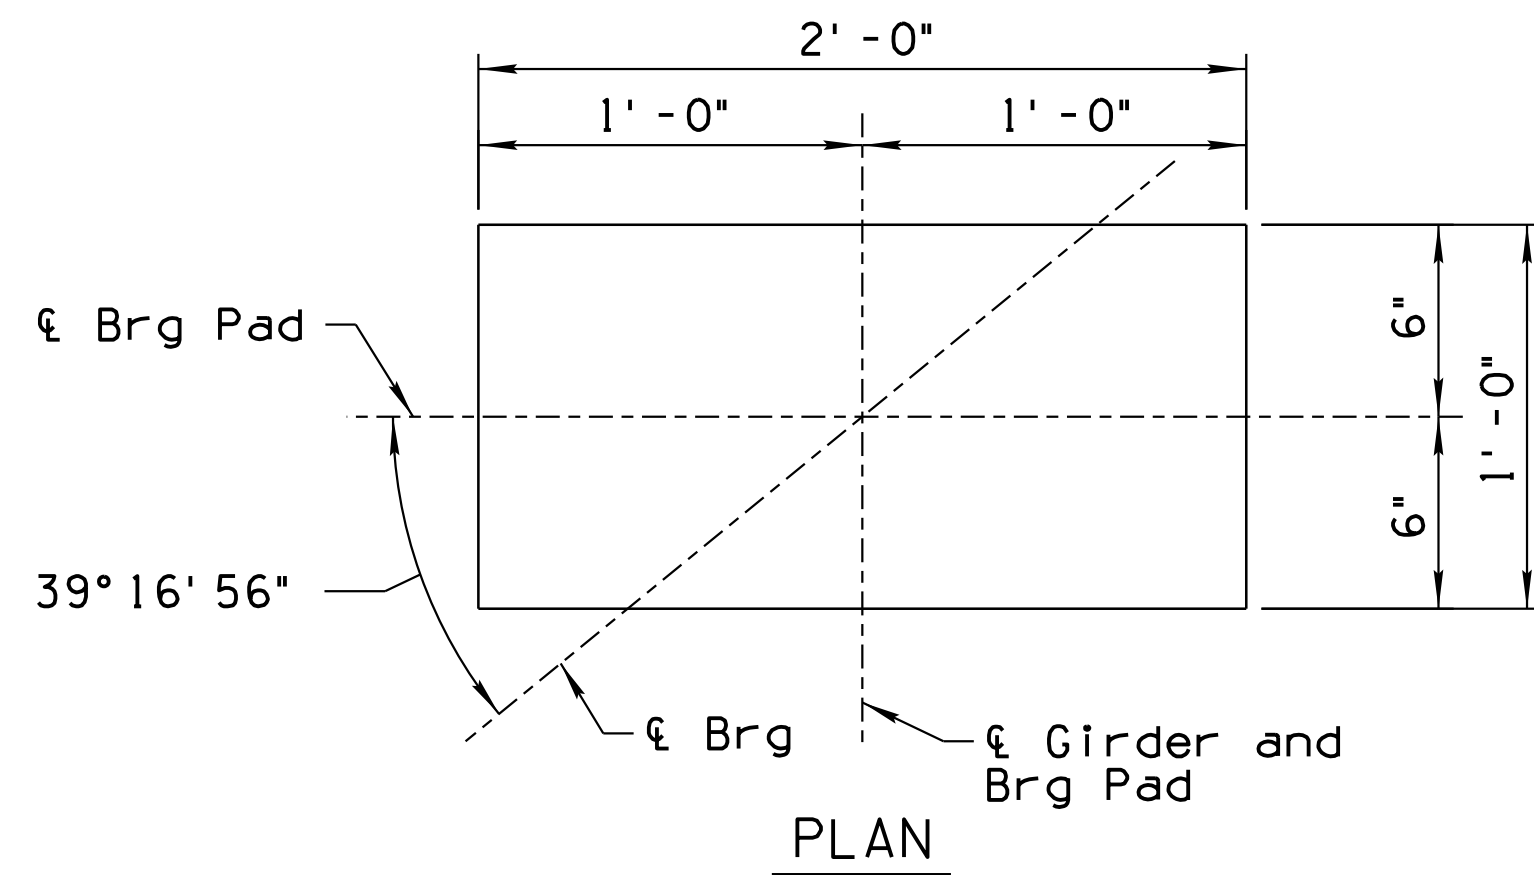


PLAN

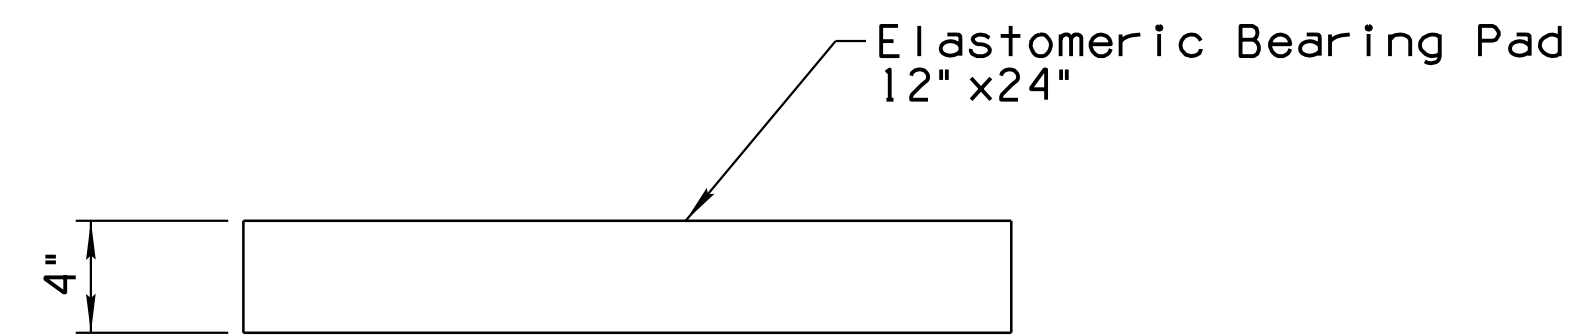


ELEVATION

DETAIL - ELASTOMERIC BEARING PAD 1

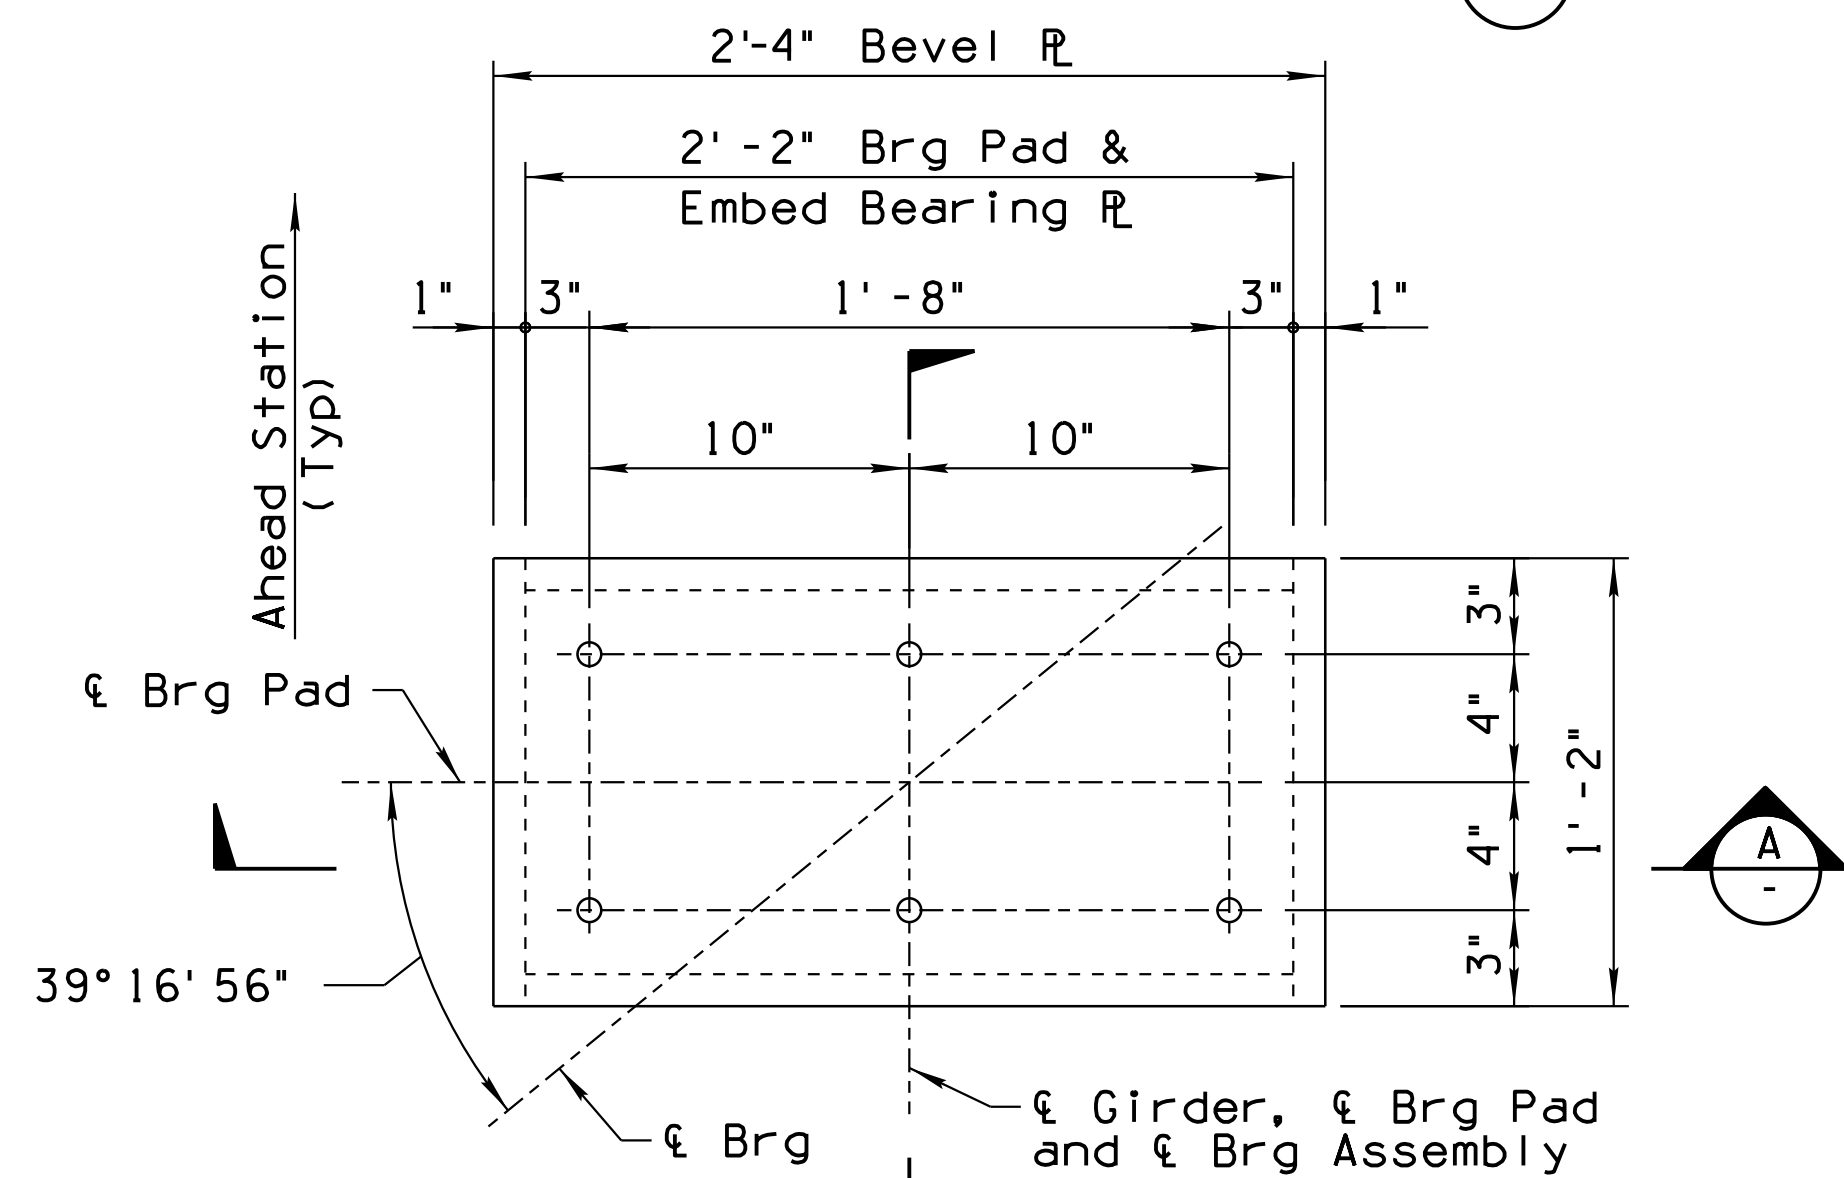


DETAIL - BEARING ASSEMBLY 2

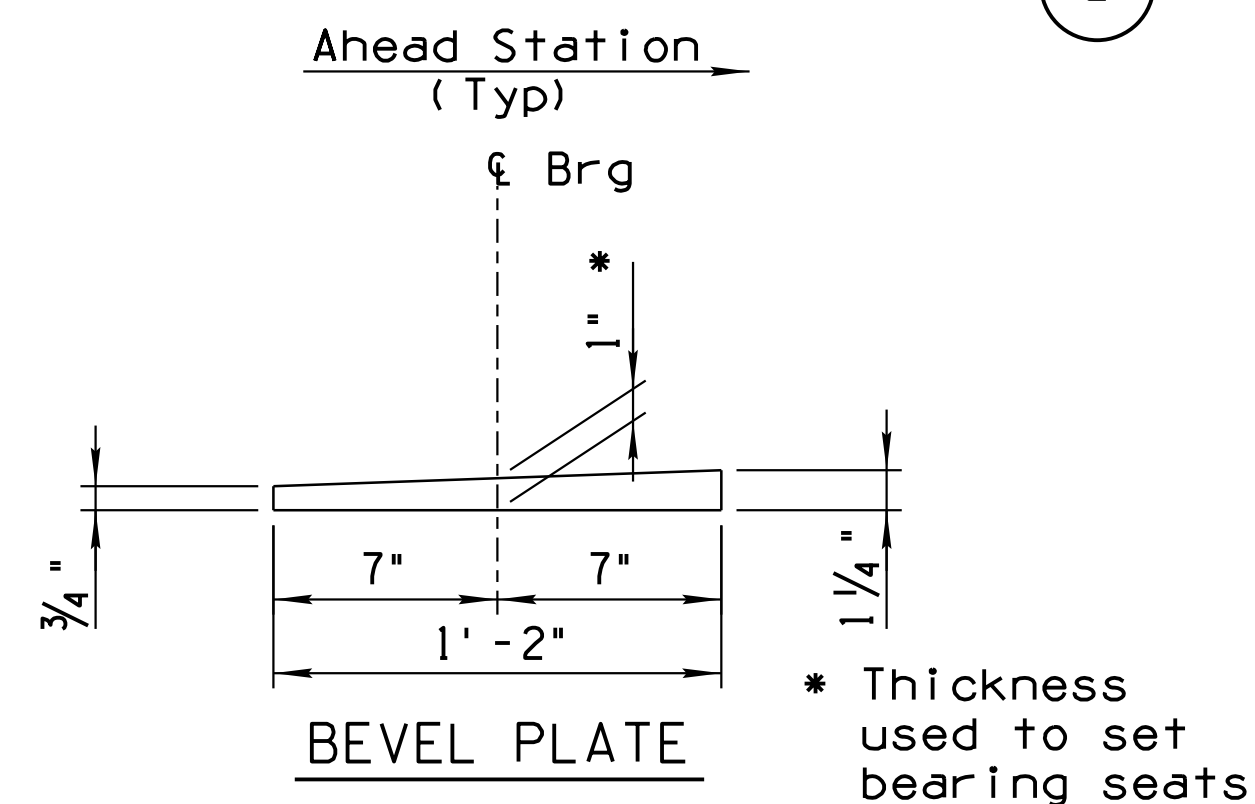

SECTION

Scale: 1/2" = 1'-0"

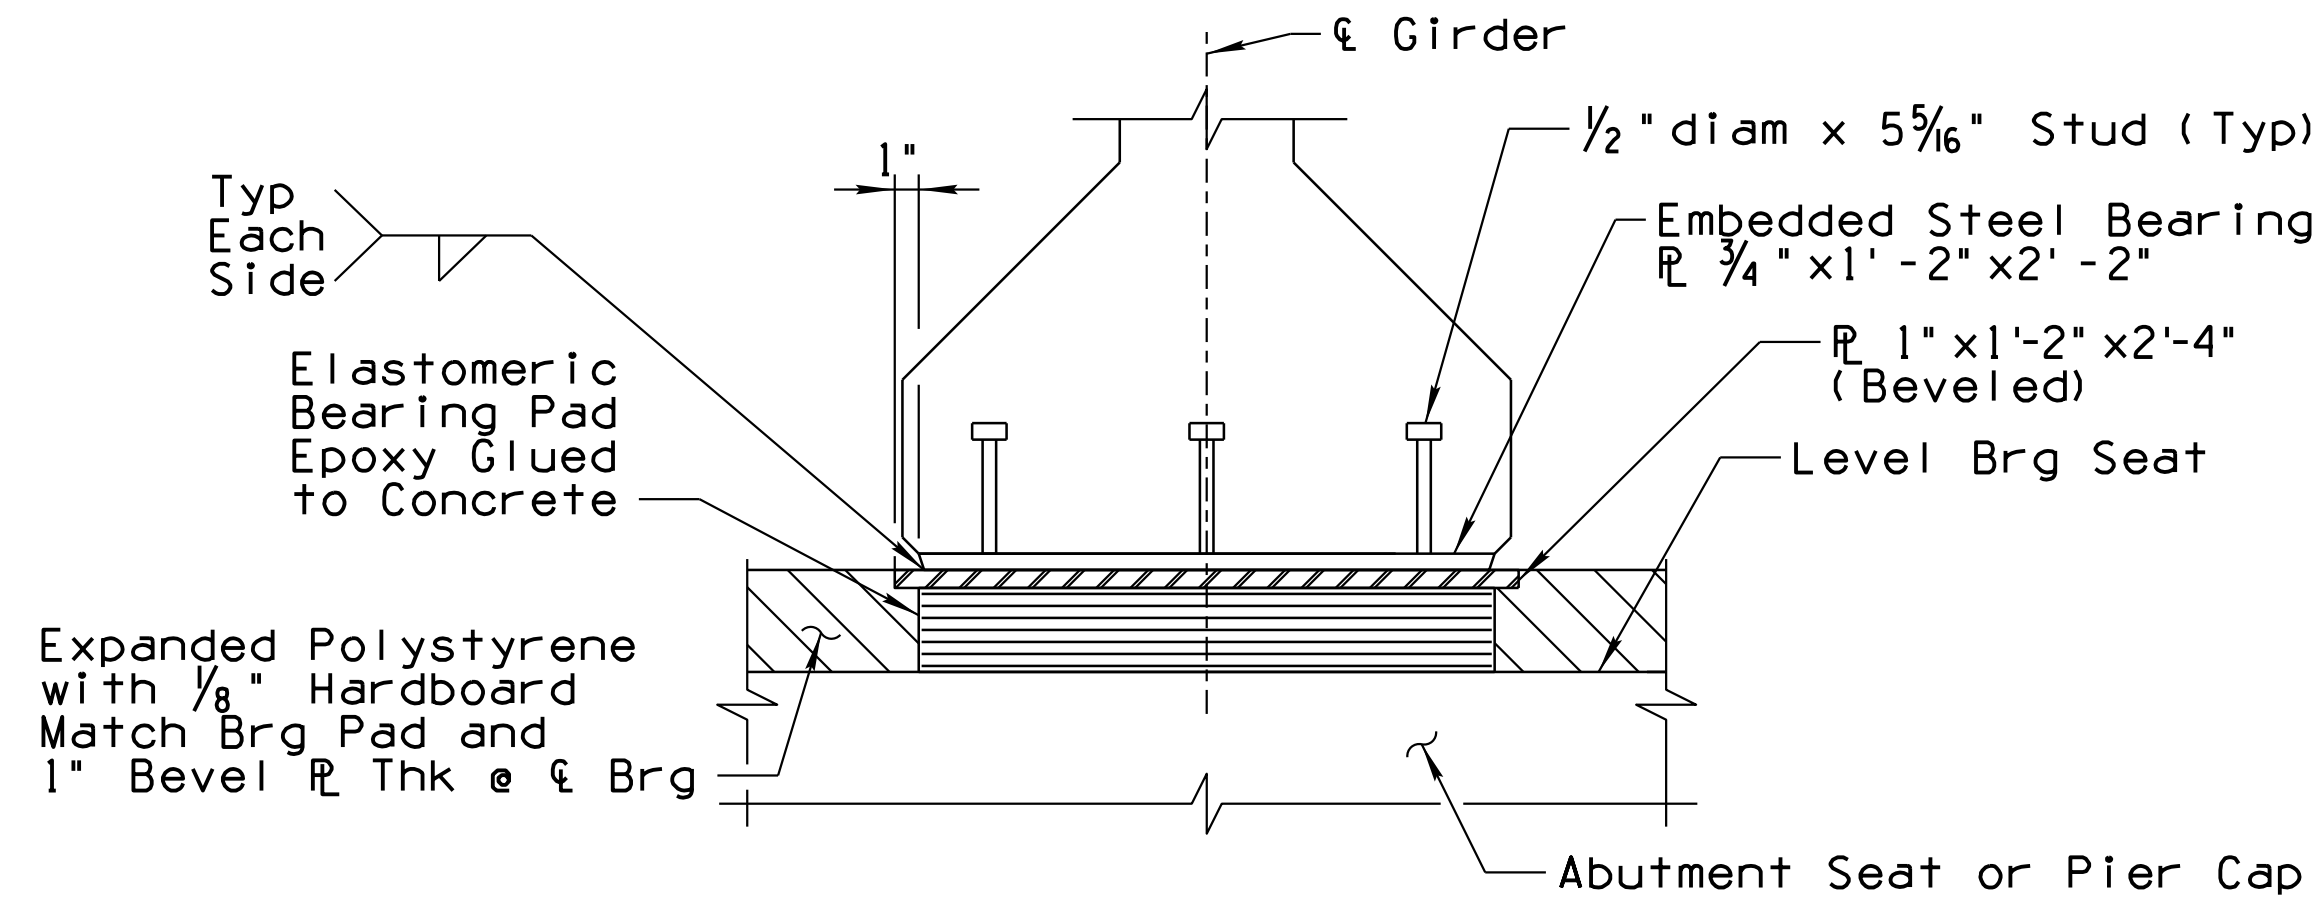

SECTION

Scale: 1/2" = 1'-0"

**ELASTOMERIC BEARING PAD NOTES:**

1. Install bearing Pads Level.
2. Bearing pads shall be steel reinforced and have a Shear Modulus of G=130 psi at 73°F, and a mean durometer hardness of 55.
3. Bearing Design Method A.
4. Max Design Loads Service DL=182 Kips  
Service DL+LL ( No impact )=324 Kips
5. Elastomeric Grade 0.
6. Low Temperature Zone A.
7. Elastomeric bearing pads shall be 100% virgin chloroprene and conform to AASHTO material specification M251. Elastomeric bearing pads shall be reinforced with steel reinforcement.
8. Use Structural Steel conforming to AASHTO M270 Grade 36 for bearing plate and bevel plate. Galvanize according to AASHTO M111 after fabrication.
9. Minimum in service rotational capacity = 0.01 rad.
10. Seal all openings around bearing to prohibit concrete intrusion under bottom girder flange and sliding surface.

DESIGN	NAME	DATE	ARIZONA DEPARTMENT OF TRANSPORTATION INFRASTRUCTURE DELIVERY AND OPERATIONS DIVISION BRIDGE GROUP
DESIGN	LES / HV	3-19	
DRAWN	DAY	3-19	
CHECKED	AGG / JAC	3-19	<b>WSP</b> <small>WSP USA, Inc. 177 N. Church Avenue Suite 1105 Tucson, AZ 85701</small>
I-10 ROUTE    252.00 MILEPOST    20159 STRUCTURE NO.			
TRACS NO. H 8480 OIC			STA 99+ <b>RUTHRAUFF ROAD T.I. UNDERPASS            BEARING PAD DETAILS</b>
LOCATION <b>RUTHRAUFF ROAD T.I.</b>			EXPIRES 3/31/2019 DWG NO. S-1.20
010-D(213)S			<b>OF</b>







F.H.W.A. REGION	STATE	PROJECT NO.	SHEET NO.	TOTAL SHEETS	RECORD DRAWING
9	ARIZ.	010-D(213)S	636	849	

010 PM 252

**PRESTRESSING NOTES:**

**CONCRETE**

f'ci = 6000 psi minimum concrete strength at transfer.  
f'c = 7500 psi minimum concrete strength at 28 days.

The contact surface of the top flange shall be intentionally roughened to an amplitude of approx 1/4".

The Contractor shall adjust the dimensions shown on the drawings to account for elastic shortening, creep and shrinkage occurring between the time of casting and the erection of girder.

**PRESTRESSING**

- Girders shall be prestressed by pretensioning method only.
- All low relaxation strands shall be stressed to 0.75 fpu.
- Debonding of strands will not be allowed.
- Total Jacking Force in all strands is Pjack = 2,329 Kips.
- Total Force in all strands after all losses is Pw = 1,890 Kips.

**STRANDS**





- 0.6" dia ASTM A416 grade 270, 7-Wire low relaxation prestressing strands. f's = 270,000 psi.

**GIRDER BRACING NOTE:**

The Contractor shall provide temporary bracing for the girders immediately after erection to ensure that they remain stable until the permanent intermediate diaphragms are constructed. The temporary bracing must remain in place until the intermediate diaphragms are poured and the concrete has reached the required 28-day strength. The cost of the temporary bracing shall be incidental to the cost of the girders.

**NOTES:**

- 1" diameter through sleeves shall be used for interior/exterior girders at Abutment Diaphragms and Pier Diaphragms. Threaded inserts for 3/4" diameter threaded bar shall be used for interior girders and inside face of exterior girders at Intermediate Diaphragms.
- Threaded inserts shall be ferrule loop type which develop an ultimate pullout strength of 10,800 lbs.
- All through sleeves shall be skewed to match diaphragm face.
- All dimensions shown in Typical Girder Elevation are along Girder C.
- Installation of Lifting Loops is permitted. Lifting Loops shall be used in a manner that will not cause damage, bending, or torsional forces. Lifting Loops may be cut off flush when no longer needed.
- See Sheets S-1.21 & 1.22 for Intermediate Diaphragm locations and see Sheet S-1.29 for connection details.
- See Signing Sheets for locations and installation details of signs attached to girders.

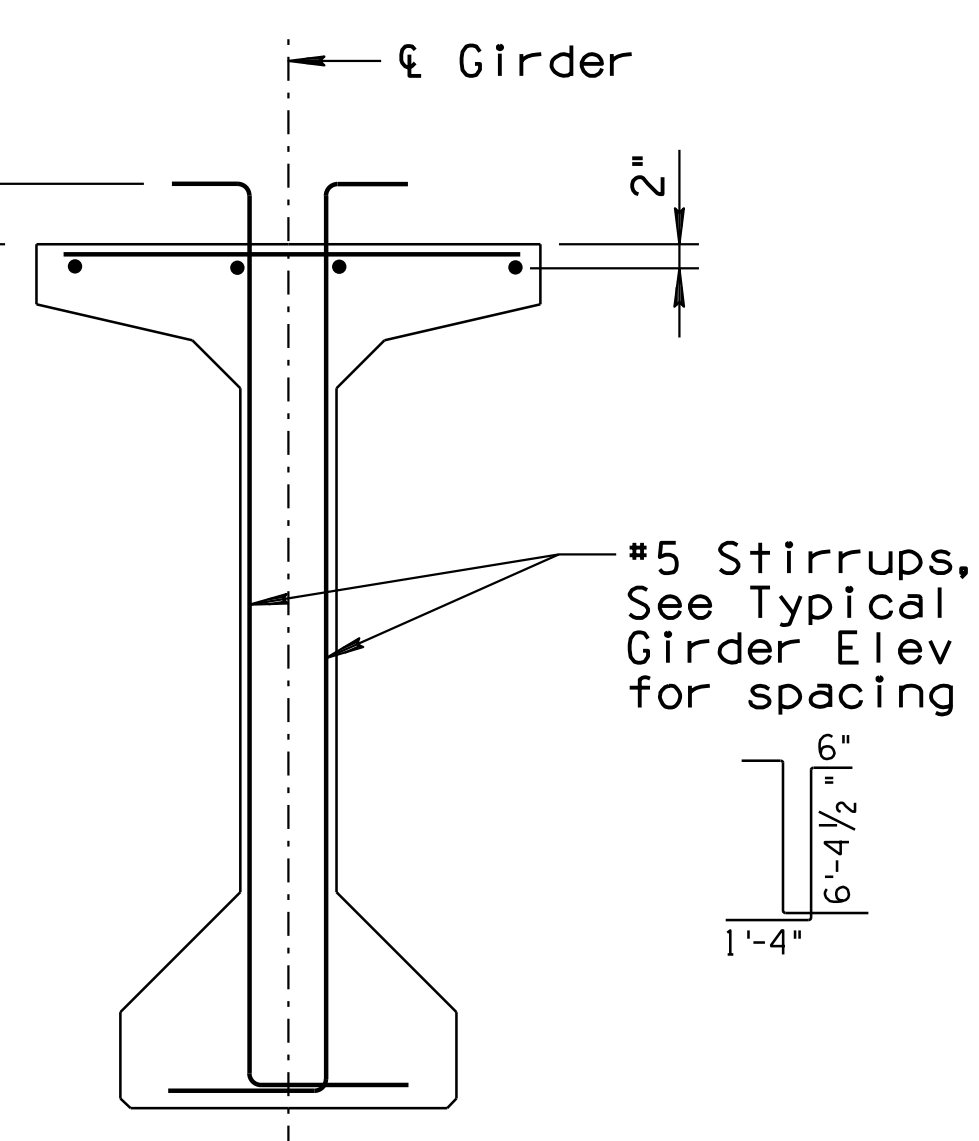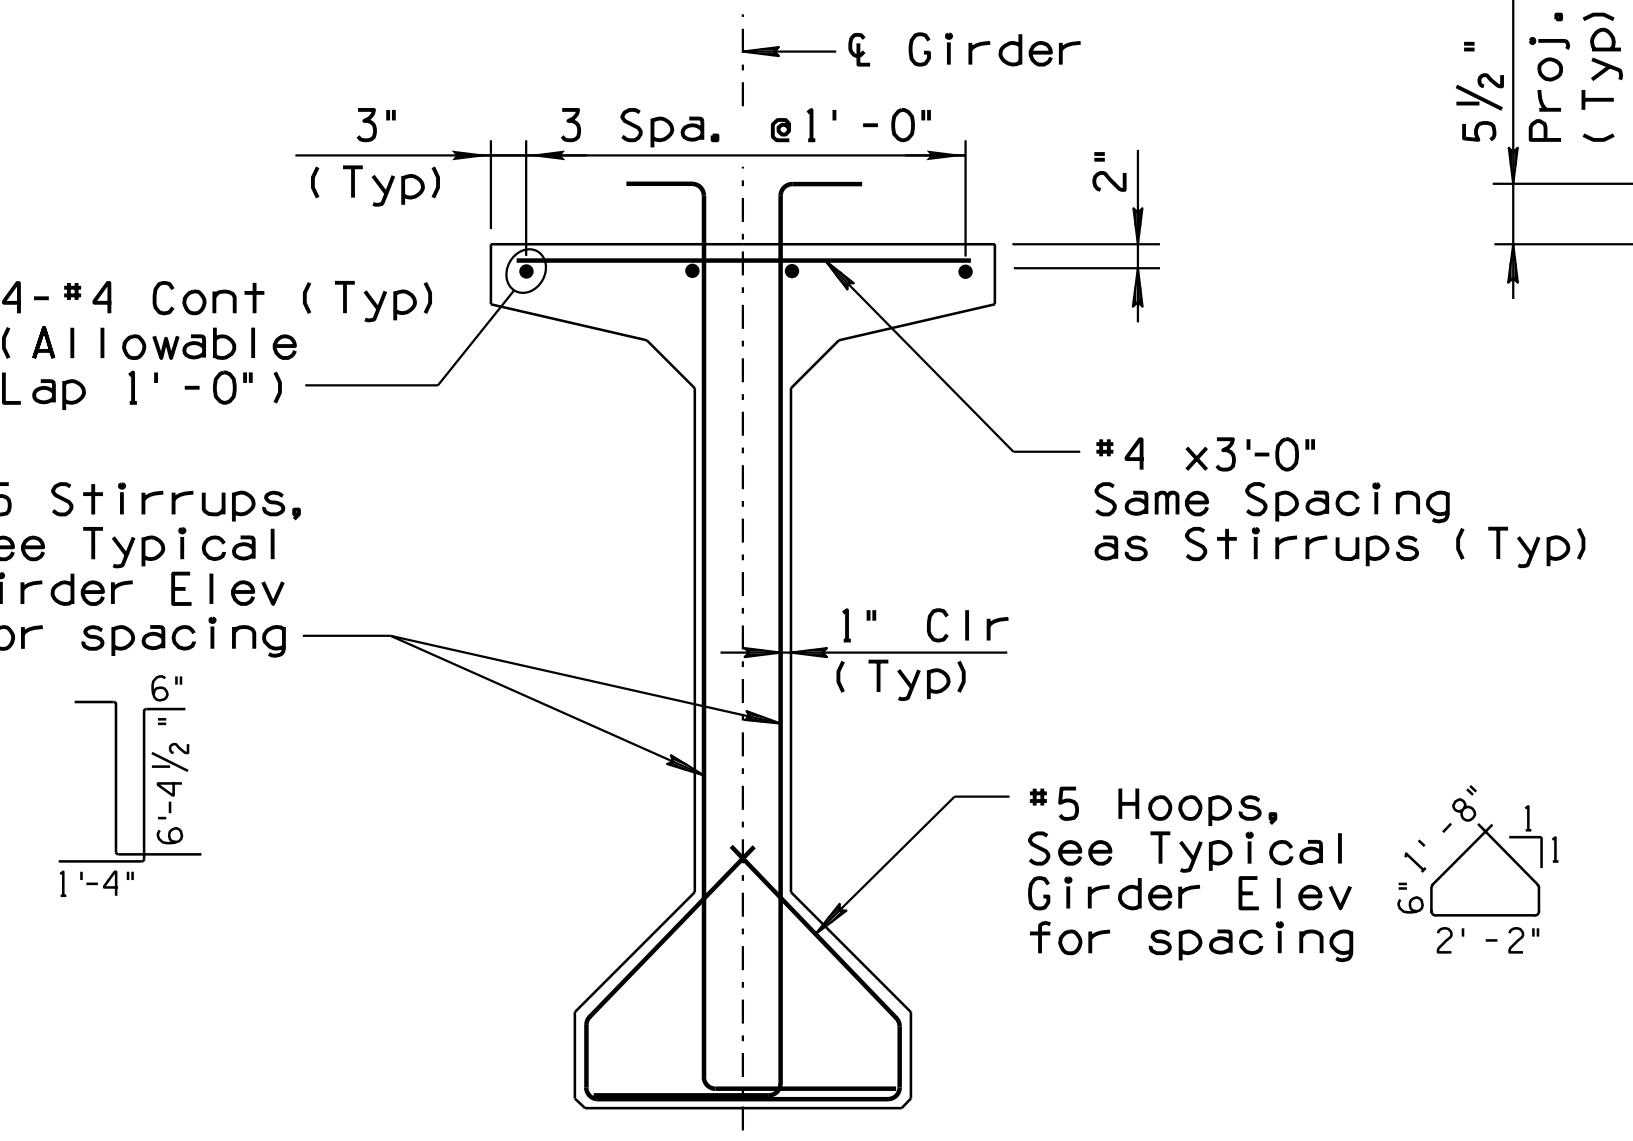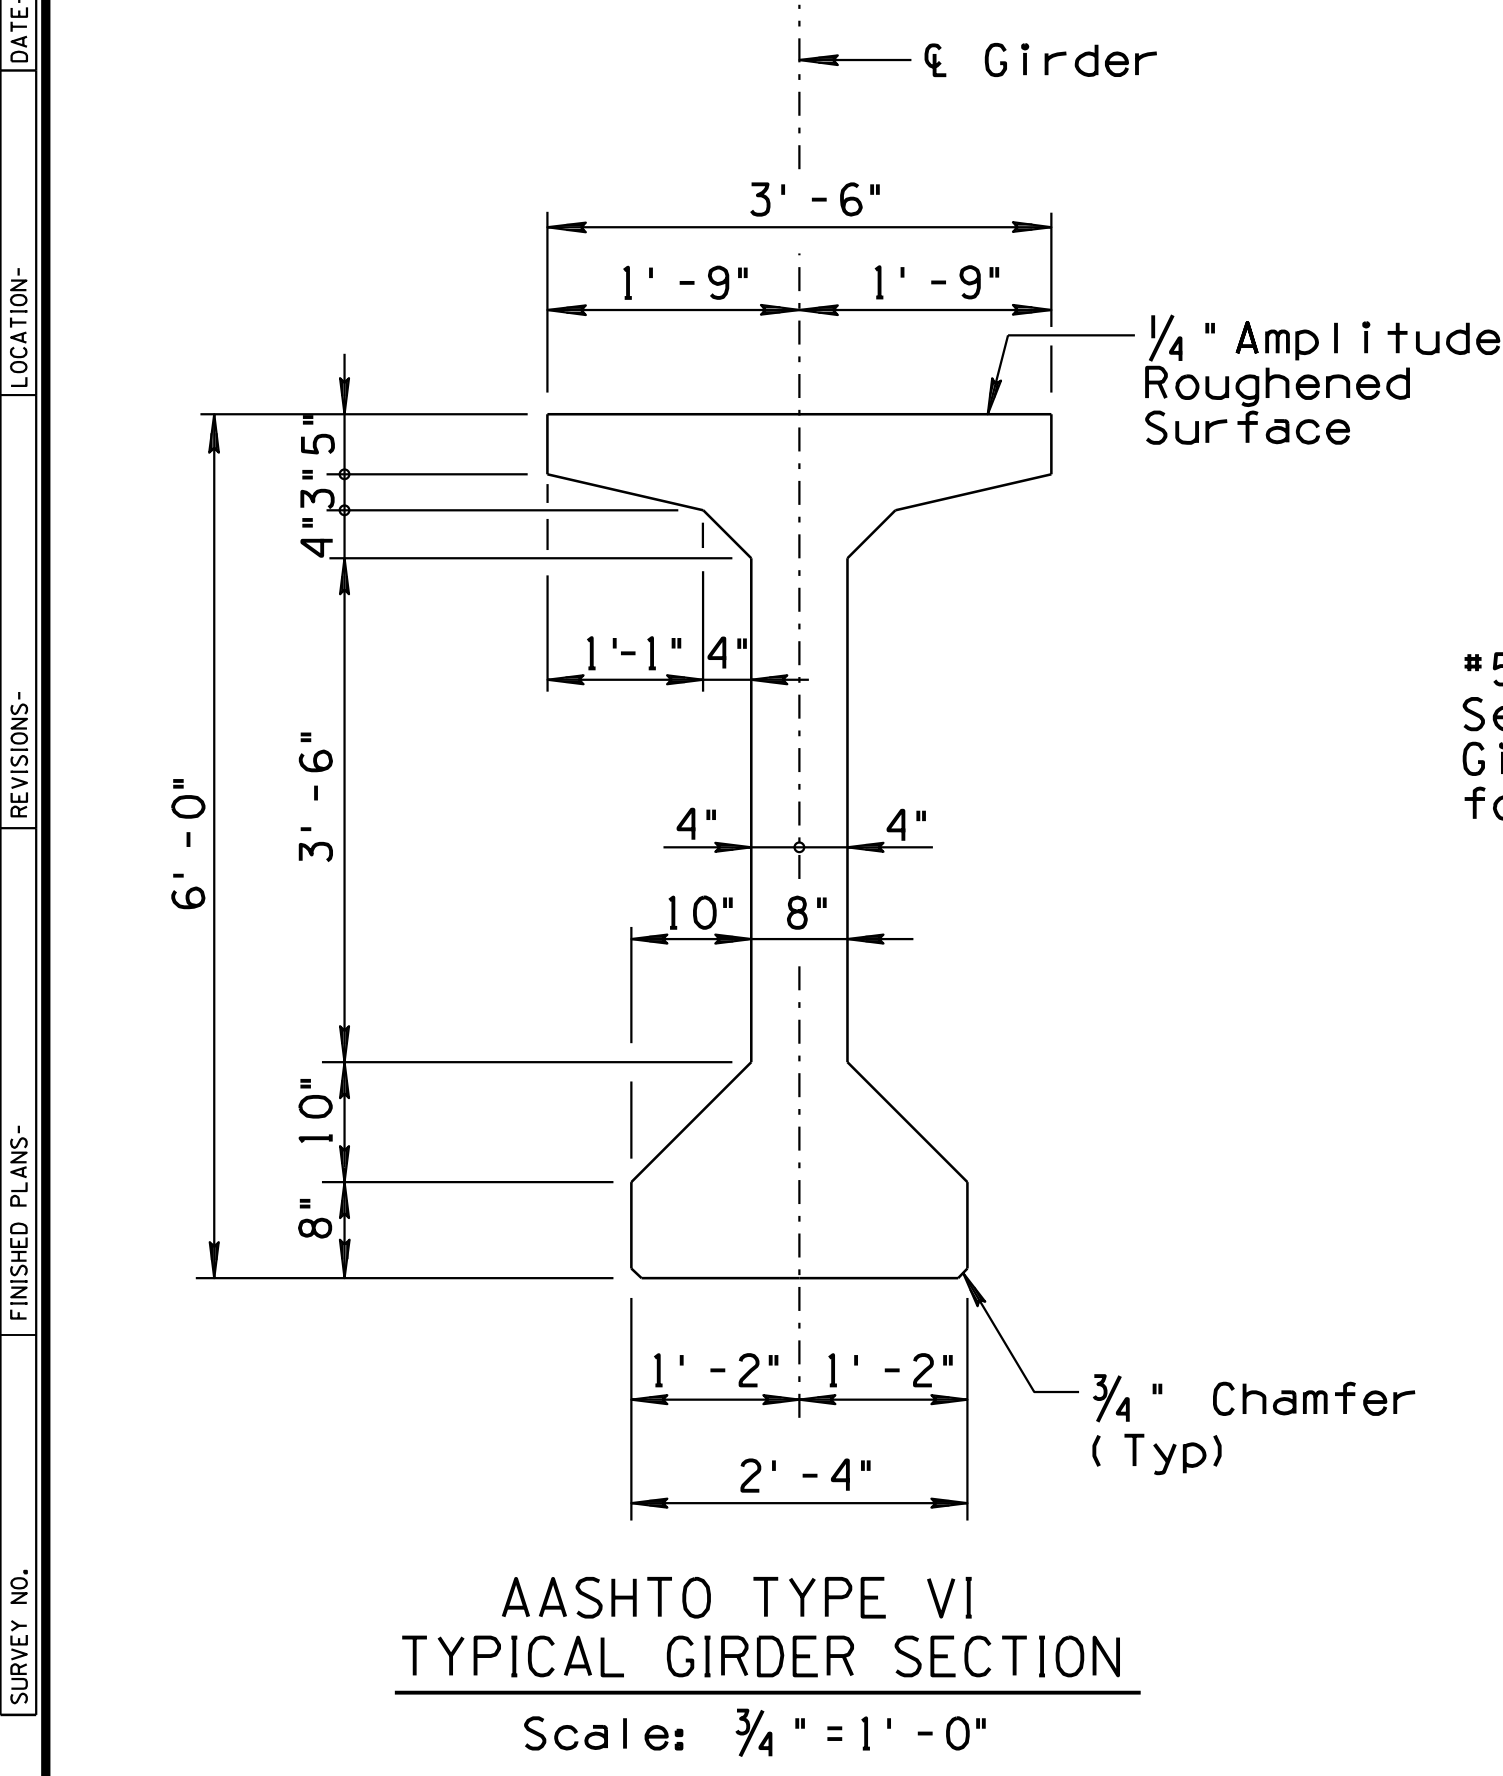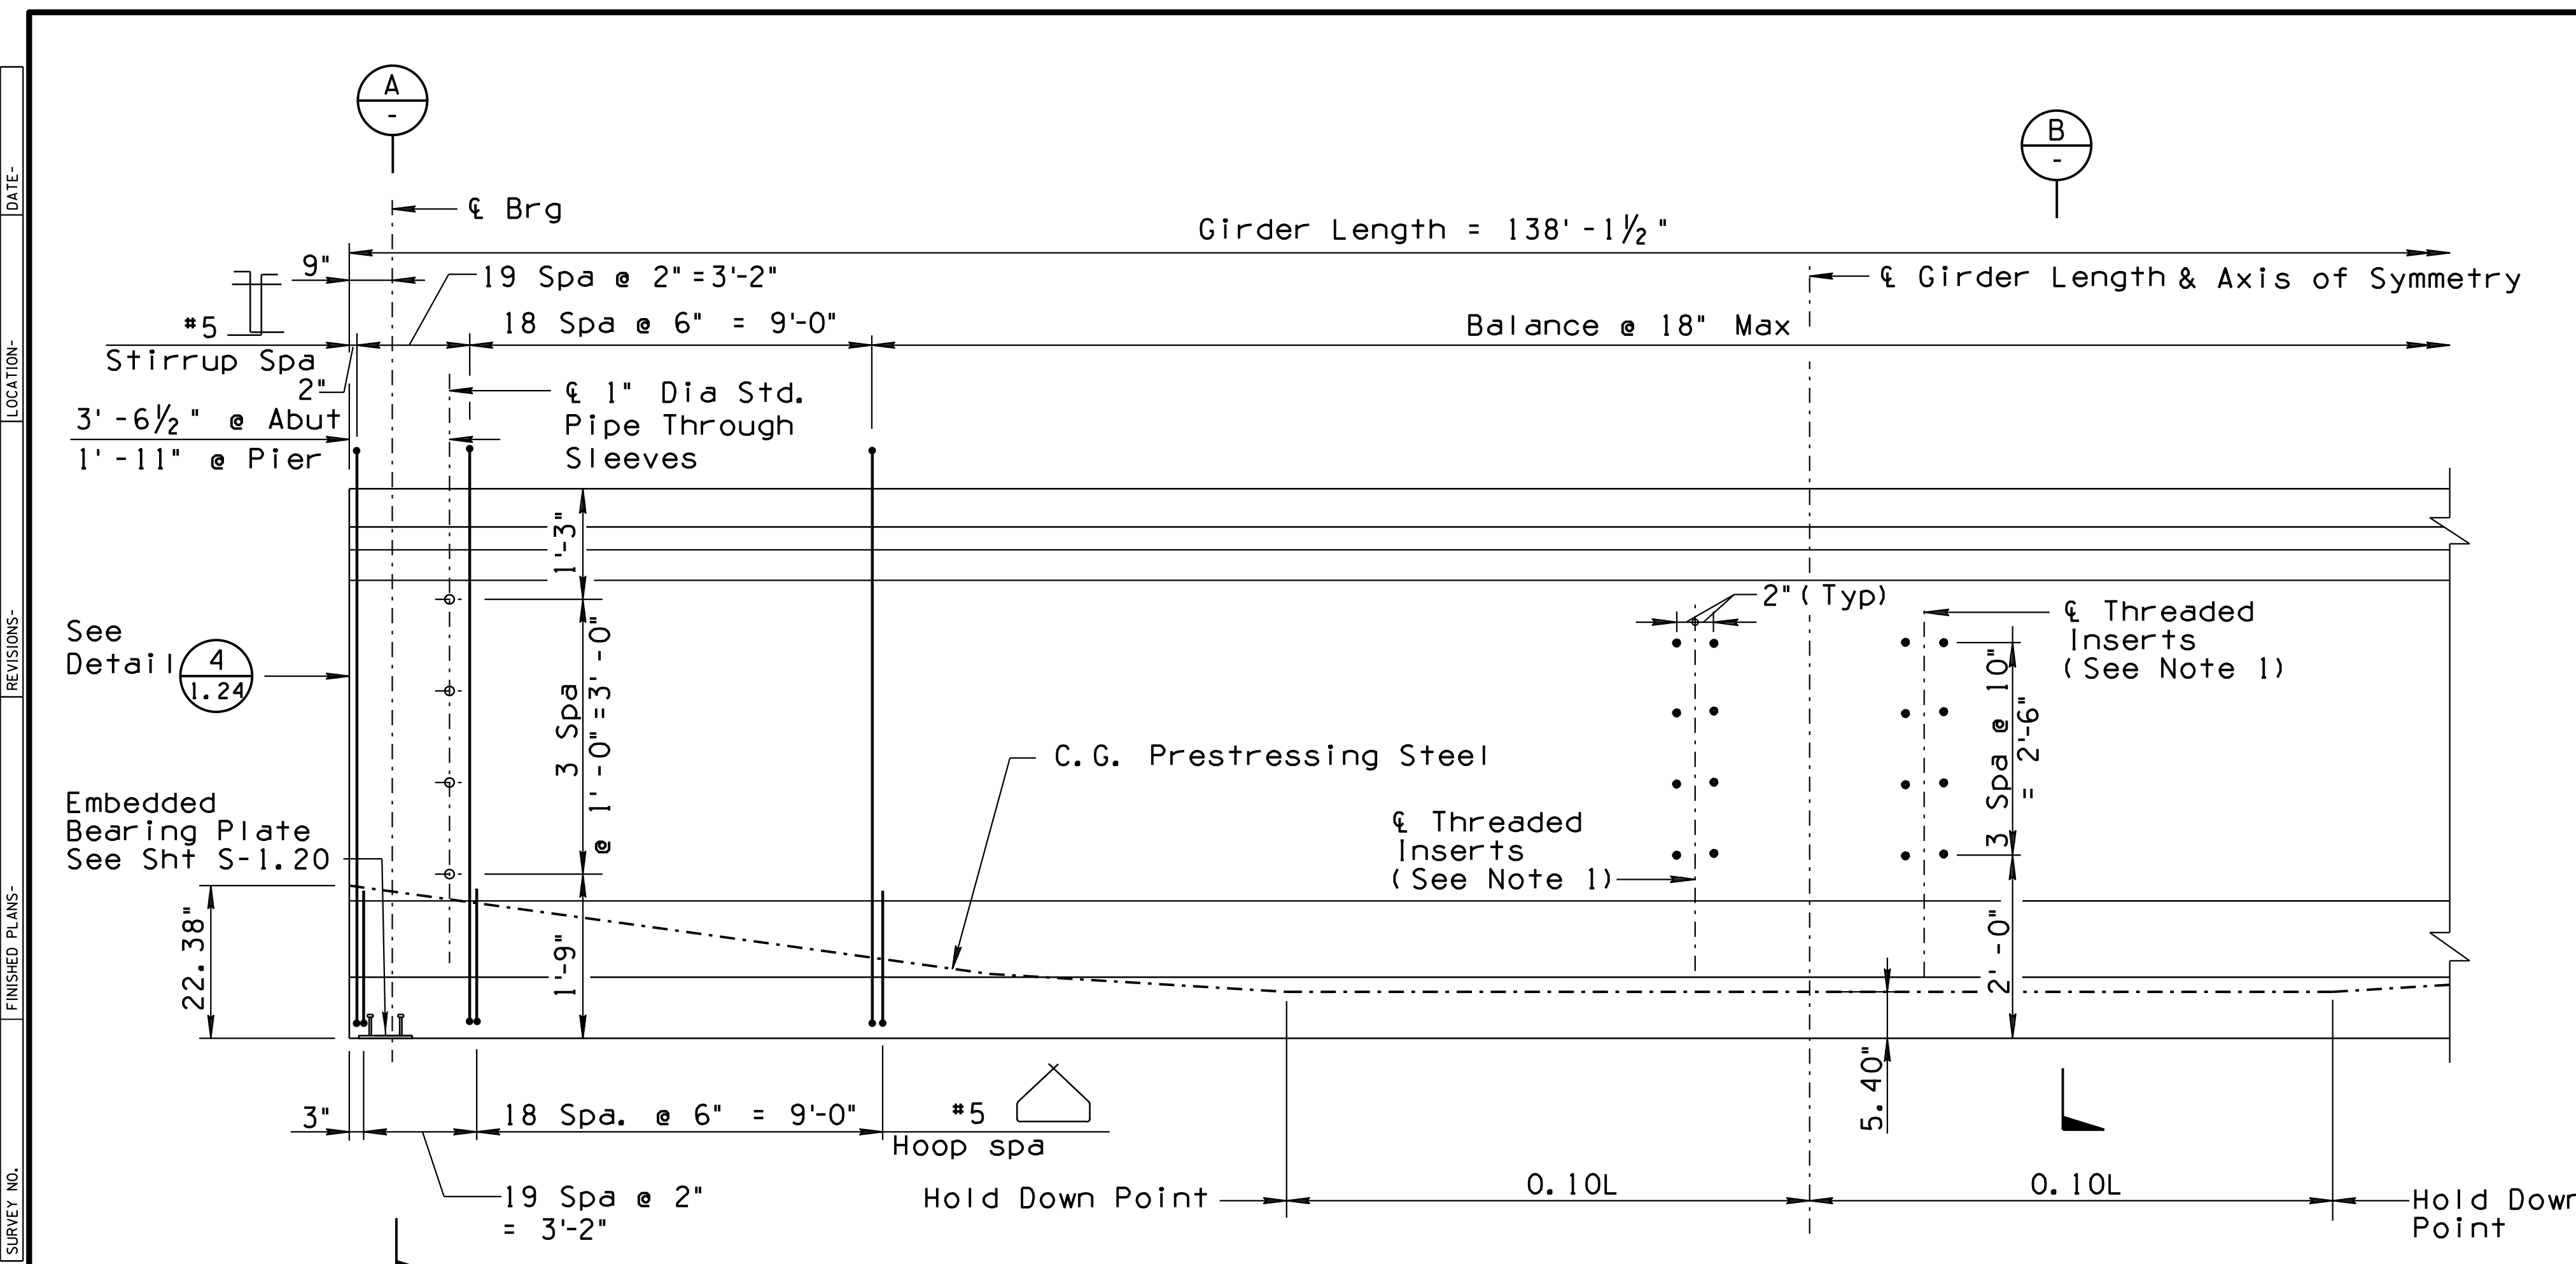


DESIGN	LES / HV	DATE	3-19	ARIZONA DEPARTMENT OF TRANSPORTATION INFRASTRUCTURE DELIVERY AND OPERATIONS DIVISION BRIDGE GROUP STA 99+ RUTHRAUFF ROAD T.I. UNDERPASS GIRDER DETAILS I	
DRAWN	DAY	DATE	3-19		
CHECKED	AGG / JAC	DATE	3-19		
WSP	WSP USA Inc. 177 N. Church Avenue Suite 1105 Tucson, AZ 85701	LOCATION	RUTHRAUFF ROAD T.I.	TRACS NO. H 8480 OIC	010-D(213)S
I-10	252.00	20159	STRUCTURE NO.		DWG NO. S-1.23
					OF


F.H.W.A. REGION	STATE	PROJECT NO.	SHEET NO.	TOTAL SHEETS	RECORD DRAWING
9	ARIZ.	010-D(213)S	637	849	

010 PM 252


REVISIONS: FINISHED PLANS: SURVEY NO.: DATE: LOCATION: DATE: REVISIONS: FINISHED PLANS: SURVEY NO.: DATE:

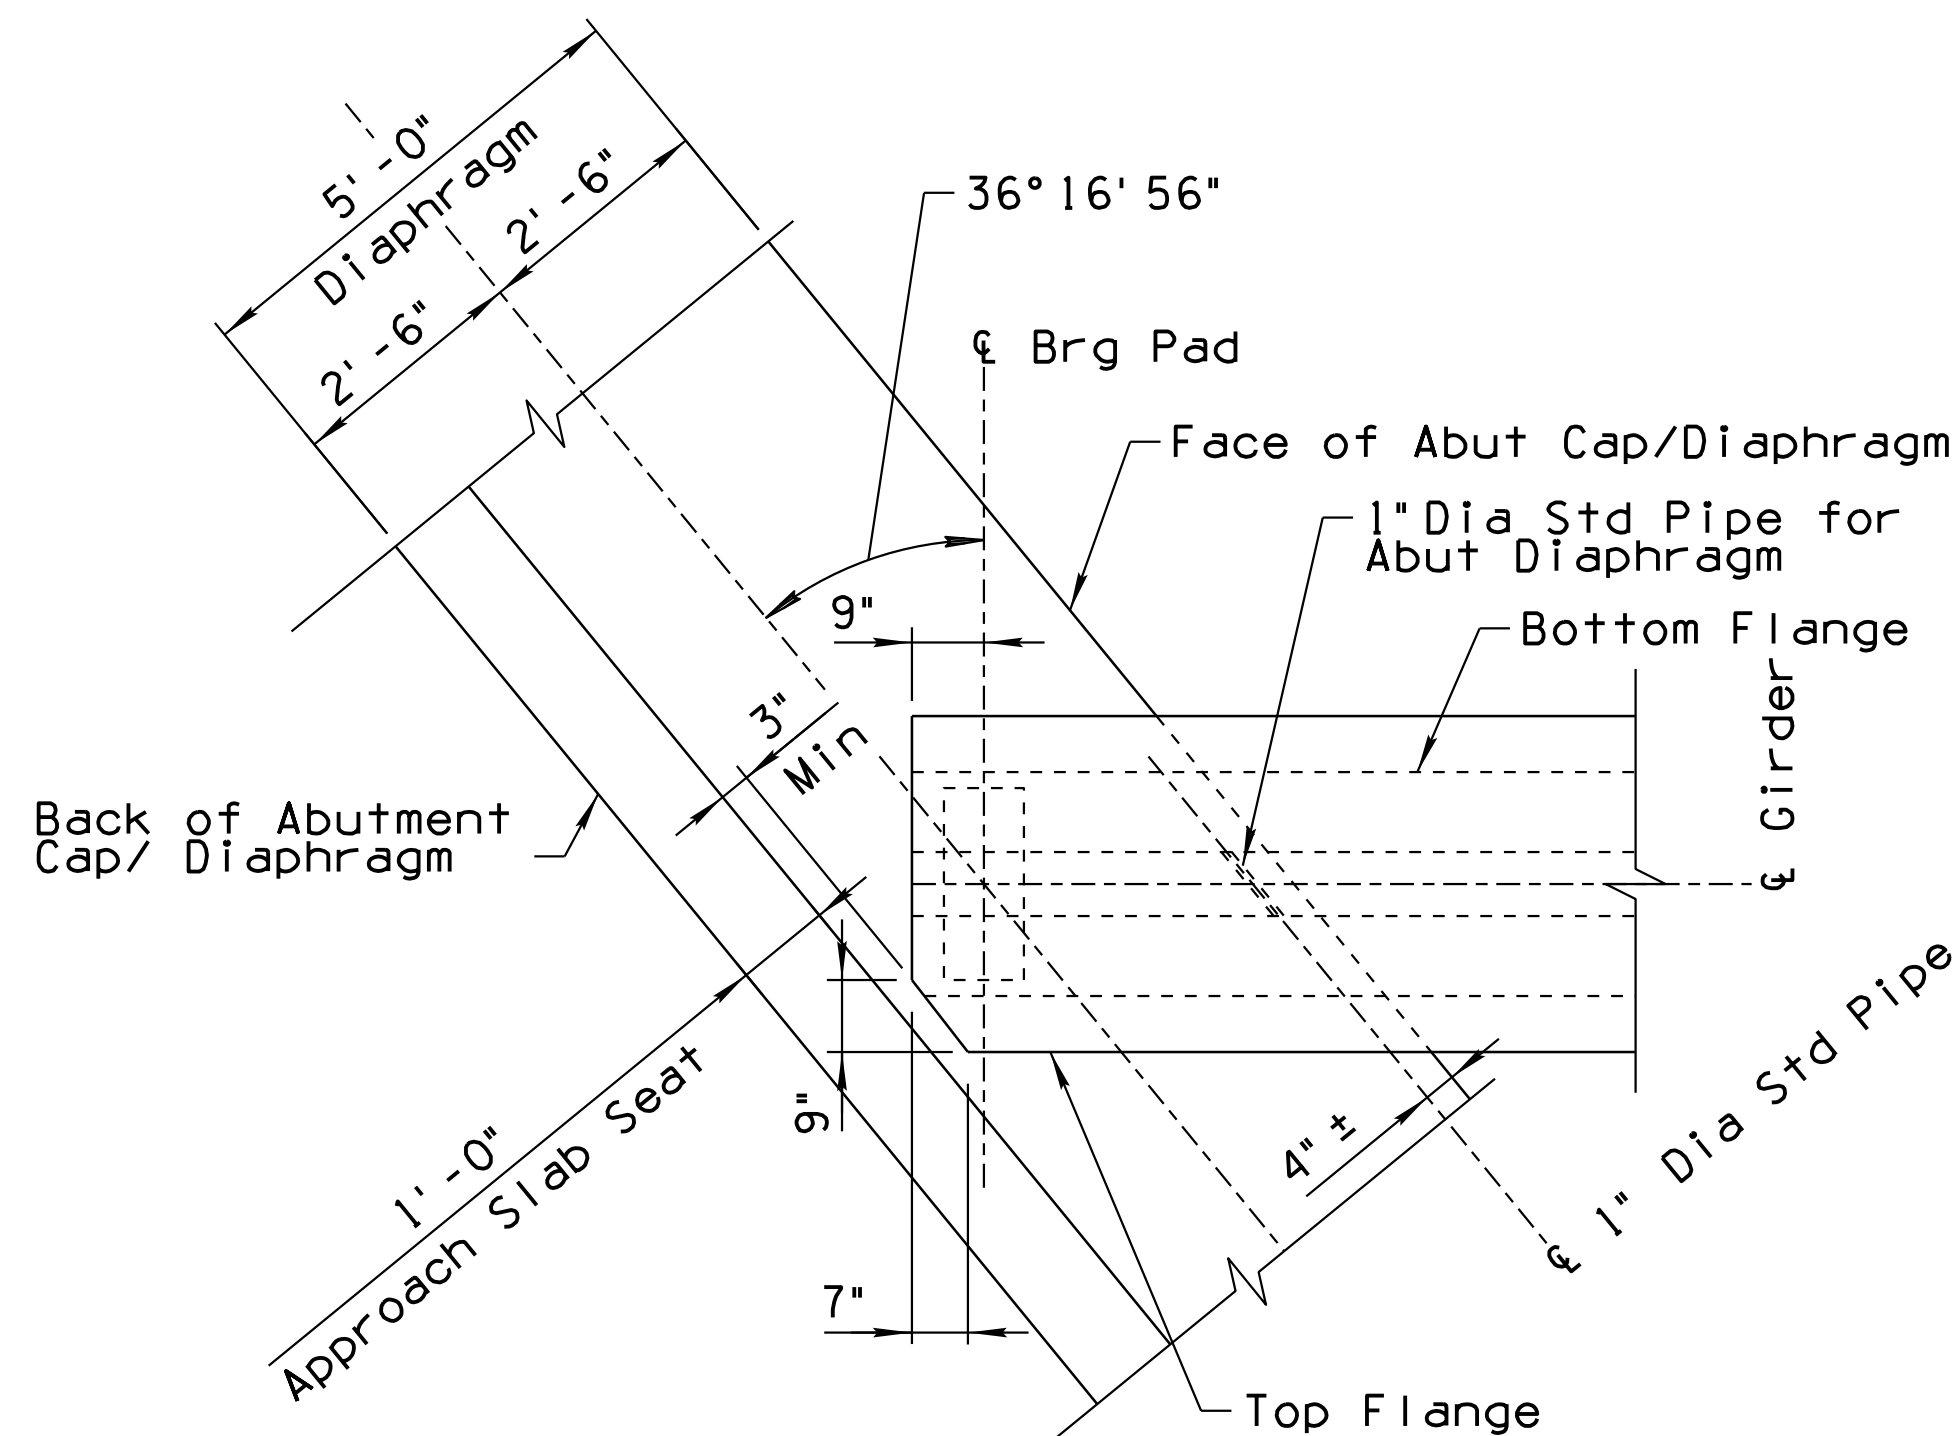


DETAIL - COPING AT ABUTMENT (1.21/1.22)  
Scale: 1/2" = 1'-0"

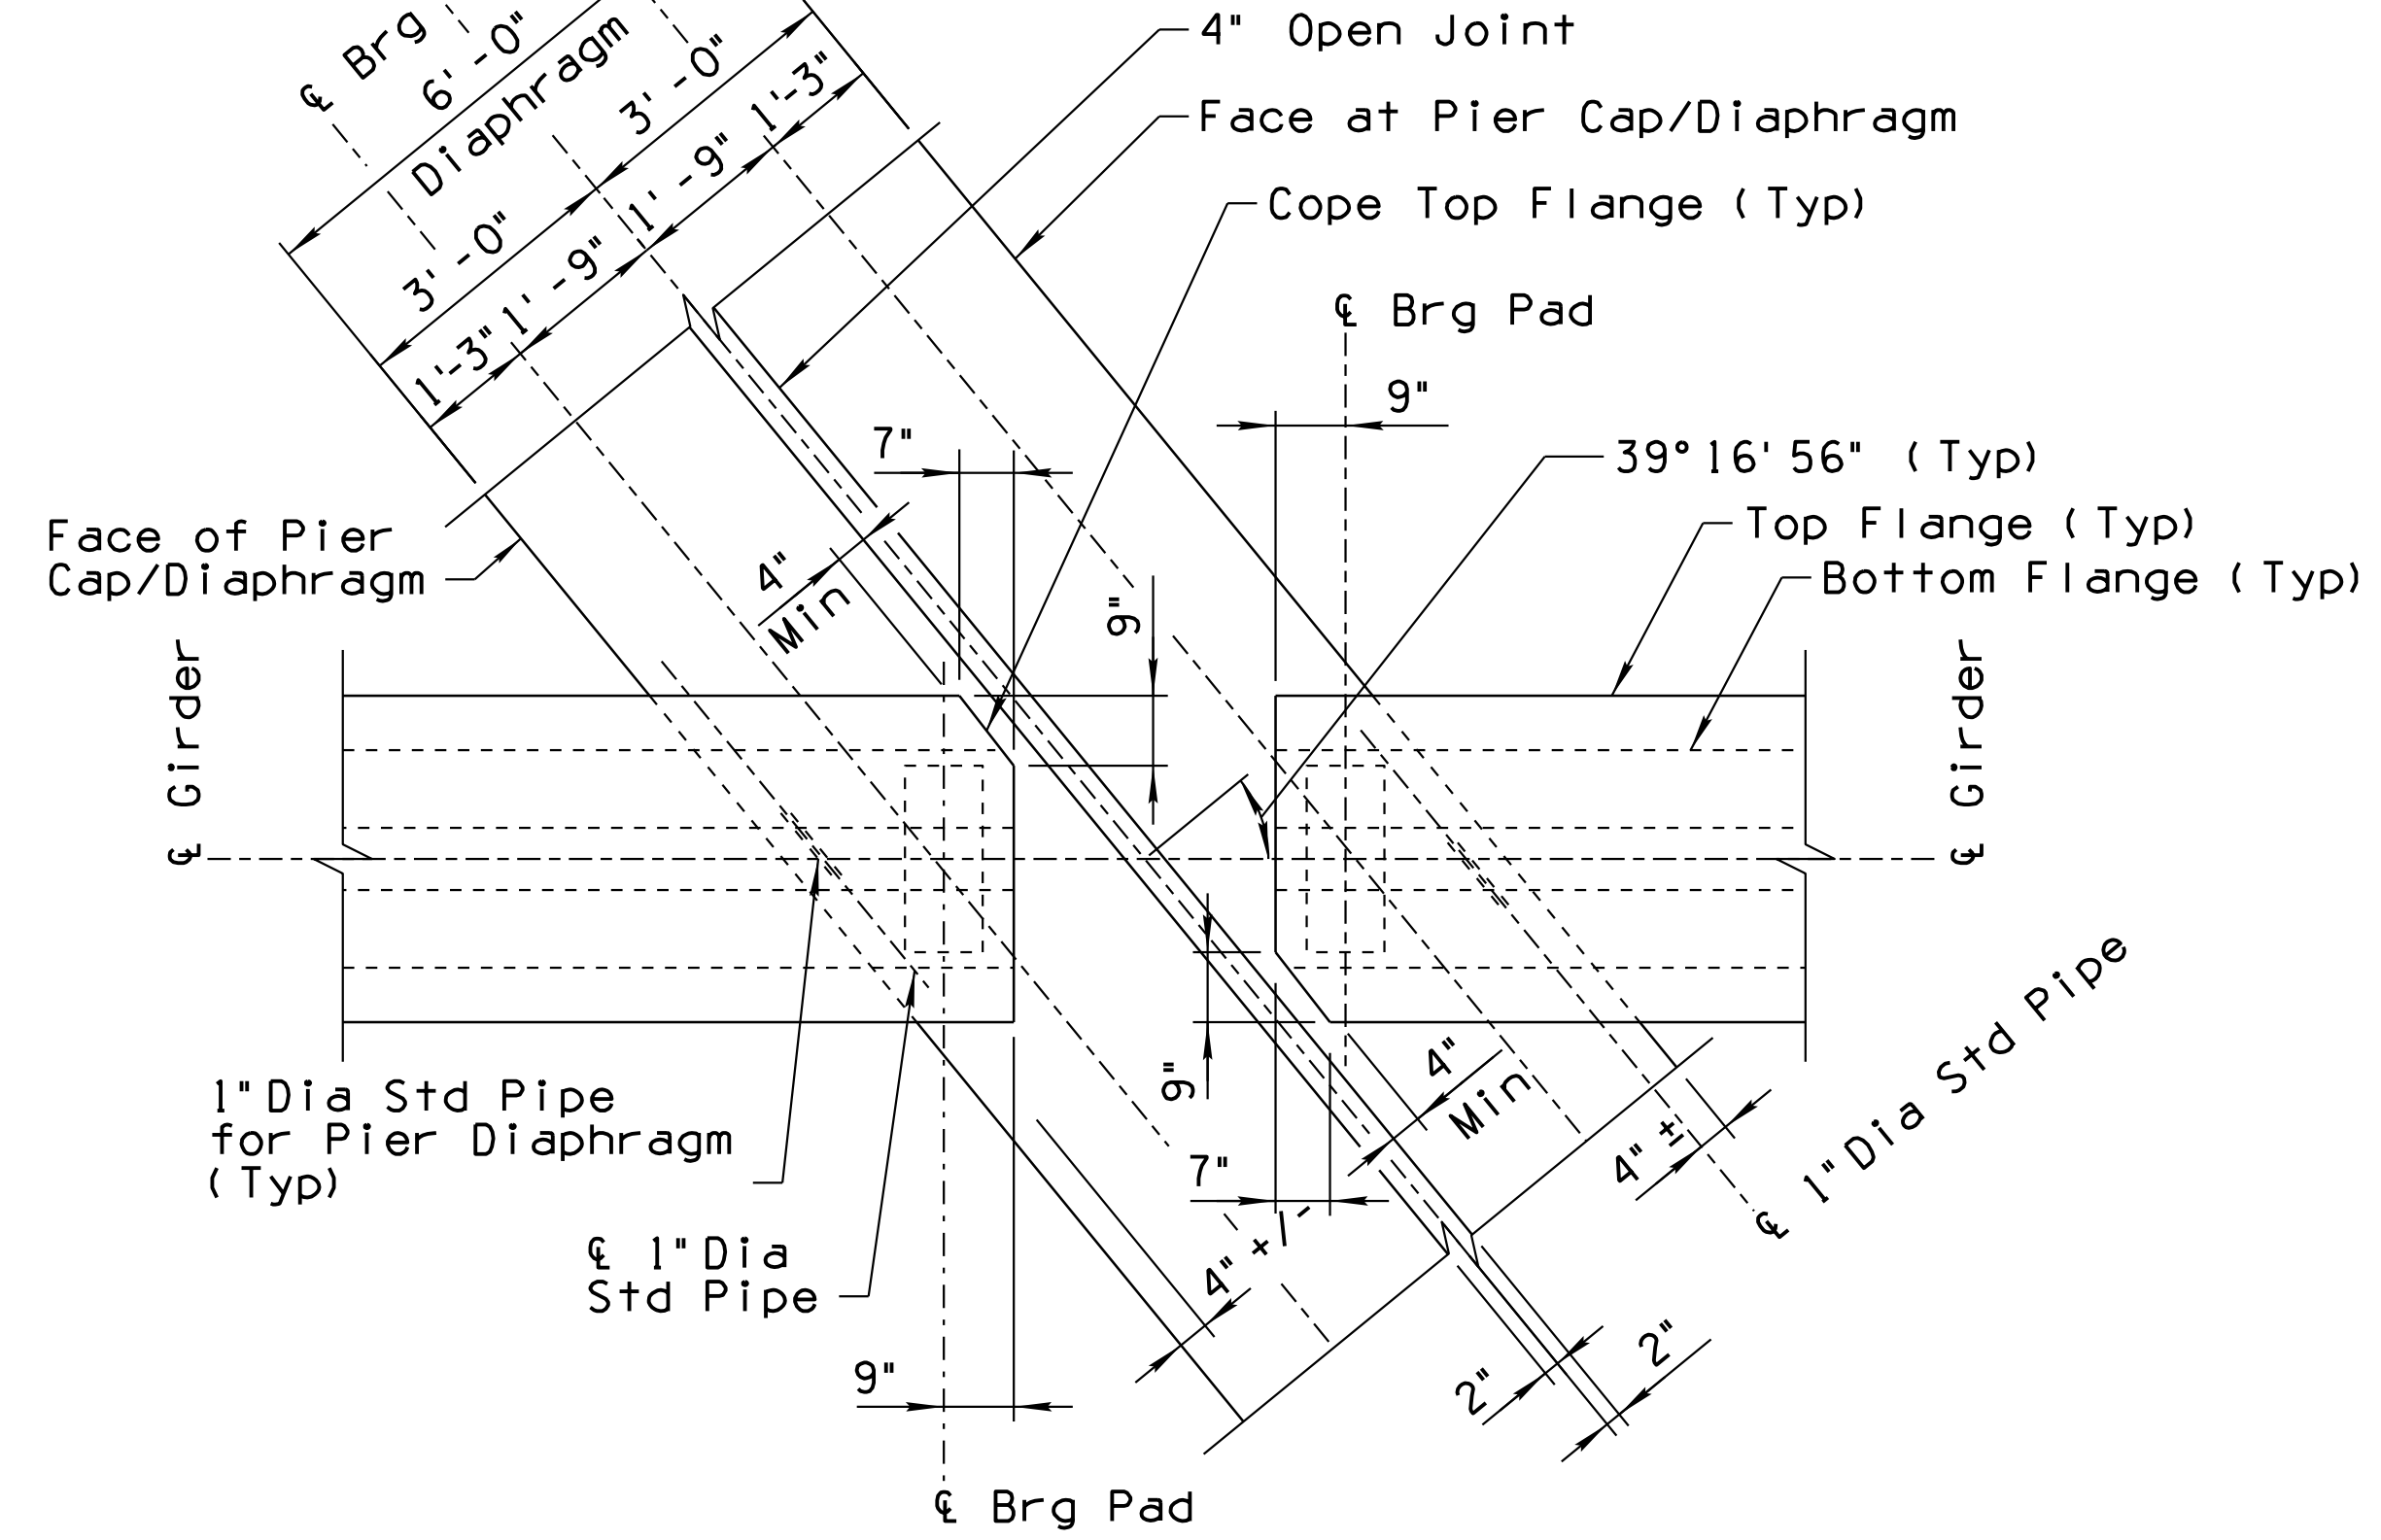


DETAIL - COPING AT PIER (2.21/1.22)  
Scale: 1/2" = 1'-0"

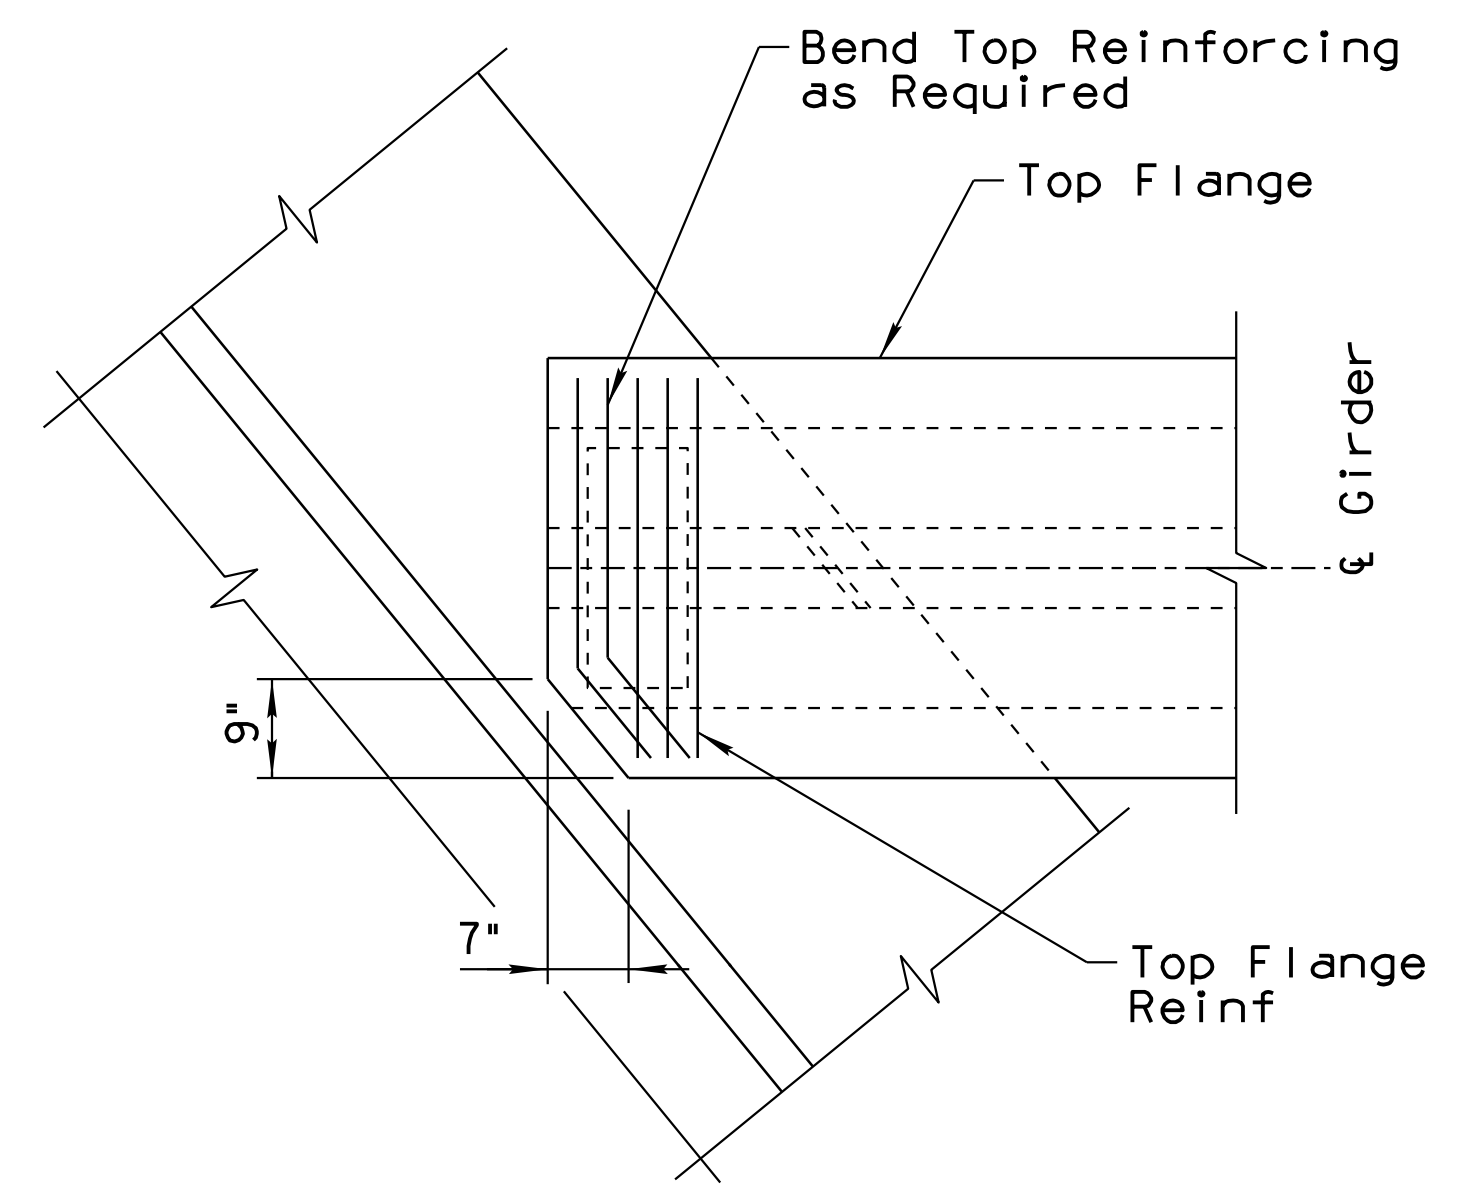

DETAIL - GIRDER COPING (3)  
Scale: 3/4" = 1'-0"

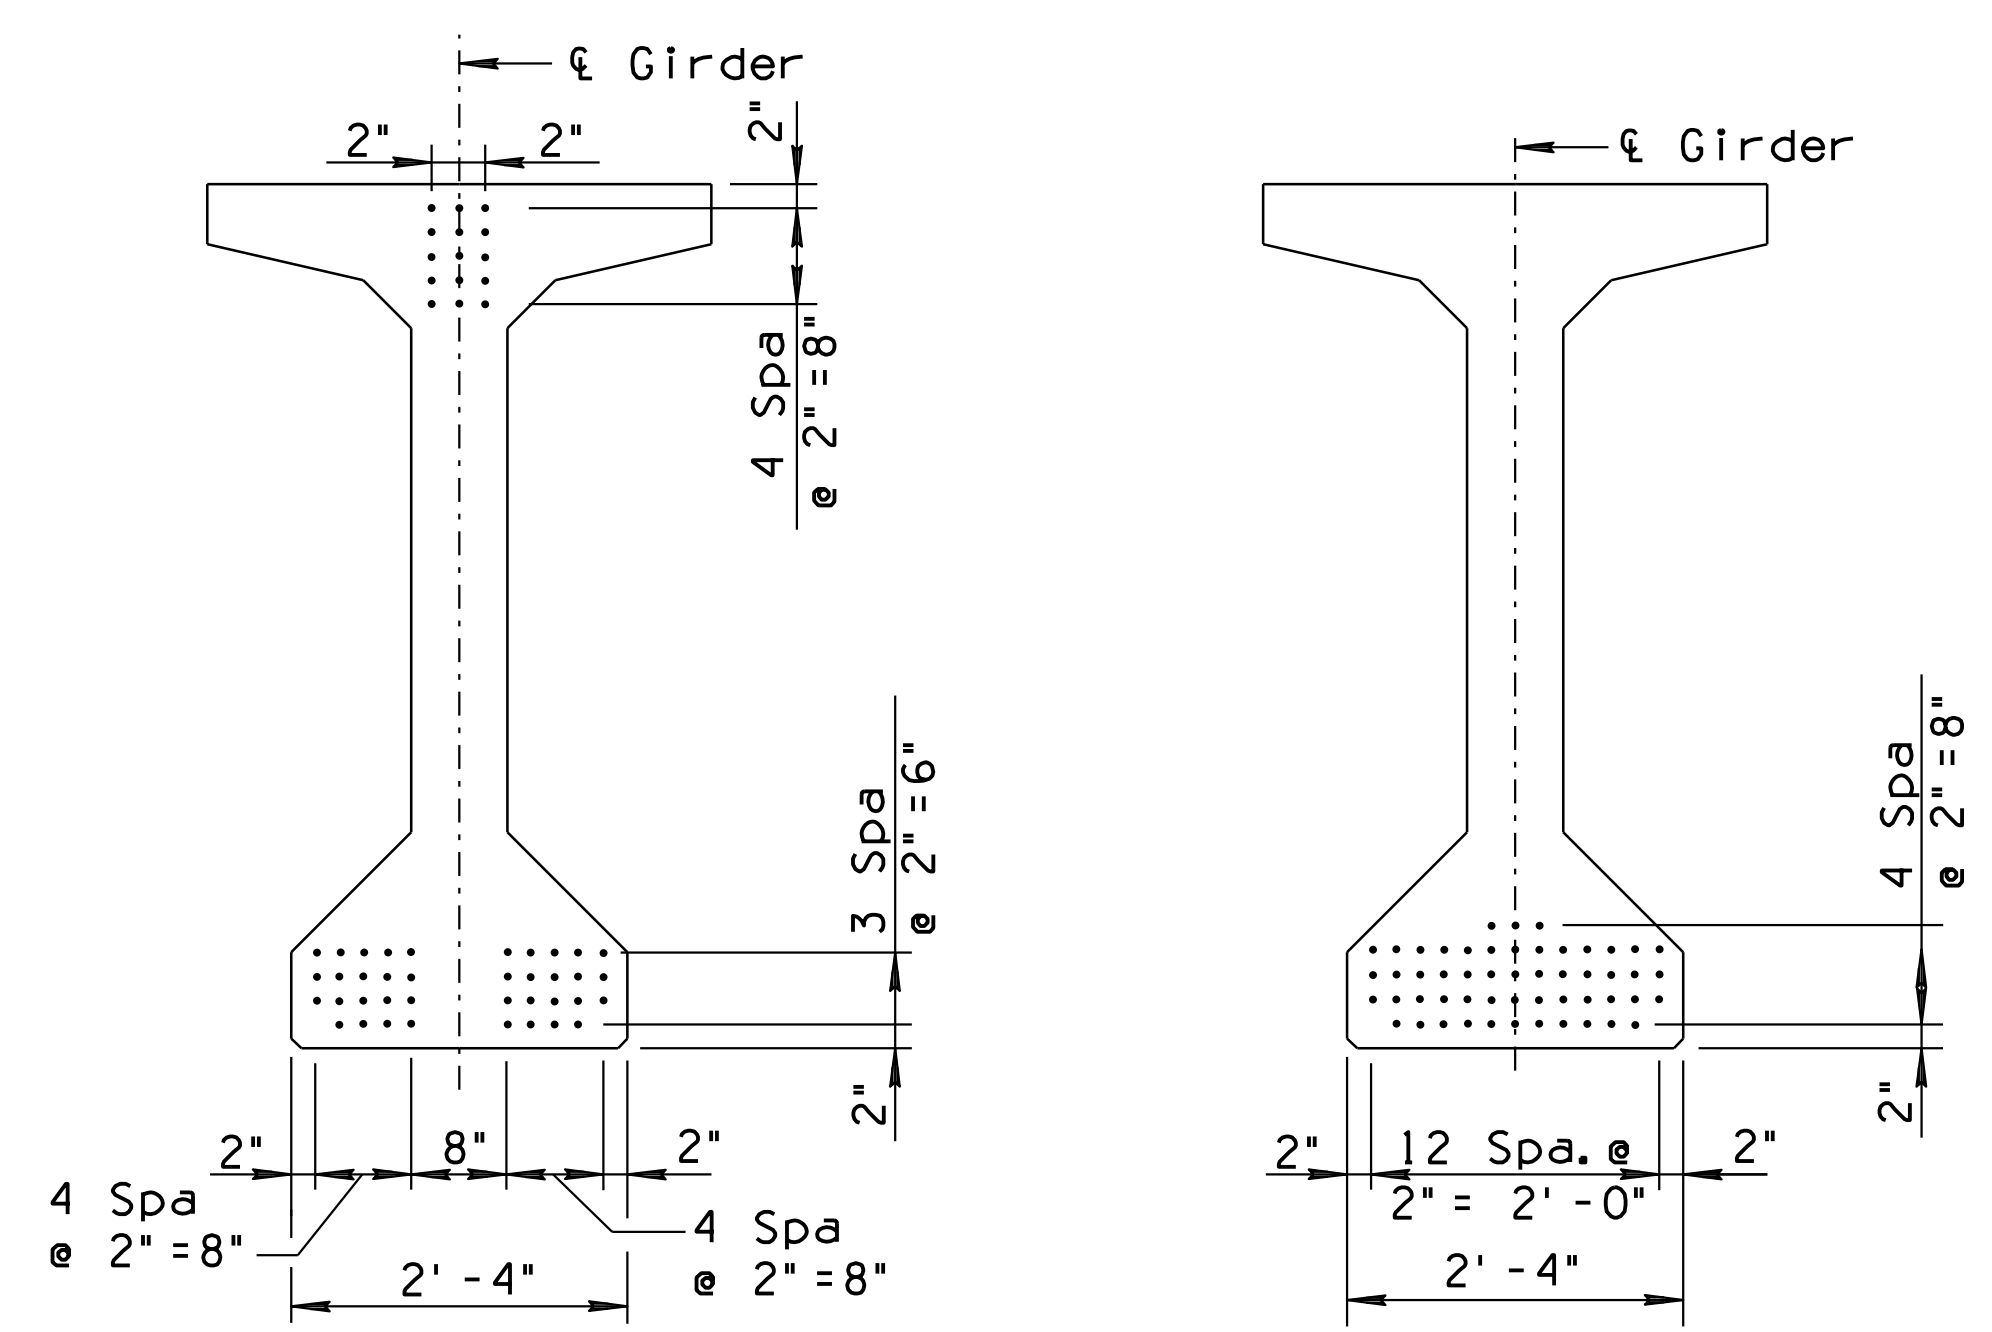

ENDS  $Y_E = 22.38$   
MIDSPAN  $Y_C = 5.40$   
STRAND PATTERN  
Scale: 3/4" = 1'-0"  
(53 TOTAL STRANDS)

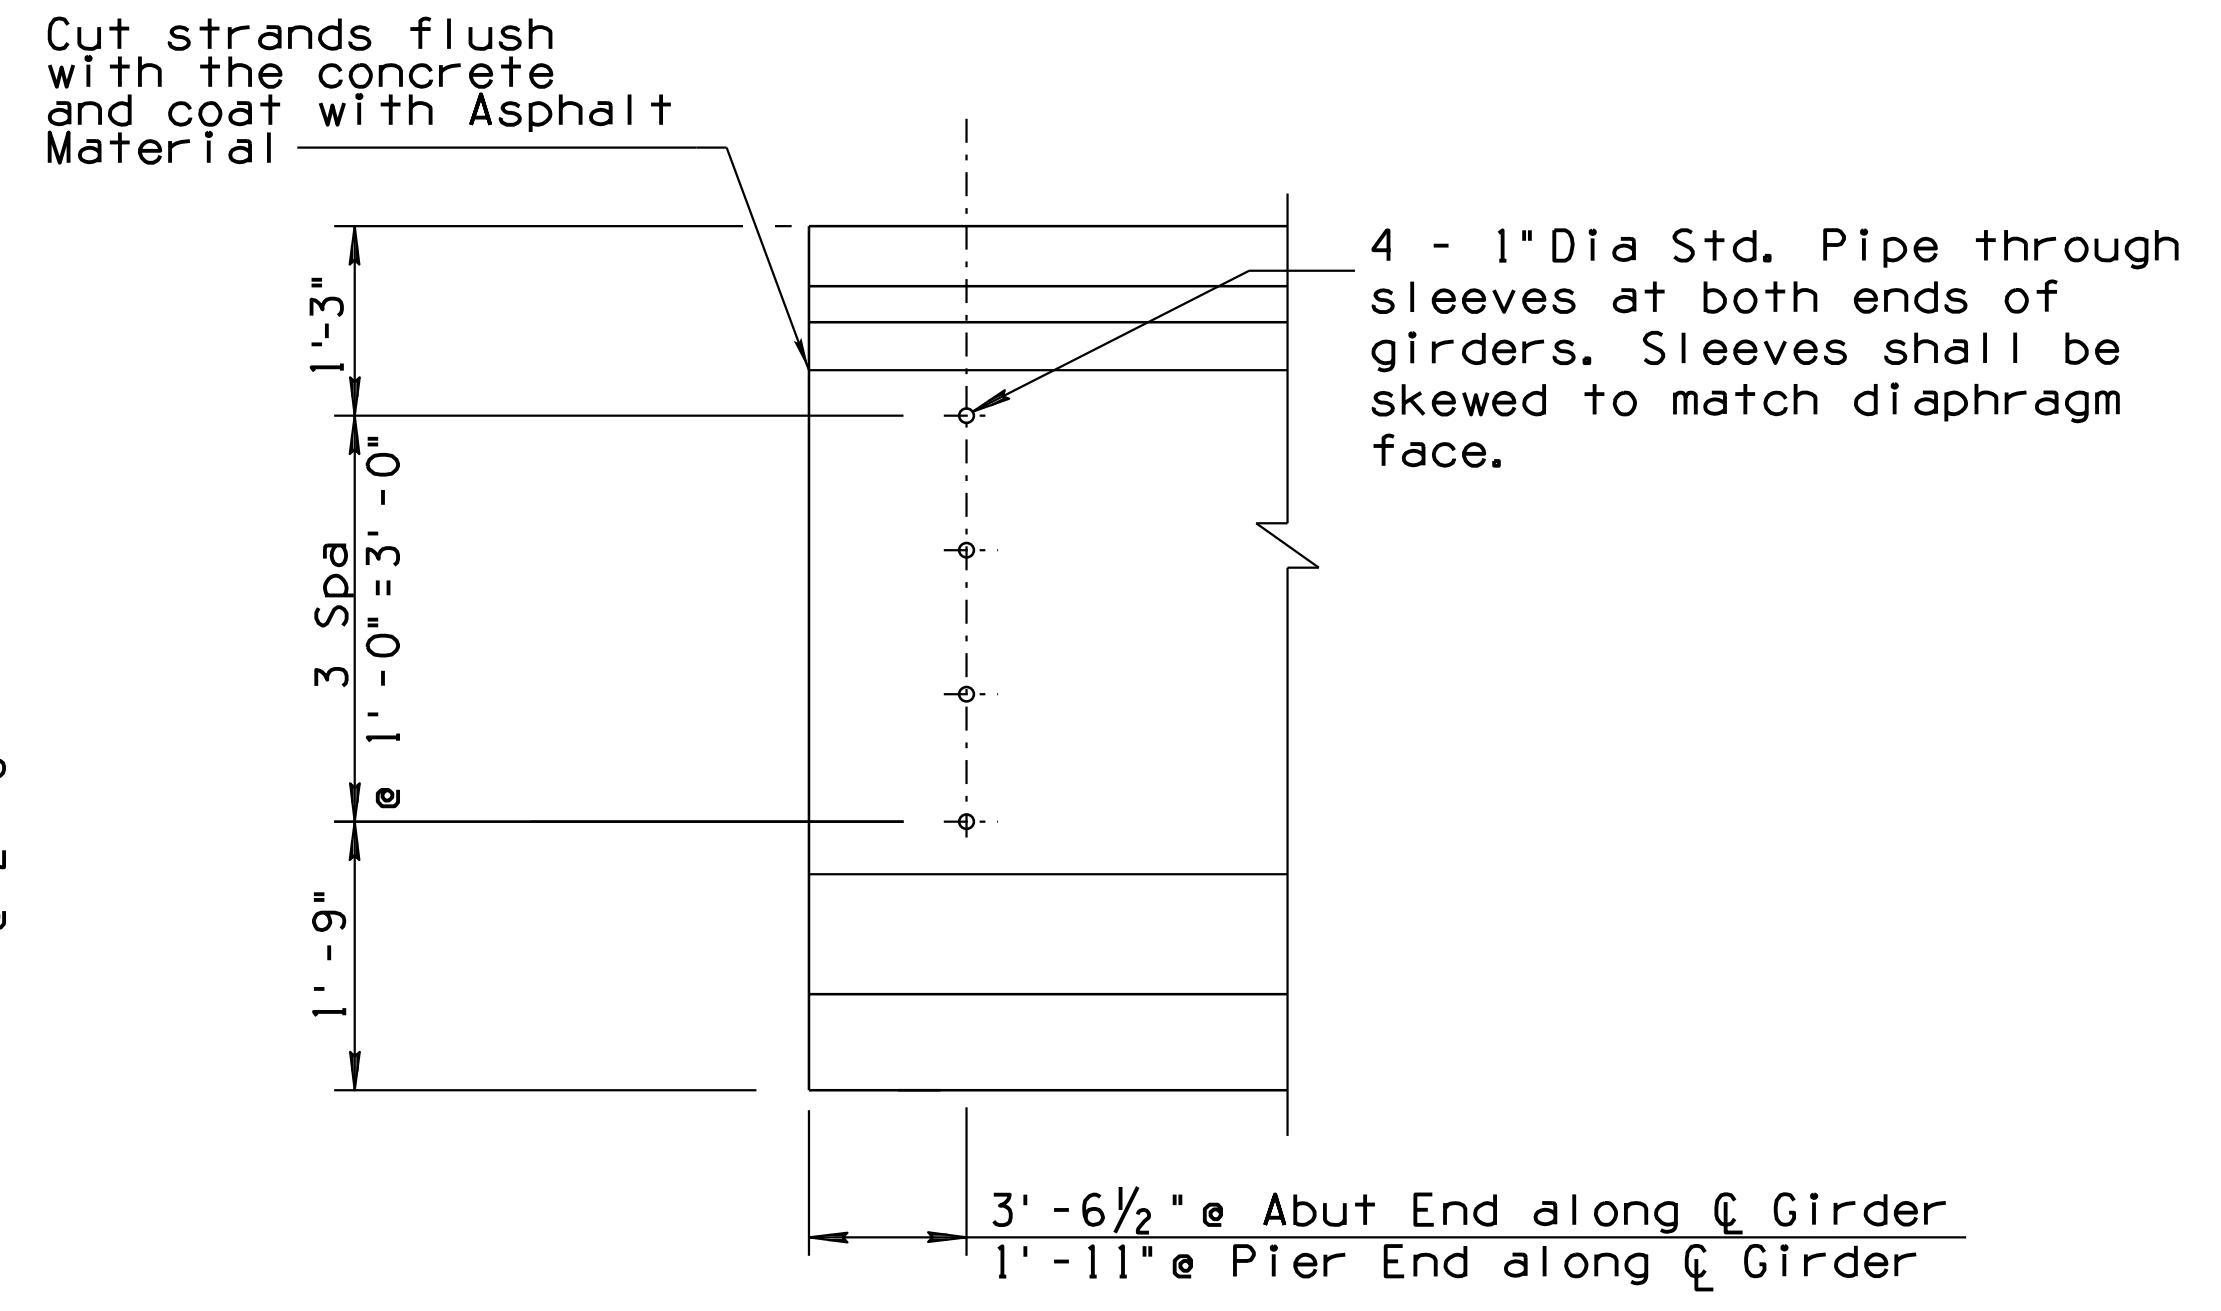


DETAIL (4)  
Scale: 3/4" = 1'-0" (1.23)

DESIGN	LES / HV	DATE	3-19	ARIZONA DEPARTMENT OF TRANSPORTATION INFRASTRUCTURE DELIVERY AND OPERATIONS DIVISION BRIDGE GROUP STA 99+ RUTHRAUFF ROAD T.I. UNDERPASS GIRDER DETAILS 2
DRAWN	DAY	DATE	3-19	
CHECKED	AGG / JAC	DATE	3-19	
WSP WSP USA, Inc. 177 N. Church Avenue Suite 1105 Tucson, AZ 85701		LOCATION RUTHRAUFF ROAD T.I.		DWG NO. S-1.24 OF
ROUTE	MILEPOST	STRUCTURE NO.	010-D(213)S	
TRACS NO. H 8480 OIC				

F.H.W.A. REGION	STATE	PROJECT NO.	SHEET NO.	TOTAL SHEETS	RECORD DRAWING
9	ARIZ.	010-D(213)S	638	849	

010 PM 252

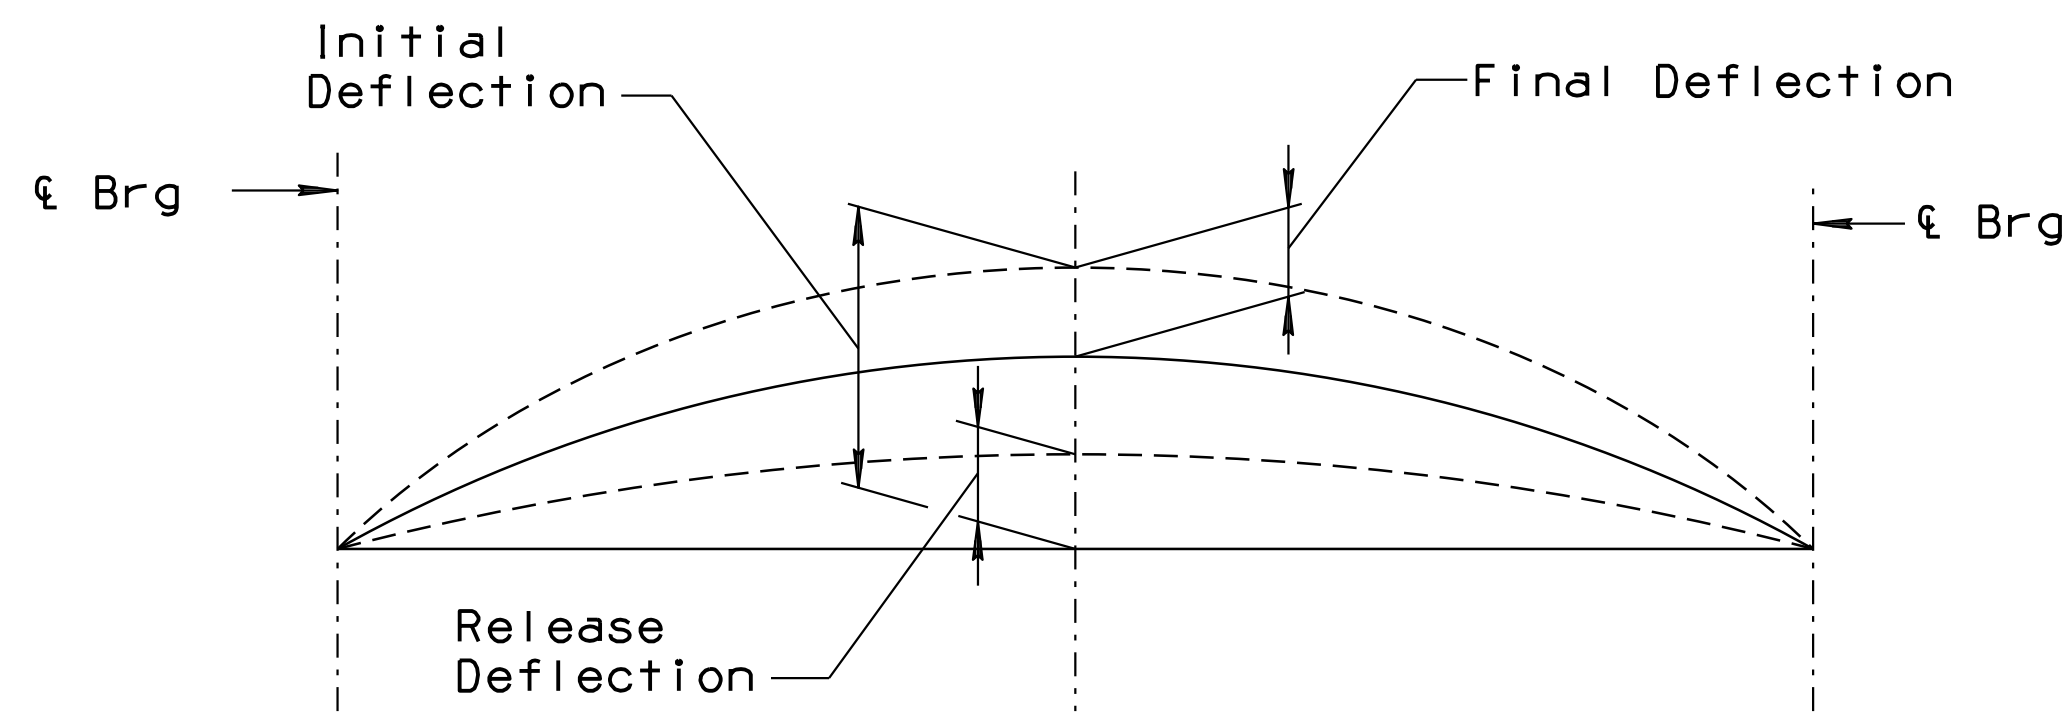

**DEFLECTION DIAGRAM**  
No Scale

**DEFLECTION NOTES:**

1. Release Deflection equals the deflection that the prestressed girder undergoes at the time of strand release. The Release Deflection includes the dead load of the girder and the release prestressing force (including the effects of the elastic shortening).
2. Initial Deflection equals the deflection the prestressed girder undergoes at the time of erection prior to the diaphragm or deck pours. The Initial Deflection includes the deflection due to the dead load of the girder, the initial prestressing and the effects of creep & loss of prestress up to the time of erection. (Assumed at 60 days after release).
3. Final Deflection equals elastic deflection due to the dead load of the deck slab, diaphragms, barriers, sidewalks, median and the effects of long term creep & loss of prestress. The effects of future wearing surface loading are not included.
4. Due to intermediate diaphragm action, final deflection shown is the average final deflection for all beams within the spans.

**ERECTION NOTE:**


1. Girders shall be braced to prevent tipping and to control Lateral Bending during shipping. The contractor shall provide temporary bracing for the girders immediately after erection to ensure they remain stable until the diaphragms have been constructed.
2. The contractor shall provide the as-built girder bearing seat elevations at abutments and pier as well as as-built girder top elevations (Release and Initial) at tenth points to the Engineer for verification of screed grade elevations prior to setting deck formwork.

DEFLECTION AT TENTH POINTS ( FT )												
	LOCATION	0.0	0.1	0.2	0.3	0.4	0.5	0.6	0.7	0.8	0.9	1.00
SPAN 1	Release	0.000	0.092	0.163	0.215	0.245	0.255	0.245	0.215	0.163	0.092	0.000
	Initial	0.000	0.162	0.288	0.378	0.431	0.449	0.431	0.378	0.288	0.162	0.000
	Final	0.000	-0.071	-0.126	-0.166	-0.189	-0.197	-0.189	-0.166	-0.126	-0.071	0.000
SPAN 2	Release	0.000	0.092	0.163	0.215	0.245	0.255	0.245	0.215	0.163	0.092	0.000
	Initial	0.000	0.162	0.288	0.378	0.431	0.449	0.431	0.378	0.288	0.162	0.000
	Final	0.000	-0.071	-0.126	-0.166	-0.189	-0.197	-0.189	-0.166	-0.126	-0.071	0.000

Note: Positive values represent upward deflection, and negative values represent downward deflection.





DATE- LOCATION- REVISIONS- FINISHED PLANS- SURVEY NO. DATE- LOCATION- REVISIONS- FINISHED PLANS- SURVEY NO.

DESIGN	LES / HV	DATE	3-19	ARIZONA DEPARTMENT OF TRANSPORTATION INFRASTRUCTURE DELIVERY AND OPERATIONS DIVISION BRIDGE GROUP
DRAWN	DAY	DATE	3-19	
CHECKED	AGG / JAC	DATE	3-19	
		WSP USA Inc. 177 N. Church Avenue Suite 1105 Tucson, AZ 85701		STA 99+ RUTHRAUFF ROAD T.I. UNDERPASS GIRDER DETAILS 3
I-10	252.00	20159	LOCATION	
ROUTE	MILEPOST	STRUCTURE NO.	RUTHRAUFF ROAD T.I.	DWG NO. S-1.25
TRACS NO. H 8480 OIC			010-D(213)S	OF

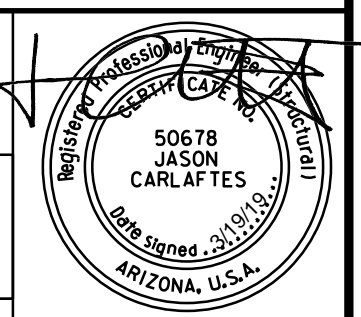

F.H.W.A. REGION	STATE	PROJECT NO.	SHEET NO.	TOTAL SHEETS	RECORD DRAWING
9	ARIZ.	010-D(213)S	639	849	

010 PM 252

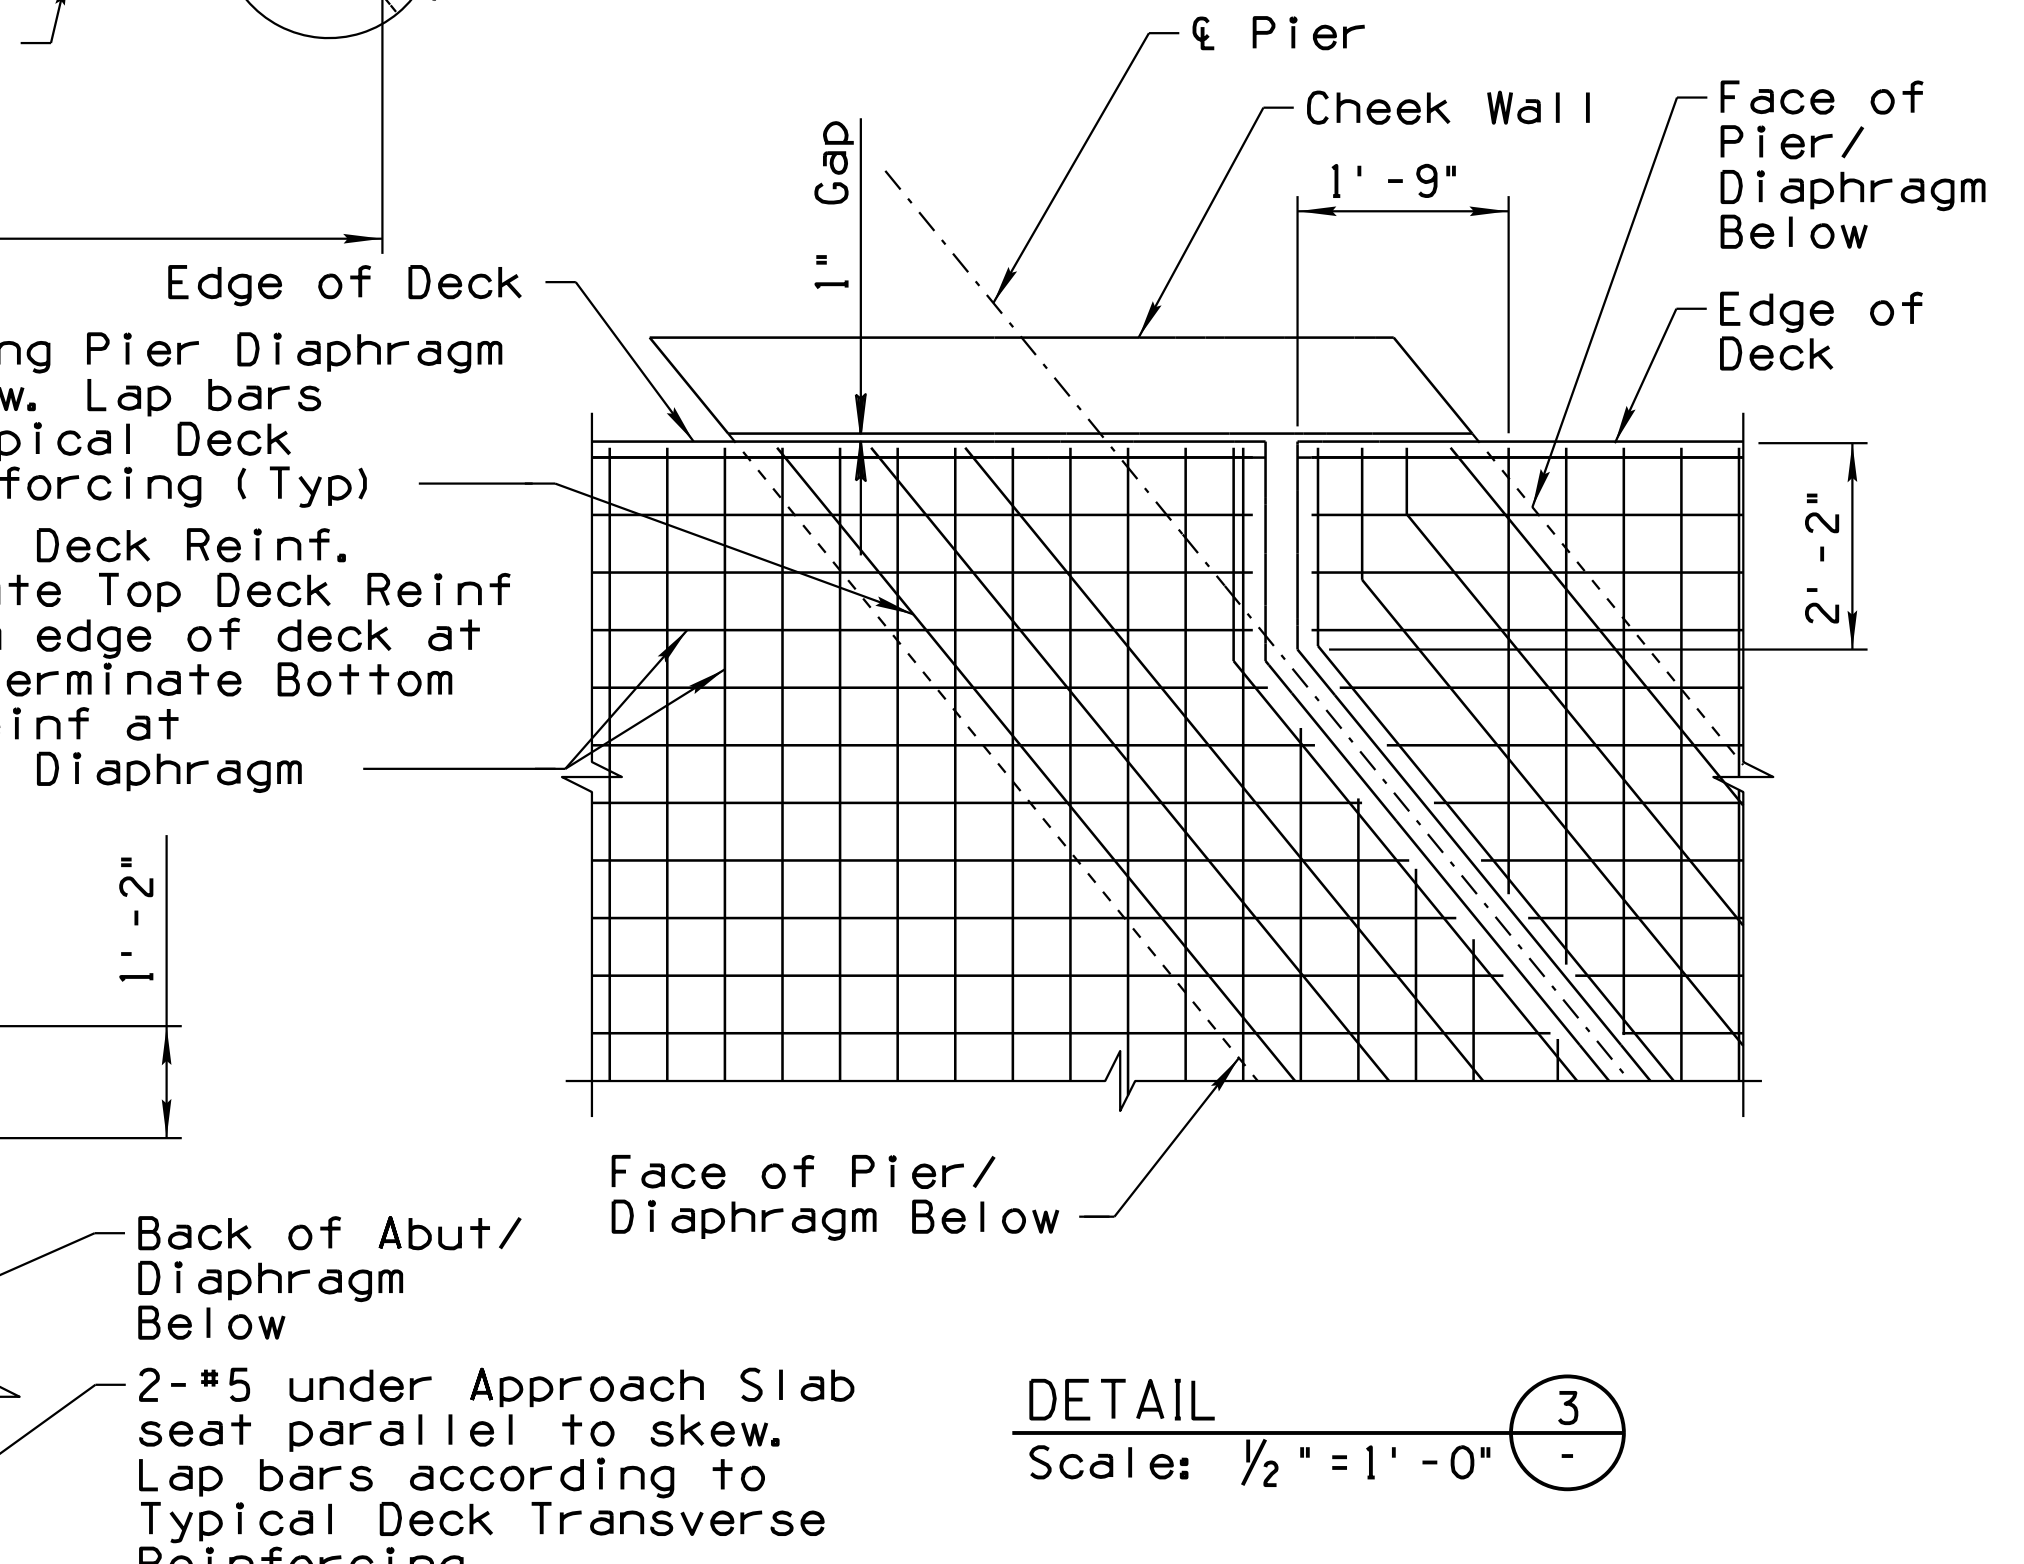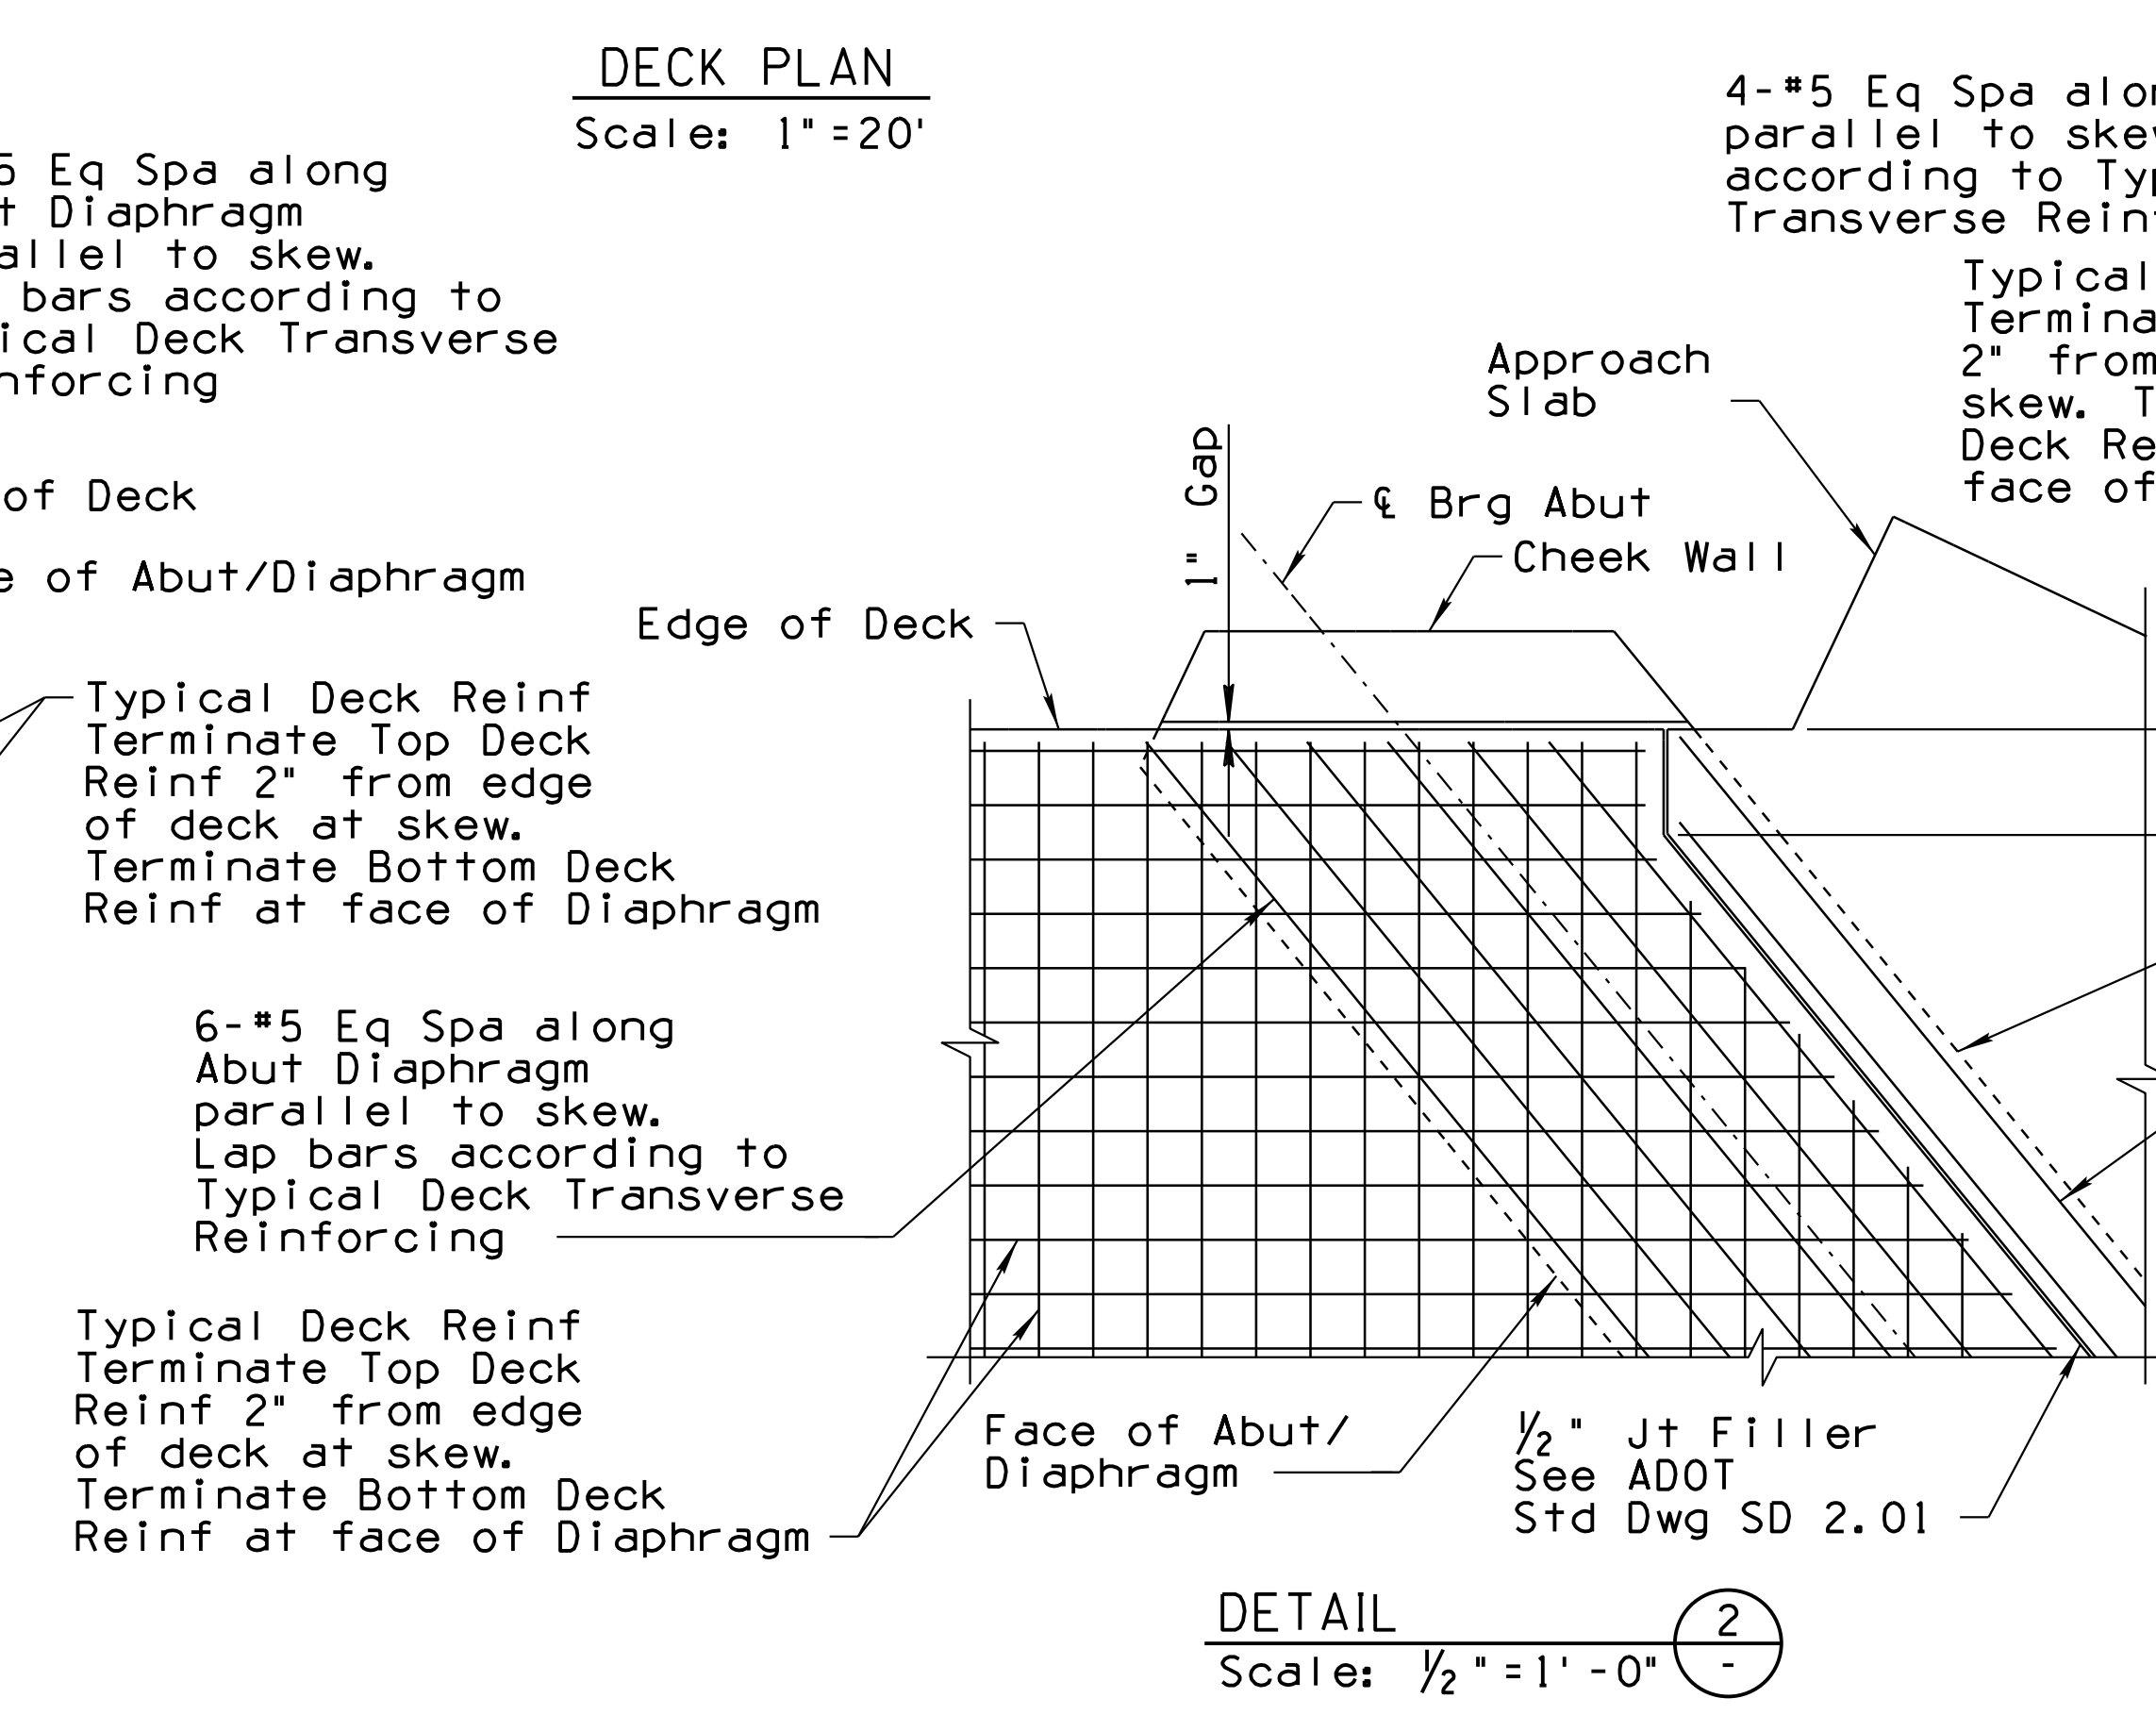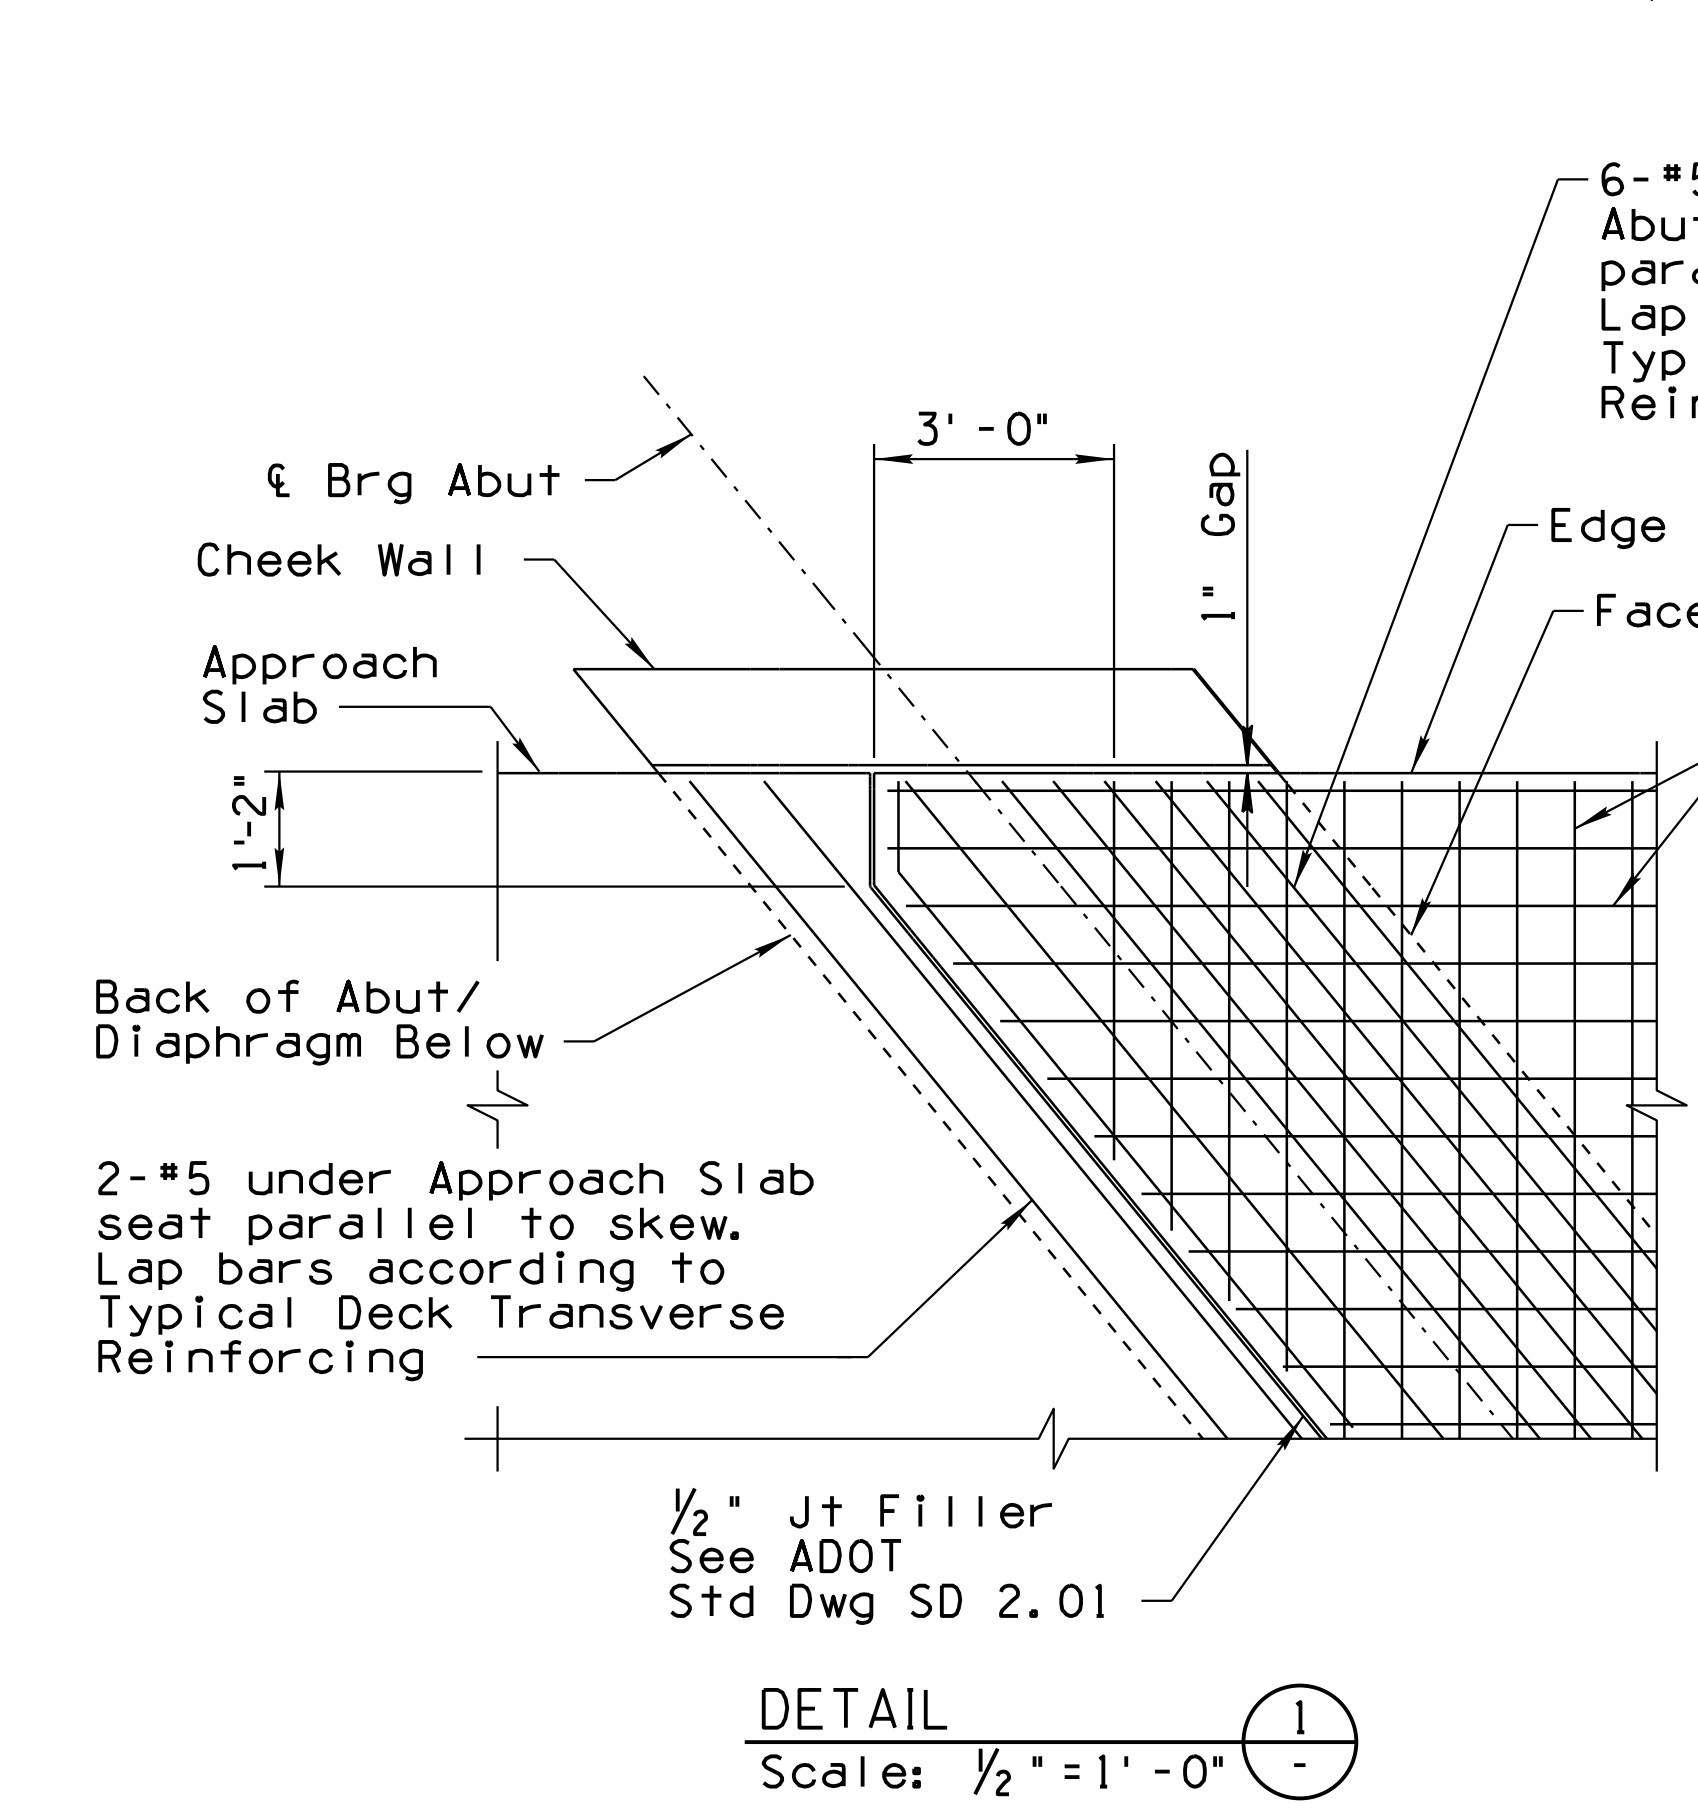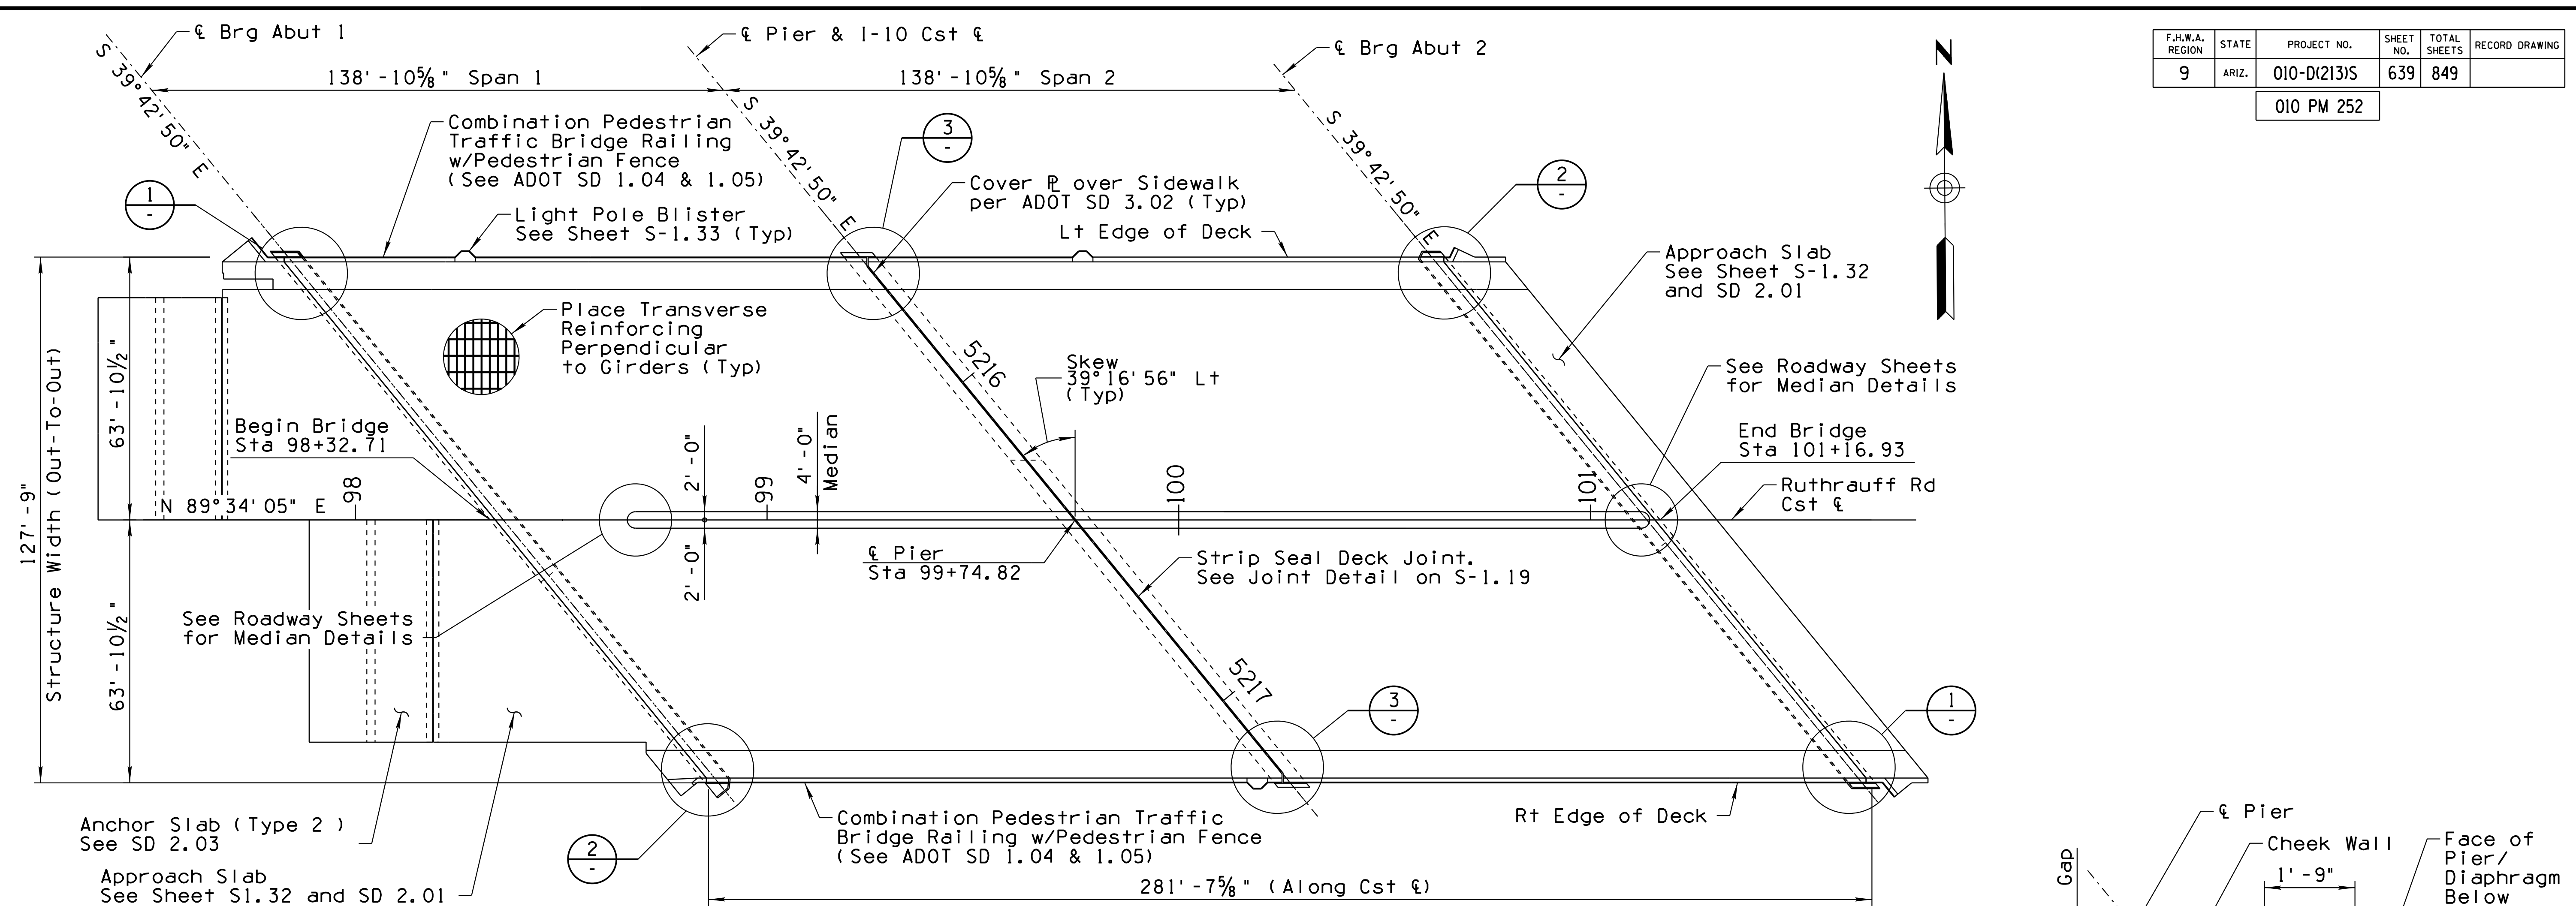


DESIGN	NAME	DATE	ARIZONA DEPARTMENT OF TRANSPORTATION INFRASTRUCTURE DELIVERY AND OPERATIONS DIVISION BRIDGE GROUP
DESIGN	LES / HV	3-19	<b>STA 99+ RUTHRAUFF ROAD T.I. UNDERPASS DECK PLAN</b>
DRAWN	DAY	3-19	
CHECKED	AGG / JAC	3-19	
1-10	252.00	20159	LOCATION RUTHRAUFF ROAD T.I.
TRACS NO. H 8480 OIC			010-D(213)S

SURVEY NO. FINISHED PLANS DATE REVISIONS LOCATION DATE FINISHED PLANS SURVEY NO.




F.H.W.A. REGION	STATE	PROJECT NO.	SHEET NO.	TOTAL SHEETS	RECORD DRAWING
9	ARIZ.	010-D(213)S	640	849	

010 PM 252

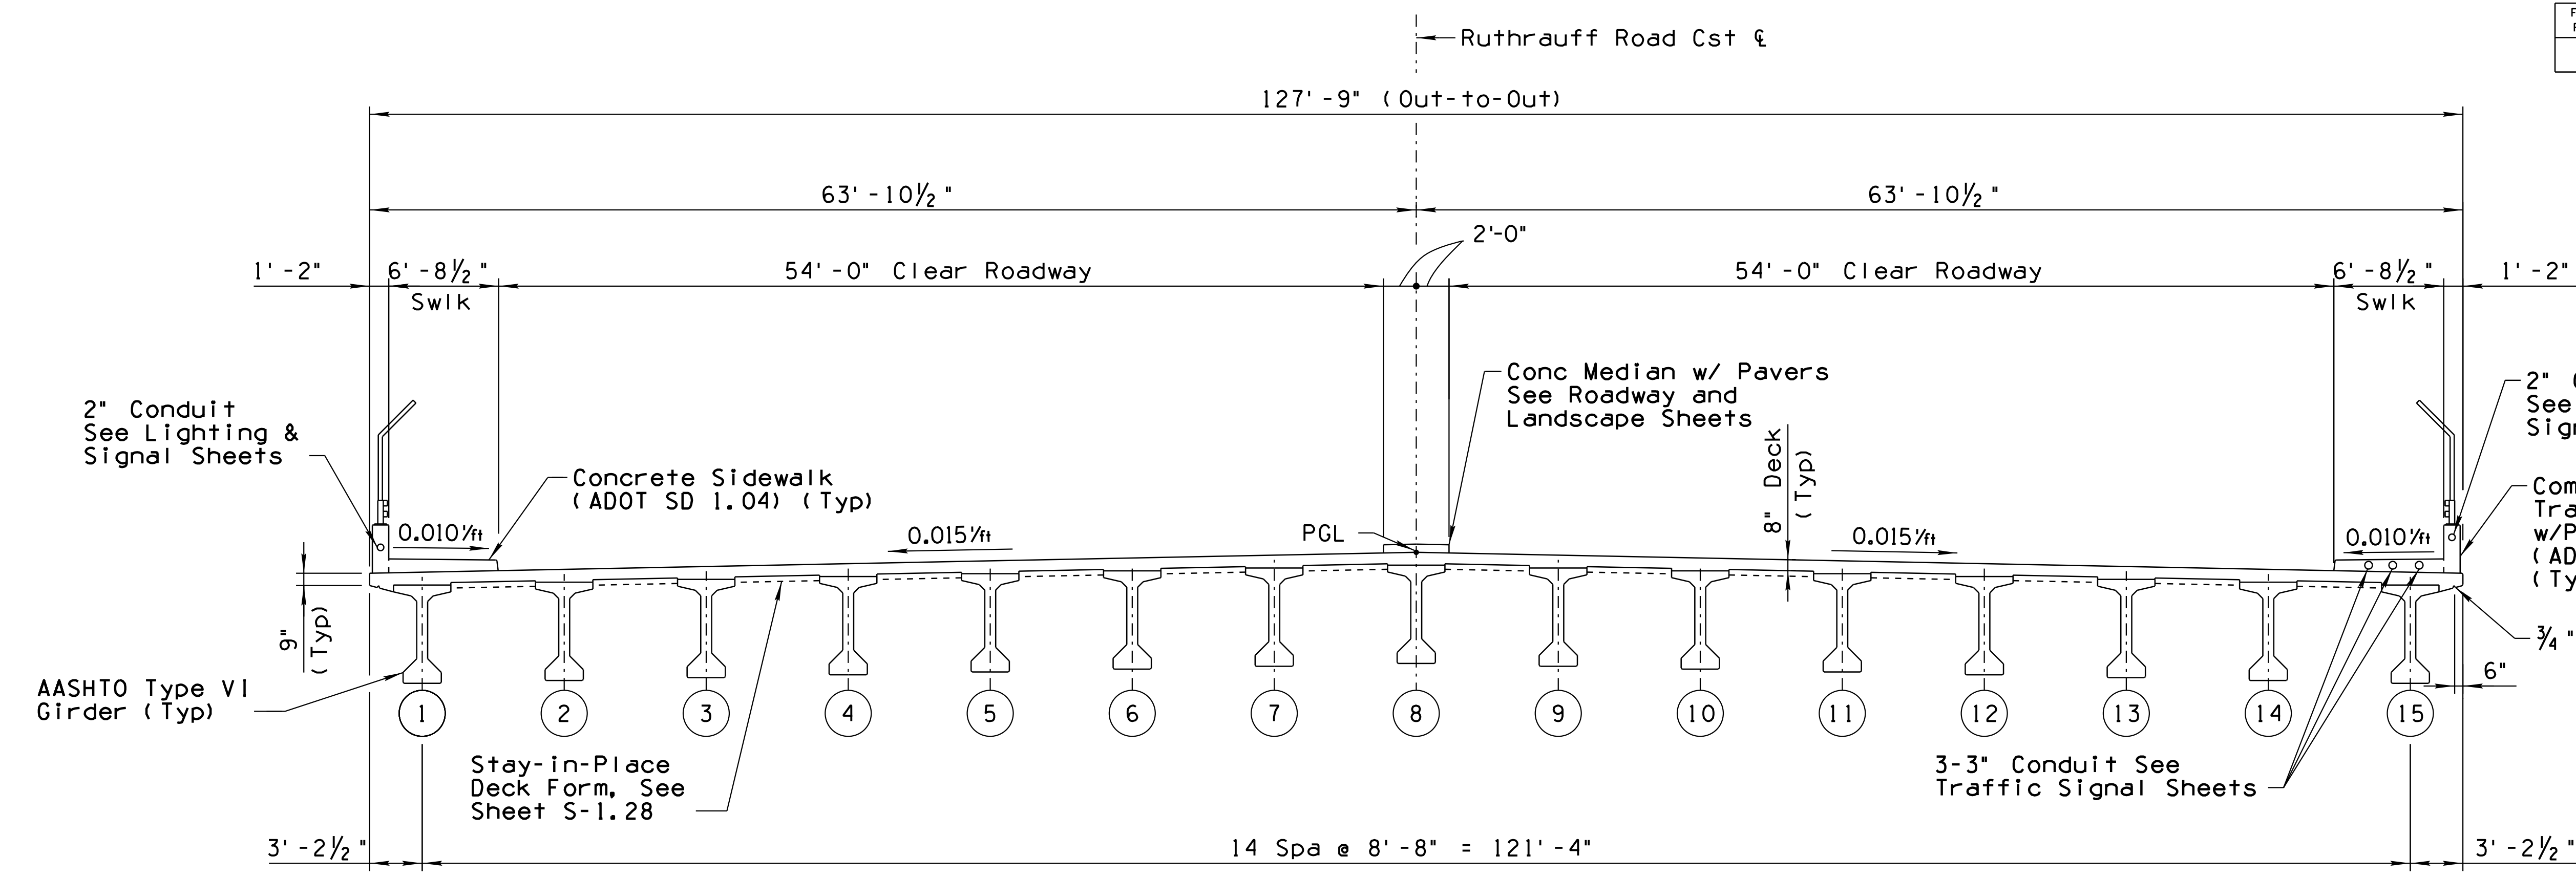


**TYPICAL DECK SECTION**

Scale: 3/16" = 1'-0"  
(Dimensions shown perpendicular to Cst &)

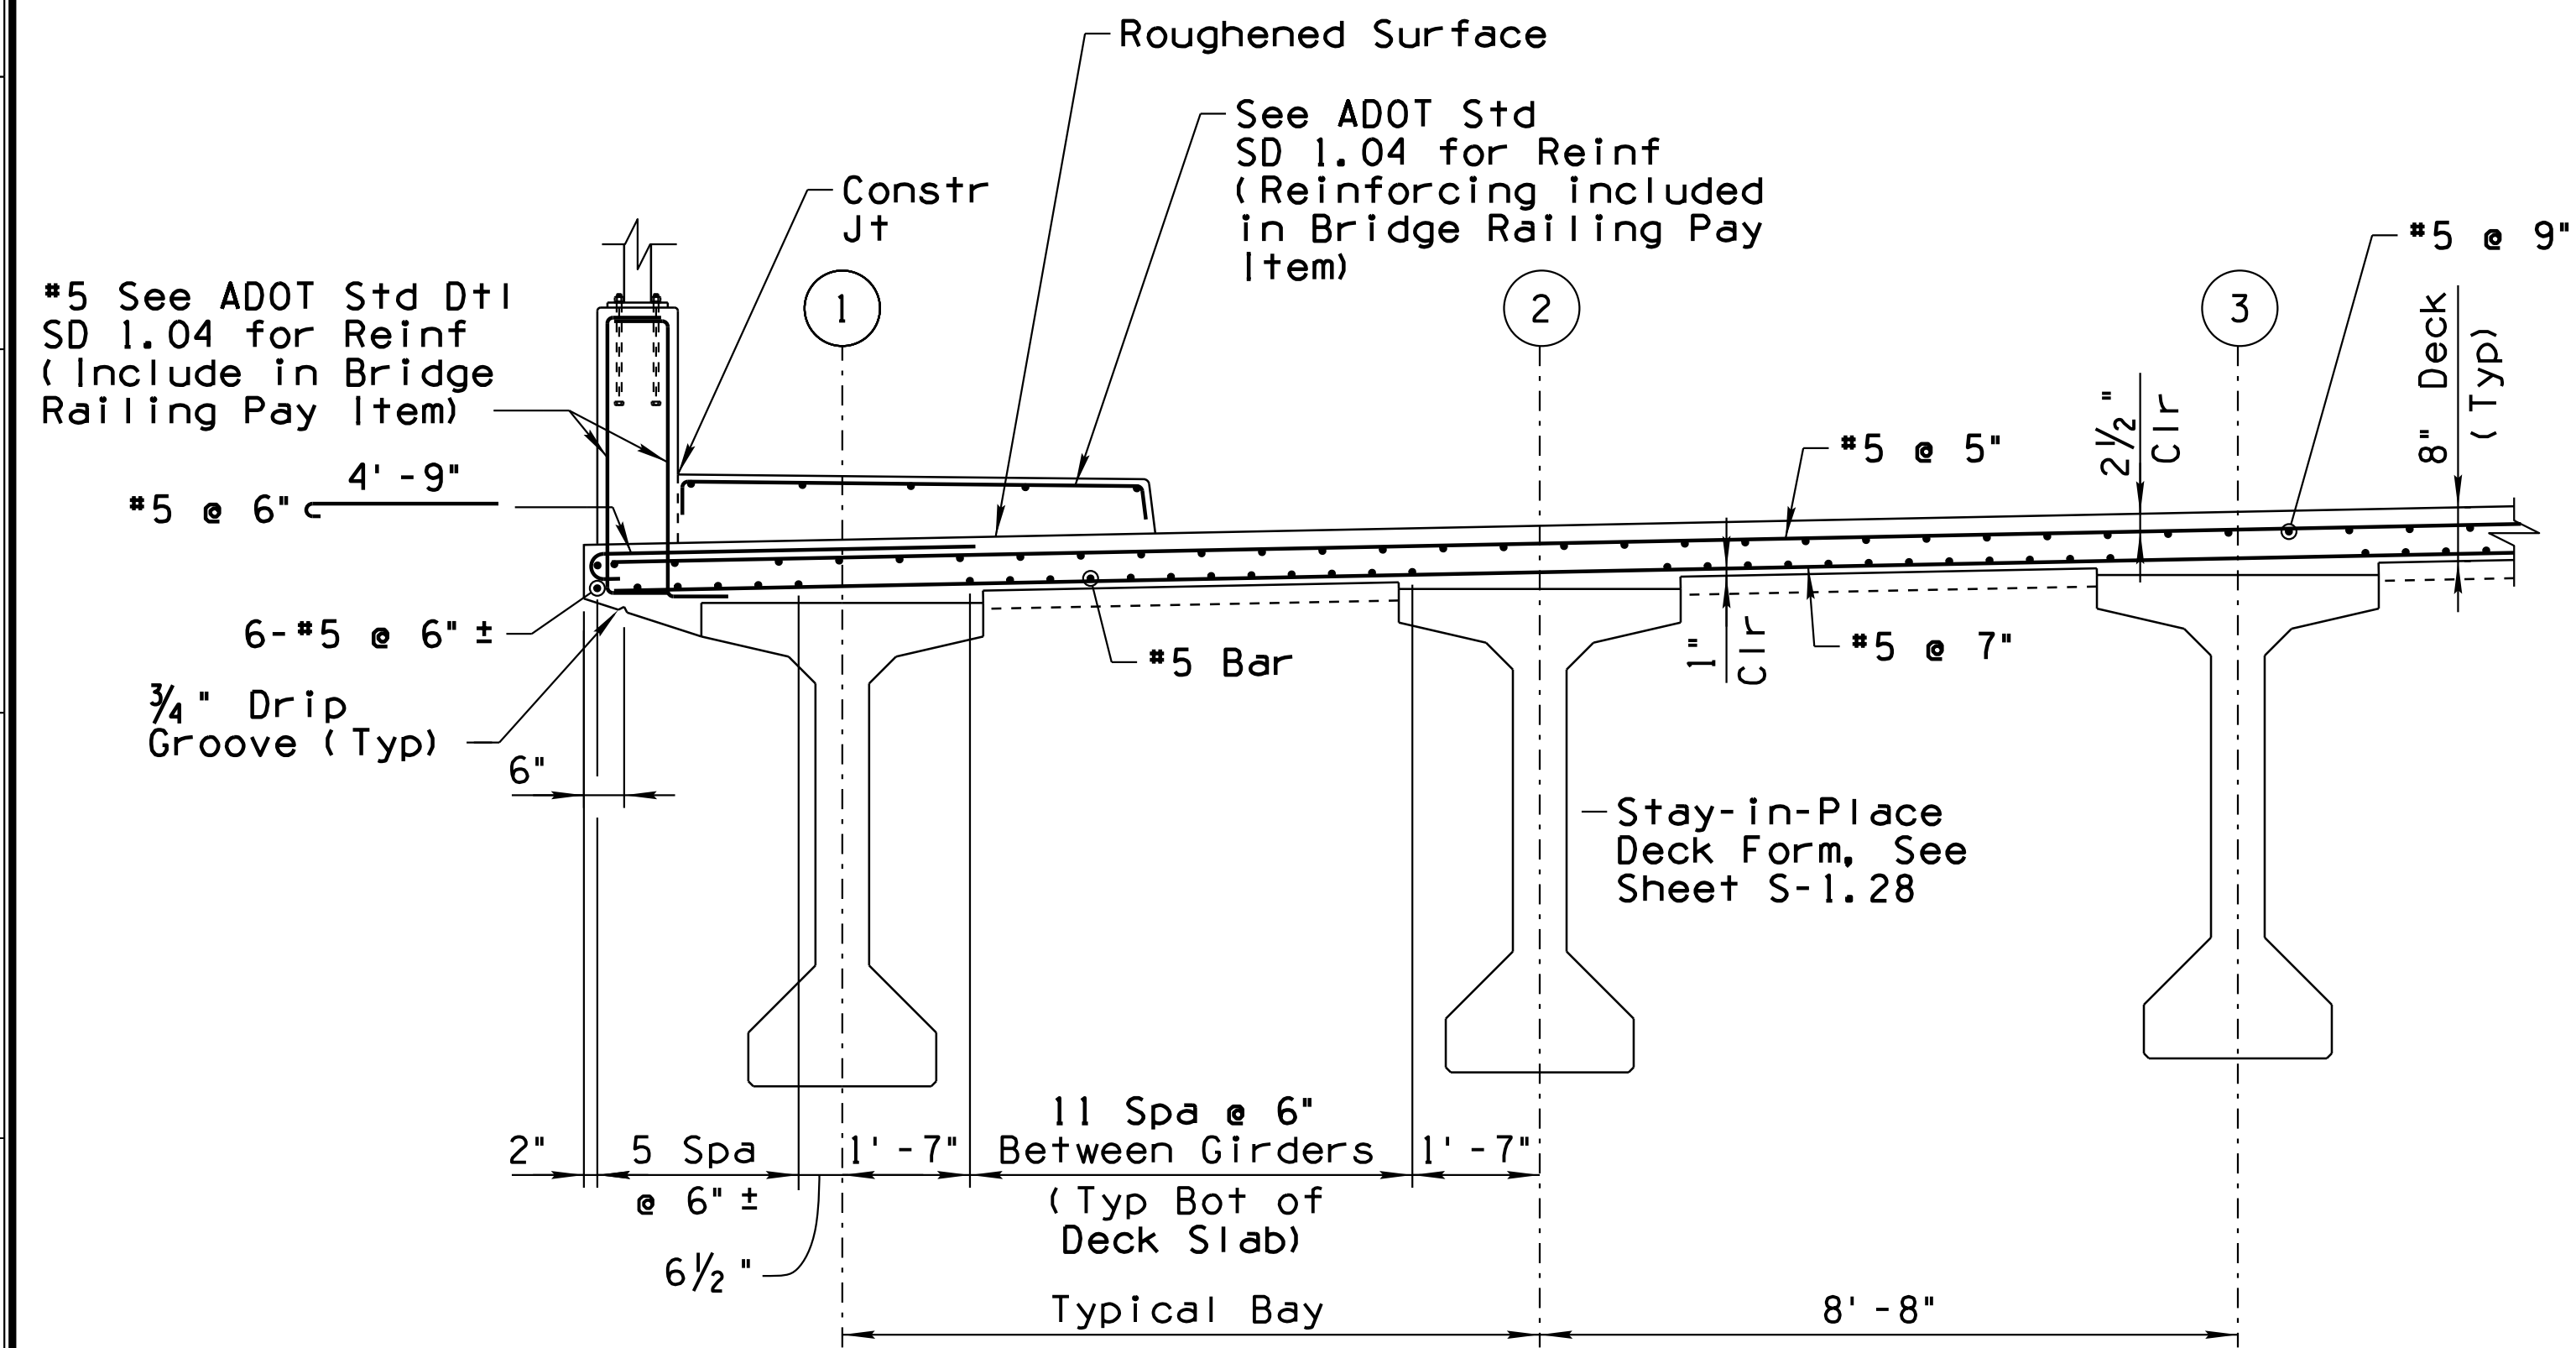

**TYPICAL PARTIAL SECTION - REINFORCEMENT**

Scale: 3/4" = 1'-0"

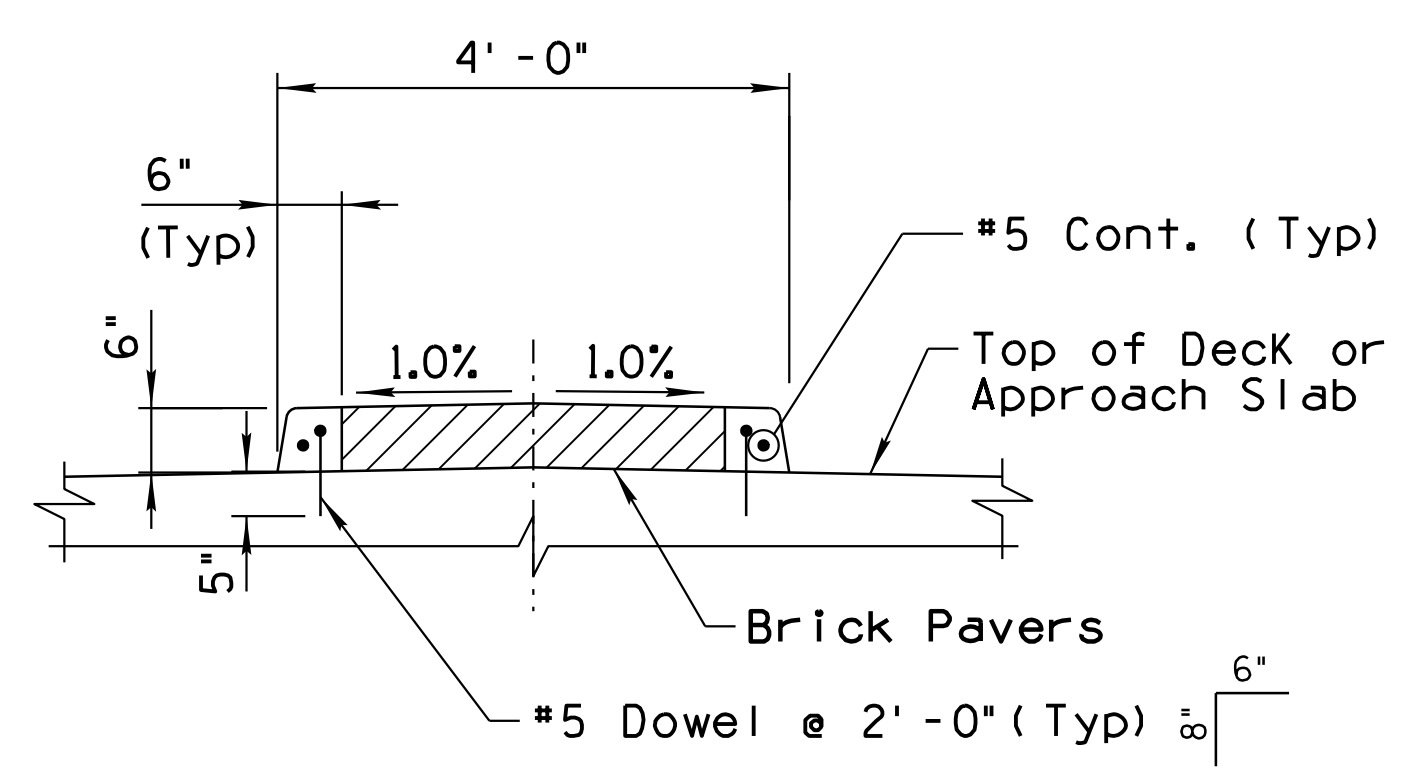

**NOTES:**

Median reinforcing shall be included in Deck Reinforcing


**MEDIAN DETAIL**

Scale: 3/4" = 1'-0"  
(Median Concrete shall be Class "S" Concrete, f'c = 4.0 Ksi. Quantity under Superstructure Concrete, f'c = 4.0 Ksi.)  
Pavers are paid for elsewhere. See Landscape Sheets.

**Notes:**



- All longitudinal reinforcement shall be placed parallel to Construction &.
- All continuous #5 horizontal bars in deck slab and barriers, including transverse slab bars, may be spliced with minimum lap length of 1'-8".
- Top transverse straight bars in deck slab shall be spliced at center of span between girders. Bottom transverse straight bars in deck slab shall be spliced at centerline of girder.
- Bars shall not be spliced within the required lap length of adjacent bars.
- (X) Indicates girder number.
- Dowels shall be installed using an epoxy from the Approved Products List. Install per Manufacturer's recommendations.

DESIGN	LES / HV	DATE	3-19	ARIZONA DEPARTMENT OF TRANSPORTATION INFRASTRUCTURE DELIVERY AND OPERATIONS DIVISION BRIDGE GROUP
DRAWN	DAY	DATE	3-19	
CHECKED	AGG / JAC	DATE	3-19	
				STA 99+ <b>RUTHRAUFF ROAD T.I. UNDERPASS          DECK SECTION</b>
I-10	252.00	20159	LOCATION	RUTHRAUFF ROAD T.I.
TRACS NO. H 8480 OIC			010-D(213)S	DWG NO. S-1.27

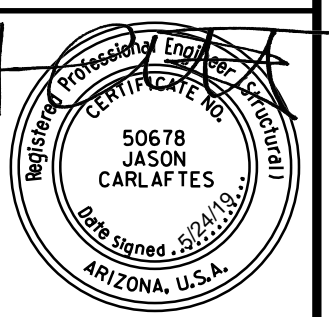

F.H.W.A. REGION	STATE	PROJECT NO.	SHEET NO.	TOTAL SHEETS	RECORD DRAWING
9	ARIZ.	010-D(213)S	641	849	


010 PM 252

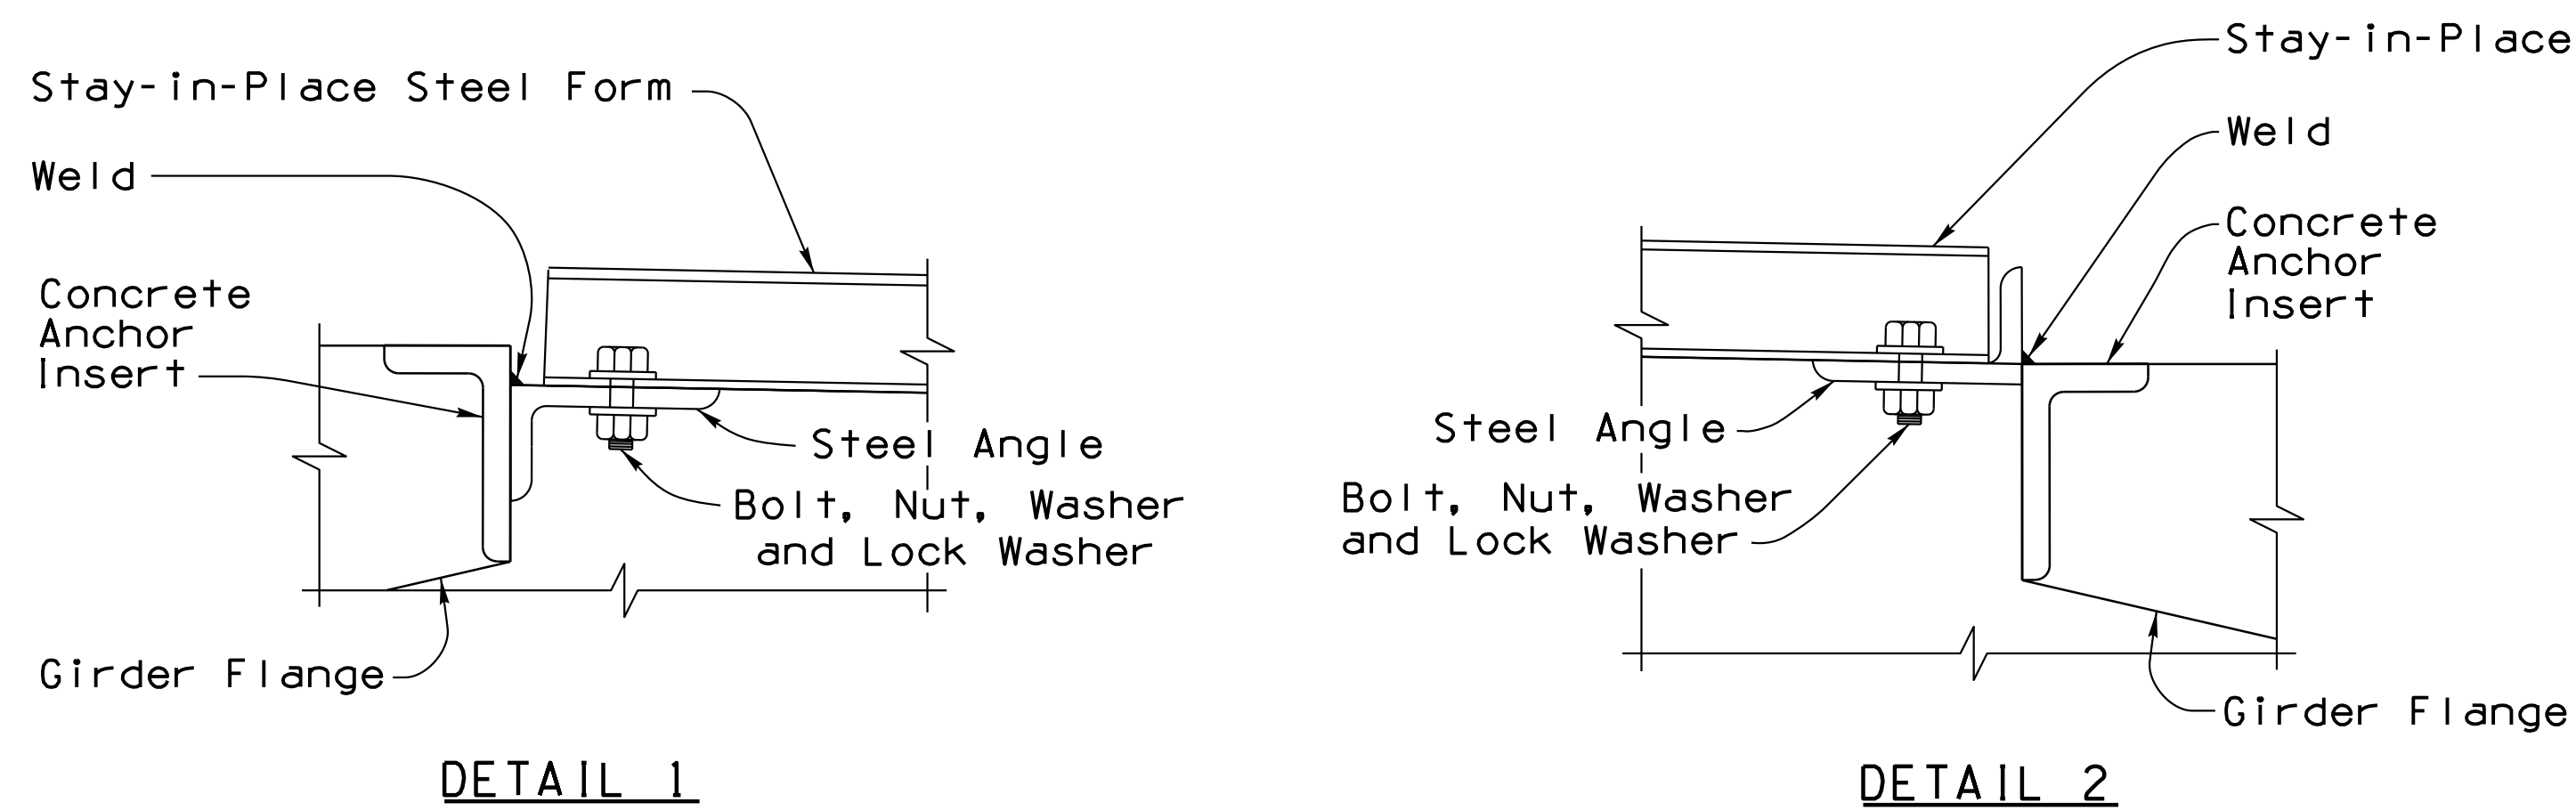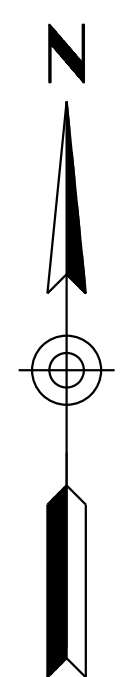

DETAIL 1

DETAIL 2

STAY-IN-PLACE STEEL DECK FORM DETAIL  
No Scale

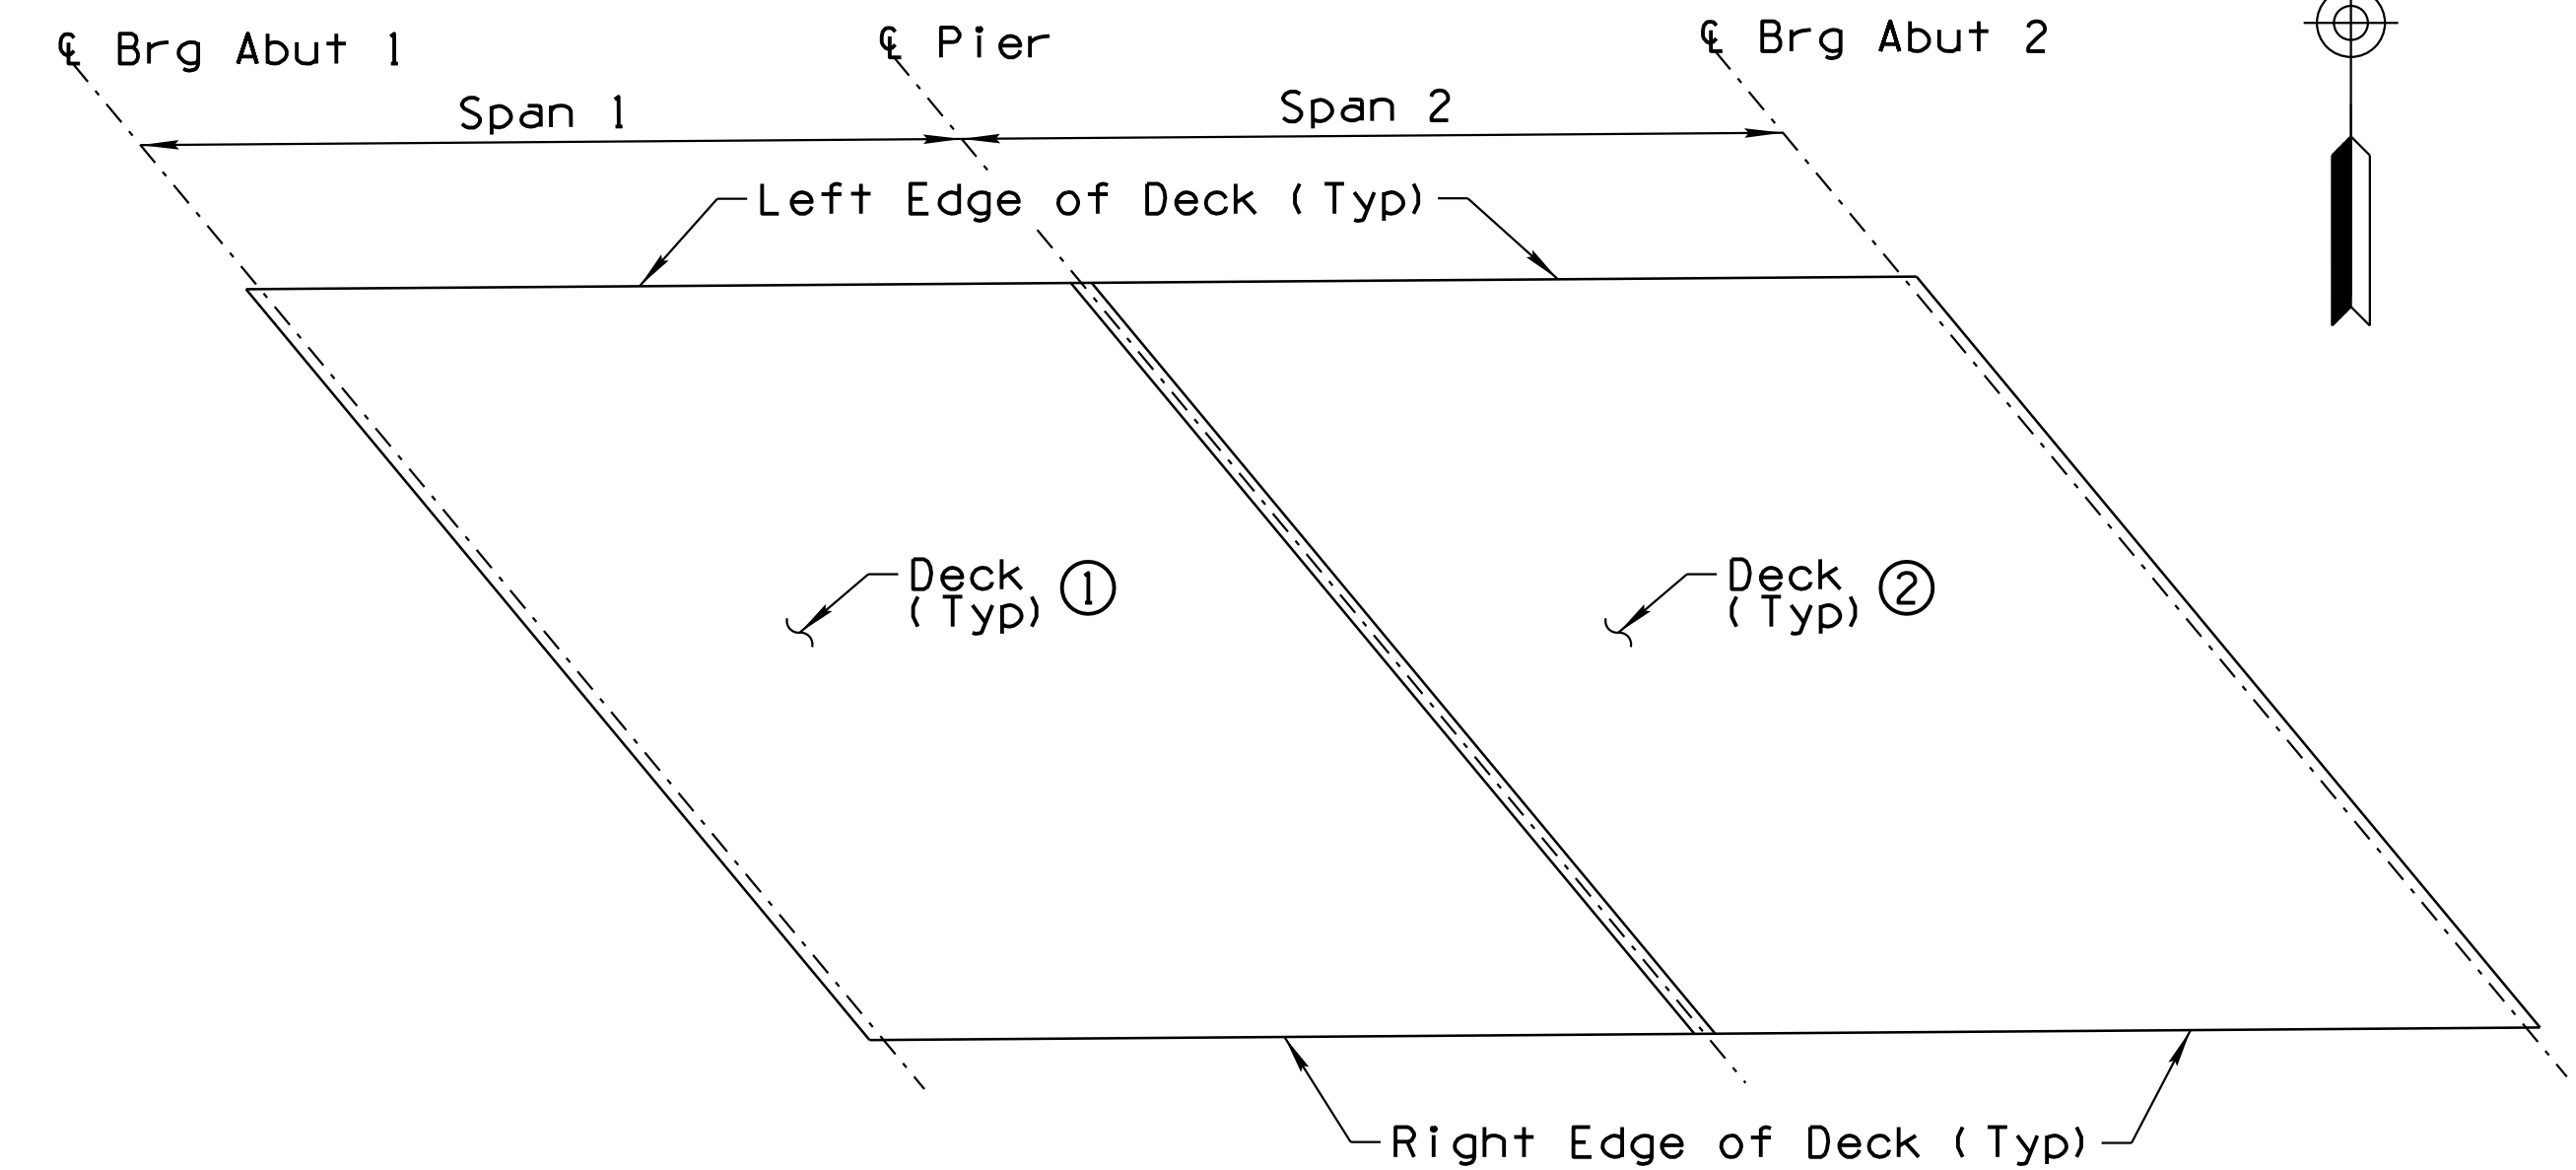

DECK POUR SEQUENCE  
No Scale


STAY IN PLACE STEEL DECK FORM NOTES:

1. The concrete insert anchors may be cast with the girder to accommodate the use of stay-in-place forms. Alternate methods of support will be considered provided the detail is adequate to support the loads, prevent leakage and allow for the adjustment for the varying build-up to maintain a constant deck thickness.
2. The Steel Forms panels and angles shall be galvanized in accordance with ASTM A123. All bolts shall conform to ASTM Specification A325. All nuts, bolts and washers shall be galvanized in accordance with the requirements of ASTM A153.
3. The Contractor shall determine the sizes of all bolts, welds, angles, etc to support the required loads.
4. The Contractor shall submit shop drawings showing details of the stay-in-place Steel forms including the method of installation and adjustment to the Bridge Engineer for approval. The Steel form submittal must be made simultaneously with the precast girder shop drawings to ensure coordination between the girder fabrication and the stay-in-place steel form design. Stay-in-place steel form details shall be sealed by a Professional Engineer Licensed in the State of Arizona.
5. The Contractor shall use due care in the placement of the girders to ensure a constant distance is maintained between girder flanges.
6. The bridge design has an assumed dead load of 15 psf for the stay-in-place steel forms and additional concrete.

POUR NOTES:


1. Numbers ① and ② indicate placing sequence of deck concrete on each span.
2. Intermediate Diaphragm, Pier and Abutment Diaphragms for each Span shall be poured prior to the Deck Pour.
3. Span 1 and Span 2 are separate pours.
4. The Contractor shall submit a Pour Schedule to the Engineer for approval prior to placing concrete.
5. It shall be the Contractor's responsibility to brace/shore girders/diaphragm formwork/falsework adequately prior to deck pour and during the pour until deck/diaphragm concrete hardens fully. The cost of the bracing is included in the cost of the deck concrete.
6. Pours Shall not occur over live traffic.

DESIGN	NAME	DATE	ARIZONA DEPARTMENT OF TRANSPORTATION INFRASTRUCTURE DELIVERY AND OPERATIONS DIVISION BRIDGE GROUP
DRAWN	LES / HV	3-19	
CHECKED	DAY	3-19	
WSP			STA 99+ RUTHRAUFF ROAD T.I. UNDERPASS DECK DETAILS
WSP USA Inc. 177 N. Church Avenue Suite 1105 Tucson, AZ 85701			
I-10	252.00	20159	LOCATION RUTHRAUFF ROAD T.I.
ROUTE	MILEPOST	STRUCTURE NO.	DWG NO. S-1.28
TRACS NO. H 8480 OIC			010-D(213)S

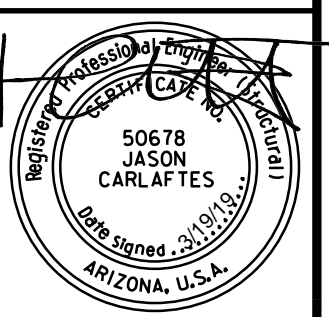


F.H.W.A. REGION	STATE	PROJECT NO.	SHEET NO.	TOTAL SHEETS	RECORD DRAWING
9	ARIZ.	010-D(213)S	642	849	

010 PM 252

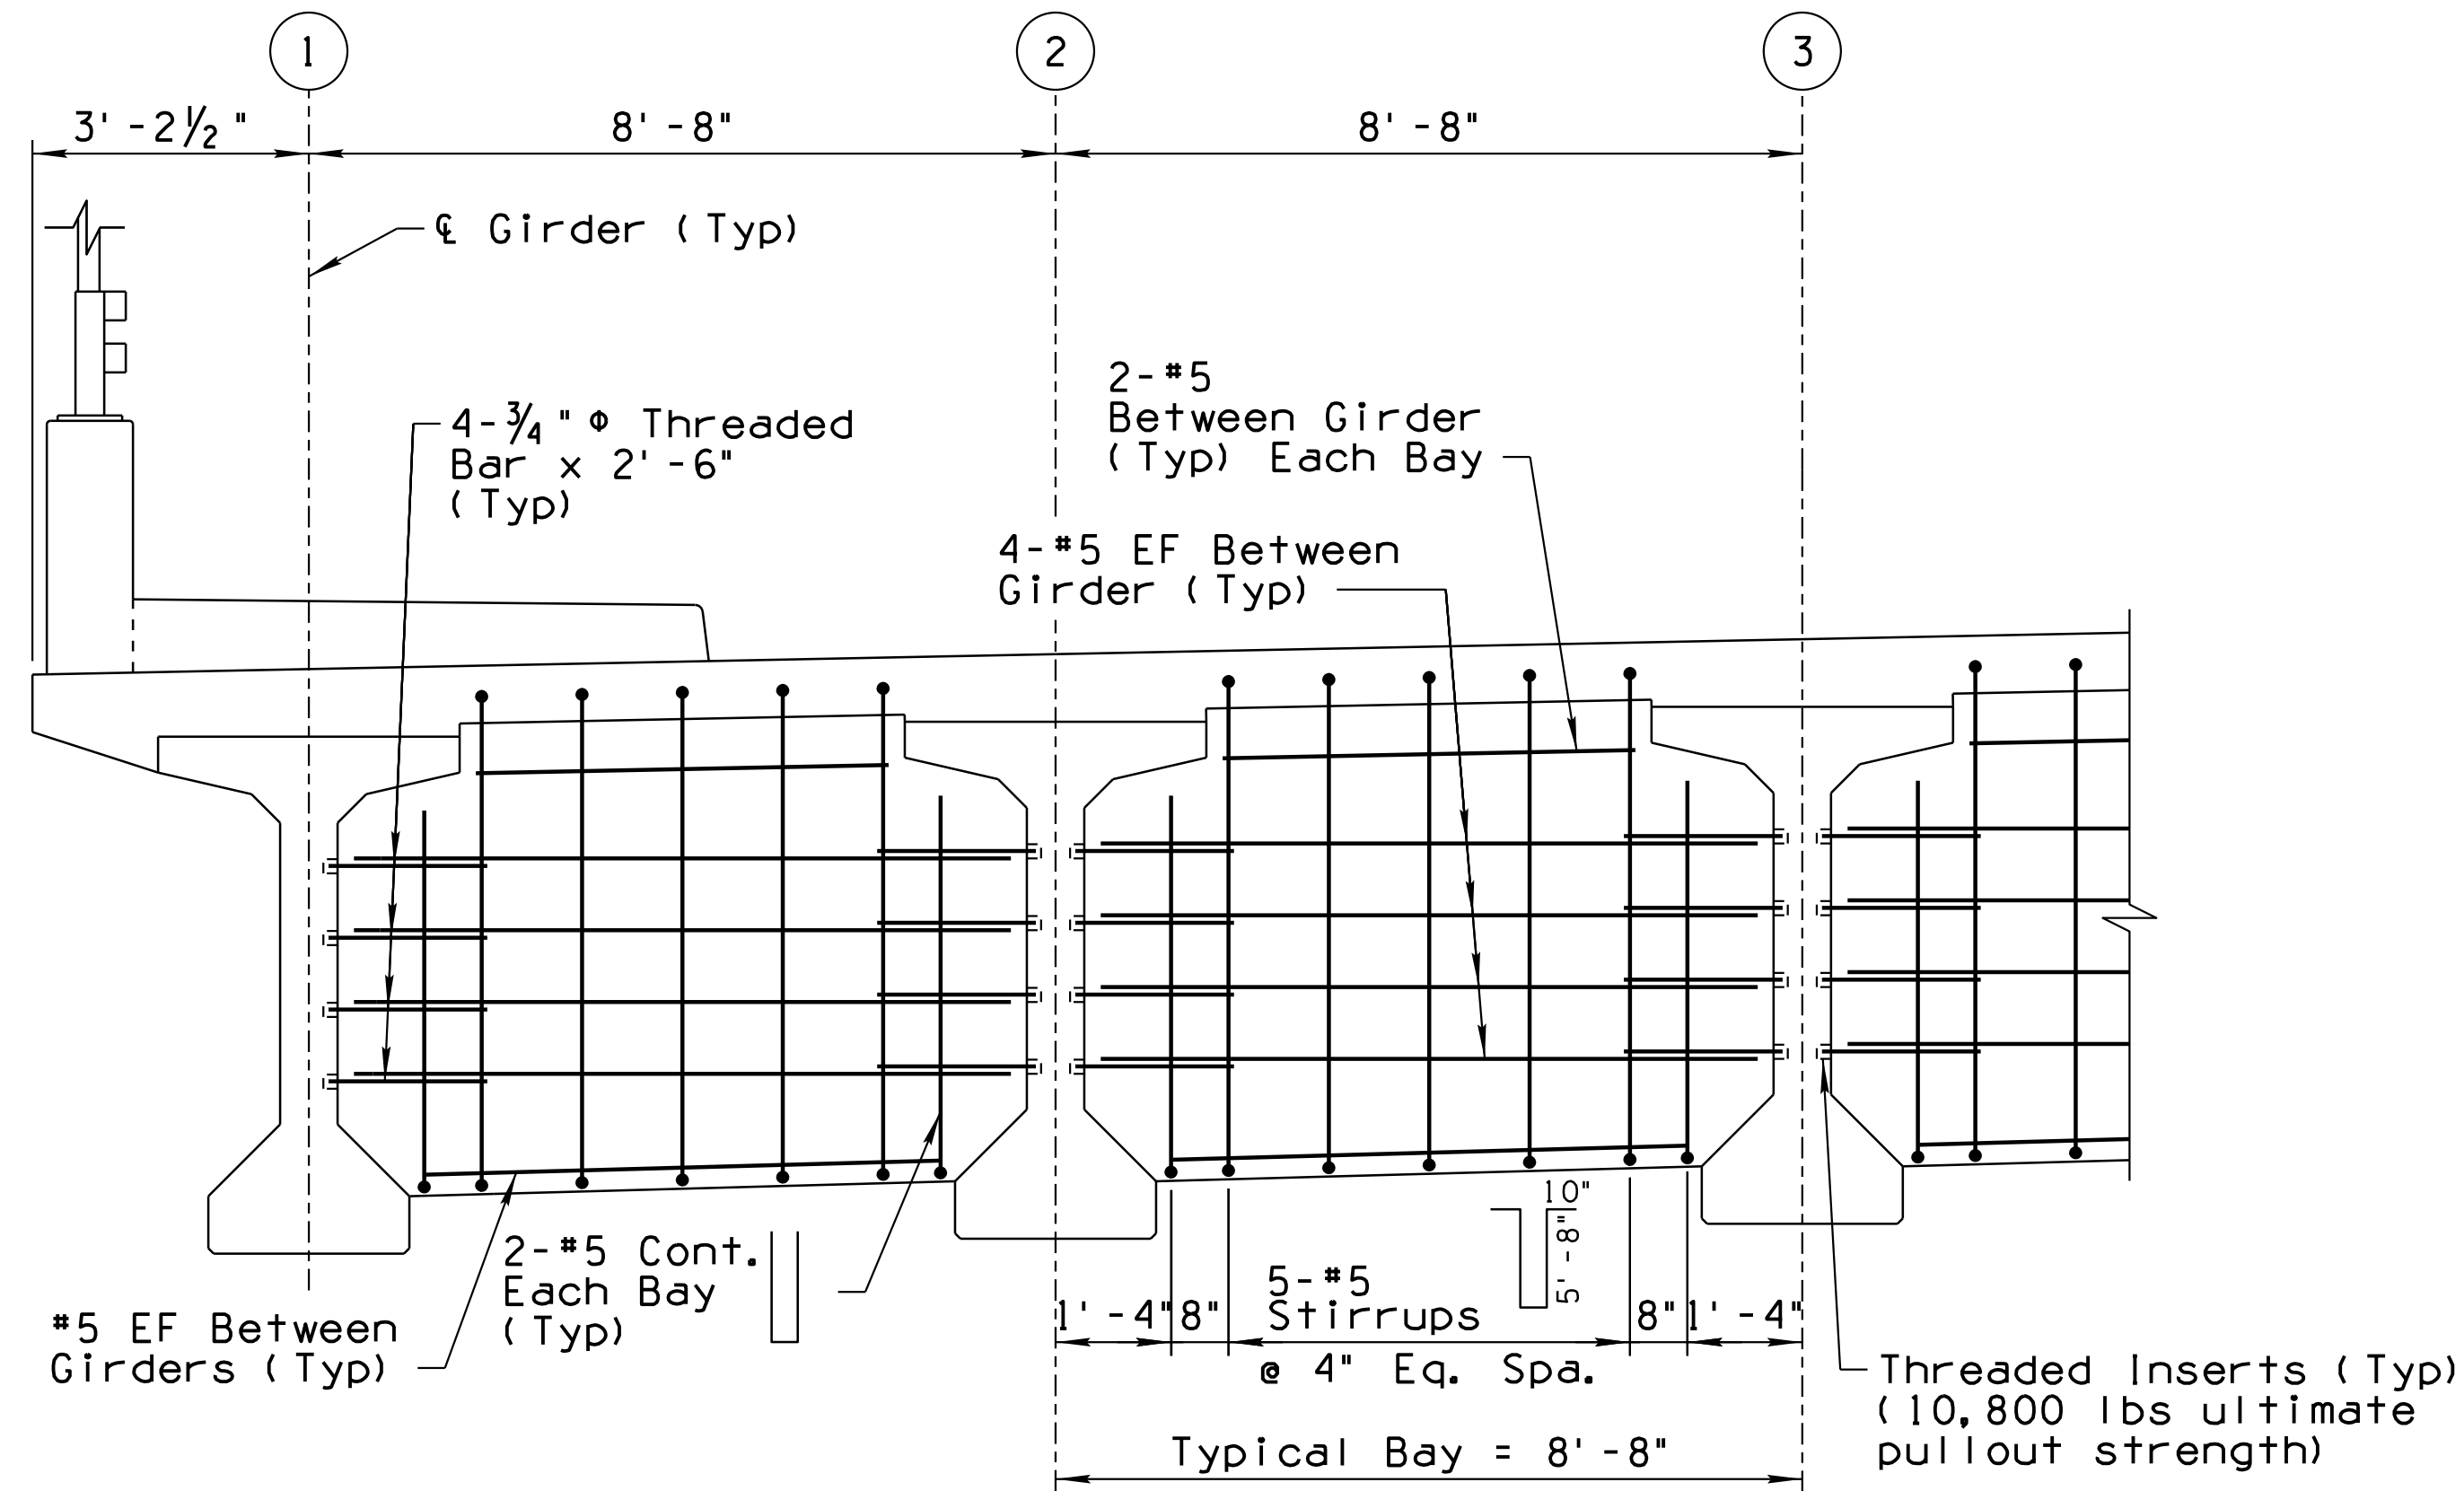

**ELEVATION**


\* Intermediate Diaphragm Concrete shall be Class "S", f'c=4.5 ksi under Superstructure Concrete

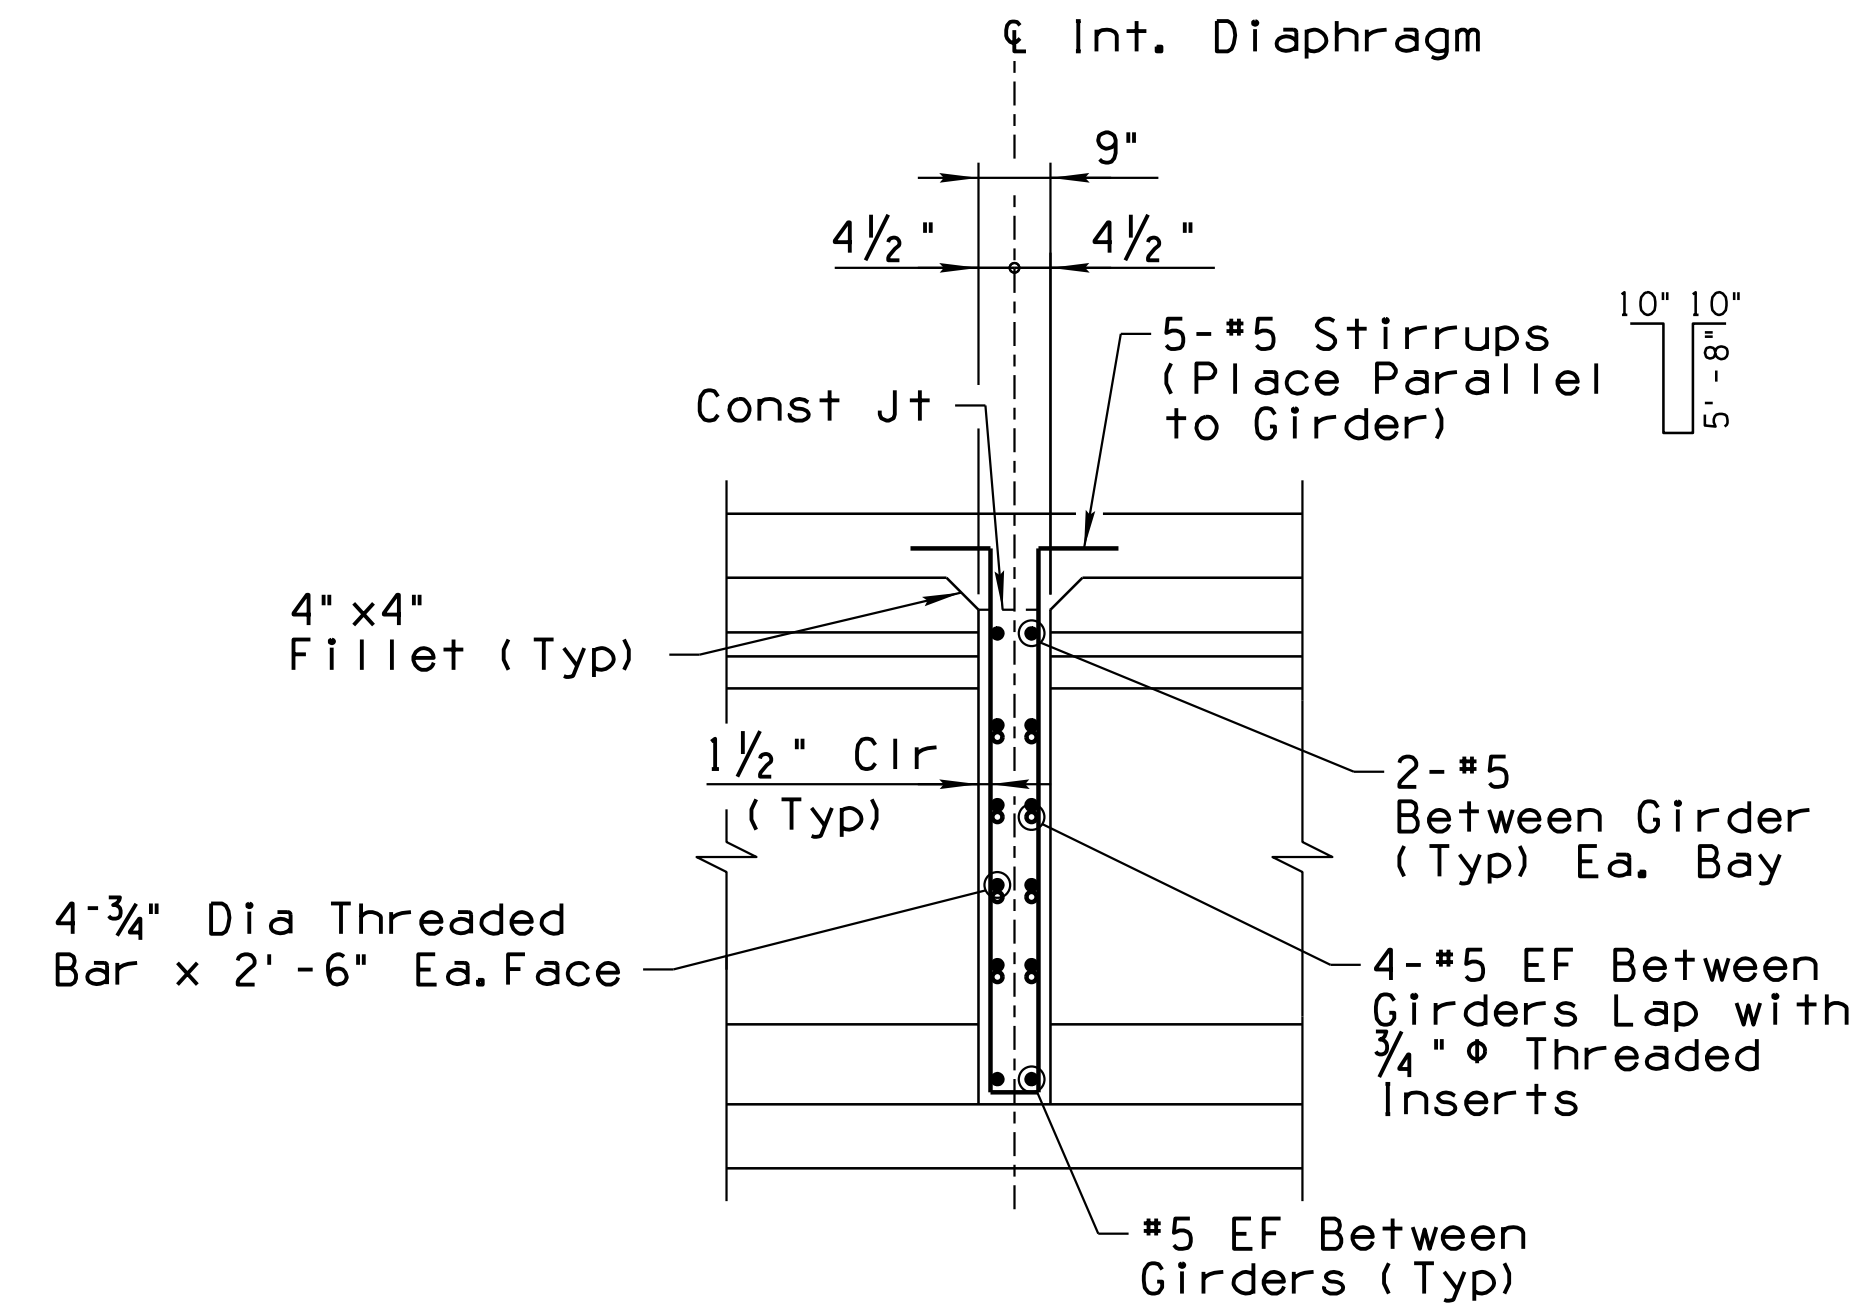

**SECTION**


**INTERMEDIATE DIAPHRAGM DETAIL**

Scale: 1/2" = 1'-0"

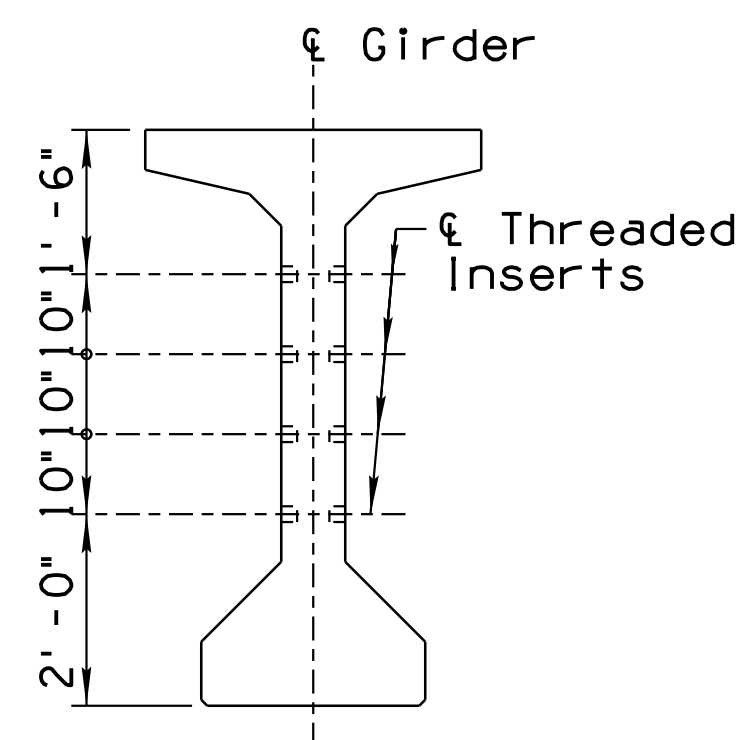

**TYPICAL GIRDER INSERT DETAIL**

@ Int. Diaphragm only

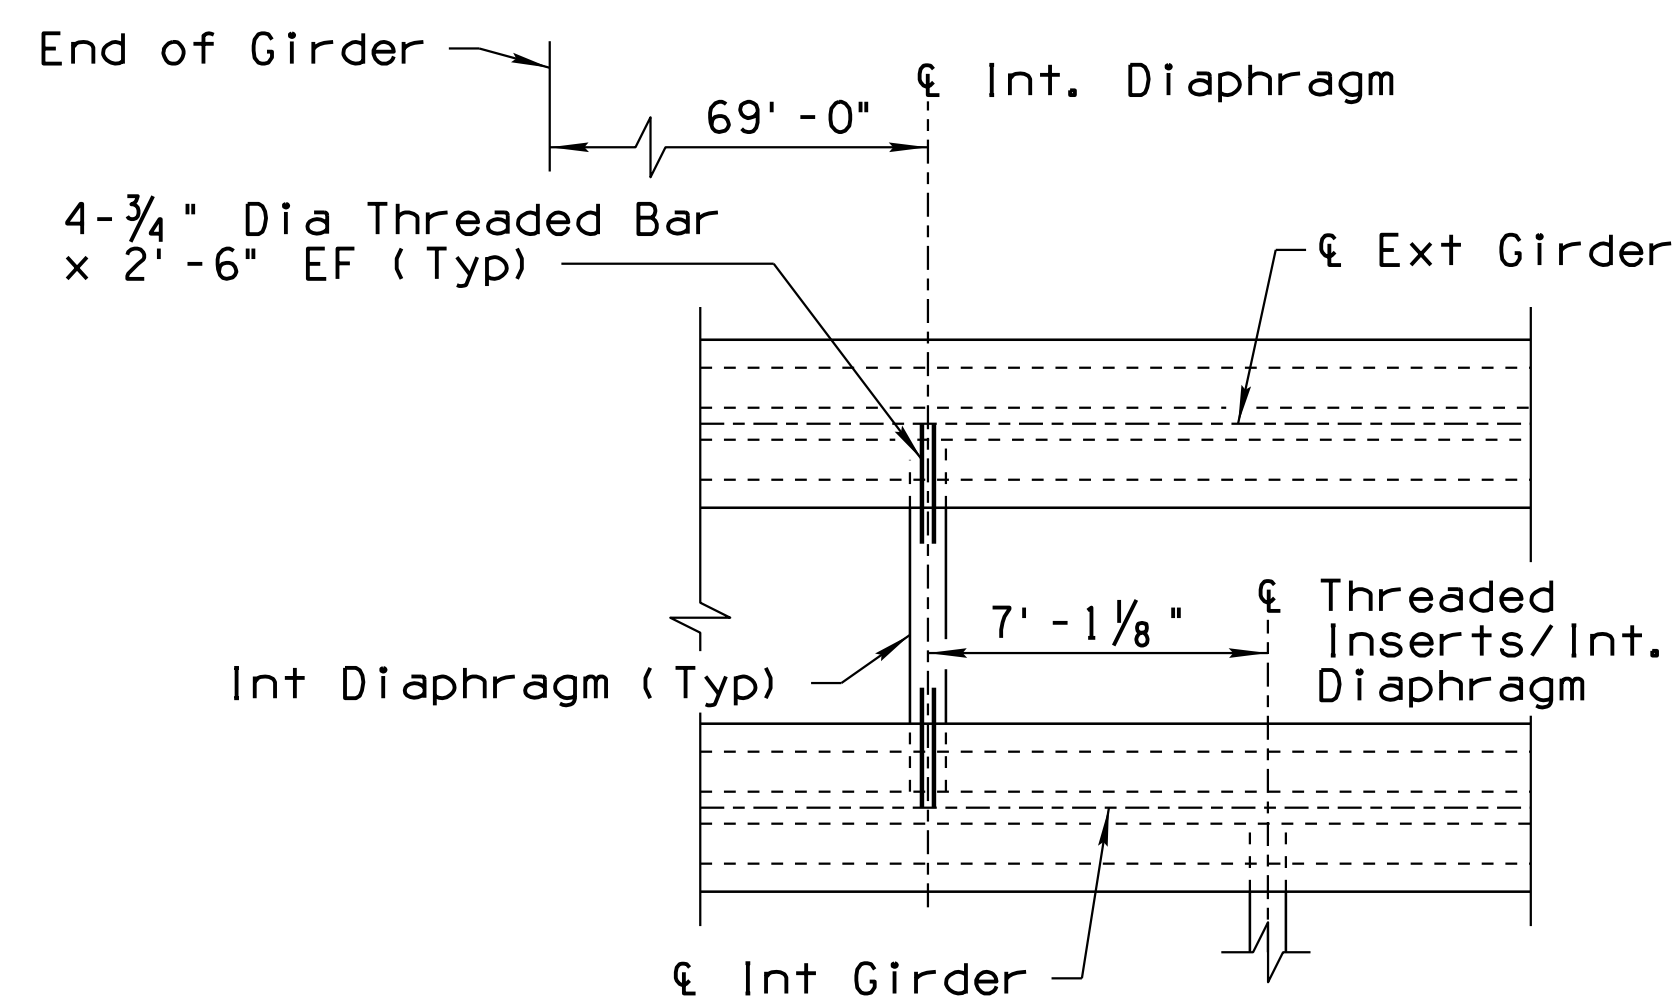

**DETAIL**


Scale: 1/2" = 1'-0"

4 4  
1.2 1.22

**INSERT NOTES:**


1. Threaded inserts in Intermediate Diaphragms are Ferrule Loop inserts for 3/4" dia Threaded bars. Inserts shall have a 10,800 lbs ultimate pullout strength.
2. Threaded inserts shall be placed normal to girder web.

DESIGN	NAME	DATE	ARIZONA DEPARTMENT OF TRANSPORTATION INFRASTRUCTURE DELIVERY AND OPERATIONS DIVISION BRIDGE GROUP
DRAWN	LES / HV	3-19	
CHECKED	DAY	3-19	
			<b>STA 99+ RUTHRAUFF ROAD T.I. UNDERPASS INT DIAPHRAGM DETAILS</b>
I-10	252.00	20159	
TRACS NO. H 8480 OIC			DWG NO. S-1.29
010-D(213)S			OF

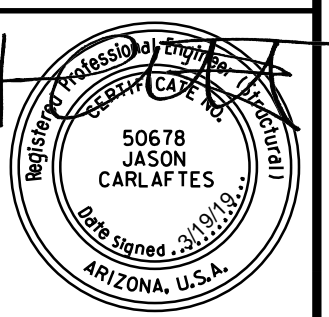


F.H.W.A. REGION	STATE	PROJECT NO.	SHEET NO.	TOTAL SHEETS	RECORD DRAWING
9	ARIZ.	010-D(213)S	643	849	

010 PM 252

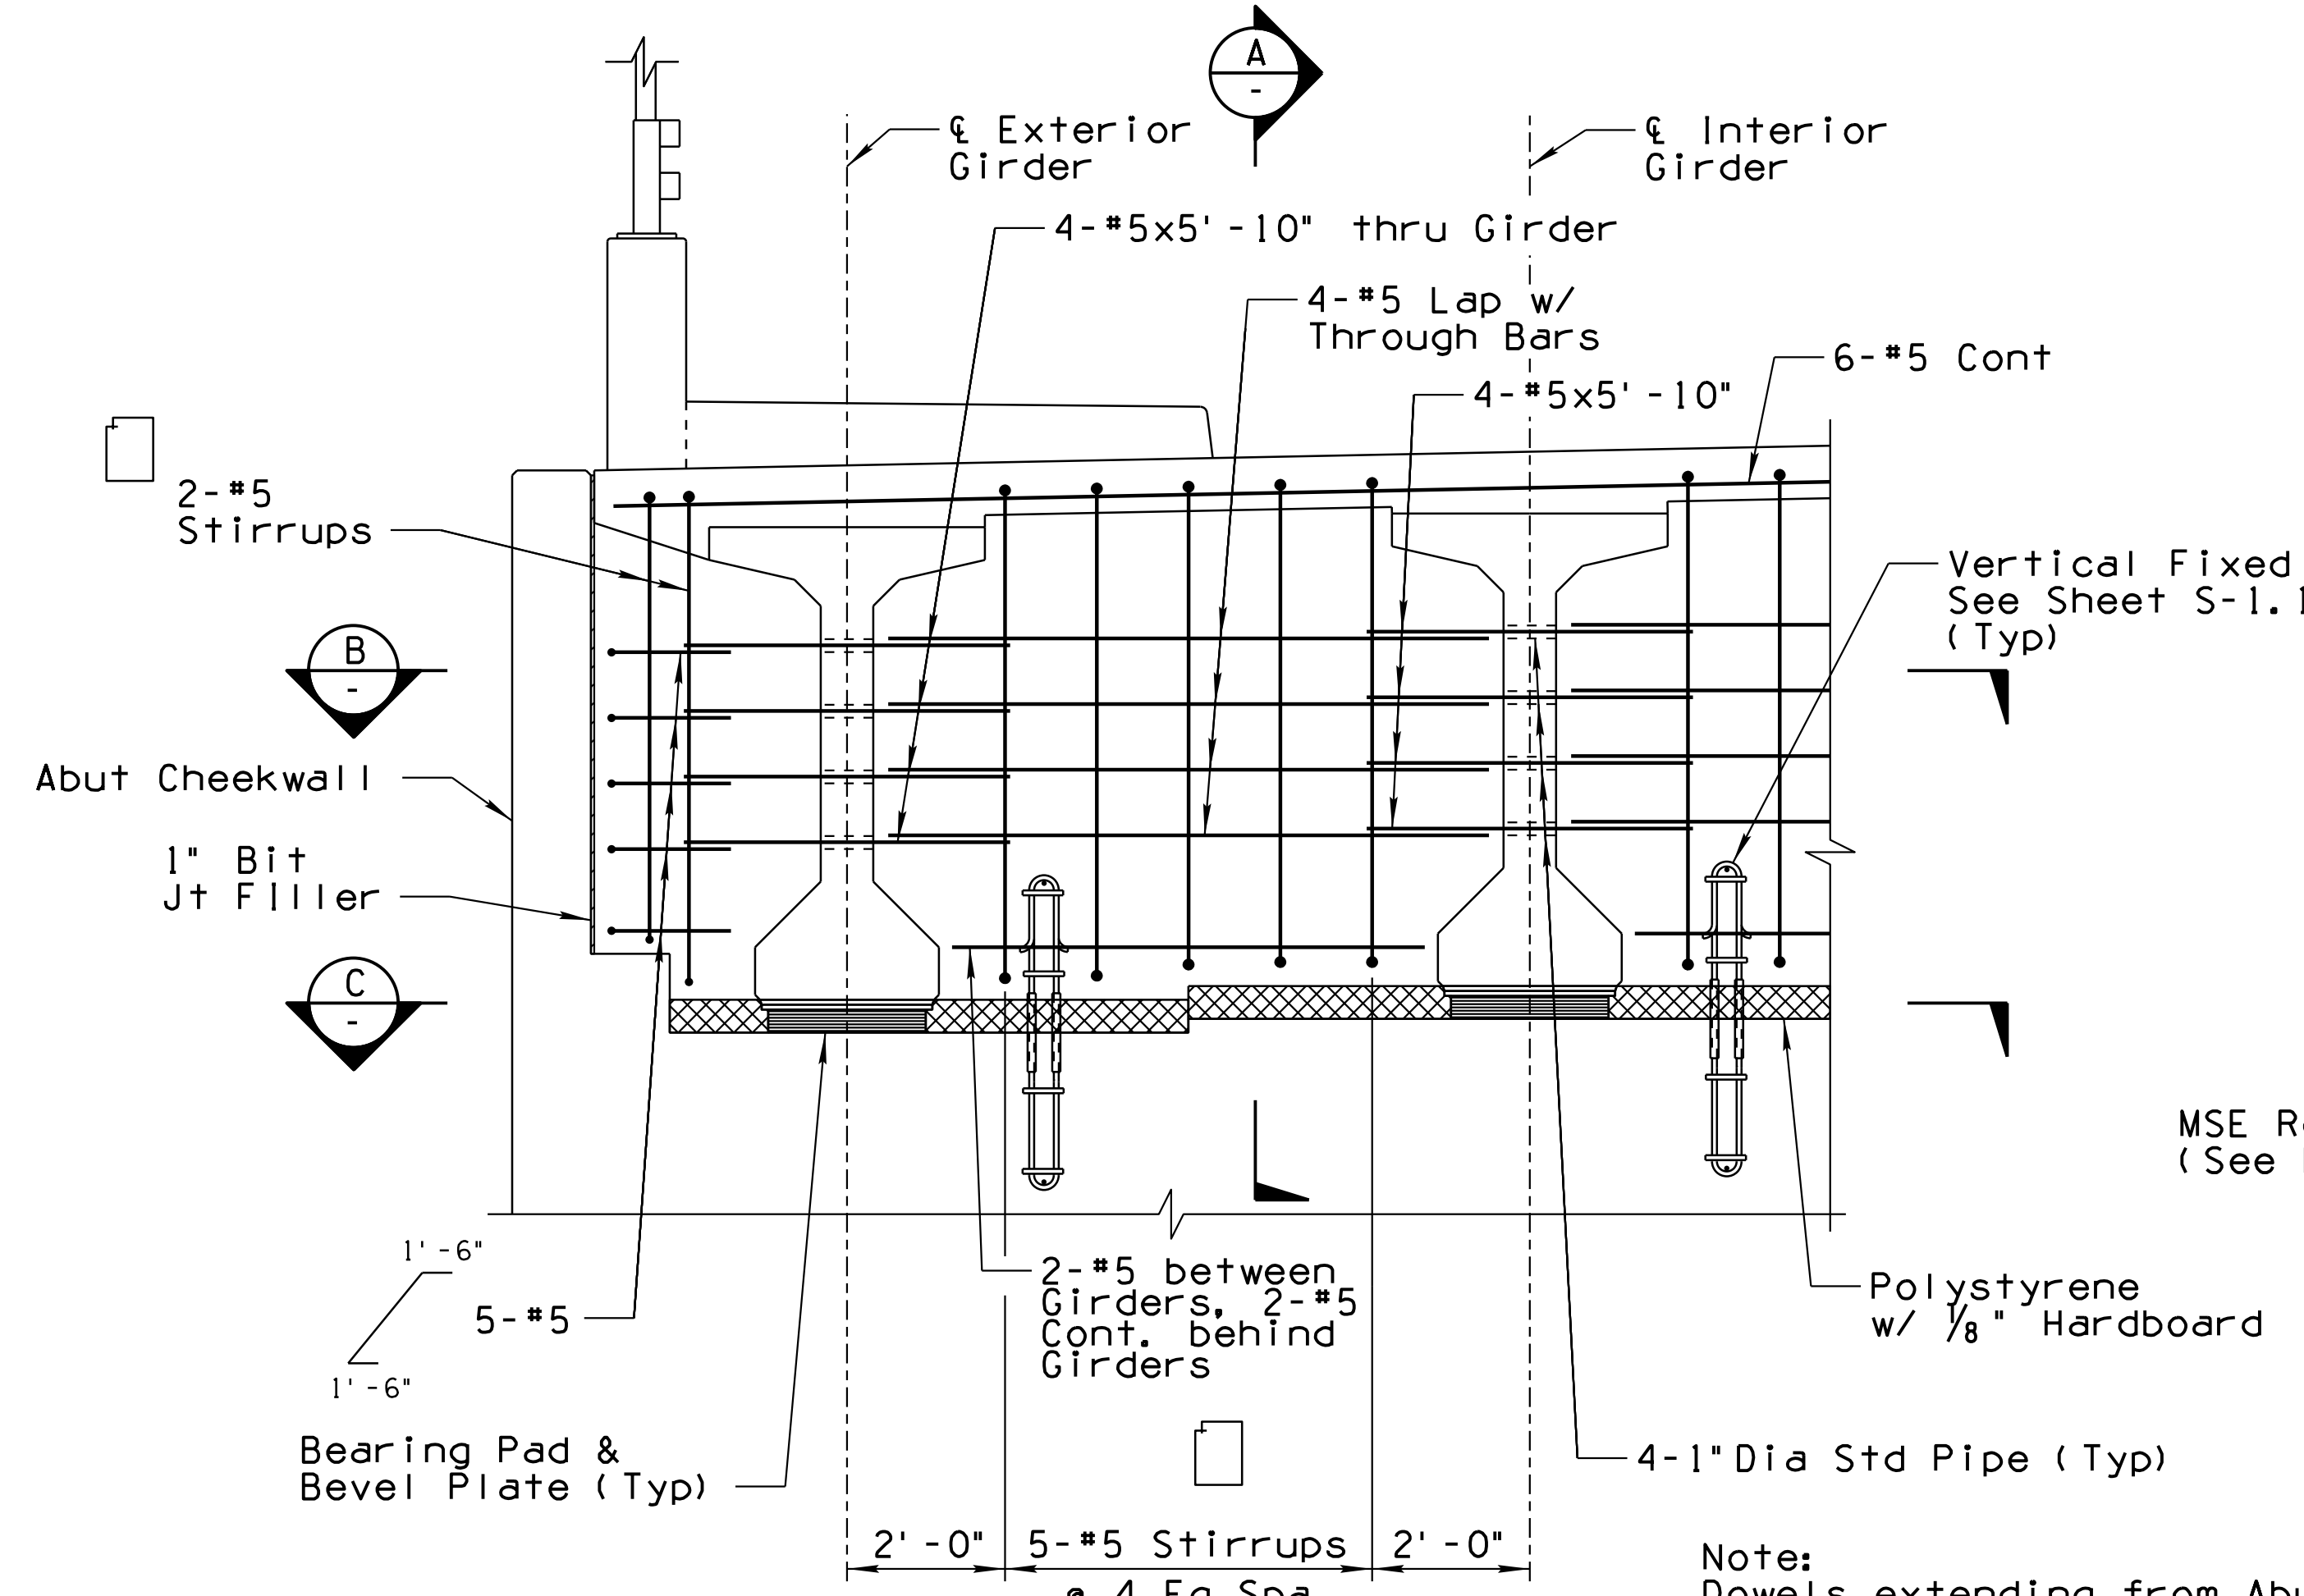


PARTIAL ELEVATION AT ABUTMENT  
Scale: 1/2" = 1'-0"

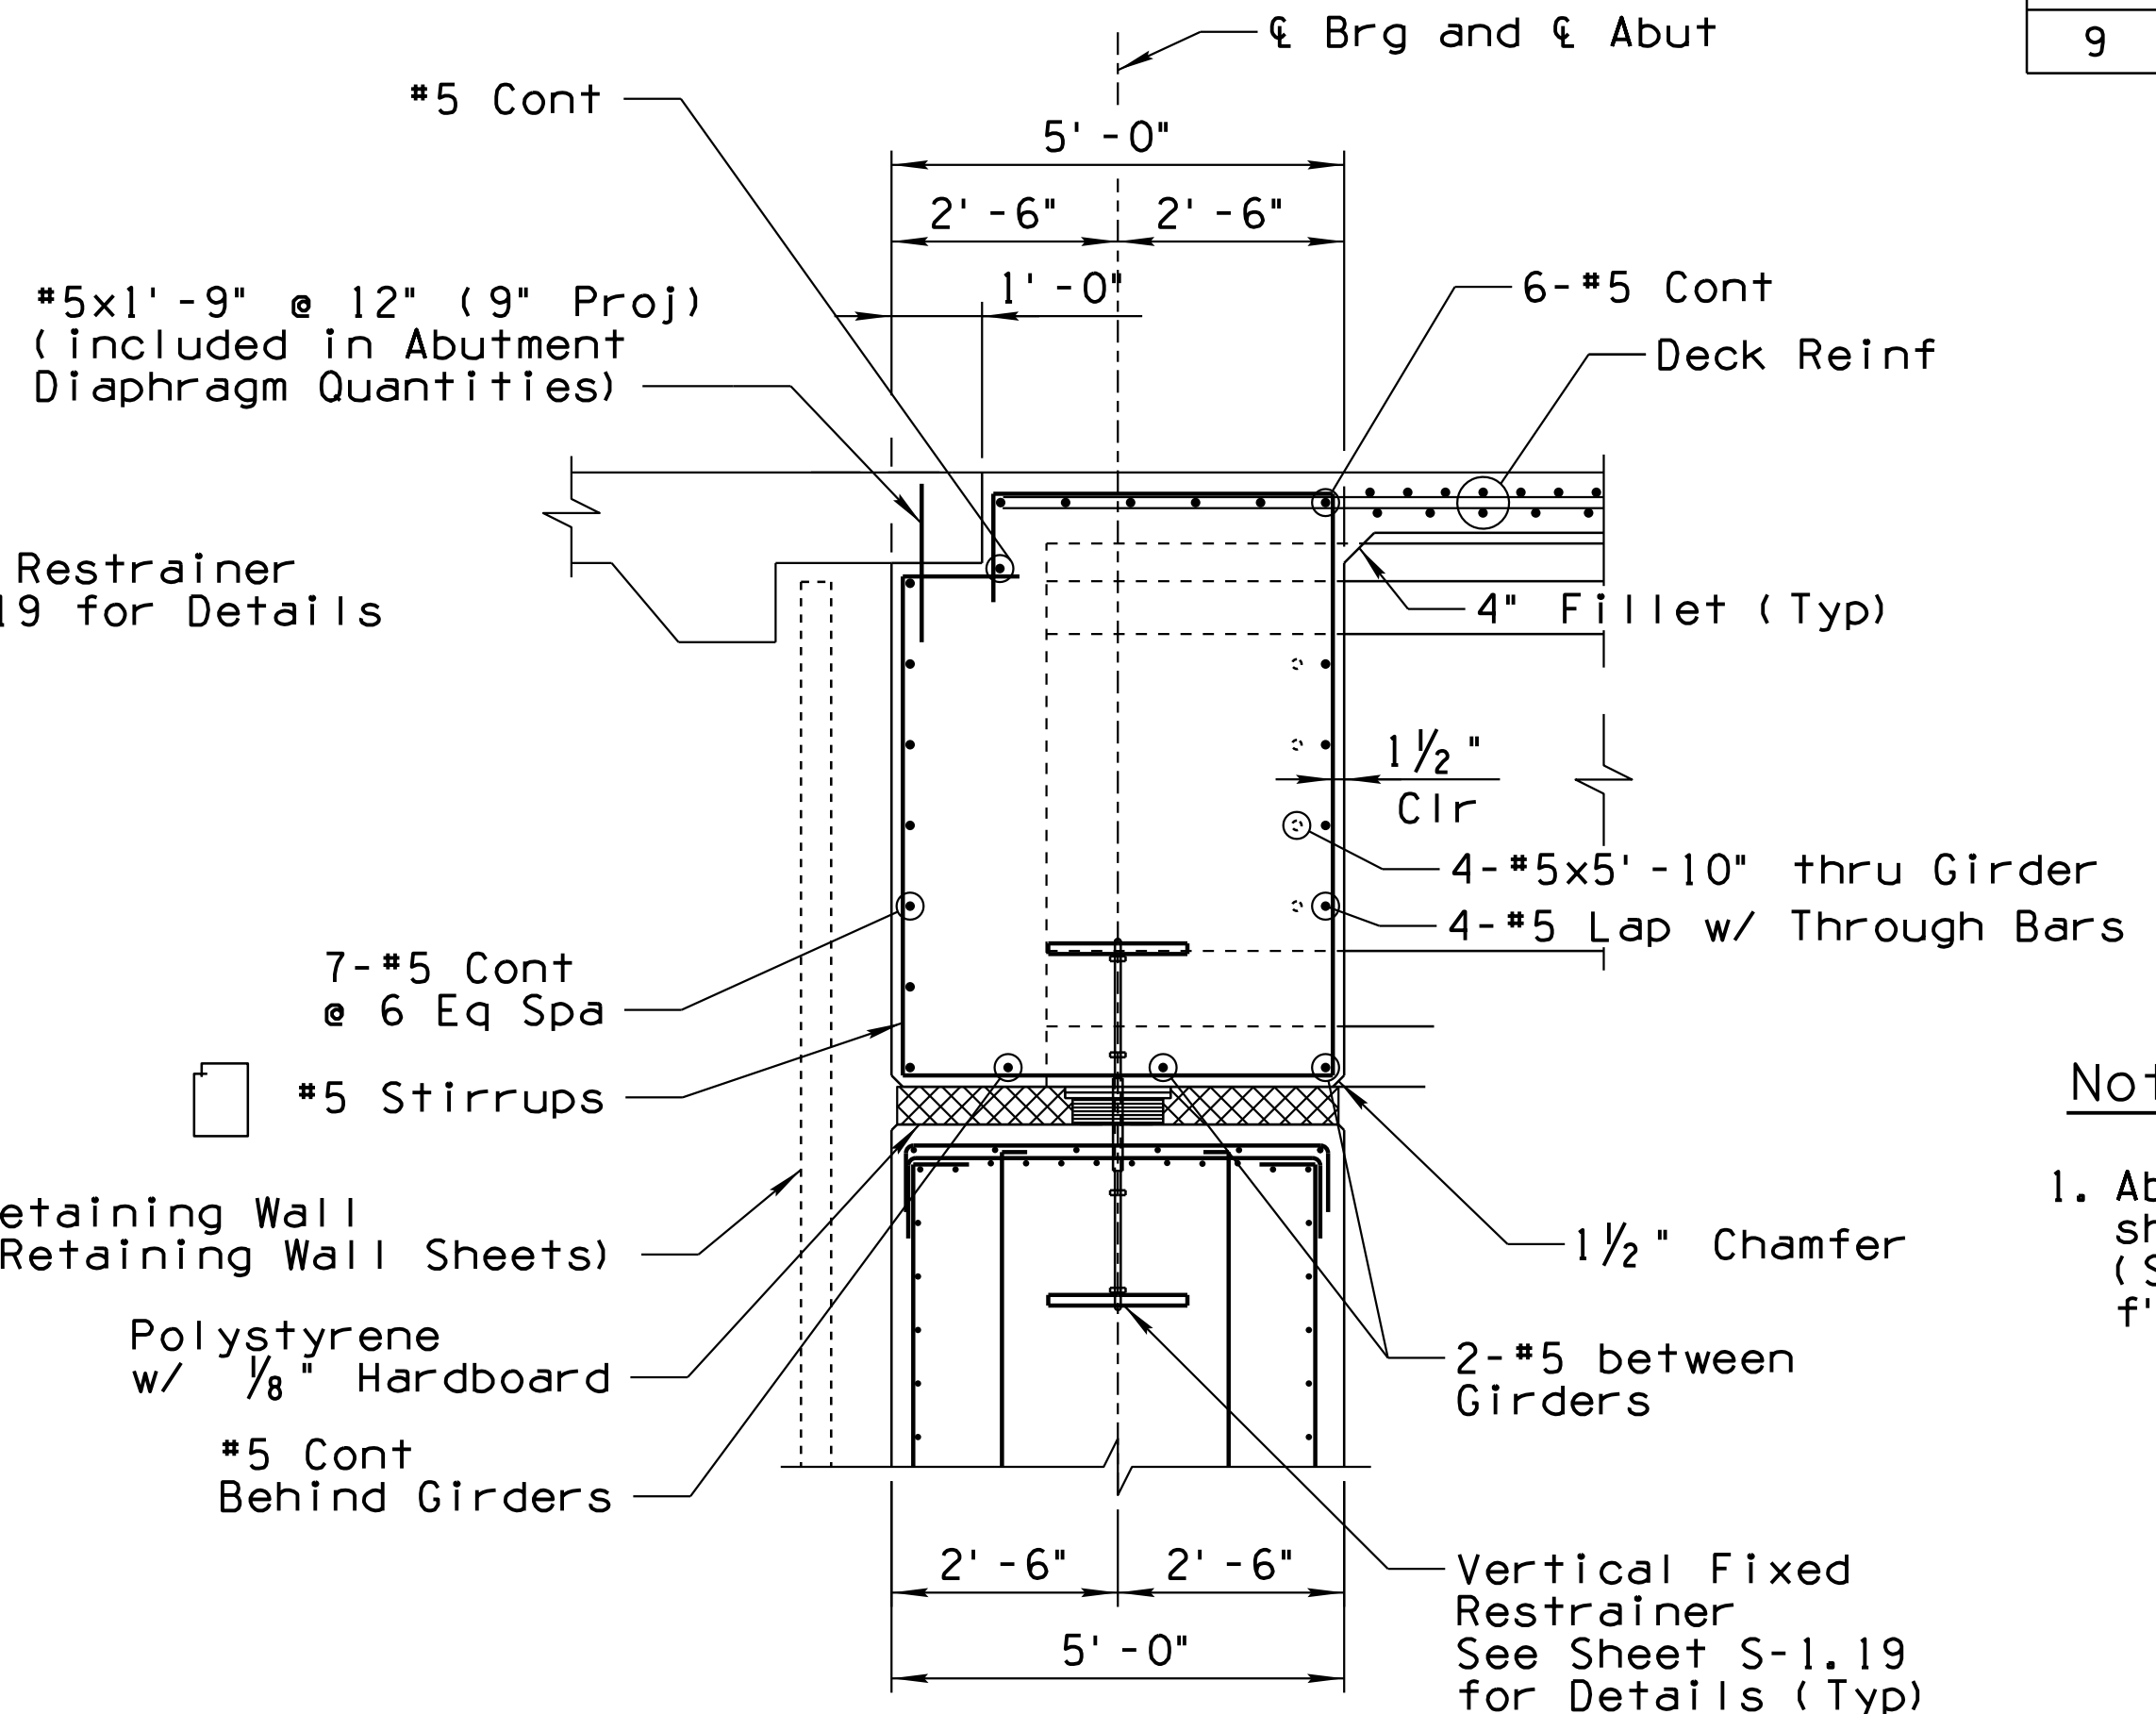


SECTION A  
Scale: 1/2" = 1'-0"

Notes:  
1. Abutment Diaphragm Concrete shall be f'c=4.5 ksi under (Superstructure Concrete f'c=4.5 ksi)

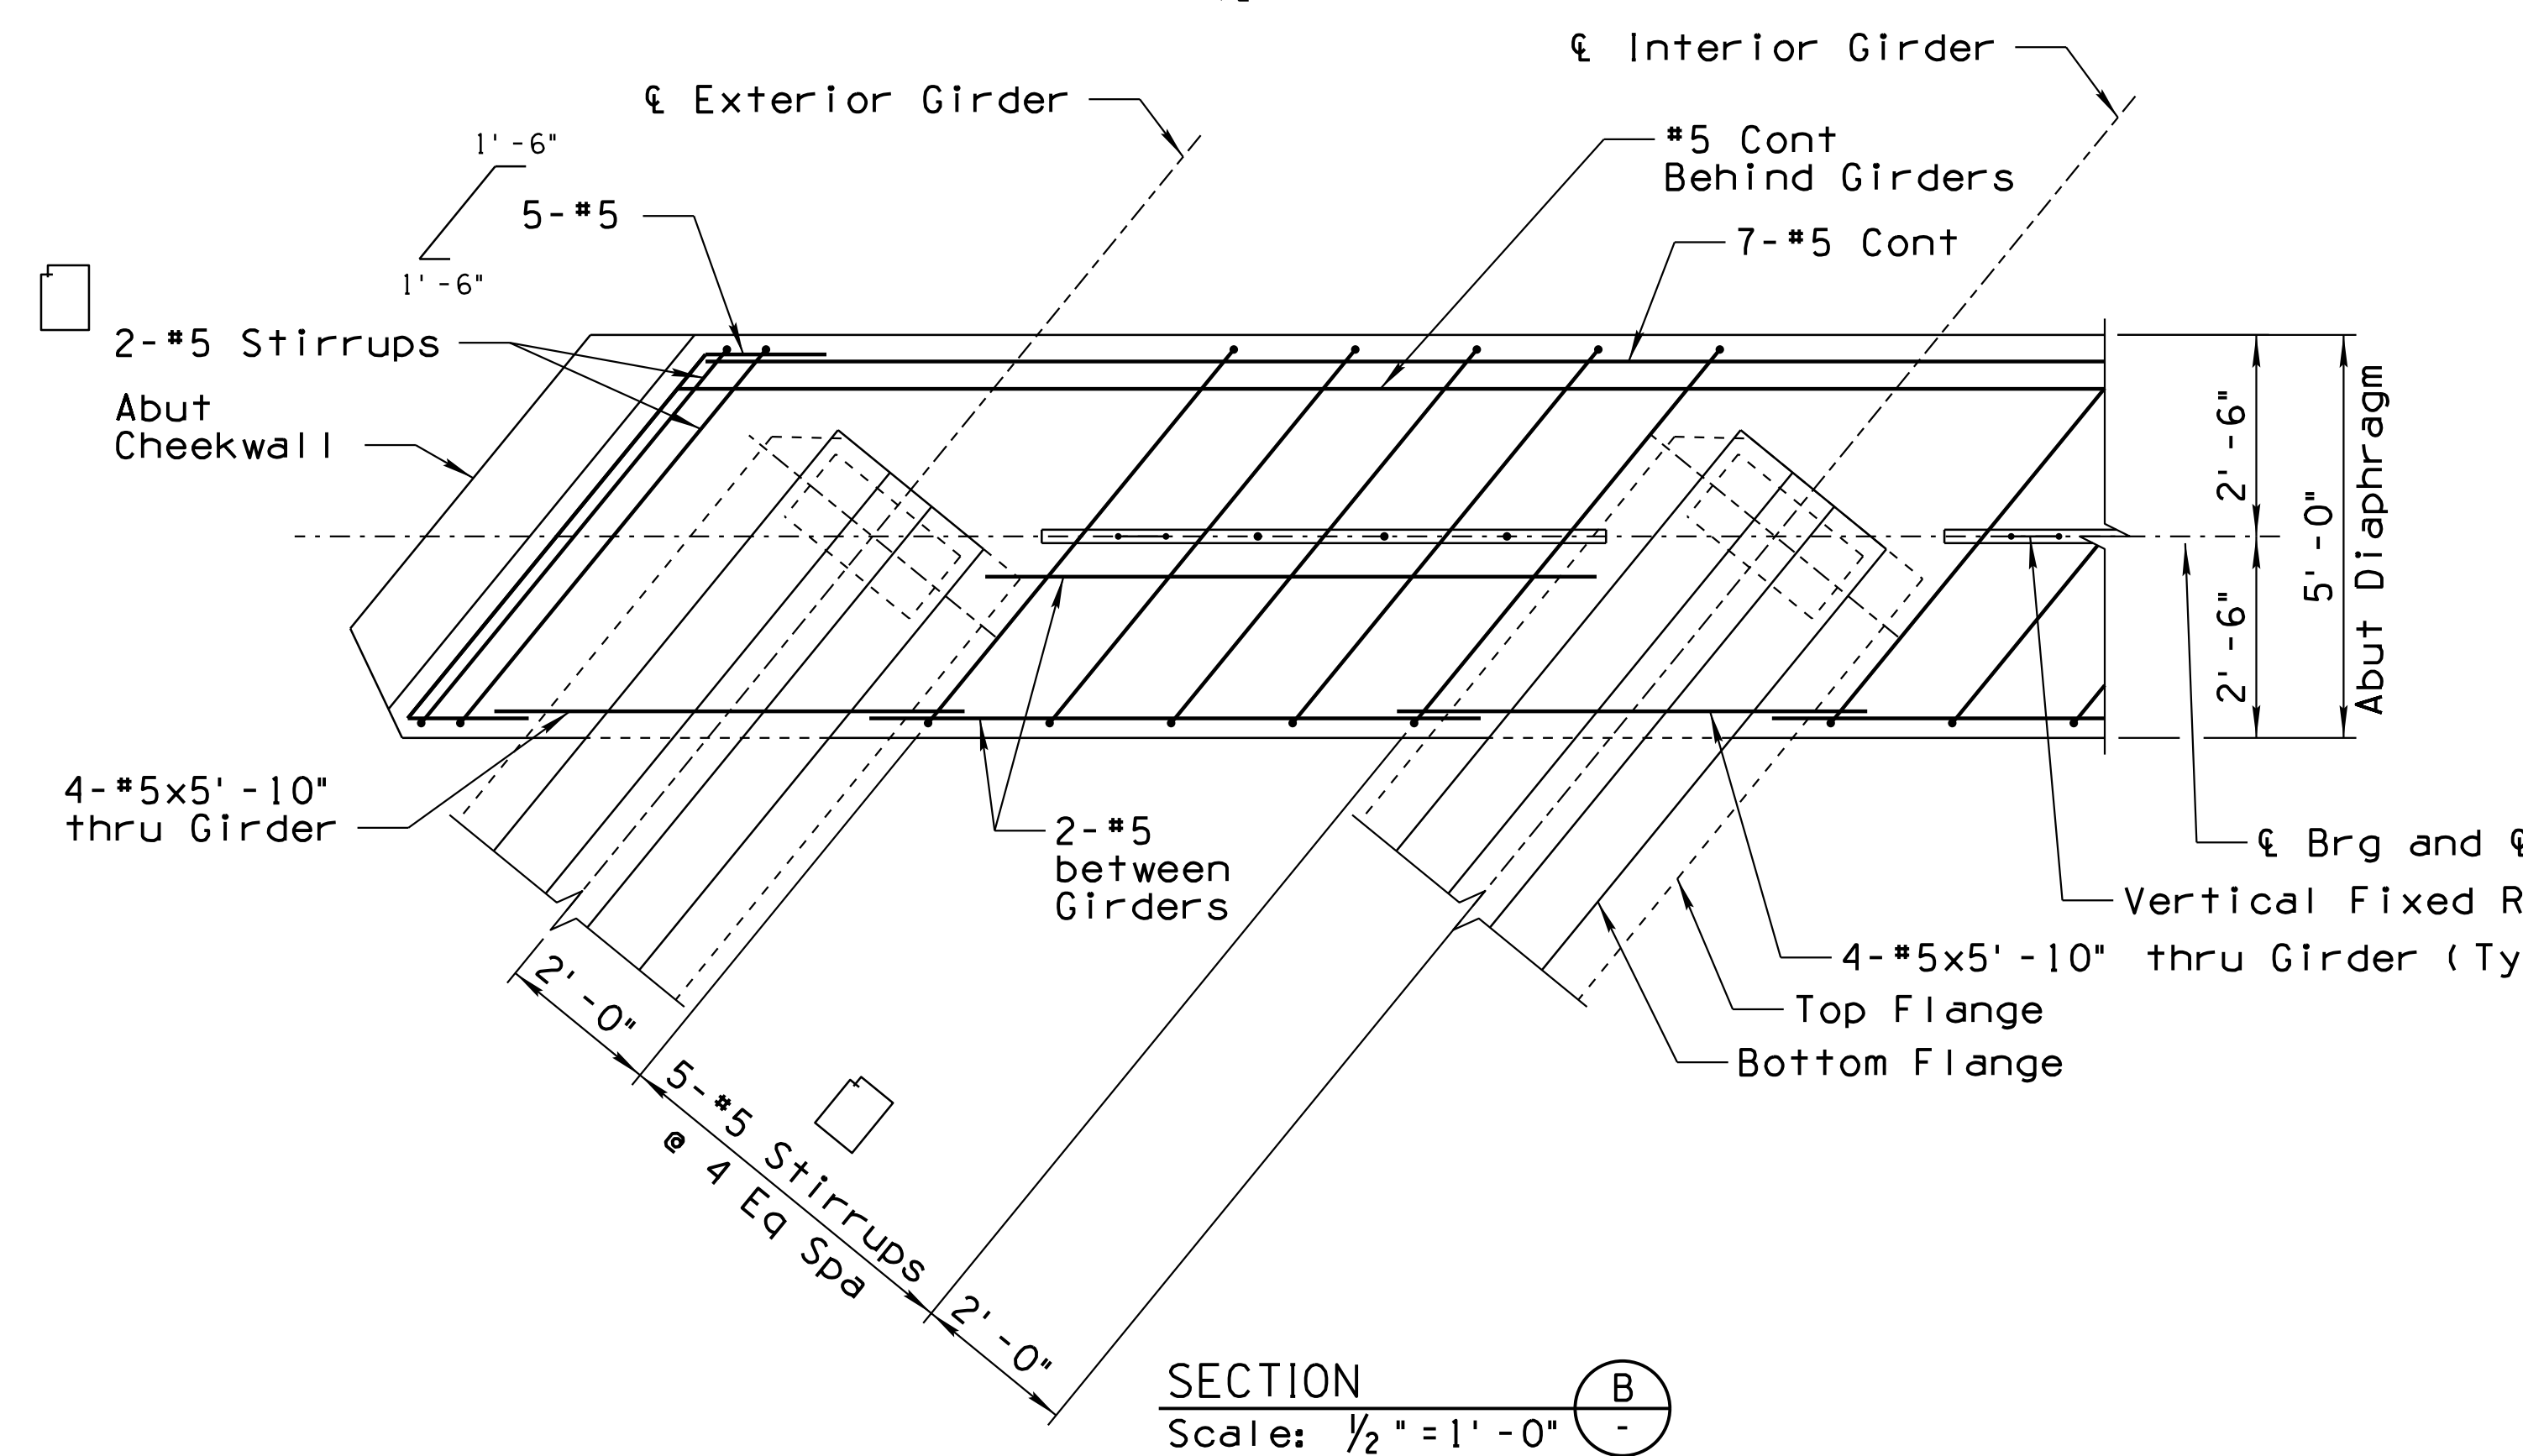


SECTION B  
Scale: 1/2" = 1'-0"

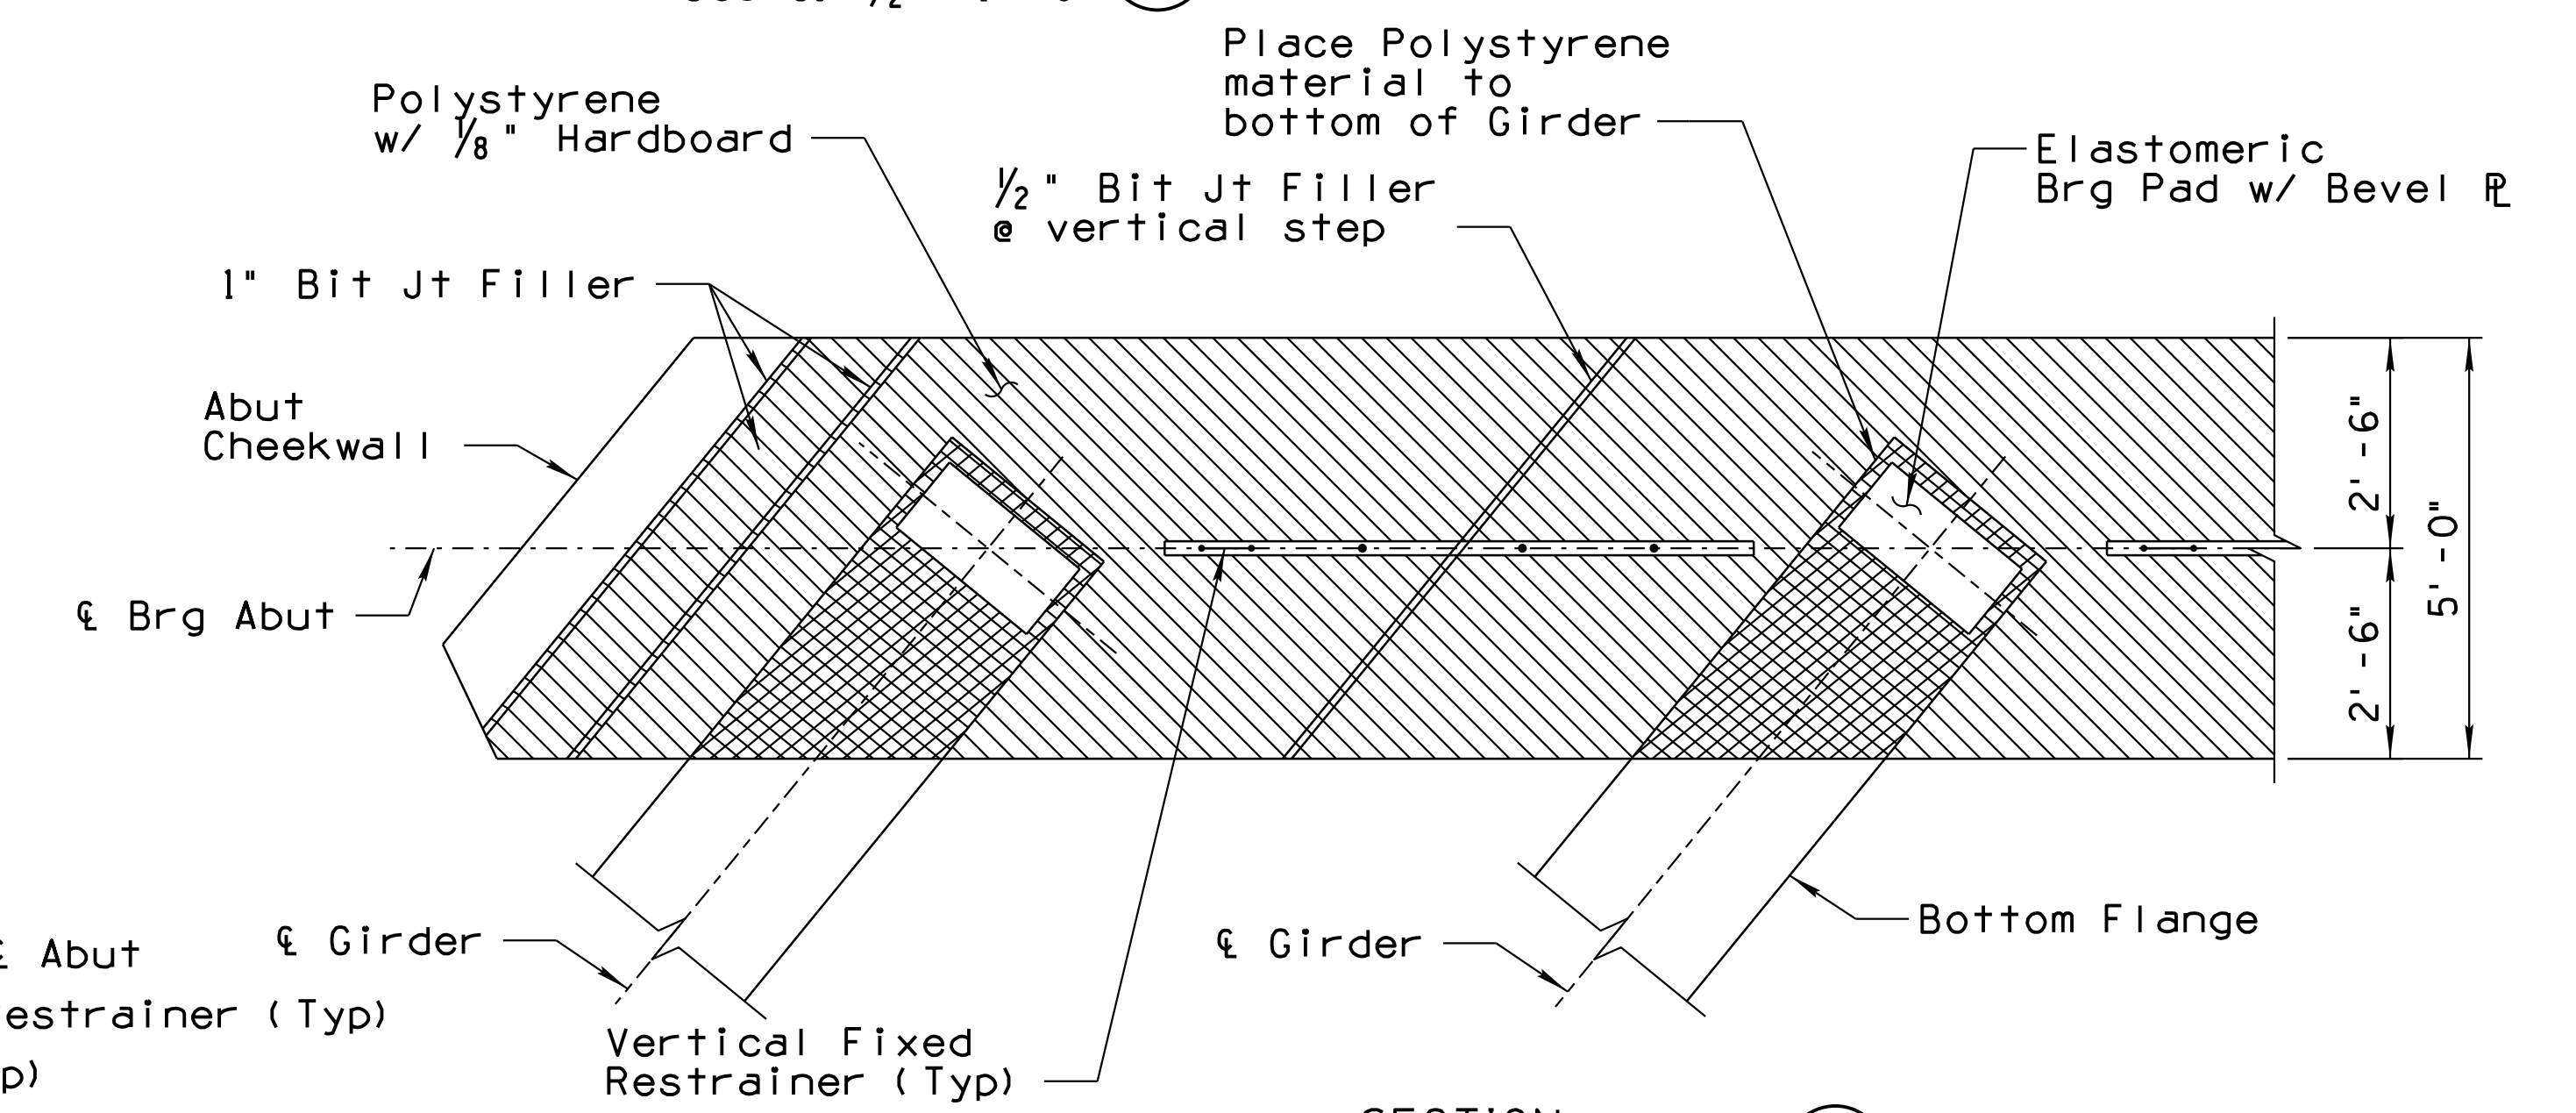

SECTION C  
Scale: 1/2" = 1'-0"

DESIGN	NAME	DATE	ARIZONA DEPARTMENT OF TRANSPORTATION INFRASTRUCTURE DELIVERY AND OPERATIONS DIVISION BRIDGE GROUP
DRAWN	LES / HV	3-19	
CHECKED	DAY	3-19	
WSP			STA 99+ RUTHRAUFF ROAD T.I. UNDERPASS ABUTMENT DIAPHRAGM DETAILS
WSP USA Inc. 177 N. Church Avenue Suite 1105 Tucson, AZ 85701			
I-10	252.00	20159	LOCATION
ROUTE	MILEPOST	STRUCTURE NO.	RUTHRAUFF ROAD T.I.
TRACS NO. H 8480 OIC			010-D(213)S

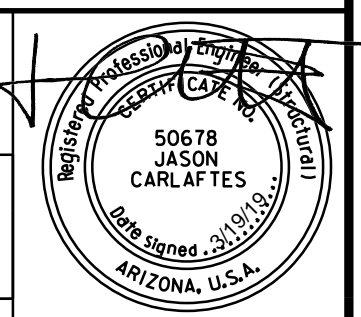


DATE: \_\_\_\_\_ LOCATION: \_\_\_\_\_ REVISIONS: \_\_\_\_\_ FINISHED PLANS: \_\_\_\_\_ SURVEY NO.: \_\_\_\_\_ DATE: \_\_\_\_\_ LOCATION: \_\_\_\_\_ REVISIONS: \_\_\_\_\_ FINISHED PLANS: \_\_\_\_\_ SURVEY NO.: \_\_\_\_\_




F.H.W.A. REGION	STATE	PROJECT NO.	SHEET NO.	TOTAL SHEETS	RECORD DRAWING
9	ARIZ.	010-D(213)S	644	849	


010 PM 252

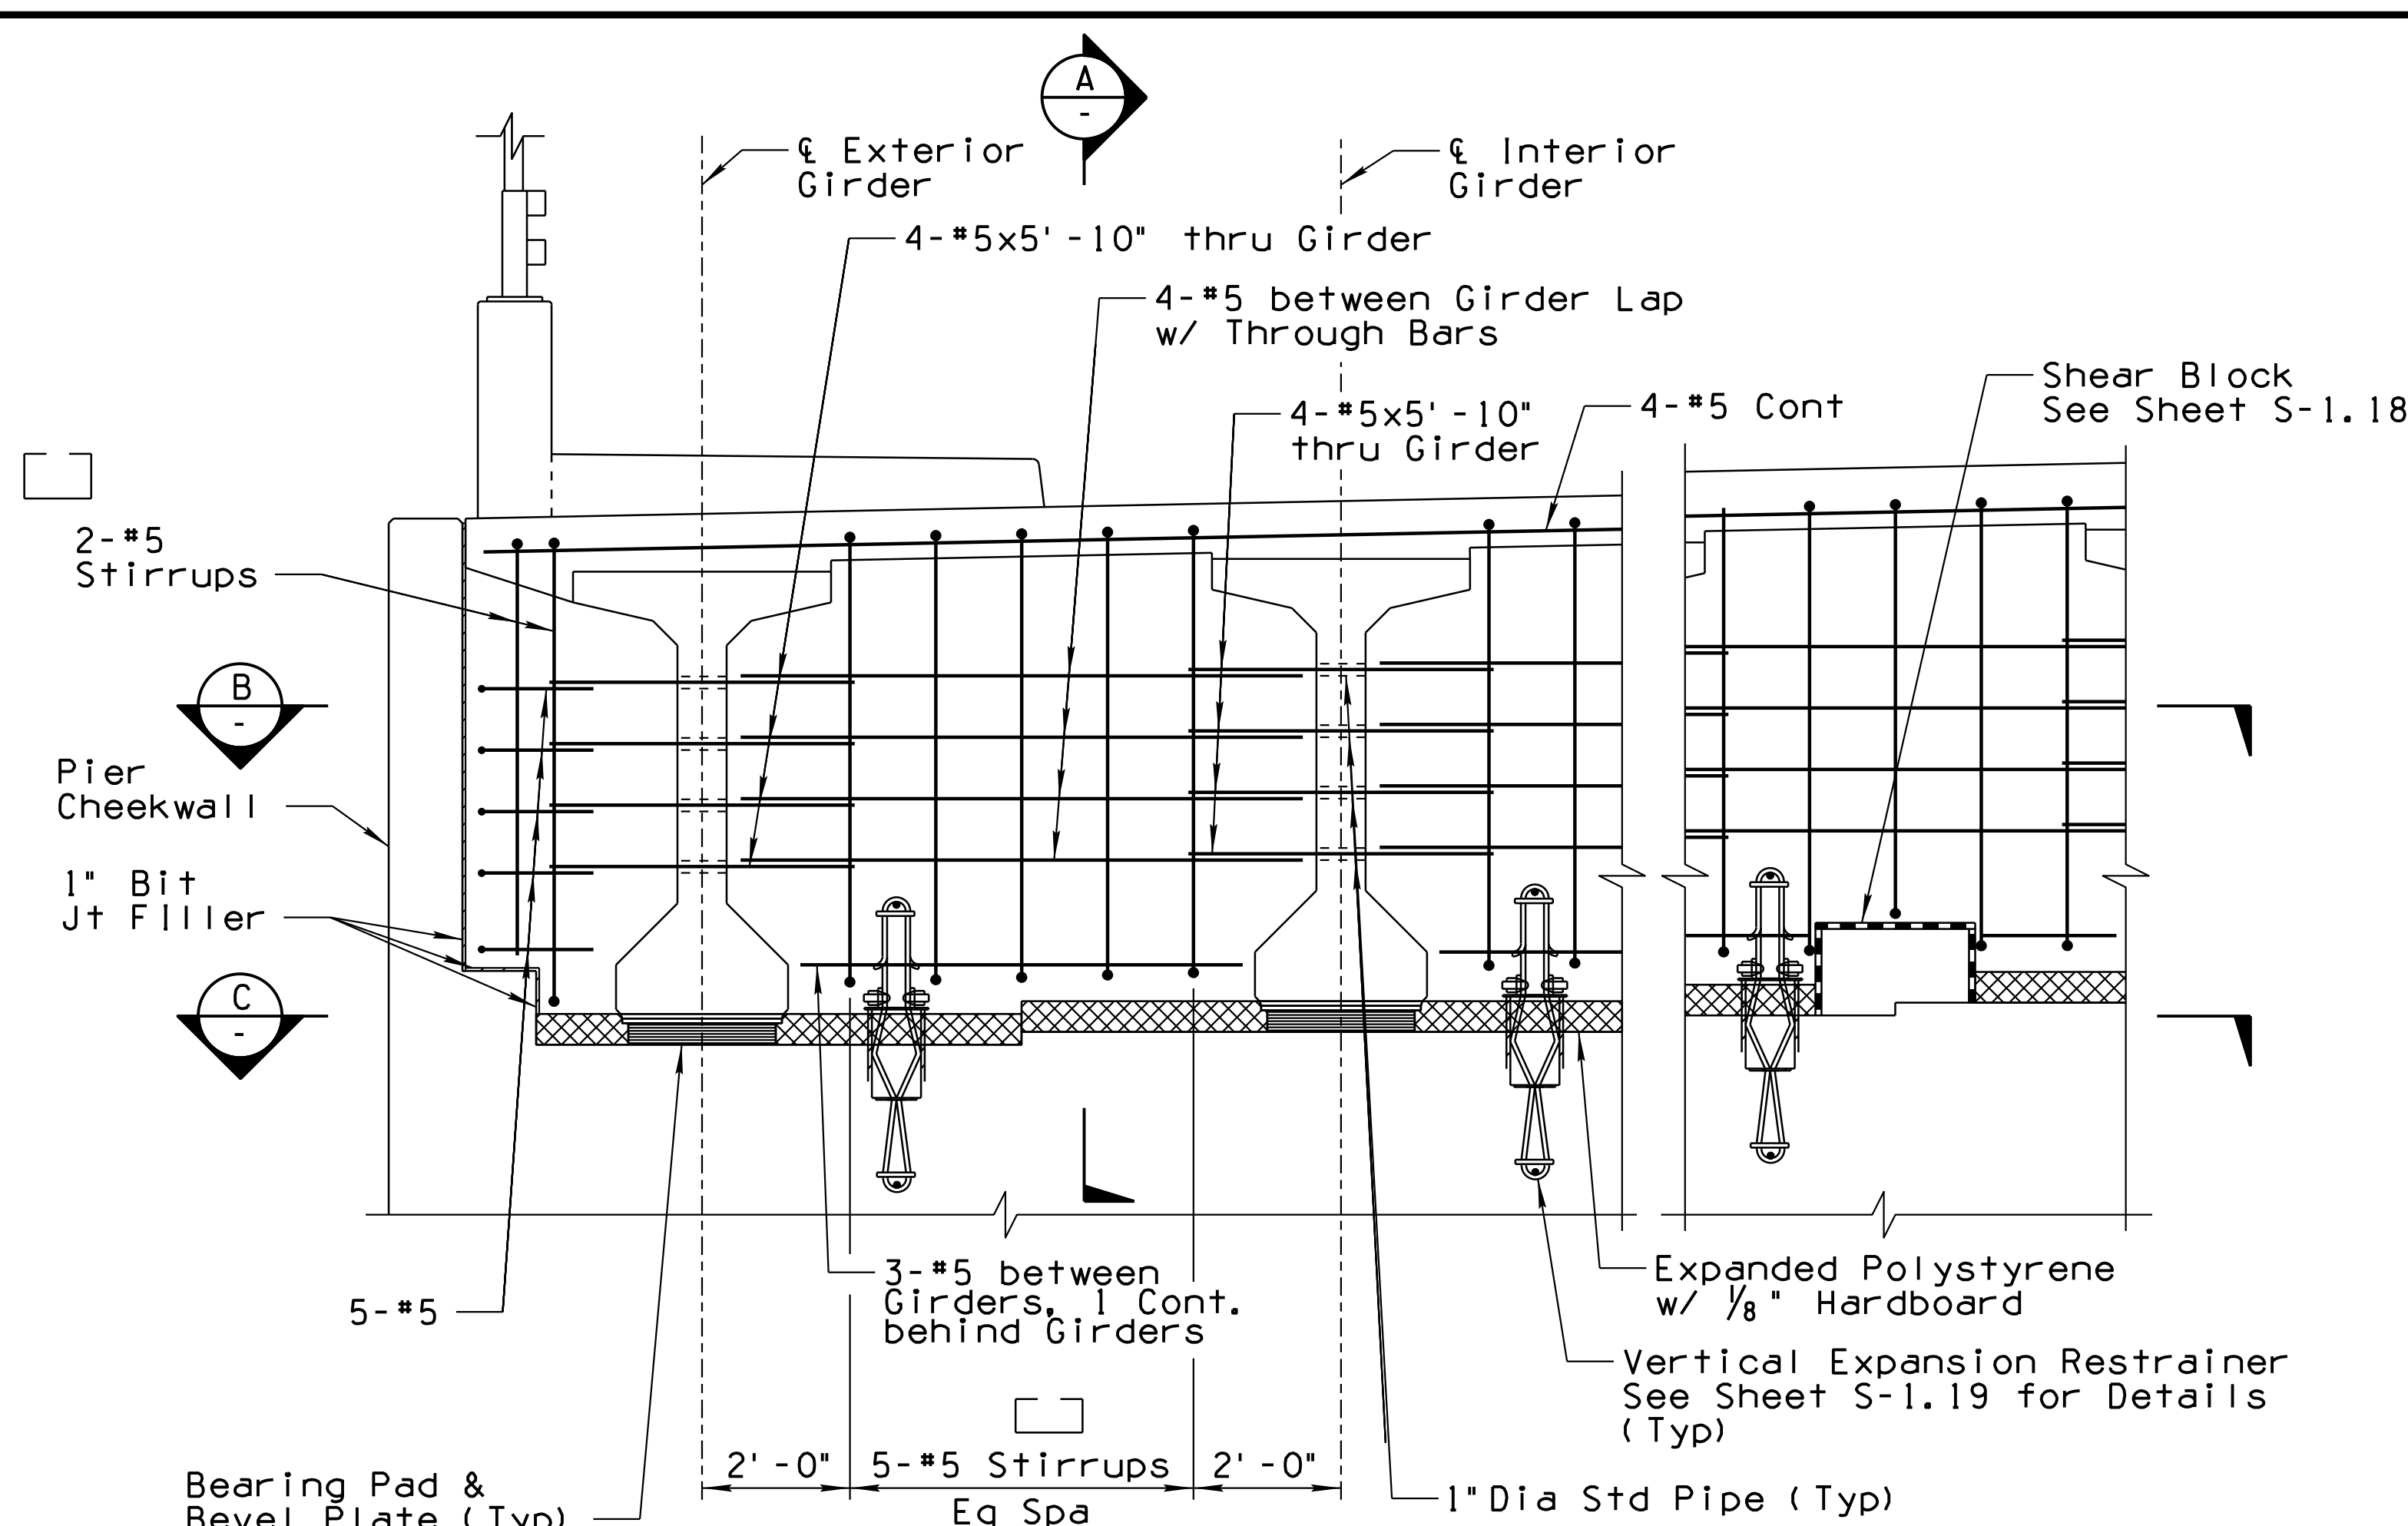


PARTIAL ELEVATION AT PIER  
Scale: 1/2" = 1'-0"

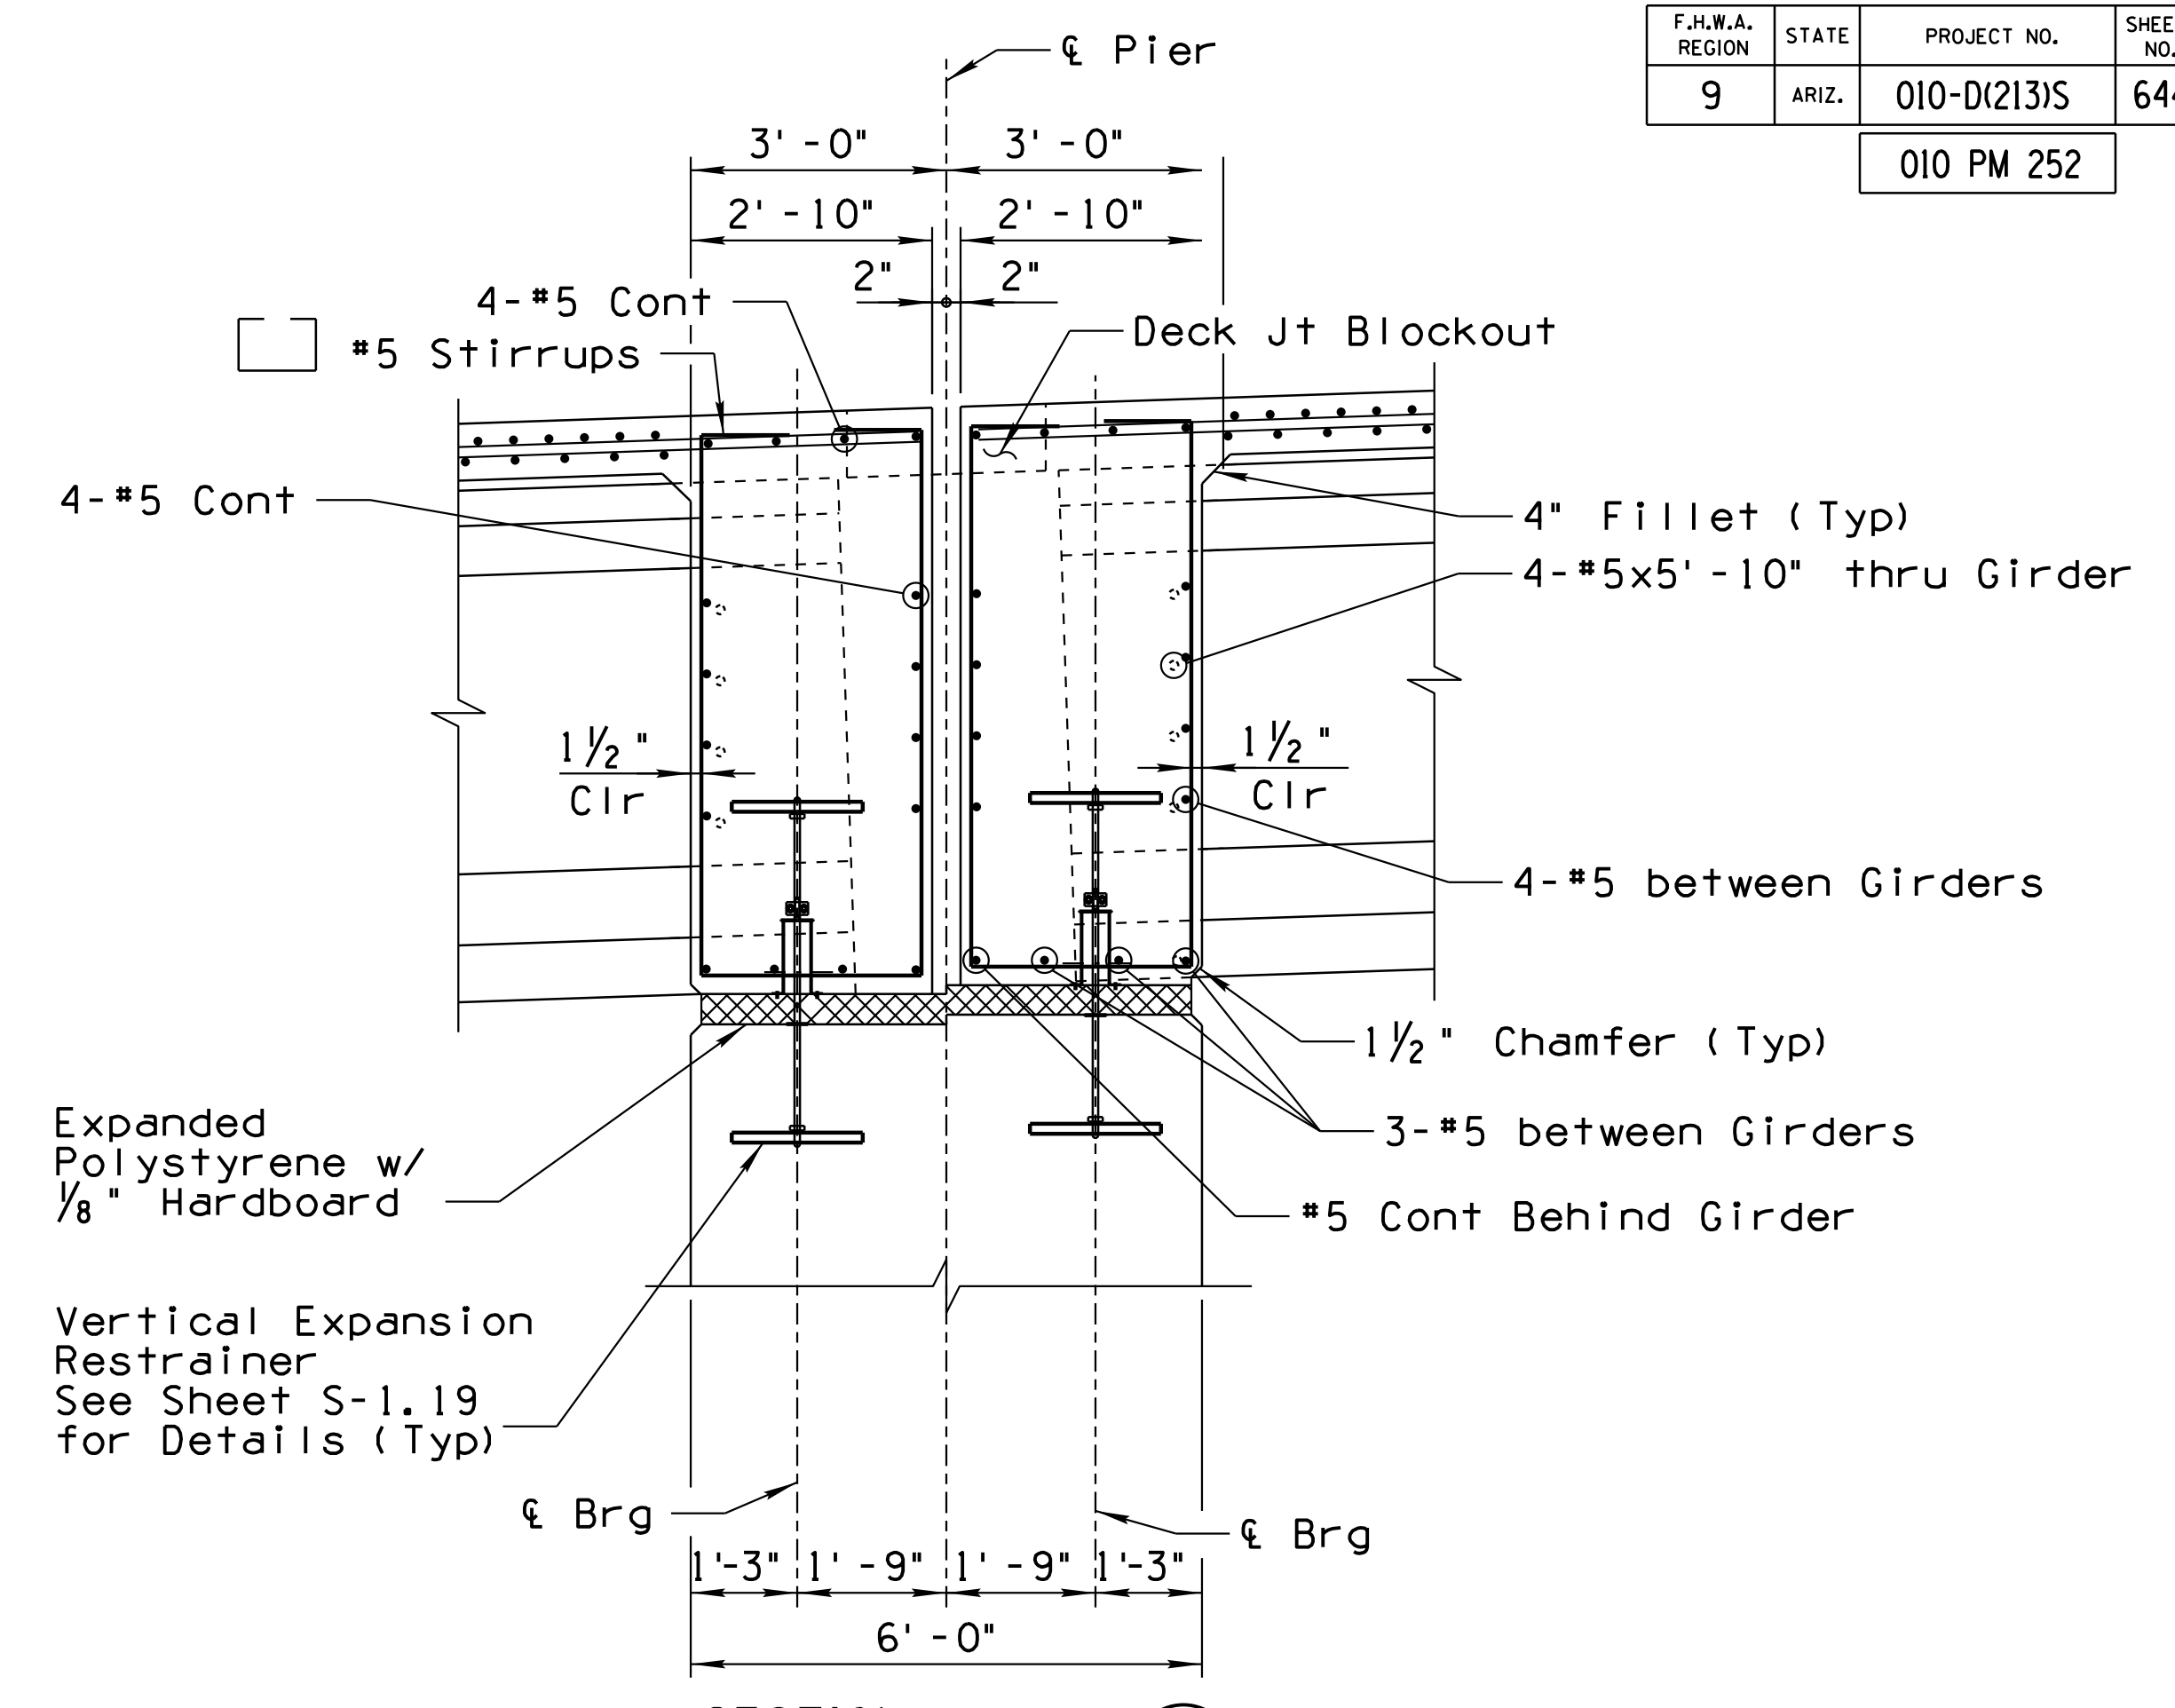

SECTION A  
Scale: 1/2" = 1'-0"

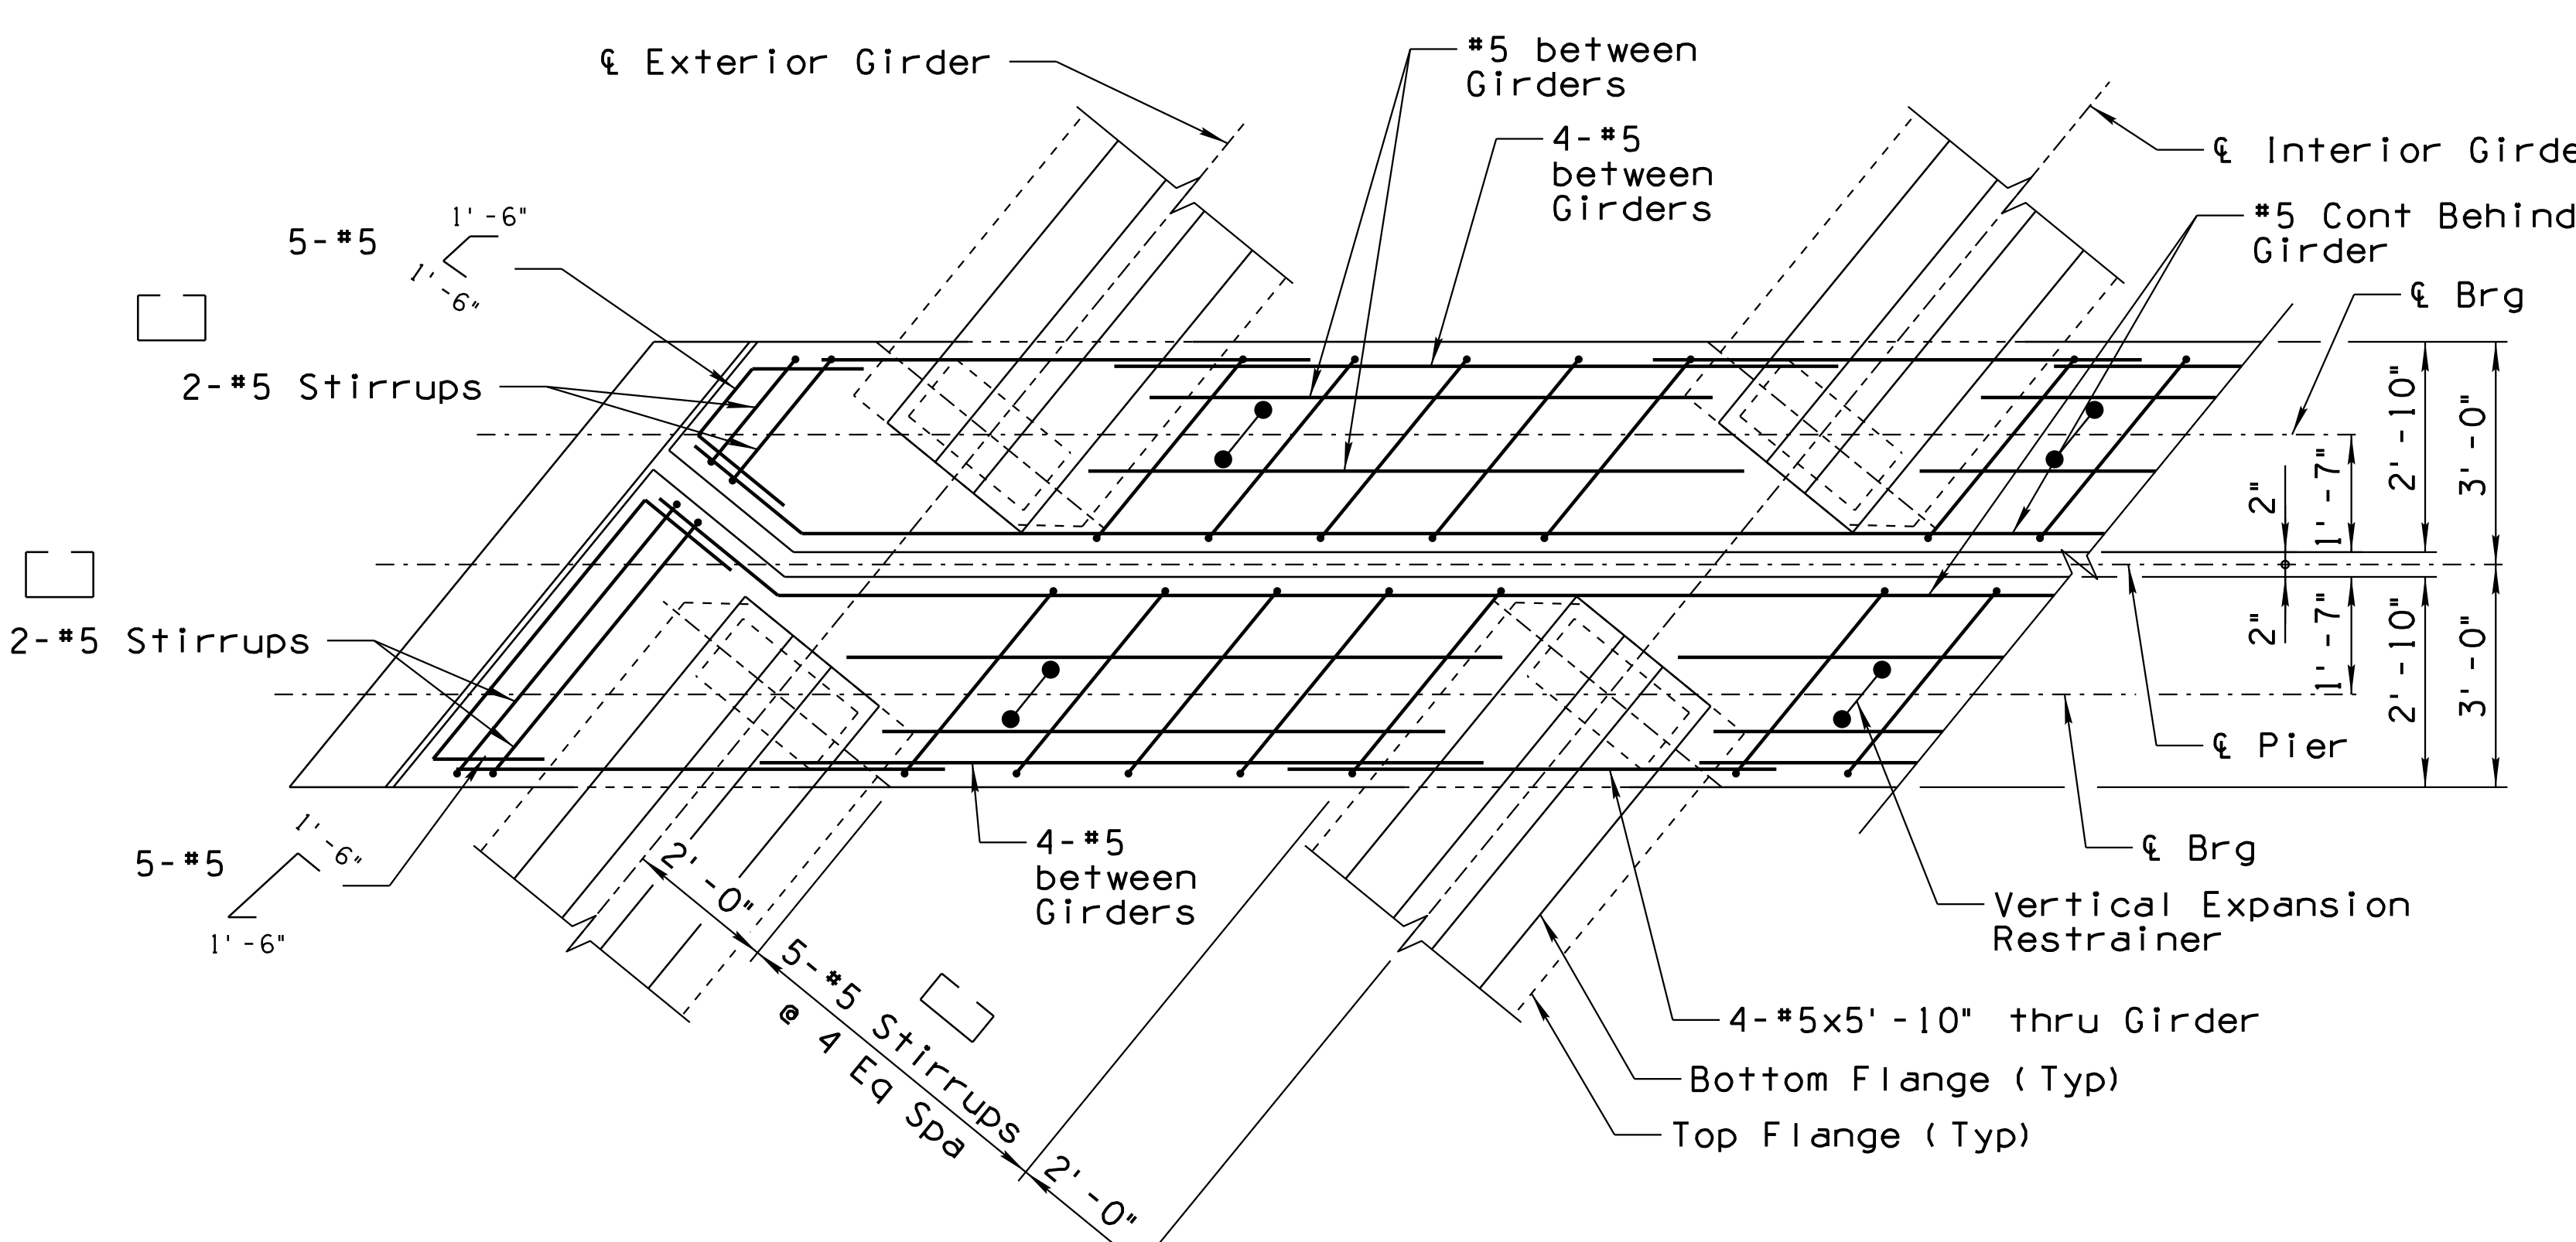


SECTION B  
Scale: 1/2" = 1'-0"

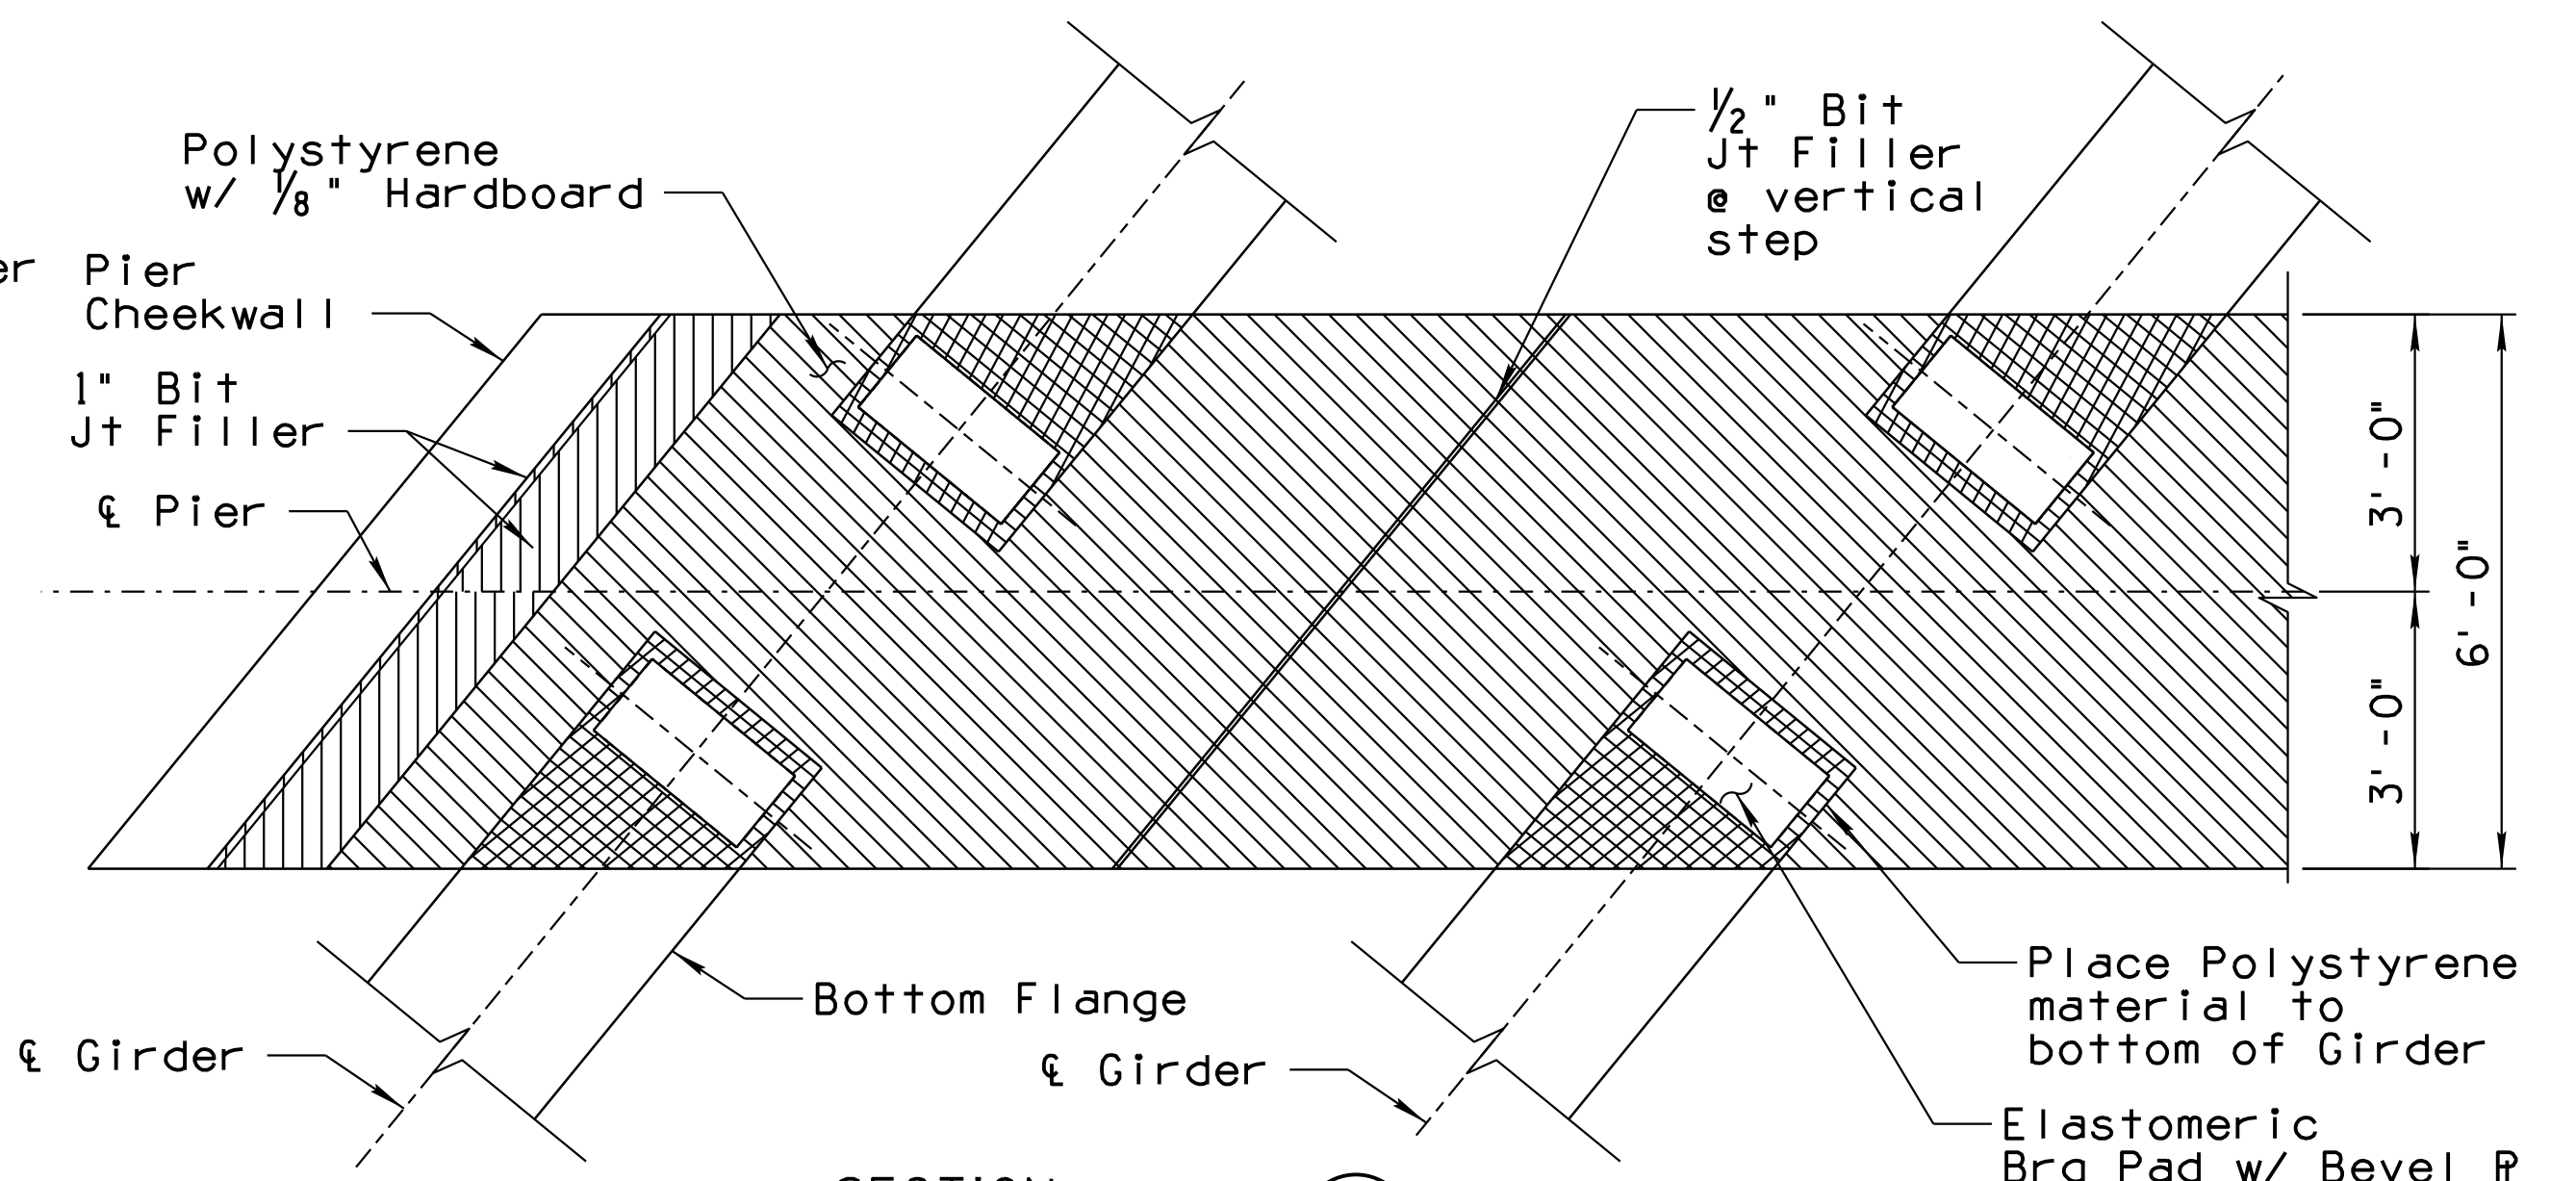

SECTION C  
Scale: 1/2" = 1'-0"



DESIGN	NAME	DATE	ARIZONA DEPARTMENT OF TRANSPORTATION INFRASTRUCTURE DELIVERY AND OPERATIONS DIVISION BRIDGE GROUP
LES / HV		3-19	
DAY		3-19	
CHECKED	AGG / JAC	3-19	<b>WSP</b> <small>WSP USA Inc. 177 N. Church Avenue Suite 1105 Tucson, AZ 85701</small>
STA 99+ <b>RUTHRAUFF ROAD T.I. UNDERPASS            PIER DIAPHRAGM DETAILS</b>			
I-10	252.00	20159	LOCATION RUTHRAUFF ROAD T.I.
TRACS NO. H 8480 OIC			010-D(213)S

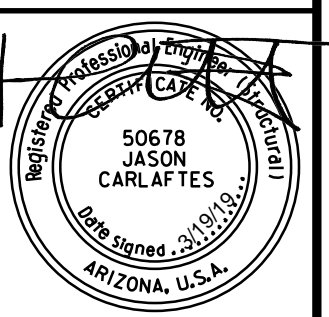

REVISIONS: LOCATION: SURVEY NO.: DATE: FINISHED PLANS: DATE: SURVEY NO.: DATE: FINISHED PLANS:


F.H.W.A. REGION	STATE	PROJECT NO.	SHEET NO.	TOTAL SHEETS	RECORD DRAWING
9	ARIZ.	010-D(213)S	645	849	

010 PM 252

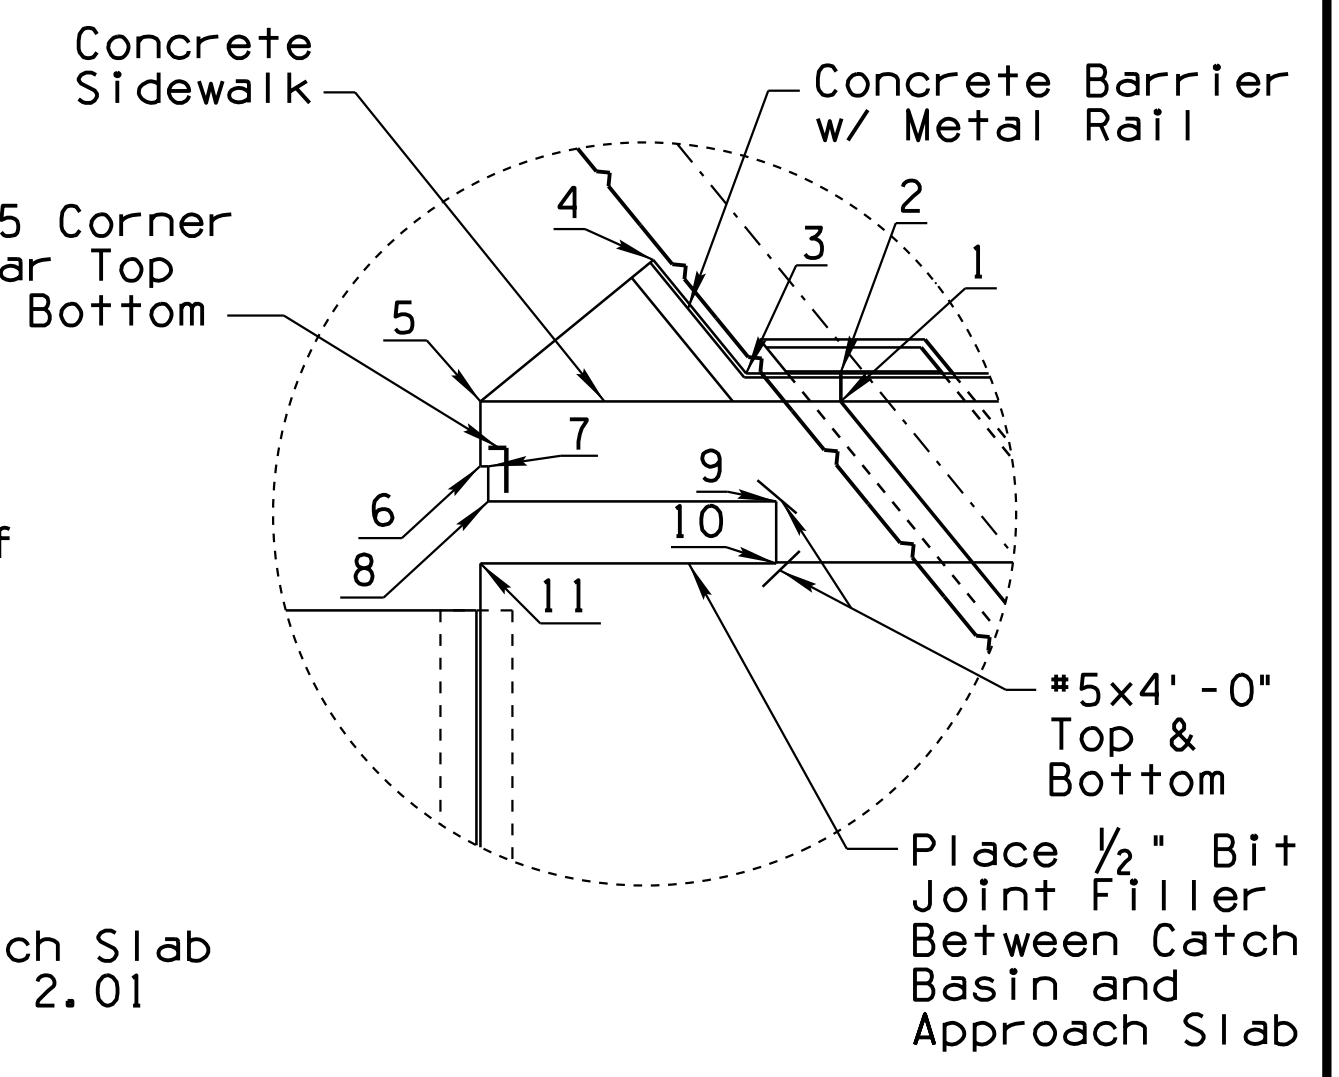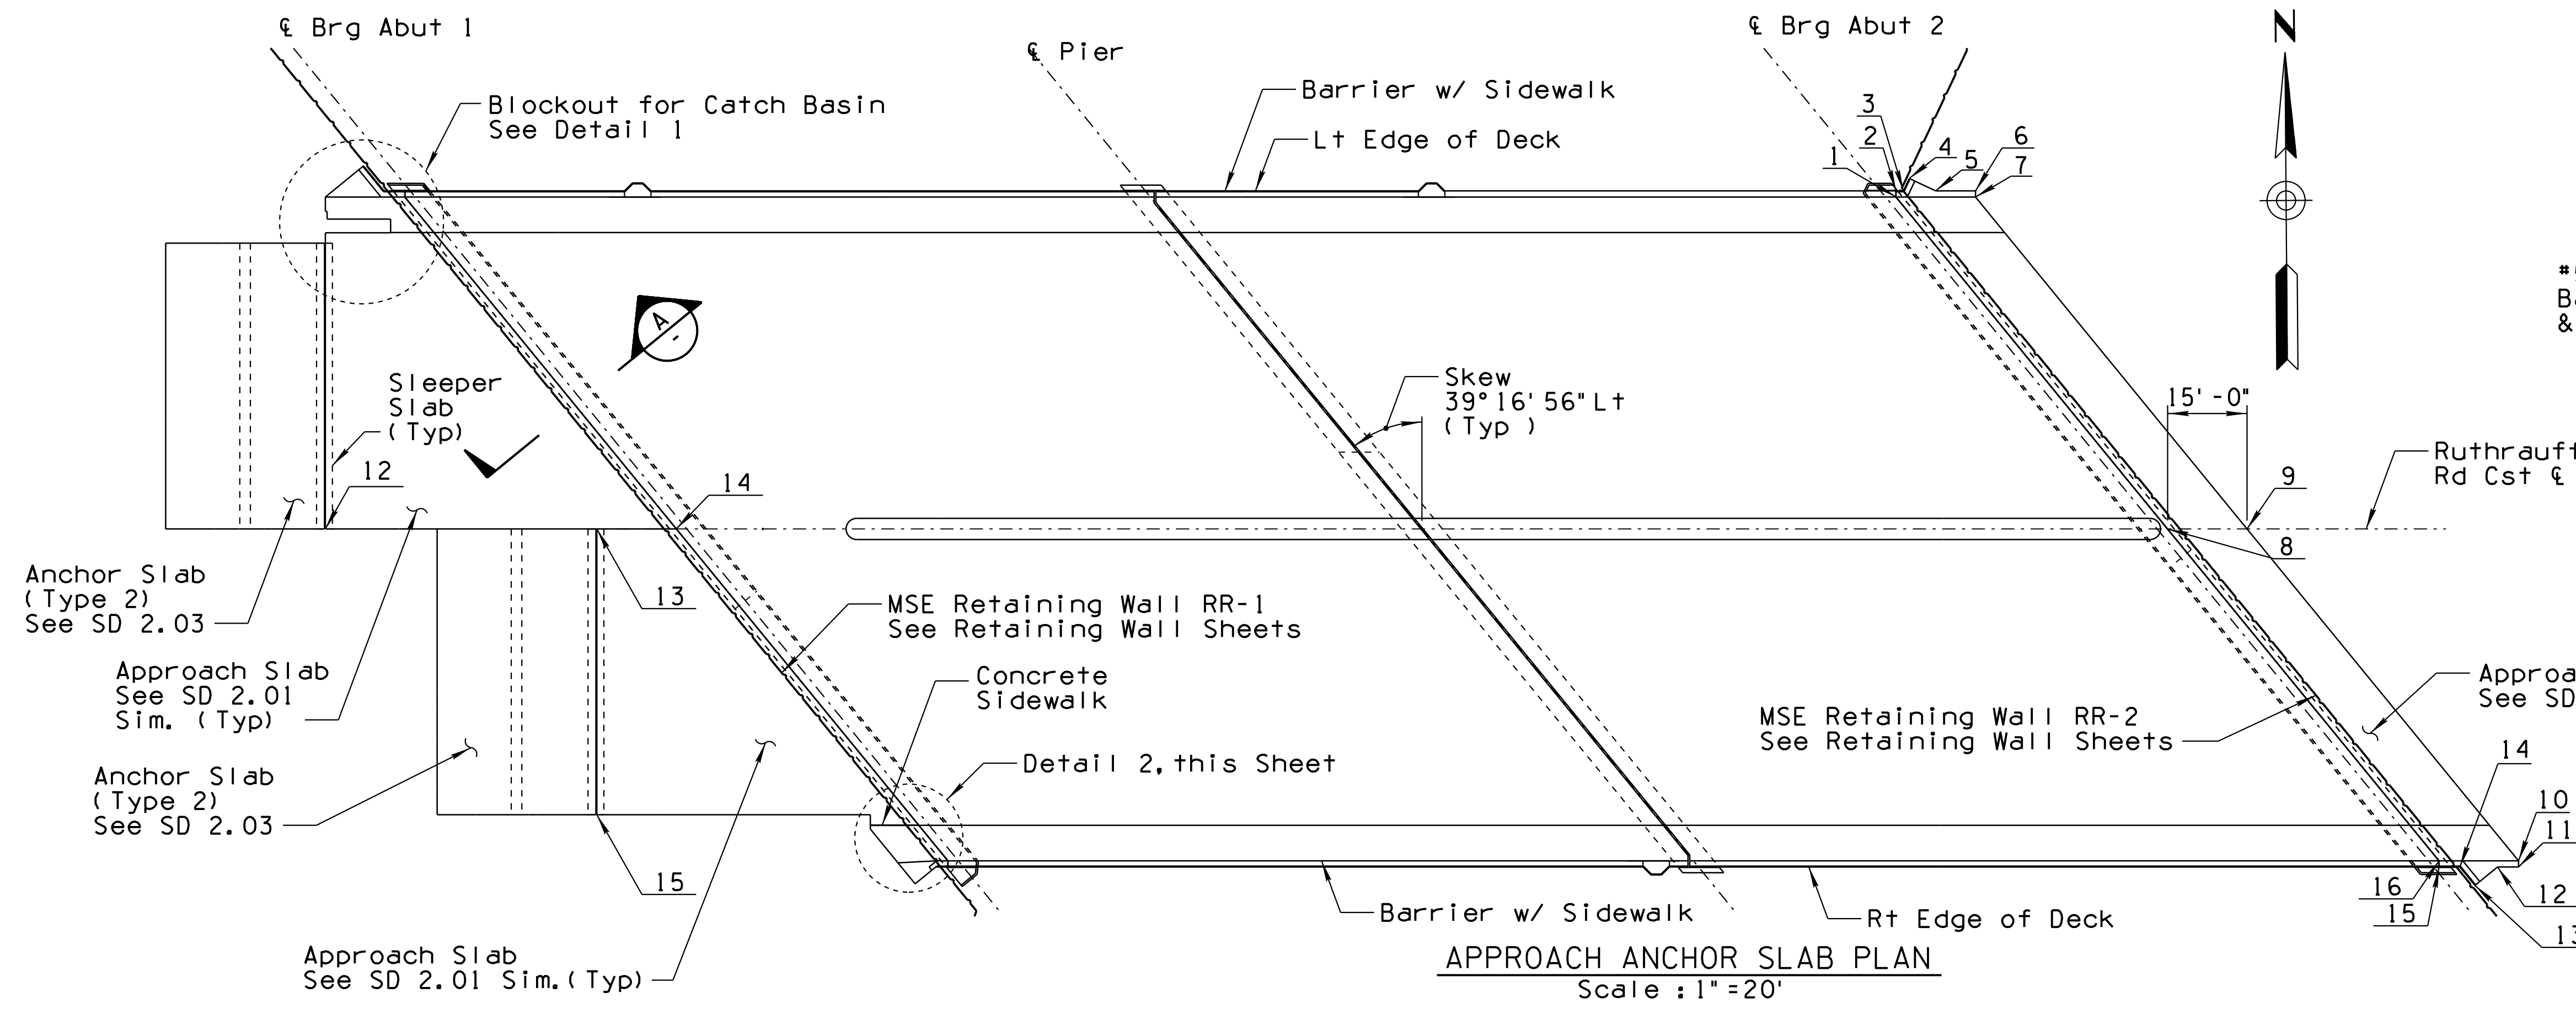

ABUT 1 APPROACH SLAB ELEVS			
POINT	STATION	OFFSET	ELEV
1	97+82.67	62.69 Lt	2268.78
2	97+82.67	63.88 Lt	2268.77
3	97+78.74	63.88 Lt	2268.65
4	97+74.87	68.60 Lt	2268.46
5	97+67.67	62.71 Lt	2268.33
6	97+67.67	60.00 Lt	2268.38
7	97+67.99	60.00 Lt	2268.38
8	97+67.99	58.54 Lt	2268.41
9	97+79.99	58.54 Lt	2268.77
10	97+79.99	55.96 Lt	2268.81
11	97+67.67	55.96 Lt	2268.44
12	97+67.67	--	2269.28
13	98+18.95	--	2270.81
14	98+33.95	--	2271.26
15	98+18.95	54.00 Rt	2270.00
16	98+70.62	54.00 Rt	2271.55
17	98+70.62	56.71 Rt	2271.51
18	98+79.08	67.06 Rt	2271.61
19	98+82.97	63.87 Rt	2271.78
20	98+85.25	63.87 Rt	2271.84
21	98+85.25	62.72 Rt	2271.86

ABUT 2 APPROACH SLAB ELEVS			
POINT	STATION	OFFSET	ELEV
1	100+64.39	62.72 Lt	2277.24
2	100+64.39	63.88 Lt	2277.22
3	100+65.77	63.88 Lt	2277.26
4	100+66.88	66.22 Lt	2277.26
5	100+71.86	63.88 Lt	2277.44
6	100+79.40	63.88 Lt	2277.67
7	100+79.40	62.71 Lt	2277.69
8	101+15.69	--	2279.72
9	101+30.69	--	2280.16
10	101+81.99	62.71 Rt	2280.56
11	101+81.99	63.87 Rt	2280.54
12	101+78.01	63.87 Rt	2280.44
13	101+73.75	67.36 Rt	2280.29
14	101+70.90	63.87 Rt	2280.27
15	101+66.98	63.87 Rt	2280.17
16	101+66.98	62.69 Rt	2280.19

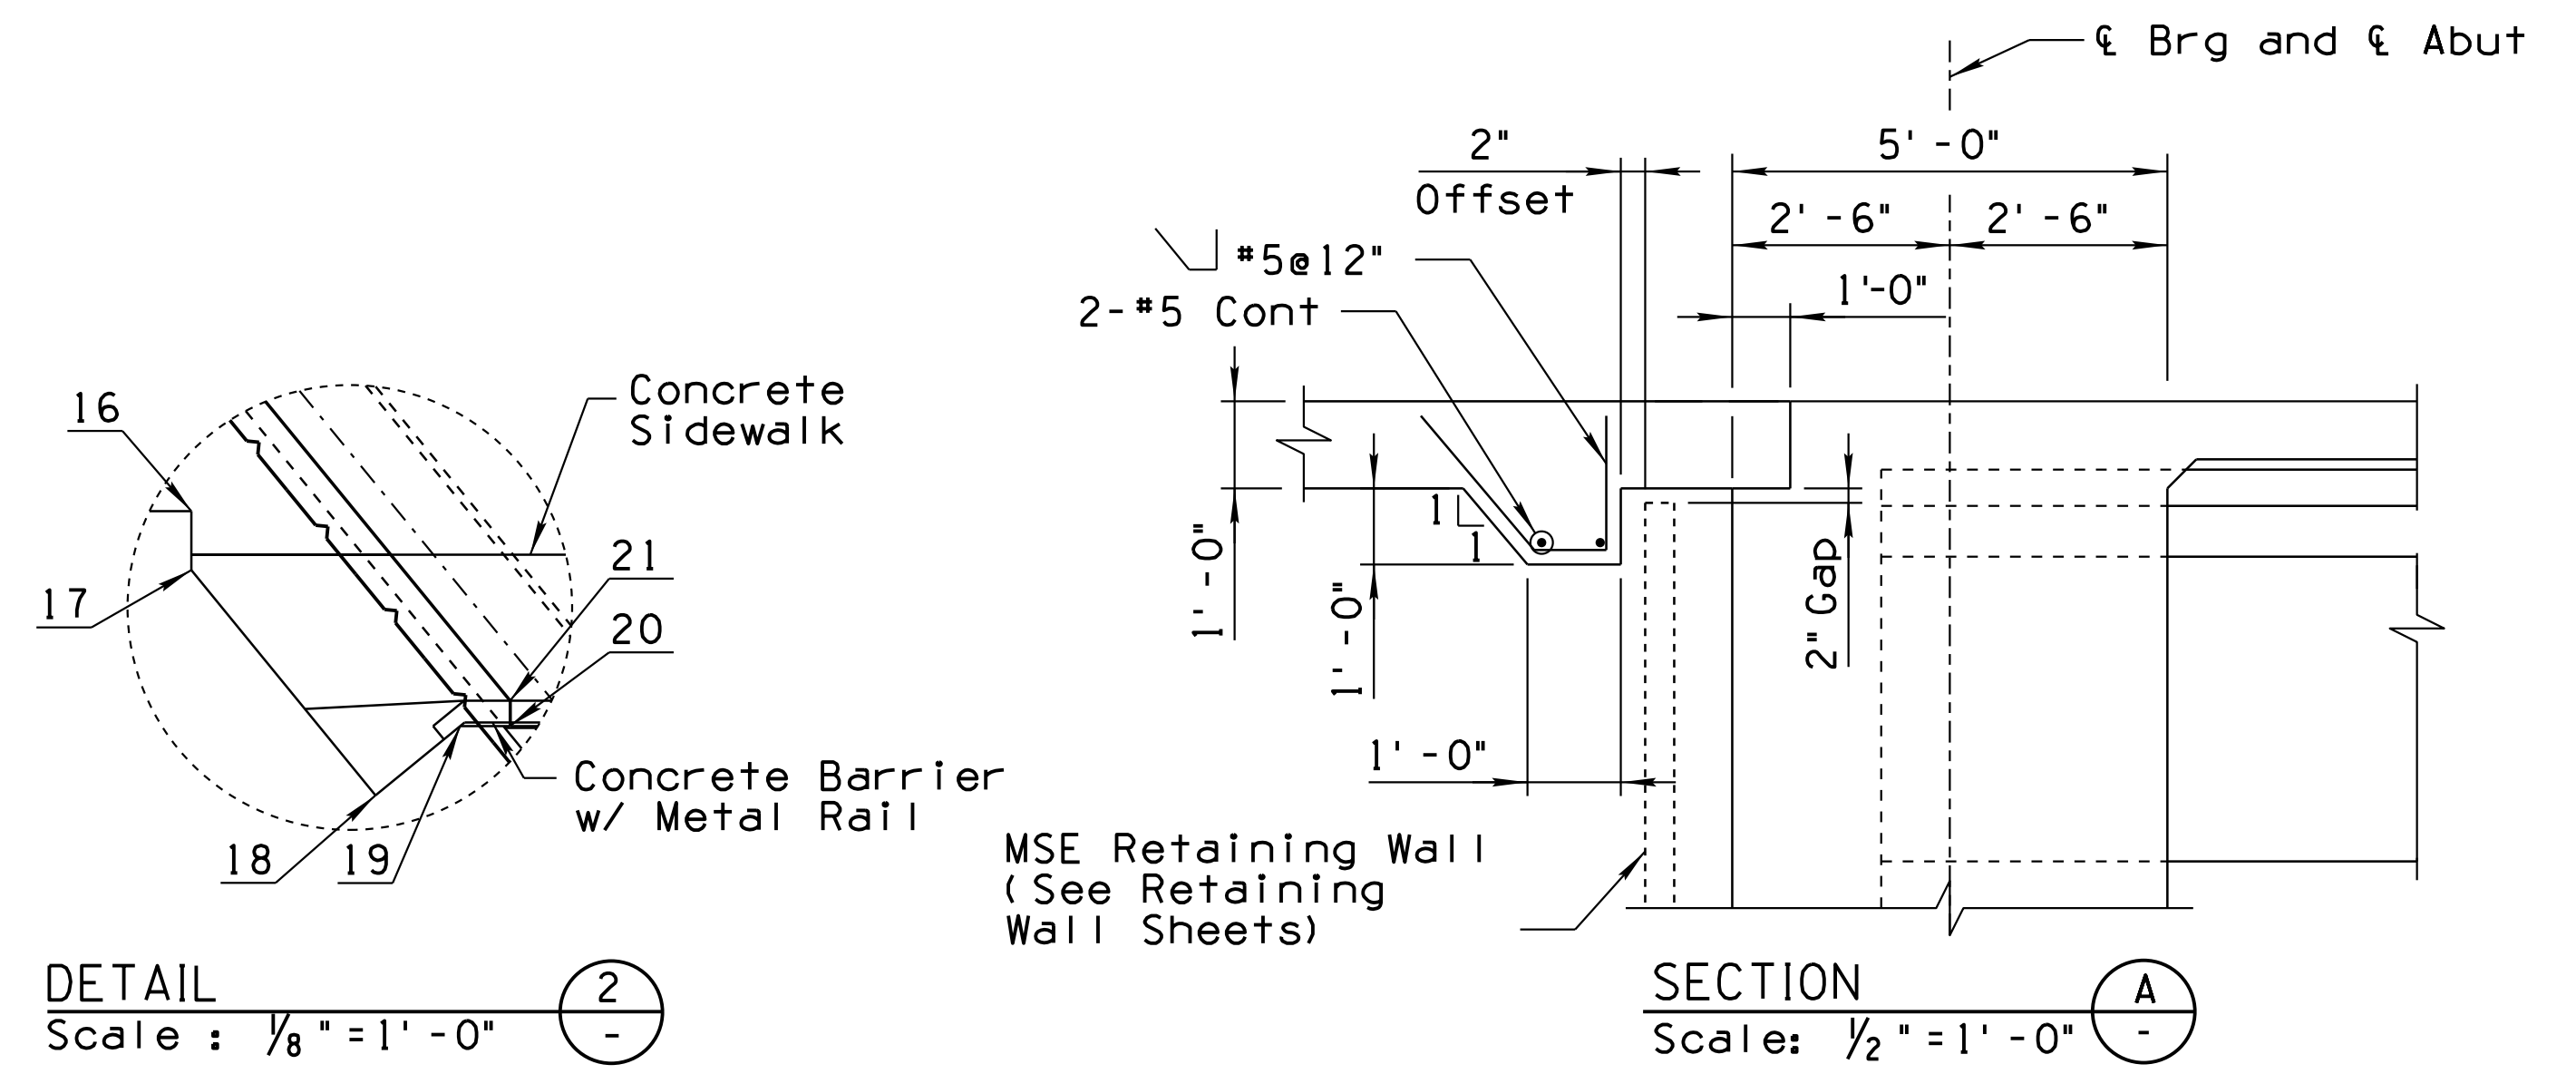


- NOTES:
- Anchor slab layout is to fit with pavement joints. See PCCP Joint Plans.
  - Stations and offsets are given along Ruthrauff Road Construction  $\epsilon$ .

DESIGN	LES / HV	DATE	3-19	ARIZONA DEPARTMENT OF TRANSPORTATION INFRASTRUCTURE DELIVERY AND OPERATIONS DIVISION BRIDGE GROUP
DRAWN	DAY	DATE	3-19	
CHECKED	AGG / JAC	DATE	3-19	
		WSP USA Inc. 177 N. Church Avenue Suite 1105 Tucson, AZ 85701	STA 99+ RUTHRAUFF ROAD T.I. UNDERPASS BRIDGE APPROACH DETAILS	
I-10	252.00	20159	LOCATION	RUTHRAUFF ROAD T.I.
ROUTE	MILEPOST	STRUCTURE NO.		DWG NO. S-1.32
TRACS NO. H 8480 OIC				010-D(213)S

F.H.W.A. REGION	STATE	PROJECT NO.	SHEET NO.	TOTAL SHEETS	RECORD DRAWING
9	ARIZ.	010-D(213)S	646	849	

010 PM 252

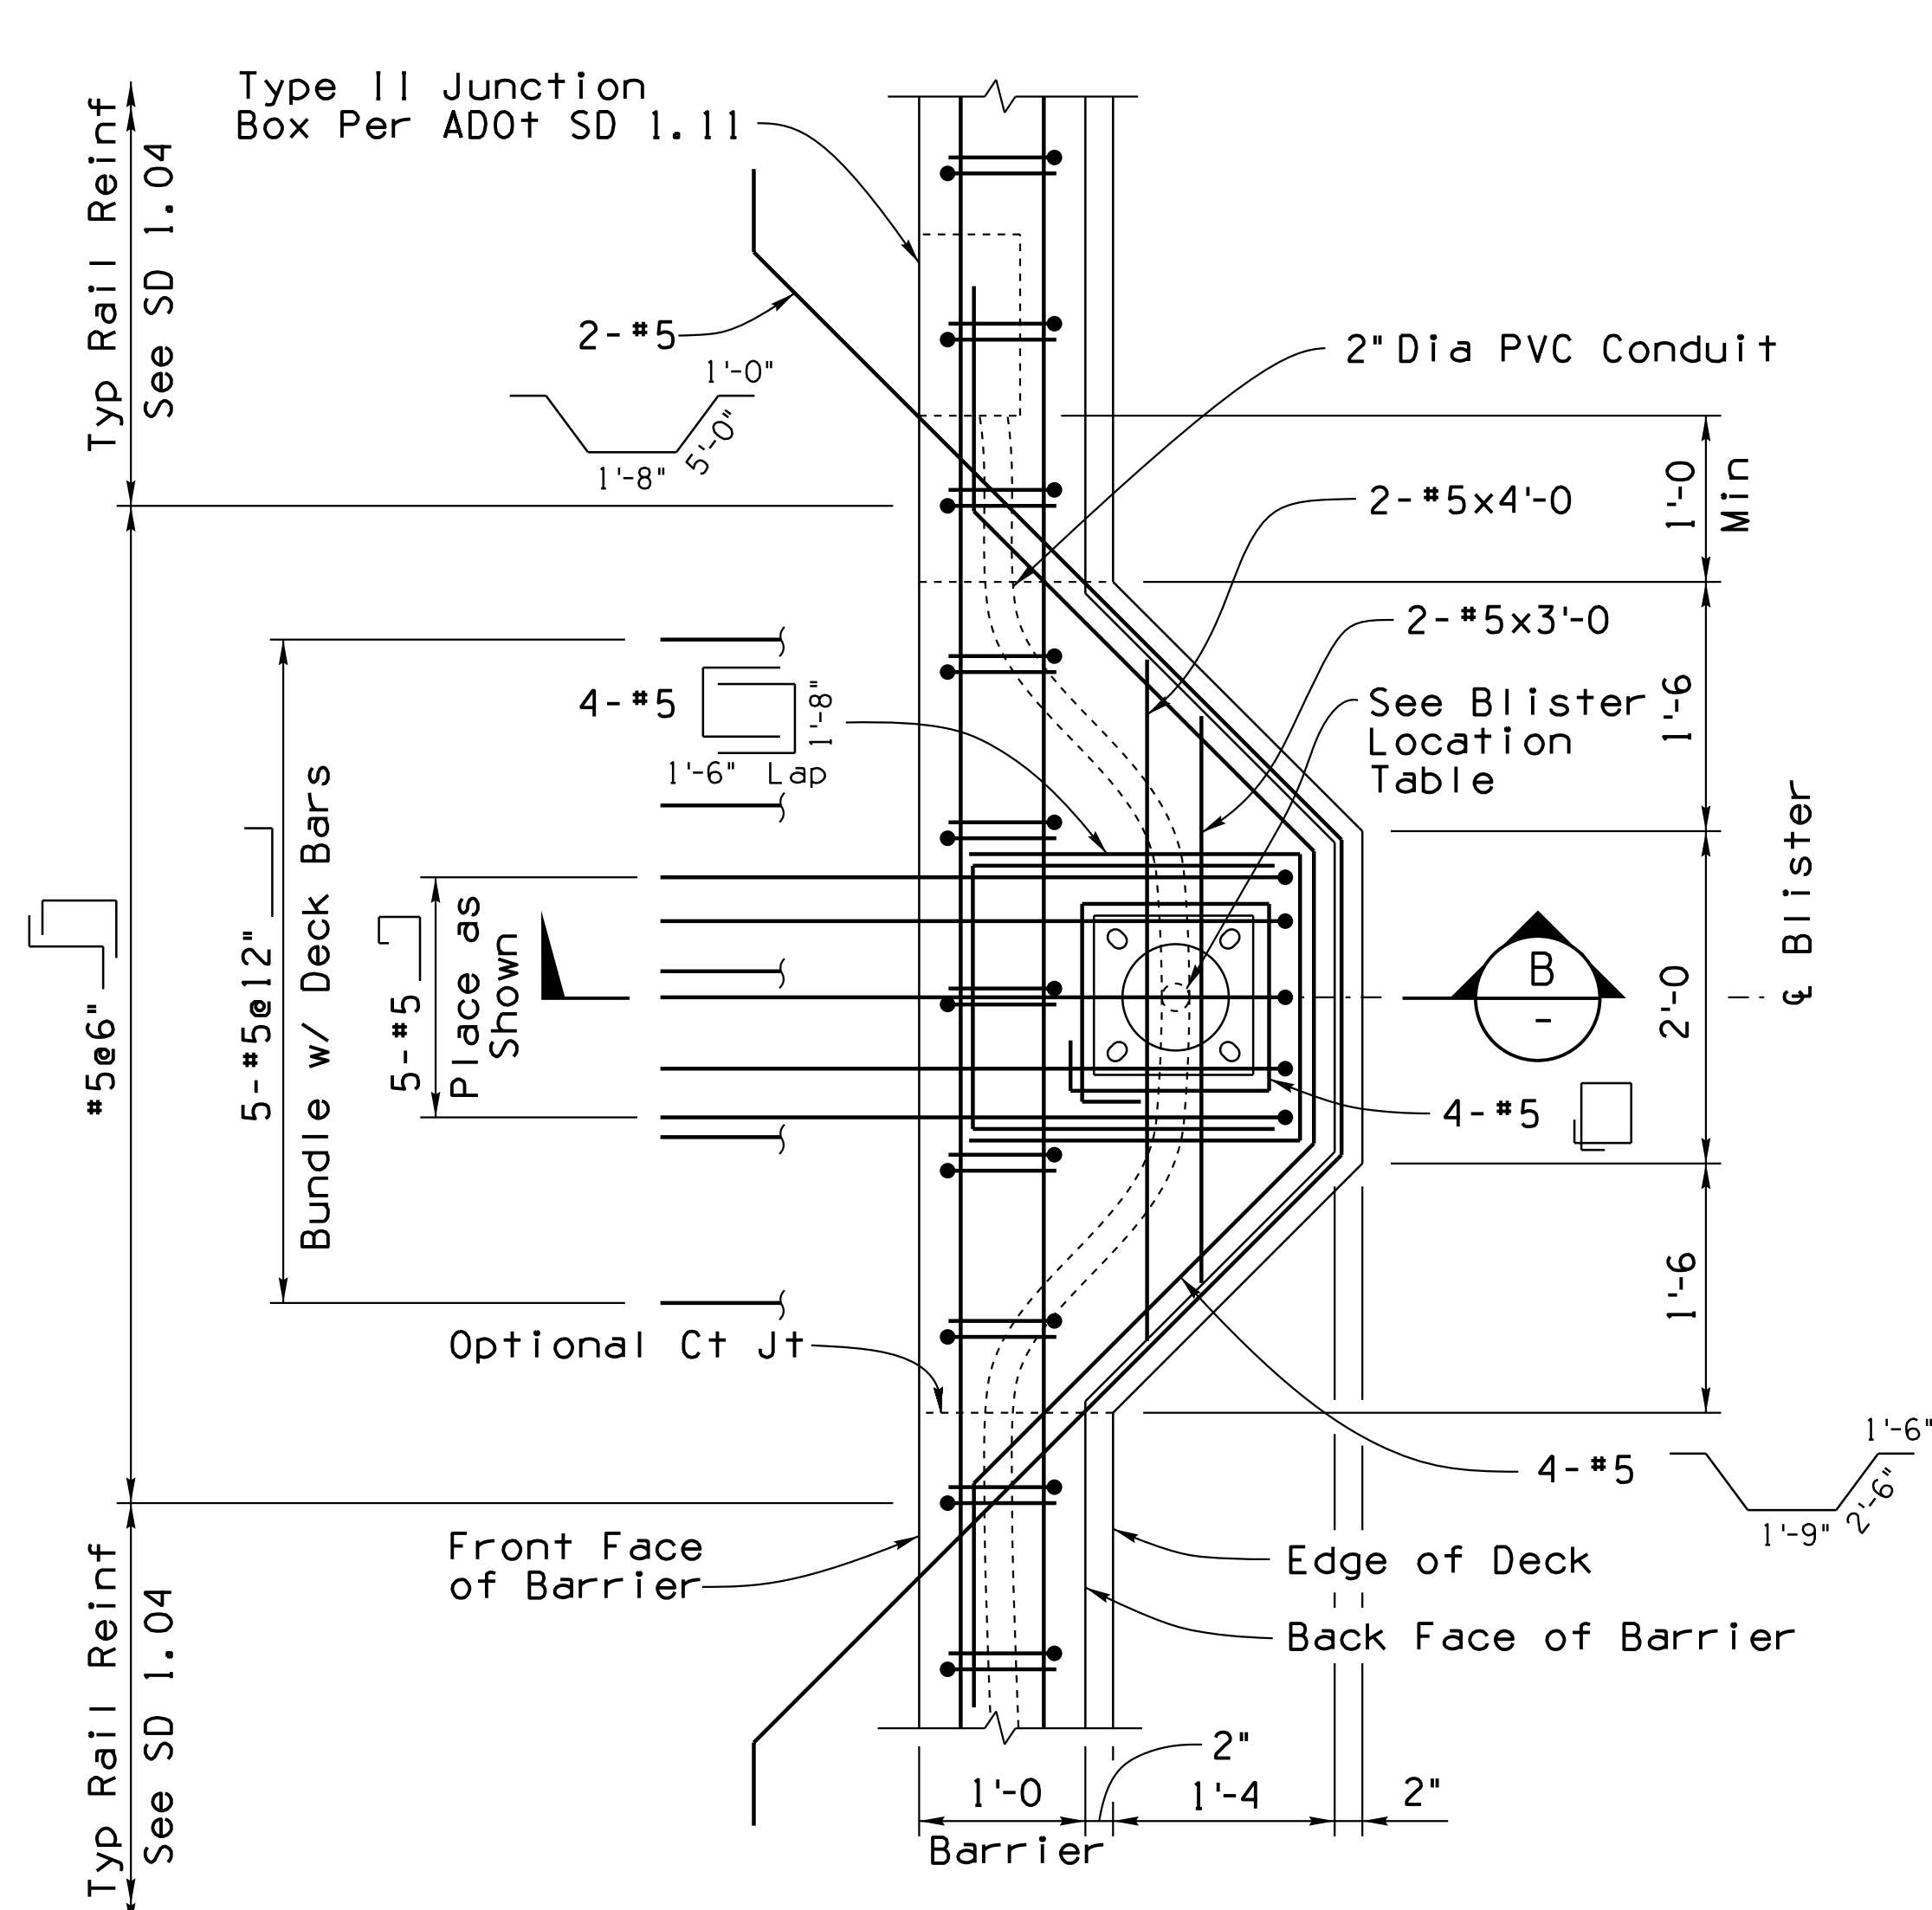


**LIGHT POLE BLISTER DETAIL**

Scale: 1" = 1'-0"


#	Station	Offset
1	98+26.66	64.25 Lt
2	100+19.08	64.25 Rt
3	99+76.65	64.25 Lt

Lighting Junction Box, place between reinforcement. If reinforcement is cut, place equal reinforcement each side of box. See Lighting Sheets

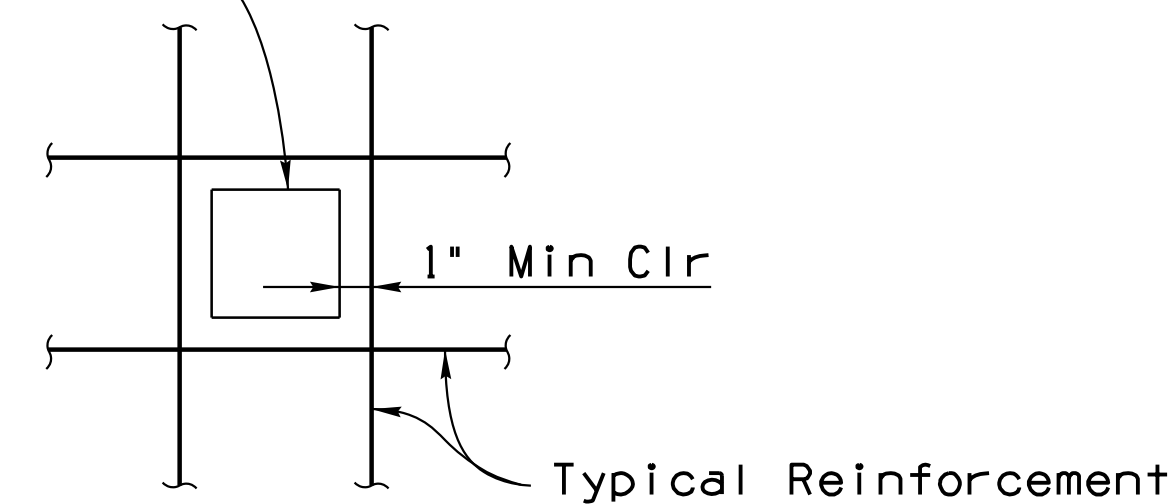

**JUNCTION BOX DETAIL**

Scale: 2" = 1'-0"

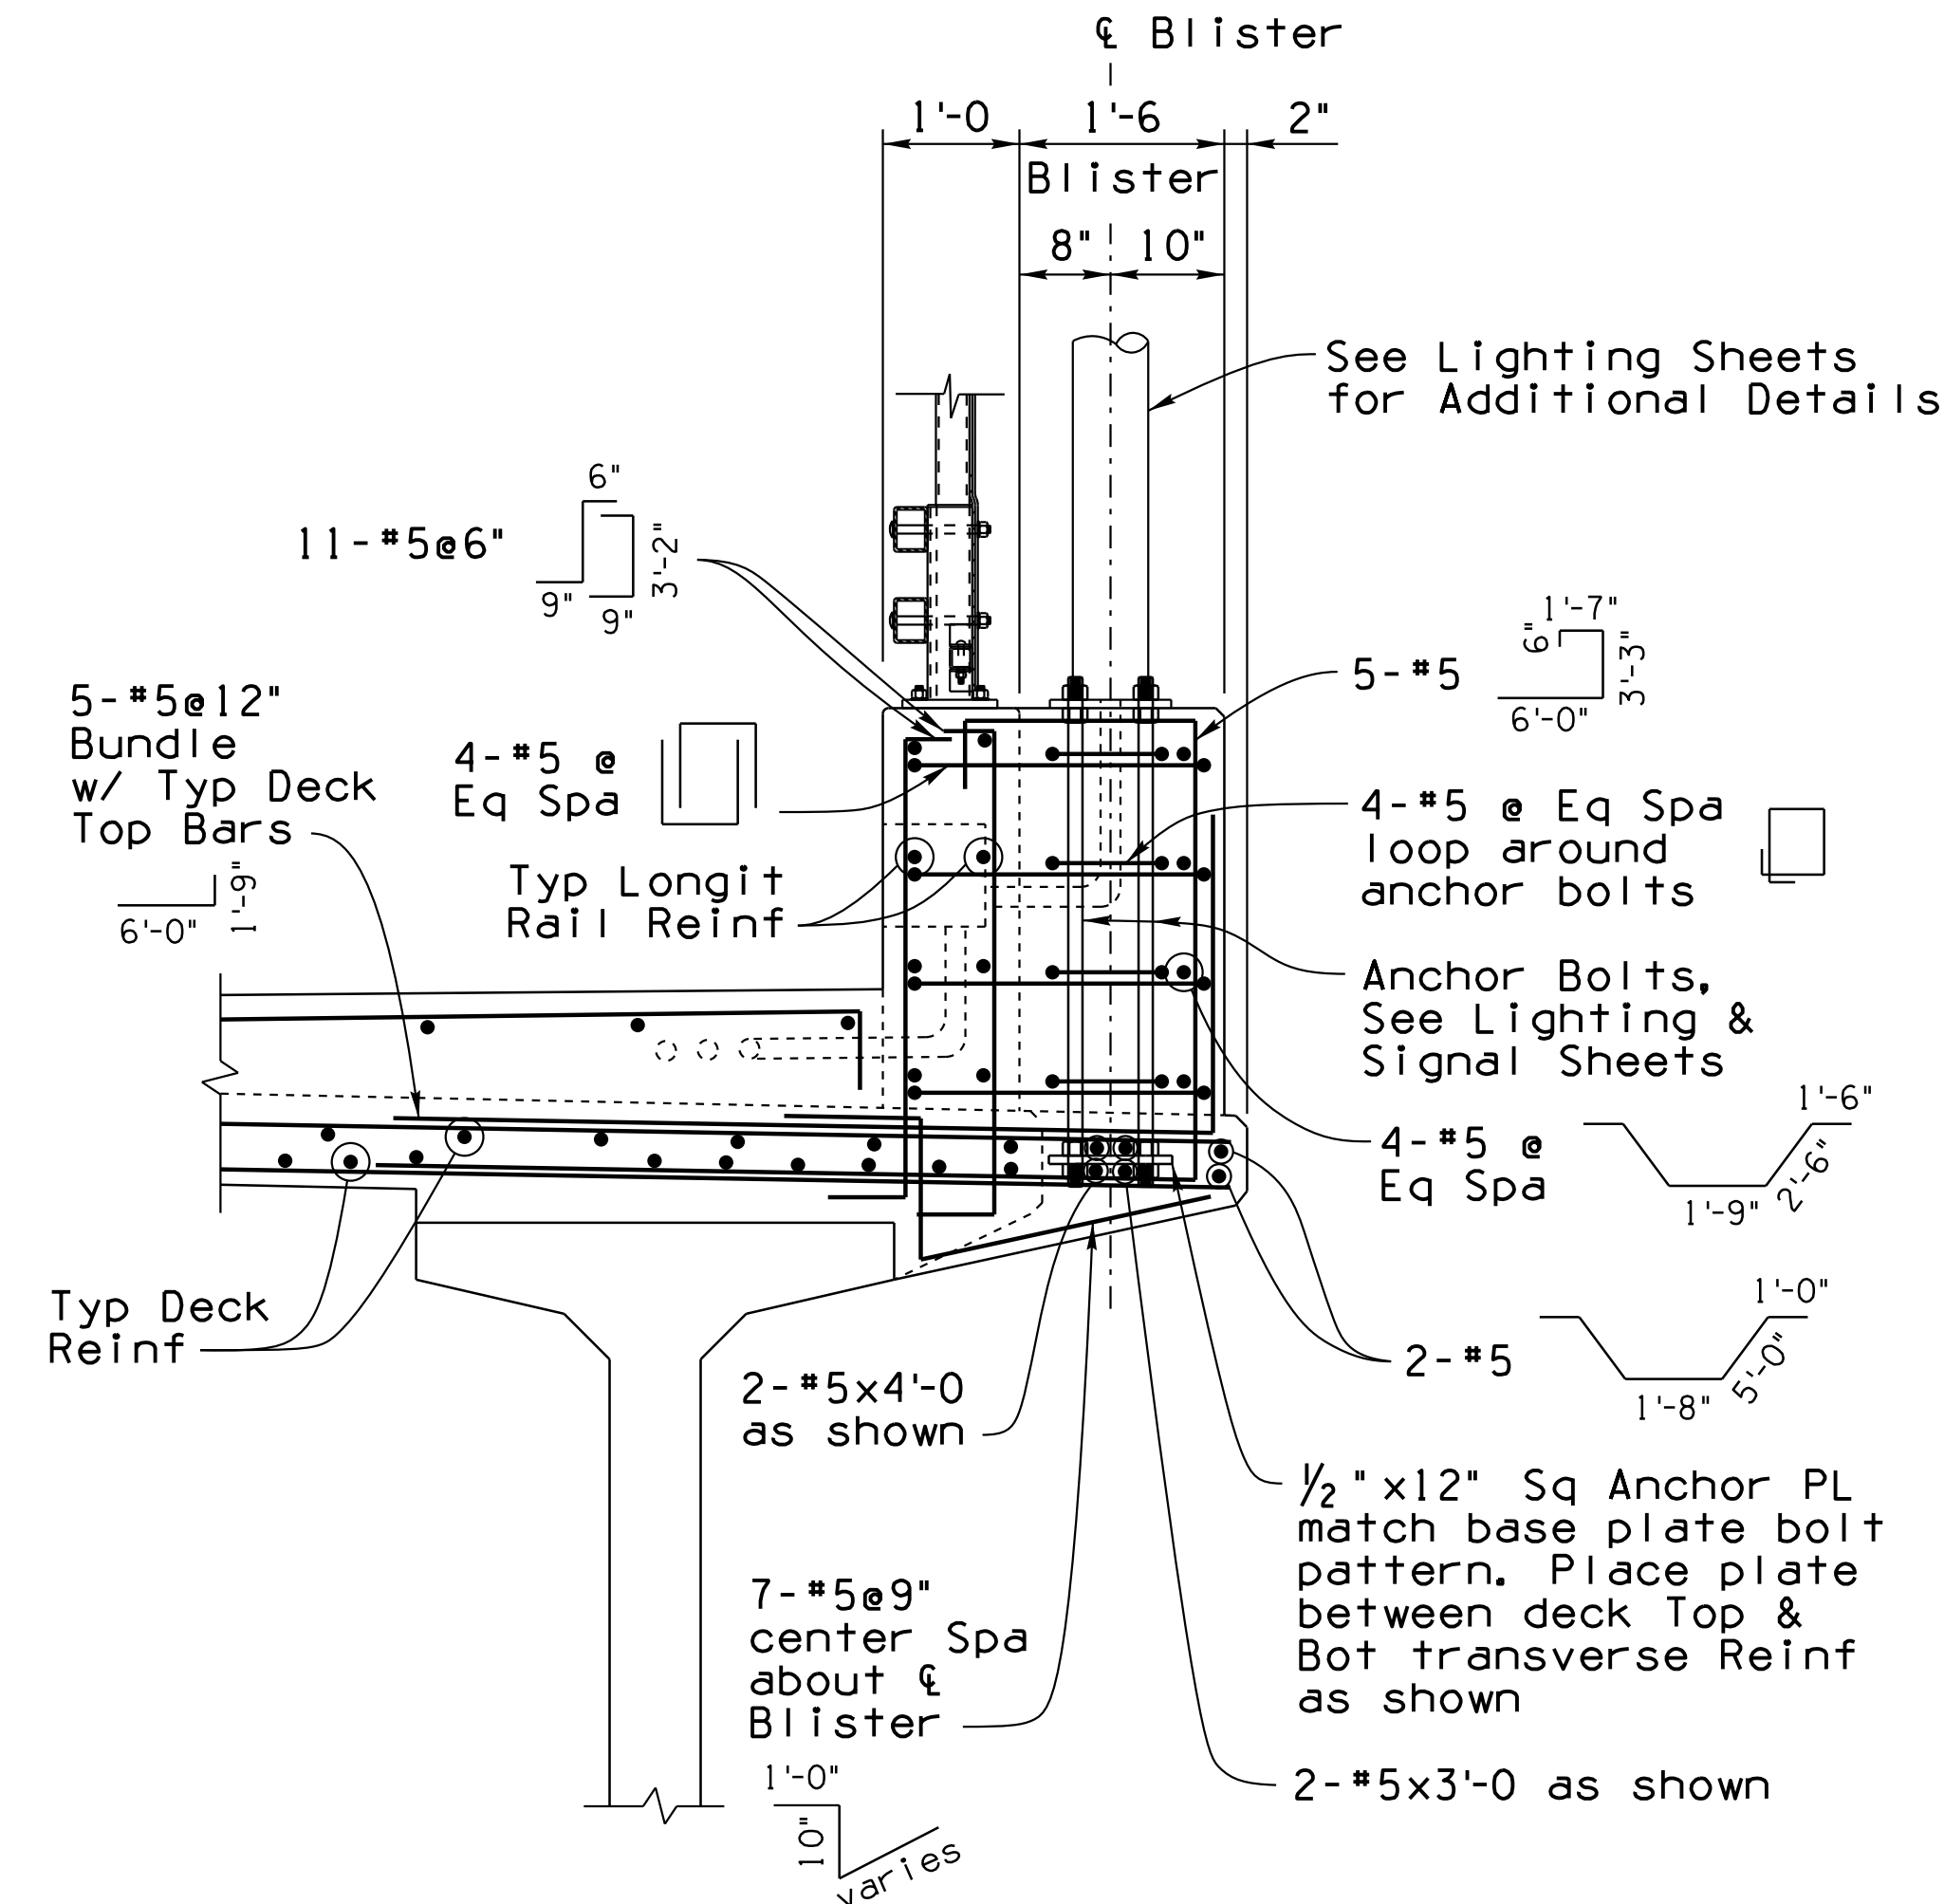

**SECTION B**

Scale: 3/4" = 1'-0"

**Notes:**

1. Light Pole Blister Concrete and Reinforcing Shall be Considered Included in payment for the Combination Pedestrian - Traffic Bridge Railing (SD 1.04). No separate payment will be made for these items.
2. All Structural Steel shall be galvanized. Contractor shall submit shop drawings for any alternative lighting support for review and approval. All materials for furnishing and application of Lighting shall be included in Lighting pay items requiring the materials.

DESIGN	LES / HV	DATE	3-19	ARIZONA DEPARTMENT OF TRANSPORTATION INFRASTRUCTURE DELIVERY AND OPERATIONS DIVISION BRIDGE GROUP	
DRAWN	DAY	DATE	3-19		
CHECKED	AGG / JAC	DATE	3-19		
		WSP USA Inc. 177 N. Church Avenue Suite 1105 Tucson, AZ 85701		STA 99+ RUTHRAUFF ROAD T.I. UNDERPASS LIGHTING DETAILS	
I-10	252.00	20159	LOCATION	RUTHRAUFF ROAD T.I.	DWG NO. S-1.33
TRACS NO. H 8480 OIC			010-D(213)S		

F.H.W.A. REGION	STATE	PROJECT NO.	SHEET NO.	TOTAL SHEETS	RECORD DRAWING
9	ARIZ.	010-D(213)S	647	849	




010 PM 252

BRIDGE SCREED ELEVATIONS - SPAN 1

	€ Brg Abut 1	0.1 pt	0.2 pt	0.3 pt	0.4 pt	0.5 pt	0.6 pt	0.7 pt	0.8 pt	0.9 pt	€ Pier
LT EDGE OF DECK	2268.81	2269.29	2269.76	2270.21	2270.65	2271.08	2271.49	2271.88	2272.26	2272.62	2272.97
FF LT BARRIER	2268.85	2269.34	2269.81	2270.27	2270.71	2271.13	2271.54	2271.94	2272.32	2272.69	2273.04
€ GIRDER 1	2268.93	2269.41	2269.87	2270.32	2270.75	2271.17	2271.57	2271.96	2272.33	2272.69	2273.01
€ GIRDER 2	2269.28	2269.76	2270.22	2270.67	2271.11	2271.52	2271.93	2272.31	2272.68	2273.04	2273.38
€ GIRDER 3	2269.62	2270.10	2270.57	2271.01	2271.45	2271.87	2272.27	2272.65	2273.02	2273.38	2273.72
€ GIRDER 4	2269.96	2270.44	2270.91	2271.36	2271.79	2272.21	2272.61	2273.00	2273.37	2273.72	2274.06
€ GIRDER 5	2270.31	2270.79	2271.25	2271.70	2272.13	2272.55	2272.95	2273.34	2273.71	2274.06	2274.40
€ GIRDER 6	2270.65	2271.13	2271.59	2272.04	2272.48	2272.89	2273.30	2273.68	2274.05	2274.41	2274.75
€ GIRDER 7	2270.99	2271.47	2271.94	2272.39	2272.82	2273.24	2273.64	2274.03	2274.40	2274.75	2275.09
€ GRDR 8 & BRIDGE	2271.33	2271.81	2272.28	2272.73	2273.16	2273.58	2273.98	2274.37	2274.74	2275.09	2275.43
€ GIRDER 9	2271.42	2271.90	2272.36	2272.81	2273.24	2273.66	2274.06	2274.45	2274.82	2275.18	2275.51
€ GIRDER 10	2271.50	2271.98	2272.44	2272.89	2273.33	2273.74	2274.15	2274.53	2274.90	2275.26	2275.60
€ GIRDER 11	2271.58	2272.06	2272.53	2272.98	2273.41	2273.83	2274.23	2274.62	2274.99	2275.34	2275.68
€ GIRDER 12	2271.66	2272.14	2272.61	2273.06	2273.49	2273.91	2274.31	2274.70	2275.07	2275.42	2275.76
€ GIRDER 13	2271.75	2272.23	2272.69	2273.14	2273.58	2273.99	2274.39	2274.78	2275.15	2275.51	2275.85
€ GIRDER 14	2271.83	2272.31	2272.77	2273.22	2273.66	2274.08	2274.48	2274.86	2275.23	2275.59	2275.93
€ GIRDER 15	2271.91	2272.39	2272.85	2273.30	2273.73	2274.15	2274.55	2274.94	2275.31	2275.67	2276.01
FF RT BARRIER	2271.93	2272.41	2272.88	2273.34	2273.78	2274.20	2274.61	2275.00	2275.38	2275.75	2276.10
RT EDGE OF DECK	2271.94	2272.43	2272.90	2273.35	2273.79	2274.21	2274.62	2275.02	2275.39	2275.76	2276.11

SCREED ELEVATION NOTES:

1. Screed elevations are given along lines parallel to € Abut/Pier at intervals of 1/10 the distance between centerline of bearings at abutment and € of pier.
2. Release and initial Deflections shall be measured at tenth points for each girder and the data provided to the Engineer for evaluation.
3. The top of Erected Girder Elevations shall be measured in the field at tenth points and the information shall be provided to the Engineer for review & approval prior to setting formwork or screed elevations.
4. The tabulated Screed Elevation includes an allowance for the deflection due to dead load of the deck slab, diaphragms, barriers, sidewalks, median, and the effect of long term creep.
5. The build-up is calculated based on the measured elevations at the top of girder. (Build-up) = (Screed Elevation) - (Deck Slab Thickness) - (Measured Erected Elevation at Top of Girder).
6. The tabulated Screed Elevations shall be used in setting screeds. Adjustments to the screed elevations, if necessary, will be determined by the Engineer after reviewing the top of erected girder elevations. (DO NOT USE FINISHED GRADE ELEVATIONS FOR SETTING SCREEDS).
7. Contractor shall screed bridge such that screed machine progresses along skew.

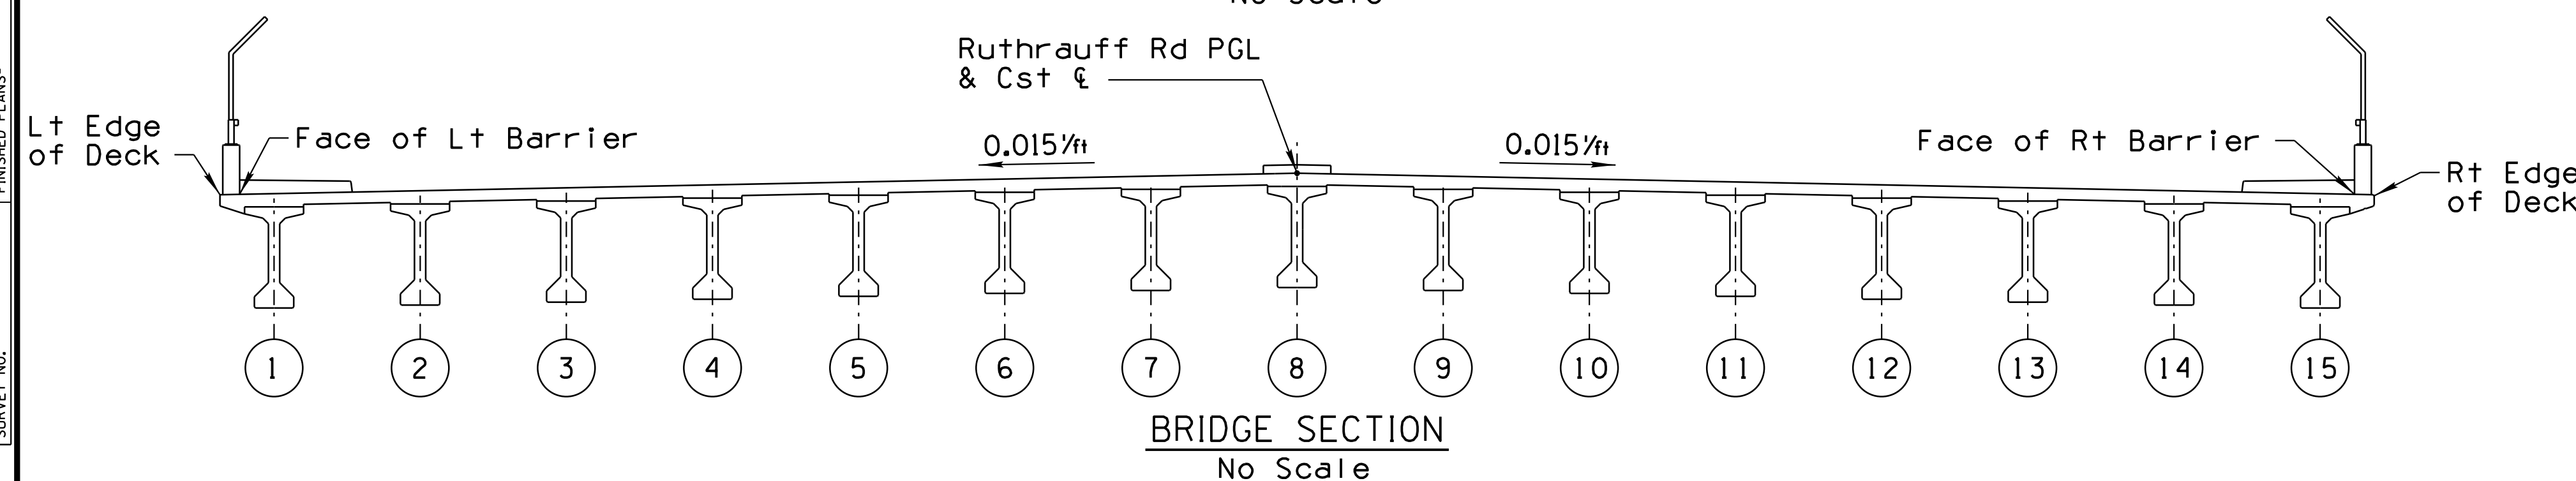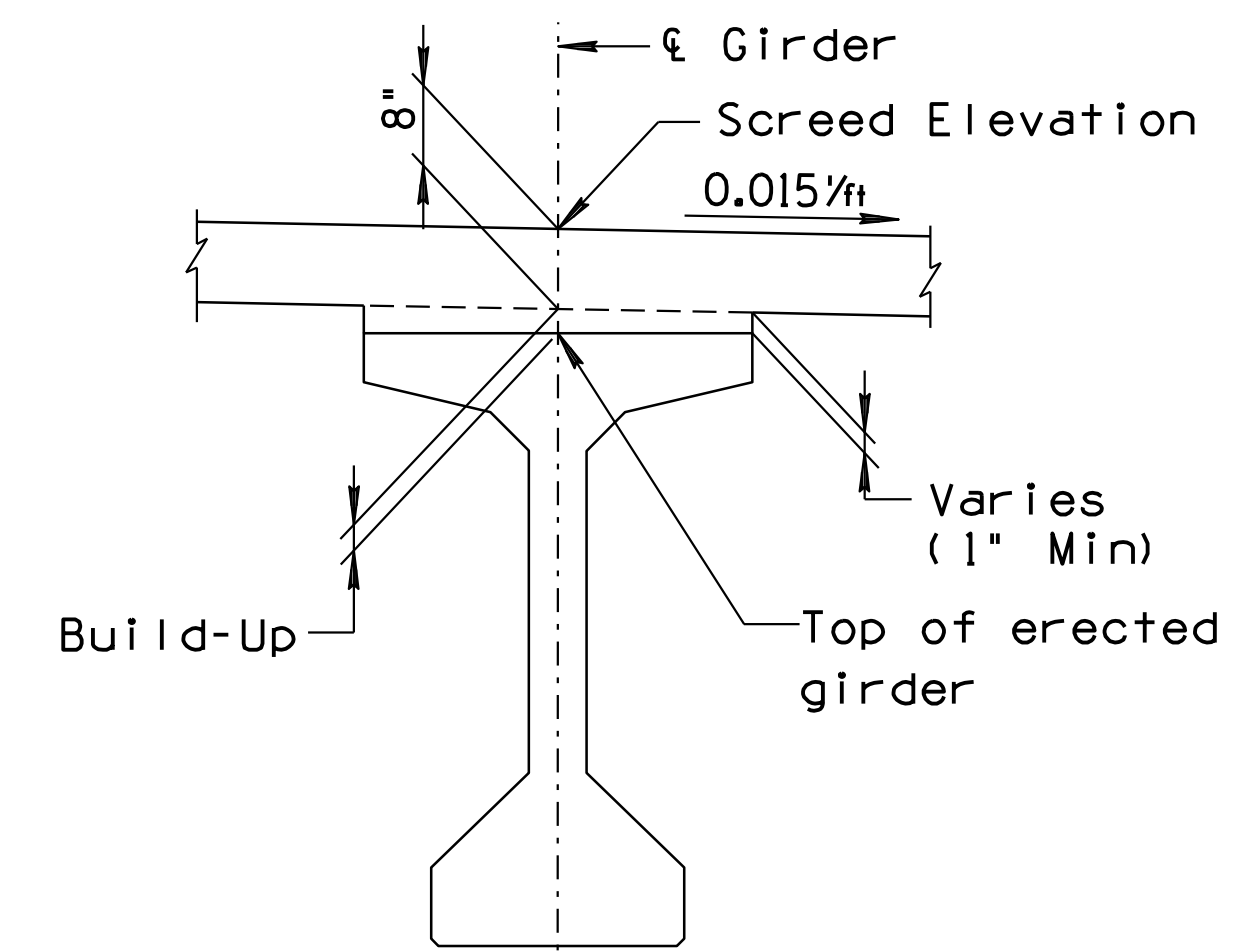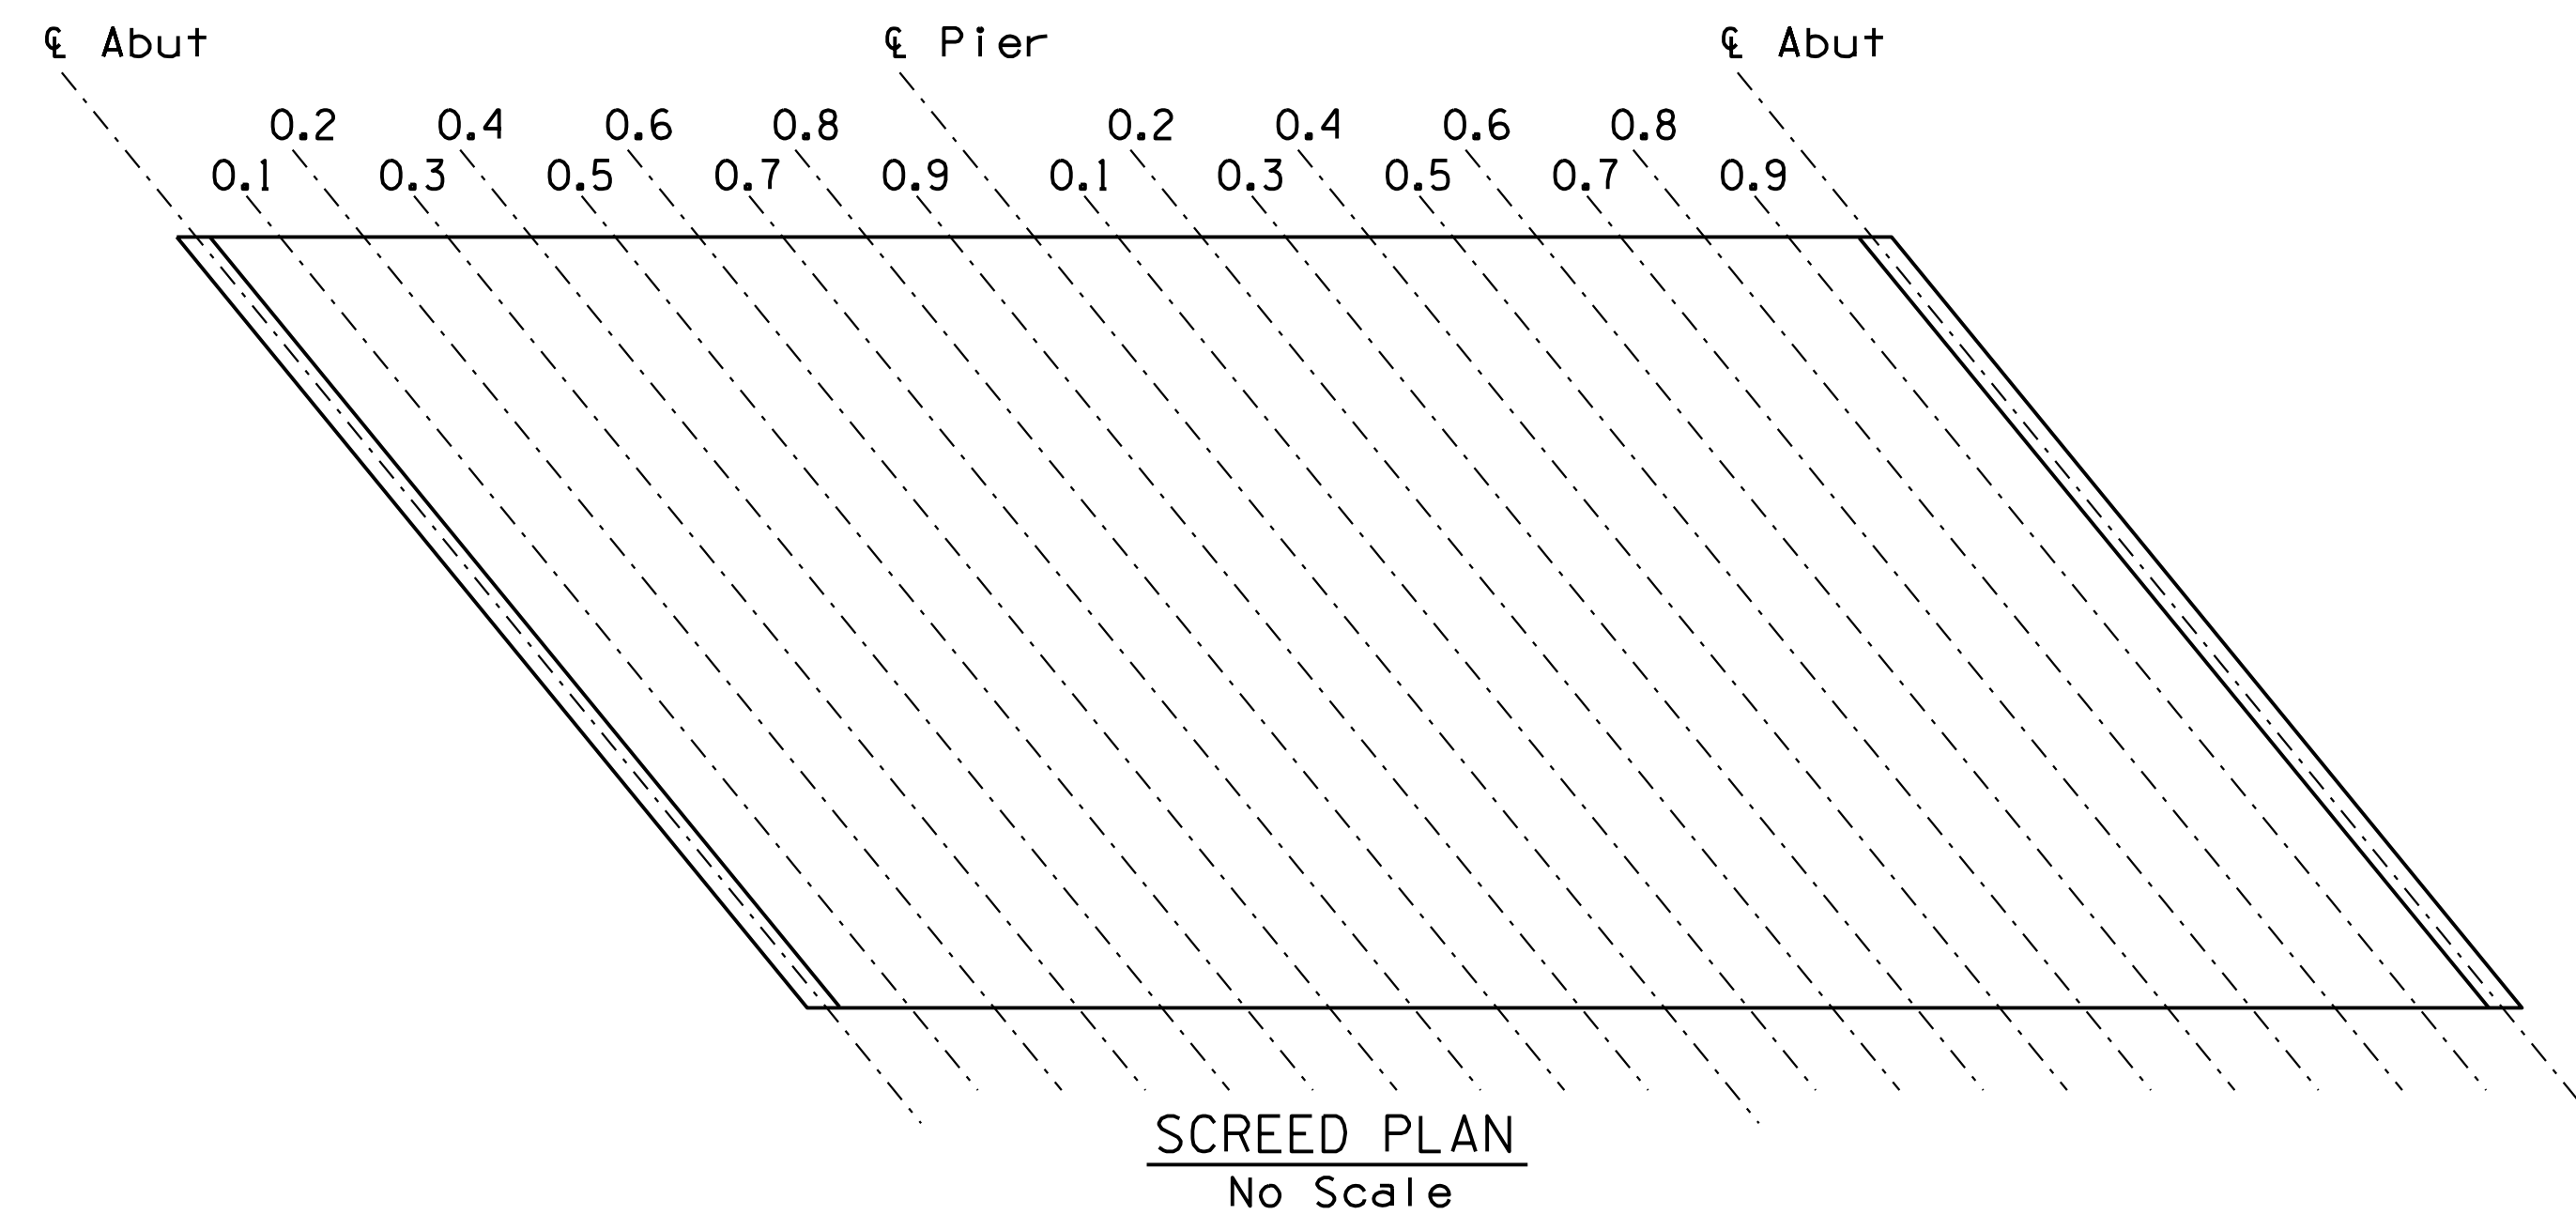

DESIGN	LES / HV	DATE	3-19	ARIZONA DEPARTMENT OF TRANSPORTATION INFRASTRUCTURE DELIVERY AND OPERATIONS DIVISION <b>BRIDGE GROUP</b>  STA 99+ <b>RUTHRAUFF ROAD T.I. UNDERPASS</b> <b>SCREED ELEVATIONS 1</b>	
DRAWN	DAY	3-19			
CHECKED	AGG / JAC	3-19			
<b>wsp</b> WSP USA Inc. 177 N. Church Avenue Suite 1105 Tucson, AZ 85701		LOCATION	RUTHRAUFF ROAD T.I.	DWG NO.	S-1.34
I-10 ROUTE	252.00 MILEPOST	20159 STRUCTURE NO.	TRACS NO. H 8480 OIC		
			010-D(213)S		
					OF



F.H.W.A. REGION	STATE	PROJECT NO.	SHEET NO.	TOTAL SHEETS	RECORD DRAWING
9	ARIZ.	010-D(213)S	648	849	


010 PM 252

BRIDGE SCREED ELEVATIONS - SPAN 2


	€ Pier	0.1 pt	0.2 pt	0.3 pt	0.4 pt	0.5 pt	0.6 pt	0.7 pt	0.8 pt	0.9 pt	€ Brg Abut 2
LT EDGE OF DECK	2272.97	2273.46	2273.93	2274.38	2274.82	2275.24	2275.65	2276.05	2276.43	2276.79	2277.14
FF LT BARRIER	2273.04	2273.52	2273.99	2274.44	2274.88	2275.30	2275.71	2276.10	2276.48	2276.84	2277.19
€ GIRDER 1	2273.17	2273.65	2274.11	2274.55	2274.99	2275.40	2275.81	2276.19	2276.57	2276.92	2277.27
€ GIRDER 2	2273.51	2273.99	2274.46	2274.91	2275.34	2275.76	2276.16	2276.55	2276.92	2277.27	2277.61
€ GIRDER 3	2273.85	2274.34	2274.80	2275.25	2275.68	2276.10	2276.50	2276.89	2277.26	2277.61	2277.95
€ GIRDER 4	2274.20	2274.68	2275.14	2275.59	2276.03	2276.44	2276.85	2277.23	2277.60	2277.96	2278.30
€ GIRDER 5	2274.54	2275.02	2275.49	2275.93	2276.37	2276.79	2277.19	2277.57	2277.94	2278.30	2278.64
€ GIRDER 6	2274.88	2275.36	2275.83	2276.28	2276.71	2277.13	2277.53	2277.92	2278.29	2278.64	2278.98
€ GIRDER 7	2275.22	2275.70	2276.17	2276.62	2277.05	2277.46	2277.86	2278.25	2278.62	2278.97	2279.31
€ GRDR 8 & BRIDGE	2275.57	2276.05	2276.51	2276.96	2277.40	2277.81	2278.22	2278.60	2278.97	2279.33	2279.67
€ GIRDER 9	2275.65	2276.13	2276.60	2277.05	2277.48	2277.90	2278.30	2278.68	2279.06	2279.41	2279.75
€ GIRDER 10	2275.73	2276.21	2276.68	2277.13	2277.56	2277.98	2278.38	2278.77	2279.14	2279.49	2279.83
€ GIRDER 11	2275.82	2276.30	2276.76	2277.21	2277.64	2278.06	2278.46	2278.85	2279.22	2279.57	2279.90
€ GIRDER 12	2275.90	2276.38	2276.84	2277.29	2277.73	2278.14	2278.55	2278.93	2279.30	2279.65	2279.97
€ GIRDER 13	2275.98	2276.46	2276.93	2277.38	2277.81	2278.23	2278.63	2279.02	2279.38	2279.72	2280.03
€ GIRDER 14	2276.06	2276.54	2277.01	2277.46	2277.89	2278.31	2278.71	2279.10	2279.46	2279.79	2280.09
€ GIRDER 15	2276.15	2276.62	2277.09	2277.53	2277.96	2278.38	2278.78	2279.17	2279.53	2279.85	2280.14
FF RT BARRIER	2276.10	2276.58	2277.05	2277.50	2277.94	2278.37	2278.78	2279.17	2279.53	2279.86	2280.15
RT EDGE OF DECK	2276.11	2276.59	2277.06	2277.52	2277.95	2278.38	2278.79	2279.18	2279.54	2279.87	2280.16

SCREED ELEVATION NOTES:


1. Screed elevations are given along lines parallel to € Abut/Pier at intervals of 1/10 the distance between centerline of bearings at abutment and € of pier.
2. Release and initial Deflections shall be measured at tenth points for each girder and the data provided to the Engineer for evaluation.
3. The top of Erected Girder Elevations shall be measured in the field at tenth points and the information shall be provided to the Engineer for review & approval prior to setting formwork or screed elevations.
4. The tabulated Screed Elevation includes an allowance for the deflection due to dead load of the deck slab, diaphragms, barriers, sidewalks, median, and the effect of long term creep.
5. The build-up is calculated based on the measured elevations at the top of girder. (Build-up) = (Screed Elevation) - (Deck Slab Thickness) - (Measured Erected Elevation at Top of Girder).
6. The tabulated Screed Elevations shall be used in setting screeds. Adjustments to the screed elevations, if necessary, will be determined by the Engineer after reviewing the top of erected girder elevations. (DO NOT USE FINISHED GRADE ELEVATIONS FOR SETTING SCREEDS).
7. Contractor shall screed bridge such that screed machine progresses along skew.

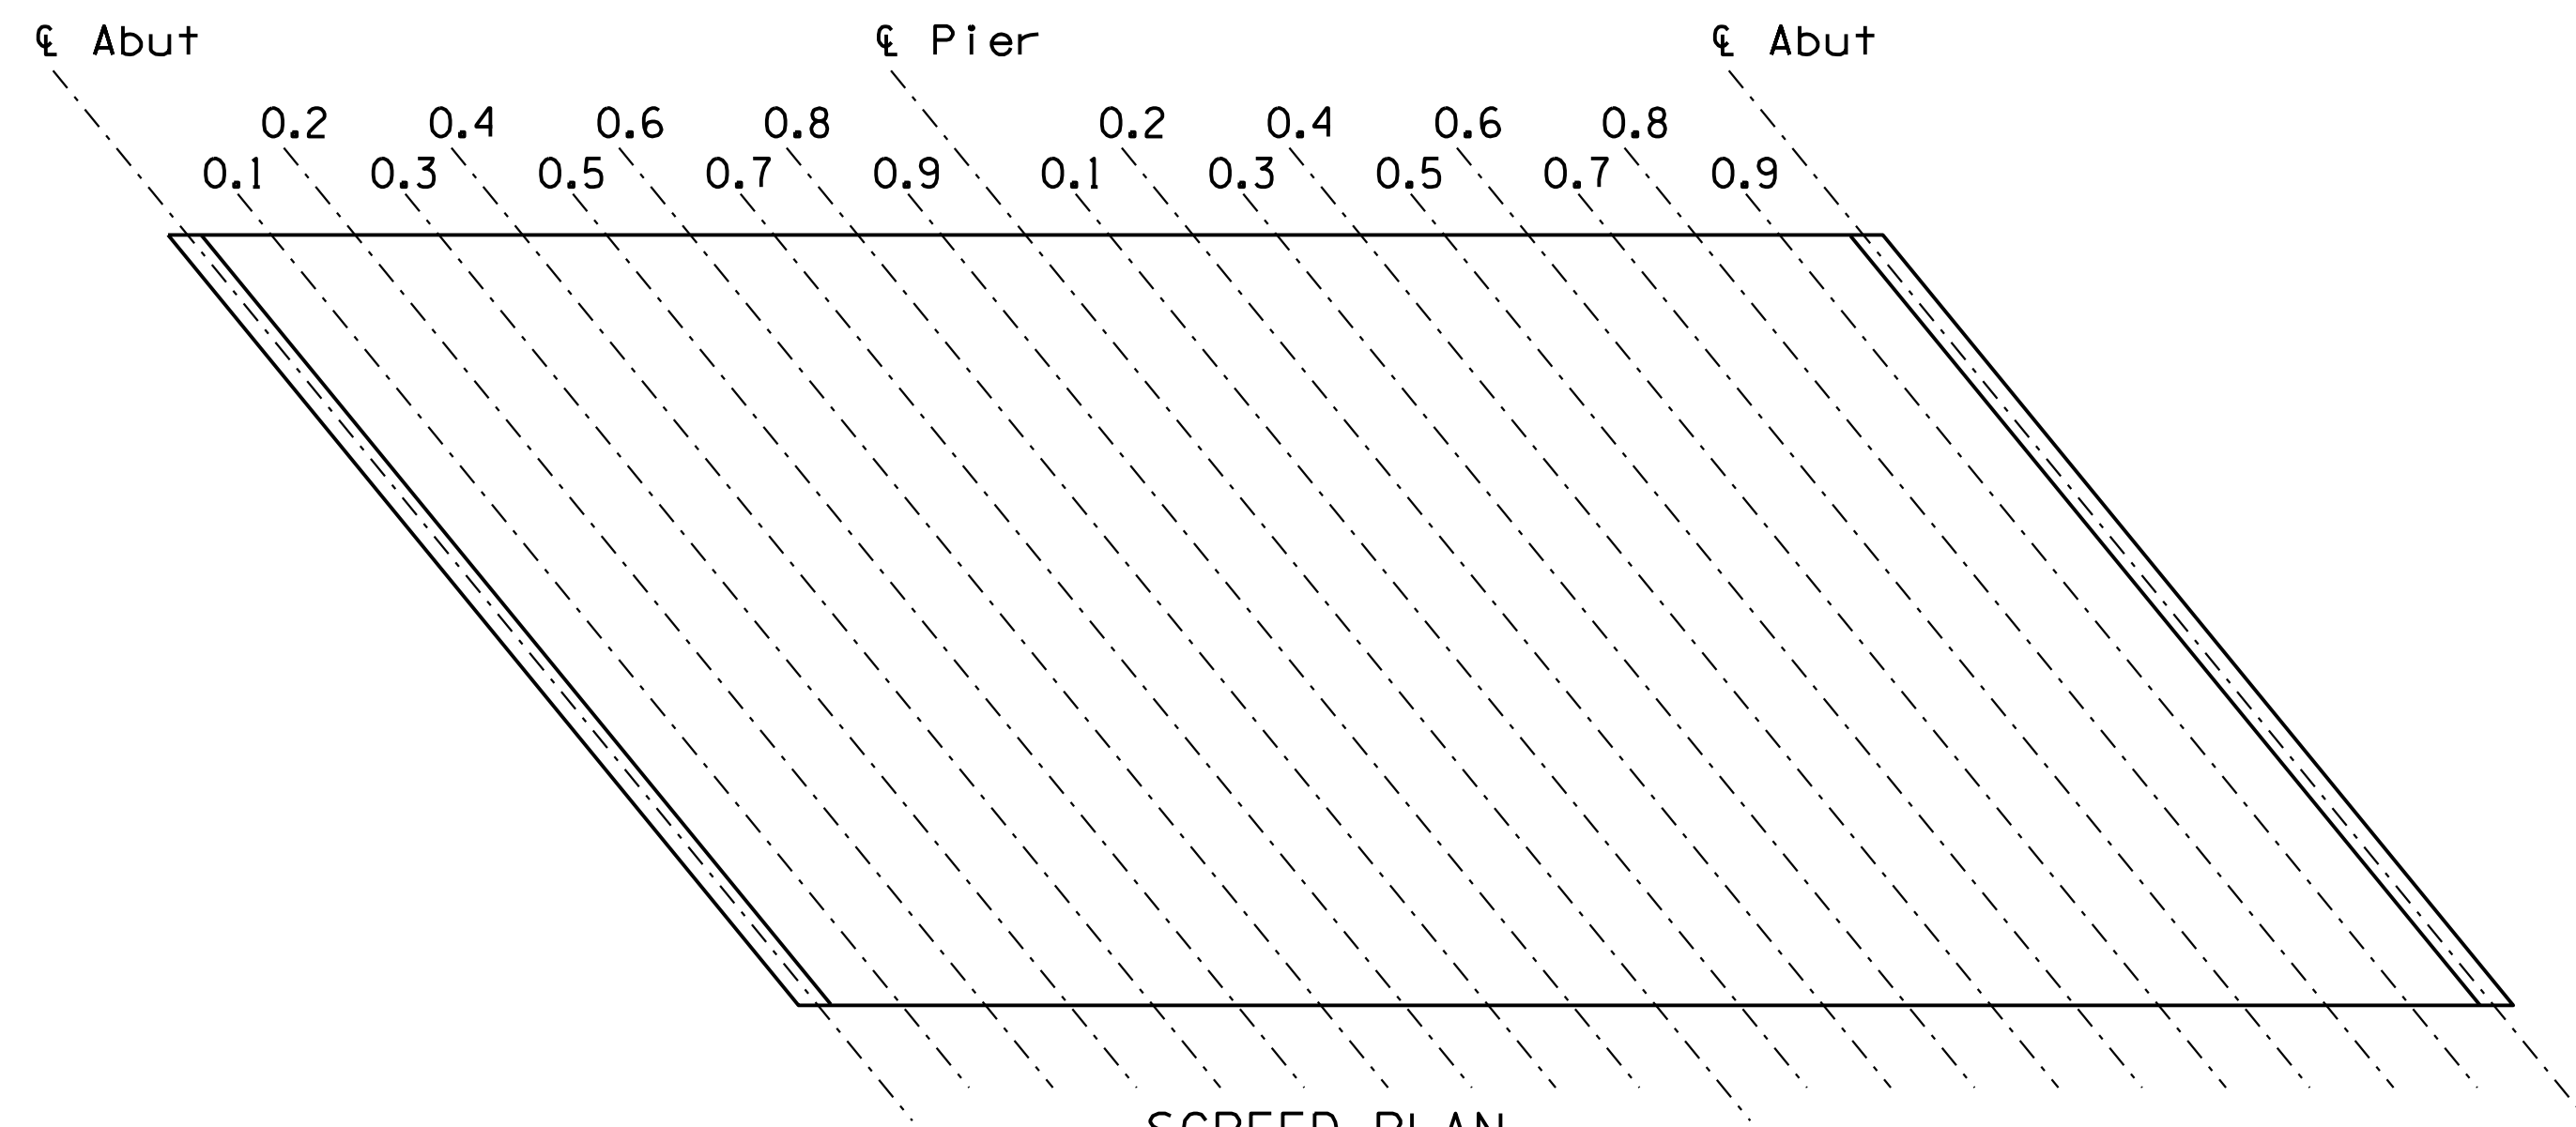

SCREED PLAN  
No Scale

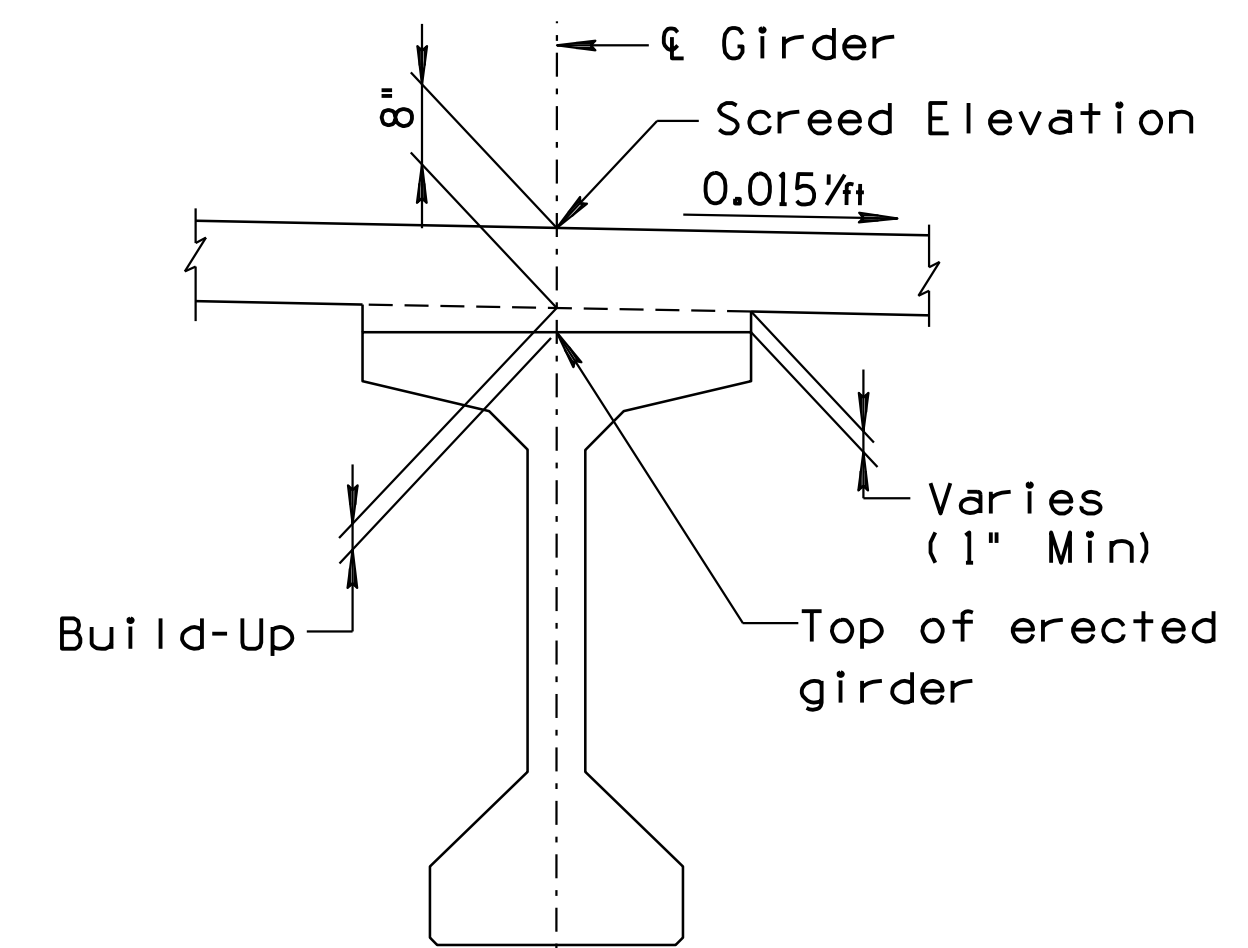

SCREED ELEVATION SECTION  
No Scale

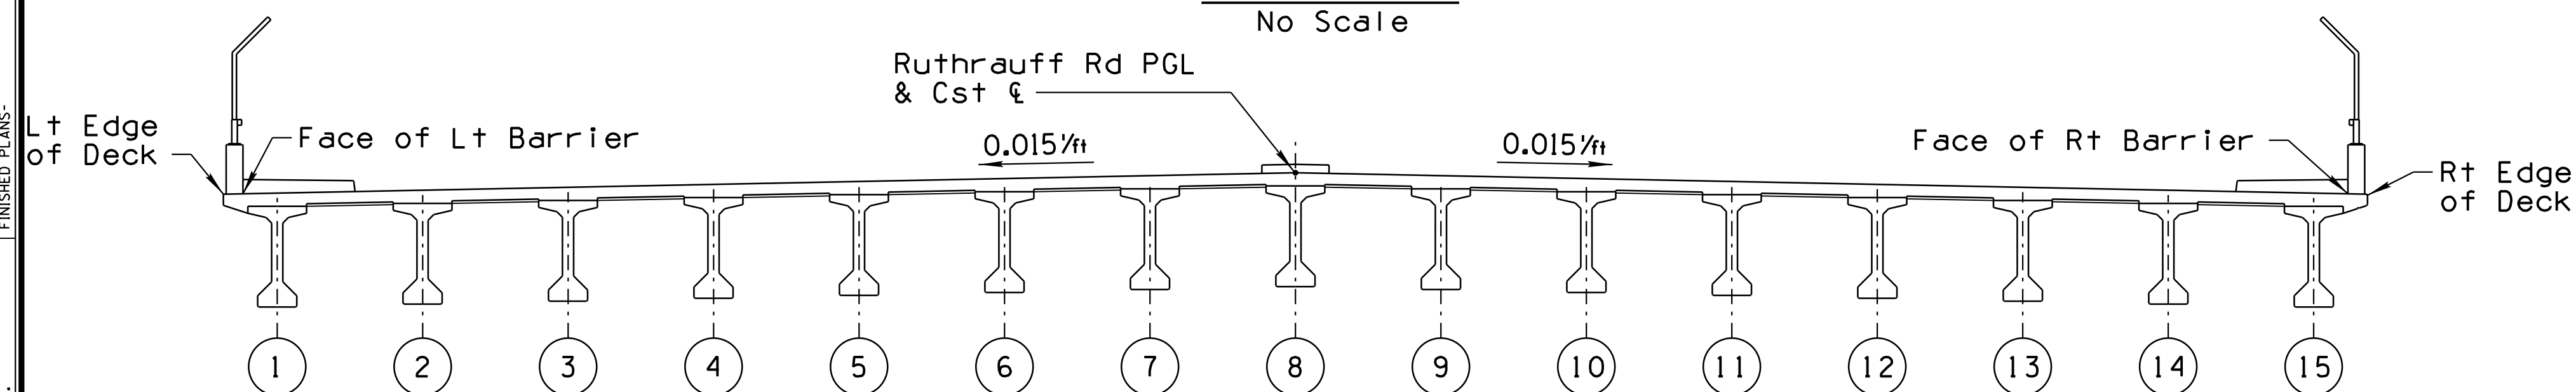

BRIDGE SECTION  
No Scale

DESIGN	LES / HV	DATE	3-19	ARIZONA DEPARTMENT OF TRANSPORTATION INFRASTRUCTURE DELIVERY AND OPERATIONS DIVISION <b>BRIDGE GROUP</b>  STA 99+ <b>RUTHRAUFF ROAD T.I. UNDERPASS</b> <b>SCREED ELEVATIONS 2</b>	
DRAWN	DAY	3-19			
CHECKED	AGG / JAC	3-19			
<b>wsp</b> WSP USA Inc. 177 N. Church Avenue Suite 1105 Tucson, AZ 85701		LOCATION	RUTHRAUFF ROAD T.I.	DWG NO.	S-1.35
I-10 ROUTE	252.00 MILEPOST	20159 STRUCTURE NO.	TRACS NO. H 8480 OIC      010-D(213)S <u>OF</u>		

F.H.W.A. REGION	STATE	PROJECT NO.	SHEET NO.	TOTAL SHEETS	RECORD DRAWING
9	ARIZ.	010-D(213)S	649	849	


010 PM 252

GENERAL NOTES

- General soil and rock (where encountered) strata descriptions and indicated boundaries are based on engineering interpretation of available subsurface information by the geotechnical engineer and may not reflect actual variation in subsurface conditions between borings and samples. The location of contacts between strata may be gradual rather than abrupt. Classification of soil material is in general accordance with ASTM D 2488-93 and is presented in the Geotechnical Report.
- The observed water levels and/or moisture conditions indicated on the boring logs are as recorded at the time of field investigation. These water levels and/or moisture conditions may vary considerably with time according to the prevailing climate, rainfall or other factors and are otherwise dependent upon the duration of and methods used in the field investigation program.
- Sound engineering judgment was exercised in preparing the subsurface information presented on these sheets. This information was prepared and is intended for design and estimating purposes. Its presentation on the plans or elsewhere is for the purpose of providing intended users with access to the same information as was provided to the State and its designers. Interpretations of subsurface information are presented in good faith and are not intended as a substitute for personal investigation, independent interpretations or judgment of the contractor.
- A 140 lb. hammer, 30-inch free-fall, was used to drive both the Standard Penetration Test (SPT) split-spoon sampler and the ring-lined sampler in general conformance with ASTM D 1586-96 and D 3550-01, respectively.
- For further information, refer to NCS report "Final Geotechnical Report; I-10, Ruthrauff Road Traffic Interchange," submitted to HDR on March 31, 2015 and any addenda.
- Reaction to dilute HCl (as per ASTM D 2488) does not necessarily correlate to the degree of carbonate cementation. For example, a "strong" reaction to HCl and a low SPT N-value may indicate that the soil particles are coated with calcium carbonate or lime but the voids are mostly clear, i.e. the particles are not significantly cemented to each other; therefore, the density is loose. In other cases, soil may exhibit "no" to "weak" reaction to HCl but appear to be strongly cemented due to induration. Thus, the user should consider the reported reaction to HCl and SPT N-values in conjunction with other relevant factors to evaluate the degree of cementation and its effect on construction activities.
- Refusal SPT N-values may be indicative of the presence of cobbles or boulders whose size cannot be determined by the investigative techniques used for this project. Cobbles and boulders will likely be encountered during the construction of the drilled shafts. Additionally, cemented layers may form cobble or boulder size pieces when broken up. The contractor should mobilize the appropriate equipment for removing this material.
- The site soils contain random zones of poorly graded sands and gravels. These soils are prone to caving. Therefore, localized caving should be anticipated during drilled shaft construction. These local zones may be up to 20-ft thick and can occur at various depths.
- The site soils contain random zones of gravels, cobbles and boulders. These materials experience large fluid loss during slurry-assisted drilled shaft construction.

BORING PLAN

SCALE 1:100

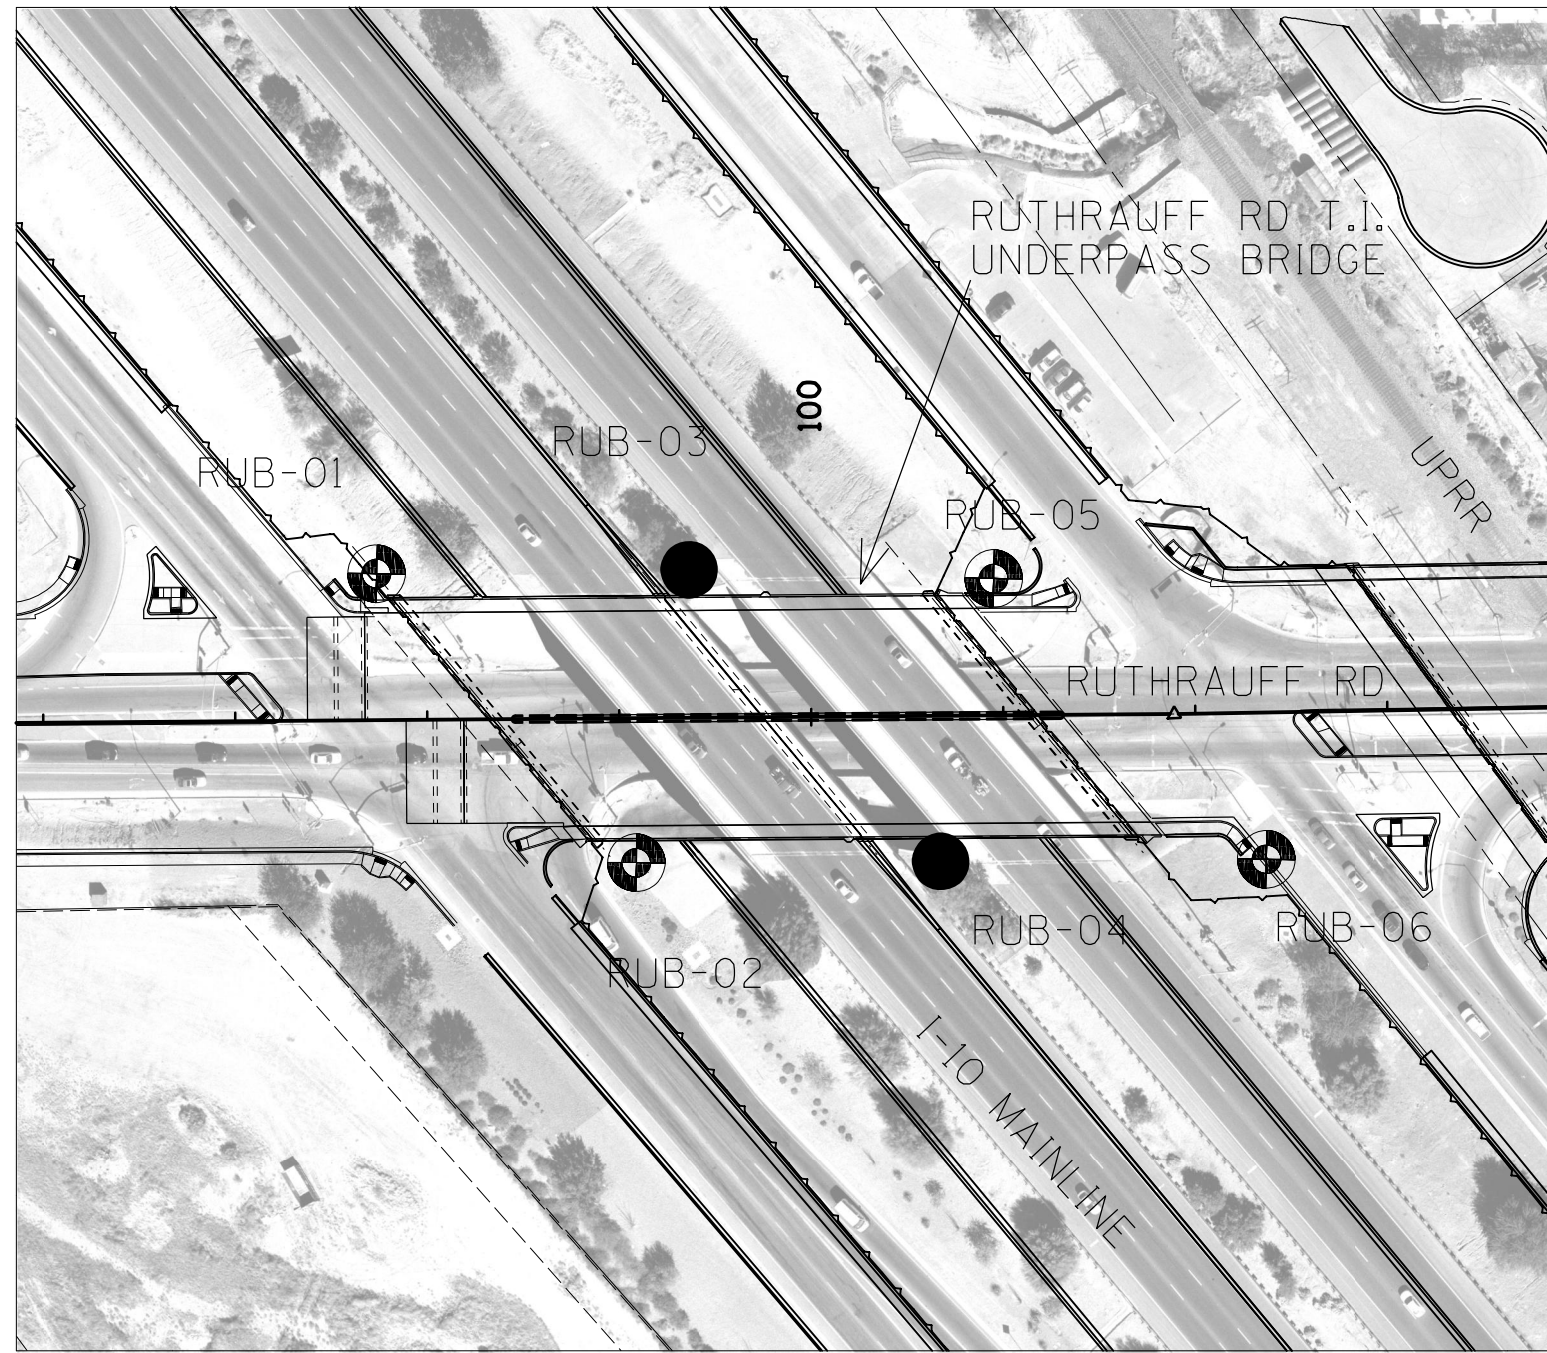

- PHASE 1 BORING LOCATION
- PHASE 2 BORING LOCATION

OTHER TERMINOLOGY

<b>Quantity:</b>	<b>Reaction to HCl:</b>	
Trace < 5%	No reaction	No visible reaction
Few 5-10%	Weak reaction	Some reaction, with bubbles forming slowly
Little 15-25%	Strong reaction	Violent reaction, with bubbles forming immediately
Some 30-45%		
Mostly > 50%		

DESIGN	JBH	DATE	3-19	<b>ARIZONA DEPARTMENT OF TRANSPORTATION</b> <b>INFRASTRUCTURE DELIVERY AND OPERATIONS DIVISION</b> <b>BRIDGE GROUP</b>  STA 99+ <b>RUTHRAUFF ROAD T.I. UNDERPASS</b> <b>FOUNDATION DATA (1 OF 7)</b>	
DRAWN	JBH	3-19			
CHECKED	KW	3-19			
<b>SCE ENGINEERING</b>		510 E. 4TH STREET TUCSON, AZ 85705 520-405-1353		RUTHRAUFF ROAD T.I. DWG NO. <b>S-1.36</b>	
I-10	252.00	20159	LOCATION	<b>010-D(213)S</b>	
ROUTE	MILEPOST	STRUCTURE NO.	RUTHRAUFF ROAD T.I.	<b>OF</b>	
TRACS NO. H8480 OIC					



DATE- LOCATION- REVISIONS- FINISHED PLANS- SURVEY NO. DATE- LOCATION- REVISIONS- FINISHED PLANS- SURVEY NO.



F.H.W.A. REGION	STATE	PROJECT NO.	SHEET NO.	TOTAL SHEETS	RECORD DRAWING
9	ARIZ.	010-D(213)S	650	849	

010 PM 252

**SCE BORING LOG: RUB-01 (1 of 2)**

5214+54, 124 Rt. (Ref. Al. I-10 CL)  
 NORTHING: 472,052 EASTING: 973,992  
 ELEV.: 2,241.2 TOTAL DEPTH: 130.2

CONTRACTOR: GSI  
 DRILLER: C. Fiesler  
 INSPECTOR: JDG  
 RIG TYPE: Truck mt. CME 75  
 DRILLING METHOD: 8" OD HSA  
 HAMMER TYPE: Auto Hammer  
 SCE PROJECT #: J2009-14/J2012-07

STARTED: 04/07/2010 09:00 AM  
 FINISHED: 04/07/2010 03:30 PM

DEPTH (FT)	ELEV. (FT)	GRAPHIC	SAMPLE			SAMPLER TYPES	Type	Symbol	Description	I.D.	O.D.	Length
			TYPE	SYMBOL	BLOWS							
								VISUAL SOIL IDENTIFICATION / DESCRIPTION AND REMARKS				
2240								FAT CLAY WITH SAND (native), very stiff, dry to moist, brown, high plasticity CLAY, little fine to coarse sand, no cementation, no reaction with HCl. (CH)				
5	2235		S	⊗	3-7-11			POORLY-GRADED SAND WITH SILT, medium dense, dry, brown, fine to medium SAND, few low plasticity fines, no cementation, no reaction with HCl. (SP-SM)				
10	2230		S	⊗	4-7-9			WELL-GRADED SAND WITH SILT AND GRAVEL, dense, dry, brown, fine to coarse SAND, little fine gravel, few nonplastic fines, no cementation, no reaction with HCl, max. particle size 0.75". (SW-SM)				
15	2225		S	⊗	7-15-17			2" gravel in cuttings. Becomes medium dense. No recovery.				
20	2220		S	⊗	7-9-7			POORLY-GRADED GRAVEL WITH SAND, very dense, dry, brown, fine to coarse GRAVEL, some fine to coarse sand, trace nonplastic fines, no cementation, no reaction with HCl, max. particle size 1". (GP)				
25	2215		S	⊗	17-25-48			Cobbles present at 28' based on drilling.				
30	2210		S	⊗	11-23-50/3							
35	2205		S	⊗	30-50/4							
40	2200		S	⊗	50/5			Becomes max. particle size 4" based on cuttings.				
45	2195		S	⊗	17-47-40			WELL-GRADED SAND WITH SILT AND GRAVEL, very dense, dry, light brown, fine to coarse SAND, little fine gravel, few low plasticity fines, no cementation, no reaction with HCl, max. particle size 1". (SW-SM)				
50	2190		S	⊗	27-40-42			Becomes few low to medium plasticity fines.				
55	2185		S	⊗	15-17-19			POORLY-GRADED GRAVEL WITH CLAY AND SAND, dense, dry to moist, brown, fine to coarse GRAVEL, some fine to coarse sand, few high plasticity fines, no cementation, no reaction with HCl, max. particle size 1". (GP-GC) Occasional cobbles, based on drilling.				
60	2180		S	⊗	12-17-18			CLAYEY SAND WITH GRAVEL, dense, dry to moist, brown, fine to coarse SAND, little low plasticity fines, little fine gravel, no cementation, no reaction with HCl, max. particle size 2.5". (SC)				
65	2175		S	⊗	11-14-29			No cobbles noted.				
70												

**SCE BORING LOG: RUB-01 (2 of 2)**

5214+54, 124 Rt. (Ref. Al. I-10 CL)  
 NORTHING: 472,052 EASTING: 973,992  
 ELEV.: 2,241.2 TOTAL DEPTH: 130.2


CONTRACTOR: GSI  
 DRILLER: C. Fiesler  
 INSPECTOR: JDG  
 RIG TYPE: Truck mt. CME 75  
 DRILLING METHOD: 8" OD HSA  
 HAMMER TYPE: Auto Hammer  
 SCE PROJECT #: J2009-14/J2012-07

STARTED: 04/07/2010 09:00 AM  
 FINISHED: 04/07/2010 03:30 PM

DEPTH (FT)	ELEV. (FT)	GRAPHIC	SAMPLE			SAMPLER TYPES	Type	Symbol	Description	I.D.	O.D.	Length
			TYPE	SYMBOL	BLOWS							
								VISUAL SOIL IDENTIFICATION / DESCRIPTION AND REMARKS				
75	2170		S	⊗	17-24-18							
80	2165		S	⊗	15-17-20							
85	2160		S	⊗	24-31-28			Becomes very dense, some fine gravel, max. particle size 0.75".				
90	2155		S	⊗	22-32-28							
95	2150		S	⊗	17-20-35			Becomes little medium plasticity fines.				
100	2145		S	⊗	26-32-40							
105	2140		S	⊗	22-24-24			Becomes dense.				
110	2135		S	⊗	40-37-50/5			Becomes very dense, weak cementation, weak reaction with HCl.				
115	2130		S	⊗	50/5			Becomes some fine to coarse gravel, max. particle size 1".				
120	2125		S	⊗	27-50/5							
125	2120		S	⊗	50/4							
130	2115		S	⊗	44-50/5							
135	2110		S	⊗	50/2			No recovery. Rock in sampler tip. End of boring at 130'. Sampler stopped at 130.2'. No groundwater encountered. Backfilled with cuttings to 20'. Grout to surface.				
140	2105											

**BORING PLAN**

SCALE 1:100

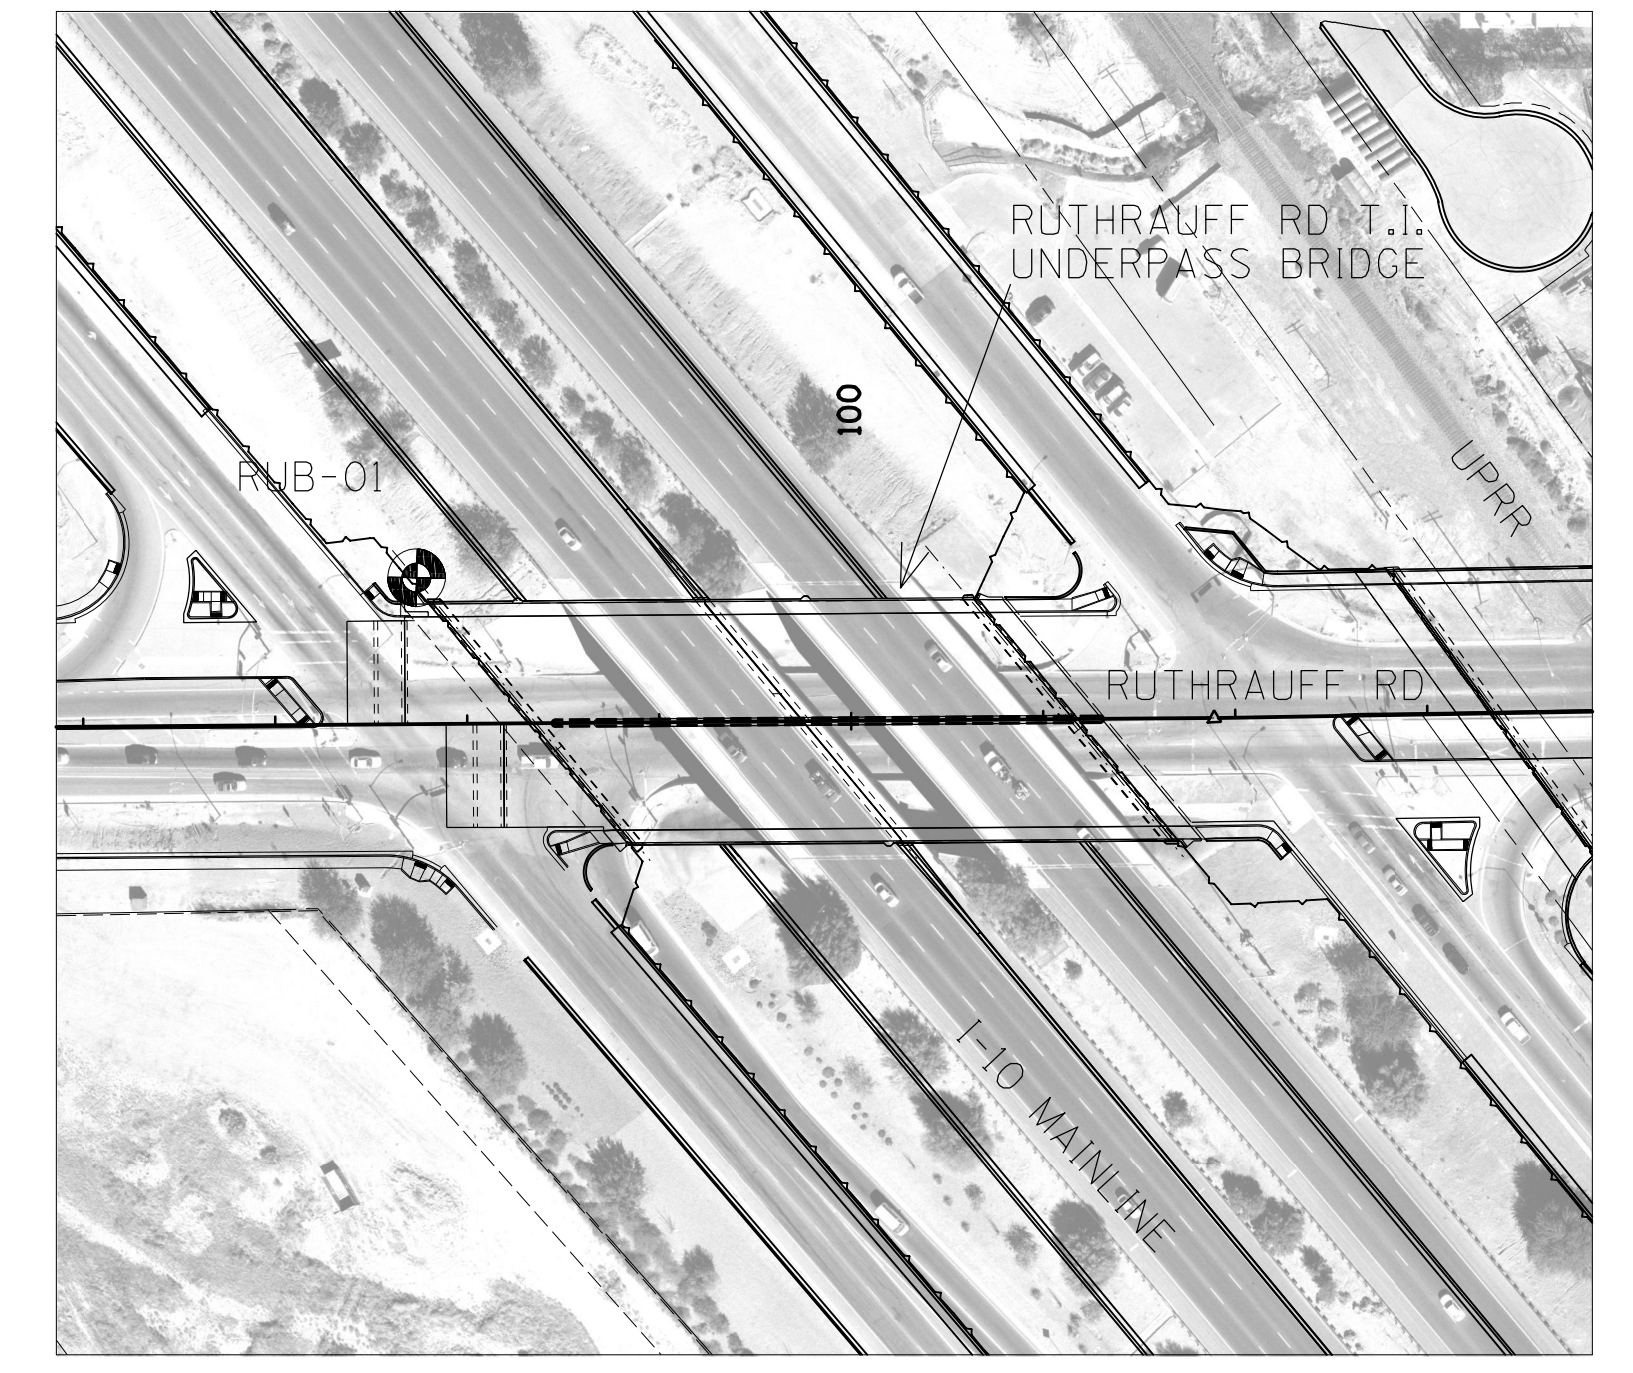

- PHASE 1 BORING LOCATION
- PHASE 2 BORING LOCATION

DESIGN	JBH	3-19	<b>ARIZONA DEPARTMENT OF TRANSPORTATION</b> <b>INFRASTRUCTURE DELIVERY AND OPERATIONS DIVISION</b> <b>BRIDGE GROUP</b>  STA 99+ <b>RUTHRAUFF ROAD T.I. UNDERPASS</b> <b>FOUNDATION DATA (2 OF 7)</b>	
DRAWN	JBH	3-19		
CHECKED	KW	3-19		
<b>SCE ENGINEERING</b> 510 E. 4TH STREET TUCSON, AZ 85705 520-405-1353		LOCATION <b>RUTHRAUFF ROAD T.I.</b>	DWG NO.	S-1.37
I-10 ROUTE 252.00 MILEPOST 20159 STRUCTURE NO.		<b>TRACS NO. H8480 OIC</b>		<b>010-D(213)S</b> OF





SURVEY NO. FINISHED PLANS DATE REVISIONS LOCATION DATE

**SCE BORING LOG: RUB-02 (1 of 2)**  
 5216+50, 126 Rt. (Ref. Al. I-10 CL)  
 NORTHING: 471,901 EASTING: 974,118  
 ELEV.: 2,239.2 TOTAL DEPTH: 131.5  
 STARTED: 04/14/2010 12:45 PM  
 FINISHED: 04/15/2010 03:30 PM

CONTRACTOR: GSI  
 DRILLER: C. Fiesler  
 INSPECTOR: JDG  
 RIG TYPE: Truck mt. CME 75  
 DRILLING METHOD: 8" OD HSA  
 HAMMER TYPE: Auto Hammer  
 SCE PROJECT #: J2009-14/J2012-07

DEPTH (FT)	ELEV. (FT)	GRAPHIC	SAMPLE			SAMPLER TYPES	Type	Symbol	Description	I.D.	O.D.	Length	VISUAL SOIL IDENTIFICATION / DESCRIPTION AND REMARKS
			TYPE	SYMBOL	BLOWS								
			S	⊗		S	⊗	Split Spoon	1.375"	2"	18"	CLAYEY SAND (native), loose, dry to moist, brown, fine SAND, some medium plasticity fines, no cementation, no reaction with HCl. (SC)	
			R	■		R	■	Ring Sampler	2.5"	3"	18"		
			U	□		U	□	Shelby Tube					
5	2235		S	⊗	3-4-6							POORLY-GRADED SAND WITH SILT, loose, dry, brown, fine to medium SAND, few nonplastic fines, trace fine gravel, no cementation, no reaction with HCl, max. particle size 0.25". (SP-SM)	
10	2230		S	⊗	2-2-6			Becomes dry to moist.					
15	2225		S	⊗	3-6-8			Becomes medium dense with some 1" layers of silty sand.					
20	2220		S	⊗	11-13-16			WELL-GRADED SAND WITH SILT AND GRAVEL, medium dense, dry, brown, fine to coarse SAND, little fine to coarse gravel, few nonplastic fines, no cementation, no reaction with HCl, max. particle size 1.25". (SW-SM) Occasional cobbles based on drilling.					
25	2215		S	⊗	10-18-26			Becomes dense, recovered crushed rock in sampler tip. Slow auger advance.					
30	2210		S	⊗	36-50/3			Becomes very dense.					
35	2205		S	⊗	23-50/5								
40	2200		S	⊗	30-28-25			Cobbles present, slow auger advance.					
45	2195		S	⊗	20-37-50/5			No cobbles noted at 47'.					
50	2190		S	⊗	15-14-25			Becomes dense, increasing fines.					
55	2185		S	⊗	14-16-21			CLAYEY SAND WITH GRAVEL, dense, dry, brown, fine to coarse SAND, little medium plasticity fines, little fine to coarse gravel, no cementation, no reaction with HCl, max. particle size 1". (SC) 2.5" gravel present in cuttings.					
60	2180		S	⊗	9-14-20								
65	2175		S	⊗	18-14-14			Becomes medium dense, moist.					
70	2170												

**SCE BORING LOG: RUB-02 (2 of 2)**  
 5216+50, 126 Rt. (Ref. Al. I-10 CL)  
 NORTHING: 471,901 EASTING: 974,118  
 ELEV.: 2,239.2 TOTAL DEPTH: 131.5  
 STARTED: 04/14/2010 12:45 PM  
 FINISHED: 04/15/2010 03:30 PM

CONTRACTOR: GSI  
 DRILLER: C. Fiesler  
 INSPECTOR: JDG  
 RIG TYPE: Truck mt. CME 75  
 DRILLING METHOD: 8" OD HSA  
 HAMMER TYPE: Auto Hammer  
 SCE PROJECT #: J2009-14/J2012-07


DEPTH (FT)	ELEV. (FT)	GRAPHIC	SAMPLE			SAMPLER TYPES	Type	Symbol	Description	I.D.	O.D.	Length	VISUAL SOIL IDENTIFICATION / DESCRIPTION AND REMARKS
			TYPE	SYMBOL	BLOWS								
			S	⊗	9-26-35			Becomes very dense, dry with decreasing fines.					
75	2165		S	⊗	19-22-17			Becomes dense, some fine to coarse gravel, little low plasticity fines.					
80	2160		S	⊗	34-32-50/5			Becomes very dense.					
85	2155		S	⊗	13-12-24			Becomes dense, some low plasticity fines.					
90	2150		S	⊗	29-35-42			Becomes very dense, some fine gravel, little low plasticity fines, max. particle size 0.75".					
95	2145		S	⊗	24-40-40								
100	2140		S	⊗	30-37-49								
105	2135		S	⊗	21-38-41								
110	2130		S	⊗	28-50/6								
115	2125		S	⊗	30-50/6								
120	2120		S	⊗	50/4								
125	2115		S	⊗	50/5			Becomes dry to moist.					
130	2110		S	⊗	30-30-49			Becomes max. particle size 1".					
135	2105							End of boring at 130'. Sampler stopped at 131.5'. No groundwater encountered. Backfilled with cuttings to 20'. Grout to surface.					
140	2100												

F.H.W.A. REGION	STATE	PROJECT NO.	SHEET NO.	TOTAL SHEETS	RECORD DRAWING
9	ARIZ.	010-D(213)S	651	849	

010 PM 252

**BORING PLAN**

SCALE 1:100

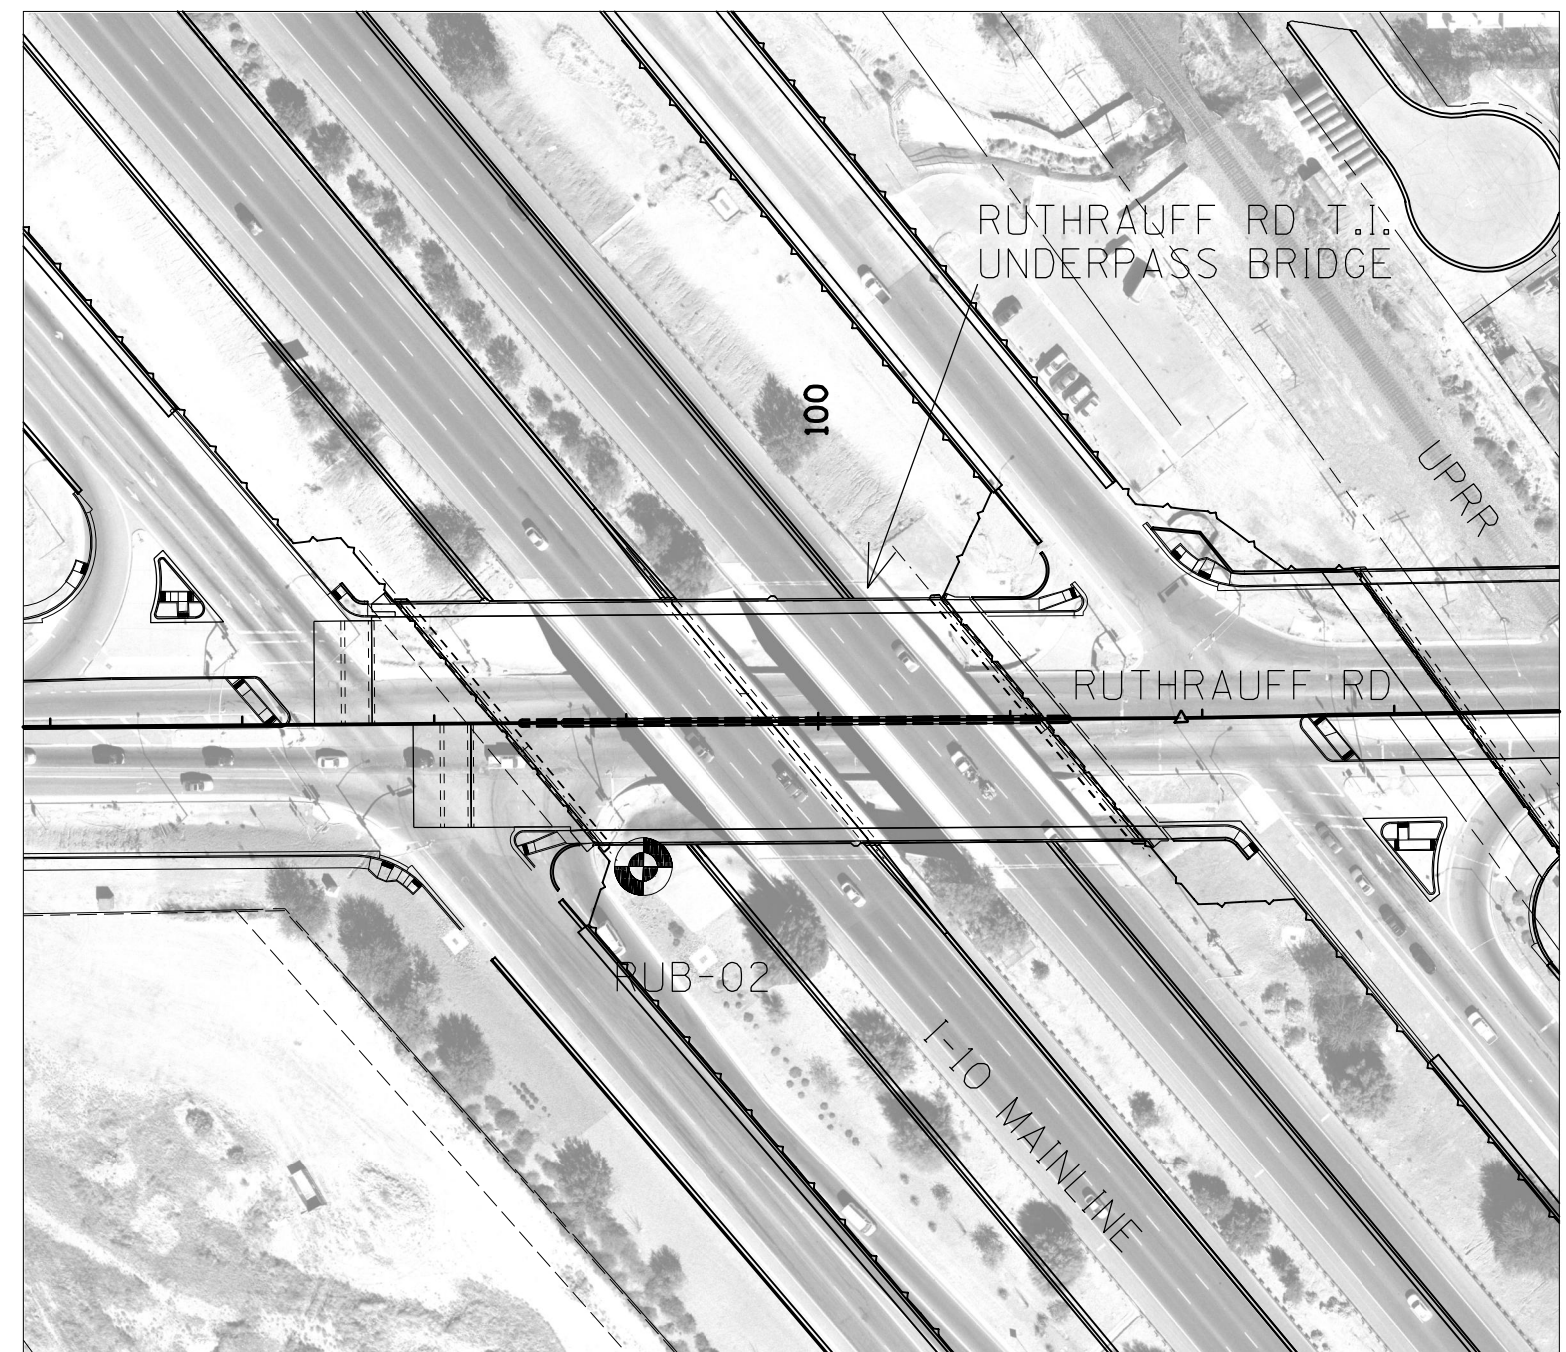

- PHASE 1 BORING LOCATION
- PHASE 2 BORING LOCATION

DESIGN	JBH	DATE	3-19	<b>ARIZONA DEPARTMENT OF TRANSPORTATION</b> <b>INFRASTRUCTURE DELIVERY AND OPERATIONS DIVISION</b> <b>BRIDGE GROUP</b>  STA 99+ <b>RUTHRAUFF ROAD T.I. UNDERPASS</b> <b>FOUNDATION DATA (3 OF 7)</b>	
DRAWN	JBH	3-19			
CHECKED	KW	3-19			
<b>SCE ENGINEERING</b>		510 E. 4TH STREET TUCSON, AZ 85705 520-405-1353		LOCATION	RUTHRAUFF ROAD T.I.
I-10	252.00	20159	ROUTE MILEPOST STRUCTURE NO.	DWG NO.	S-1.38
TRACS NO. H8480 01C				010-D(213)S	





DATE: LOCATION: REVISIONS: FINISHED PLANS: SURVEY NO. DATE: LOCATION: REVISIONS: FINISHED PLANS: SURVEY NO.

**SCE BORING LOG: RUB-03 (1 of 2)**  
 5215+48, 19 Lt. (Ref. Al. I-10 CL)  
 NORTHING: 472,062 EASTING: 974,147  
 ELEV.: 2,257.3 TOTAL DEPTH: 150.5

CONTRACTOR: GSI  
 DRILLER: C. Fiesler/R. Quezada  
 INSPECTOR: E. Everts  
 RIG TYPE: Truck mt. CME 75/95  
 DRILLING METHOD: 8" OD HSA  
 HAMMER TYPE: Auto Hammer  
 SCE PROJECT #: J2009-14/J2012-07


DEPTH (FT)	ELEV. (FT)	GRAPHIC	SAMPLE			SAMPLER TYPES	Type	Symbol	Description	I.D.	O.D.	Length	VISUAL SOIL IDENTIFICATION / DESCRIPTION AND REMARKS
			TYPE	SYMBOL	BLOWS								
5	2255		R	■	13-18	R	■	CLAYEY SAND WITH GRAVEL (fill), medium dense, dry, brown, fine to coarse SAND, some low plasticity fines, little fine to coarse subrounded to subangular gravel, no cementation, strong reaction with HCl, max. particle size 1.25". (SC)	1.375"	2"	18"		
10	2250		CU	■	17-34	CU	■	SANDY LEAN CLAY (fill), stiff, dry, brown, medium plasticity CLAY, some fine to medium sand, few fine subrounded to subangular gravel, no cementation, strong reaction with HCl, max. particle size 0.75", some calcium carbonates. (CL)	2.5"	3"	18"		
15	2245		R	■	11-19	R	■	CLAYEY SAND (fill), medium dense, dry, brown, fine to coarse SAND, some low plasticity fines, few fine to coarse subrounded to subangular gravel, no cementation, strong reaction with HCl, max. particle size 1.5", some calcium carbonates. (SC)					
20	2240		R	■	10-18	R	■	SILTY SAND (fill), medium dense, dry, brown, fine to medium SAND, some low plasticity fines, little fine to coarse subrounded to subangular gravel, no cementation, strong reaction with HCl, max. particle size 1.5", some calcium carbonates. (SM)					
25	2235		R	■	8-10	R	■	SILTY SAND (native), medium dense, dry, light brown, fine to medium SAND, little nonplastic fines, trace fine subrounded to subangular gravel, no cementation, strong reaction with HCl, max. particle size 0.5". (SM)					
30	2230		R	■	8-10	R	■	Becomes loose, fine SAND, no reaction with HCl, max. particle size 0.25".					
35	2225		S	⊗	4-12-13	S	⊗	Becomes medium dense, fine to medium SAND, few fine to coarse subrounded to subangular gravel, max. particle size 1.25".					
40	2220		S	⊗	8-11-11	S	⊗	No recovery.					
45	2215		S	⊗	20-24-13	S	⊗	Becomes SILTY SAND WITH GRAVEL, dense, little fine to coarse subrounded to subangular gravel, max. particle size 1.5".					
50	2210		S	⊗	26-7-8	S	⊗	Becomes medium dense. No recovery.					
55	2205		S	⊗	6-6-15	S	⊗	POORLY-GRADED GRAVEL WITH CLAY AND SAND, medium dense, wet, brown, fine to coarse subrounded to subangular GRAVEL, some fine to coarse sand, few medium plasticity fines, no cementation, no reaction with HCl, max. particle size 1.5". (GP-GC)					
60	2200		R	■	50/4	R	■	Becomes very dense, moist.					
65	2195		S	⊗	32-50/4	S	⊗	Noted 2" gravel in cuttings.					
70	2190		S	⊗	17-29-37	S	⊗	SILTY, CLAYEY SAND, very dense, moist, brown, fine to medium SAND, little low plasticity fines, few fine subrounded to subangular gravel, no cementation, no reaction with HCl, max. particle size 0.5". (SC-SM)					
75	2185		R	■	50/4	R	■	CLAYEY GRAVEL WITH SAND, very dense, moist, brown, fine to coarse subrounded to subangular GRAVEL, some fine to coarse sand, little low plasticity fines, no cementation, no reaction with HCl, max. particle size 2.5". (GC) Noted 3" gravel in cuttings.					
80	2180		S	⊗	50/2	S	⊗	No recovery.					
								CLAYEY SAND WITH GRAVEL, very dense, moist, brown, fine to					

**SCE BORING LOG: RUB-03 (2 of 2)**  
 5215+48, 19 Lt. (Ref. Al. I-10 CL)  
 NORTHING: 472,062 EASTING: 974,147  
 ELEV.: 2,257.3 TOTAL DEPTH: 150.5

CONTRACTOR: GSI  
 DRILLER: C. Fiesler/R. Quezada  
 INSPECTOR: E. Everts  
 RIG TYPE: Truck mt. CME 75/95  
 DRILLING METHOD: 8" OD HSA  
 HAMMER TYPE: Auto Hammer  
 SCE PROJECT #: J2009-14/J2012-07

DEPTH (FT)	ELEV. (FT)	GRAPHIC	SAMPLE			SAMPLER TYPES	Type	Symbol	Description	I.D.	O.D.	Length	VISUAL SOIL IDENTIFICATION / DESCRIPTION AND REMARKS
			TYPE	SYMBOL	BLOWS								
85	2175		S	⊗	11-22-31	S	⊗	coarse SAND, little fine subrounded to subangular gravel, little medium plasticity fines, no cementation, no reaction with HCl, max. particle size 0.75". (SC)	1.375"	2"	18"		
90	2170		S	⊗	35-27-33	S	⊗						
95	2165		R	■	30-50/5	R	■	Added 5 gallons of water to boring at 90'.					
100	2160		S	⊗	24-15-17	S	⊗	Becomes dense.					
105	2155		S	⊗	29-35-42	S	⊗	Becomes very dense. Added 5 gallons of water to boring at 100'.					
110	2150		S	⊗	20-29-33	S	⊗	Becomes little fine subangular gravel.					
115	2145		R	■	26-50/5	R	■	Added 5 gallons of water to boring at 110'.					
120	2140		S	⊗	27-36-31	S	⊗	Becomes some fine subangular gravel.					
125	2135		S	⊗	28-33-39	S	⊗	Becomes some fine to coarse subangular gravel, max. particle size 1.5". Added 5 gallons of water to boring at 120'.					
130	2130		S	⊗	24-32-38	S	⊗	Added 5 gallons of water to boring at 125'.					
135	2125		R	■	50/2	R	■	Becomes little fine subangular gravel, max. particle size 0.75". Added 5 gallons of water to boring at 130'.					
140	2120		S	⊗	28-38-50/5	S	⊗	Becomes max. particle size 0.5". Added 10 gallons of water to boring at 135'.					
145	2115		S	⊗	30-50/5	S	⊗	Added 5 gallons of water to boring at 140'.					
150	2110		S	⊗	37-50/4	S	⊗	Added 5 gallons of water to boring at 145'.					
155	2105		R	■	50/6	R	■	Becomes little fine to coarse subangular gravel, max. particle size 1". End of boring at 150'. Stopped sampler at 150.5'. No groundwater encountered. Backfilled with portland cement and sand mixture.					
160	2100												

**BORING PLAN**  
 SCALE 1:100

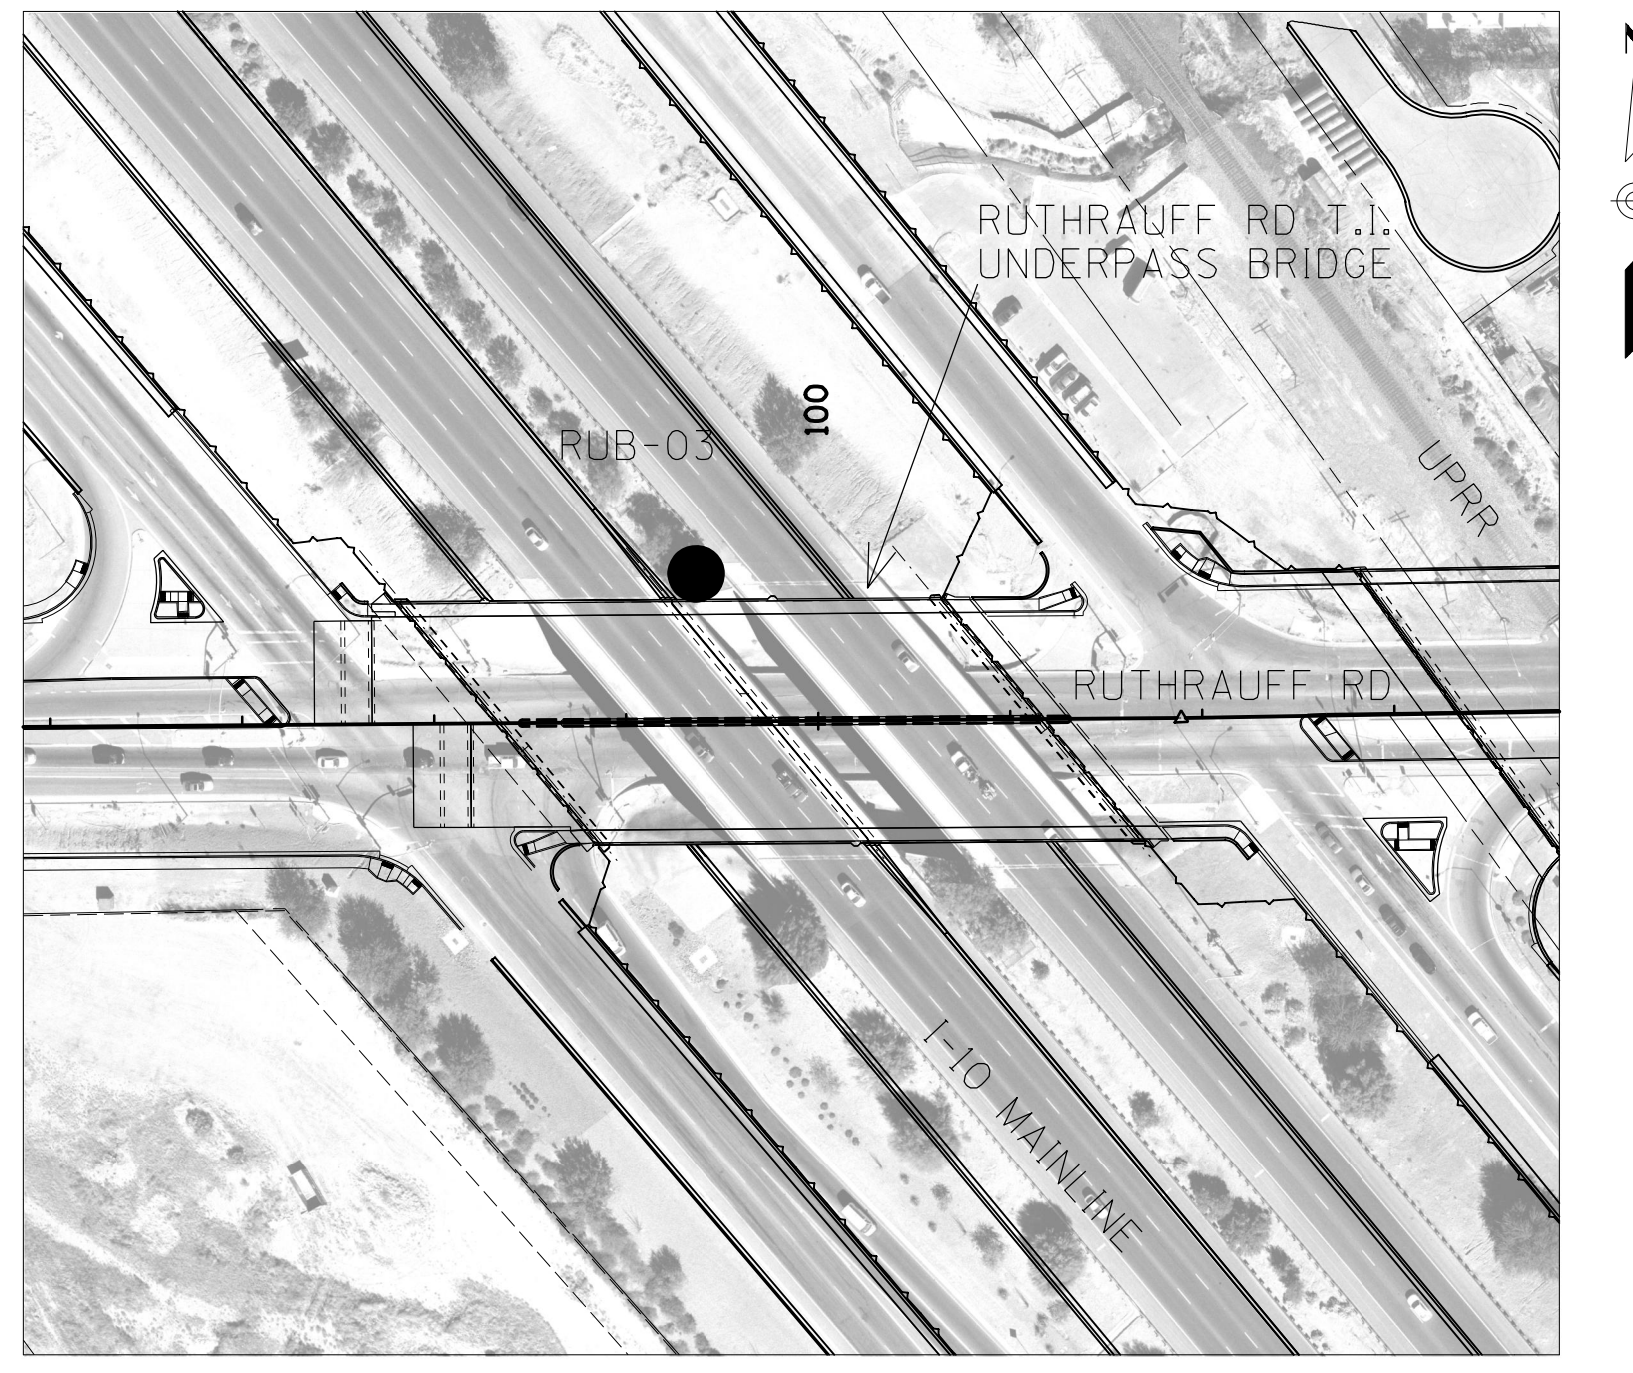

- PHASE 1 BORING LOCATION
- PHASE 2 BORING LOCATION

DESIGN	JBH	3-19	<b>ARIZONA DEPARTMENT OF TRANSPORTATION</b> <b>INFRASTRUCTURE DELIVERY AND OPERATIONS DIVISION</b> <b>BRIDGE GROUP</b>  STA 99+ RUTHRAUFF ROAD T.I. UNDERPASS FOUNDATION DATA (4 OF 7)	
DRAWN	JBH	3-19		
CHECKED	KW	3-19		
<b>SCE ENGINEERING</b> 510 E. 4TH STREET TUCSON, AZ 85705 520-405-1353		LOCATION RUTHRAUFF ROAD T.I.	DWG NO. S-1.39	
I-10 ROUTE 252.00 MILEPOST 20159 STRUCTURE NO.	TRACS NO. H8480 OIC		O10-D(213)S	OF





F.H.W.A. REGION	STATE	PROJECT NO.	SHEET NO.	TOTAL SHEETS	RECORD DRAWING
9	ARIZ.	010-D(213)S	653	849	

010 PM 252

**SCE BORING LOG: RUB-04 (1 of 2)**

5217+75, 17 Lt. (Ref. Al. I-10 CL)  
 NORTHING: 471,887 EASTING: 974,291  
 ELEV.: 2,257.1 TOTAL DEPTH: 150.6

CONTRACTOR: GSI  
 DRILLER: C. Fiesler  
 INSPECTOR: E. Everts  
 RIG TYPE: Truck mt. CME 75  
 DRILLING METHOD: 8" OD HSA  
 HAMMER TYPE: Auto Hammer  
 SCE PROJECT #: J2009-14/J2012-07

STARTED: 08/19/2013 09:00 AM  
 FINISHED: 08/20/2013 10:30 AM

DEPTH (FT)	ELEV. (FT)	GRAPHIC	SAMPLE			SAMPLER TYPES	Type	Symbol	Description	I.D.	O.D.	Length	VISUAL SOIL IDENTIFICATION / DESCRIPTION AND REMARKS
			TYPE	SYMBOL	BLOWS								
5	2255		R	█	10-14	S	⊗	Split Spoon	1.375"	2"	18"	CLAYEY SAND (fill), medium dense, dry, brown, fine to medium SAND, some low plasticity fines, trace fine to coarse subrounded to subangular gravel, no cementation, strong reaction with HCl, max. particle size 1". (SC)	
10	2250		CU	█	12-37	R	█	Ring Sampler	2.5"	3"	18"	SANDY LEAN CLAY (fill), very stiff, dry, brown, medium plasticity CLAY, some fine to coarse sand, few fine to coarse subrounded to subangular gravel, no cementation, strong reaction with HCl, max. particle size 1". (CL)	
15	2245		R	█	13-13	R	█	Ring Sampler	2.5"	3"	18"	Becomes stiff, some fine to medium sand, trace fine subrounded to subangular gravel, max. particle size 0.5", some calcium carbonates.	
20	2240		R	█	7-10	R	█	Ring Sampler	2.5"	3"	18"	SILTY SAND (native), loose, dry, brown, fine SAND, some nonplastic fines, no cementation, strong reaction with HCl. (SM)	
25	2235		R	█	6-16	R	█	Ring Sampler	2.5"	3"	18"	SILTY, CLAYEY SAND, loose, dry, brown, fine to medium SAND, some low plasticity fines, no cementation, no reaction with HCl. (SC-SM)	
30	2230		S	⊗	7-10-12	S	⊗	Split Spoon	1.375"	2"	18"	SILTY SAND WITH GRAVEL, medium dense, dry, brown, fine to coarse SAND, little fine subrounded to subangular gravel, little nonplastic fines, no cementation, no reaction with HCl, max. particle size 0.75". (SM)	
35	2225		S	⊗	10-14-11	S	⊗	Split Spoon	1.375"	2"	18"	Becomes dense.	
40	2220		S	⊗	6-17-24	S	⊗	Split Spoon	1.375"	2"	18"	Becomes dense.	
45	2215		S	⊗	4-5-5	S	⊗	Split Spoon	1.375"	2"	18"	Becomes SILTY SAND, loose, moist, yellow-brown, fine SAND, trace fine to coarse subrounded to subangular gravel, max. particle size 1".	
50	2210		S	⊗	50/4	S	⊗	Split Spoon	1.375"	2"	18"	SILTY GRAVEL WITH SAND, very dense, dry, brown, fine to coarse subrounded to subangular GRAVEL, some fine to coarse sand, little nonplastic fines, no cementation, no reaction with HCl, max. particle size 1.5". (GM) Noted 4" cobbles in cuttings.	
55	2205		R	█	50/5	R	█	Ring Sampler	2.5"	3"	18"	POORLY-GRADED GRAVEL WITH CLAY AND SAND, very dense, dry, brown, fine to coarse subrounded to subangular GRAVEL, some fine to coarse sand, few low plasticity fines, no cementation, no reaction with HCl, max. particle size 1.5". (GP-GC) Noted 4" cobbles in cuttings.	
60	2200		S	⊗	37-24-38	S	⊗	Split Spoon	1.375"	2"	18"	Becomes max. particle size 1.5". Added 5 gallons of water to boring at 135'.	
65	2195		R	█	28-50/2	R	█	Ring Sampler	2.5"	3"	18"	Added 5 gallons of water to boring at 140'.	
70	2190		S	⊗	9-17-15	S	⊗	Split Spoon	1.375"	2"	18"	Added 5 gallons of water to boring at 145'.	
75	2185		S	⊗	15-9-20	S	⊗	Split Spoon	1.375"	2"	18"	SILTY SAND, dense, dry, light brown, fine to coarse SAND, little nonplastic fines, no cementation, no reaction with HCl. (SM)	
80	2180		S	⊗		S	⊗	Split Spoon	1.375"	2"	18"	CLAYEY SAND WITH GRAVEL, medium dense, moist, brown, fine to coarse SAND, some fine to coarse subangular gravel, little medium plasticity fines, no cementation, no reaction with HCl, max. particle size 1". (SC)	

**SCE BORING LOG: RUB-04 (2 of 2)**

5217+75, 17 Lt. (Ref. Al. I-10 CL)  
 NORTHING: 471,887 EASTING: 974,291  
 ELEV.: 2,257.1 TOTAL DEPTH: 150.6


CONTRACTOR: GSI  
 DRILLER: C. Fiesler  
 INSPECTOR: E. Everts  
 RIG TYPE: Truck mt. CME 75  
 DRILLING METHOD: 8" OD HSA  
 HAMMER TYPE: Auto Hammer  
 SCE PROJECT #: J2009-14/J2012-07

STARTED: 08/19/2013 09:00 AM  
 FINISHED: 08/20/2013 10:30 AM

DEPTH (FT)	ELEV. (FT)	GRAPHIC	SAMPLE			SAMPLER TYPES	Type	Symbol	Description	I.D.	O.D.	Length	VISUAL SOIL IDENTIFICATION / DESCRIPTION AND REMARKS
			TYPE	SYMBOL	BLOWS								
85	2175		S	⊗	11-13-22	S	⊗	Split Spoon	1.375"	2"	18"	Becomes dense.	
90	2170		S	⊗	13-21-22	S	⊗	Split Spoon	1.375"	2"	18"	Becomes very dense.	
95	2165		S	⊗	9-27-26	S	⊗	Split Spoon	1.375"	2"	18"	Becomes little fine subangular gravel, max. particle size 0.5".	
100	2160		S	⊗	13-20-34	S	⊗	Split Spoon	1.375"	2"	18"	Added 5 gallons of water to boring at 100'.	
105	2155		S	⊗	24-33-34	S	⊗	Split Spoon	1.375"	2"	18"	Becomes dense. Added 5 gallons of water to boring at 105'.	
110	2150		S	⊗	13-23-24	S	⊗	Split Spoon	1.375"	2"	18"	Becomes very dense. Added 5 gallons of water to boring at 110'.	
115	2145		S	⊗	15-21-36	S	⊗	Split Spoon	1.375"	2"	18"	Added 5 gallons of water to boring at 115'.	
120	2140		S	⊗	30-41-45	S	⊗	Split Spoon	1.375"	2"	18"	Becomes some fine subangular gravel, max. particle size 0.75". Added 5 gallons of water to boring at 120'.	
125	2135		S	⊗	18-32-50	S	⊗	Split Spoon	1.375"	2"	18"	Added 5 gallons of water to boring at 125'.	
130	2130		S	⊗	40-50/3	S	⊗	Split Spoon	1.375"	2"	18"	Becomes dry, some fine to coarse subangular gravel, max. particle size 1". Added 5 gallons of water to boring at 130'.	
135	2125		S	⊗	31-50/4	S	⊗	Split Spoon	1.375"	2"	18"	Becomes max. particle size 1.5". Added 5 gallons of water to boring at 135'.	
140	2120		S	⊗	50/5	S	⊗	Split Spoon	1.375"	2"	18"	Added 5 gallons of water to boring at 140'.	
145	2115		R	█	40-50/2	R	█	Ring Sampler	2.5"	3"	18"	Added 5 gallons of water to boring at 145'.	
150	2110		S	⊗	37-50/6	S	⊗	Split Spoon	1.375"	2"	18"	End of boring at 150'. Stopped sampler at 150.6'. No groundwater encountered. Backfilled with portland cement and sand mixture.	
155	2105		S	⊗	41-50/1	S	⊗	Split Spoon	1.375"	2"	18"		

**BORING PLAN**

SCALE 1:100

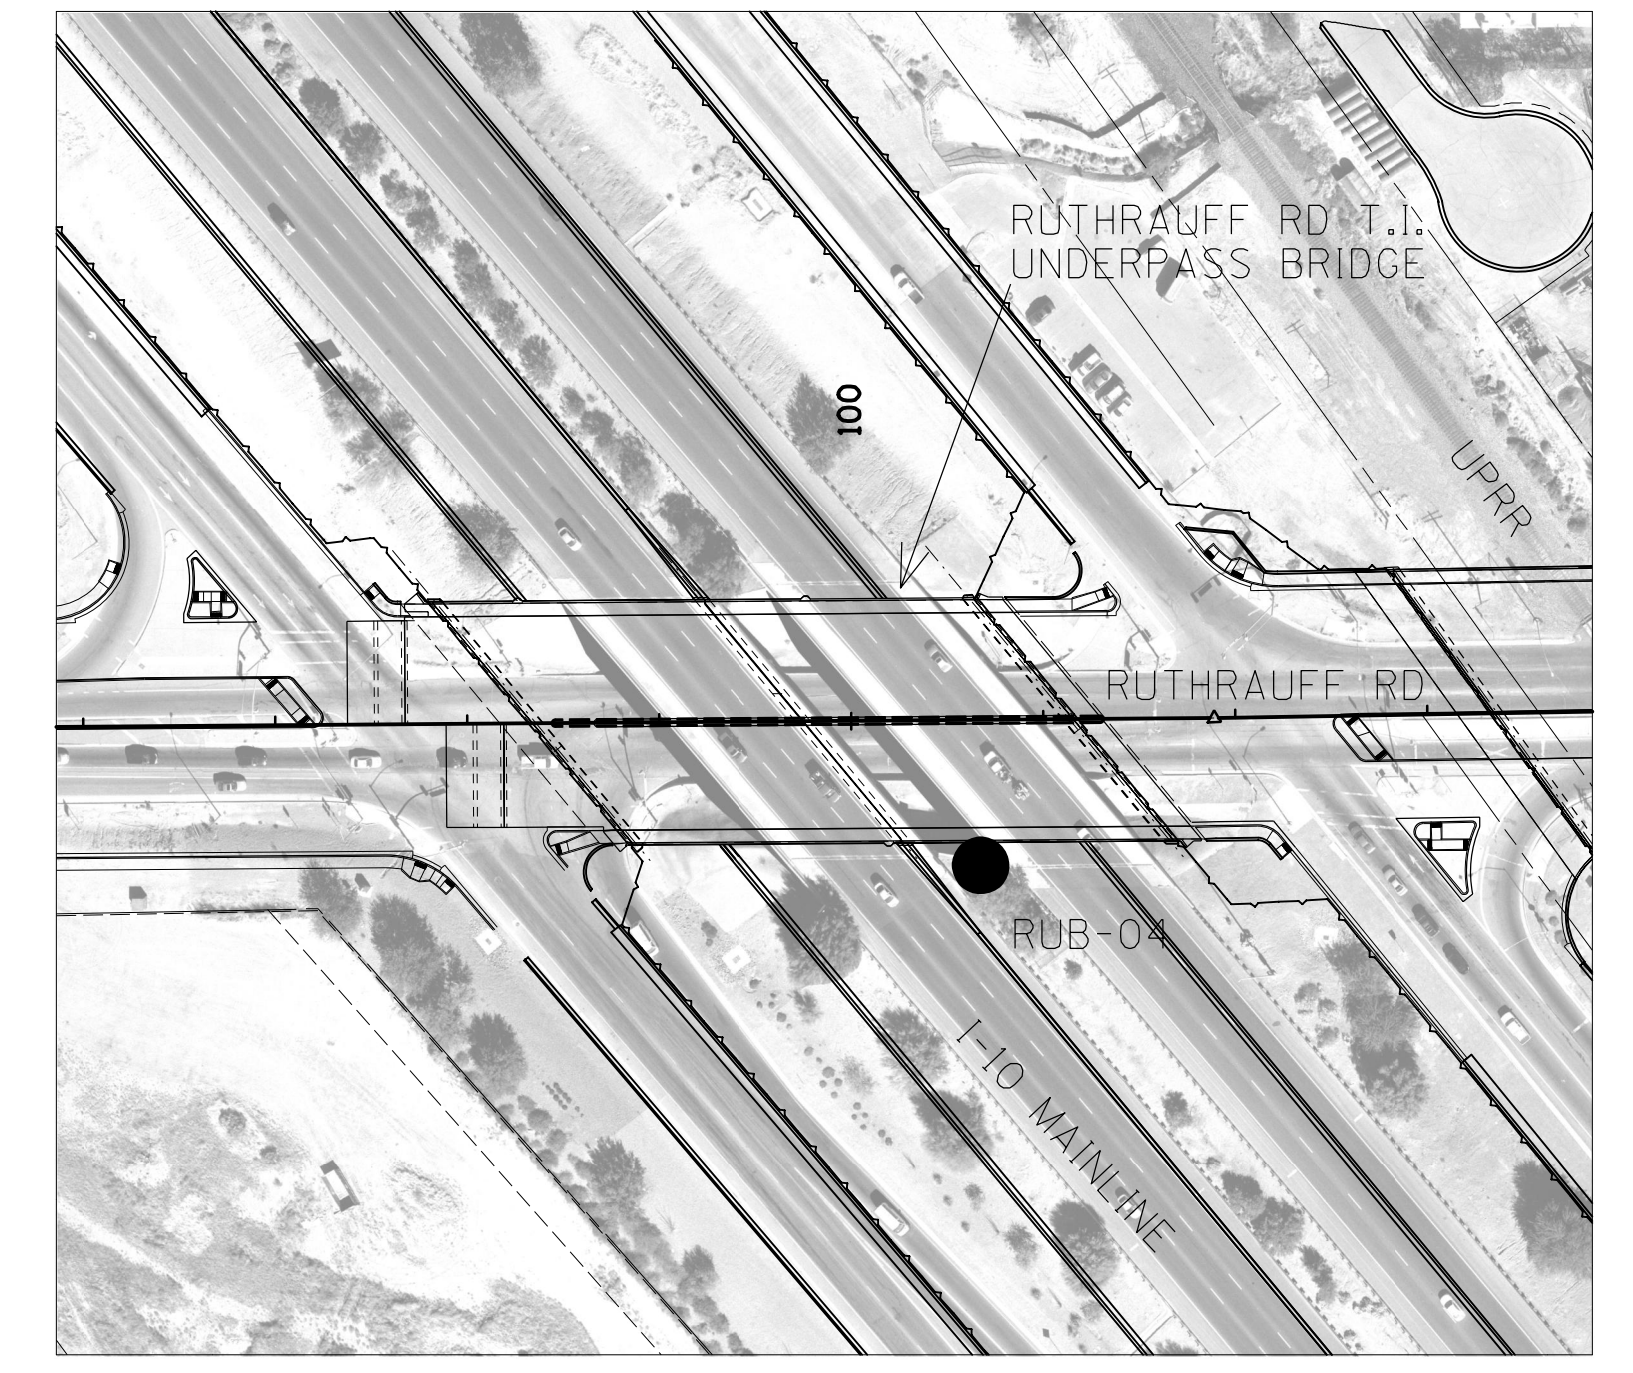

- PHASE 1 BORING LOCATION
- PHASE 2 BORING LOCATION

DESIGN	JBH	DATE	3-19	<b>ARIZONA DEPARTMENT OF TRANSPORTATION</b> <b>INFRASTRUCTURE DELIVERY AND OPERATIONS DIVISION</b> <b>BRIDGE GROUP</b>  STA 99+ RUTHRAUFF ROAD T.I. UNDERPASS FOUNDATION DATA (5 OF 7)	
DRAWN	JBH	3-19			
CHECKED	KW	3-19			
<b>SCE ENGINEERING</b> 510 E. 4TH STREET TUCSON, AZ 85705 520-405-1353		LOCATION RUTHRAUFF ROAD T.I.		DWG NO.	S-140
I-10 ROUTE 252.00 MILEPOST 20159 STRUCTURE NO.		TRACS NO. H8480 OIC		010-D(213)S OF	





F.H.W.A. REGION	STATE	PROJECT NO.	SHEET NO.	TOTAL SHEETS	RECORD DRAWING
9	ARIZ.	010-D(213)S	654	849	

010 PM 252

**SCE BORING LOG: RUB-05 (1 of 2)**

5216+73, 128 Lt. (Ref. Al. I-10 CL)  
 NORTHING: 472,049 EASTING: 974,326  
 ELEV.: 2,241.5 TOTAL DEPTH: 131.4

CONTRACTOR: GSI  
 DRILLER: C. Fiesler  
 INSPECTOR: JDG  
 RIG TYPE: Truck mt. CME 75  
 DRILLING METHOD: 8" OD HSA  
 HAMMER TYPE: Auto Hammer  
 SCE PROJECT #: J2009-14/J2012-07

STARTED: 04/08/2010 10:40 AM  
 FINISHED: 04/09/2010 11:00 AM

DEPTH (FT)	ELEV. (FT)	GRAPHIC	SAMPLE			SAMPLER TYPES	Type	Symbol	Description	I.D.	O.D.	Length	VISUAL SOIL IDENTIFICATION / DESCRIPTION AND REMARKS
			TYPE	SYMBOL	BLOWS								
	2240											POORLY-GRADED SAND (native), loose, dry, brown, fine to medium SAND, no cementation, no reaction with HCl. (SP)	
5	2235		S	⊗	4-3-4								
10	2230		S	⊗	3-5-6			Becomes medium dense, trace fine gravel, max. particle size 0.75".					
15	2225		S	⊗	3-6-7			Becomes dry to moist, trace nonplastic fines.					
20	2220		S	⊗	5-6-9			Occasional cobbles present based on drilling at 22'.					
25	2215		S	⊗	5-9-17			No recovery.					
30	2210		S	⊗	50/2			WELL-GRADED SAND WITH SILT AND GRAVEL, very dense, dry to moist, brown, fine to coarse SAND, some fine gravel, few nonplastic fines, no cementation, no reaction with HCl, max. particle size 1". (SW-SM) No recovery. Increasing cobbles present with depth.					
35	2205		S	⊗	23-42-38			Slow auger advance. Cobbles present.					
40	2200		S	⊗	26-50/5								
45	2195		S	⊗	13-19-26			CLAYEY SAND WITH GRAVEL, dense, moist, brown, fine to coarse SAND, some medium plasticity fines, little fine gravel, no cementation, no reaction with HCl, max. particle size 0.5". (SC)					
50	2190		S	⊗	18-17-24			Pulled auger stem to retooth. Significant wear on drilling bit.					
55	2185		S	⊗	15-9-25			Reduced cobbles.					
60	2180		S	⊗	18-11-24			SILTY SAND WITH GRAVEL, dense, moist, brown, fine to coarse SAND, some fine gravel, few low plasticity fines, no cementation, no reaction with HCl. (SM) Cobbles no longer present based on drilling.					
65	2175		S	⊗	12-22-26			Becomes dry.					
70								CLAYEY SAND WITH GRAVEL, medium dense, moist, brown, fine to coarse SAND, some medium plasticity fines, little fine gravel, no					

**SCE BORING LOG: RUB-05 (2 of 2)**

5216+73, 128 Lt. (Ref. Al. I-10 CL)  
 NORTHING: 472,049 EASTING: 974,326  
 ELEV.: 2,241.5 TOTAL DEPTH: 131.4


CONTRACTOR: GSI  
 DRILLER: C. Fiesler  
 INSPECTOR: JDG  
 RIG TYPE: Truck mt. CME 75  
 DRILLING METHOD: 8" OD HSA  
 HAMMER TYPE: Auto Hammer  
 SCE PROJECT #: J2009-14/J2012-07



STARTED: 04/08/2010 10:40 AM  
 FINISHED: 04/09/2010 11:00 AM



DEPTH (FT)	ELEV. (FT)	GRAPHIC	SAMPLE			SAMPLER TYPES	Type	Symbol	Description	I.D.	O.D.	Length	VISUAL SOIL IDENTIFICATION / DESCRIPTION AND REMARKS
			TYPE	SYMBOL	BLOWS								
75	2170		S	⊗	4-10-15			cementation, no reaction with HCl. (SC)					
80	2165		S	⊗	19-18-19			Becomes dense.					
85	2160		S	⊗	24-34-34			Becomes very dense.					
90	2155		S	⊗	22-32-26								
95	2150		S	⊗	18-18-28			Becomes dense.					
100	2145		S	⊗	18-29-28			Becomes very dense.					
105	2140		S	⊗	28-38-29			WELL-GRADED SAND WITH CLAY AND GRAVEL, very dense, dry, brown, fine to coarse SAND, some fine gravel, few medium plasticity fines, no cementation, no reaction with HCl, max. particle size 1". (SW-SC)					
110	2135		S	⊗	43-40-48								
115	2130		S	⊗	38-41-49			CLAYEY SAND WITH GRAVEL, very dense, dry, brown, fine to coarse SAND, some medium plasticity fines, little fine gravel, no cementation, no reaction with HCl. (SC)					
120	2125		S	⊗	30-50/5								
125	2120		S	⊗	43-46-48			SILTY, CLAYEY SAND WITH GRAVEL, very dense, dry to moist, brown, fine to coarse SAND, some fine gravel, few low plasticity fines, no cementation, no reaction with HCl, max. particle size 1". (SC-SM)					
130	2115		S	⊗	50/4								
135	2110		S	⊗	30-39-50/5			End of boring at 130'. Sampler stopped at 131.4'. No groundwater encountered. Backfilled with cuttings to 20'. Grout to surface.					
140	2105												

**BORING PLAN**

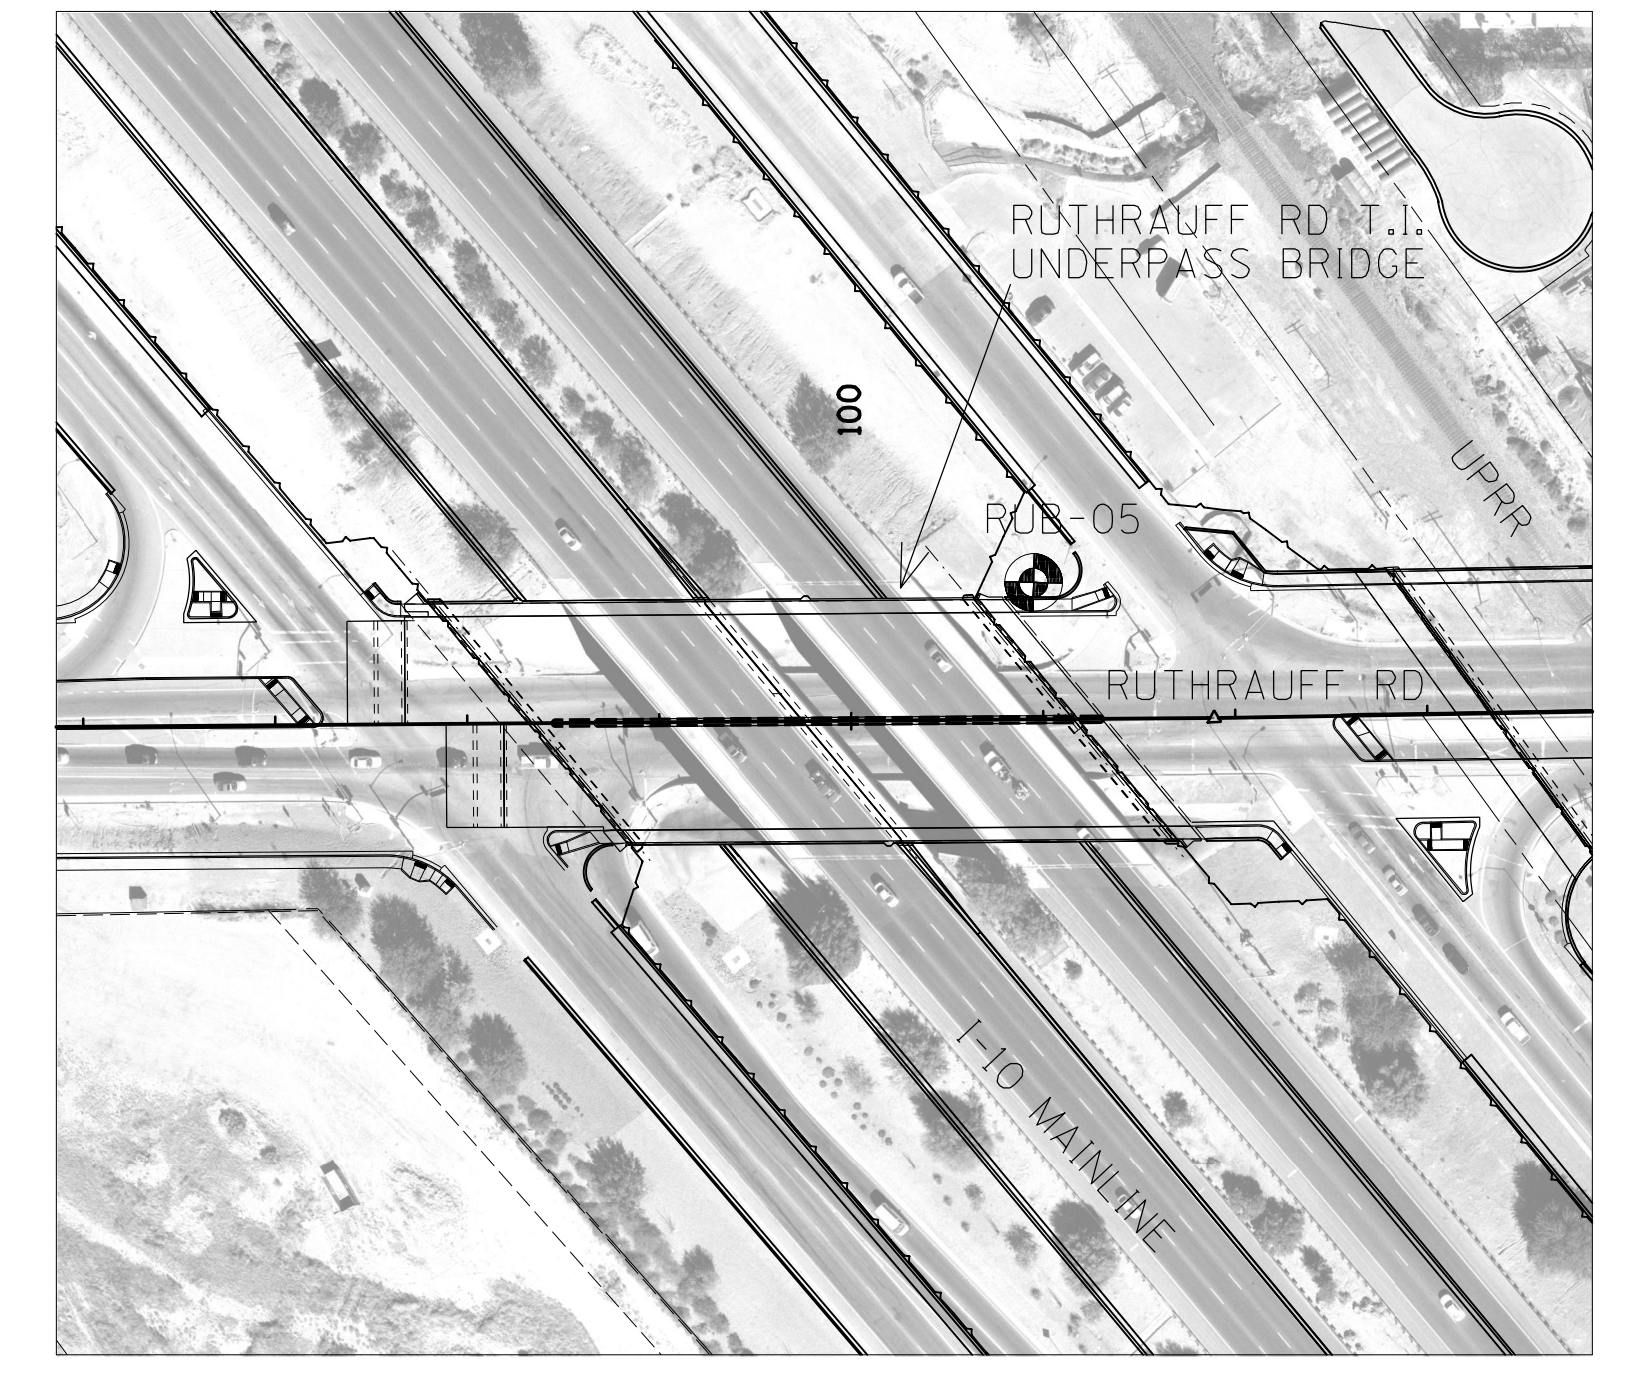SCALE 1:100



-  PHASE 1 BORING LOCATION
-  PHASE 2 BORING LOCATION

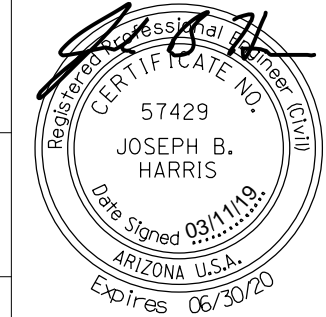DESIGN	JBH	DATE	3-19	<b>ARIZONA DEPARTMENT OF TRANSPORTATION</b> <b>INFRASTRUCTURE DELIVERY AND OPERATIONS DIVISION</b> <b>BRIDGE GROUP</b>  STA 99+ RUTHRAUFF ROAD T.I. UNDERPASS FOUNDATION DATA (6 OF 7)	
DRAWN	JBH	3-19			
CHECKED	KW	3-19			
		510 E. 4TH STREET TUCSON, AZ 85705 520-405-1353		DWG NO. <b>S-141</b>	
I-10 ROUTE	252.00 MILEPOST	20159 STRUCTURE NO.	LOCATION	RUTHRAUFF ROAD T.I.	TRACS NO. <b>H8480 OIC</b>
				<b>010-D(213)S</b>	<b>OF</b>





DATE: LOCATION: REVISIONS: FINISHED PLANS: SURVEY NO. DATE: LOCATION: REVISIONS: FINISHED PLANS: SURVEY NO.

**SCE BORING LOG: RUB-06 (1 of 2)**  
 5218+68, 133 Lt. (Ref. Al. I-10 CL)  
 NORTHING: 471,903 EASTING: 974,456  
 ELEV.: 2,244.8 TOTAL DEPTH: 130.4

CONTRACTOR: GSI  
 DRILLER: S. Bradshaw  
 INSPECTOR: Tyler Carstensen  
 RIG TYPE: Truck mt. CME 75  
 DRILLING METHOD: 8" OD HSA  
 HAMMER TYPE: Auto Hammer  
 SCE PROJECT #: J2009-14/J2012-07

DEPTH (FT)	ELEV. (FT)	GRAPHIC	SAMPLE			SAMPLER TYPES	Type	Symbol	Description	I.D.	O.D.	Length	VISUAL SOIL IDENTIFICATION / DESCRIPTION AND REMARKS
			TYPE	SYMBOL	BLOWS								
						S	⊗	Split Spoon	1.375"	2"	18"		
						R	■	Ring Sampler	2.5"	3"	18"		
						U	□	Shelby Tube					
5	2240		S	⊗	4-5-8			POORLY-GRADED SAND (native), medium dense, dry, brown, fine SAND, no cementation, no reaction with HCl. (SP)					
10	2235		S	⊗	5-6-5			POORLY-GRADED SAND WITH CLAY, medium dense, brown, fine SAND, few nonplastic fines, trace fine to coarse gravel, no cementation, no reaction with HCl. (SP-SC)					
15	2230		S	⊗	6-8-11			WELL-GRADED SAND WITH SILT AND GRAVEL, medium dense, dry, brown, medium to coarse SAND, little fine to coarse gravel, few nonplastic fines, no cementation, no reaction with HCl, max. particle size 1". (SW-SM)					
20	2225		S	⊗	7-12-18								
25	2220		S	⊗	7-12-15			WELL-GRADED SAND WITH GRAVEL, medium dense, moist, brown, fine to coarse SAND, little fine to coarse gravel, no cementation, no reaction with HCl. (SW)					
30	2215		S	⊗	12-13-9			No recovery.					
35	2210		S	⊗	50/2			Obstruction from 35.2' to 37'. No recovery. (Most likely a boulder)					
40	2205		S	⊗	46-50/6			WELL-GRADED SAND WITH SILT AND GRAVEL, very dense, dry, light brown, fine to coarse SAND, little fine gravel, few nonplastic fines, no cementation, no reaction with HCl, max. particle size 0.75". (SW-SM)					
45	2200		S	⊗	16-35-33			POORLY-GRADED GRAVEL WITH CLAY AND SAND, very dense, dry, brown and white, fine to coarse GRAVEL, some fine to coarse sand, few medium plasticity fines, no cementation, no reaction with HCl, max. particle size 1.5". (GP-GC)					
50	2195		S	⊗	50/1			No recovery.					
55	2190		S	⊗	24-28-46								
60	2185		S	⊗	21-30-35								
65	2180		S	⊗	16-18-20			Becomes dense.					
70	2175							CLAYEY SAND WITH GRAVEL, very dense, moist, brown, fine to coarse SAND, some fine gravel, little medium plasticity fines, no					

**SCE BORING LOG: RUB-06 (2 of 2)**  
 5218+68, 133 Lt. (Ref. Al. I-10 CL)  
 NORTHING: 471,903 EASTING: 974,456  
 ELEV.: 2,244.8 TOTAL DEPTH: 130.4

CONTRACTOR: GSI  
 DRILLER: S. Bradshaw  
 INSPECTOR: Tyler Carstensen  
 RIG TYPE: Truck mt. CME 75  
 DRILLING METHOD: 8" OD HSA  
 HAMMER TYPE: Auto Hammer  
 SCE PROJECT #: J2009-14/J2012-07


DEPTH (FT)	ELEV. (FT)	GRAPHIC	SAMPLE			SAMPLER TYPES	Type	Symbol	Description	I.D.	O.D.	Length	VISUAL SOIL IDENTIFICATION / DESCRIPTION AND REMARKS
			TYPE	SYMBOL	BLOWS								
			S	⊗	24-34-25			cementation, no reaction with HCl, max. particle size 1". (SC)					
75	2170		S	⊗	16-23-36			Becomes dark brown.					
80	2165		S	⊗	31-30-28								
85	2160		S	⊗	9-12-17			Becomes medium dense.					
90	2155		S	⊗	19-17-27			Becomes dense, little fine gravel.					
95	2150		S	⊗	50/4			Becomes very dense.					
100	2145		S	⊗	38-50/6								
105	2140		S	⊗	37-50/4			Becomes brown and white.					
110	2135		S	⊗	50/6			Becomes dry.					
115	2130		S	⊗	49-50/4			Becomes little low plasticity fines, max. particle size 0.75".					
120	2125		S	⊗	41-50/5								
125	2120		S	⊗	34-48-50/3			Becomes some fine gravel, little medium plasticity fines.					
130	2115		S	⊗	50/5			Becomes little fine gravel.					
135	2110							End of boring at 130'. Sampler stopped at 130.4'. No groundwater encountered. Backfilled to 20' with cuttings. Grout to surface with ADWR compliant grout.					
140	2105												

F.H.W.A. REGION	STATE	PROJECT NO.	SHEET NO.	TOTAL SHEETS	RECORD DRAWING
9	ARIZ.	010-D(213)S	655	849	

010 PM 252

**BORING PLAN**

SCALE 1:100

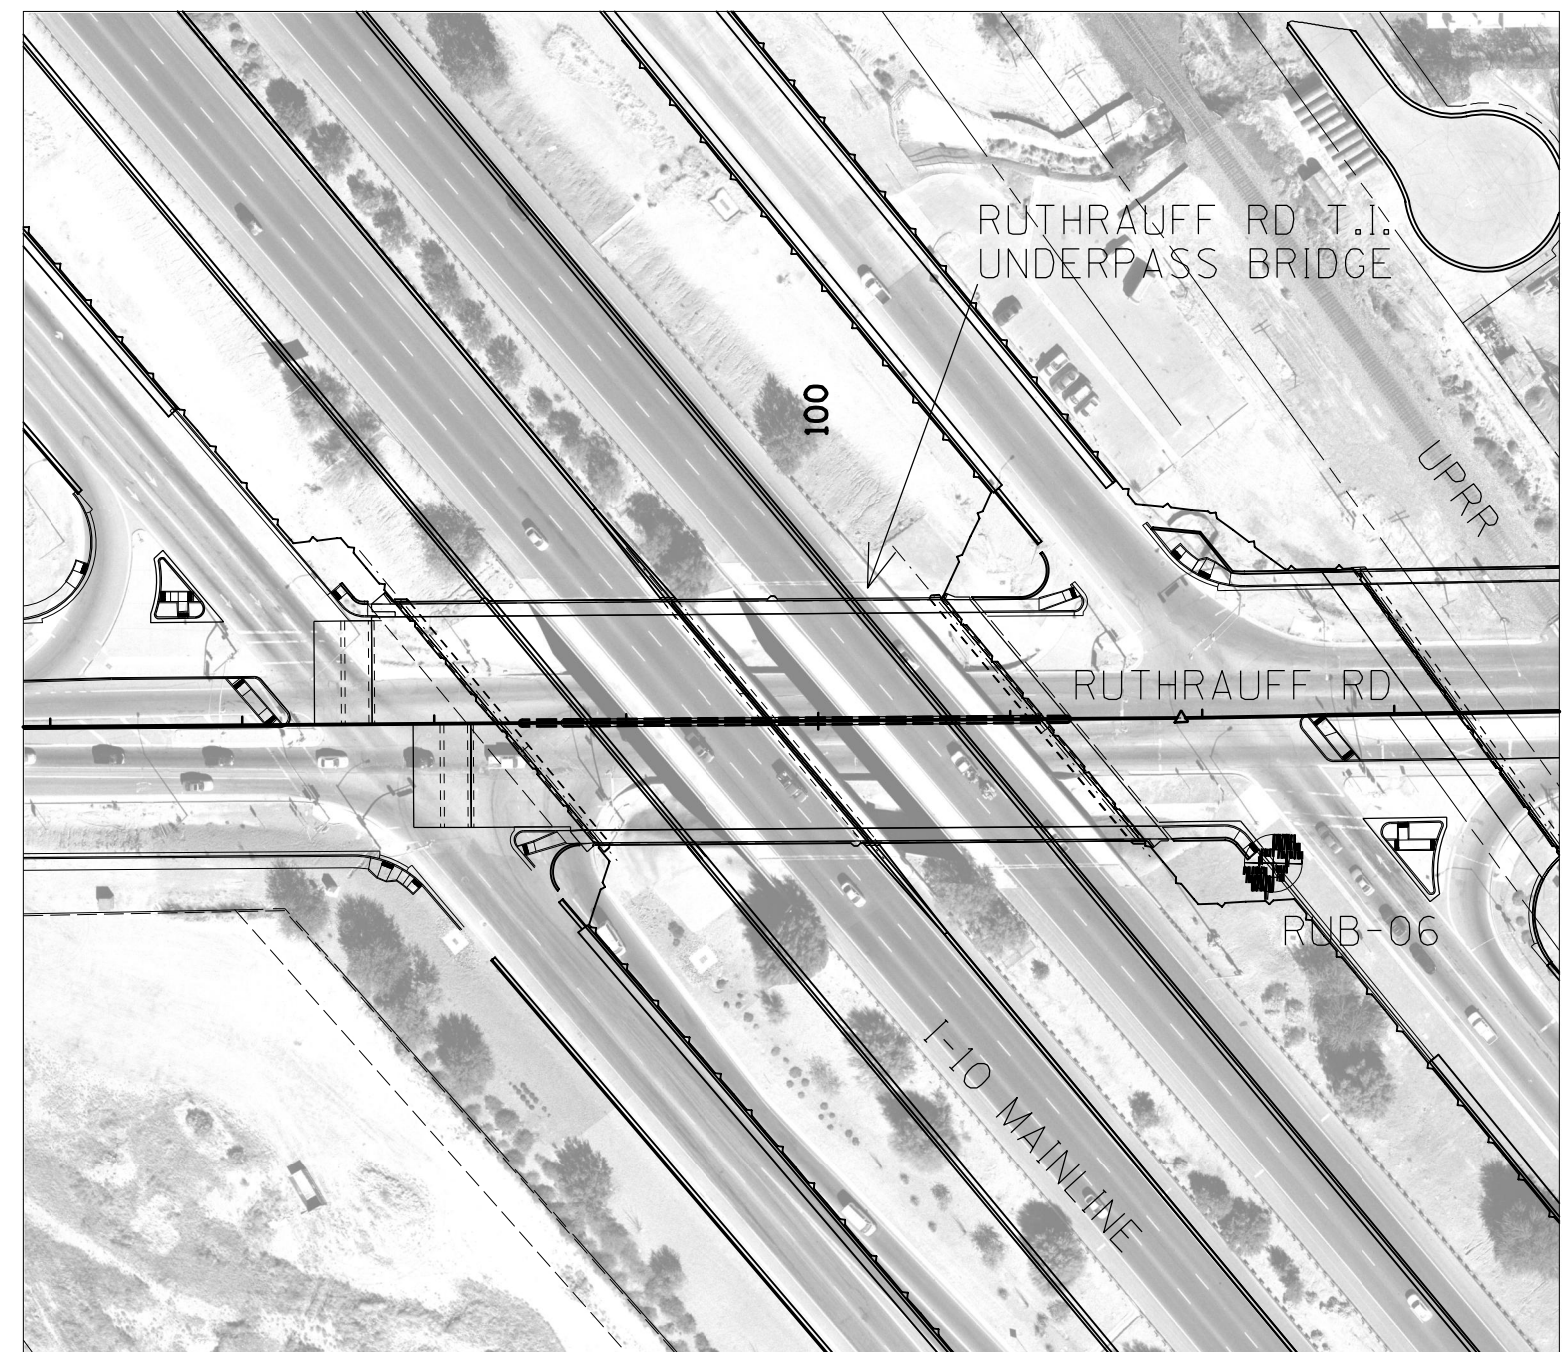

- PHASE 1 BORING LOCATION
- PHASE 2 BORING LOCATION

DESIGN	JBH	DATE	3-19	<b>ARIZONA DEPARTMENT OF TRANSPORTATION</b> <b>INFRASTRUCTURE DELIVERY AND OPERATIONS DIVISION</b> <b>BRIDGE GROUP</b>  STA 99+ RUTHRAUFF ROAD T.I. UNDERPASS FOUNDATION DATA (7 OF 7)	
DRAWN	JBH	3-19			
CHECKED	KW	3-19			
<b>SCE ENGINEERING</b> 510 E. 4TH STREET TUCSON, AZ 85705 520-405-1353		LOCATION	RUTHRAUFF ROAD T.I.	DWG NO.	S-1.42
I-10 ROUTE	252.00 MILEPOST	20159 STRUCTURE NO.	TRACS NO. H8480 OIC	010-D(213)S	OF






CASA GRANDE - TUCSON HIGHWAY ( I-10)  
RUTHRAUFF TI  
PIMA COUNTY

F.H.W.A. REGION	STATE	PROJECT NO.	SHEET NO.	TOTAL SHEETS	RECORD DRAWING
9	ARIZ.	010-D(213)S	656	849	


010 PM 252

INDEX OF DRAWINGS

DWG NO	TITLE
S-2.01	GENERAL PLAN & INDEX OF DWGS
S-2.02	LOCATION PLAN
S-2.03	ELEVATION & PROFILE
S-2.04	TYPICAL SECTION
S-2.05	GENERAL NOTES & QUANTITIES
S-2.06	RAILROAD NOTES 1
S-2.07	RAILROAD NOTES 2
S-2.08	FOUNDATION LAYOUT
S-2.09	DRILLED SHAFT DETAILS
S-2.10	ABUTMENT 1 PLAN & ELEVATION
S-2.11	ABUTMENT 2 PLAN & ELEVATION
S-2.12	ABUTMENT 1 DETAILS
S-2.13	ABUTMENT 2 DETAILS
S-2.14	GIRDER DETAILS 1
S-2.15	GIRDER DETAILS 2
S-2.16	GIRDER DETAILS 3
S-2.17	GIRDER DETAILS 4
S-2.18	FRAMING PLAN
S-2.19	DECK PLAN
S-2.20	DECK SECTION & REINFORCING
S-2.21	DECK DETAILS
S-2.22	SUPERSTRUCTURE DETAILS
S-2.23	ABUTMENT DIAPHRAGM DETAILS 1
S-2.24	ABUTMENT DIAPHRAGM DETAILS 2
S-2.25	MISCELLANEOUS DETAILS 1
S-2.26	MISCELLANEOUS DETAILS 2
S-2.27	CONSTRUCTION SEQUENCE
S-2.28	CAMBER DETAILS
S-2.29	SCREED ELEVATIONS
S-2.30	SCREED RAIL ELEVATIONS
S-2.31	UPRR UNDERDECK LIGHTING & FENCE DETAILS

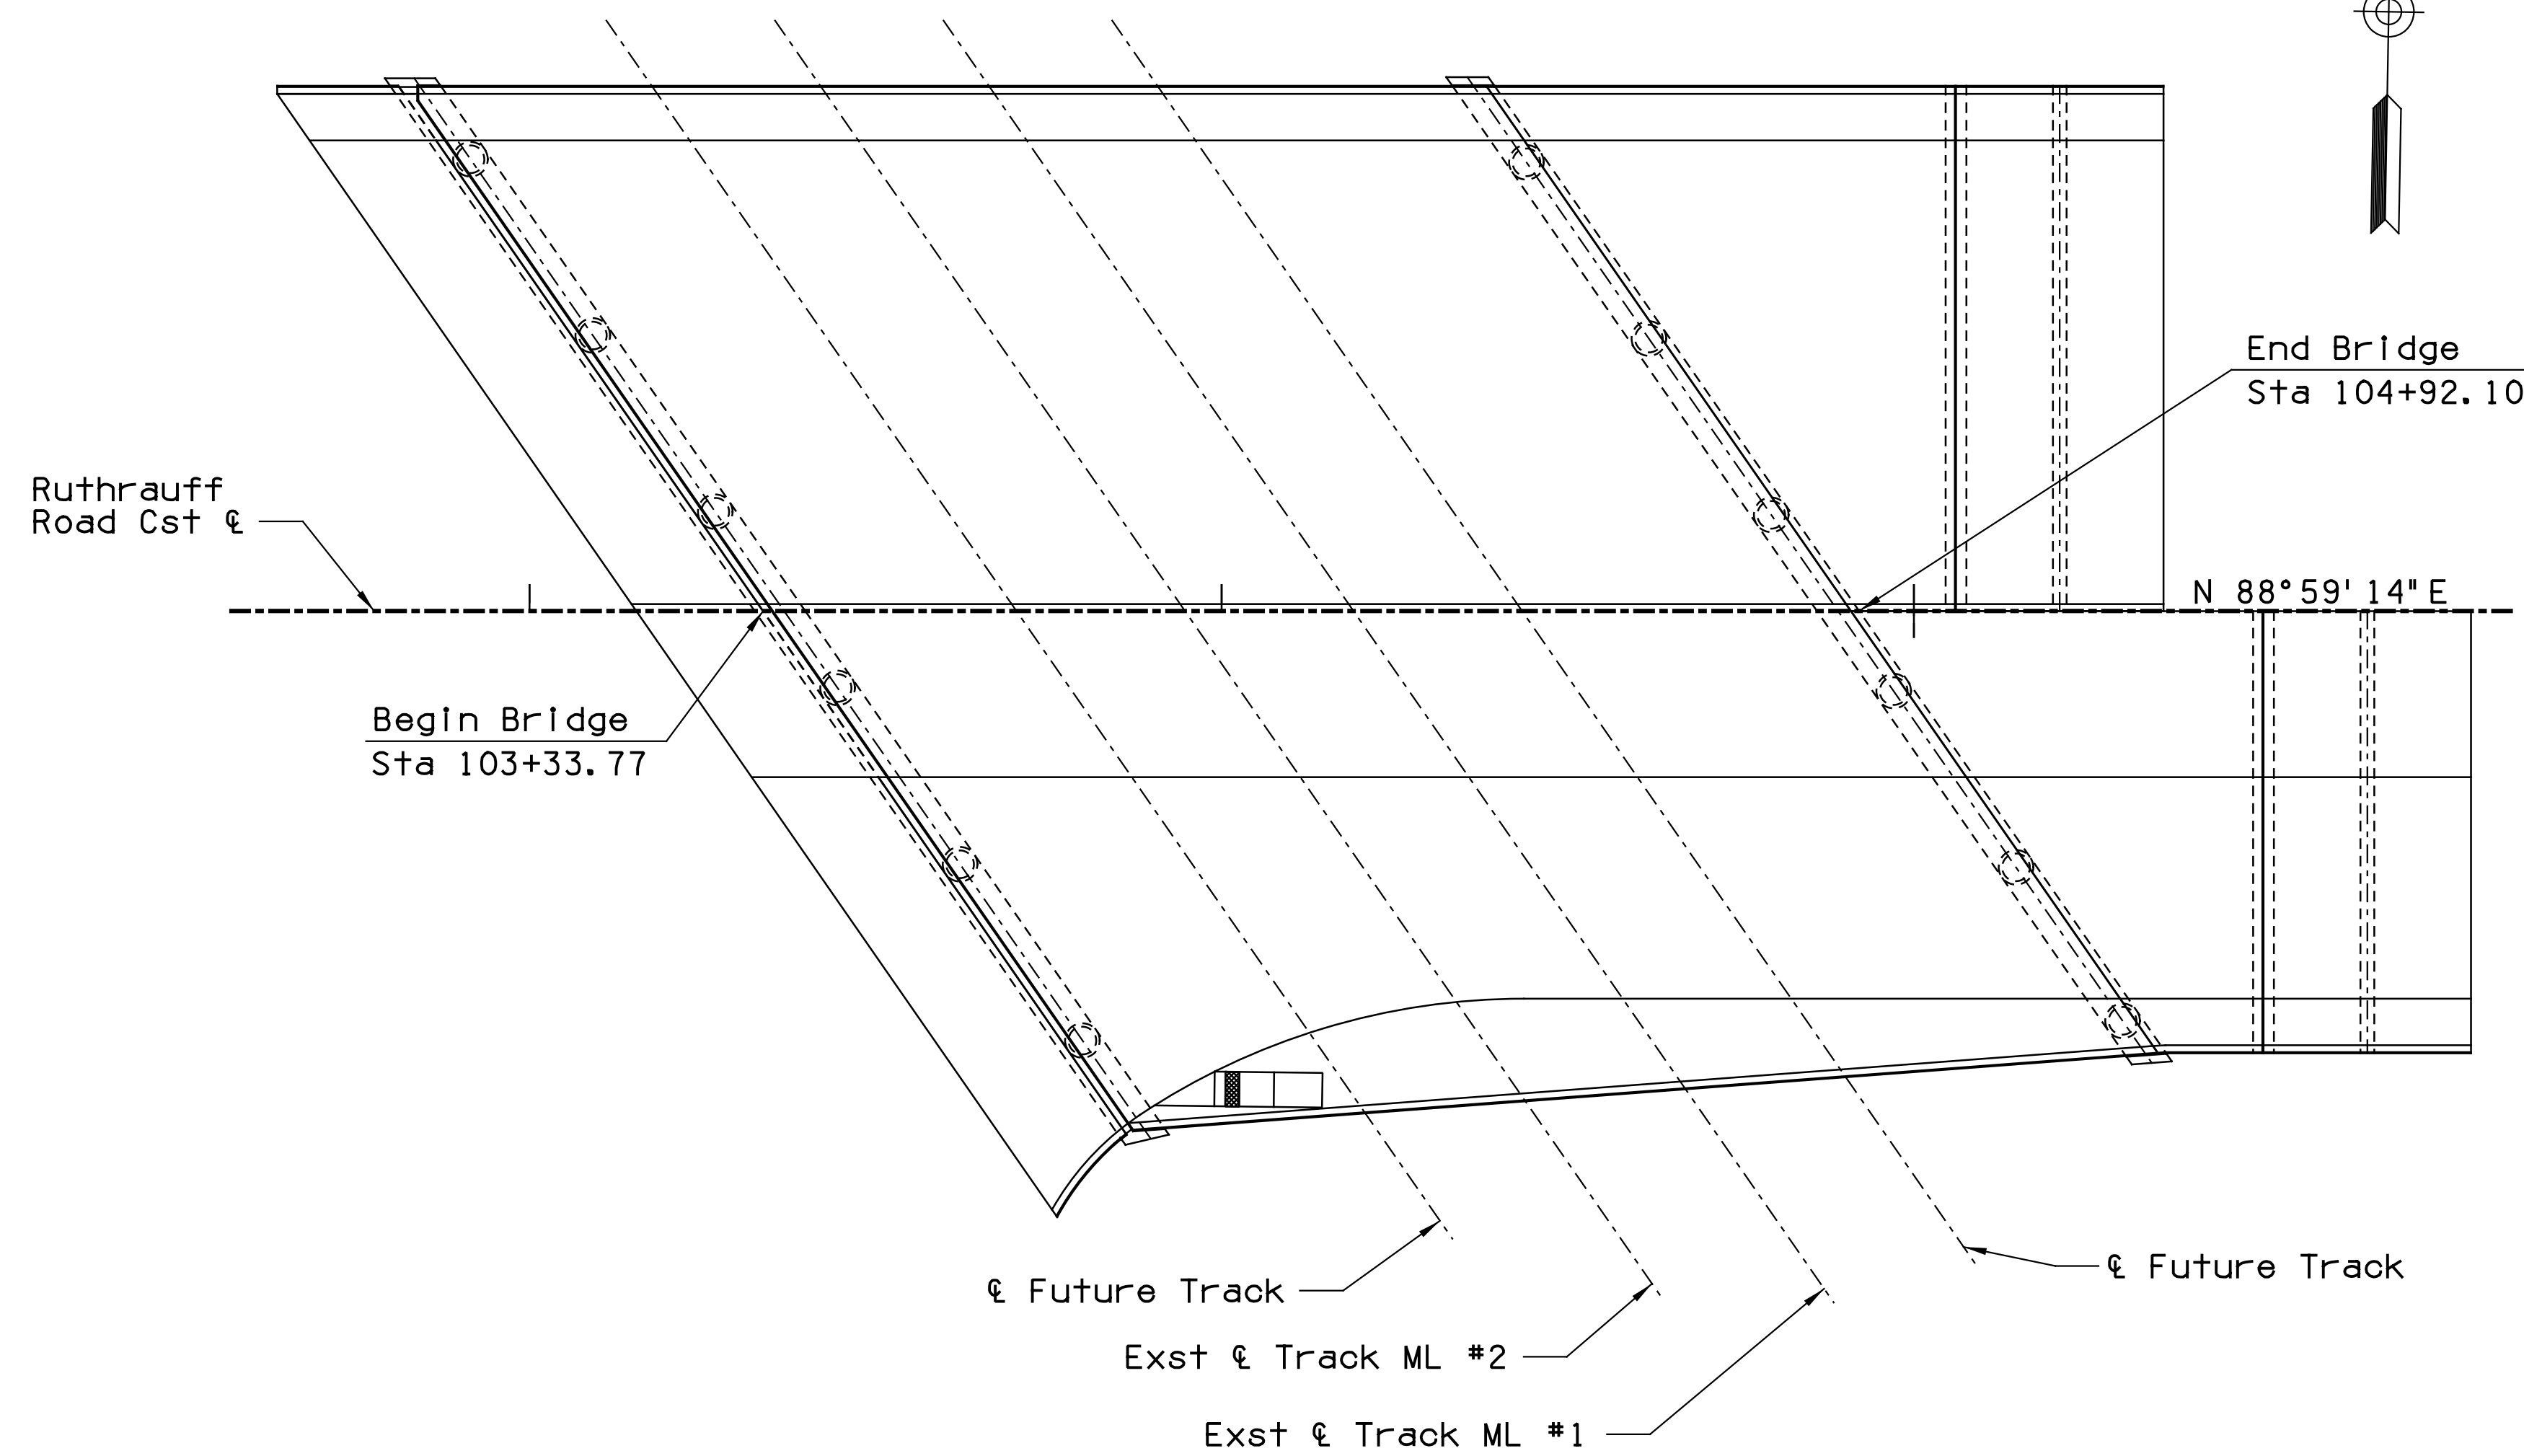


GENERAL PLAN  
Scale: 1" = 10'-0"

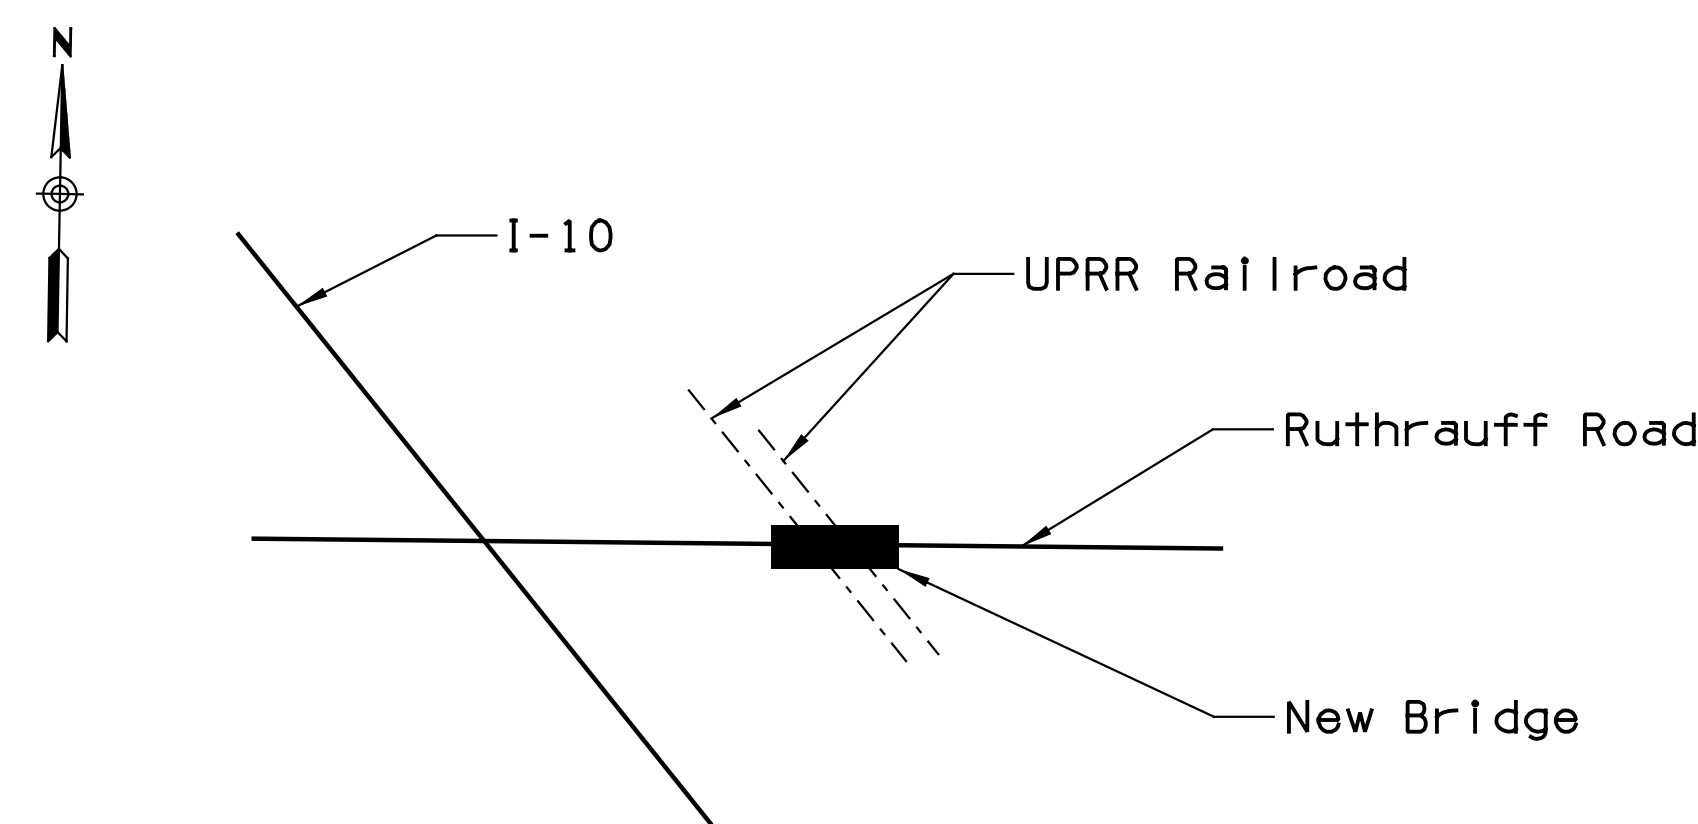

KEY MAP  
Not To Scale


LEGEND:

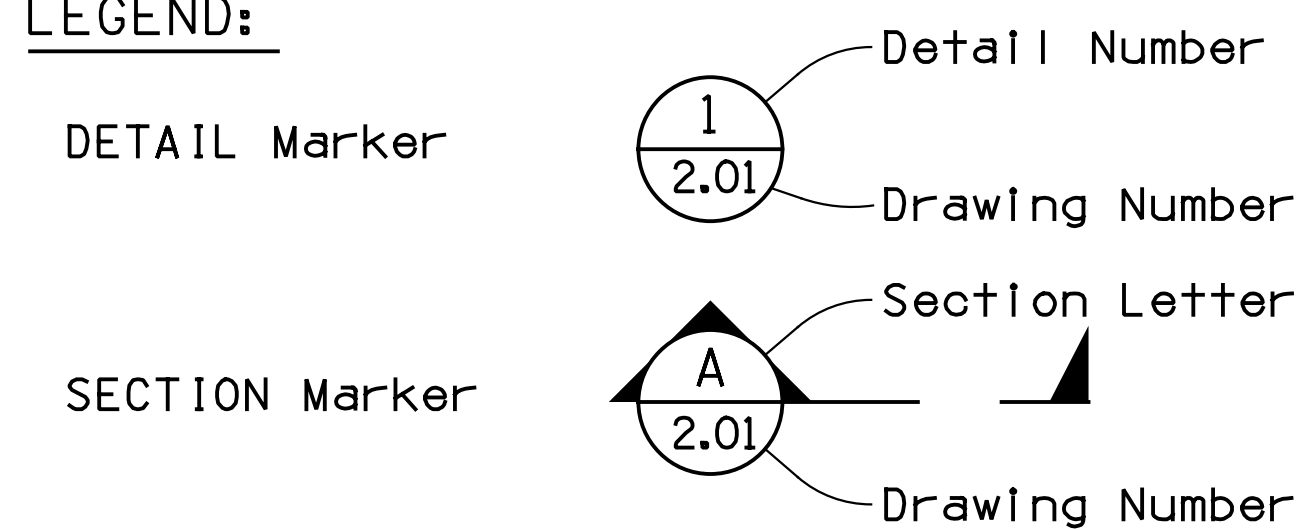

NOTE:

A line (—) in place of the Drawing Number indicates that the SECTION or DETAIL is located on the same Drawing that the SECTION or DETAIL is cut.


DESIGN	NAME	DATE	ARIZONA DEPARTMENT OF TRANSPORTATION INFRASTRUCTURE DELIVERY AND OPERATIONS DIVISION BRIDGE GROUP
KLH		03/19	<b>Sta 103+</b> <b>RUTHRAUFF RD - UPRR OVERPASS</b> <b>GENERAL PLAN &amp; INDEX OF DWGS</b>
AJM		03/19	
JRP		03/19	
<b>TY LIN INTERNATIONAL</b> <small>engineers   planners   scientists</small> 60 E. Rio Salado Parkway, Suite 501 Tempe, Arizona 85281			RUTHRAUFF TI LOCATION
I-10	252.000	20160	ROUTE MILEPOST STRUCTURE NO. RUTHRAUFF TI
TRACS NO. H8480 01C			010-D(213)S DWG. S-2 .01

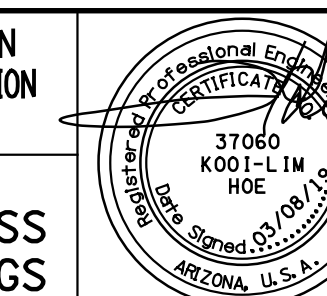



F.H.W.A. REGION	STATE	PROJECT NO.	SHEET NO.	TOTAL SHEETS	RECORD DRAWING
9	ARIZ.	010-D(213)S	658	849	


010 PM 252

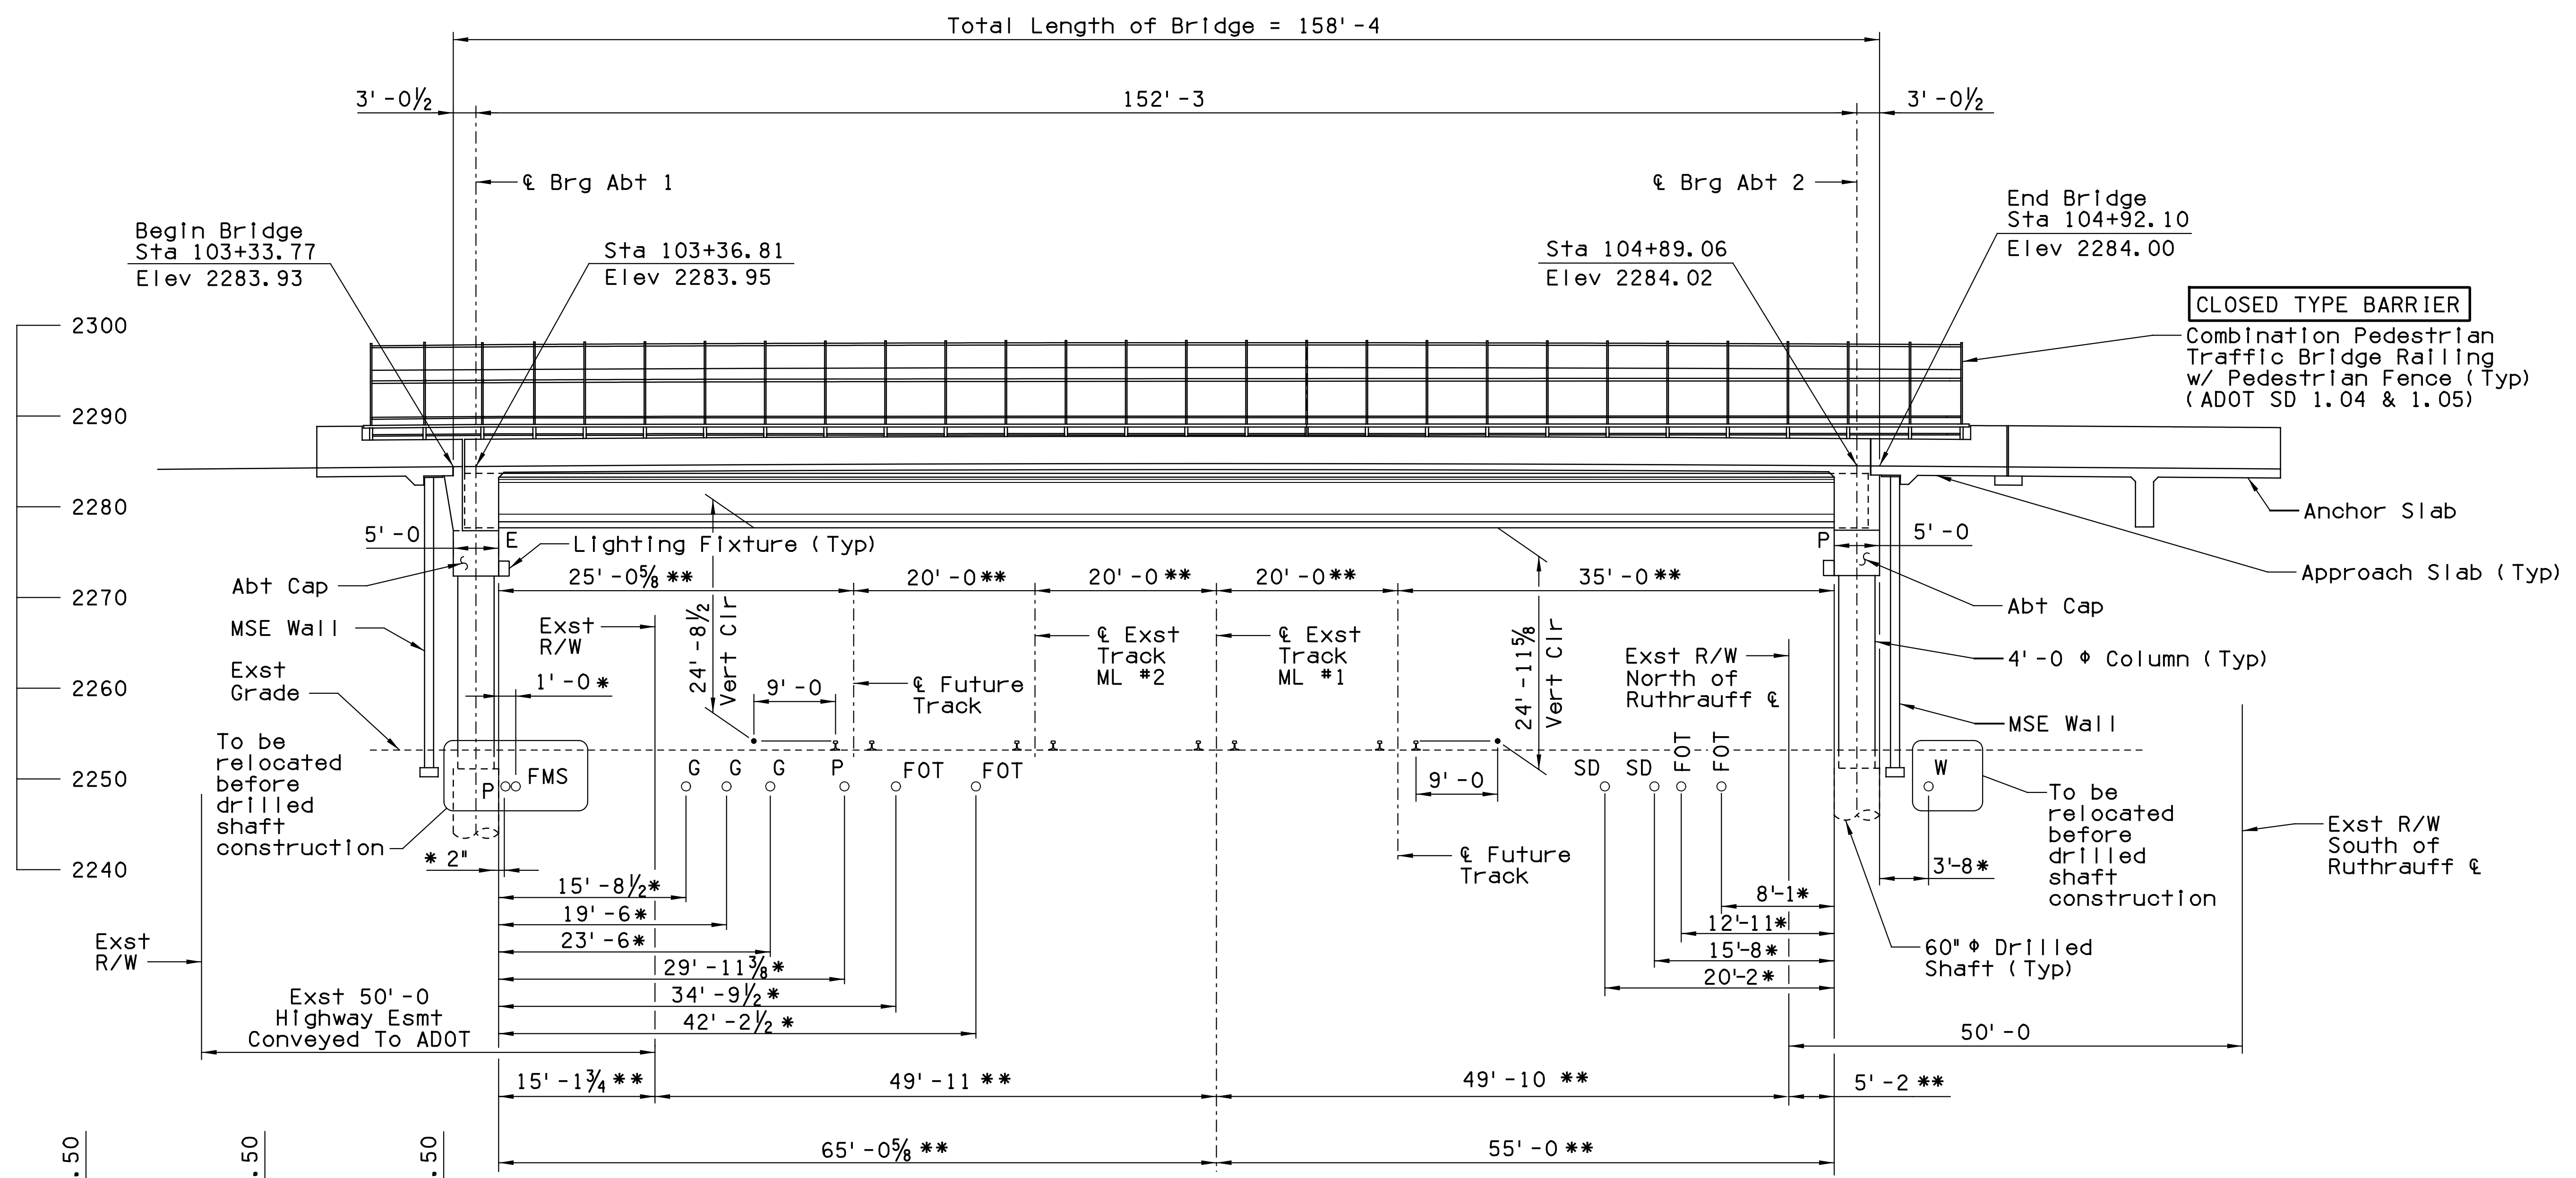

\* Minimum distance from abutment cap  
 \*\* Measured Perpendicular to  $\epsilon$  Track

**ELEVATION**

(Stations, Elevations & Dimensions Taken Along Ruthrauff Rd Cst  $\epsilon$ )  
 Scale: 1"=20'-0"

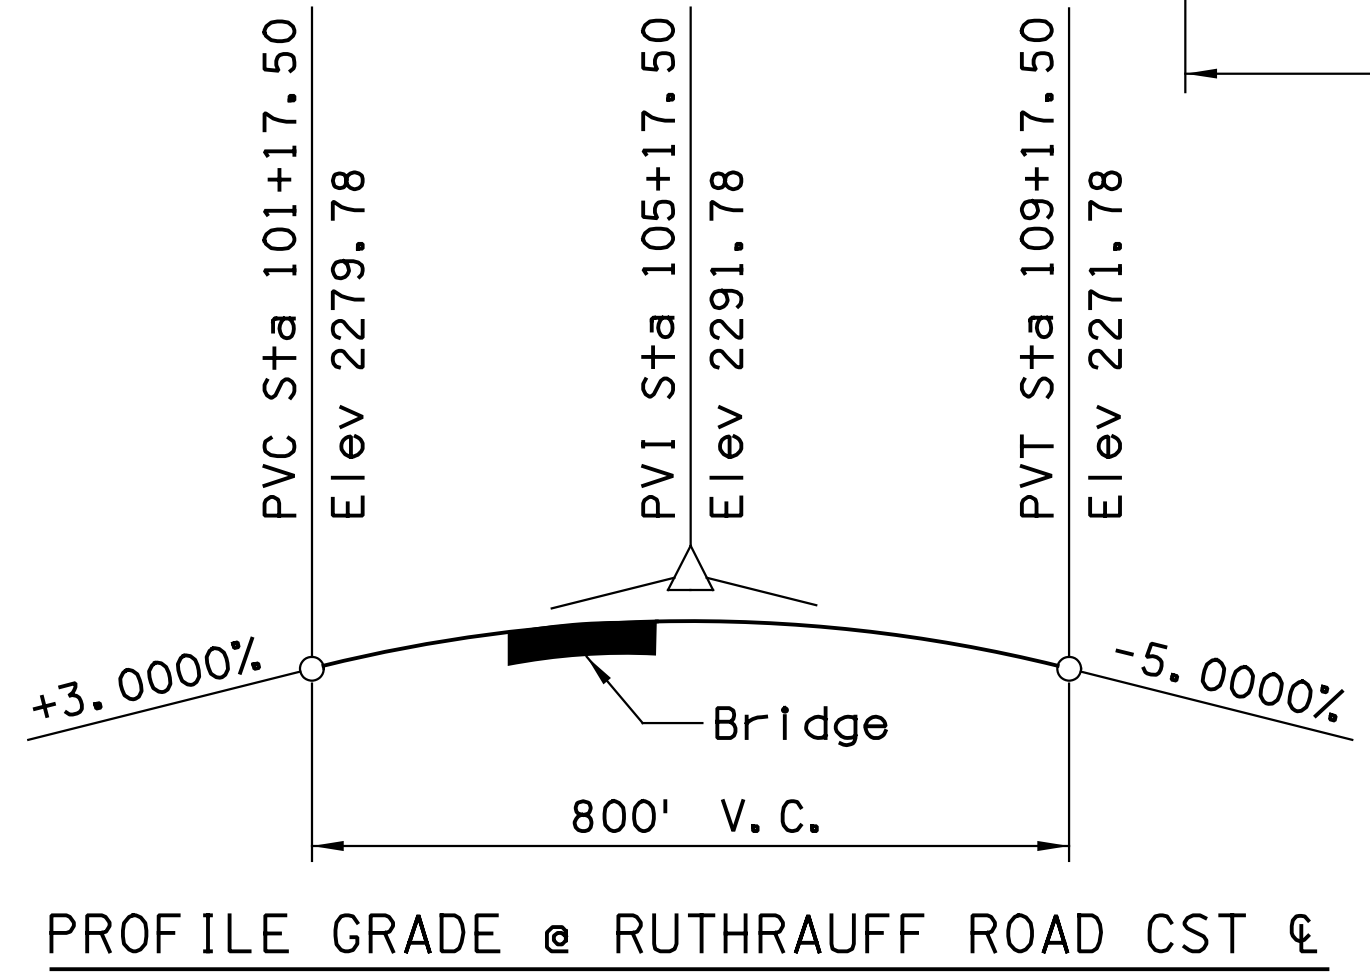


**NOTE:**  
 No drainage water on the bridge deck will be discharged to Railroad Right-of-Way.

DESIGN	KLH	DATE	03/19	ARIZONA DEPARTMENT OF TRANSPORTATION INFRASTRUCTURE DELIVERY AND OPERATIONS DIVISION <b>BRIDGE GROUP</b> Sta 103+ <b>RUTHRAUFF RD - UPRR OVERPASS          ELEVATION and PROFILE</b>	
DRAWN	AJM	03/19			
CHECKED	JRP	03/19			
<b>TY-LIN INTERNATIONAL</b> engineers   planners   scientists 60 E. Rio Salado Parkway, Suite 501 Tempe, Arizona 85281				LOCATION <b>RUTHRAUFF TI</b>	Exp. Press 12/31/2019 DWG. S-2 .03
ROUTE	252.000	20160	STRUCTURE NO.	TRACS NO. H8480 01C	
			010-D(213)S		

F.H.W.A. REGION	STATE	PROJECT NO.	SHEET NO.	TOTAL SHEETS	RECORD DRAWING
9	ARIZ.	010-D(213)S	659	849	

010 PM 252

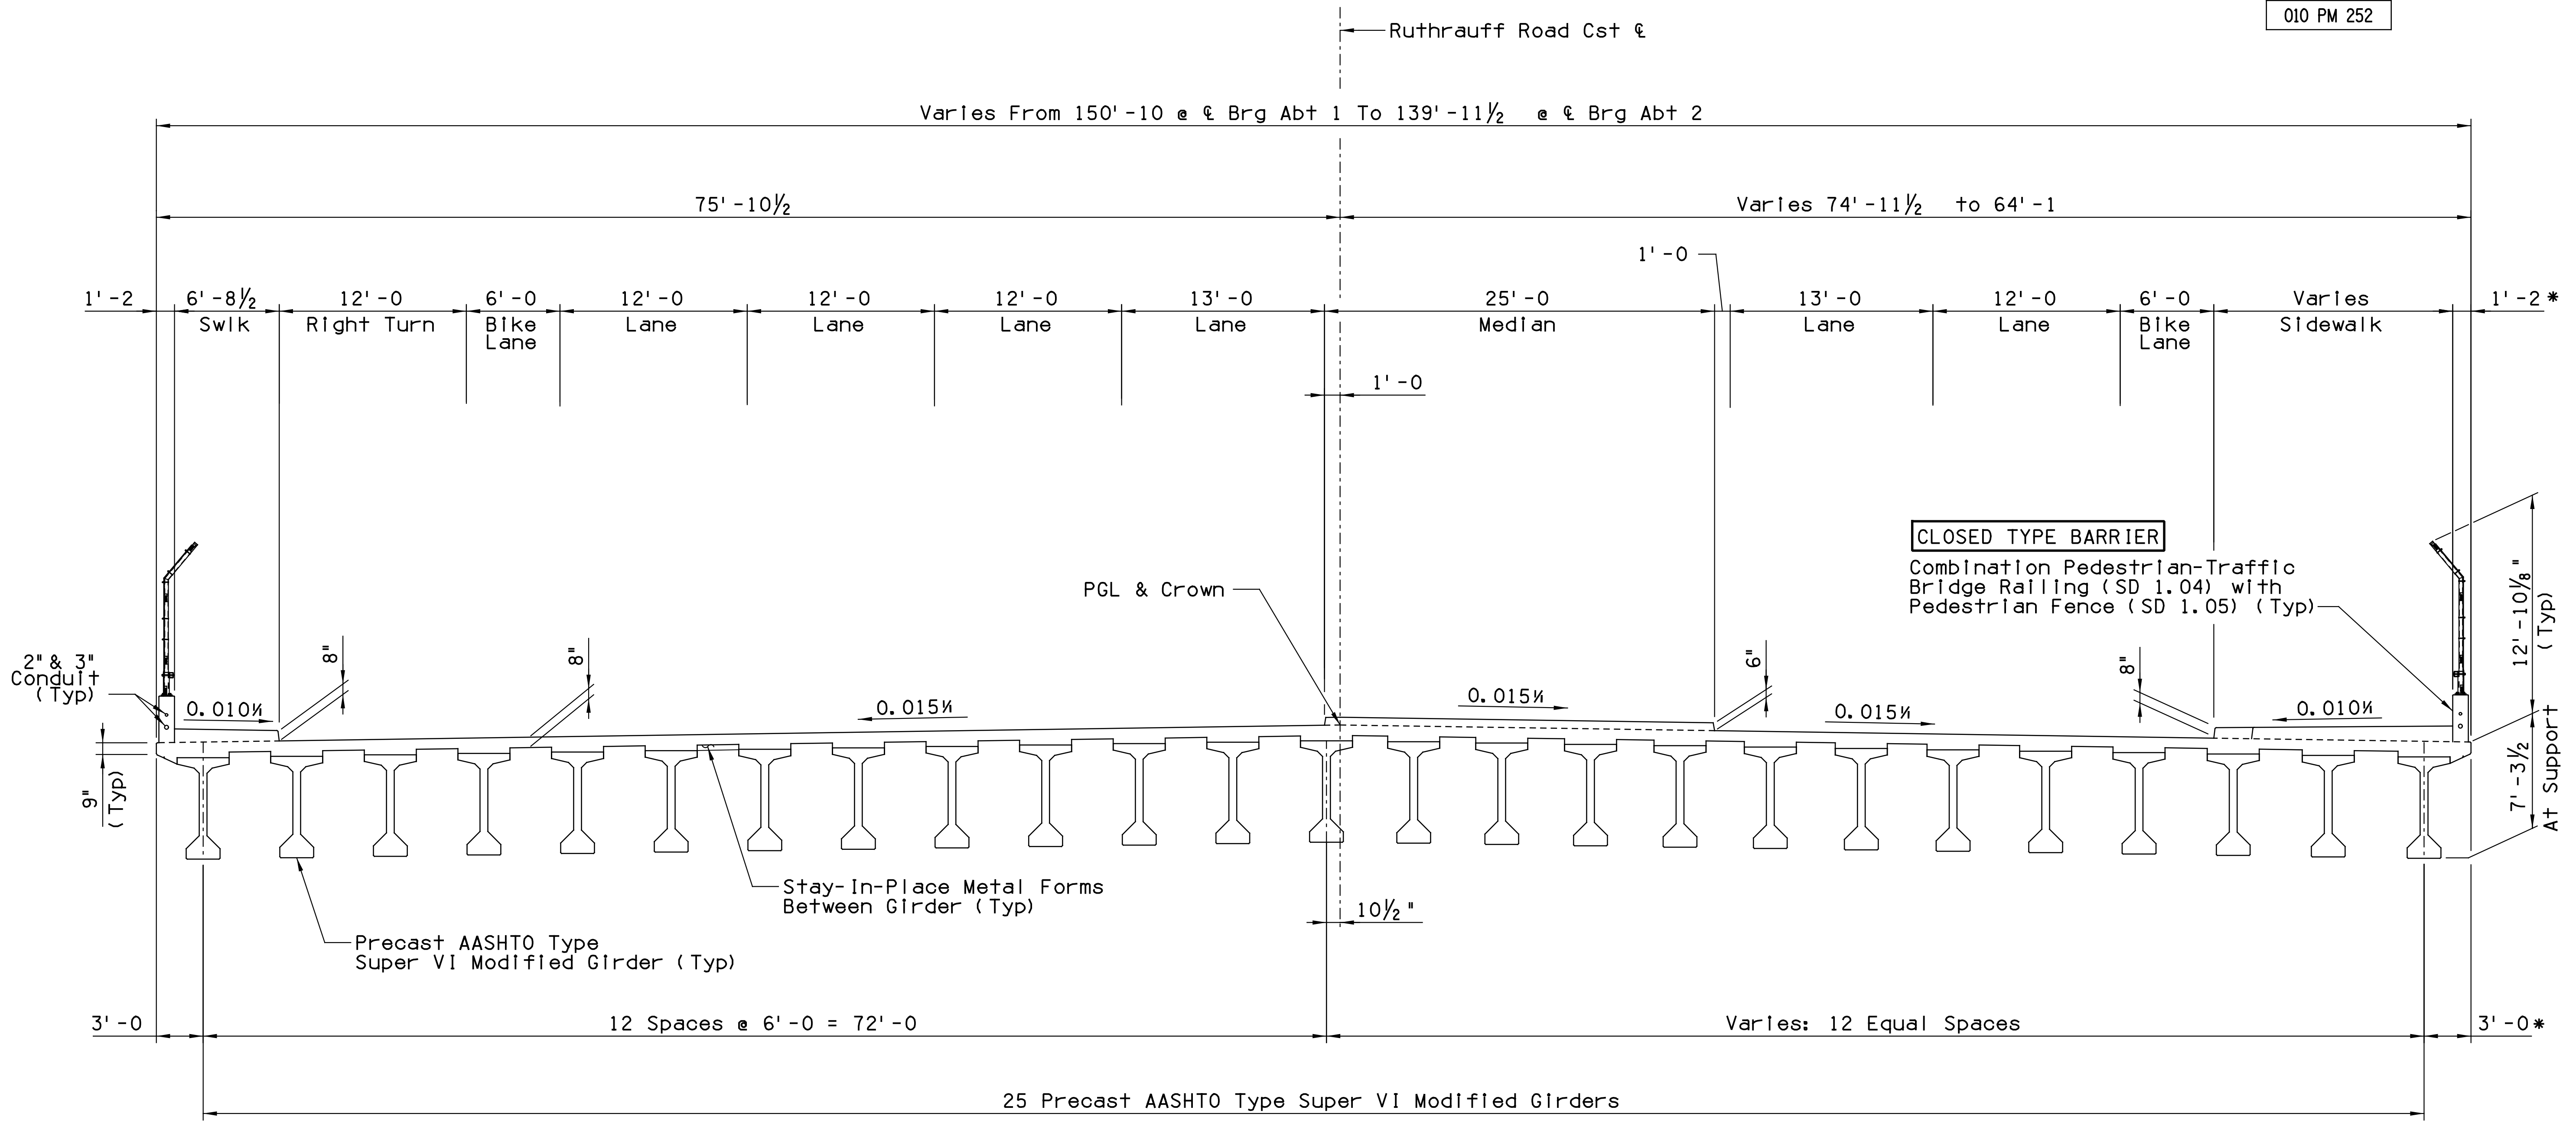

**TYPICAL SECTION** \* Normal to edge of deck  
 Scale: 3/16" = 1'-0"

**NOTE:**  
 No drainage water on the bridge deck will be discharged to Railroad Right-of-Way.

DESIGN	KLH	DATE	03/19	ARIZONA DEPARTMENT OF TRANSPORTATION INFRASTRUCTURE DELIVERY AND OPERATIONS DIVISION <b>BRIDGE GROUP</b> Sta 103+ <b>RUTHRAUFF RD - UPRR OVERPASS</b> <b>TYPICAL SECTION</b>
DRAWN	AJM	DATE	03/19	
CHECKED	JRP	DATE	03/19	
<b>TY LIN INTERNATIONAL</b> engineers   planners   scientists 60 E. Rio Salado Parkway, Suite 501 Tempe, Arizona 85281				37060 K001-LIM HOE Date Signed 03/19/19 ARIZONA, U.S.A.
I-10	252.000	20160	LOCATION	
ROUTE	MILEPOST	STRUCTURE NO.		
TRACS NO. H8480 01C			010-D(213)S	

Plot Driver: ...TYLI PLTDRAWDOT PDF FULL.plt  
 SURVEY NO. FINISHED PLANS  
 Penable: ...TYLI PLTDRAWOPENSTDPLOT.TBL  
 LOCATION FINISHED PLANS  
 REVISIONS- SURVEY NO. FINISHED PLANS  
 DATE- REVISIONS- FINISHED PLANS  
 DATE- REVISIONS- FINISHED PLANS




F.H.W.A. REGION	STATE	PROJECT NO.	SHEET NO.	TOTAL SHEETS	RECORD DRAWING
9	ARIZ.	010-D(213)S	660	849	

010 PM 252

APPROXIMATE QUANTITIES

ITEM	STRUCTURAL EXCAVATION C. Y.	STRUCTURE BACKFILL C. Y.	CLASS S CONCRETE			REINFORCING STEEL LBS	PRECAST AASHTO TYPE SUPER VI MODIFIED GIRDER	DRILLED SHAFT 60" $\phi$ L. F.
			f' c=3500 PSI C. Y.	f' c=4000 PSI C. Y.	f' c=4500 PSI C. Y.			
ABUTMENT 1	65	50	349		7	103,590		480
ABUTMENT 2	45	35	271			86,700		480
SUPERSTRUCTURE			313	123	764	150,980	3796	
TOTAL	110	85	933	123	771	341,270	3796	960
AS-BUILT								

Combination Pedestrian-Traffic Bridge Railing (SD 1.04)..... 486 L.F.  
 Vertical Restrainers (Expansion)..... 24 Ea.  
 Vertical Restrainers (Fixed)..... 48 Ea.  
 Deck Joint Assembly (Strip Seal) (SD 3.02)..... 181 L.F.  
 Approach Slab (SD 2.01)..... 8,412 S.F.  
 Anchor Slab (Type 2) (SD 2.03)..... 4193 S.F.  
 Misc Steel..... 15,010 LBS.  
 Stay-In-Place forms Included in price of Concrete Class S (f' c = 4500 psi)

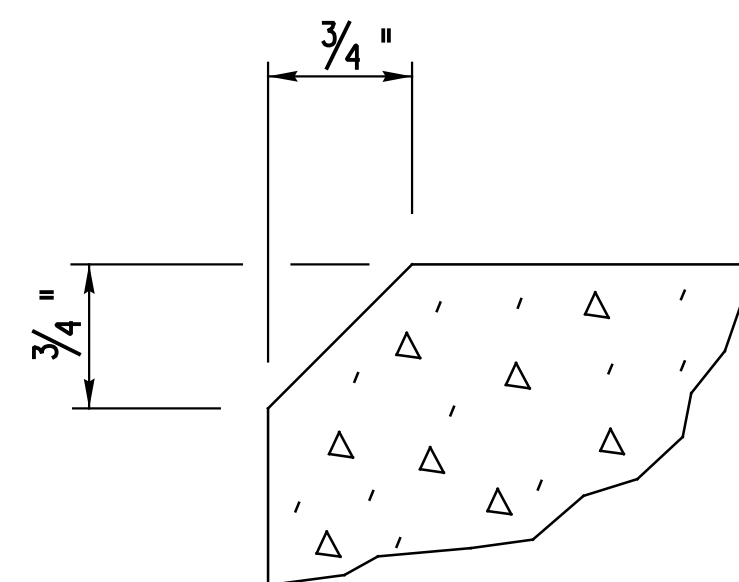

CHAMFER DETAIL  
Not To Scale

GENERAL NOTES:

Construction Specification - Arizona Department of Transportation, Standard Specifications for Road and Bridge Construction, Edition of 2008.  
 Design Specification - American Association of State Highway and Transportation Officials (AASHTO) LRFD Bridge Design Specifications for Highway Bridges, 7th Edition 2014.  
 Dead Load - Includes allowance of 25 pounds per square foot (psf) for future wearing surface (FWS) and 15 psf for metal stay-in-place forms.

Loading Class - HL-93.  
 Bridge site is classified as Seismic Zone 1 with Peak Ground Acceleration (PGA) = 0.075

Inventory and operating ratings for HL-93 are in accordance with AASHTO Manual for Condition Evaluation and Load and Resistance Factor Rating (LRFD) of Highway Bridges, 2nd Edition and 2015 Interm Revisions.

Inventory Rating RF=1.00  
 Operating Rating RF=2.38

All concrete shall be Class "S" unless noted otherwise.

Reinforcing steel shall conform to ASTM Specification A615 except reinforcing to be welded shall conform to ASTM A706. All reinforcing shall be furnished as Grade 60.

All bends and hooks shall meet the requirements of AASHTO Article 5.10.2 unless noted otherwise. All bend dimensions for reinforcing steel shall be out-to-out of bars. All placement dimensions for reinforcing steel shall be to center of bars unless noted otherwise.

All reinforcing steel shall have 2 inch clear cover unless noted otherwise.

Stresses:  
 Deck..... f' c = 4.5 ksi  
 Bridge Parapet, Dado, Sidewalk,  
 Raised Median, & Approach Slabs..... f' c = 4.0 ksi  
 Abutments, Abutment Diaphragm,  
 Intermediate Diaphragm,  
 Piers, & Drilled Shafts..... f' c = 3.5 ksi  
 Other Class "S" concrete..... f' c = 3.0 ksi  
 Grade 60 transverse deck reinf..... fs = 24 ksi  
 All other reinforcing..... fy = 60 ksi  
 Prestressing Steel..... fpu = 270 ksi  
 (0.6" dia. 7-wire Low Relaxation Strand)

Parapets shall be constructed after spans have taken dead load deflection.

Parapets shall not be slip formed.

Chamfer all exposed corners 3/4" per Chamfer Detail unless noted otherwise.

Dimensions shall not be scaled from drawings.

STRUCTURE DETAIL DRAWINGS:

SD 1.04, SD 1.05, SD 2.01, SD 2.03, SD 3.02

DESIGN	KLH	DATE	03/19	ARIZONA DEPARTMENT OF TRANSPORTATION INFRASTRUCTURE DELIVERY AND OPERATIONS DIVISION BRIDGE GROUP	
DRAWN	AJM	DATE	03/19		
CHECKED	JRP	DATE	03/19		
<b>TY LIN INTERNATIONAL</b> engineers   planners   scientists 60 E. Rio Salado Parkway, Suite 501 Tempe, Arizona 85281				Sta 103+ <b>RUTHRAUFF RD - UPRR OVERPASS</b> <b>GENERAL NOTES AND QUANTITIES</b>	
ROUTE	252.000	20160	LOCATION	RUTHRAUFF TI	
TRACS NO.	H8480 01C		PROJECT NO.	010-D(213)S	
			DWG. S-2	.05	
			DATE	OF	

F.H.W.A. REGION	STATE	PROJECT NO.	SHEET NO.	TOTAL SHEETS	RECORD DRAWING
9	ARIZ.	010-D(213)S	661	849	


010 PM 252

**GENERAL SHORING NOTES:**

- All dimensions are measured perpendicular to  $\phi$  track.
- Prior to commencing any work, the contractor shall submit for approval by the railroad, detailed plans and calculations indicating the nature & extent of the track protection shoring proposed. The contractor shall install the temporary shoring system per the approved plans. Design of the temporary shoring system shall comply with Railroad Guidelines for Temporary Shoring.
- For excavations which encroach into zone A or B, shoring plans shall be accompanied by design calculations. Plans & calculations must be signed & stamped by a professional engineer in the state of Arizona.


**RAILROAD NOTES:**

- Railroad's review and approval of shoring, demolition, erection, and falsework are required. Allow a minimum of four weeks for the review and approval of each submittal.
- Any shoring system that impacts the Railroad's operation and/or supports the Railroad's embankment shall be designed and constructed per Railroad Guidelines for Temporary Shoring.
- All demolition within the Railroad's right-of-way and/or demolition that may impact the Railroad's tracks or operation shall comply with the Railroad's Demolition requirements.
- Erection over the Railroad's right of way shall be designed to cause no interruption to Railroad's operation and shall be planned such that it enables the track to remain open to traffic per Railroad requirements.
- The elevation of the existing top-of-rail profile shall be verified before beginning construction. All discrepancies shall be brought to the attention of the Railroad prior to construction.
- The proposed grade separation project shall not increase the quantity and/or characteristics of the flow in the Railroad ditches and/or drainage structures. The Contractor must submit a proposed method of erosion and sediment control and have the method approved by the Railroad prior to beginning any grading on the project site.
- For Railroad coordination please refer to the Railroad's Coordination Requirements as part of the Specifications or Special Provisions of the project.
- Minimum Construction Clearance Envelopes of 21'-6 vertical above the plane of top-of-rail and 15 feet horizontal at right angle from centerline of track shall be maintained at all times during construction. All permanent clearances shall be verified before project closeout.
- Railroad requirements do not allow work within 50 feet of track centerline when a train passes the work site and all personnel must clear the area within 25 feet of the track centerline and secure all equipment.
- False-work clearances shall comply with minimum construction clearances.
- Provide the following excavation safety measures, either of the following methods are approved to provide sufficient safety for unattended excavations:
  - Guardrails:**
    - Guardrails shall be provided to surround unattended excavations of Railroad right-of-way per OSHA Standard Number 1926.502 as follows:
      - The guardrail height shall be at least 42 inches above the walking surface.
      - The smallest dimension for openings in the guardrail shall be no greater than 19 inches.
      - Guardrails systems shall be capable of withstanding, without failure, a force of at least 200 pounds applied within 2 inches of the top edge, in any outward or downward direction, at any point along the top edge of the guardrail.
  - Steel Plate:**
    - Steel plates may be used to cover unattended, supported, shoring systems.
    - The area shall be surrounded by orange safety fence at an effective distance from excavation edge.

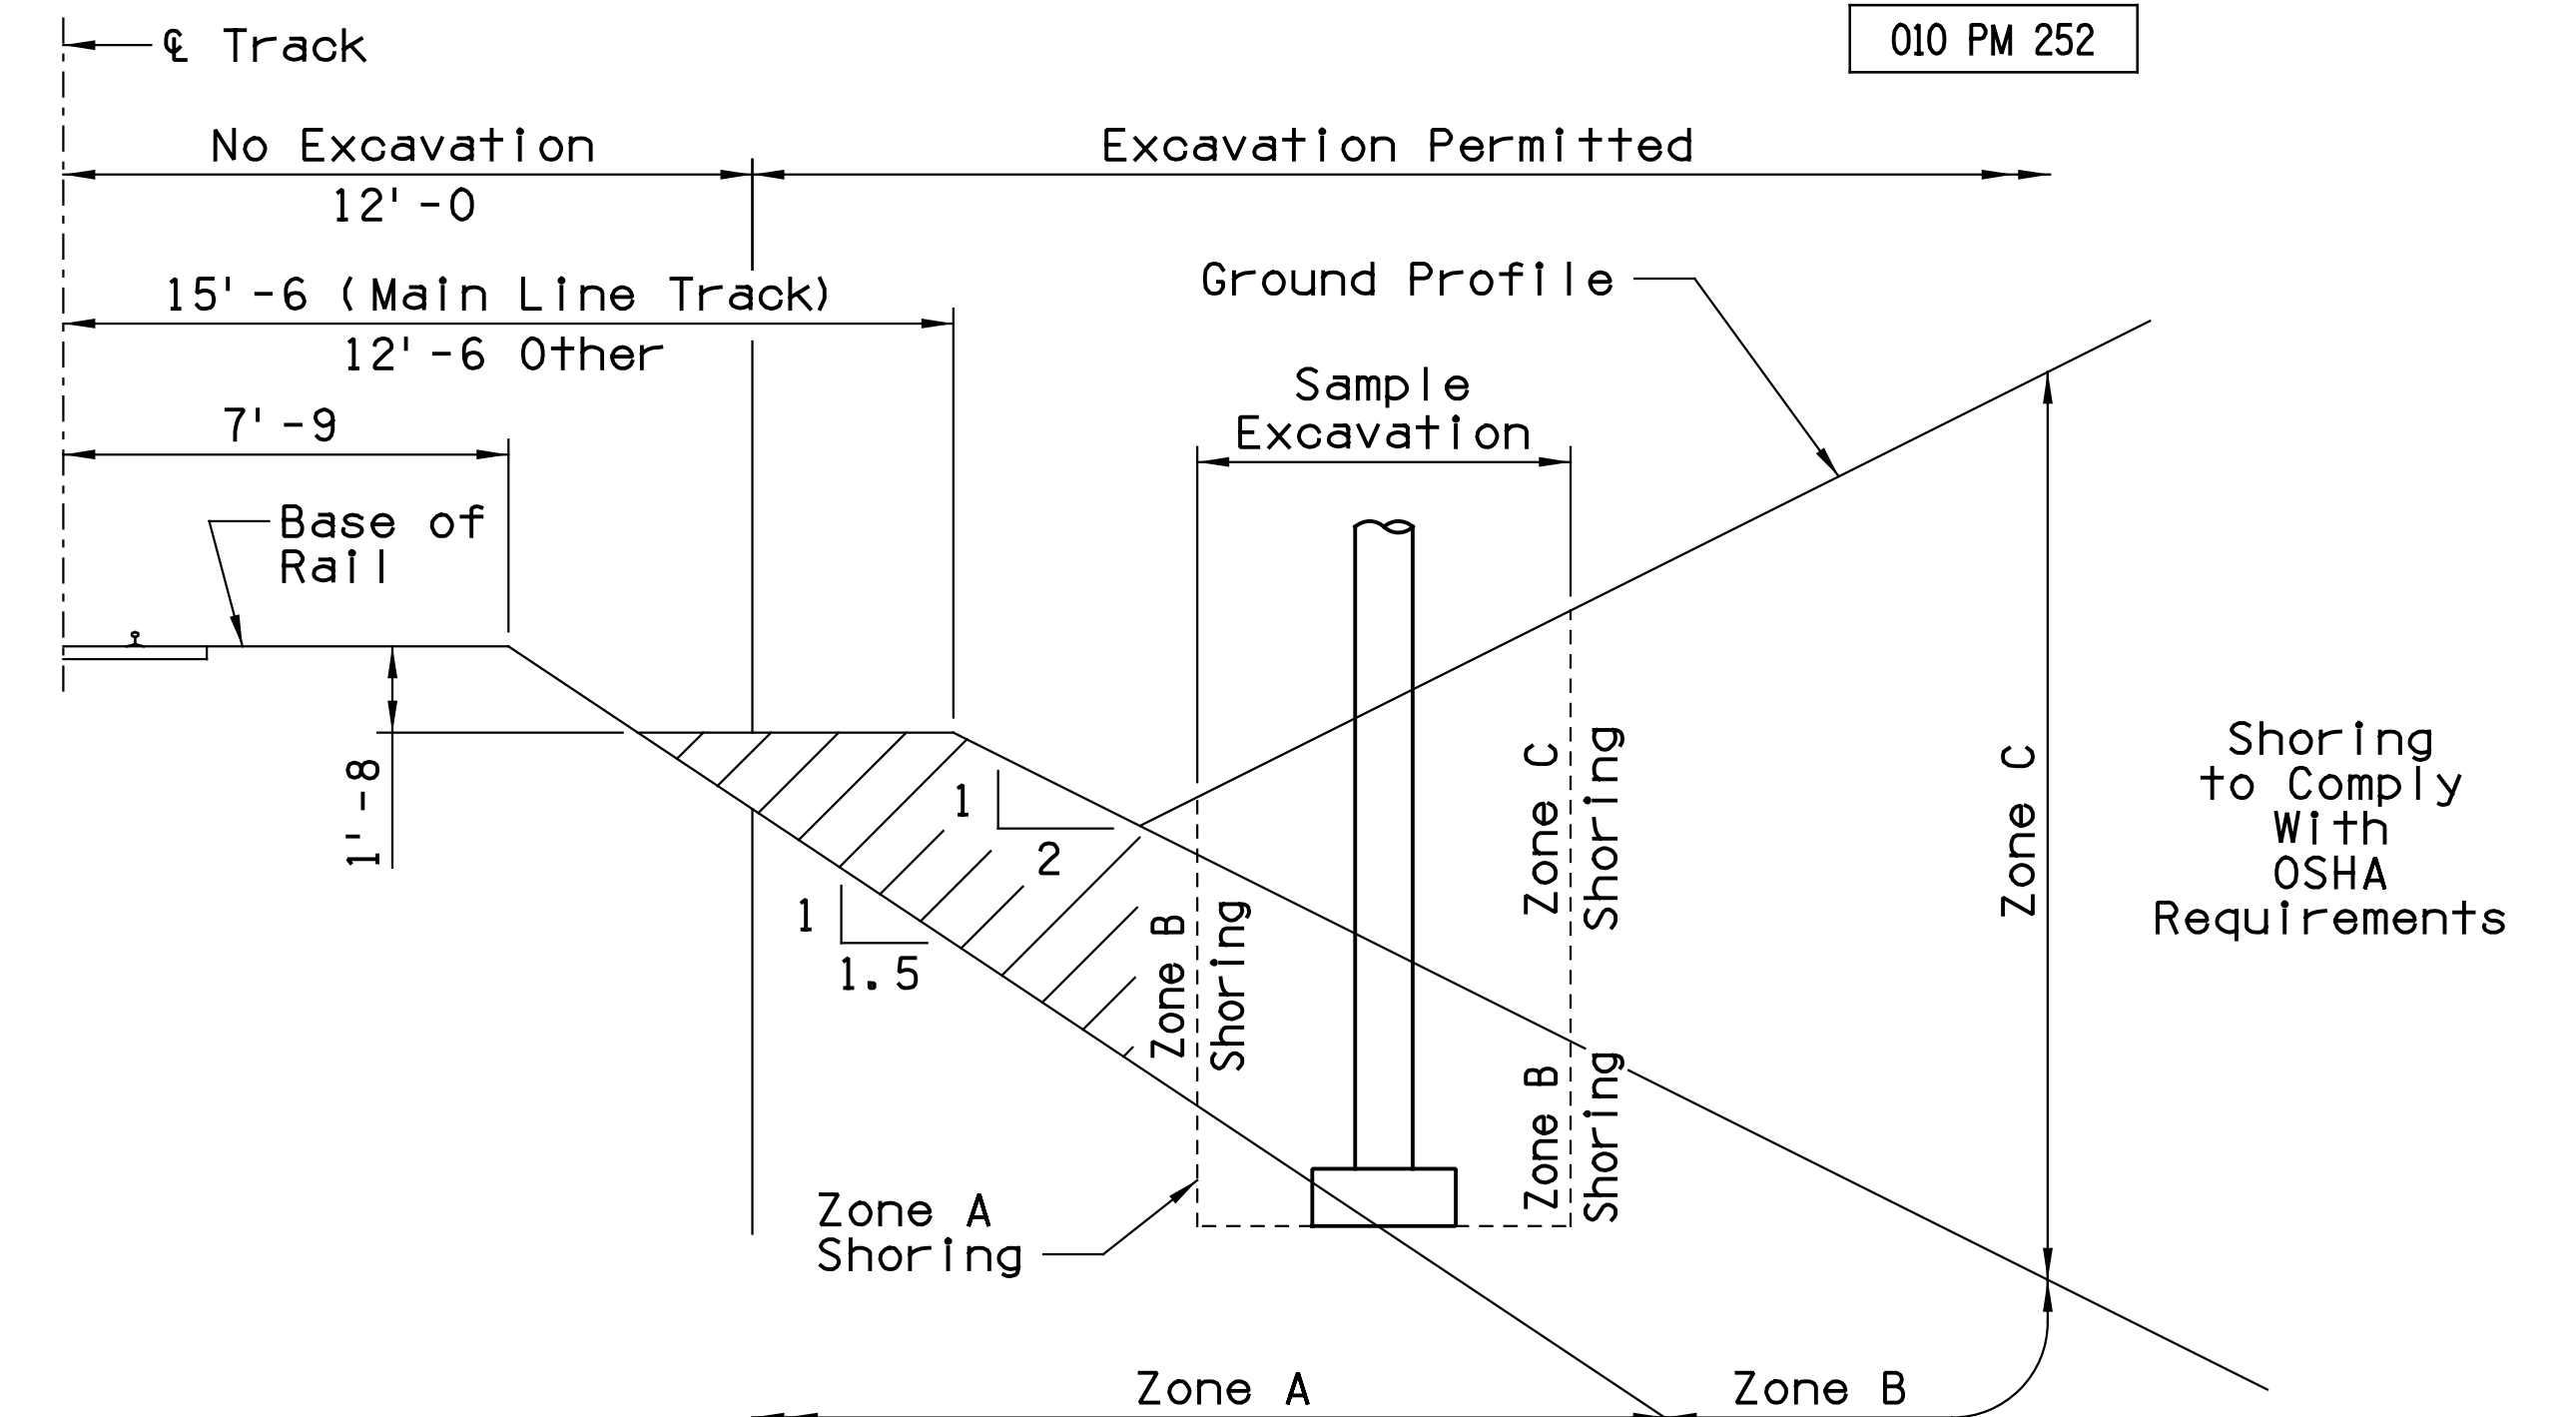

Shoring Must Be Designed for Railroad Live Load Surcharge In Addition to OSHA Standard Loads for Excavation In Zone A. Applicable Railroad Live Load: Cooper E80

Only Vertical Shoring Will Be Permitted for Excavation In Zone B (No Sloping Cuts). Shoring to Comply With OSHA Requirements

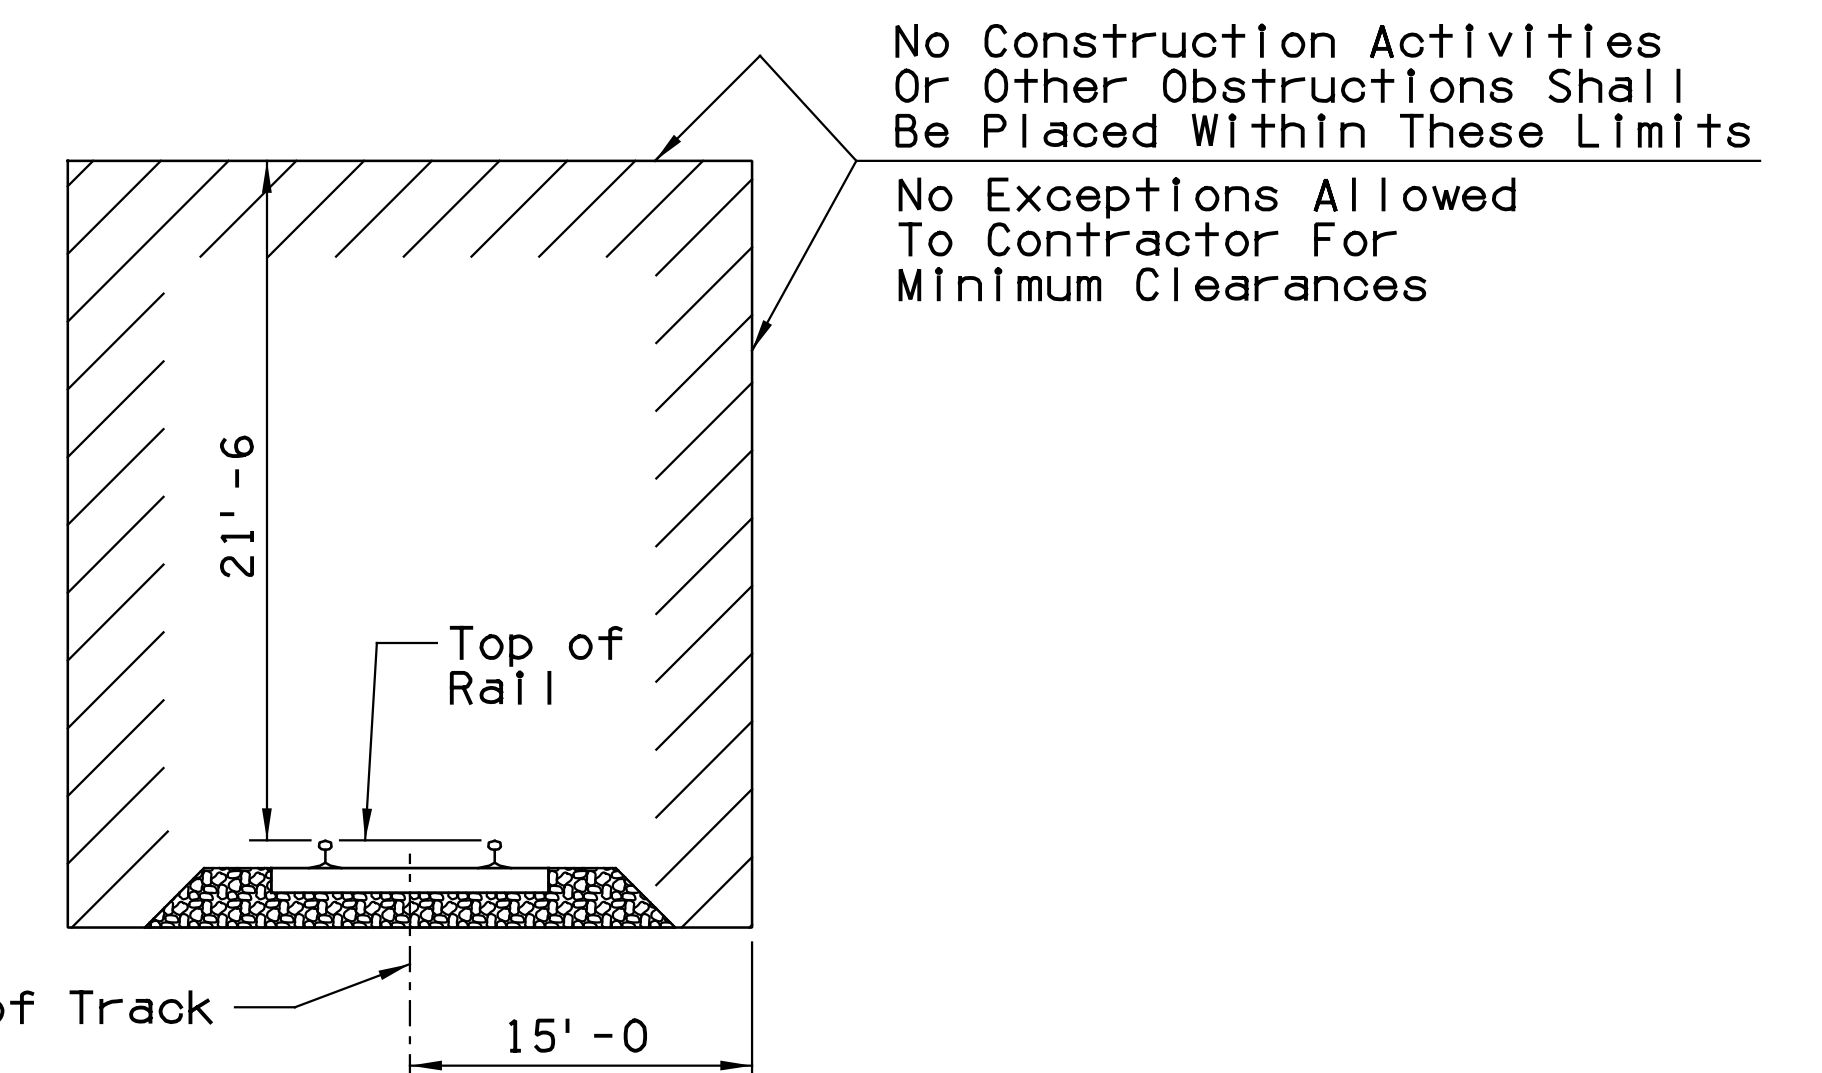

**MINIMUM CONSTRUCTION CLEARANCES**  
(Normal To Railroad)  
(Not To Scale)

No Construction Activities Or Other Obstructions Shall Be Placed Within These Limits

No Exceptions Allowed To Contractor For Minimum Clearances

DESIGN	KLH	DATE	03/19	ARIZONA DEPARTMENT OF TRANSPORTATION INFRASTRUCTURE DELIVERY AND OPERATIONS DIVISION BRIDGE GROUP	
DRAWN	AJM	DATE	03/19		
CHECKED	JRP	DATE	03/19		
<b>TY LIN INTERNATIONAL</b> engineers   planners   scientists 60 E. Rio Salado Parkway, Suite 501 Tempe, Arizona 85281				Sta 103+ <b>RUTHRAUFF RD - UPRR OVERPASS</b> <b>RAILROAD NOTES 1</b>	
I-10	252.000	20160	LOCATION	RUTHRAUFF TI	
ROUTE	MILEPOST	STRUCTURE NO.			
TRACS NO. H8480 01C			010-D(213)S		
					Exp. Press 12/31/2019 DWG. S-2 .06 OF


Plot Driver: ...TYLI PLTRVADOT PDF FULL.plt  
 SURVEY NO. FINISHED PLANS  
 Penable: ...TYLI PLTRVADOT PDF FULL.plt  
 SURVEY NO. FINISHED PLANS  
 LOCATION: ...TYLI PLTRVADOT PDF FULL.plt  
 SURVEY NO. FINISHED PLANS  
 REVISIONS: ...TYLI PLTRVADOT PDF FULL.plt  
 SURVEY NO. FINISHED PLANS  
 DATE: ...TYLI PLTRVADOT PDF FULL.plt  
 SURVEY NO. FINISHED PLANS

F.H.W.A. REGION	STATE	PROJECT NO.	SHEET NO.	TOTAL SHEETS	RECORD DRAWING
9	ARIZ.	010-D(213)S	662	849	

010 PM 252

I-10 Cst Centerline Station	Track Elevations					
	East Track East Rail	East Track West Rail	West Track East Rail	West Track West Rail	Siding East Rail	Siding West Rail
5207+00.00	2249.68	2249.73	2249.63	2249.62	N/A	N/A
5208+00.00	2249.85	2249.82	2249.75	2249.77	N/A	N/A
5209+00.00	2249.88	2249.86	2249.86	2249.82	N/A	N/A
5210+00.00	2249.93	2249.90	2249.93	2249.93	N/A	N/A
5211+00.00	2249.94	2249.96	2249.97	2249.96	N/A	N/A
5212+00.00	2250.03	2250.03	2250.18	2250.07	N/A	N/A
5213+00.00	2250.13	2250.14	2250.16	2250.17	N/A	N/A
5214+00.00	2250.26	2250.26	2250.27	2250.27	N/A	N/A
5215+00.00	2250.36	2250.37	2250.40	2250.37	N/A	N/A
5216+00.00	2250.44	2250.45	2250.45	2250.43	N/A	N/A
5217+00.00	2250.36	2250.38	2250.41	2250.40	N/A	N/A
5218+00.00	2250.39	2250.38	2250.36	2250.36	N/A	N/A
5219+00.00	2250.45	2250.46	2250.46	2250.46	N/A	N/A
5220+00.00	2250.51	2250.51	2250.56	2250.55	N/A	N/A
5221+00.00	2250.56	2250.56	2250.59	2250.57	N/A	N/A
5222+00.00	2250.68	2250.71	2250.70	2250.68	2250.67	2250.68
5223+00.00	2250.94	2250.94	2250.85	2250.87	2251.01	2250.96
5224+00.00	2251.12	2251.11	2251.05	2251.05	2251.01	2250.99
5225+00.00	2251.28	2251.24	2251.24	2251.22	2251.02	2251.00
5226+00.00	2251.46	2251.45	2251.43	2251.42	2251.18	2251.16
5227+00.00	2251.72	2251.74	2251.70	2251.73	2251.39	2251.39
5228+00.00	2252.08	2252.08	2252.00	2252.00	2251.68	2251.77
5229+00.00	2252.44	2252.47	2252.36	2252.34	2252.01	2252.07
5230+00.00	2252.81	2252.78	2252.68	2252.69	2252.42	2252.40

Stations of Railroad Intersections			
Railroad Tracks	I-10 Cst Centerline Station	I-10 Cst Centerline Offset	Ruthrauff Road Cst Centerline Station
West Track West Rail	5219+05.70	324.15' Lt	103+91.93
West Track East Rail	5219+09.44	328.82' Lt	103+97.91
East Track West Rail	5219+20.91	343.13' Lt	104+16.25
East Track East Rail	5219+24.65	347.79' Lt	104+22.23

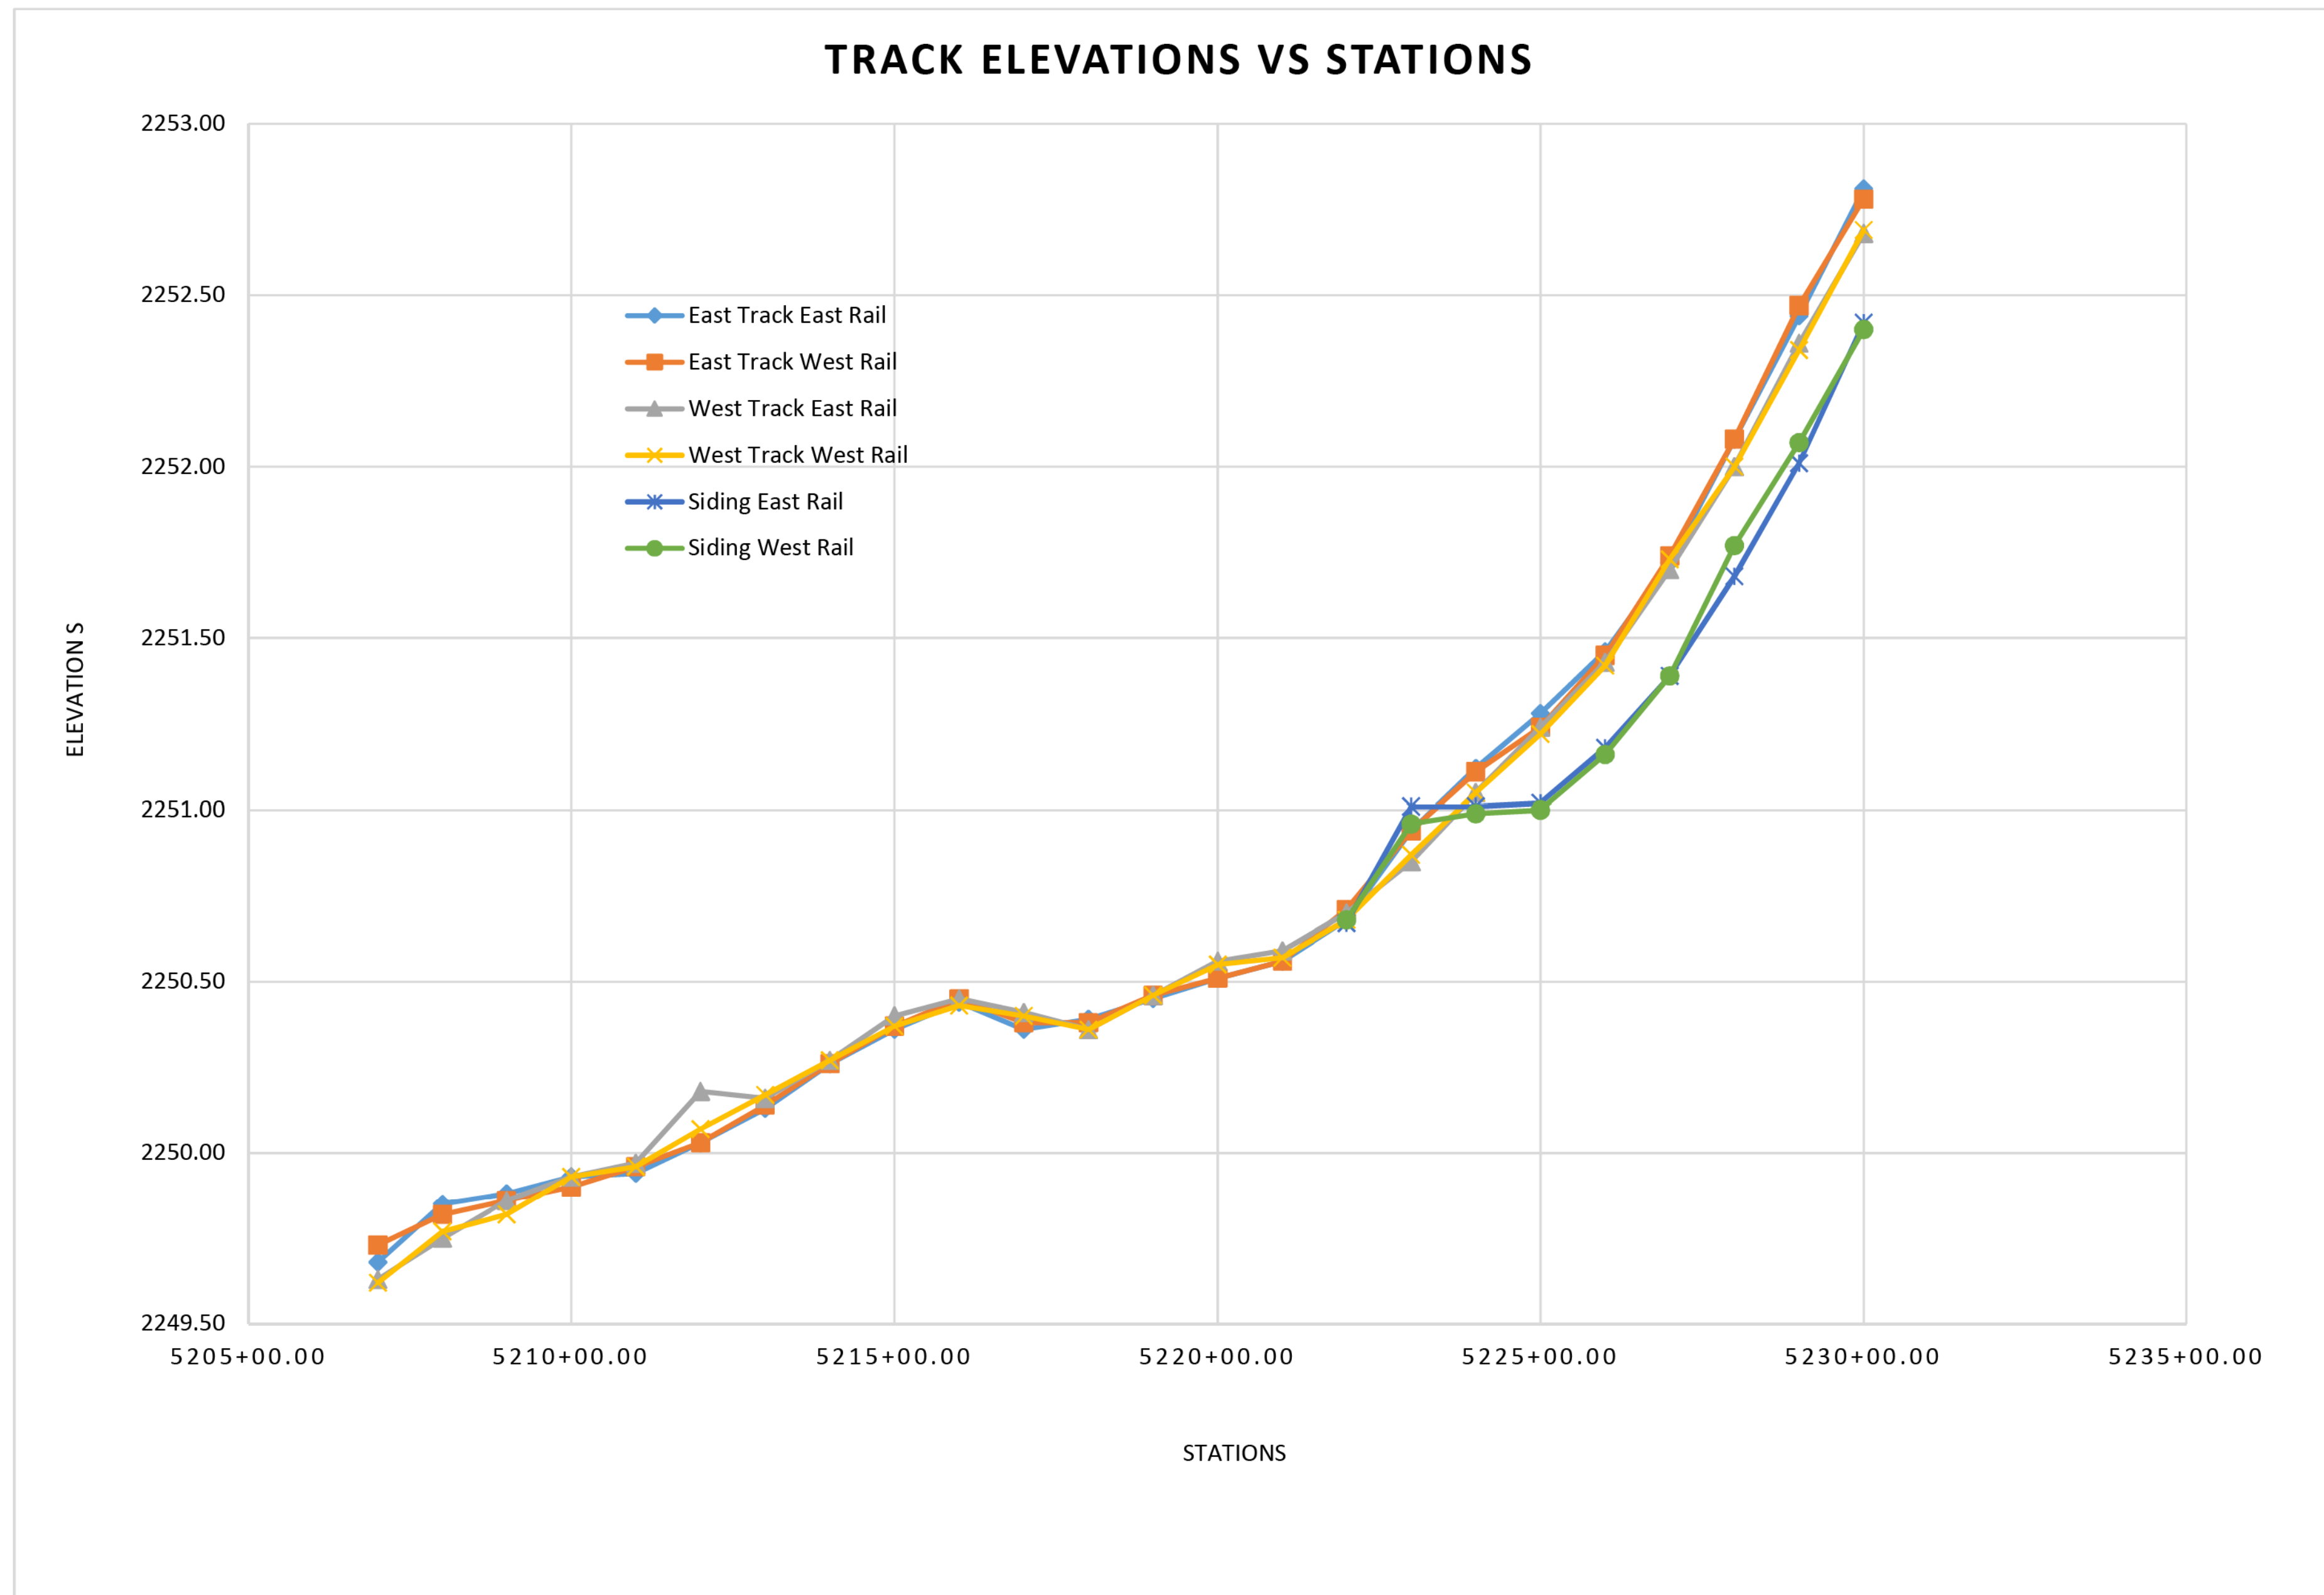

DESIGN	KLH	DATE	03/19	<b>ARIZONA DEPARTMENT OF TRANSPORTATION</b> <b>INFRASTRUCTURE DELIVERY AND OPERATIONS DIVISION</b> <b>BRIDGE GROUP</b> <b>Sta 103+</b> <b>RUTHRAUFF RD - UPRR OVERPASS</b> <b>RAILROAD NOTES 2</b>	
DRAWN	AJM	03/19			
CHECKED	JRP	03/19			
<b>TY LIN INTERNATIONAL</b> engineers   planners   scientists 60 E. Rio Salado Parkway, Suite 501 Tempe, Arizona 85281				LOCATION <b>RUTHRAUFF TI</b>	Express 12/31/2019 DWG. S-2 .07
I-10 ROUTE	252.000	20160	STRUCTURE NO.	TRACS NO. H8480 01C      010-D(213)S <u>OF</u>	

Plot Driver: ...TYLI\PLTDR\ADOT\_PDF\_FULL.plt      Penable: ...TYLI\PLTDR\open\STD\PLT.TBL  
 SURVEY NO.      FINISHED PLANS      DATE-      LOCATION-      REVISIONS-      FINISHED PLANS      SURVEY NO.      DATE-      REVISIONS-      LOCATION-      DATE-













ABUTMENT 2 GIRDER STEP ELEVATION																		
Girder	G1	G2	G3	G4	G5	G6	G7	G8	G9	G10	G11	G12	G13	G14	G15	G16	G17	G18
Elevation	2275.66	2275.75	2275.82	2275.90	2275.98	2276.05	2276.12	2276.19	2276.26	2276.33	2276.37	2276.43	2276.47	2276.44	2276.33	2276.23	2276.12	2276.01
Girder	G19	G20	G21	G22	G23	G24	G25											
Elevation	2275.90	2275.79	2275.68	2275.56	2275.45	2275.33	2275.21											

F.H.W.A. REGION	STATE	PROJECT NO.	SHEET NO.	TOTAL SHEETS	RECORD DRAWING
9	ARIZ.	010-D(213)S	666	849	


010 PM 252

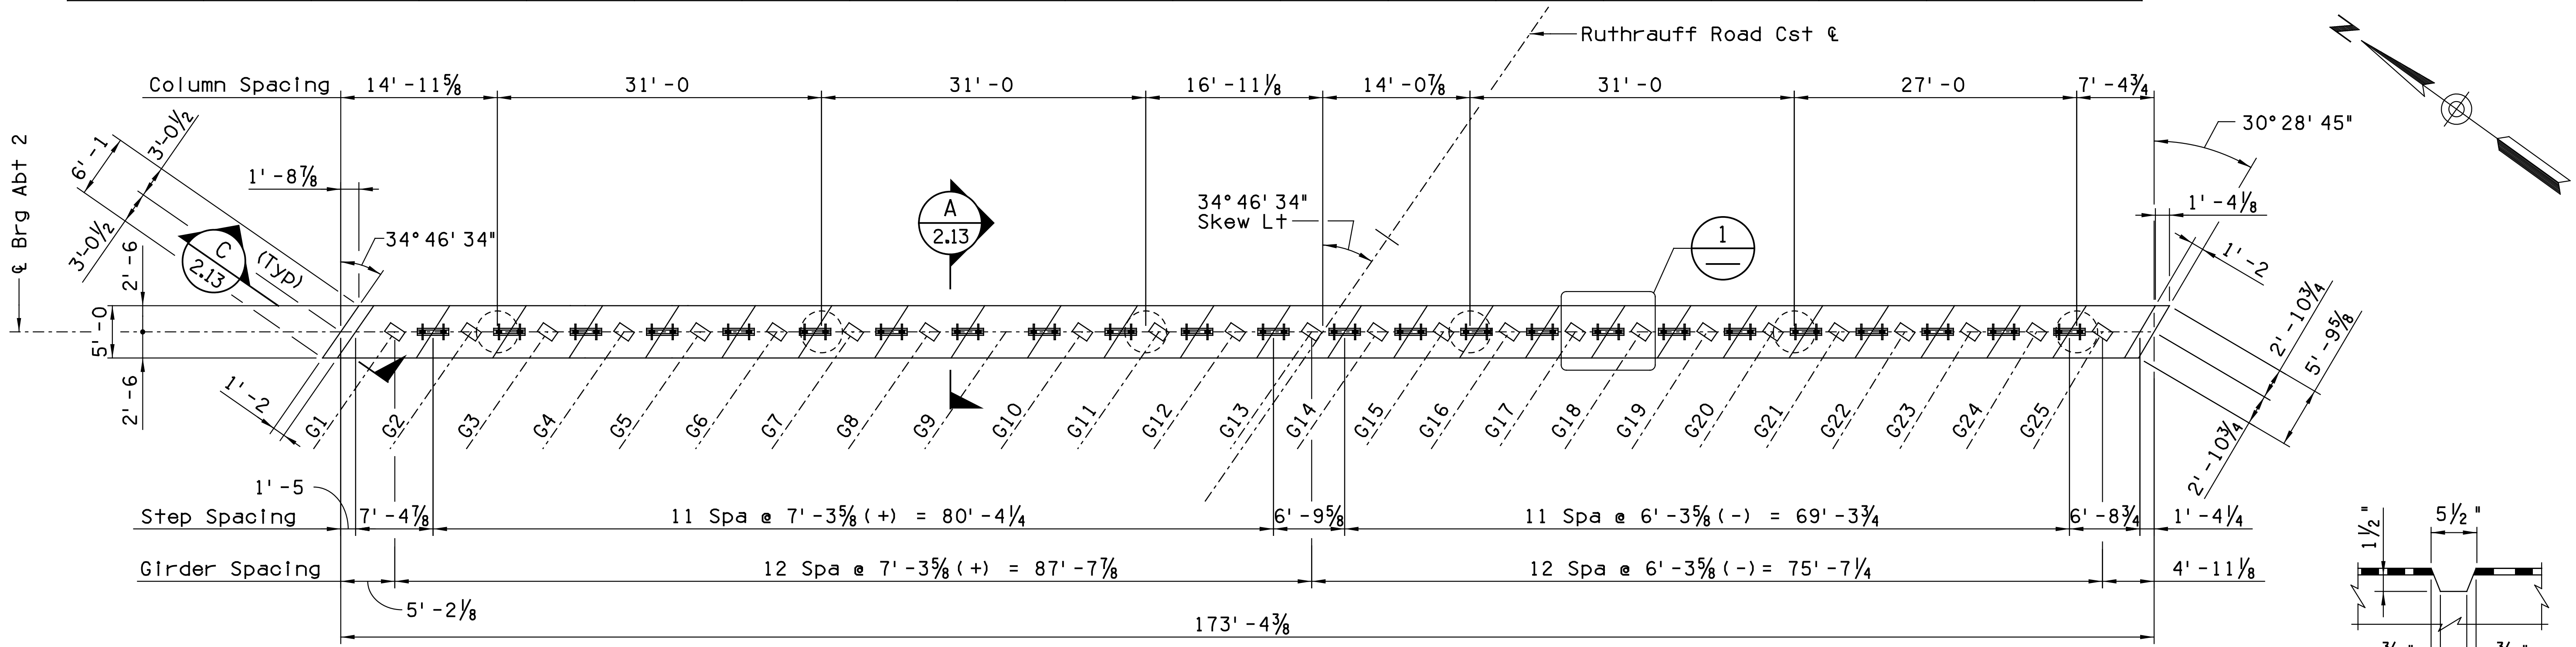

ABUTMENT 2 PLAN  
Scale: 1/8" = 1'-0"

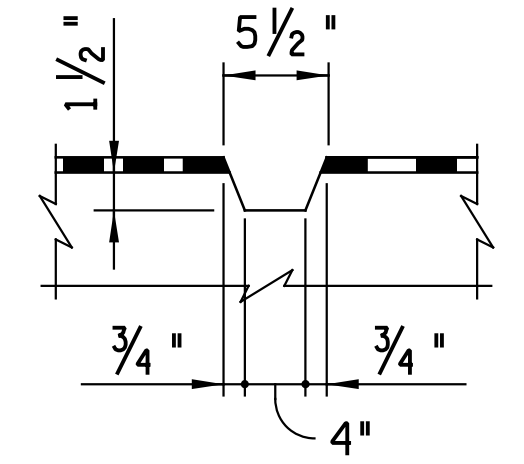


SHEAR KEY DETAIL  
Not to Scale

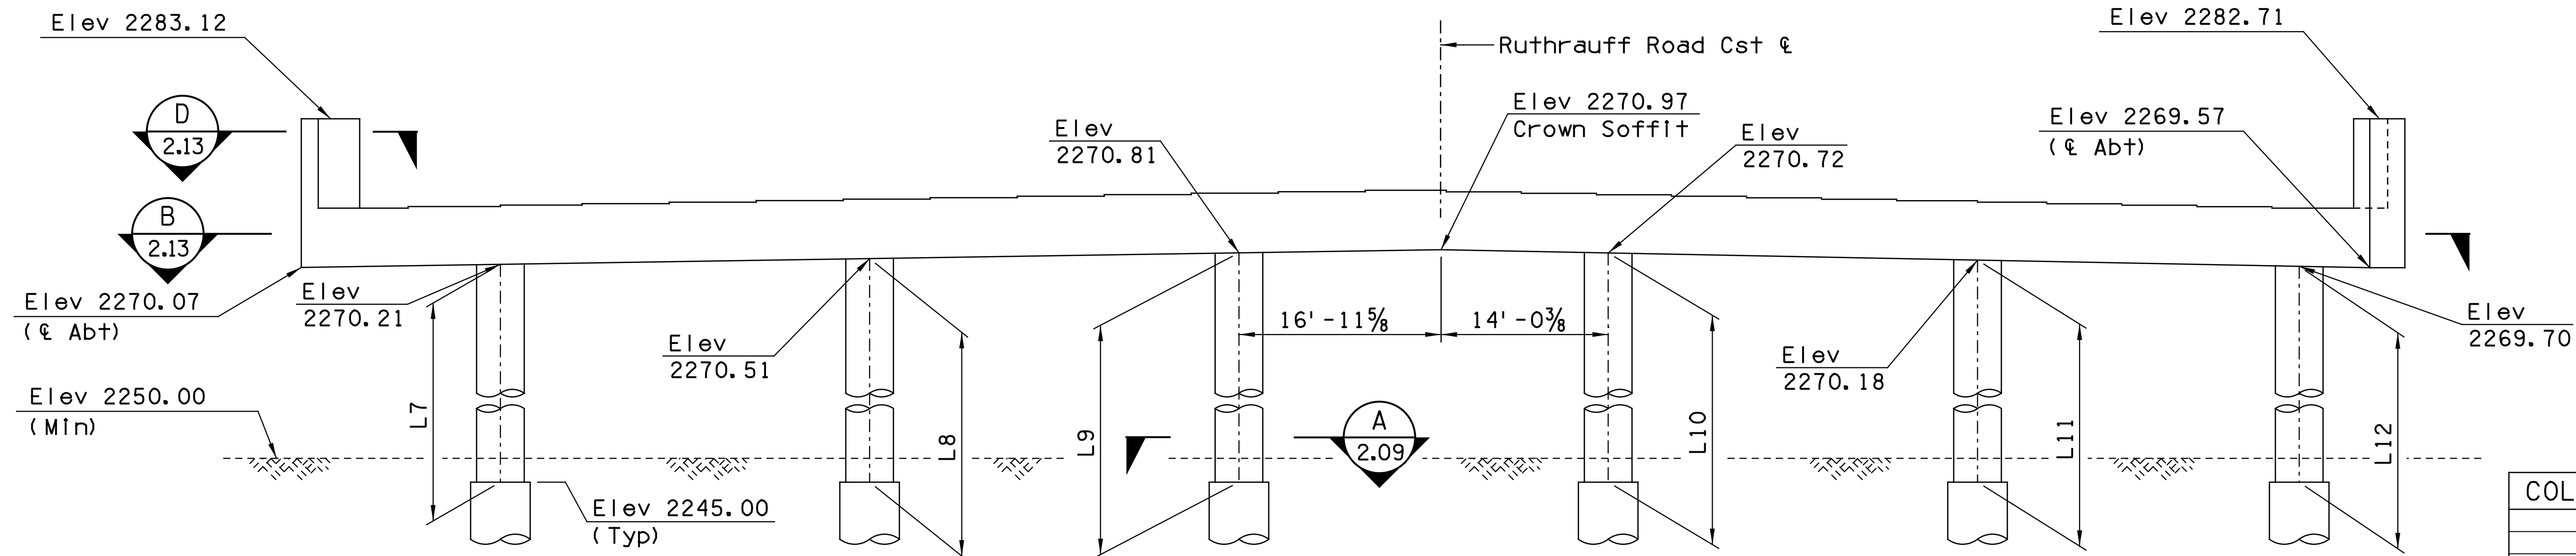

ABUTMENT 2 ELEVATION  
(Looking Upstation)  
Scale: 1/8" = 1'-0"

COLUMN LENGTH (FT)	
L7	25.21
L8	25.51
L9	25.81
L10	25.72
L11	25.18
L12	24.70

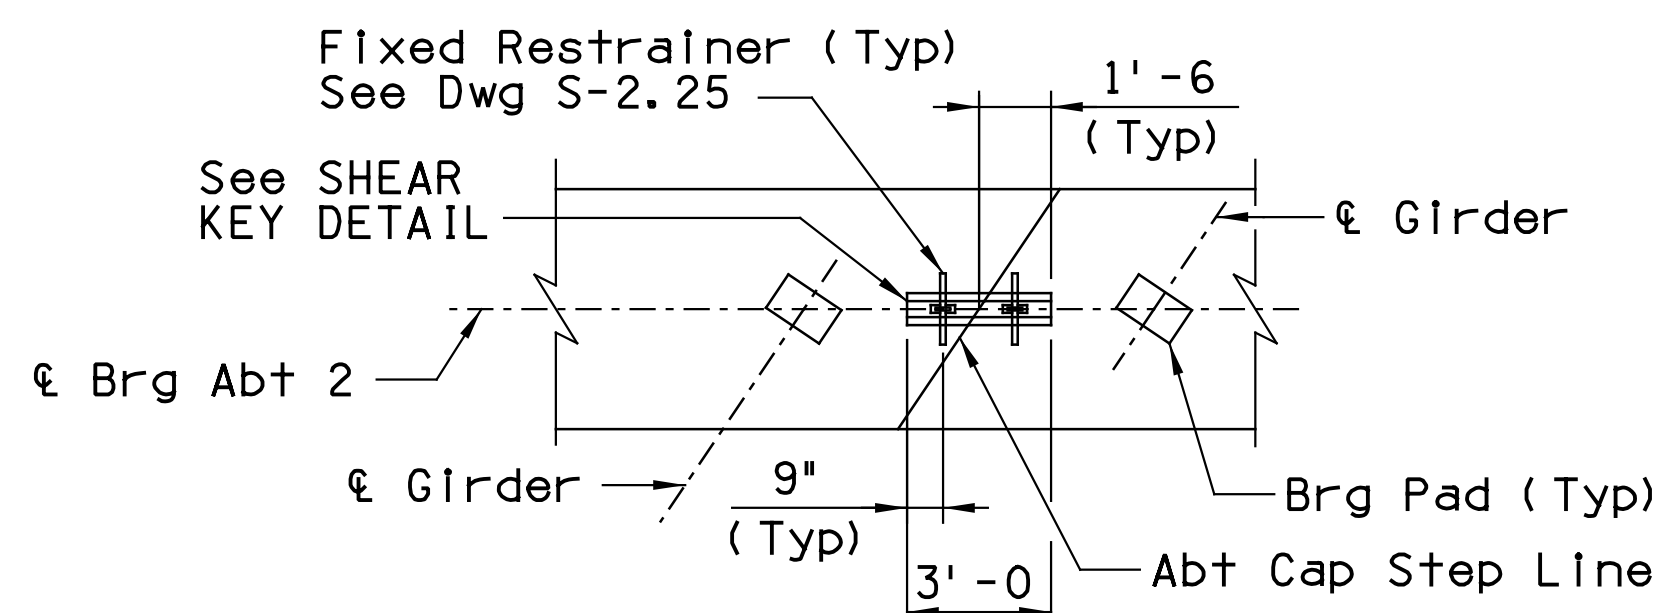


DETAIL 1  
Scale: 1/4" = 1'-0"

NOTES:

1. All dimensions and elevations shown are measured along  $\epsilon$  Brg Abt.
2. The bridge seat elevations shall be verified by the contractor prior to the erection of the girders.


DESIGN	NAME	DATE	ARIZONA DEPARTMENT OF TRANSPORTATION INFRASTRUCTURE DELIVERY AND OPERATIONS DIVISION BRIDGE GROUP
KLH		03/19	
AJM		03/19	
CHECKED	JRP	03/19	
<b>TY LINT INTERNATIONAL</b> <small>engineers   planners   scientists</small> 60 E. Rio Salado Parkway, Suite 501 Tempe, Arizona 85281			<b>RUTHRAUFF RD - UPRR OVERPASS</b> <b>ABUTMENT 2 PLAN &amp; ELEVATION</b>
I-10	252.000	20160	
TRACS NO. H8480 01C			010-D(213)S

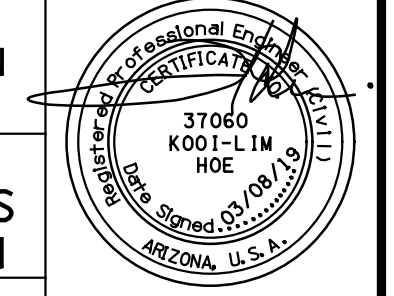


Penable: ...TYLI PLTDRVADOT.PDF FULL.plt  
 SURVEY NO. FINISHED PLANS-  
 REVISIONS-  
 LOCATION-  
 DATE-  
 FINISHED PLANS-  
 SURVEY NO.

F.H.W.A. REGION	STATE	PROJECT NO.	SHEET NO.	TOTAL SHEETS	RECORD DRAWING
9	ARIZ.	010-D(213)S	667	849	


010 PM 252

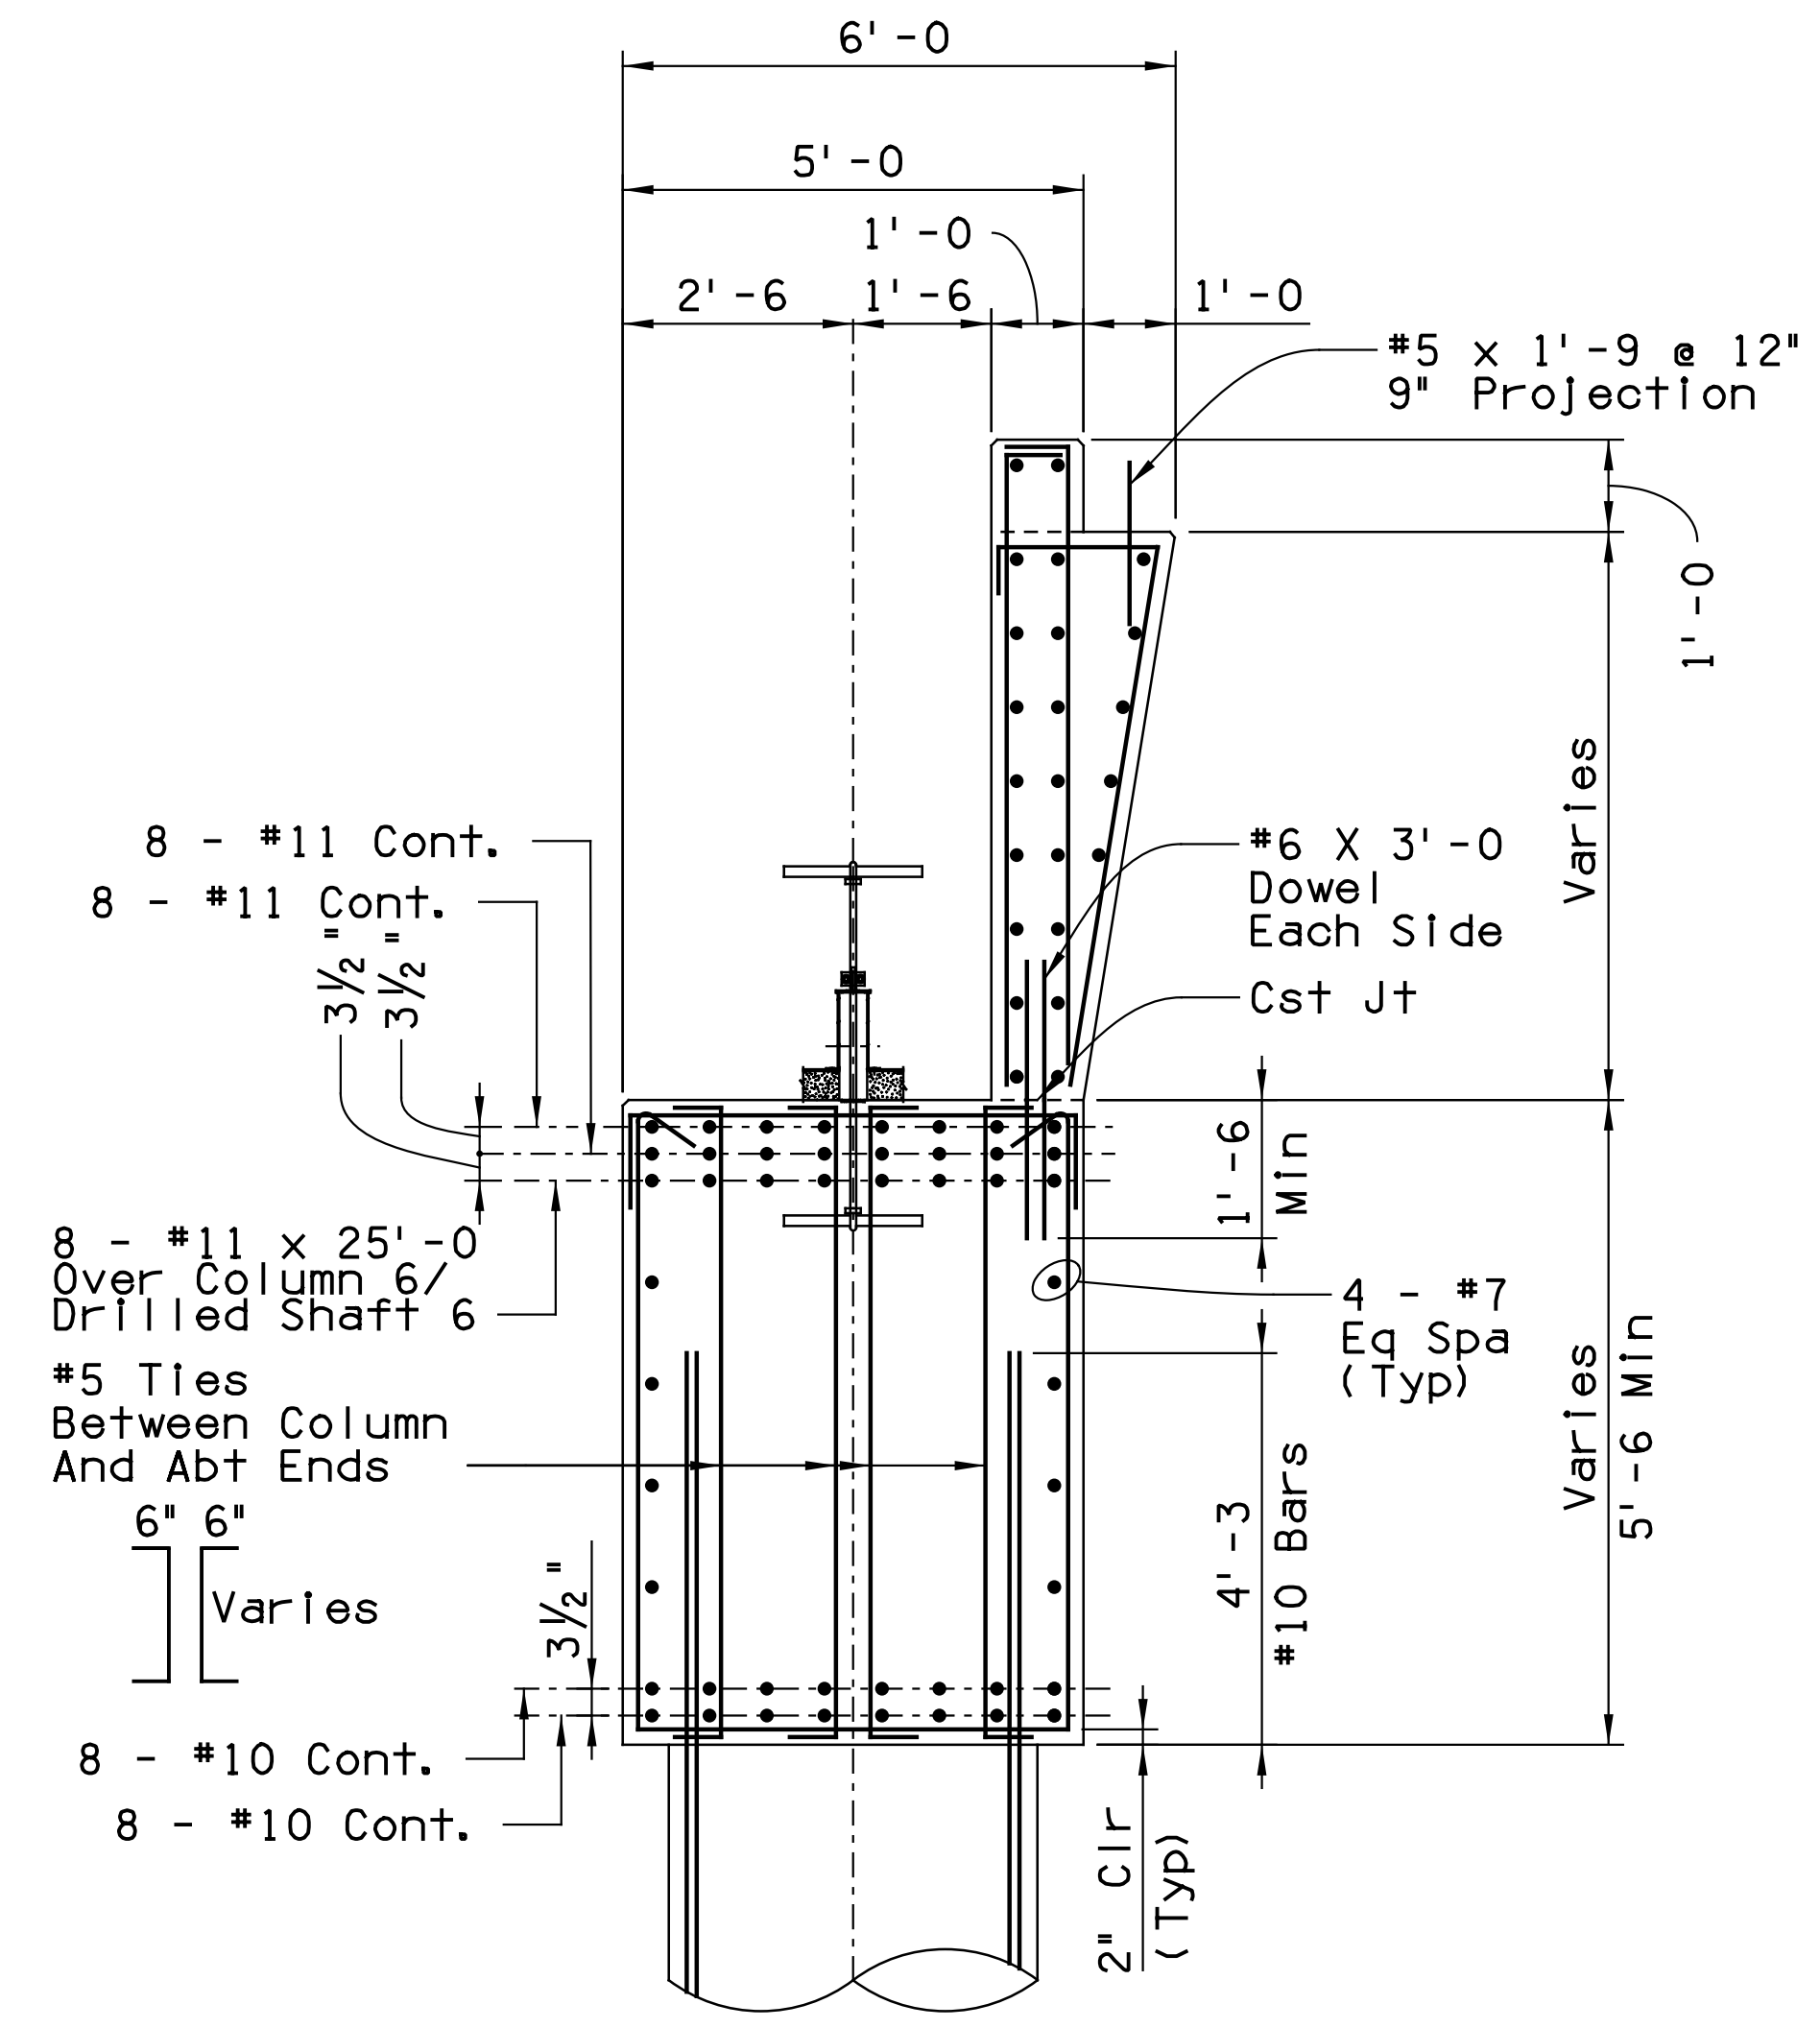


SECTION A  
Scale: 1/2" = 1'-0" (2.10)

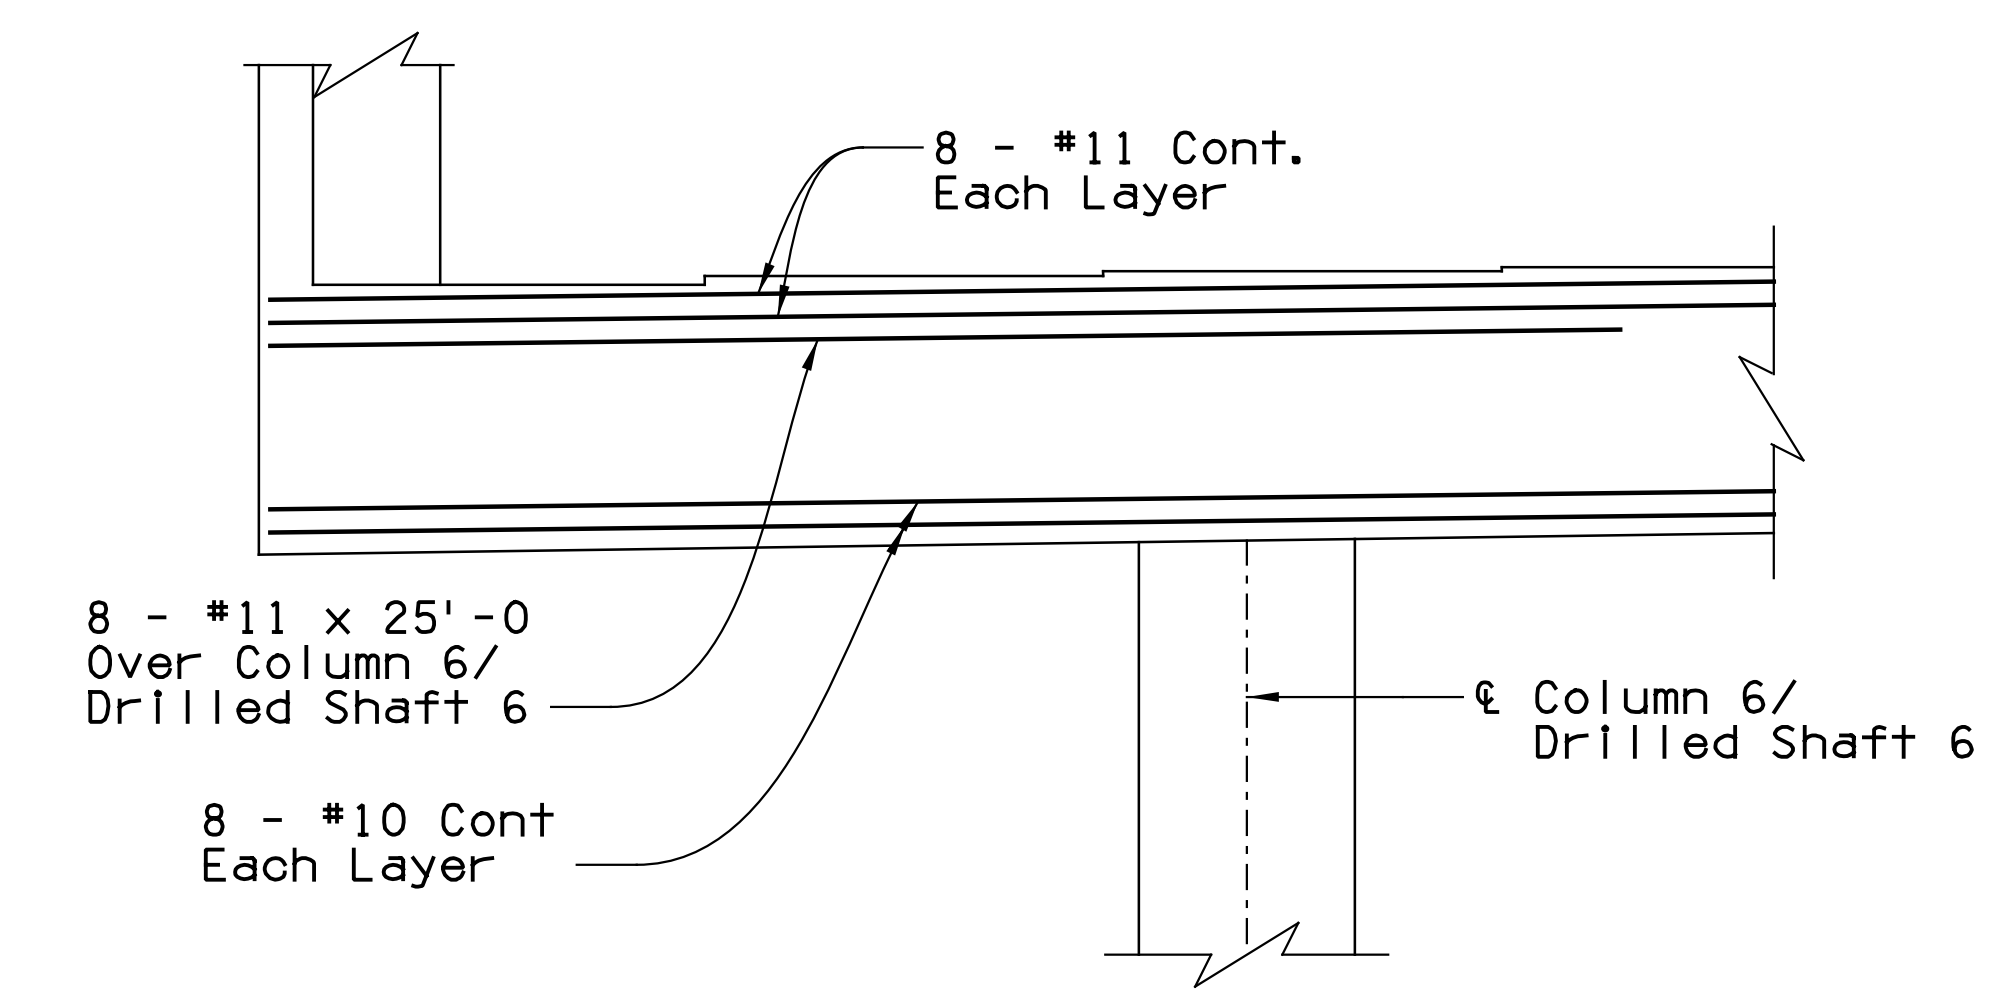

SECTION B  
Scale: 3/8" = 1'-0" (2.10)

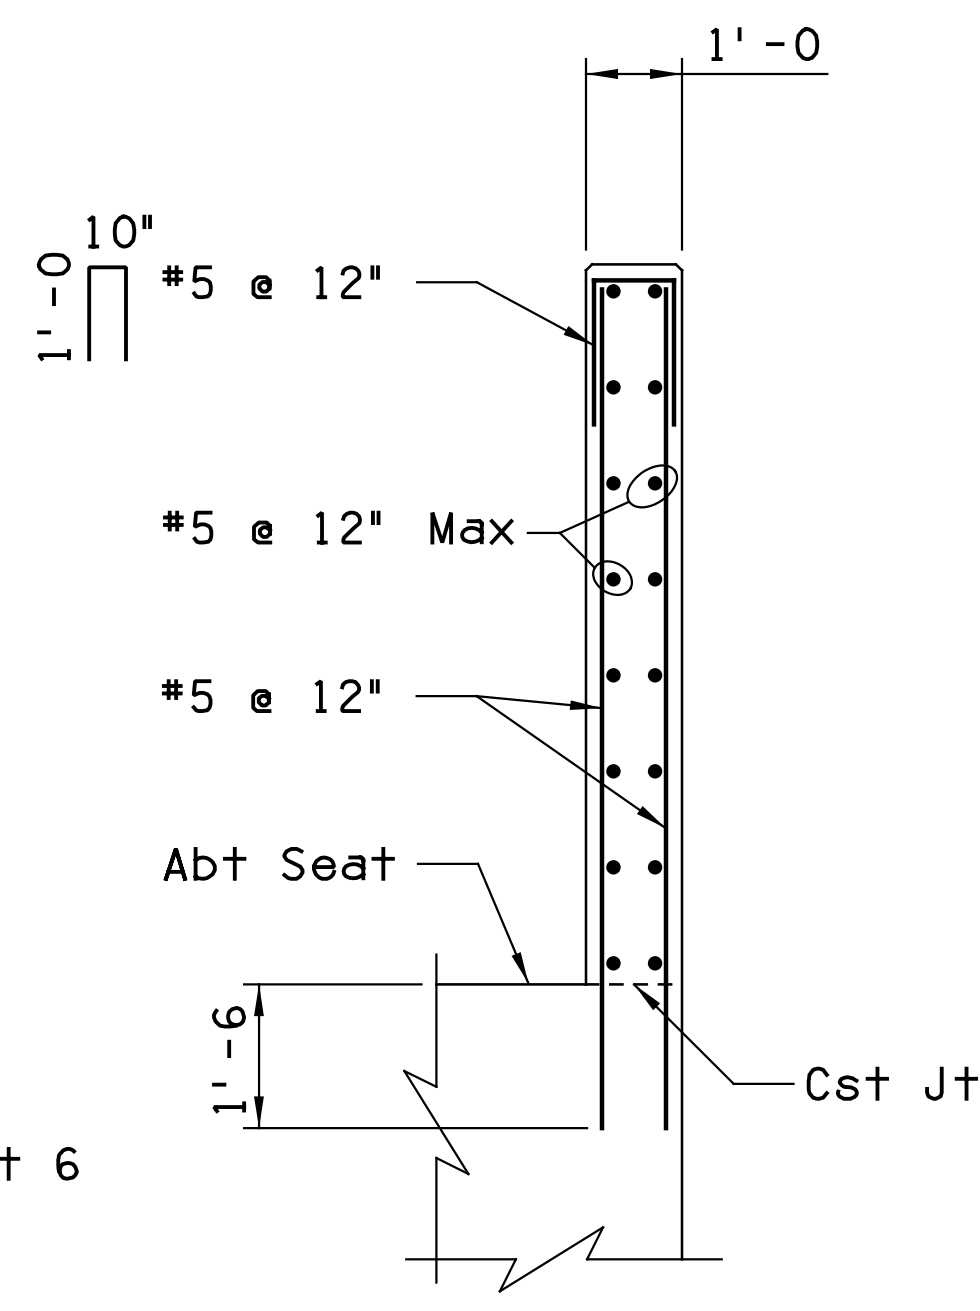

SHEAR BLOCK DETAIL  
Not To Scale

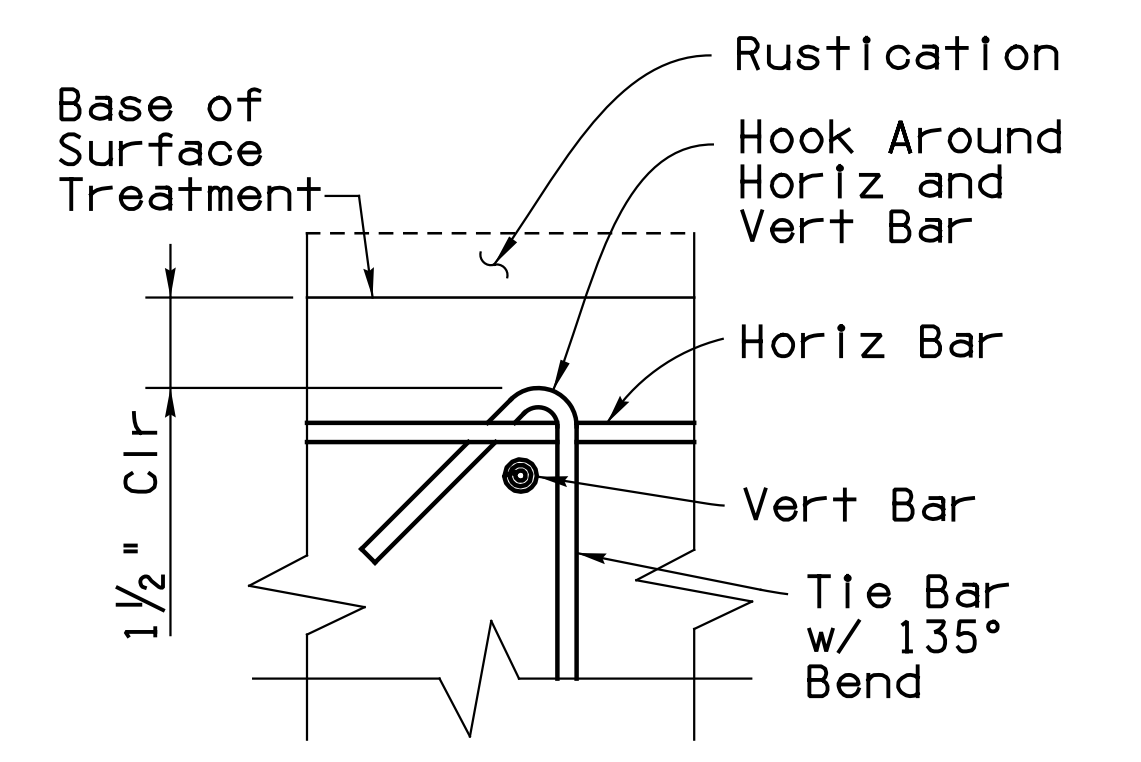

NOTE:  
135° and 90° Hooked Ends shall be Alternated for each Vertical bar per tie layer.  
COLUMN TIE DETAIL  
Not To Scale

- NOTE:  
Minimum lap length of bar splices shall be:
- Non-Staggered Splices
- #11 Bars.....12'-6 (Top Bar)
  - #11 Bars.....9'-0 (Bottom Bar)
  - #10 Bars.....10'-0 (Top Bar)
  - #10 Bars.....7'-6 (Bottom Bar)
  - #7 Bars.....4'-9
- Staggered Splices
- #11 Bars.....9'-6 (Top Bar)
  - #11 Bars.....6'-10 (Bottom Bar)
  - #10 Bars.....7'-9 (Top Bar)
  - #10 Bars.....5'-9 (Bottom Bar)
  - #7 Bars.....3'-9


ABT 1 PARTIAL ELEVATION  
Scale: 1/2" = 1'-0"

DESIGN	KLH	DATE	03/19	ARIZONA DEPARTMENT OF TRANSPORTATION INFRASTRUCTURE DELIVERY AND OPERATIONS DIVISION <b>BRIDGE GROUP</b> Sta 103+ <b>RUTHRAUFF RD - UPRR OVERPASS          ABUTMENT 1 DETAILS</b>	
DRAWN	AJM	DATE	03/19		
CHECKED	JRP	DATE	03/19		
<b>TY-LIN INTERNATIONAL</b> engineers   planners   scientists 60 E. Rio Salado Parkway, Suite 501 Tempe, Arizona 85281				LOCATION <b>RUTHRAUFF T1</b>	Exp Press 12/31/2019 DWG. S-2 .12
ROUTE	252.000	STRUCTURE NO.	20160	TRACS NO. H8480 01C	010-D(213)S



F.H.W.A. REGION	STATE	PROJECT NO.	SHEET NO.	TOTAL SHEETS	RECORD DRAWING
9	ARIZ.	010-D(213)S	668	849	

010 PM 252

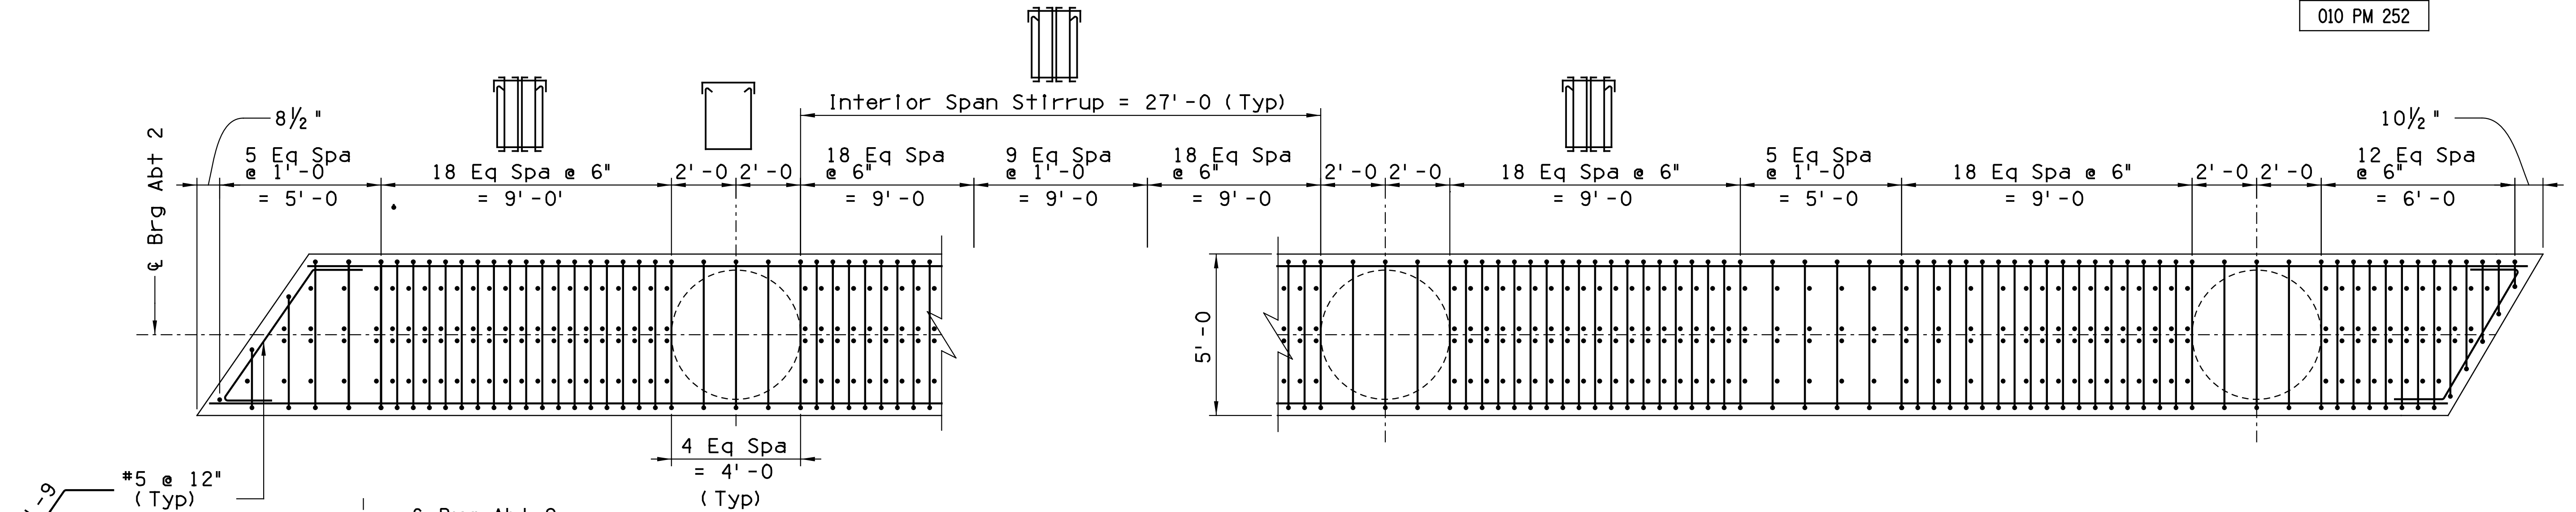


SECTION B  
Scale: 3/8" = 1'-0"

NOTE:


Minimum lap length of bar splices shall be:

- Non-Staggered Splices
- #11 Bars.....12'-6 (Top Bar)
  - #11 Bars.....9'-0 (Bottom Bar)
  - #10 Bars.....10'-0 (Top Bar)
  - #10 Bars.....7'-6 (Bottom Bar)
  - #7 Bars.....4'-9


- Staggered Splices
- #11 Bars.....9'-6 (Top Bar)
  - #11 Bars.....6'-10 (Bottom Bar)
  - #10 Bars.....7'-9 (Top Bar)
  - #10 Bars.....5'-9 (Bottom Bar)
  - #7 Bars.....3'-9

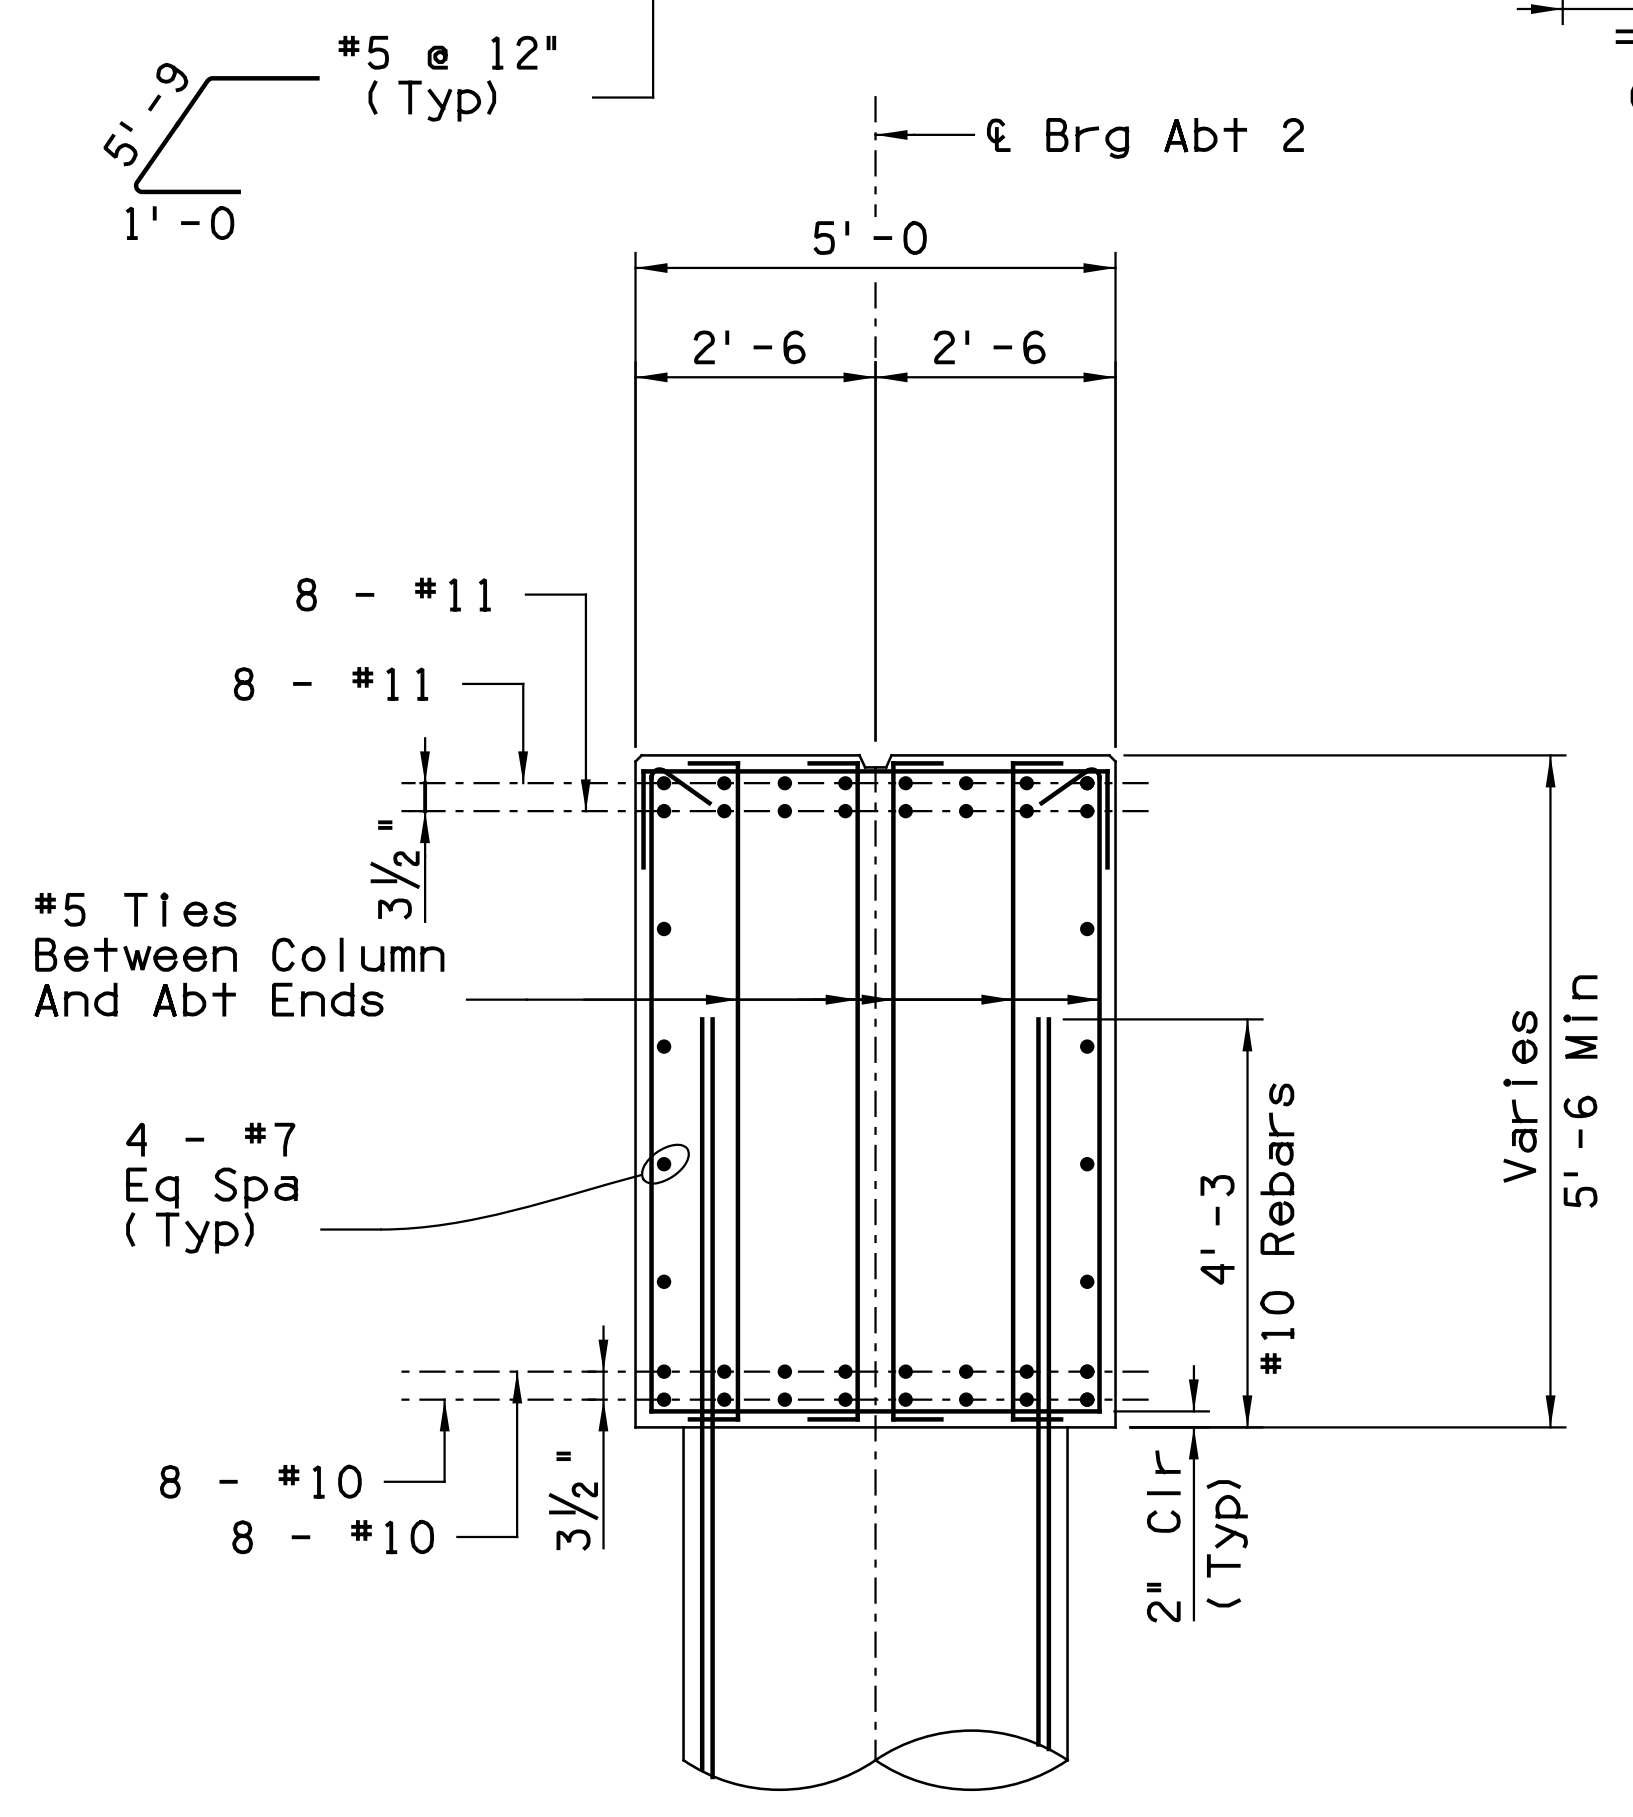

SECTION A  
Scale: 1/2" = 1'-0"

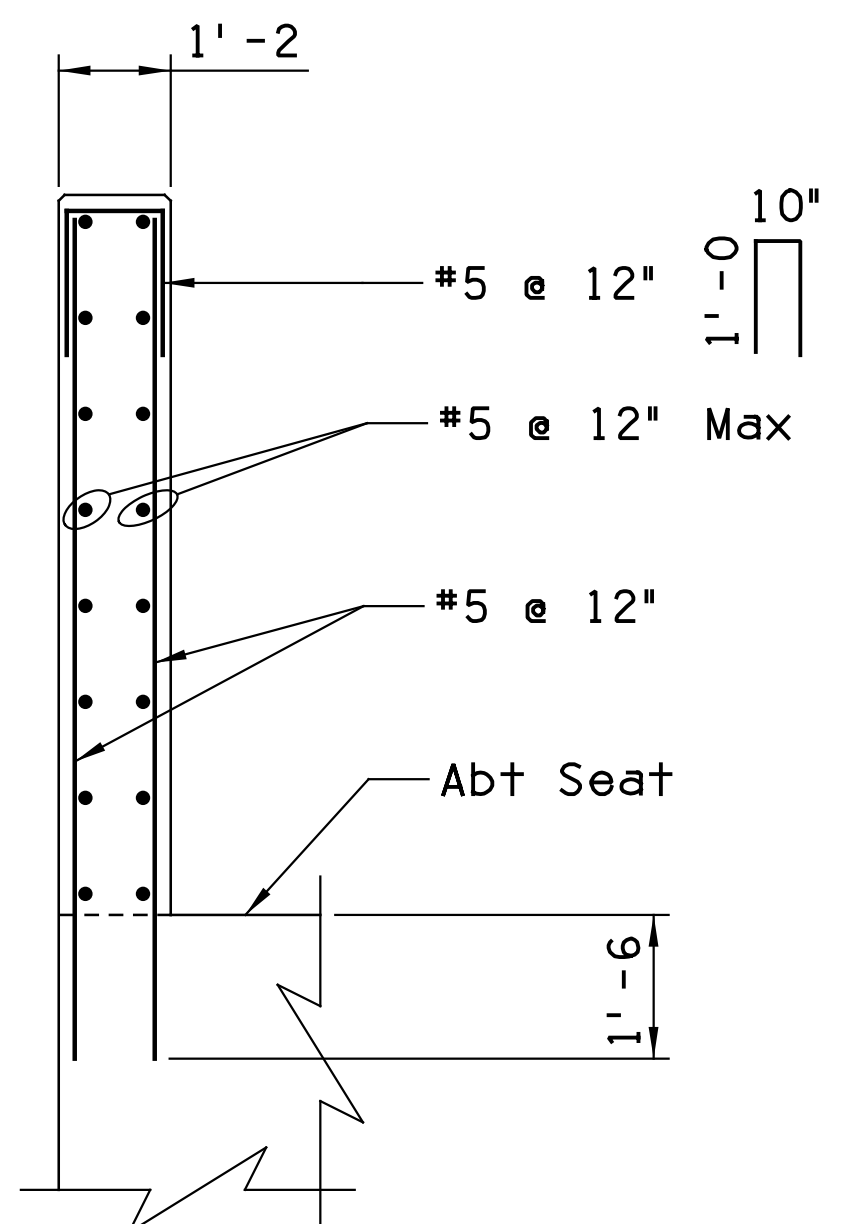

SECTION C  
Scale: 1/2" = 1'-0"

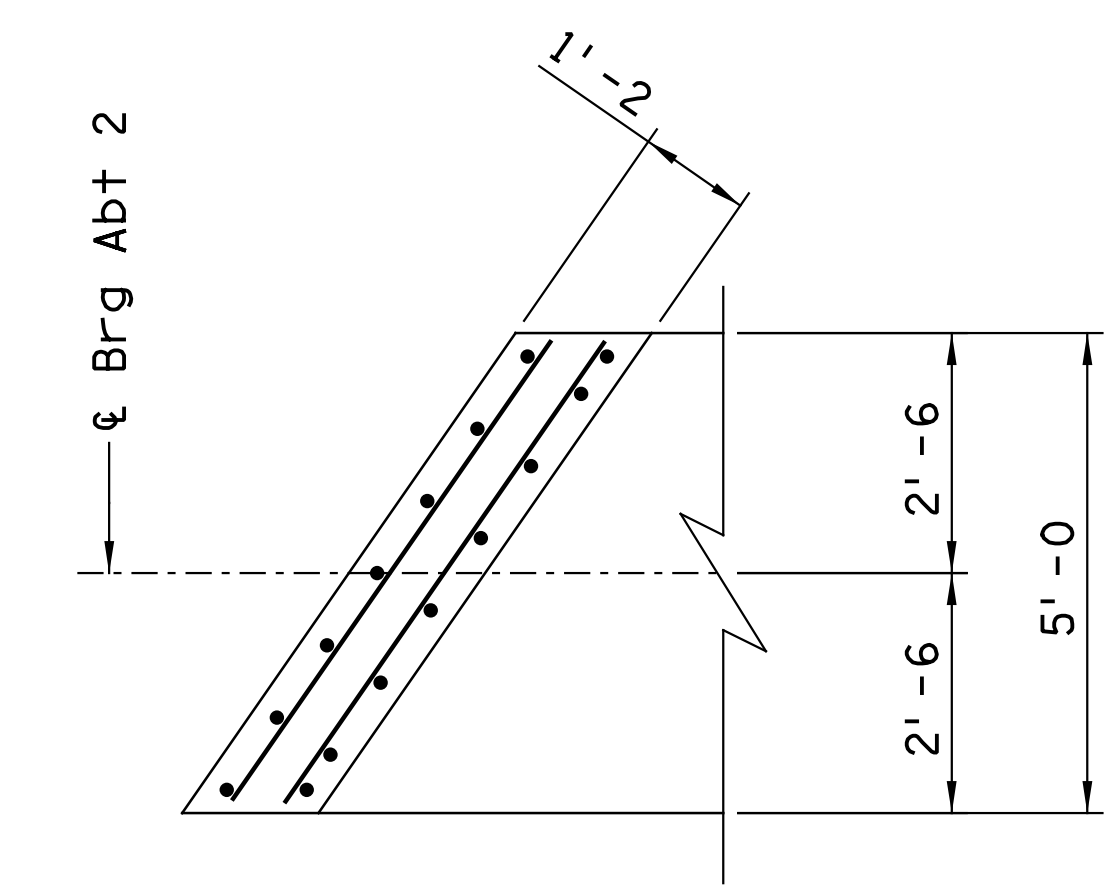


SECTION D  
Scale: 1/2" = 1'-0"

Plot Driver: ...TYLI PLTDRVADOT.PDF FULL.plt  
 SURVEY NO. LOCATION: ...TYLI PLTDRVADOT.PDF FULL.plt  
 FINISHED PLANS-  
 REVISIONS-  
 SURVEY NO. LOCATION: ...TYLI PLTDRVADOT.PDF FULL.plt  
 FINISHED PLANS-  
 REVISIONS-  
 DATE:

DESIGN	KLH	DATE	03/19	ARIZONA DEPARTMENT OF TRANSPORTATION INFRASTRUCTURE DELIVERY AND OPERATIONS DIVISION <b>BRIDGE GROUP</b> Sta 103+ <b>RUTHRAUFF RD - UPRR OVERPASS</b> <b>ABUTMENT 2 DETAILS</b>	
DRAWN	AJM	DATE	03/19		
CHECKED	JRP	DATE	03/19		
<b>TY-LIN INTERNATIONAL</b> engineers   planners   scientists 60 E. Rio Salado Parkway, Suite 501 Tempe, Arizona 85281				LOCATION <b>RUTHRAUFF TI</b>	Expires 12/31/2019 DWG. S-2 .13
I-10	252.000	20160		TRACS NO. H8480 01C	010-D(213)S

F.H.W.A. REGION	STATE	PROJECT NO.	SHEET NO.	TOTAL SHEETS	RECORD DRAWING
9	ARIZ.	010-D(213)S	669	849	

010 PM 252

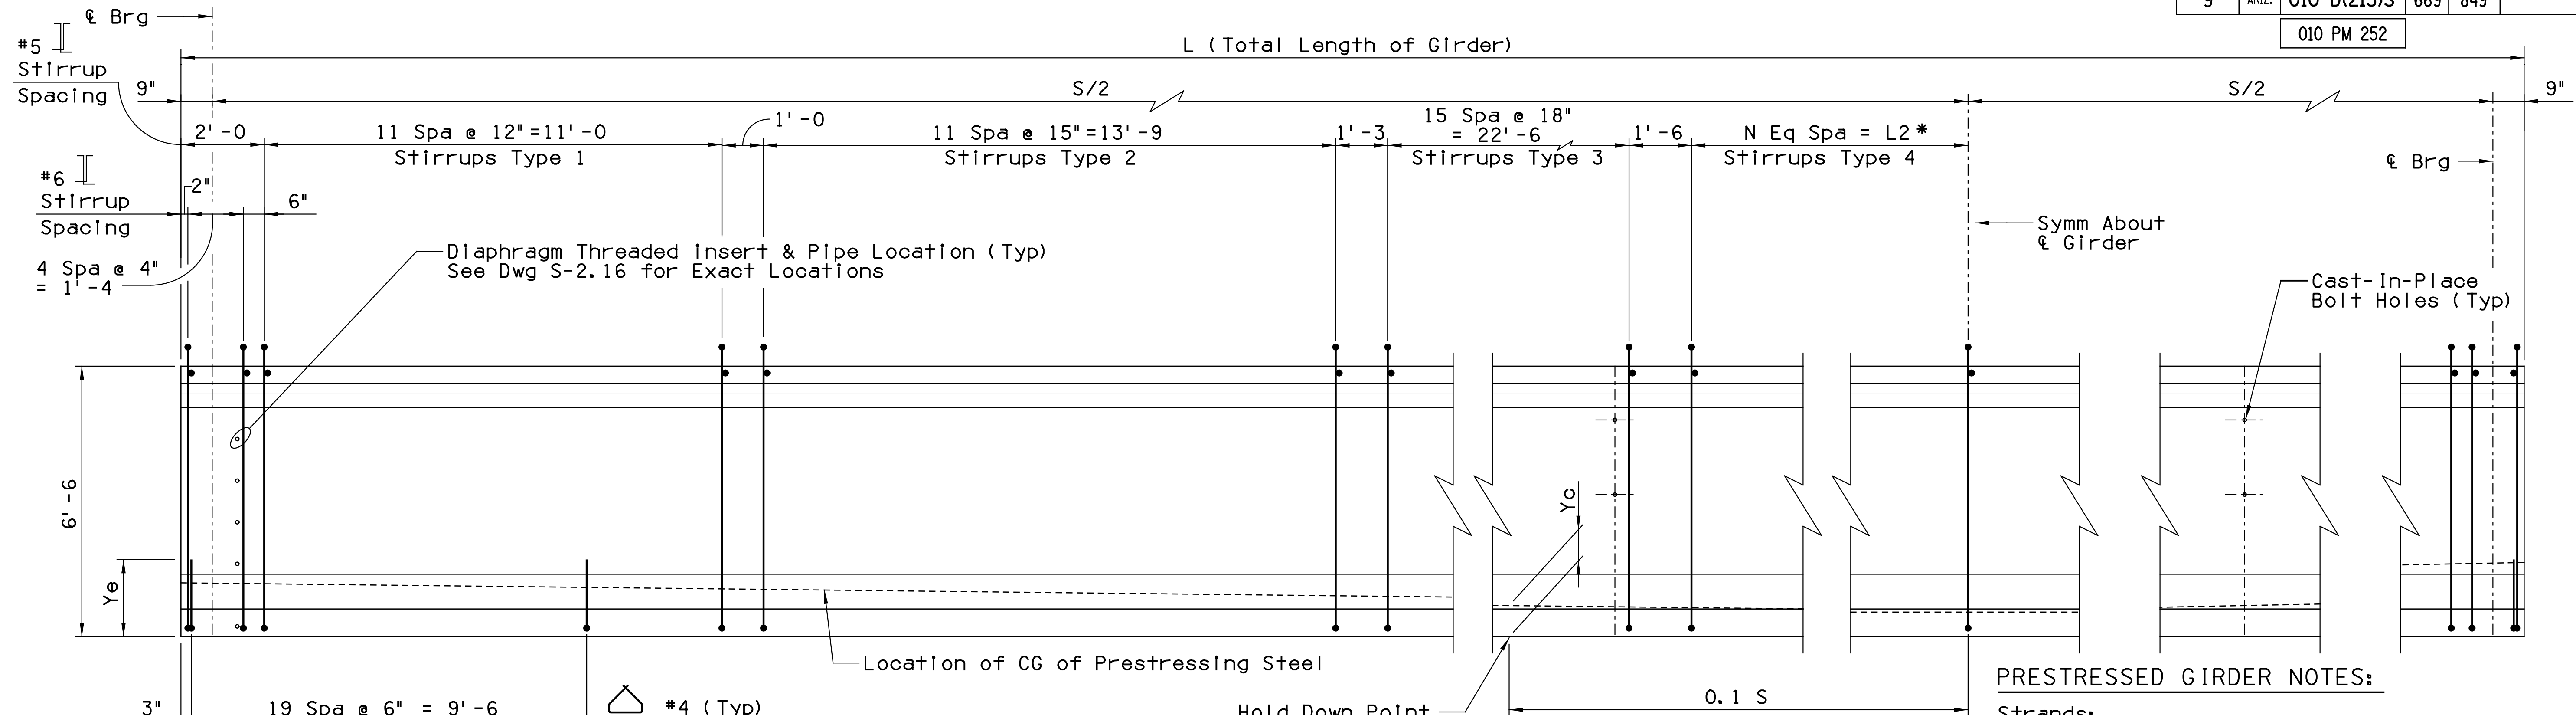

**AASHTO TYPE SUPER VI MODIFIED GIRDER ELEVATION**

Scale: 1/2" = 1'-0"

STIRRUP	
TYPE	H
1	6'-10
2	6'-11 1/2
3	7'-1
4	7'-2

**PRESTRESSED GIRDER NOTES:**

**Strands:**  
 0.6"  $\phi$  ASTM A416 Grade 270 7-wire low relaxation prestressing strand with initial strand tension equal to 43,942 lbs (0.75fpu). fpu = 270 ksi.  
 Nominal area of strand = 0.217 sq. in.  
 The use of masked strands will not be allowed. The minimum spacing for strands is 2" on centers. Approval of the Engineer is required for deviation.


**Prestressing Force:**  
 P<sub>i</sub> = \* kips initial force per girder at release.  
 P<sub>w</sub> = \* kips working force - total force remaining per girder after losses.

**Prestressing:**  
 All girders shall be prestressed by the pretensioning method only.


**Concrete Strength:**  
 f'ci = \* ksi minimum strength at transfer.  
 f'c = \* ksi minimum strength at 28 day.

**Girder Details:**  
 The girder length shown does not include elastic shortening effects. Casting lengths shall be increased as necessary to account for shortening effects. The contact surface of the top flange shall be roughened to a depth of approximately 1/4 inch.


Girder ends shall be cast vertical.  
 \* See Dwg S-2.15.

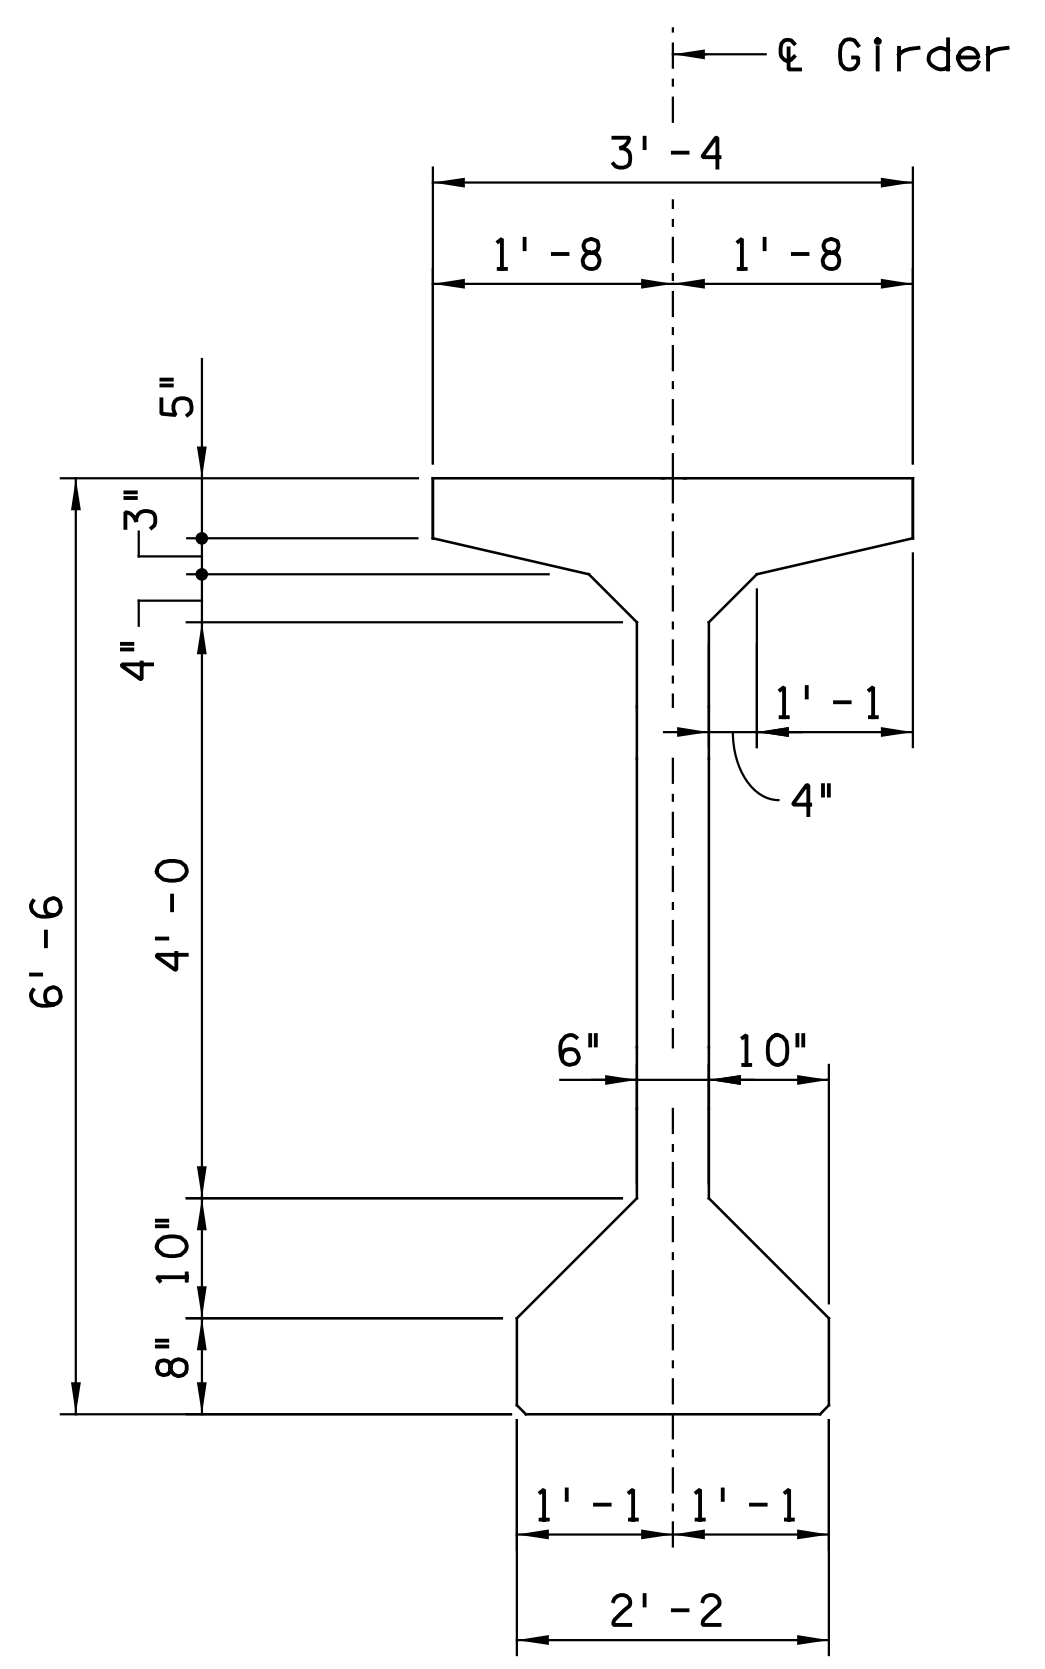

**AASHTO TYPE SUPER VI MODIFIED GIRDER**  
 (0.6"  $\phi$  270 ksi Low Relaxation Strands)  
 Scale: 3/4" = 1'-0"

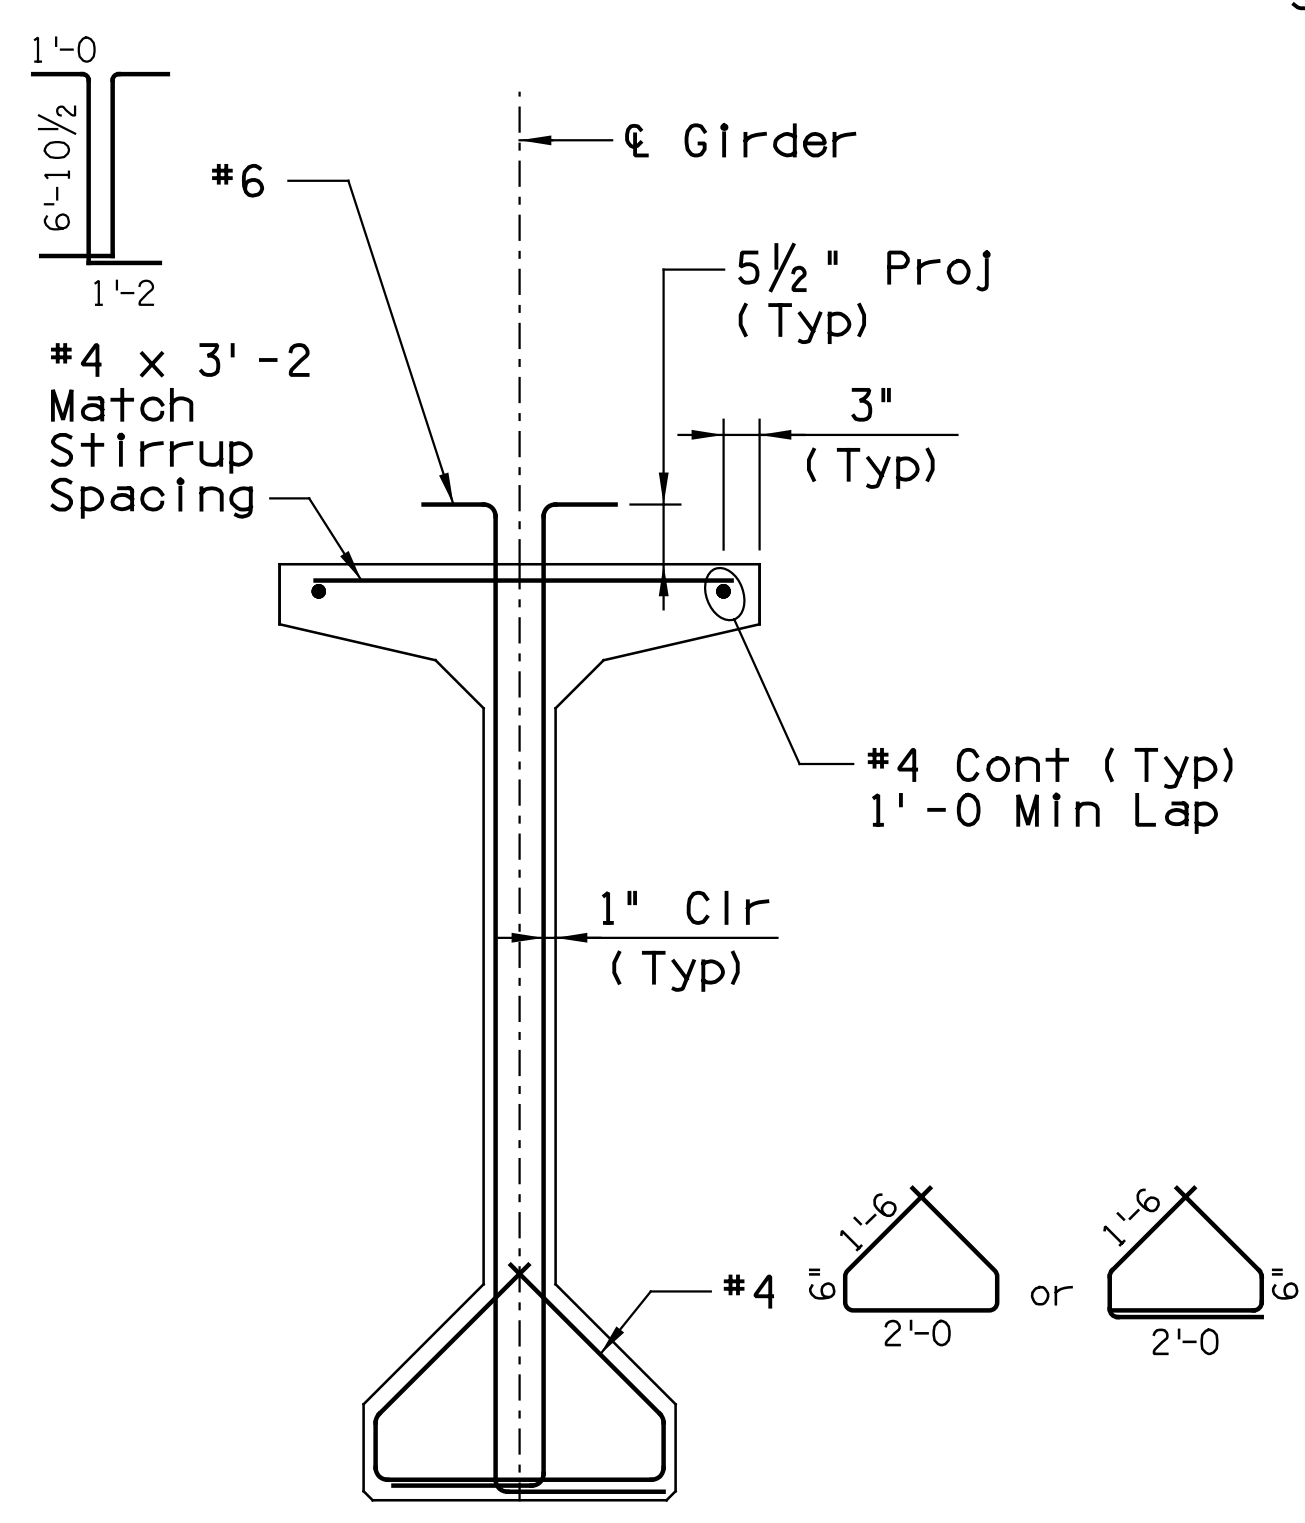

**SECTION THRU END**  
 Scale: 3/4" = 1'-0"

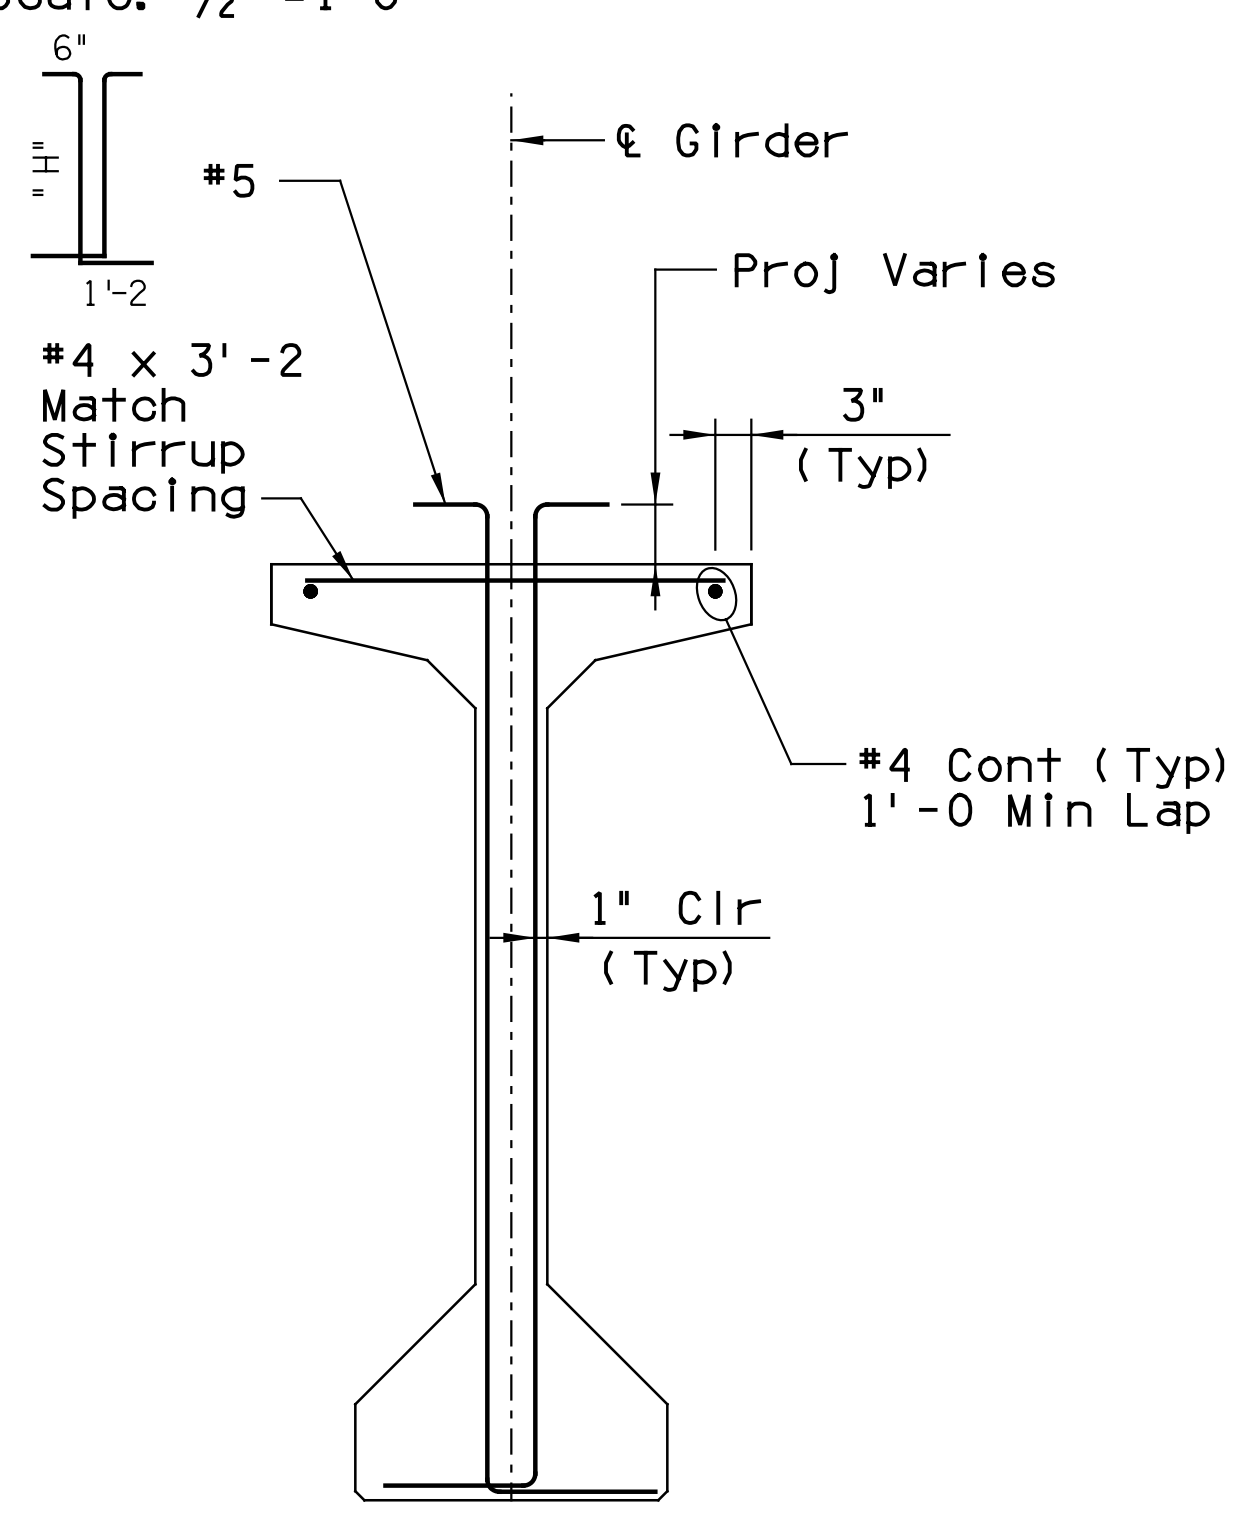


**SECTION THRU MIDSPAN**  
 Scale: 3/4" = 1'-0"


DESIGN	KLH	DATE	03/19	ARIZONA DEPARTMENT OF TRANSPORTATION INFRASTRUCTURE DELIVERY AND OPERATIONS DIVISION <b>BRIDGE GROUP</b> Sta 103+ <b>RUTHRAUFF RD - UPRR OVERPASS          GIRDER DETAILS 1</b>	
DRAWN	AJM	DATE	03/19		
CHECKED	JRP	DATE	03/19		
<b>TY-LIN INTERNATIONAL</b> engineers   planners   scientists 60 E. Rio Salado Parkway, Suite 501 Tempe, Arizona 85281					
ROUTE	252.000	20160	LOCATION		RUTHRAUFF TI
TRACS NO. H8480 01C			010-D(213)S		Exp. Press 12/31/2019 DWG. S-2 .14

F.H.W.A. REGION	STATE	PROJECT NO.	SHEET NO.	TOTAL SHEETS	RECORD DRAWING
9	ARIZ.	010-D(213)S	670	849	


010 PM 252

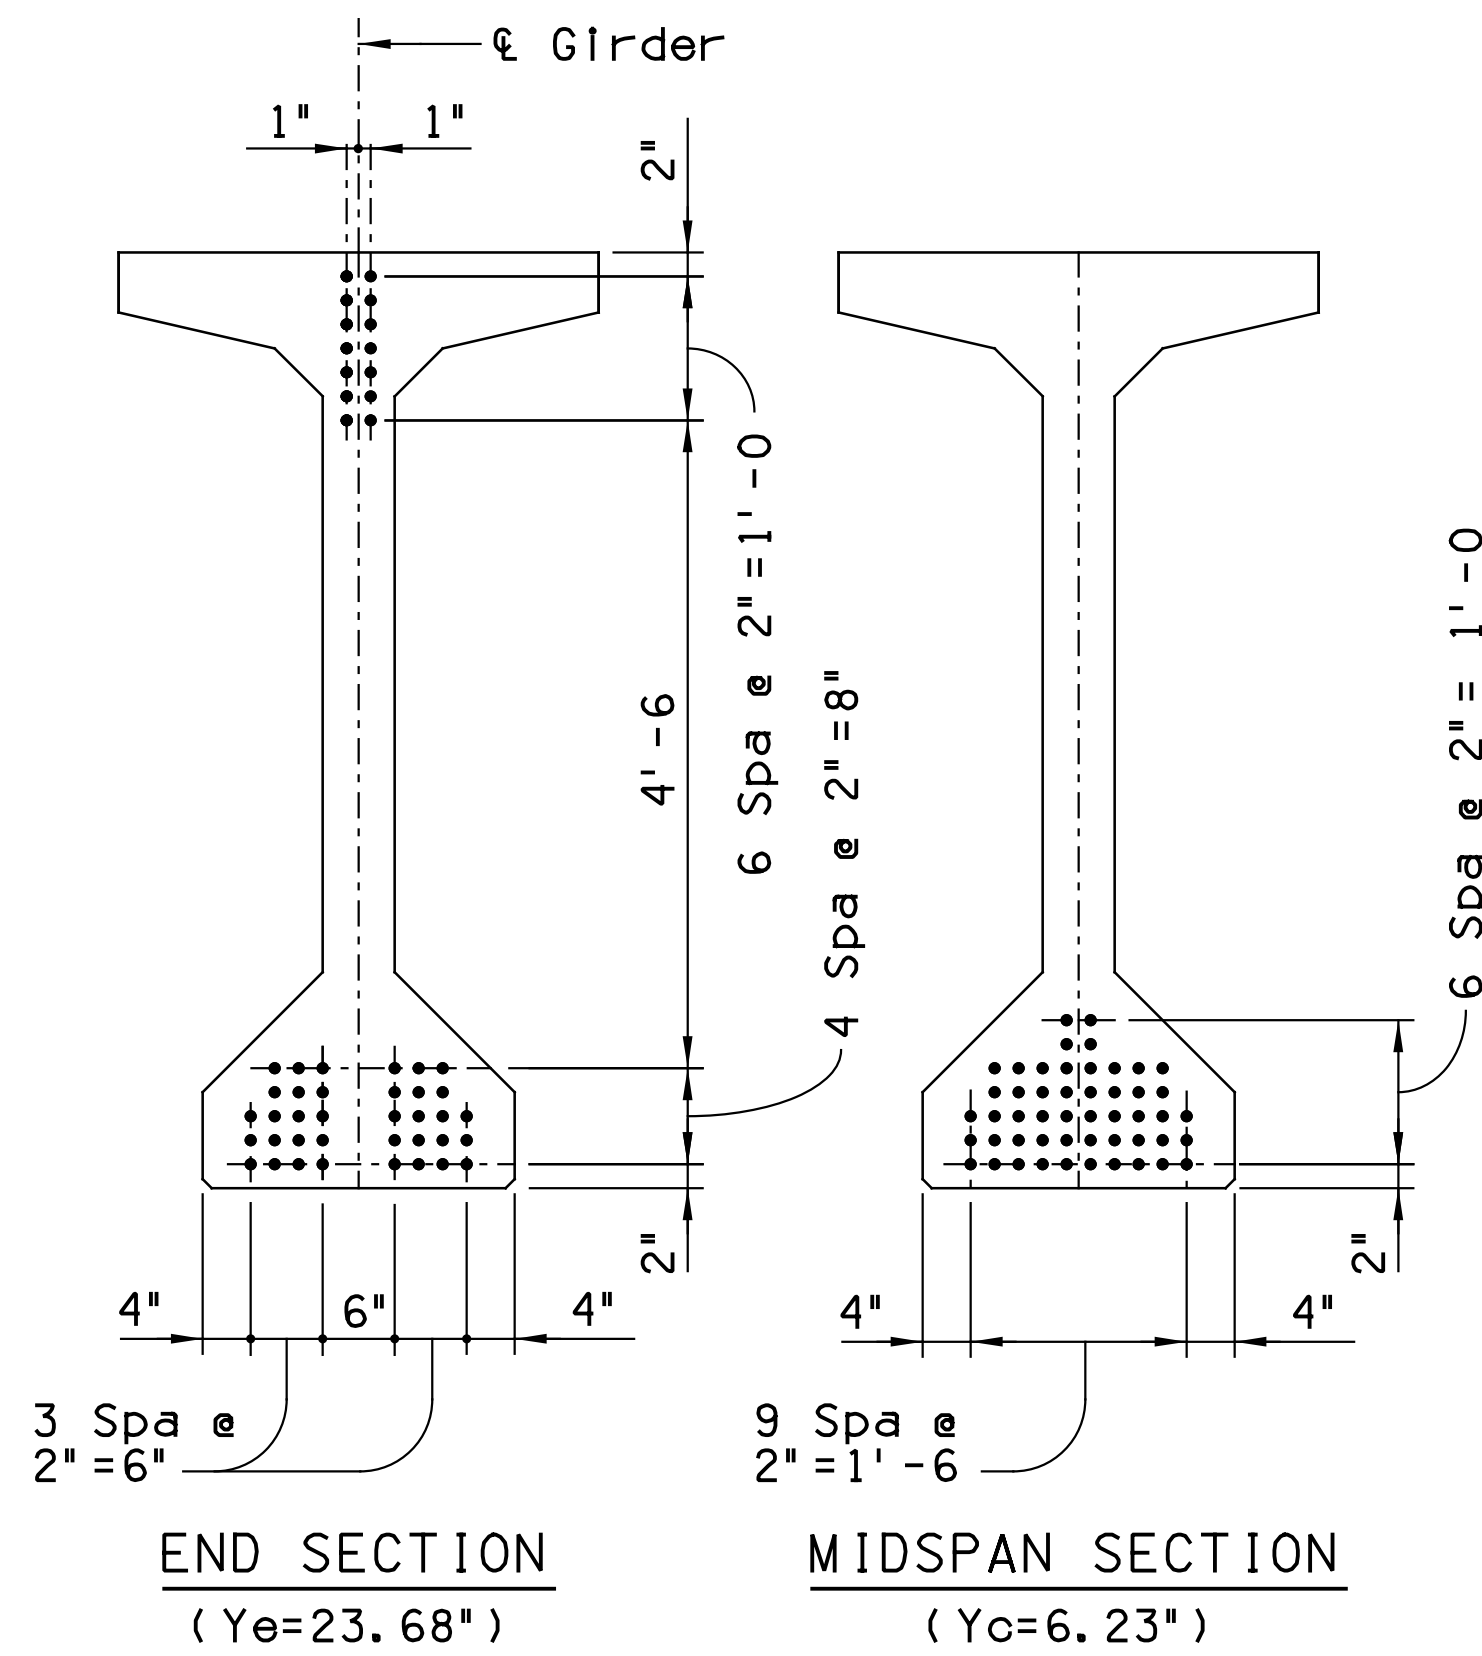

STRAND PATTERN (50)  
Scale: 3/4" = 1'-0"

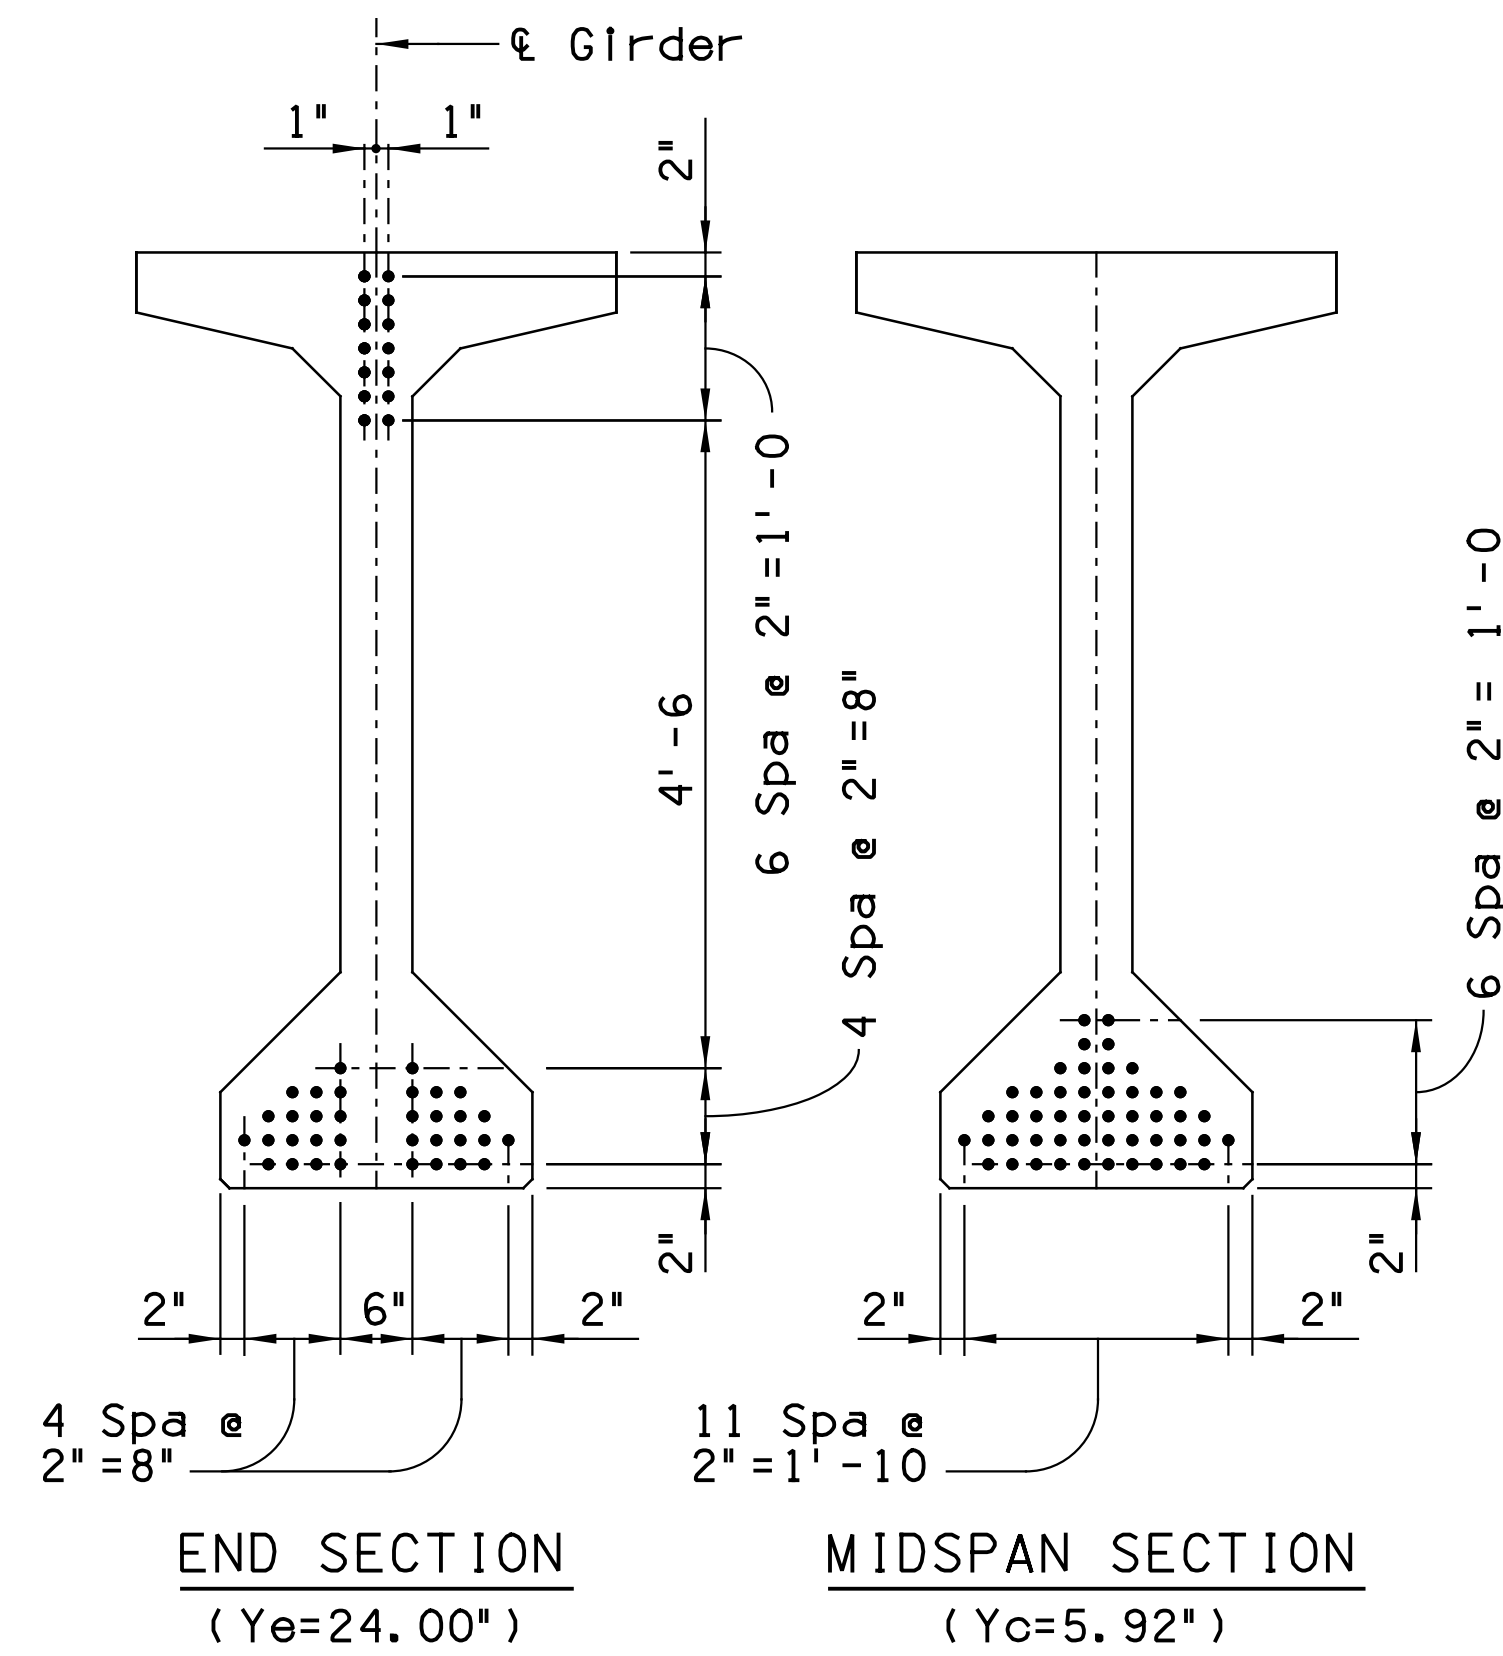


STRAND PATTERN (48)  
Scale: 3/4" = 1'-0"

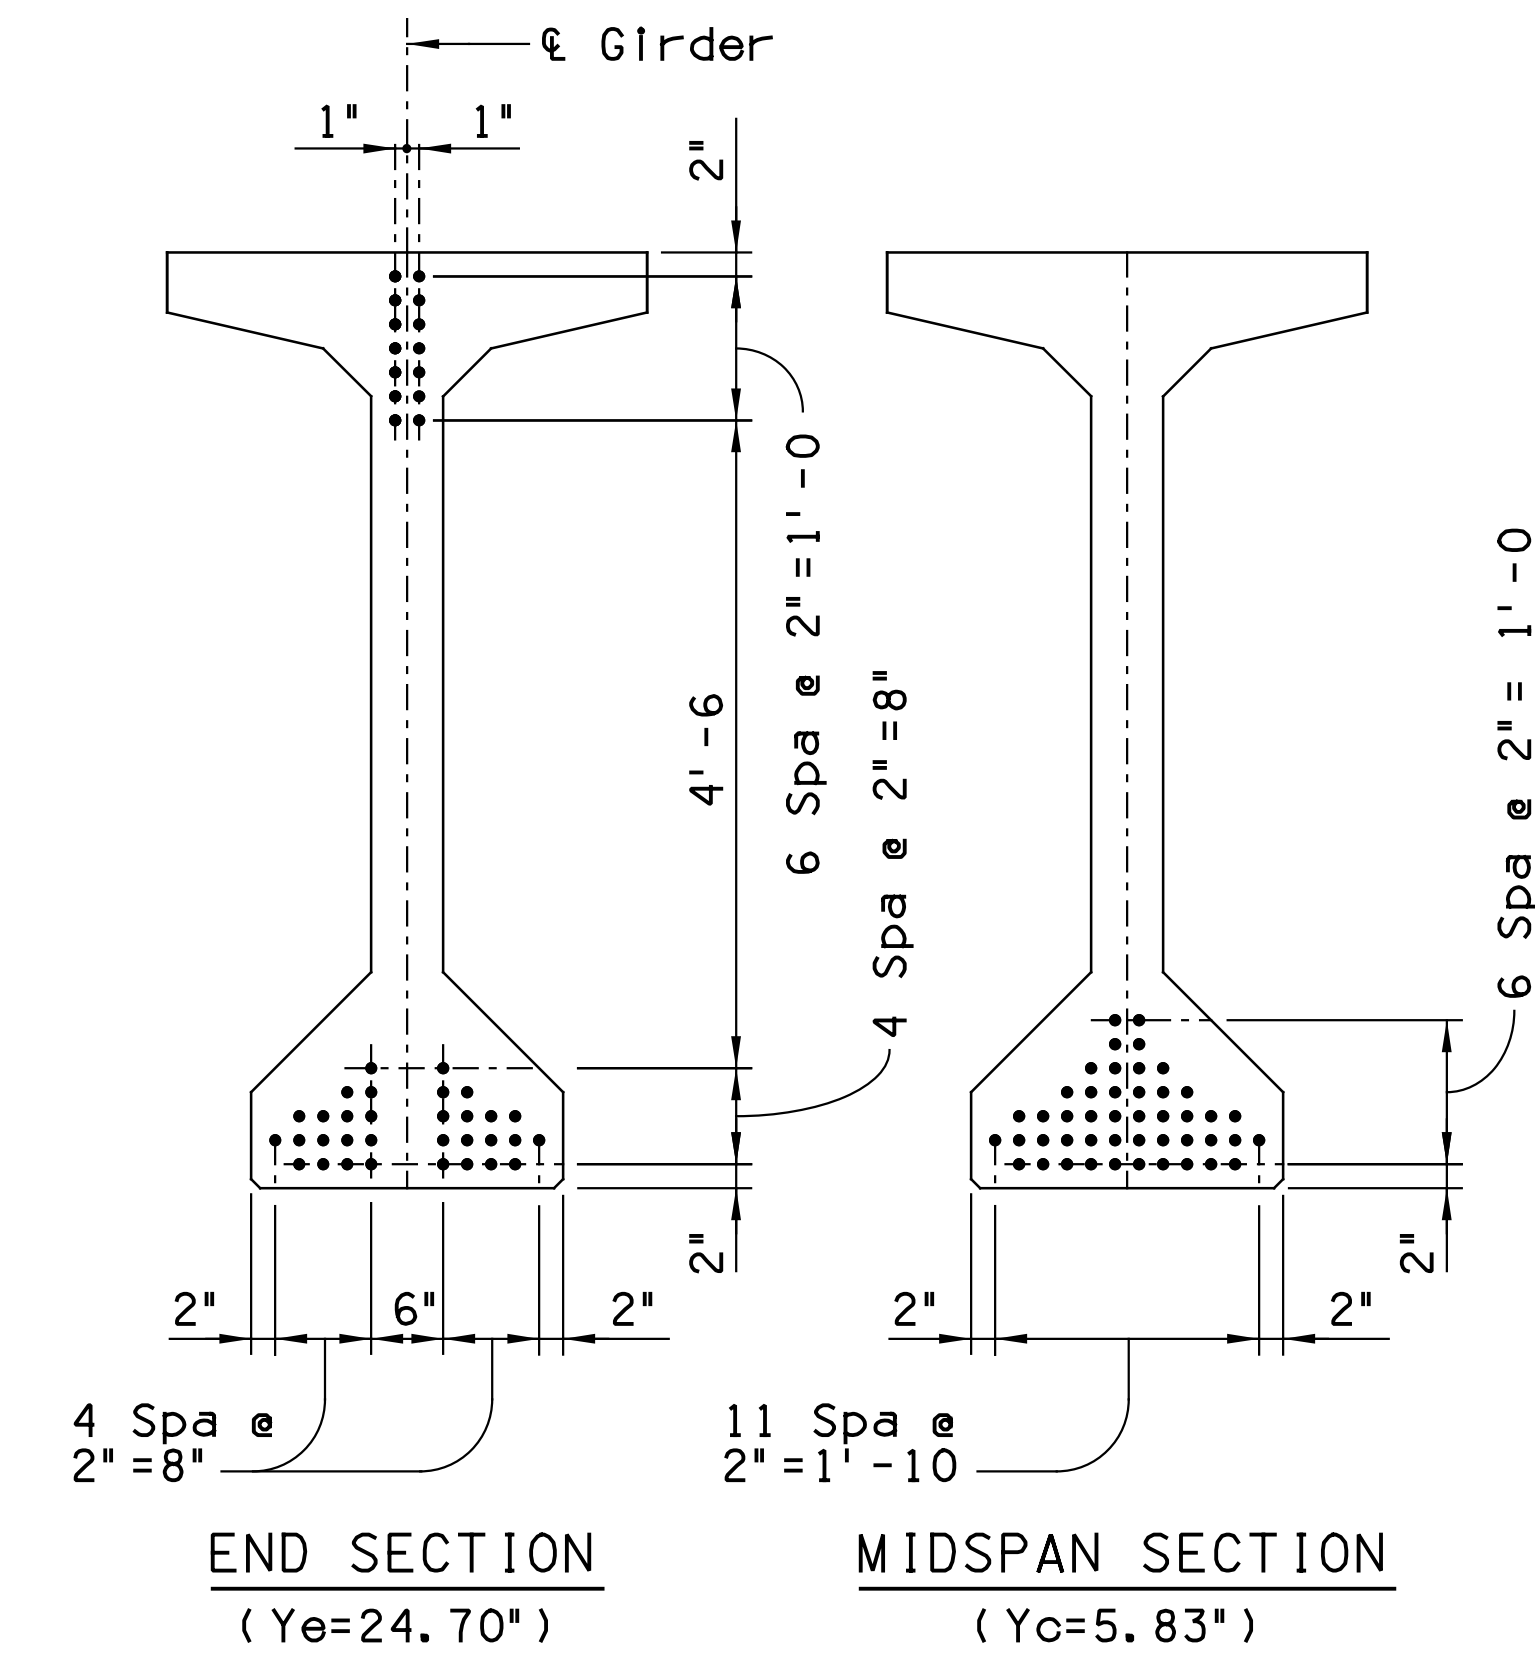

STRAND PATTERN (46)  
Scale: 3/4" = 1'-0"

NOTE:  
(50) Refers to strand pattern with 50 strands.

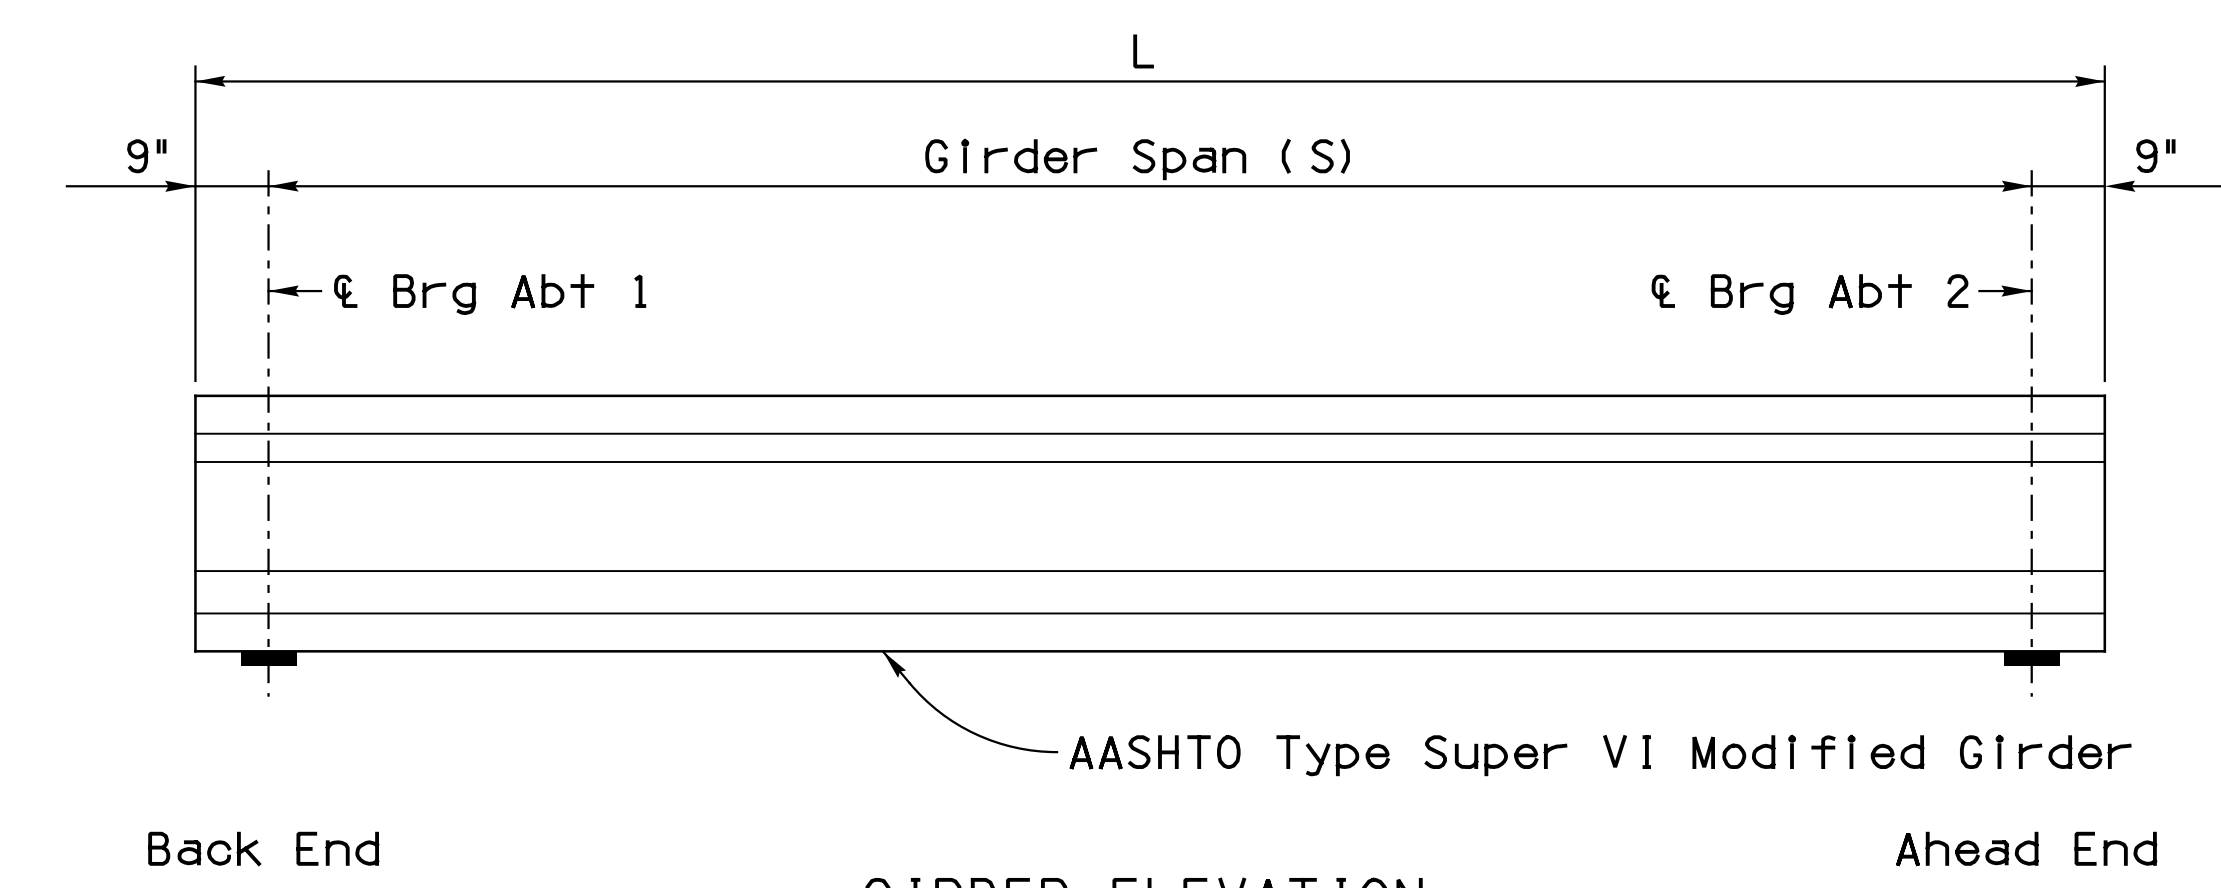

GIRDER MARK LEGEND:  
1-12 Designates girders 1 through 12 for the span.


GIRDER TABLE										
Mark	Girder		Prestressing			Minimum Concrete Strength		Number of Girders Each	Shear Stirrups Number Spa N	L2 (feet)
	Length "L" (feet)	Girder Span (S) (feet)	Strand Pattern	Initial Force P <sub>i</sub> (kips)	Working Force P <sub>w</sub> (kips)	f' c <sub>i</sub> (ksi)	f' c (ksi)			
G1-12	153.75	152.25	50	2197	1582	6.0	8.0	12	12	23.13
G13	153.75	152.25	50	2197	1582	6.0	8.0	1	12	23.13
G14	153.12	151.62	50	2197	1581	6.0	8.0	1	12	22.81
G15	152.50	151.00	48	2109	1522	5.8	7.5	1	12	22.50
G16	151.89	150.39	48	2109	1521	5.8	7.5	1	11	22.20
G17	151.28	149.78	48	2109	1520	5.8	7.5	1	11	21.89
G18	150.67	149.17	48	2109	1520	5.8	7.5	1	11	21.59
G19	150.07	148.57	48	2109	1519	5.8	7.5	1	11	21.29
G20	149.48	147.98	48	2109	1518	5.8	7.5	1	11	20.99
G21	148.90	147.40	46	2021	1460	5.6	7.0	1	11	20.70
G22	148.31	146.81	46	2021	1460	5.6	7.0	1	11	20.41
G23	147.74	146.24	46	2021	1459	5.6	7.0	1	11	20.12
G24	147.17	145.67	46	2021	1458	5.6	7.0	1	10	19.84
G25	146.61	145.11	46	2021	1458	5.6	7.0	1	10	19.56

DESIGN	KLH	DATE	03/19	ARIZONA DEPARTMENT OF TRANSPORTATION INFRASTRUCTURE DELIVERY AND OPERATIONS DIVISION BRIDGE GROUP	
DRAWN	AJM	DATE	03/19		
CHECKED	JRP	DATE	03/19		
<b>TY-LIN INTERNATIONAL</b> engineers   planners   scientists 60 E. Rio Salado Parkway, Suite 501 Tempe, Arizona 85281				Sta 103+ <b>RUTHRAUFF RD - UPRR OVERPASS          GIRDER DETAILS 2</b>	
I-10	252.000	20160	LOCATION	RUTHRAUFF T1	
ROUTE	MILEPOST	STRUCTURE NO.			
TRACS NO. H8480 01C			010-D(213)S		
			Exp. Press 12/31/2019 DWG. S-2 .15		




F.H.W.A. REGION	STATE	PROJECT NO.	SHEET NO.	TOTAL SHEETS	RECORD DRAWING
9	ARIZ.	010-D(213)S	671	849	


010 PM 252

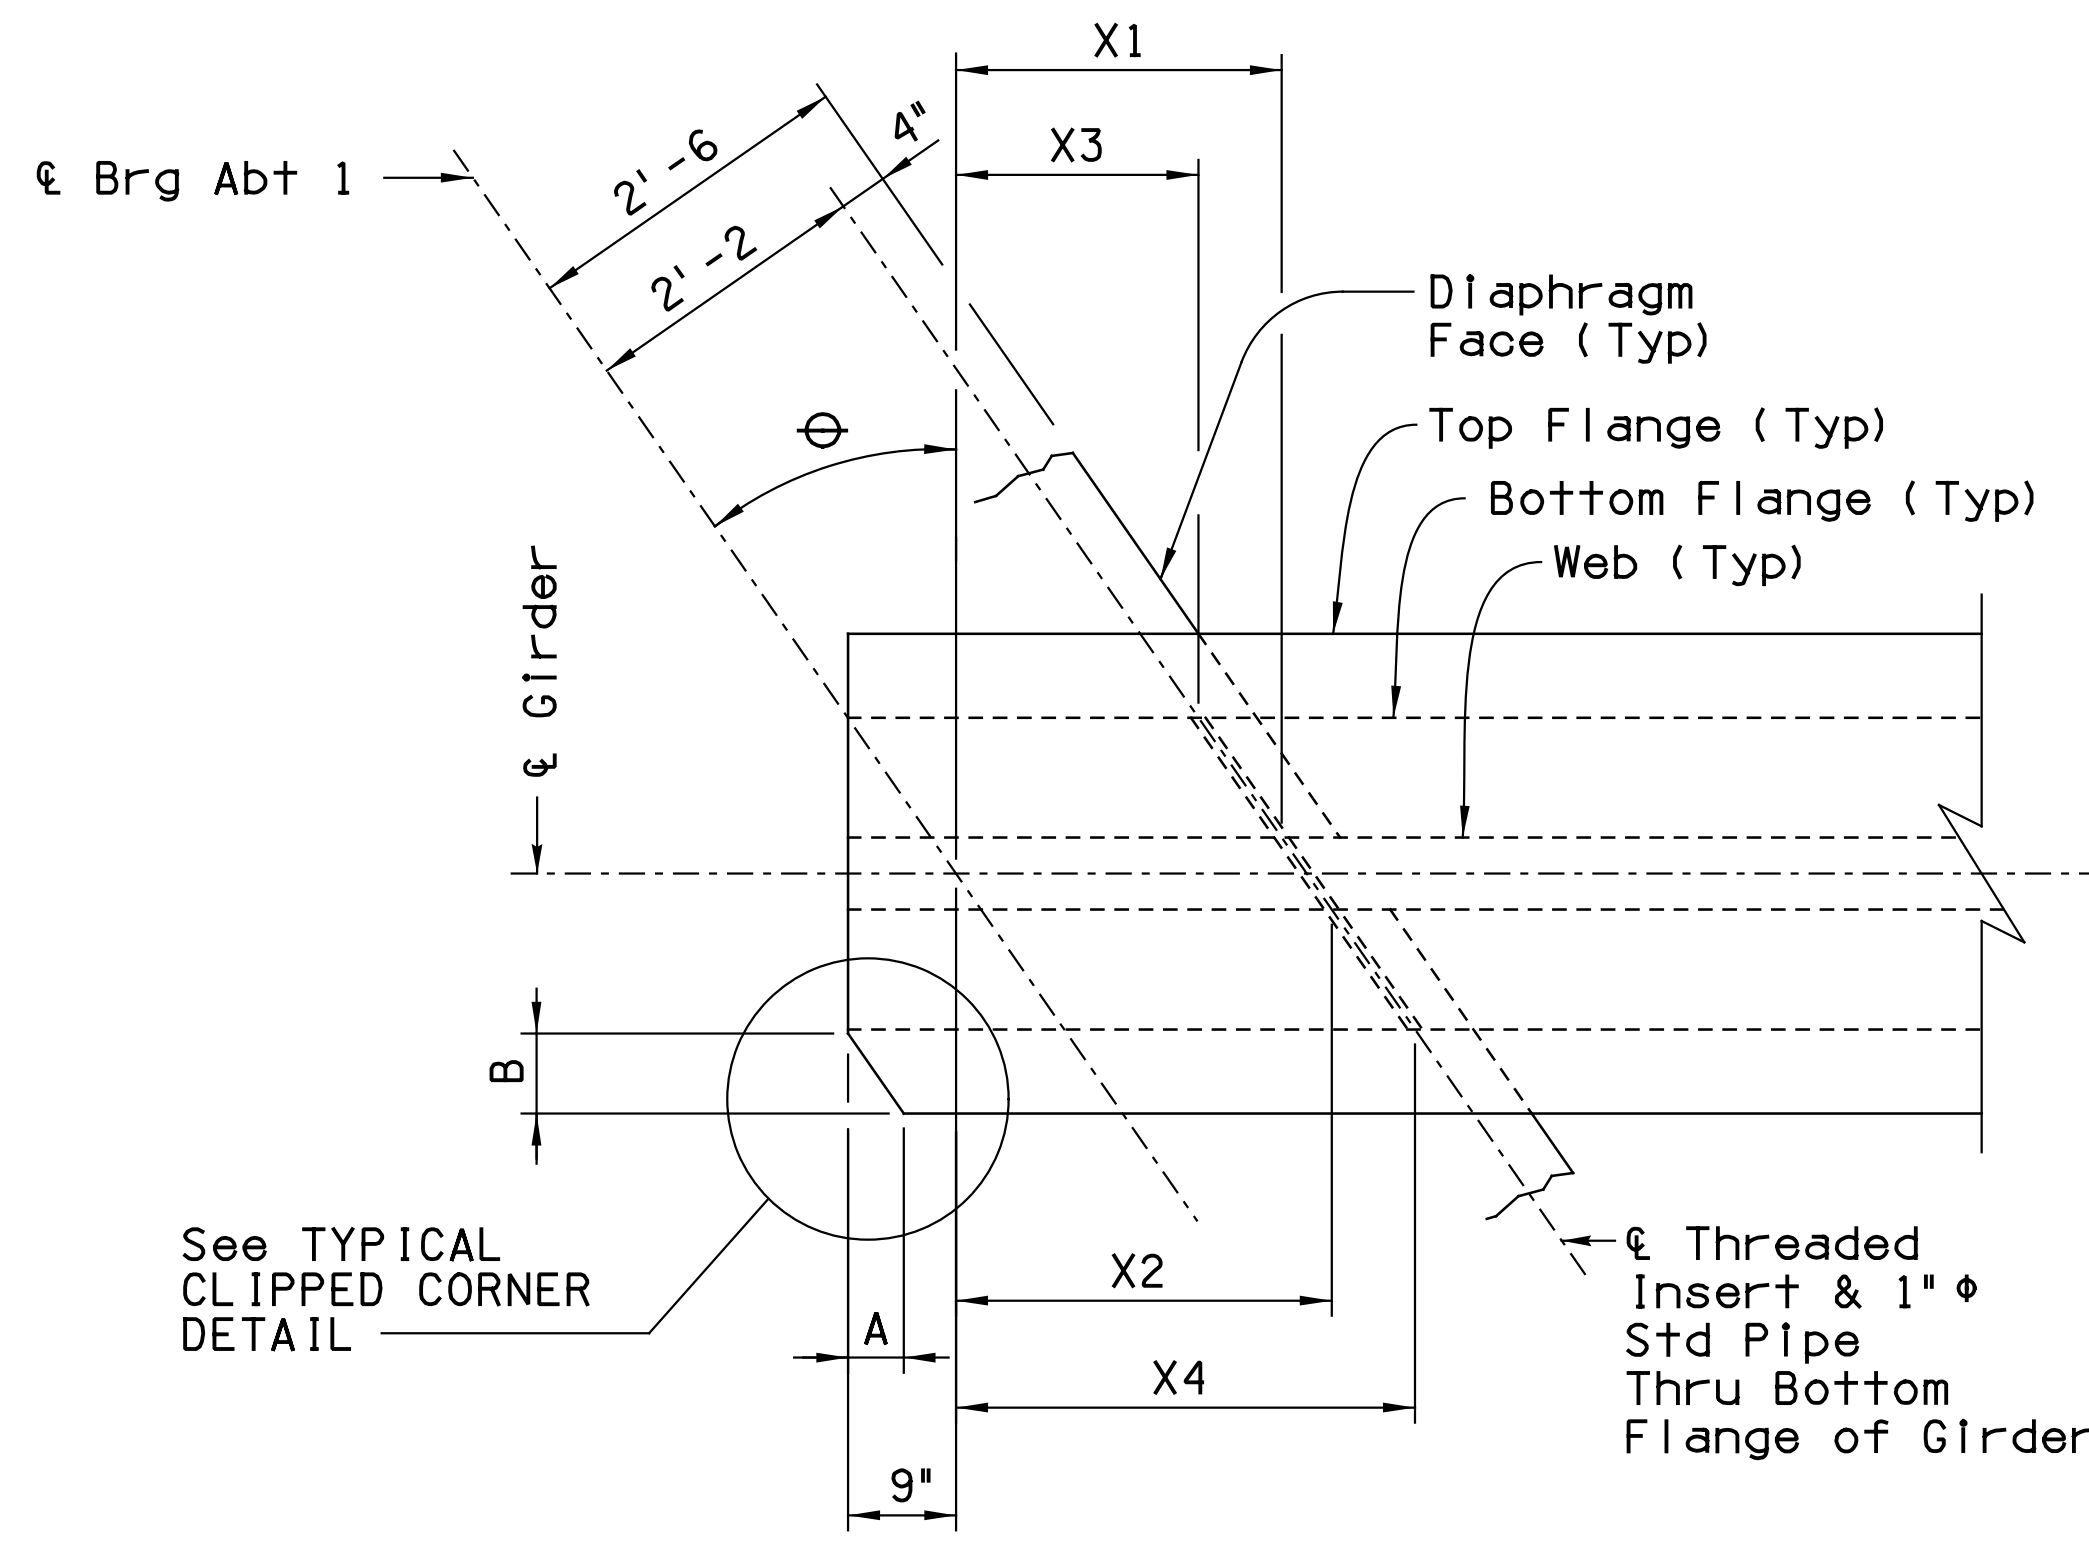

PLAN AT ABUTMENT 1 (EXPANSION)

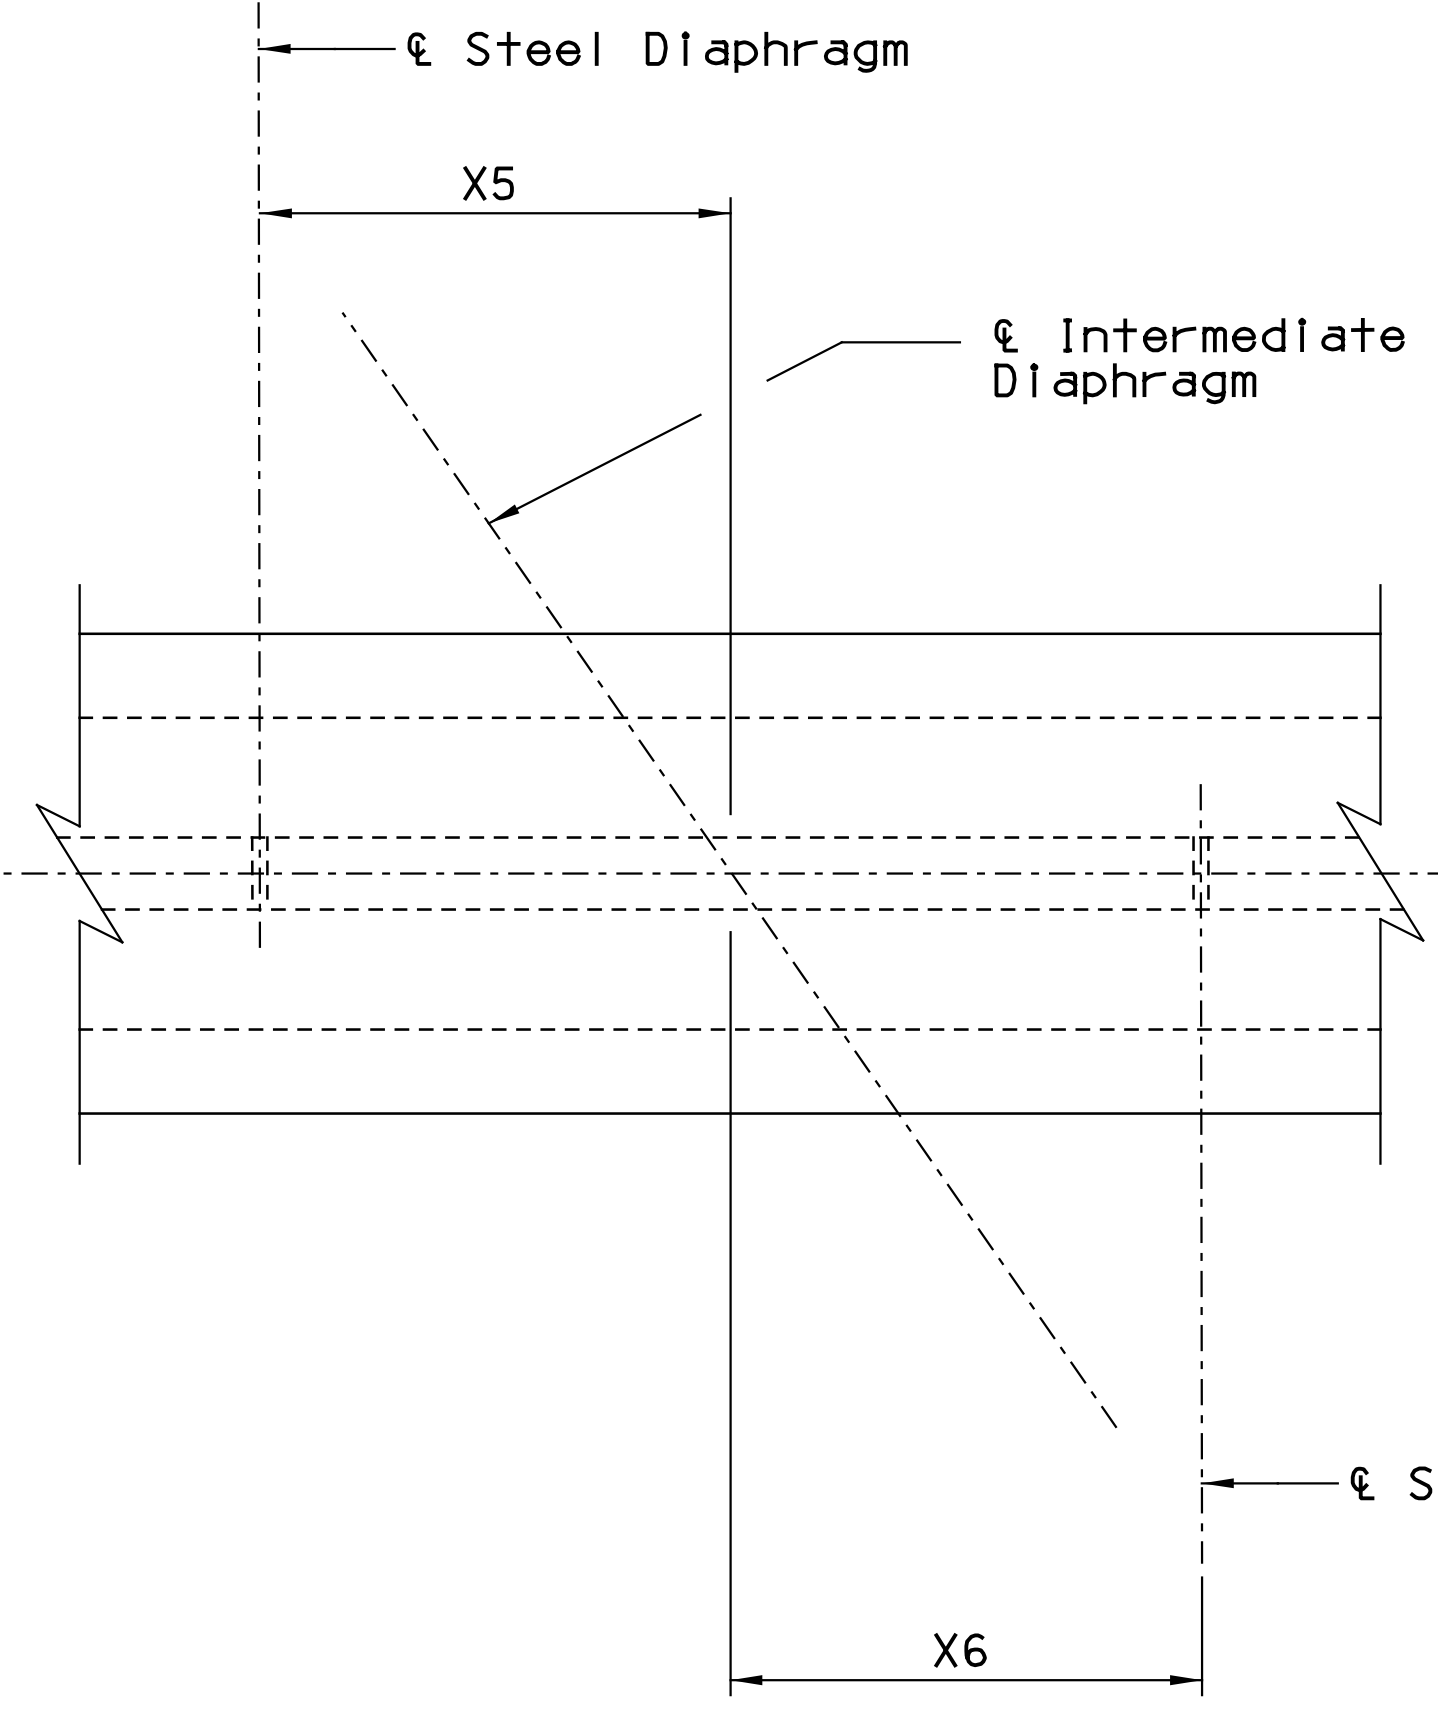


THREADED INSERT PLACEMENT DETAILS  
Not to Scale

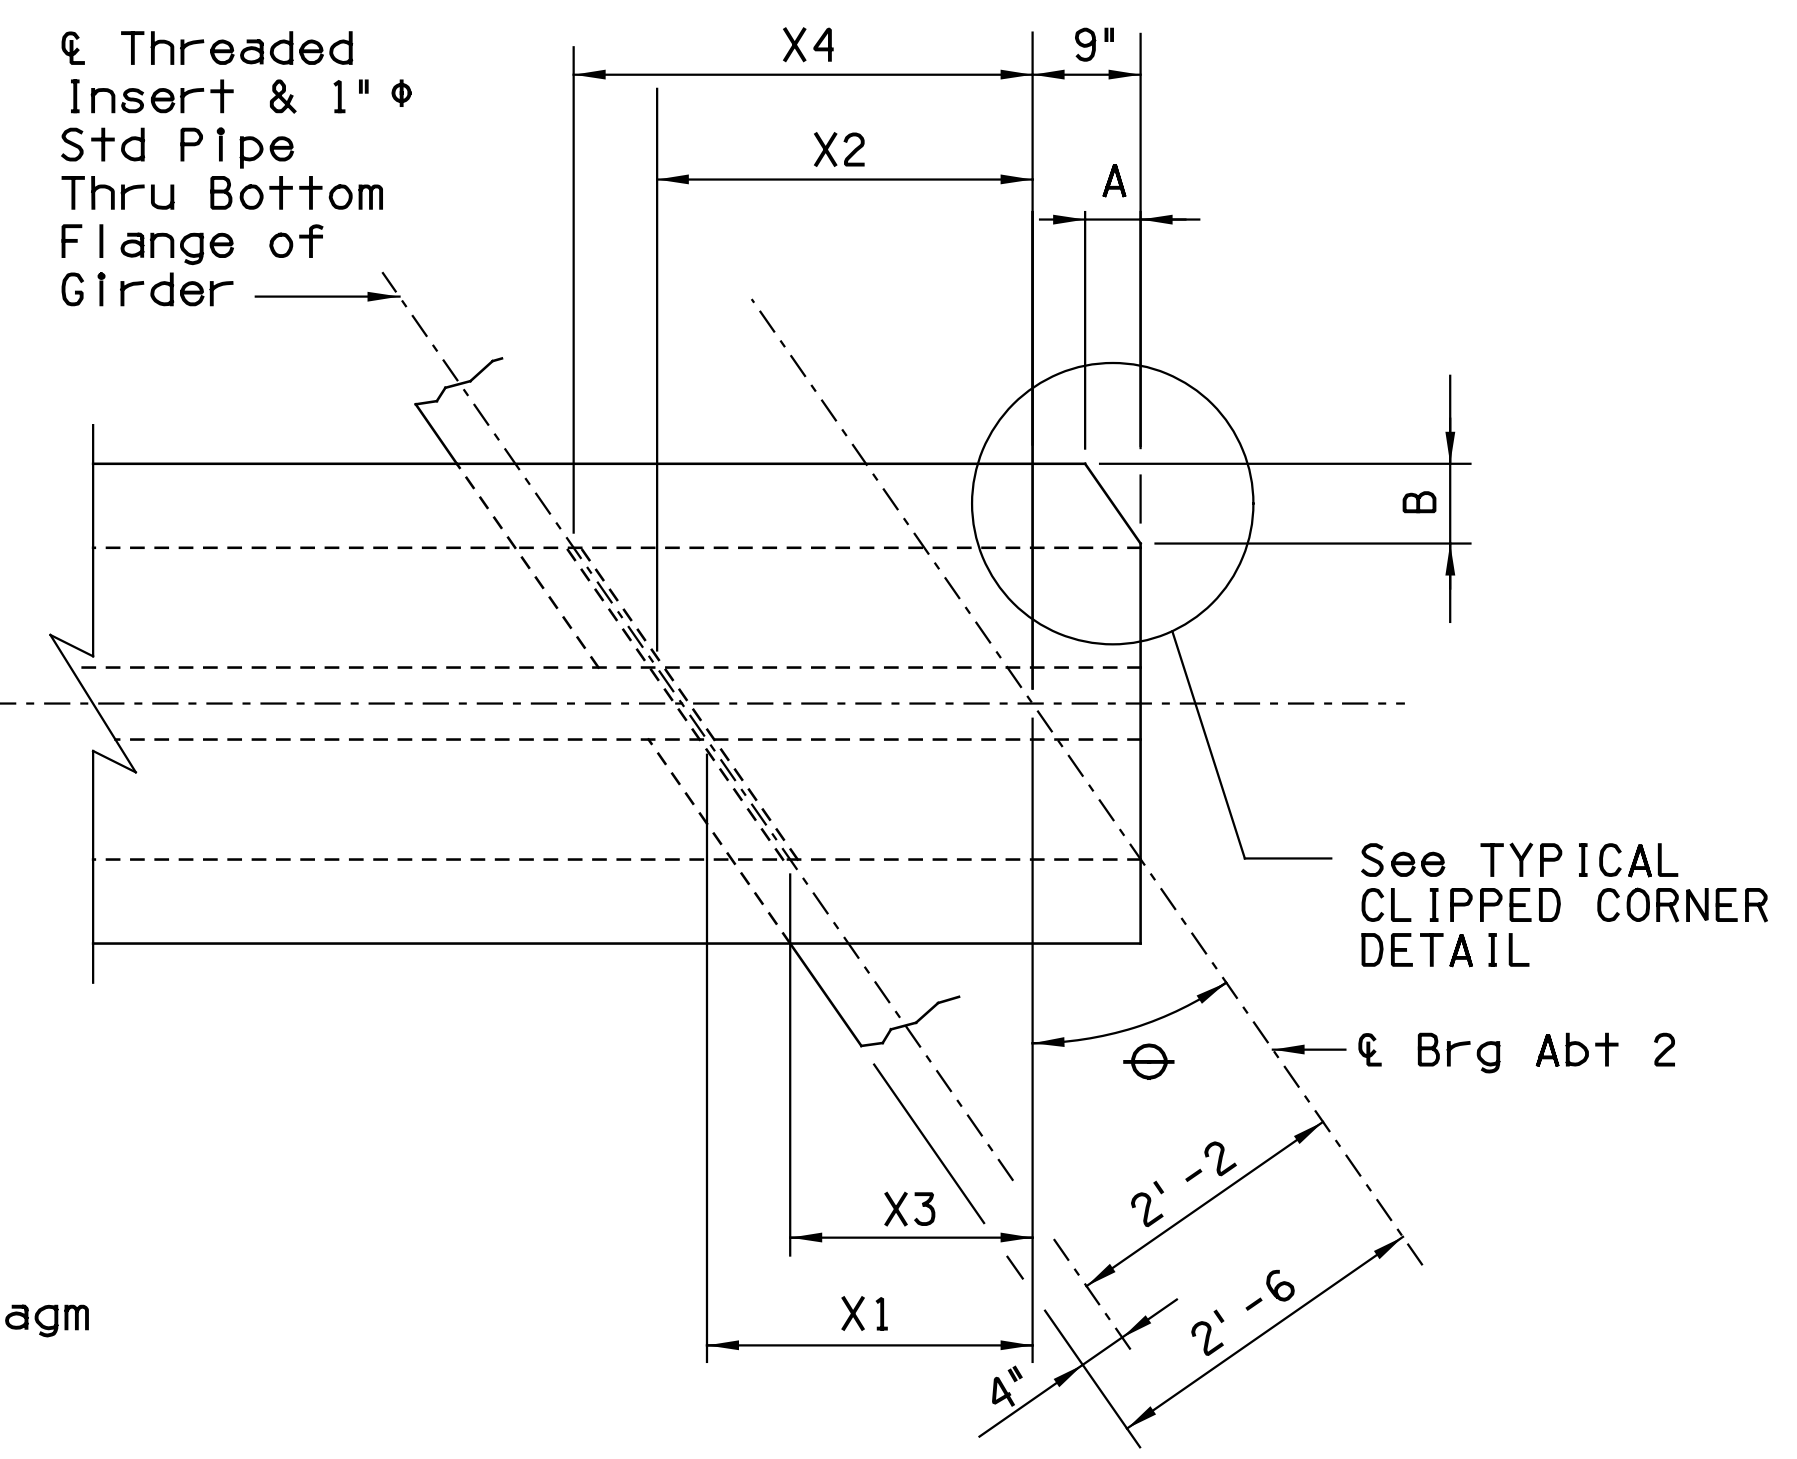

PLAN AT ABUTMENT 2 (PINNED)

NOTES:


1. X1 and X2 measured along web.
2. X3 and X4 measured along bottom flange.

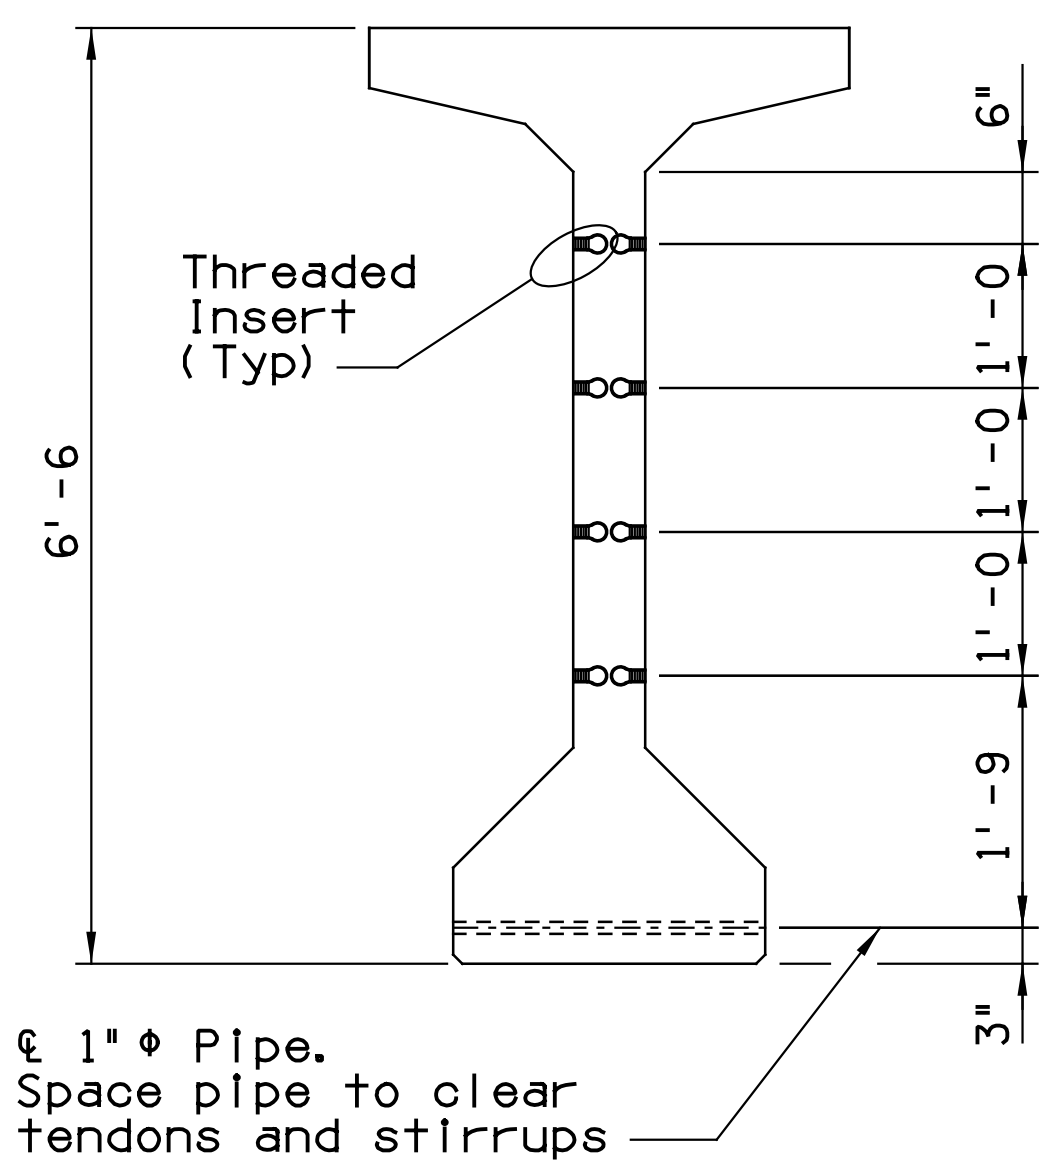

AASHTO TYPE SUPER VI MODIFIED GIRDER  
INSERT DETAIL  
Scale: 3/4" = 1'-0"

NOTES:

1. Threaded inserts shall be ferrule loop inserts for 3/4" diameter threaded rods (Typ). Ultimate pullout strength of 10800 Lbs.
2. Threaded inserts shall be placed parallel to the centerline of bridge abutments. The Contractor may place the inserts normal to the girder with the approval of the Engineer. In this case shop drawings shall be submitted showing the plan for the placement of the inserts and diaphragm reinforcement. Threaded rods may be field bent to align with face of diaphragm. Bending shall not occur within 6" of the inserted end. The Contractor shall furnish bending procedure for approval by the Engineer.
3. Pipe sleeves for girders shall be placed to align with the girder skew angle.
4. Provide threaded inserts on the inside face of the exterior girders only.

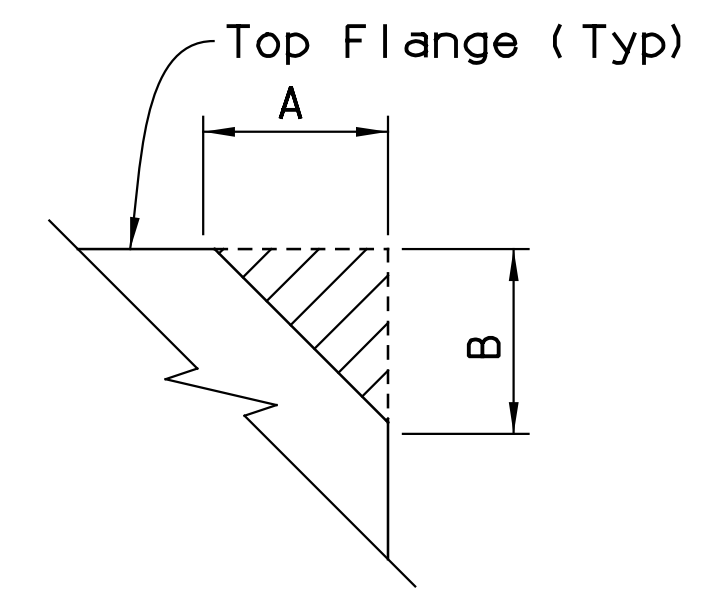

TYPICAL CLIPPED CORNER DETAIL  
Not To Scale

DESIGN	KLH	DATE	03/19	ARIZONA DEPARTMENT OF TRANSPORTATION INFRASTRUCTURE DELIVERY AND OPERATIONS DIVISION <b>BRIDGE GROUP</b> Sta 103+ <b>RUTHRAUFF RD - UPRR OVERPASS          GIRDER DETAILS 3</b>	
DRAWN	AJM	DATE	03/19		
CHECKED	JRP	DATE	03/19		
<b>TY LIN INTERNATIONAL</b> engineers   planners   scientists 60 E. Rio Salado Parkway, Suite 501 Tempe, Arizona 85281			LOCATION <b>RUTHRAUFF T1</b>		
I-10	252.000	20160	LOCATION	RUTHRAUFF T1	Expires 12/31/2019
ROUTE	MILEPOST	STRUCTURE NO.			DWG. S-2 .16
TRACS NO. H8480 01C			010-D(213)S		OF




F.H.W.A. REGION	STATE	PROJECT NO.	SHEET NO.	TOTAL SHEETS	RECORD DRAWING
9	ARIZ.	010-D(213)S	673	849	

010 PM 252

**NOTES:**

1. Contractor shall provide a secure system to maintain girders in place immediately after their erection.
2. Design and construction of deck falsework systems by the contractor, shall ensure that bridge girders be braced and tied to resist any forces that would cause rotation or torsion in the girders caused by the placing of concrete for diaphragms and decks or be shown to be adequate for those effects.

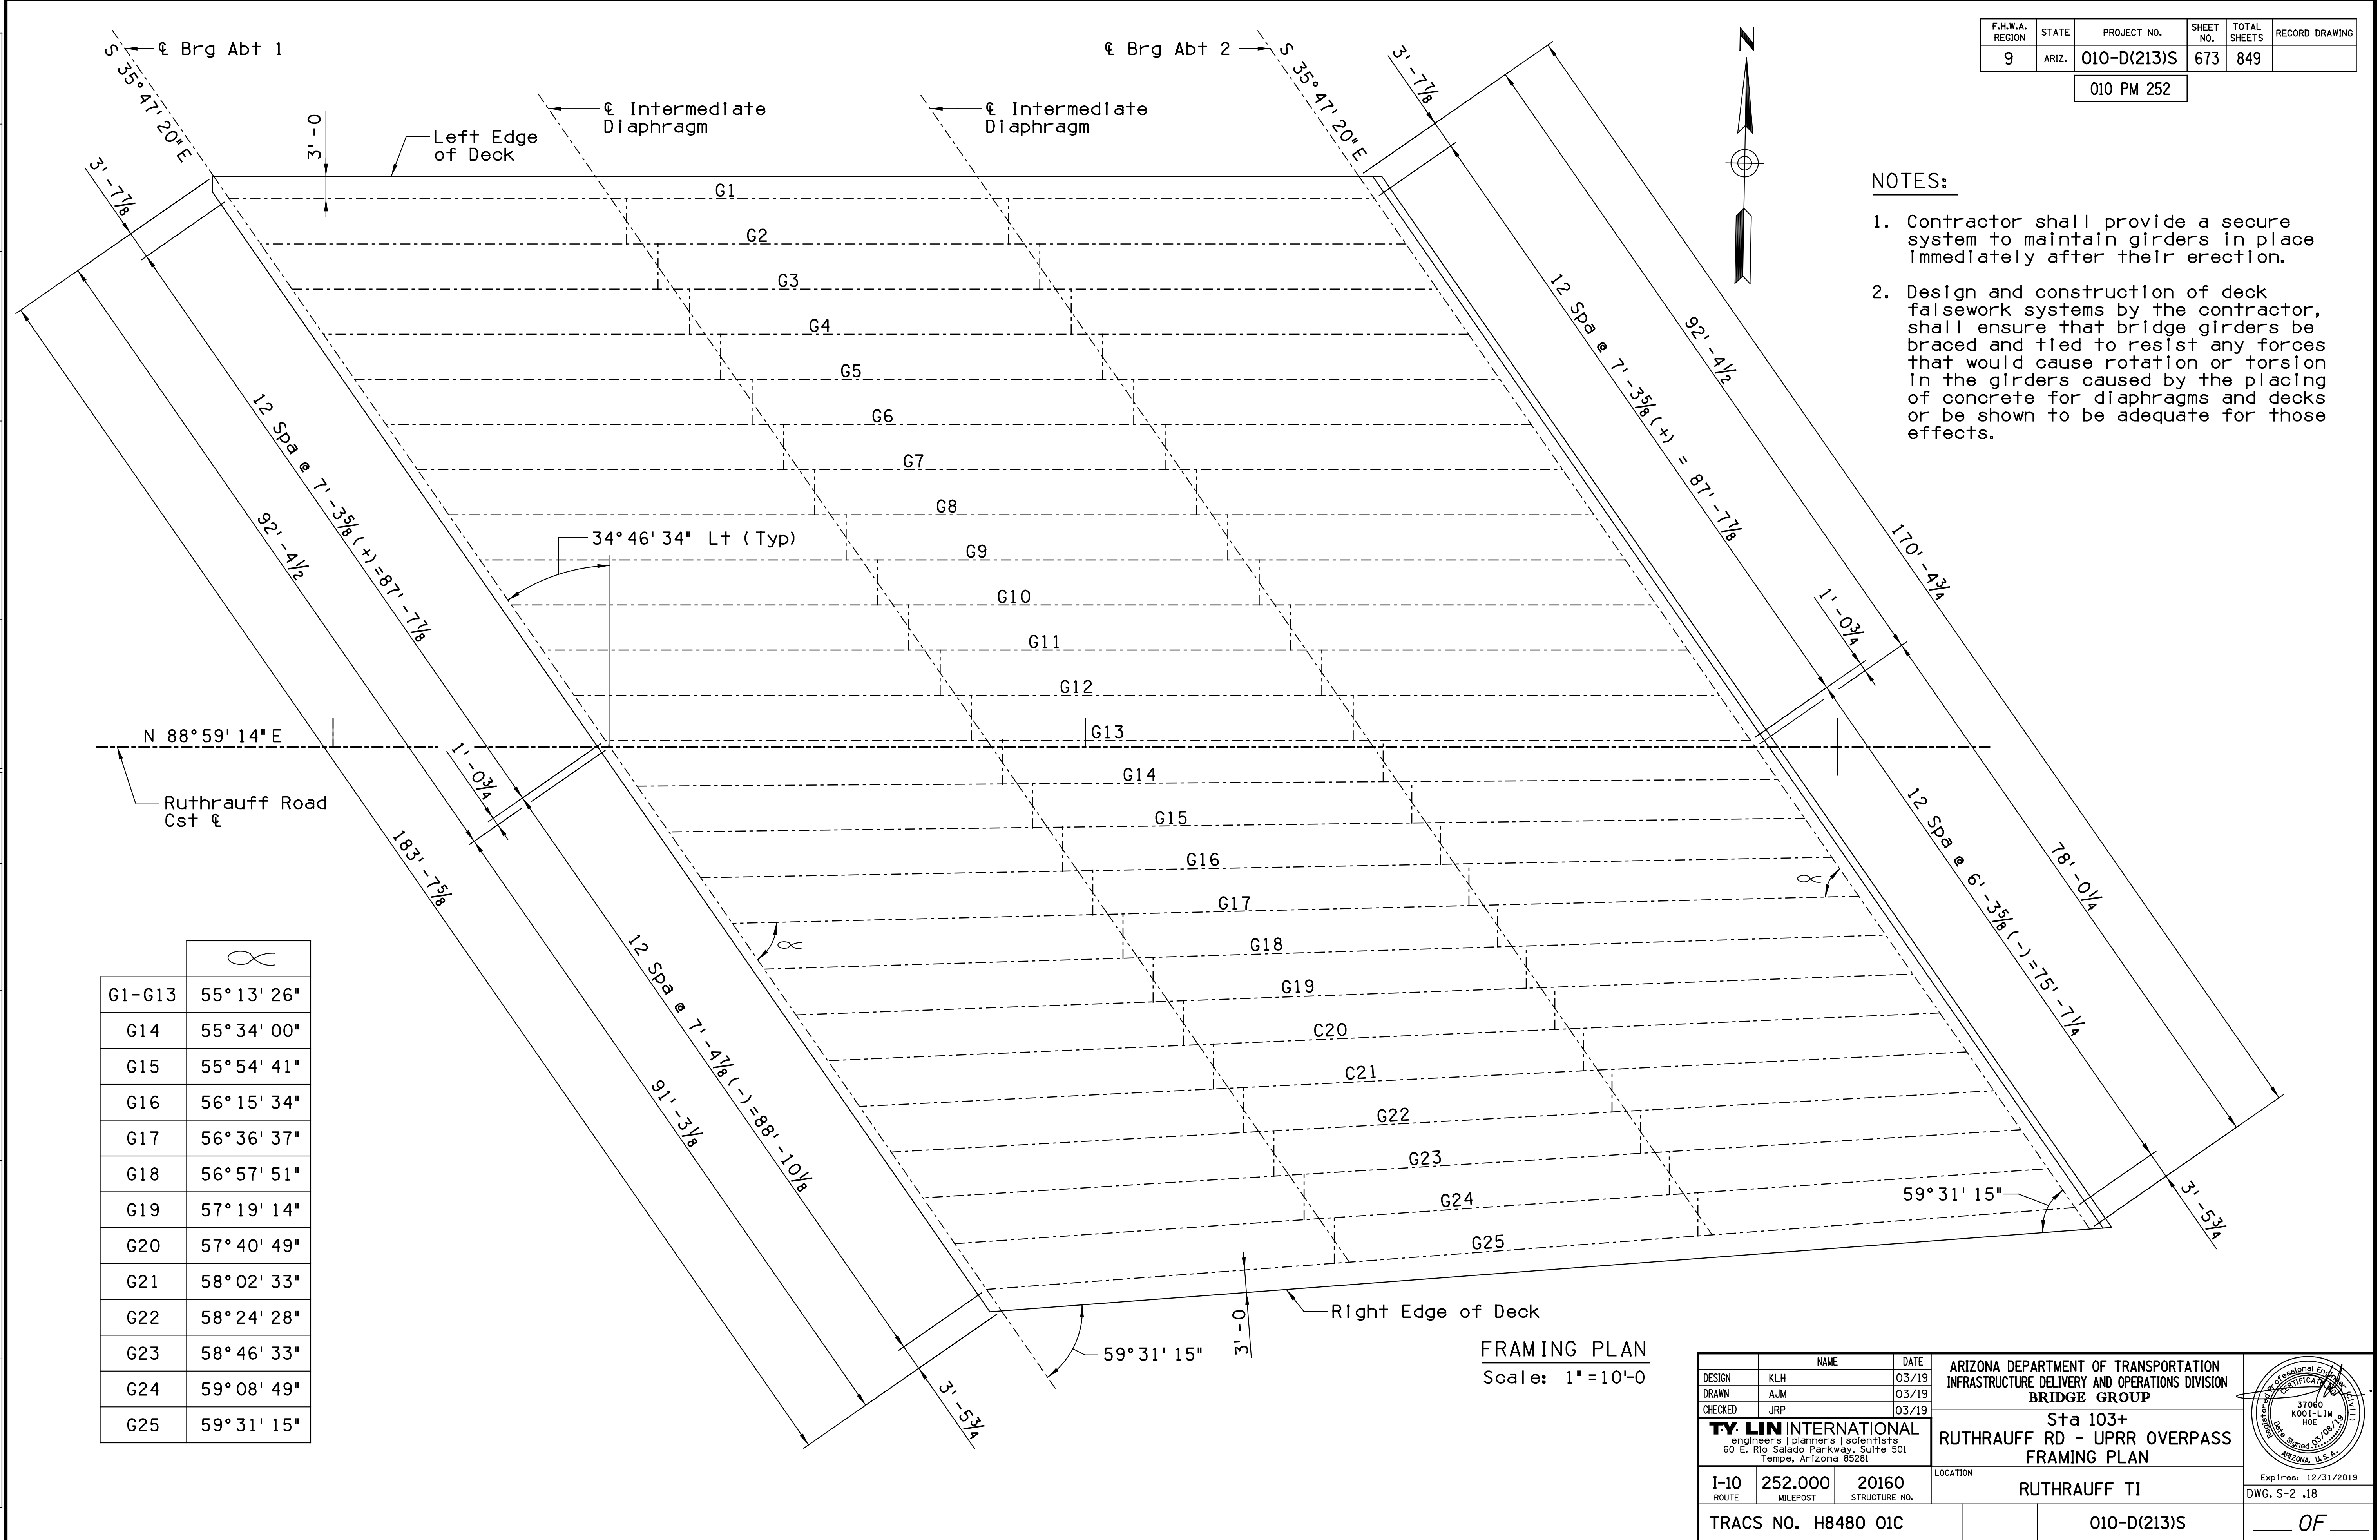

	$\alpha$
G1-G13	55° 13' 26"
G14	55° 34' 00"
G15	55° 54' 41"
G16	56° 15' 34"
G17	56° 36' 37"
G18	56° 57' 51"
G19	57° 19' 14"
G20	57° 40' 49"
G21	58° 02' 33"
G22	58° 24' 28"
G23	58° 46' 33"
G24	59° 08' 49"
G25	59° 31' 15"

**FRAMING PLAN**  
Scale: 1" = 10'-0"

DESIGN	KLH	DATE	03/19	ARIZONA DEPARTMENT OF TRANSPORTATION INFRASTRUCTURE DELIVERY AND OPERATIONS DIVISION <b>BRIDGE GROUP</b>  Sta 103+ <b>RUTHRAUFF RD - UPRR OVERPASS          FRAMING PLAN</b>	
DRAWN	AJM	DATE	03/19		
CHECKED	JRP	DATE	03/19		
<b>TY LIN INTERNATIONAL</b> engineers   planners   scientists 60 E. Rio Salado Parkway, Suite 501 Tempe, Arizona 85281				LOCATION <b>RUTHRAUFF TI</b>	Expires 12/31/2019 DWG. S-2 .18
I-10	252.000	20160		TRACS NO. H8480 01C	010-D(213)S


Penable: ...TYLI PLTDRAWOPENSTDPLOT.TBL  
 Plot Driver: ...TYLI PLTDRAWDOT PDF FULL.plt  
 SURVEY NO. LOCATION FINISHED PLANS REVISIONS DATE






F.H.W.A. REGION	STATE	PROJECT NO.	SHEET NO.	TOTAL SHEETS	RECORD DRAWING
9	ARIZ.	010-D(213)S	675	849	

010 PM 252

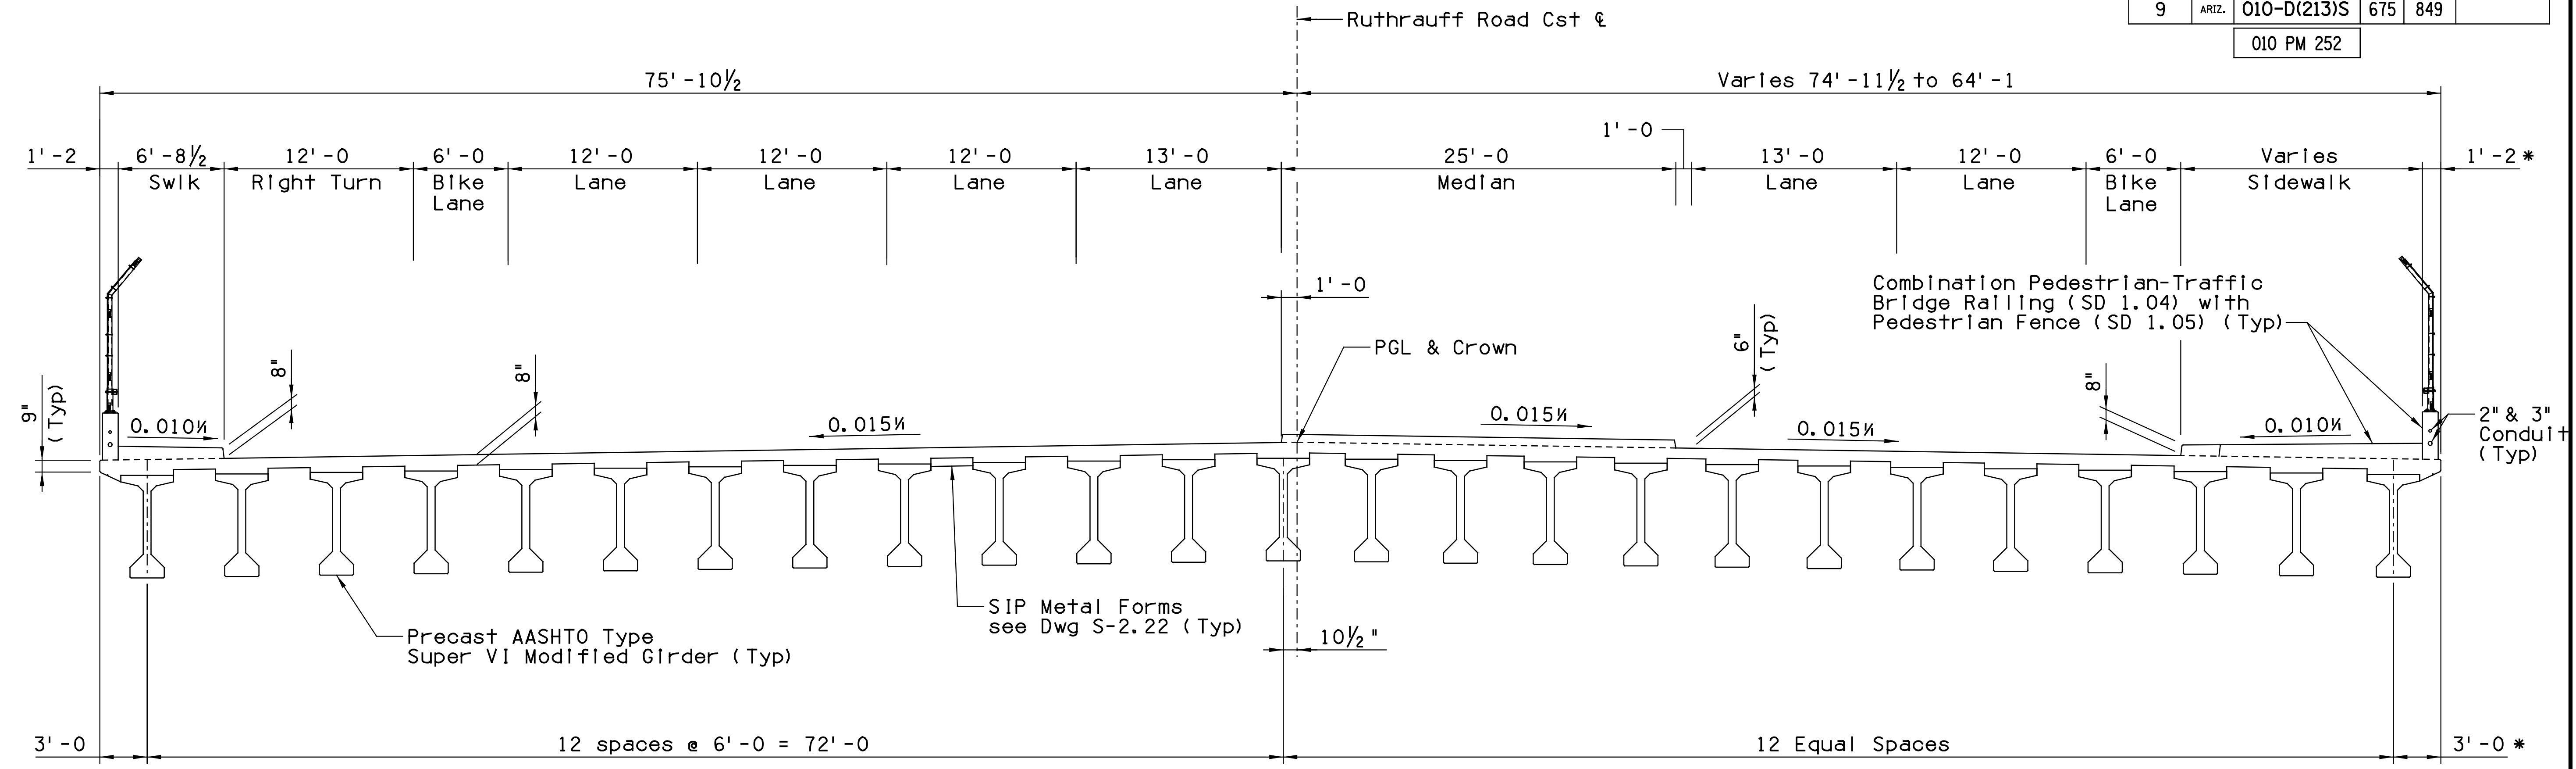


TYPICAL DECK SECTION  
Scale: 3/16" = 1'-0

\* Normal to edge of deck

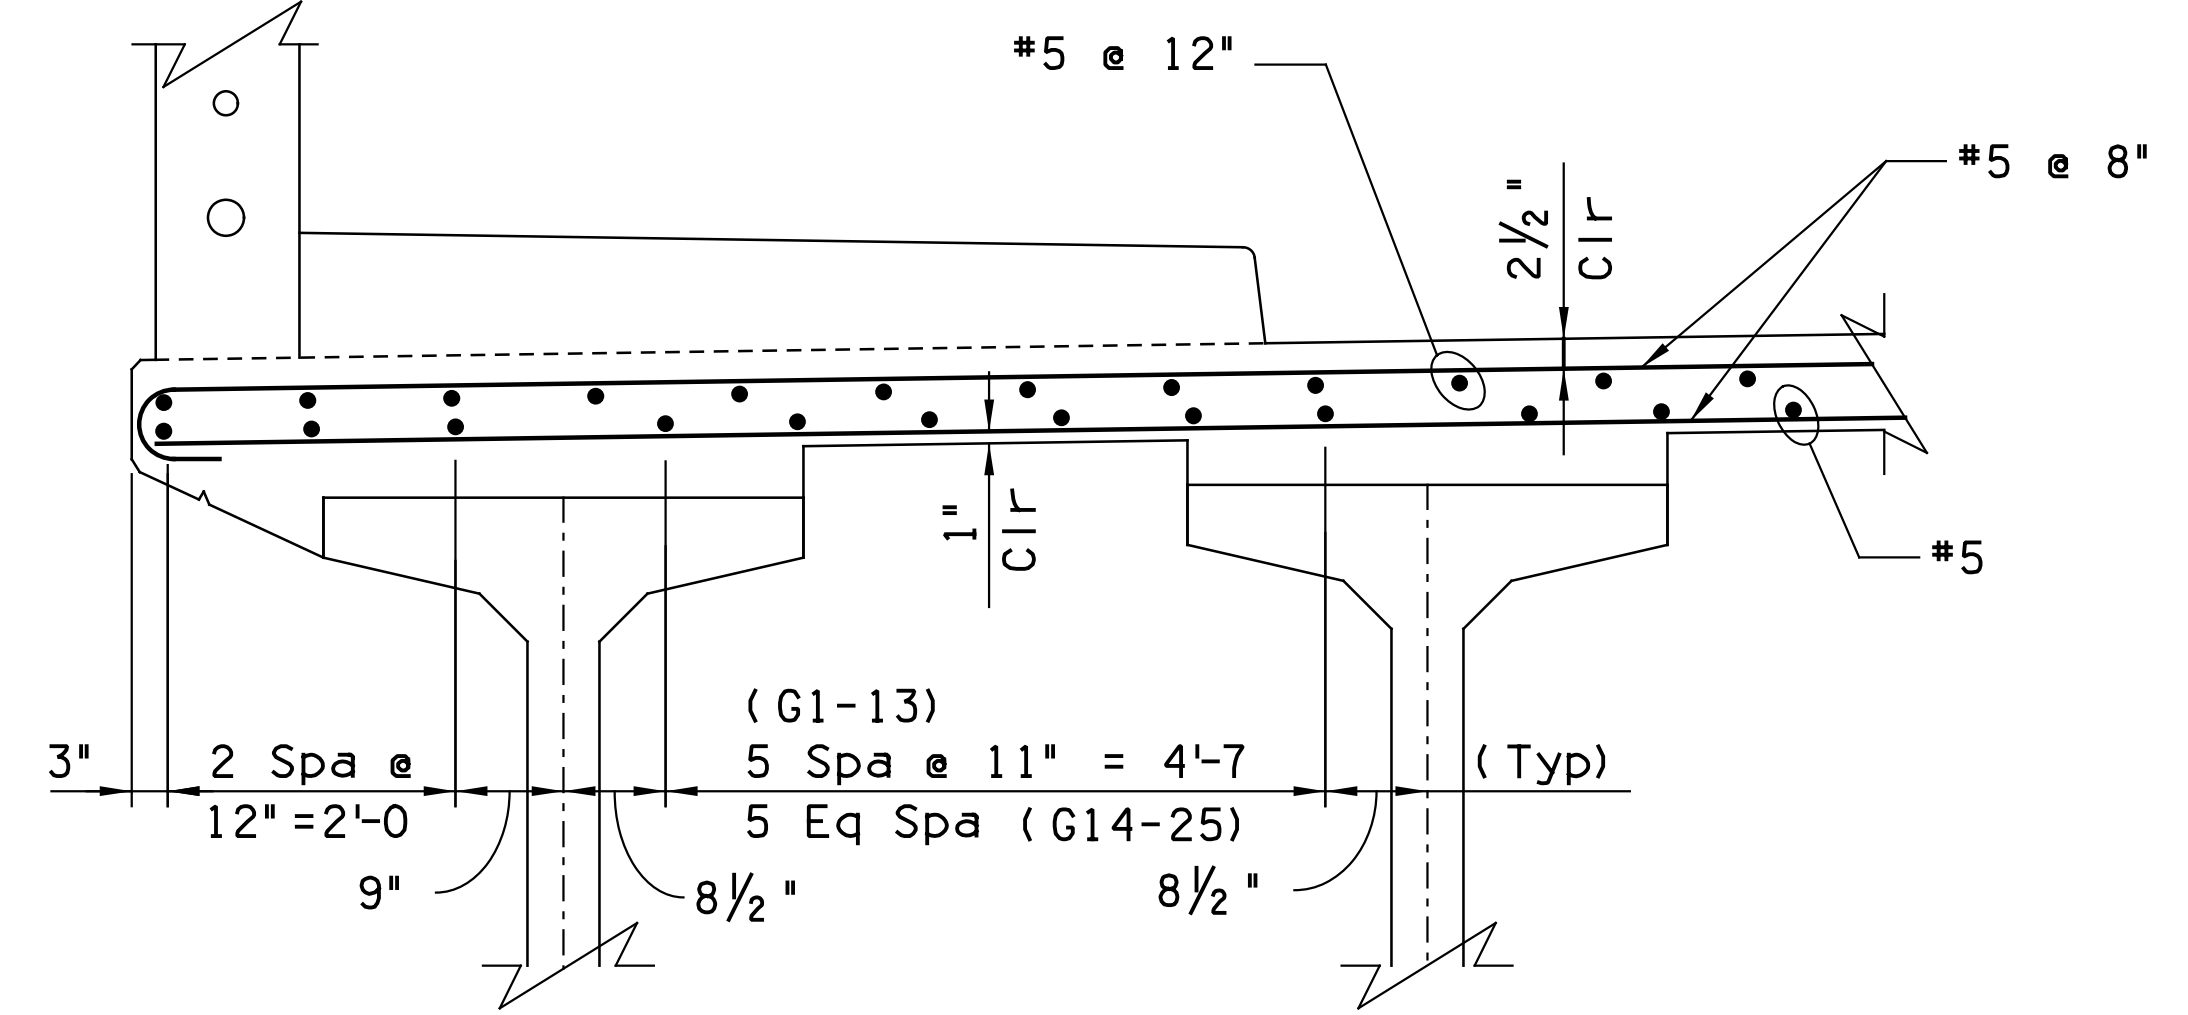

TYPICAL DECK REINFORCING  
Scale: 3/4" = 1'-0

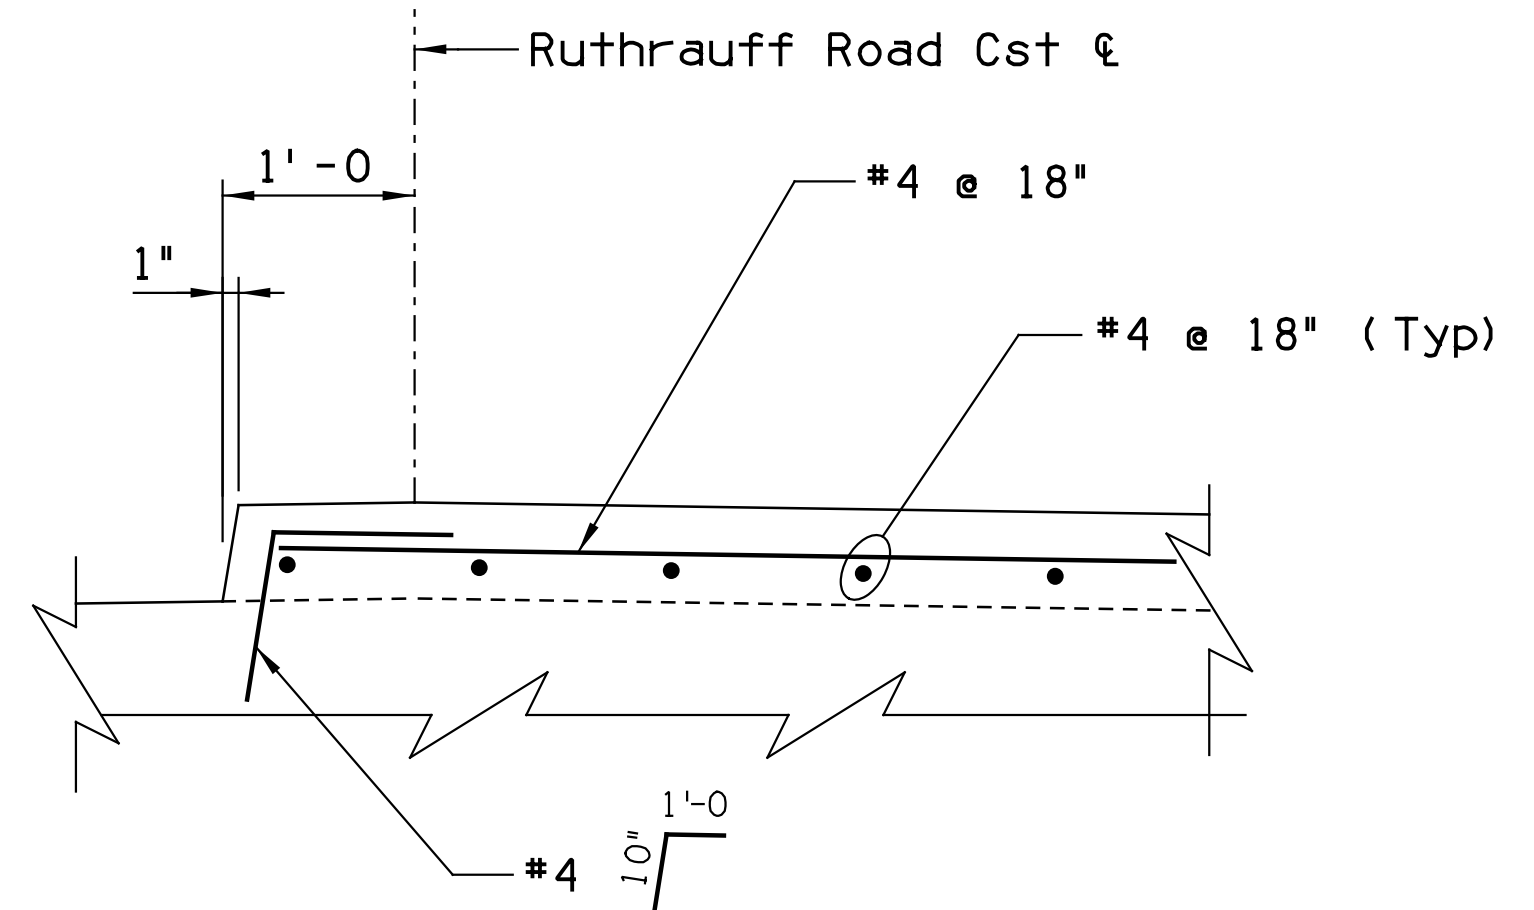


PARTIAL MEDIAN REINFORCING  
Scale: 1" = 1'-0


DESIGN	KLH	DATE	03/19	ARIZONA DEPARTMENT OF TRANSPORTATION INFRASTRUCTURE DELIVERY AND OPERATIONS DIVISION <b>BRIDGE GROUP</b> Sta 103+ <b>RUTHRAUFF RD - UPRR OVERPASS          DECK SECTION &amp; REINFORCING</b>	
DRAWN	AJM	DATE	03/19		
CHECKED	JRP	DATE	03/19		
<b>TY LIN INTERNATIONAL</b> engineers   planners   scientists 60 E. Rio Salado Parkway, Suite 501 Tempe, Arizona 85281				LOCATION <b>RUTHRAUFF TI</b>	Expires 12/31/2019 DWG. S-2 .20
I-10	252.000	20160	TRACS NO. H8480 01C		
ROUTE	MILEPOST	STRUCTURE NO.	010-D(213)S		

F.H.W.A. REGION	STATE	PROJECT NO.	SHEET NO.	TOTAL SHEETS	RECORD DRAWING
9	ARIZ.	010-D(213)S	676	849	


010 PM 252

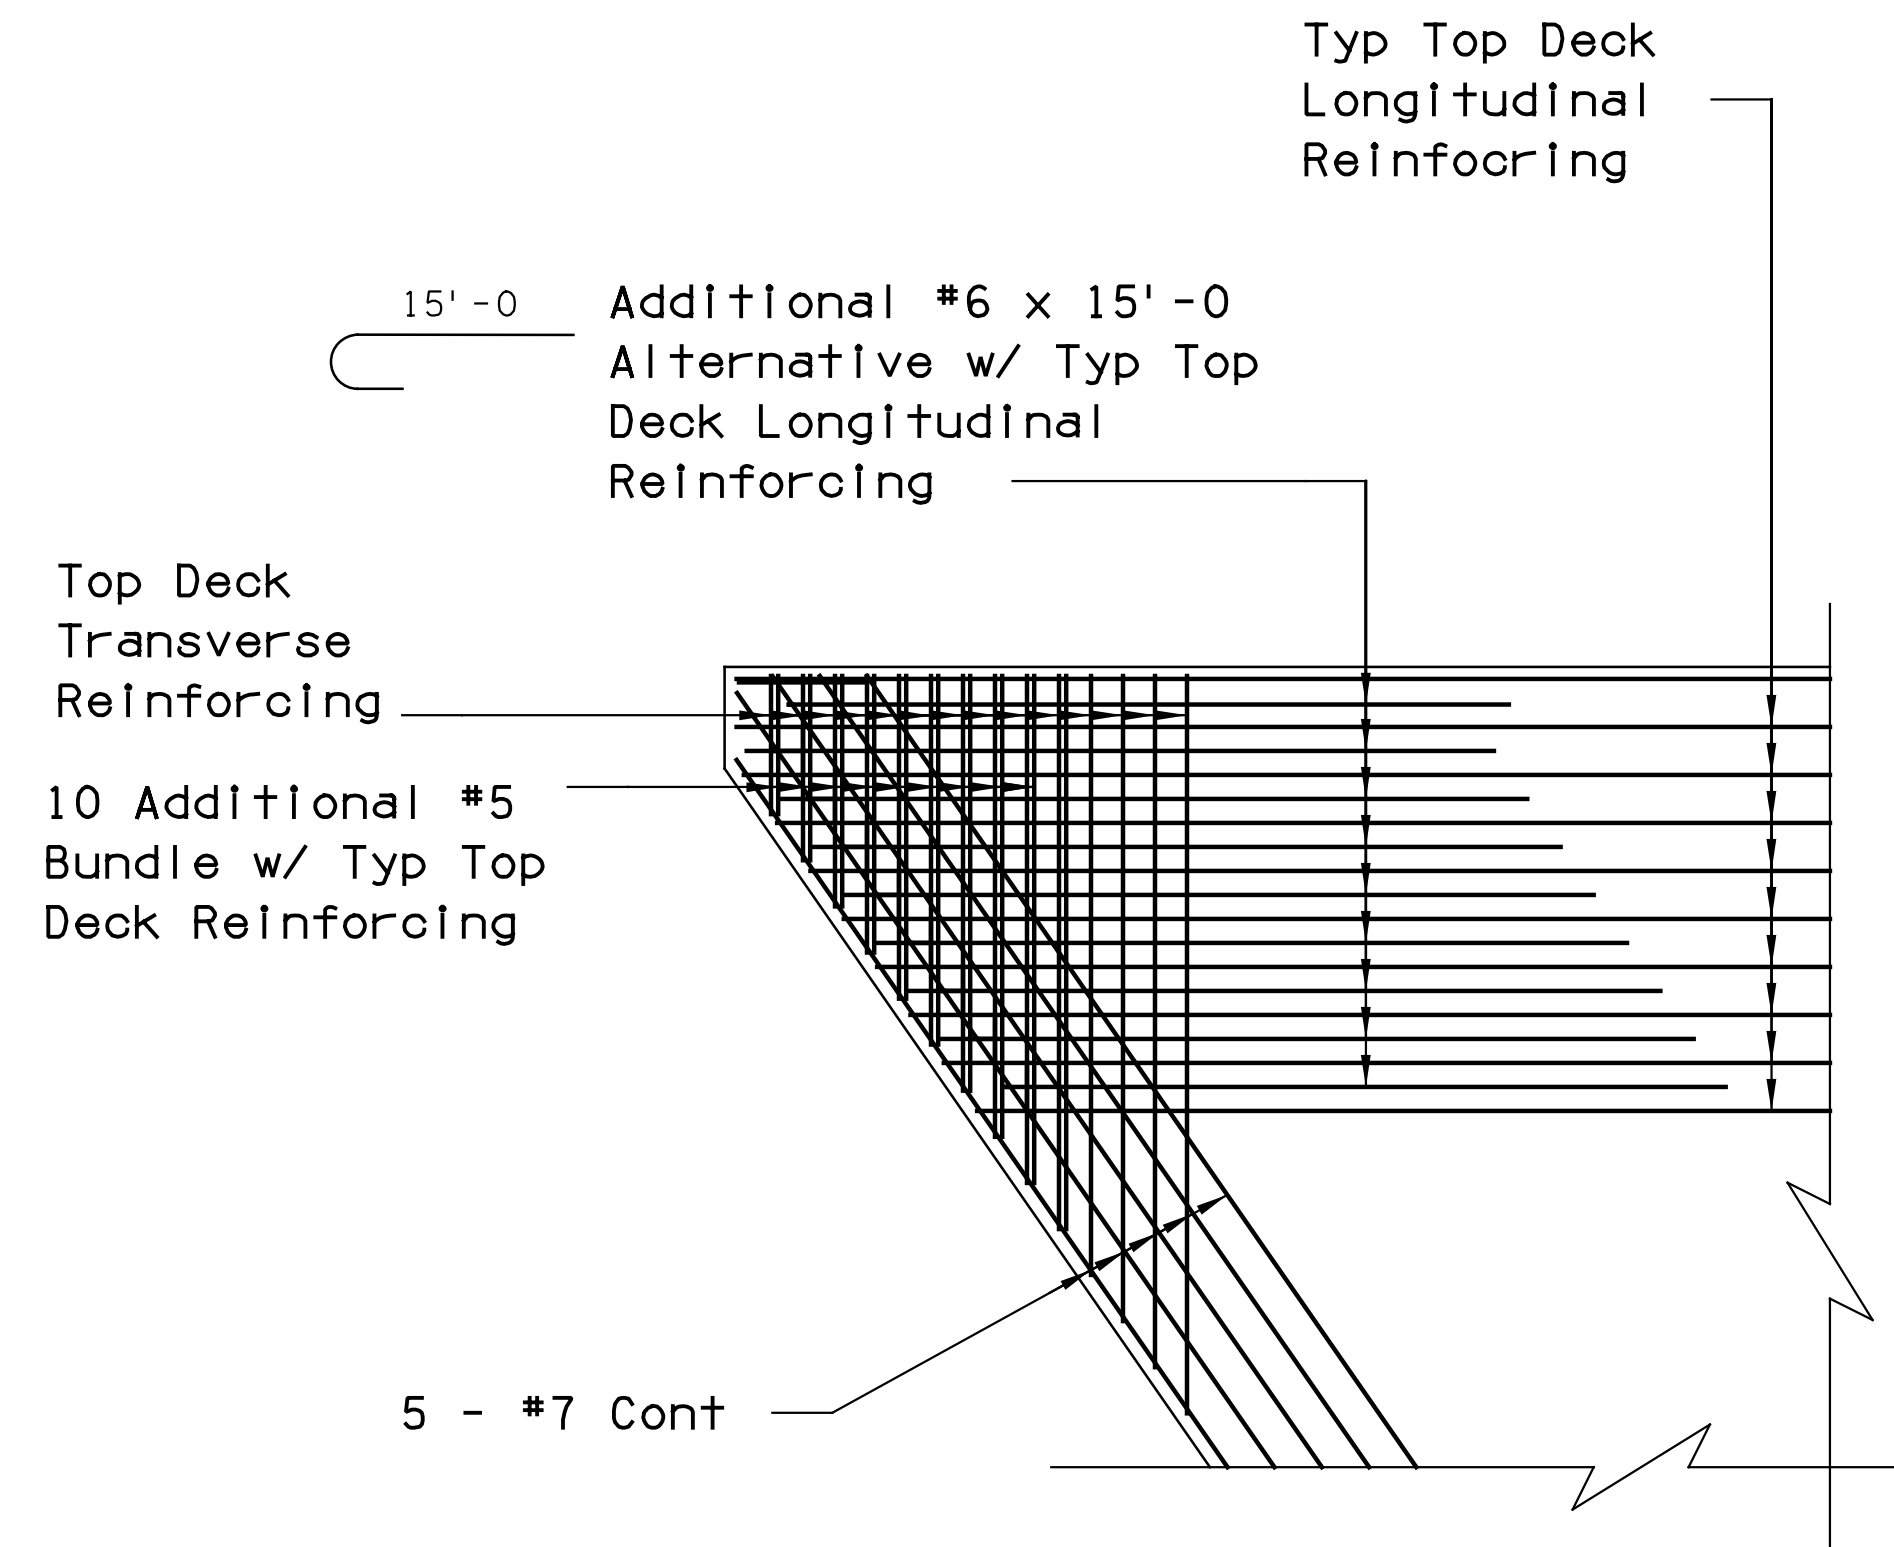


**TYPICAL DECK CORNER REINFORCING DETAILS**  
Scale: 1/4" = 1'-0

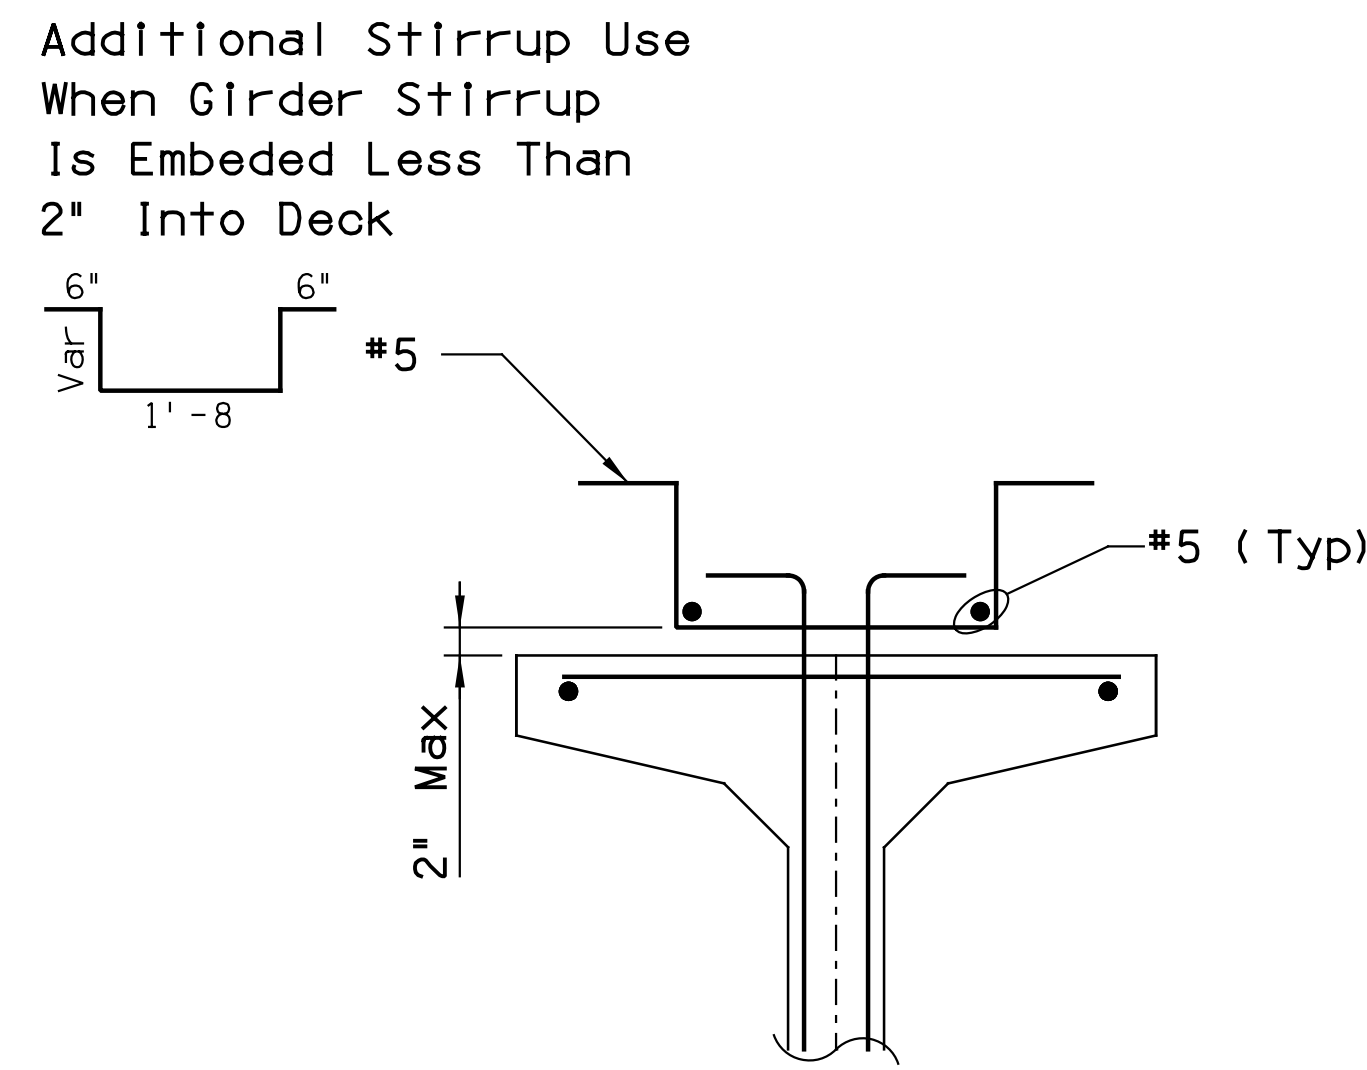

**ADDITIONAL STIRRUP DETAILS**  
Scale: 1/16" = 1'-0

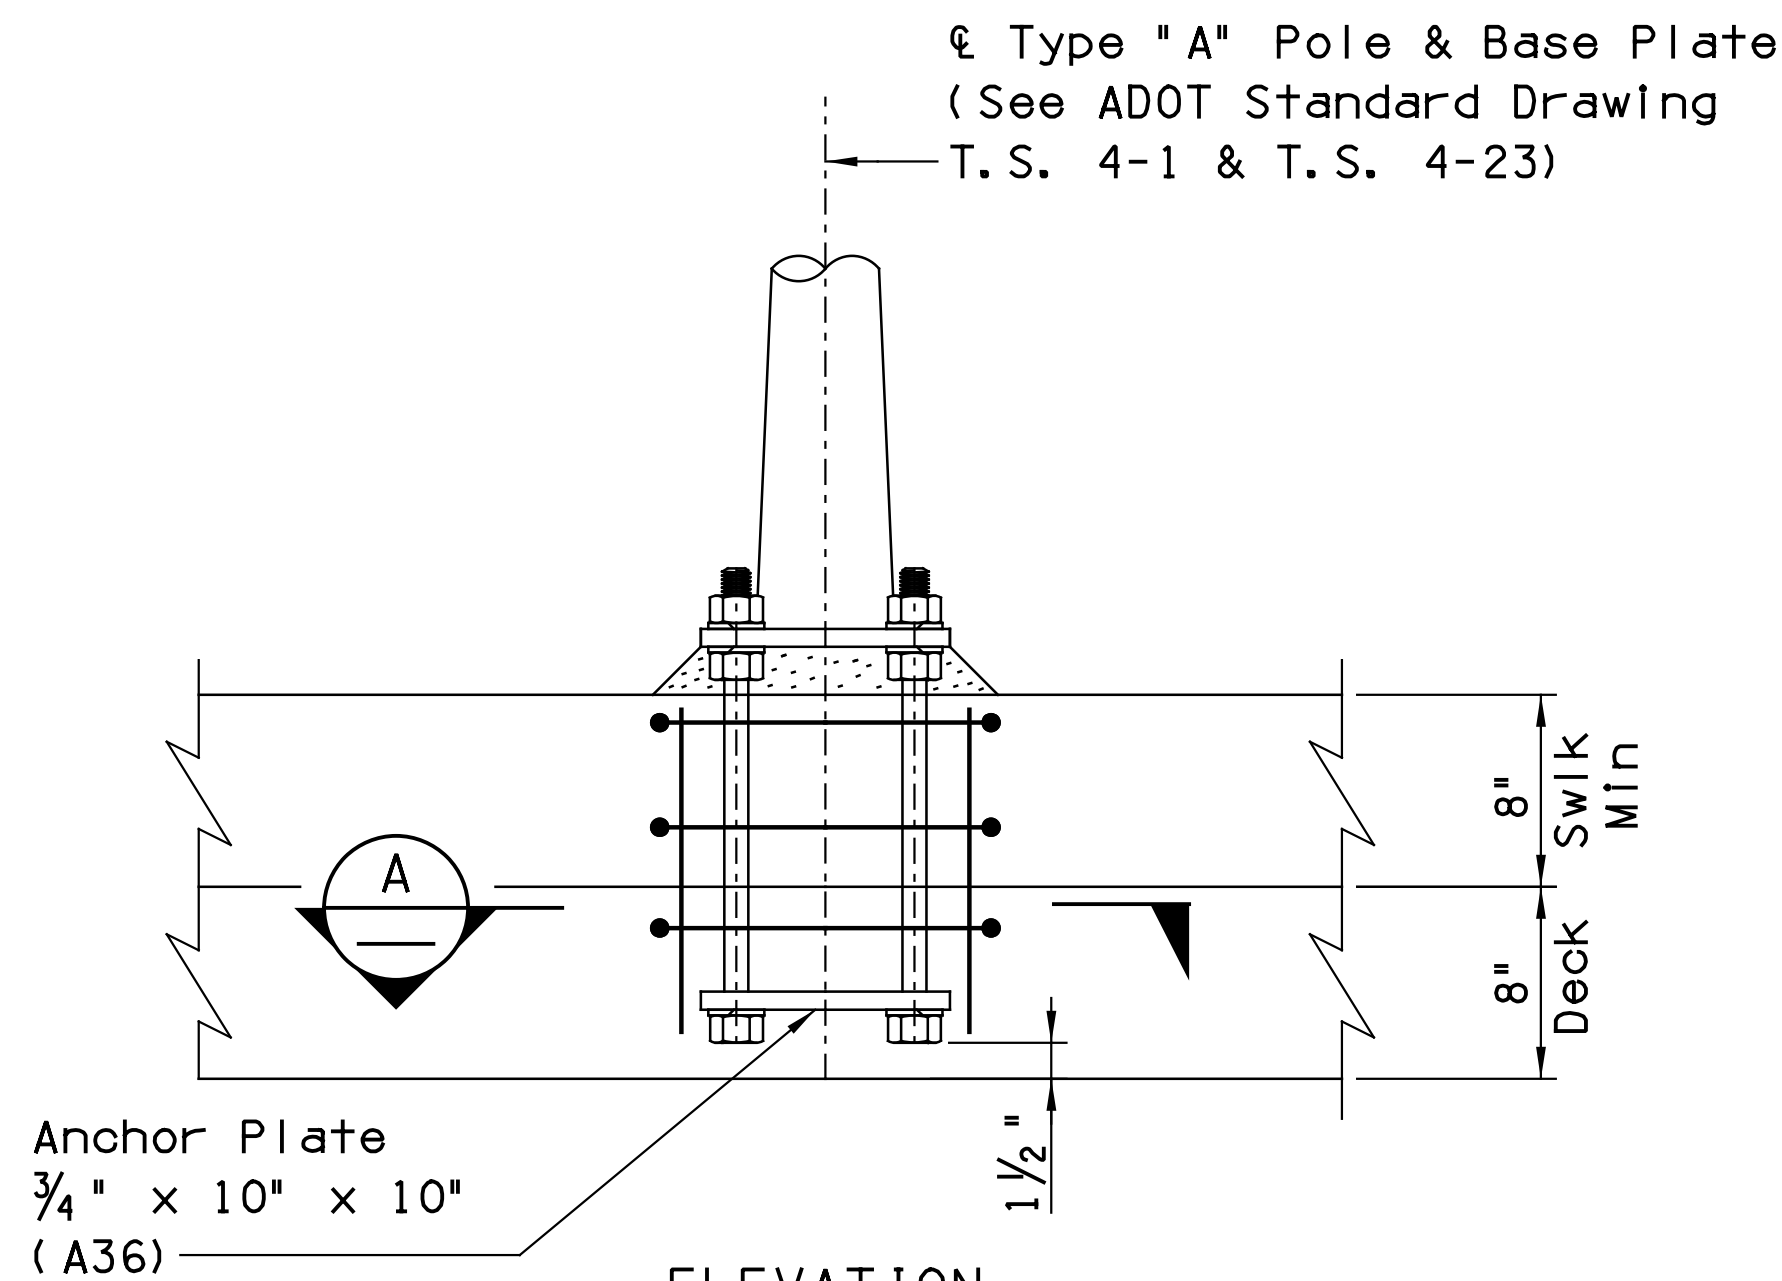


**ELEVATION**  
**DETAIL**  
Scale: 1 1/2" = 1'-0

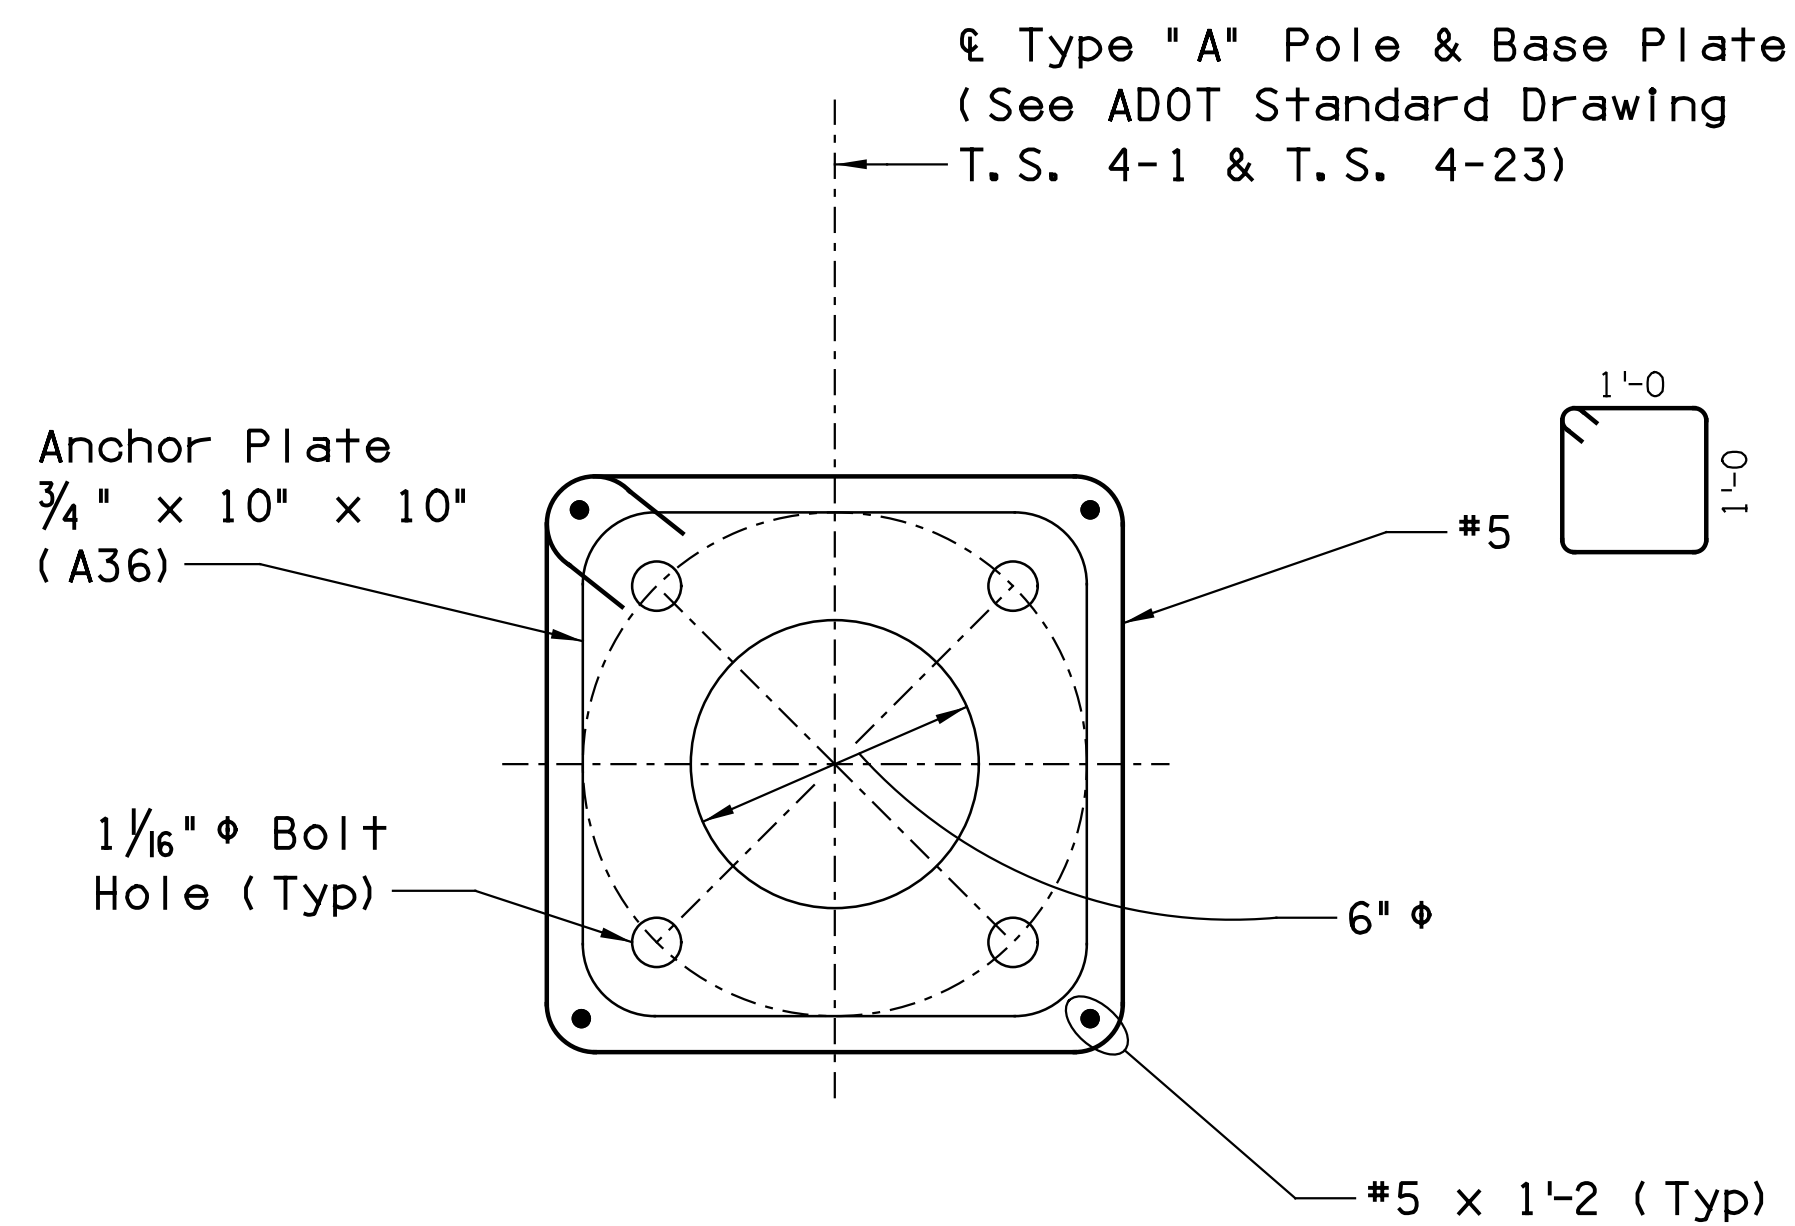

**SECTION**  
Scale: 3" = 1'-0

DESIGN	NAME	DATE	ARIZONA DEPARTMENT OF TRANSPORTATION INFRASTRUCTURE DELIVERY AND OPERATIONS DIVISION BRIDGE GROUP
KLH		03/19	<b>Sta 103+</b> <b>RUTHRAUFF RD - UPRR OVERPASS  DECK DETAILS</b>
DRAWN	AJM	03/19	
CHECKED	JRP	03/19	
<b>TY-LIN INTERNATIONAL</b> engineers   planners   scientists 60 E. Rio Salado Parkway, Suite 501 Tempe, Arizona 85281			<b>LOCATION</b> RUTHRAUFF TI
I-10	252.000	20160	<b>EXPRESS</b> 12/31/2019 DWG. S-2 .21
ROUTE	MILEPOST	STRUCTURE NO.	<b>TRACS NO.</b> H8480 01C 010-D(213)S OF

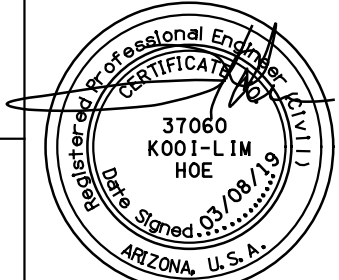


Plot Driver: ...TYLI PLTDRVADOT.PDF FULL.plt  
 SURVEY NO. FINISHED PLANS  
 Penable: ...TYLI PLTDRVopenSTDPLOT.TBL  
 REVISIONS-  
 LOCATION-  
 FINISHED PLANS-  
 REVISIONS-  
 LOCATION-  
 DATE-  
 SURVEY NO. FINISHED PLANS-  
 REVISIONS-  
 LOCATION-  
 DATE-



F.H.W.A. REGION	STATE	PROJECT NO.	SHEET NO.	TOTAL SHEETS	RECORD DRAWING
9	ARIZ.	010-D(213)S	677	849	

010 PM 252

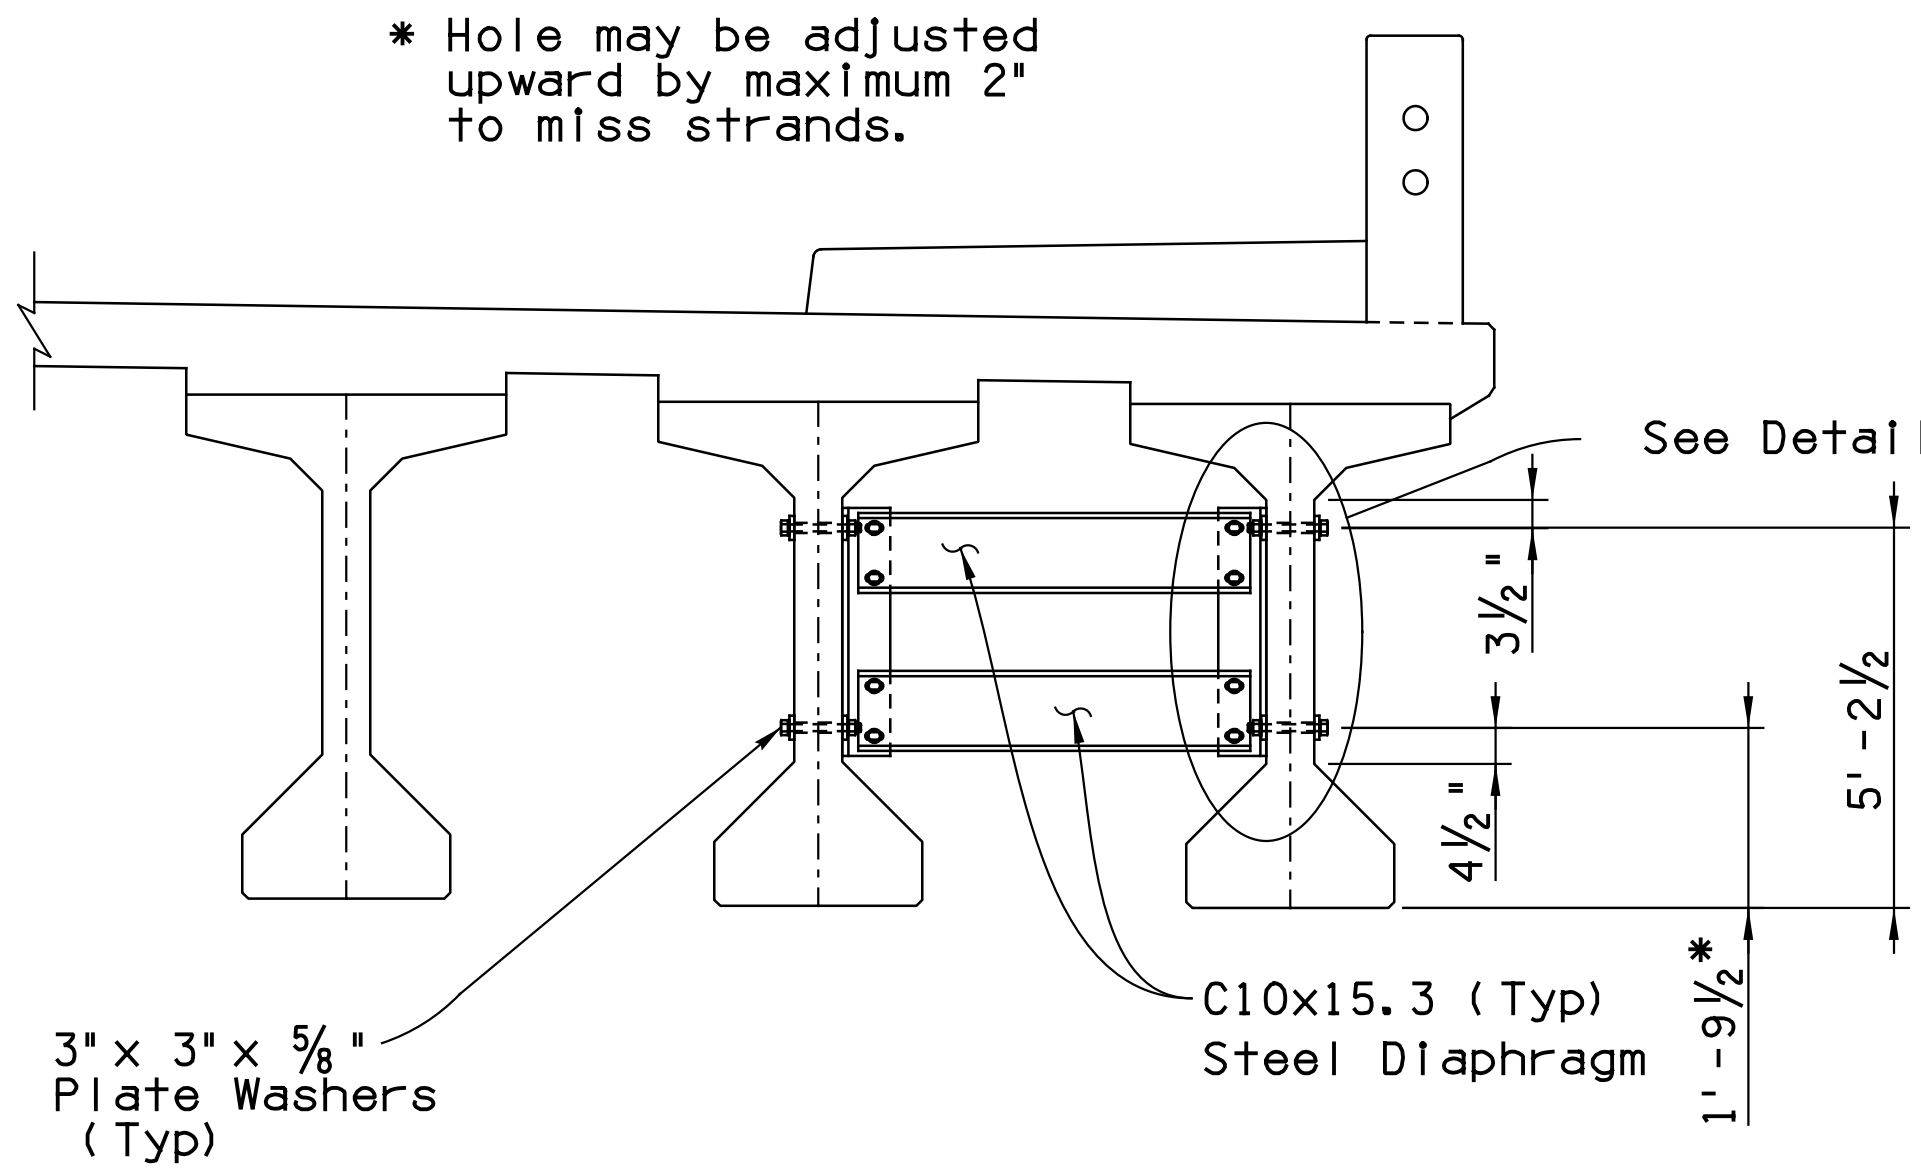


TYPICAL INTERMEDIATE DIAPHRAGM

Scale: 1/2" = 1'-0"


STEEL INTERMEDIATE DIAPHRAGM NOTES:

1. All structural steel shall be ASTM A36, galvanized as per ASTM A153, Class C.
2. All bolts are 7/8" dia. ASTM A325, Type 1. All bolts, nuts and washers shall be galvanized as per ASTM A153, Class C.
3. Bolt holes in the concrete girder webs shall be located to avoid prestressing strands.
4. The placement of deck concrete shall not proceed until all intermediate diaphragms have been properly installed.
5. Intermediate diaphragm should be bolted immediately after girder placement.
6. Bolt holes shall be cast-in-place and not drilled.

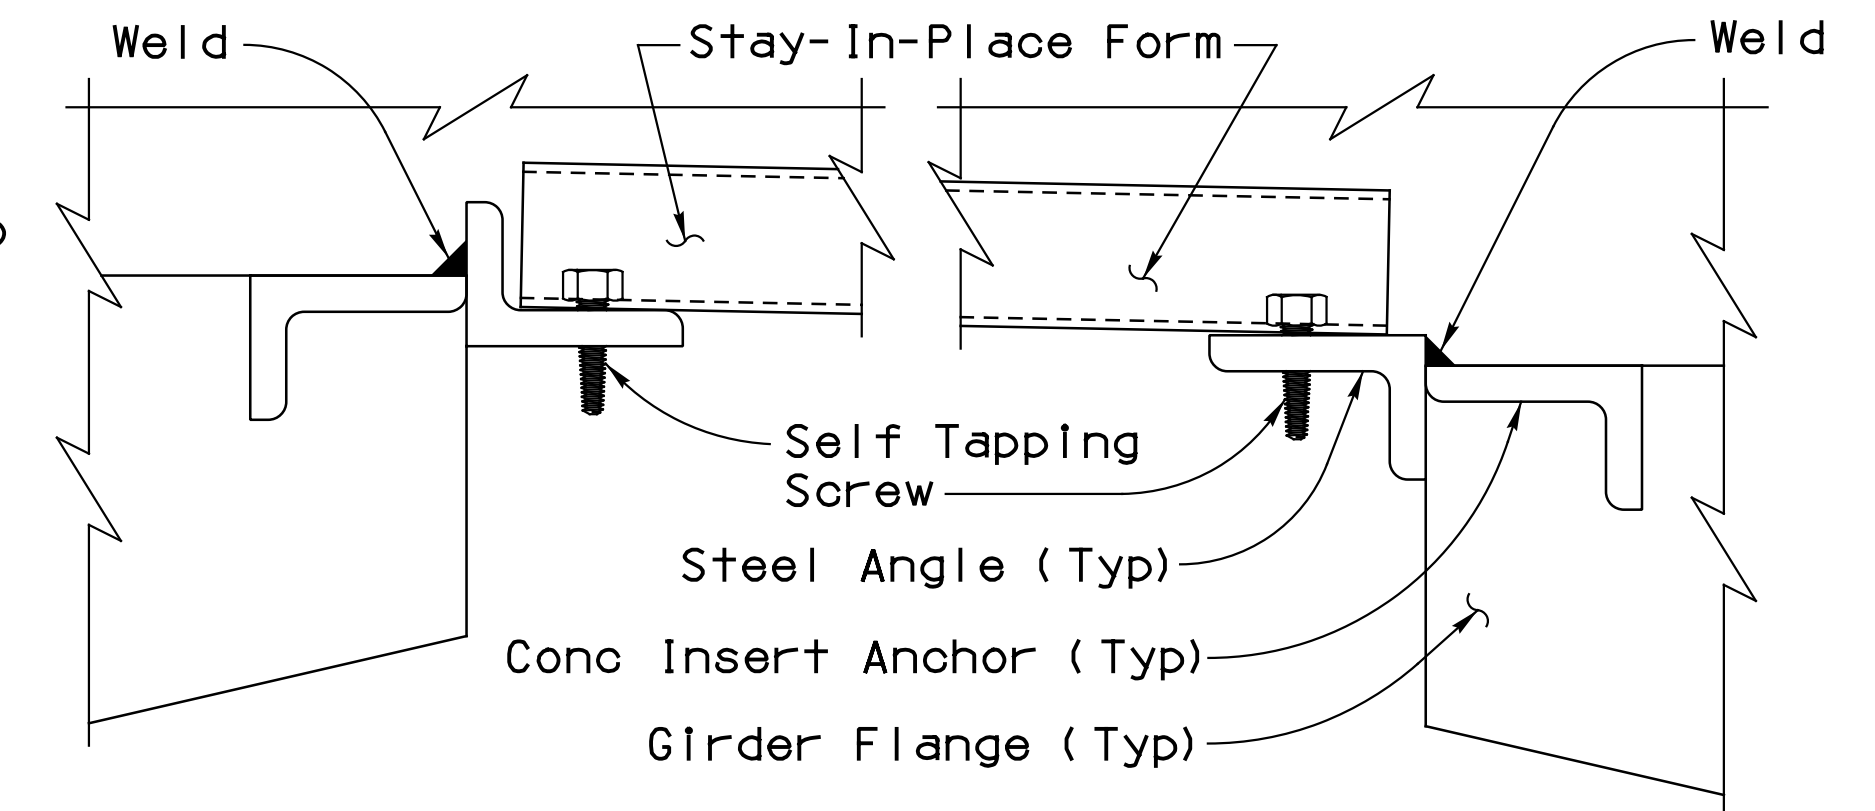


TYPICAL STAY-IN-PLACE DECK FORM DETAIL

Not To Scale

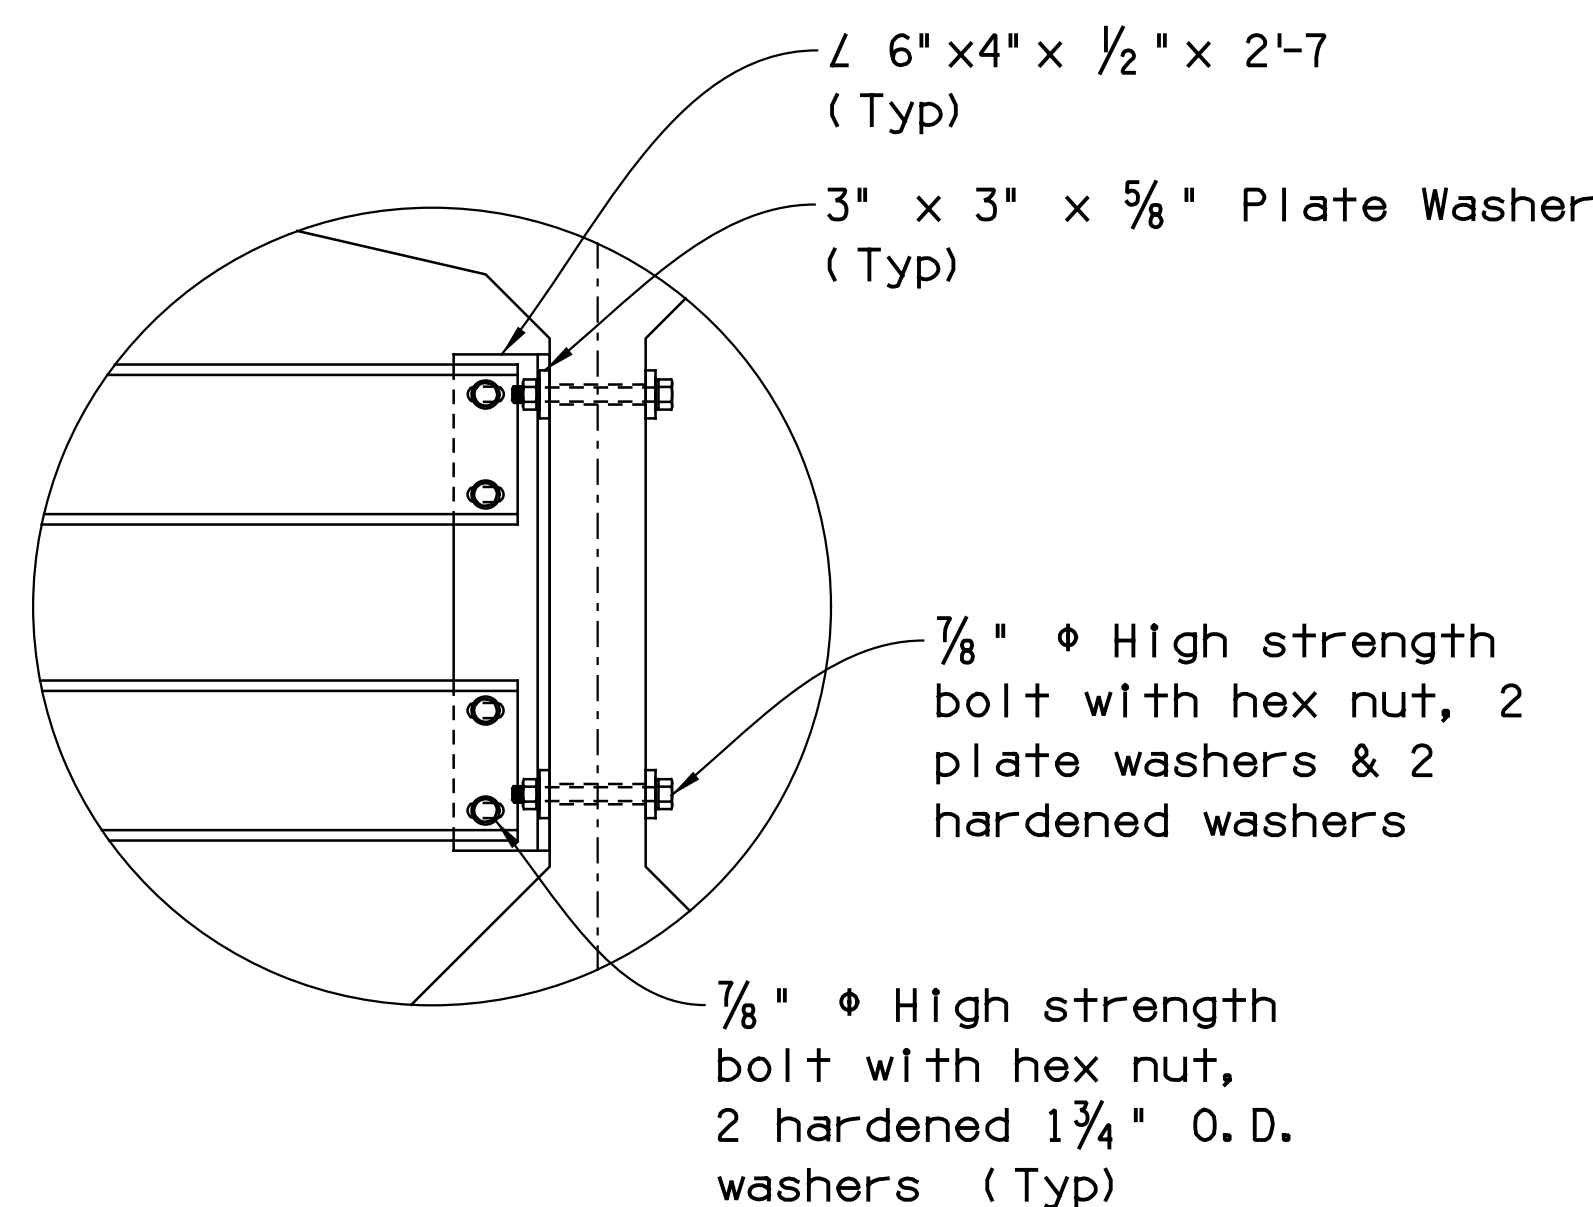

DETAIL

Scale: 1" = 1'-0"

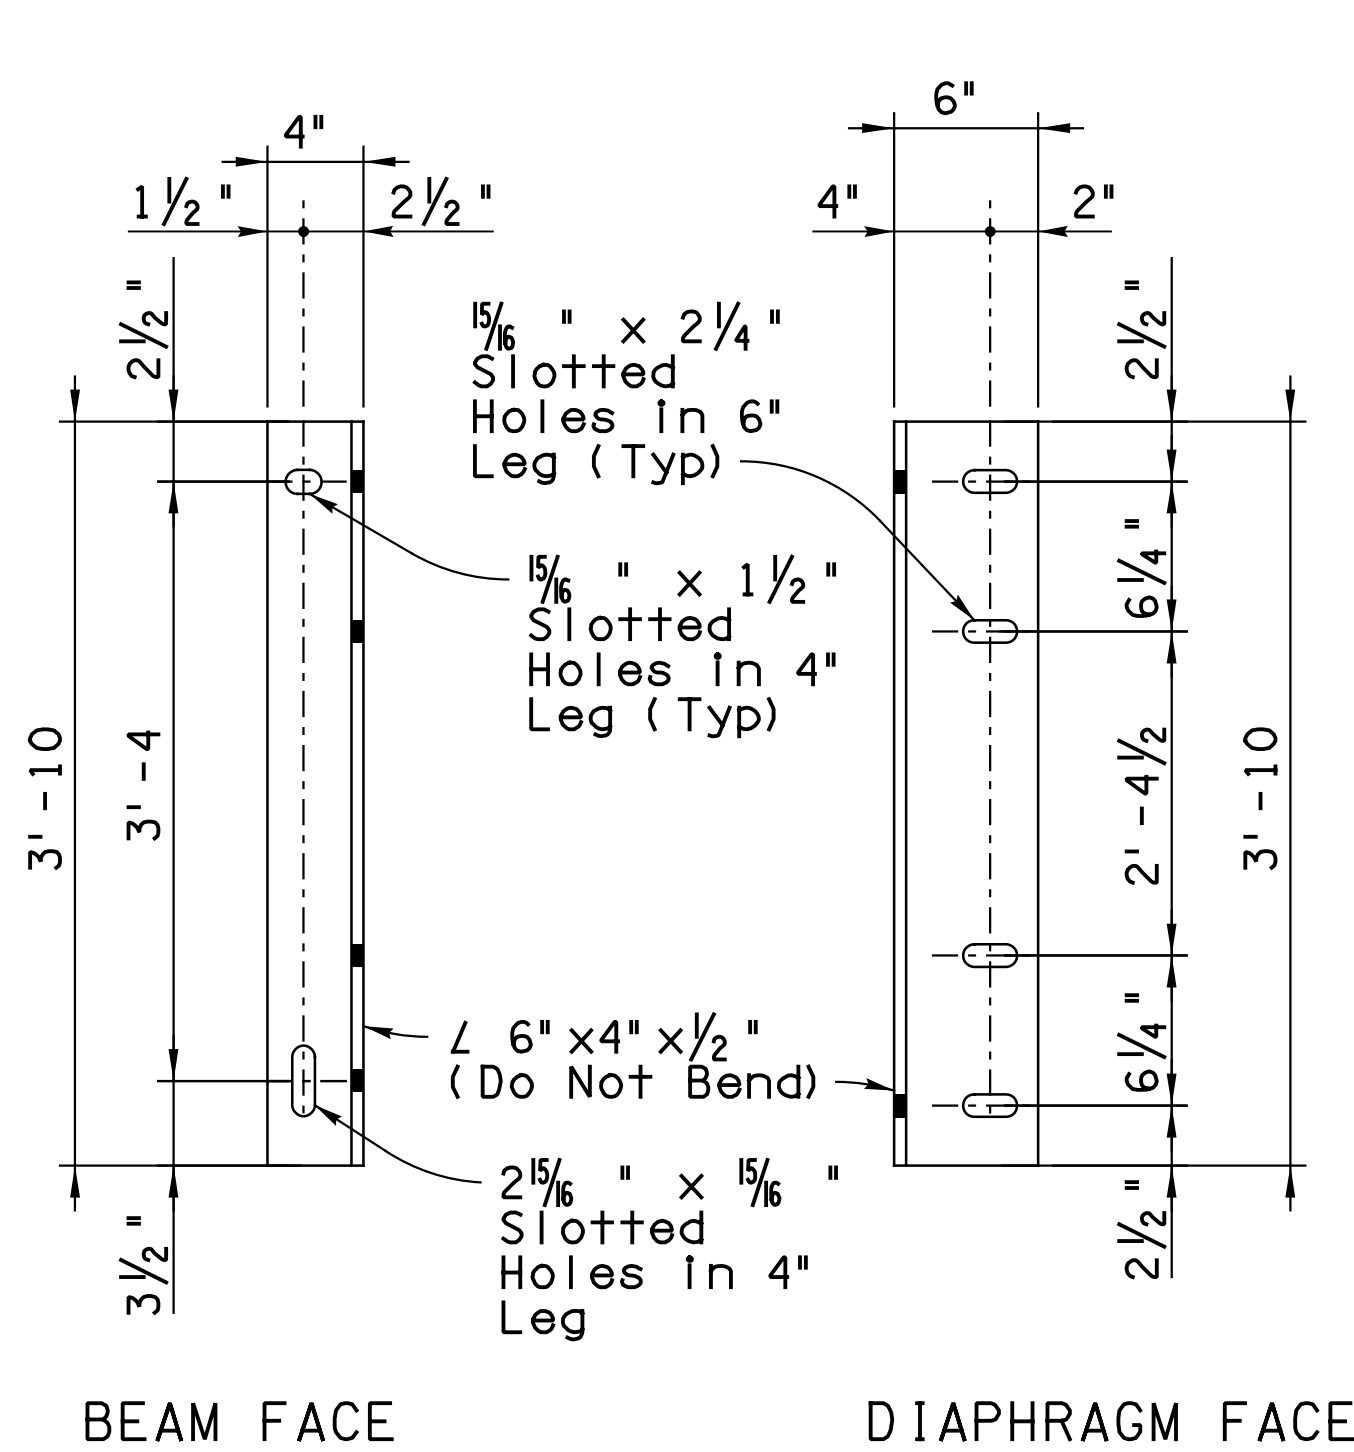

BEAM FACE

DIAPHRAGM FACE

DIAPHRAGM SUPPORT DETAILS

Scale: 1 1/2" = 1'-0"

STAY-IN-PLACE DECK FORM NOTES:

The elevation at the top of the girders shall be measured after erection of the girders and prior to placement of the deck forms.

The concrete insert anchors may be cast with the girder to accommodate the use of stay-in-place forms. Alternate methods of support will be considered provided the detail is adequate to support the loads, prevent leakage and allow for the adjustment for the varying build-up to maintain a constant deck thickness.

The deck panels, angles and screws shall be galvanized in accordance with the manufacturer's recommendations.

The Contractor shall submit drawings showing details of the stay-in-place deck forms including the method of installation and adjustment to the Bridge Engineer for approval. The deck form submittal must be made simultaneously with the precast girder shop drawings to ensure coordination between the girder fabrication and the stay-in-place forms design.

The Contractor shall determine the sizes of all welds, screws, angles, etc to support the required loads.


The cost of stay-in-place forms is included in the cost of deck concrete. The quantity of deck concrete includes the concrete in the stay-in-place deck forms.

The bridge has been designed for a maximum dead load of 15.0 psf for stay-in-place deck panels and extra concrete.


DESIGN	NAME	DATE	ARIZONA DEPARTMENT OF TRANSPORTATION INFRASTRUCTURE DELIVERY AND OPERATIONS DIVISION BRIDGE GROUP		
KLH		03/19	<b>Sta 103+</b> <b>RUTHRAUFF RD - UPRR OVERPASS  SUPERSTRUCTURE DETAILS</b>		
DRAWN	AJM	03/19			
CHECKED	JRP	03/19			
<b>TY LIN INTERNATIONAL</b> engineers   planners   scientists 60 E. Rio Salado Parkway, Suite 501 Tempe, Arizona 85281					
I-10	252.000	20160	LOCATION RUTHRAUFF TI		
ROUTE	MILEPOST	STRUCTURE NO.	Exp. Press 12/31/2019		
TRACS NO. H8480 01C			DWG. S-2 .22		
			010-D(213)S		
			OF		

F.H.W.A. REGION	STATE	PROJECT NO.	SHEET NO.	TOTAL SHEETS	RECORD DRAWING
9	ARIZ.	010-D(213)S	678	849	


010 PM 252

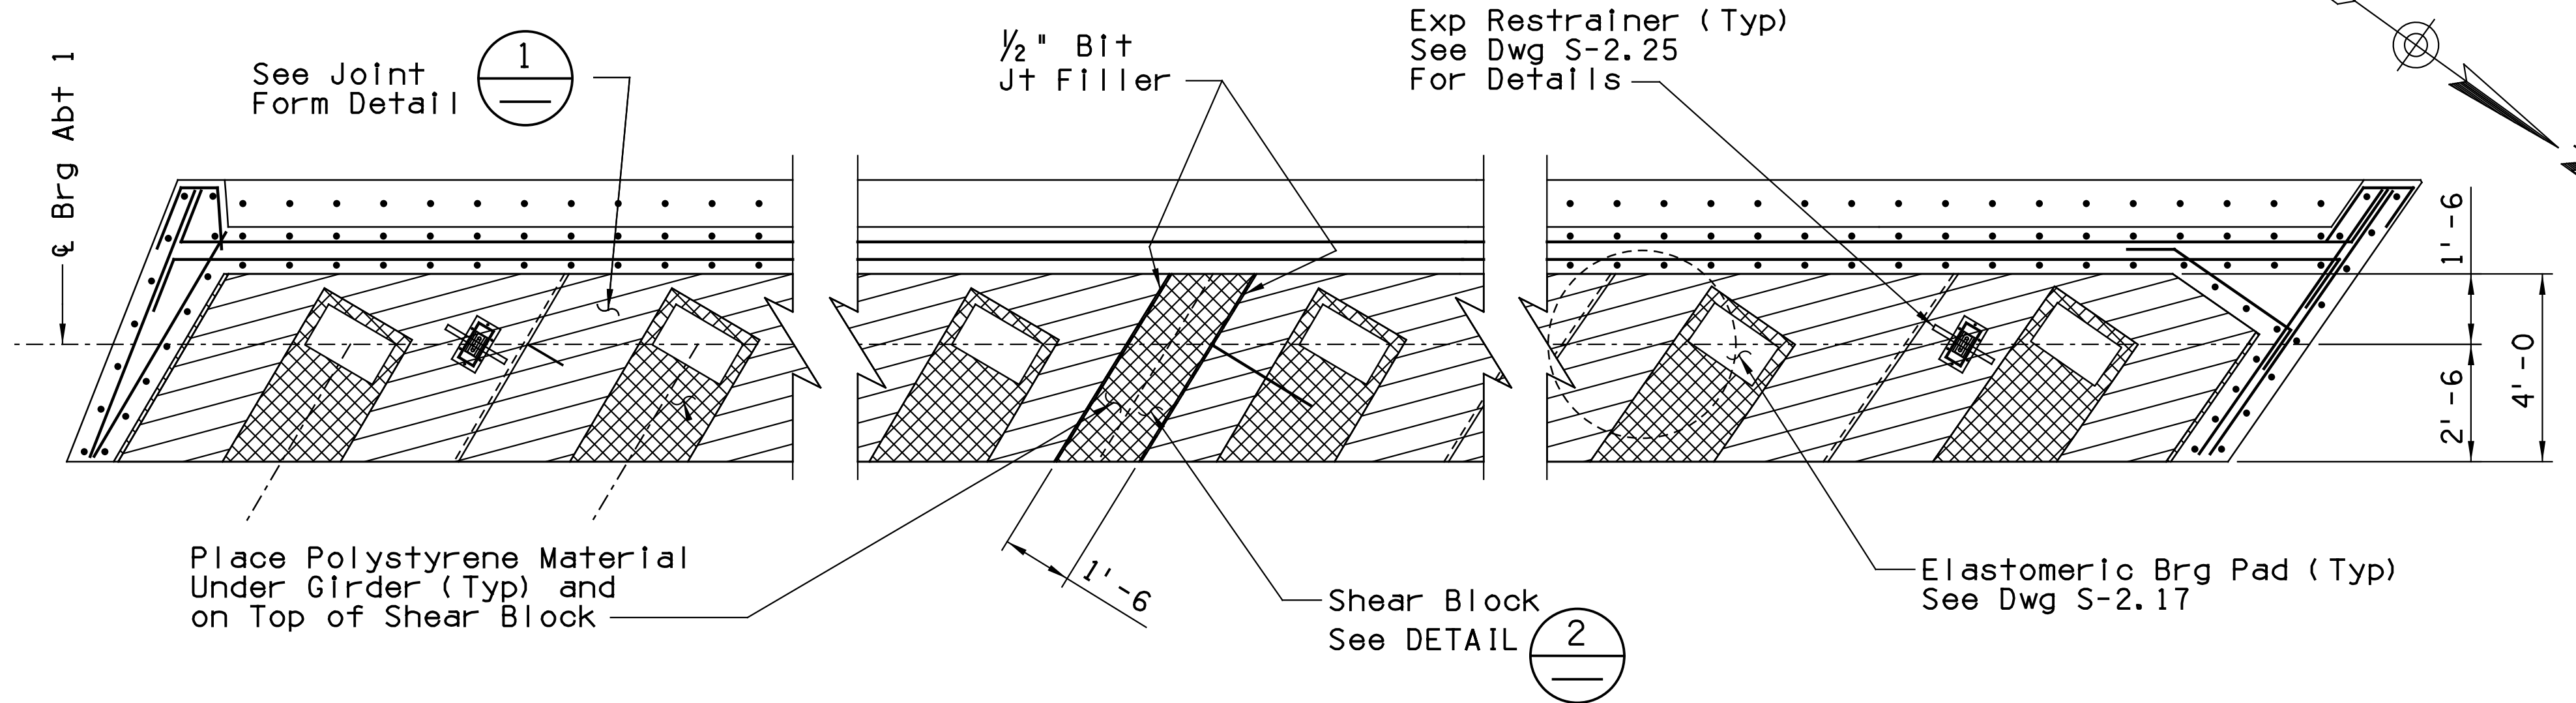


**PARTIAL PLAN AT ABUTMENT 1**  
Scale: 3/8" = 1'-0"

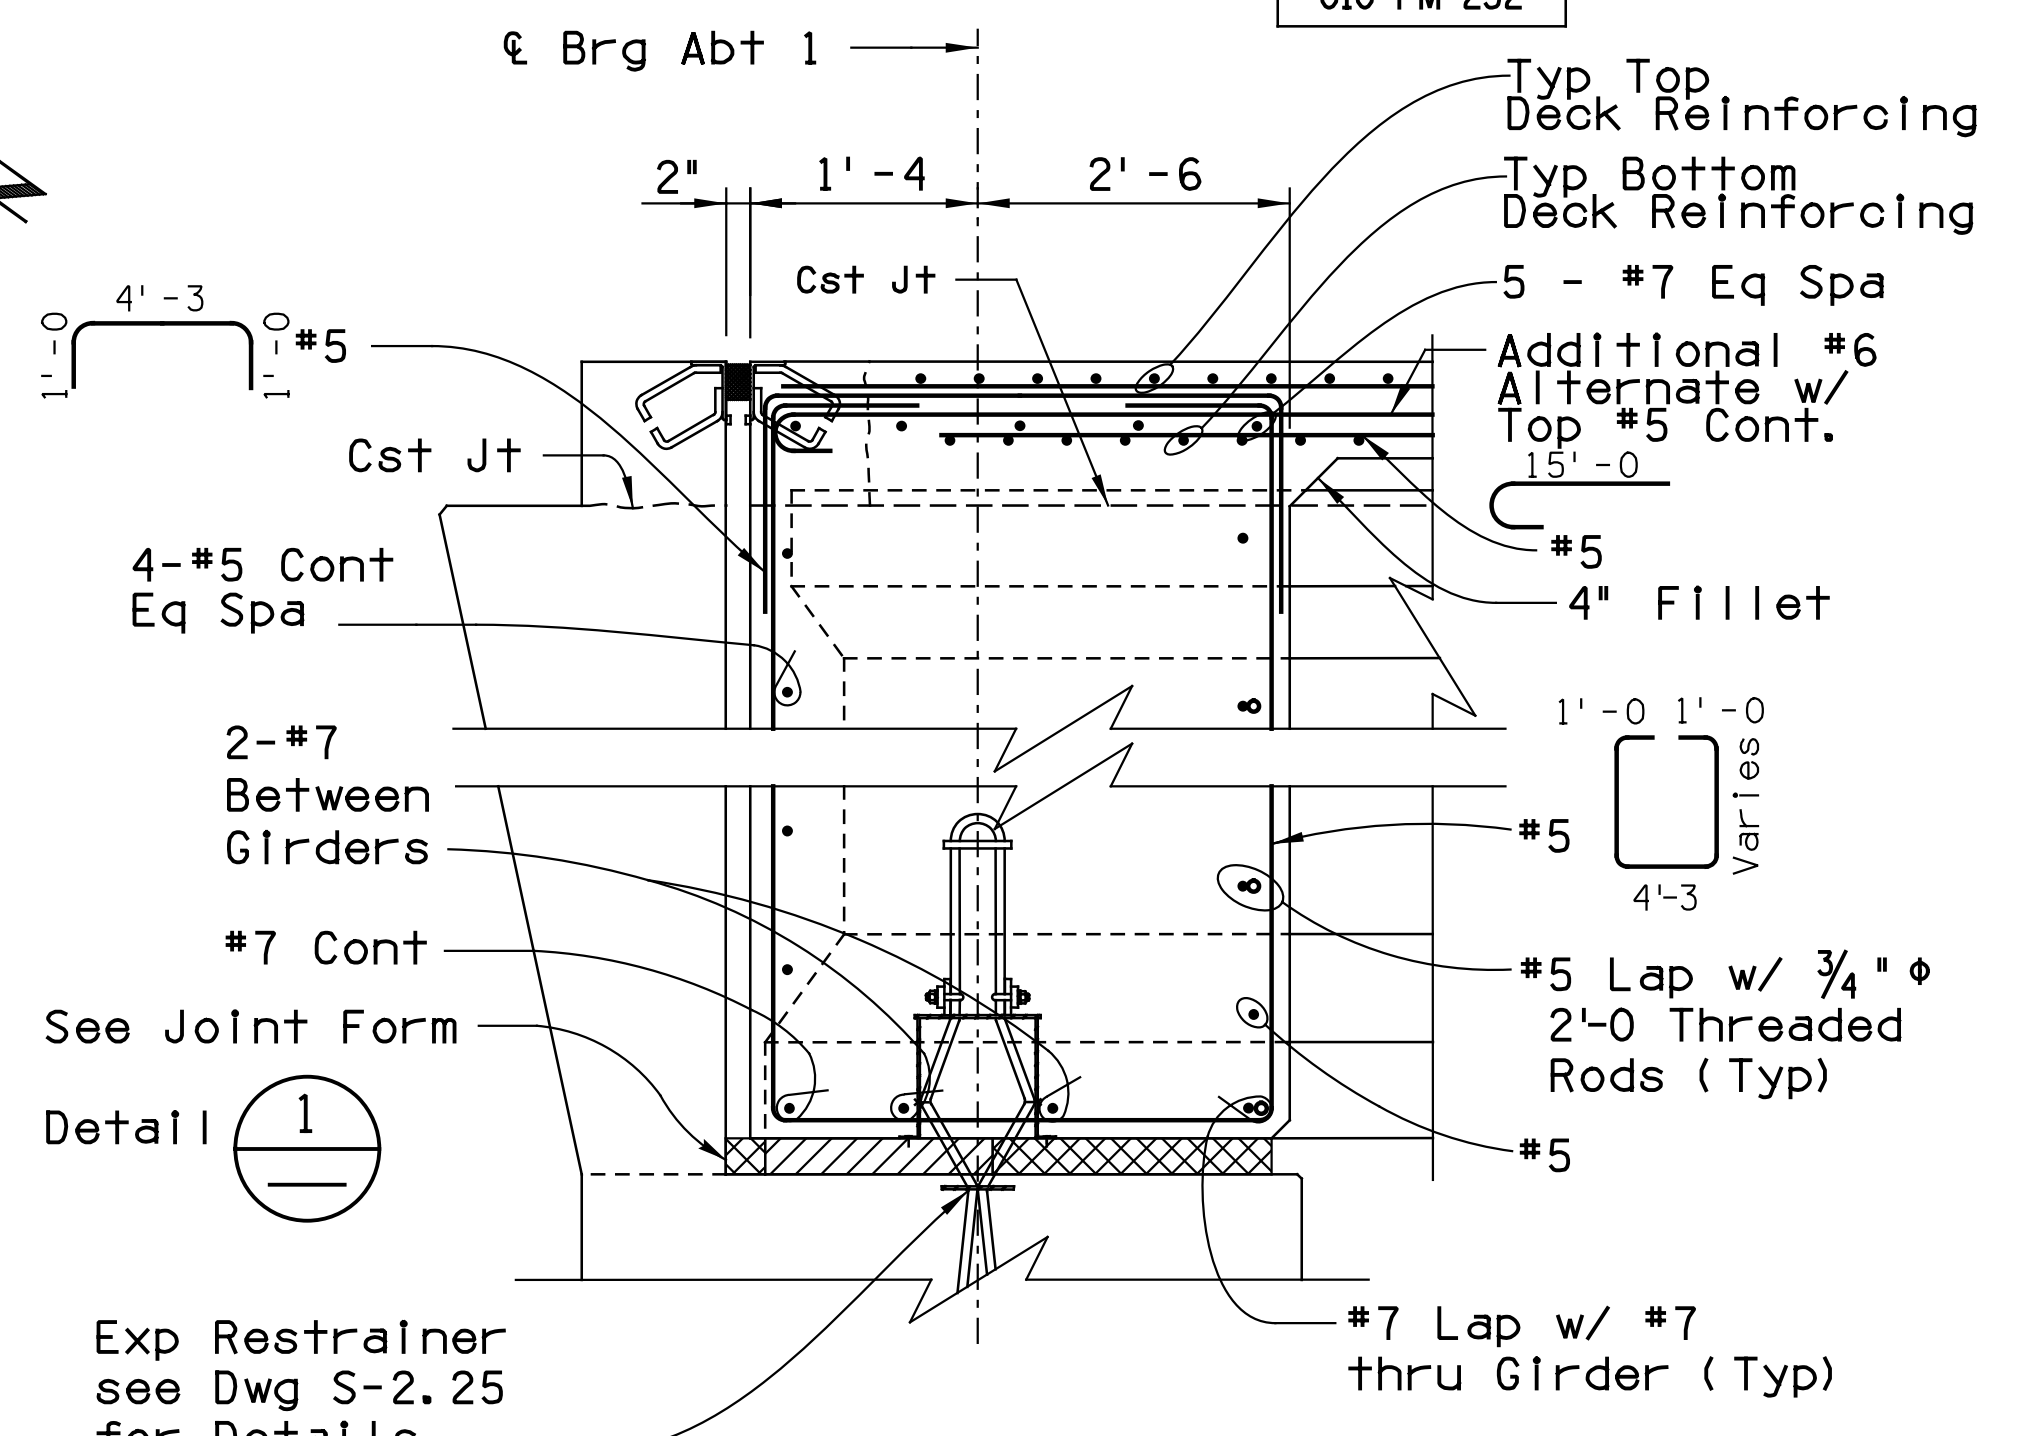


**SECTION A**  
Scale: 3/4" = 1'-0"

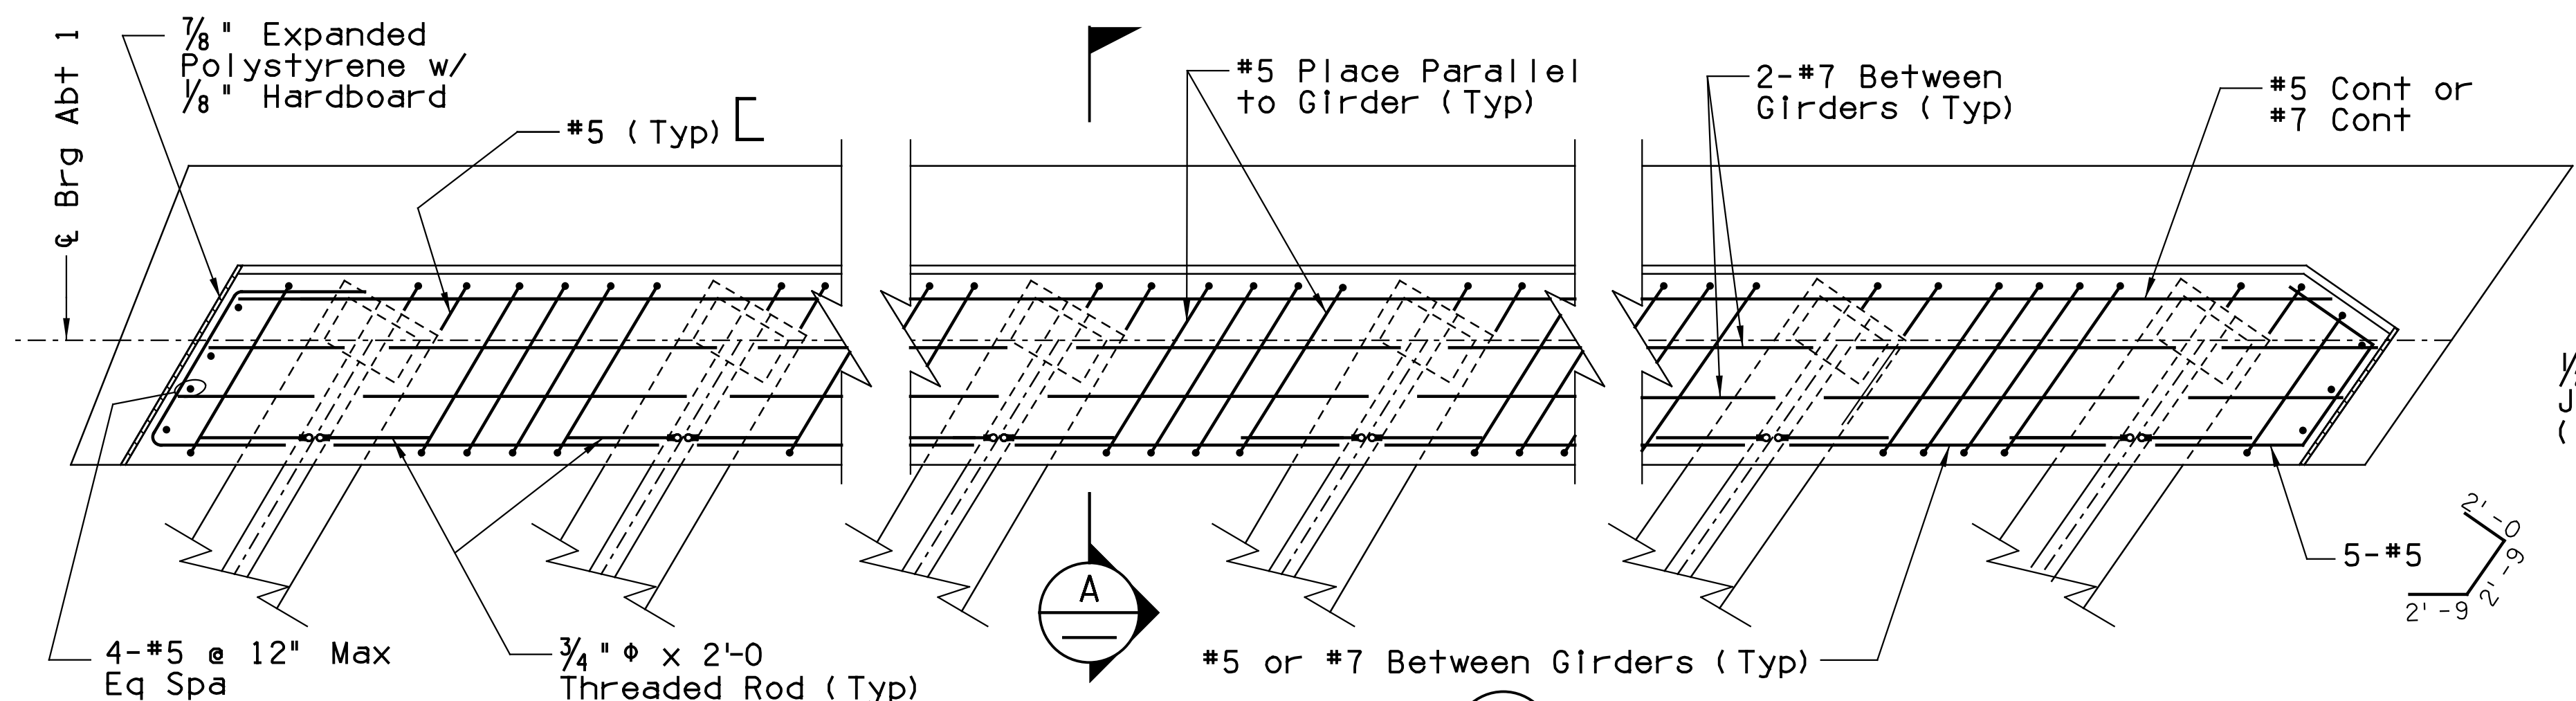

**SECTION B**  
Scale: 3/8" = 1'-0"

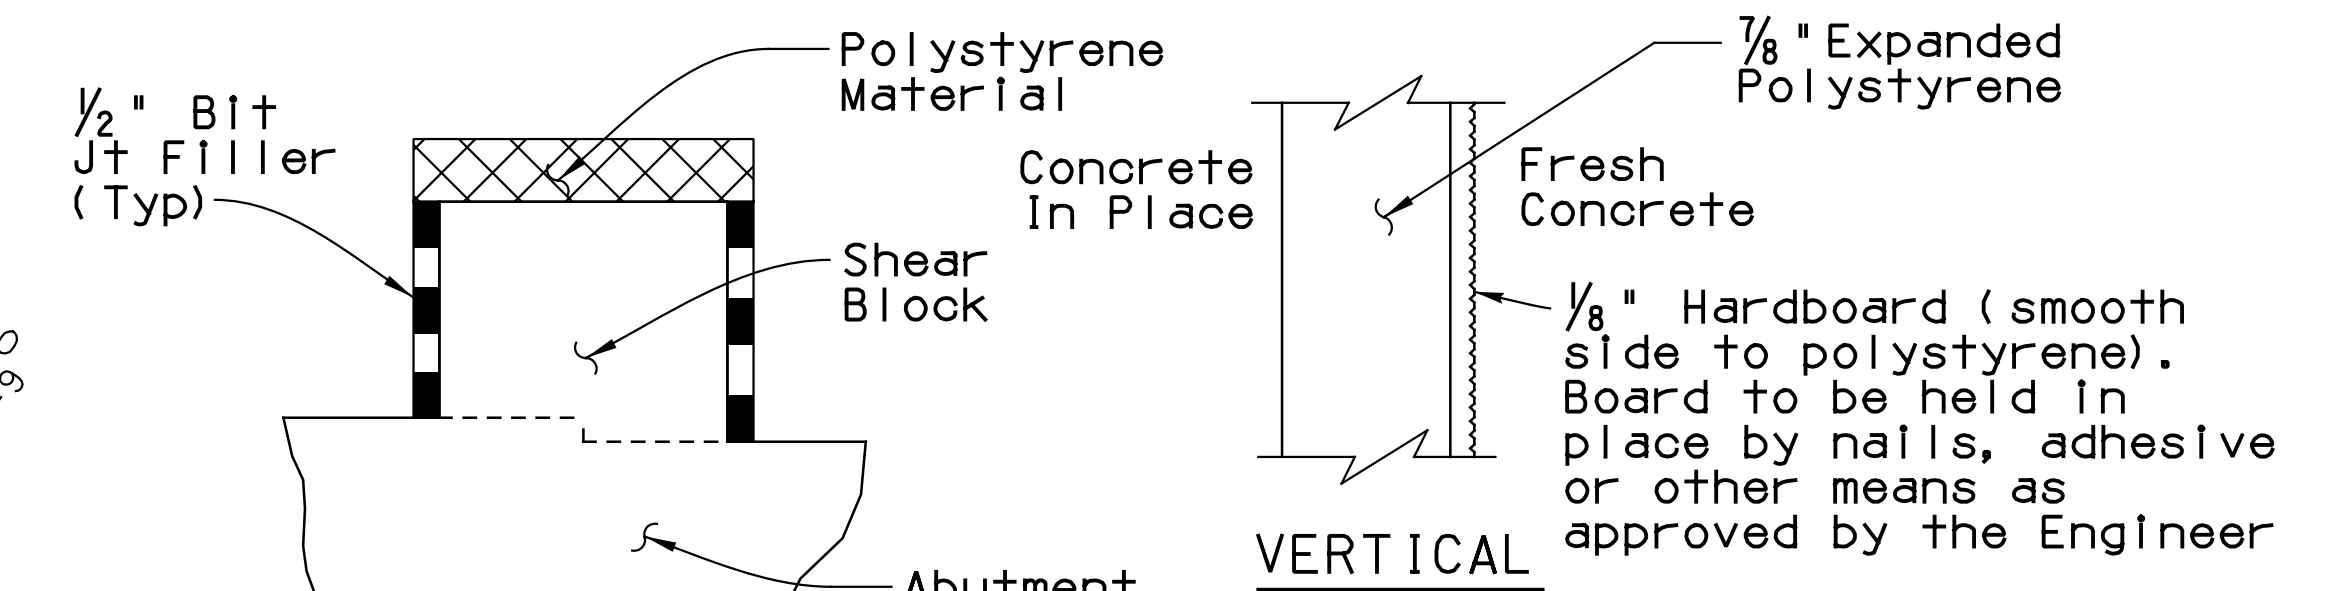

**DETAIL 2**  
Not To Scale

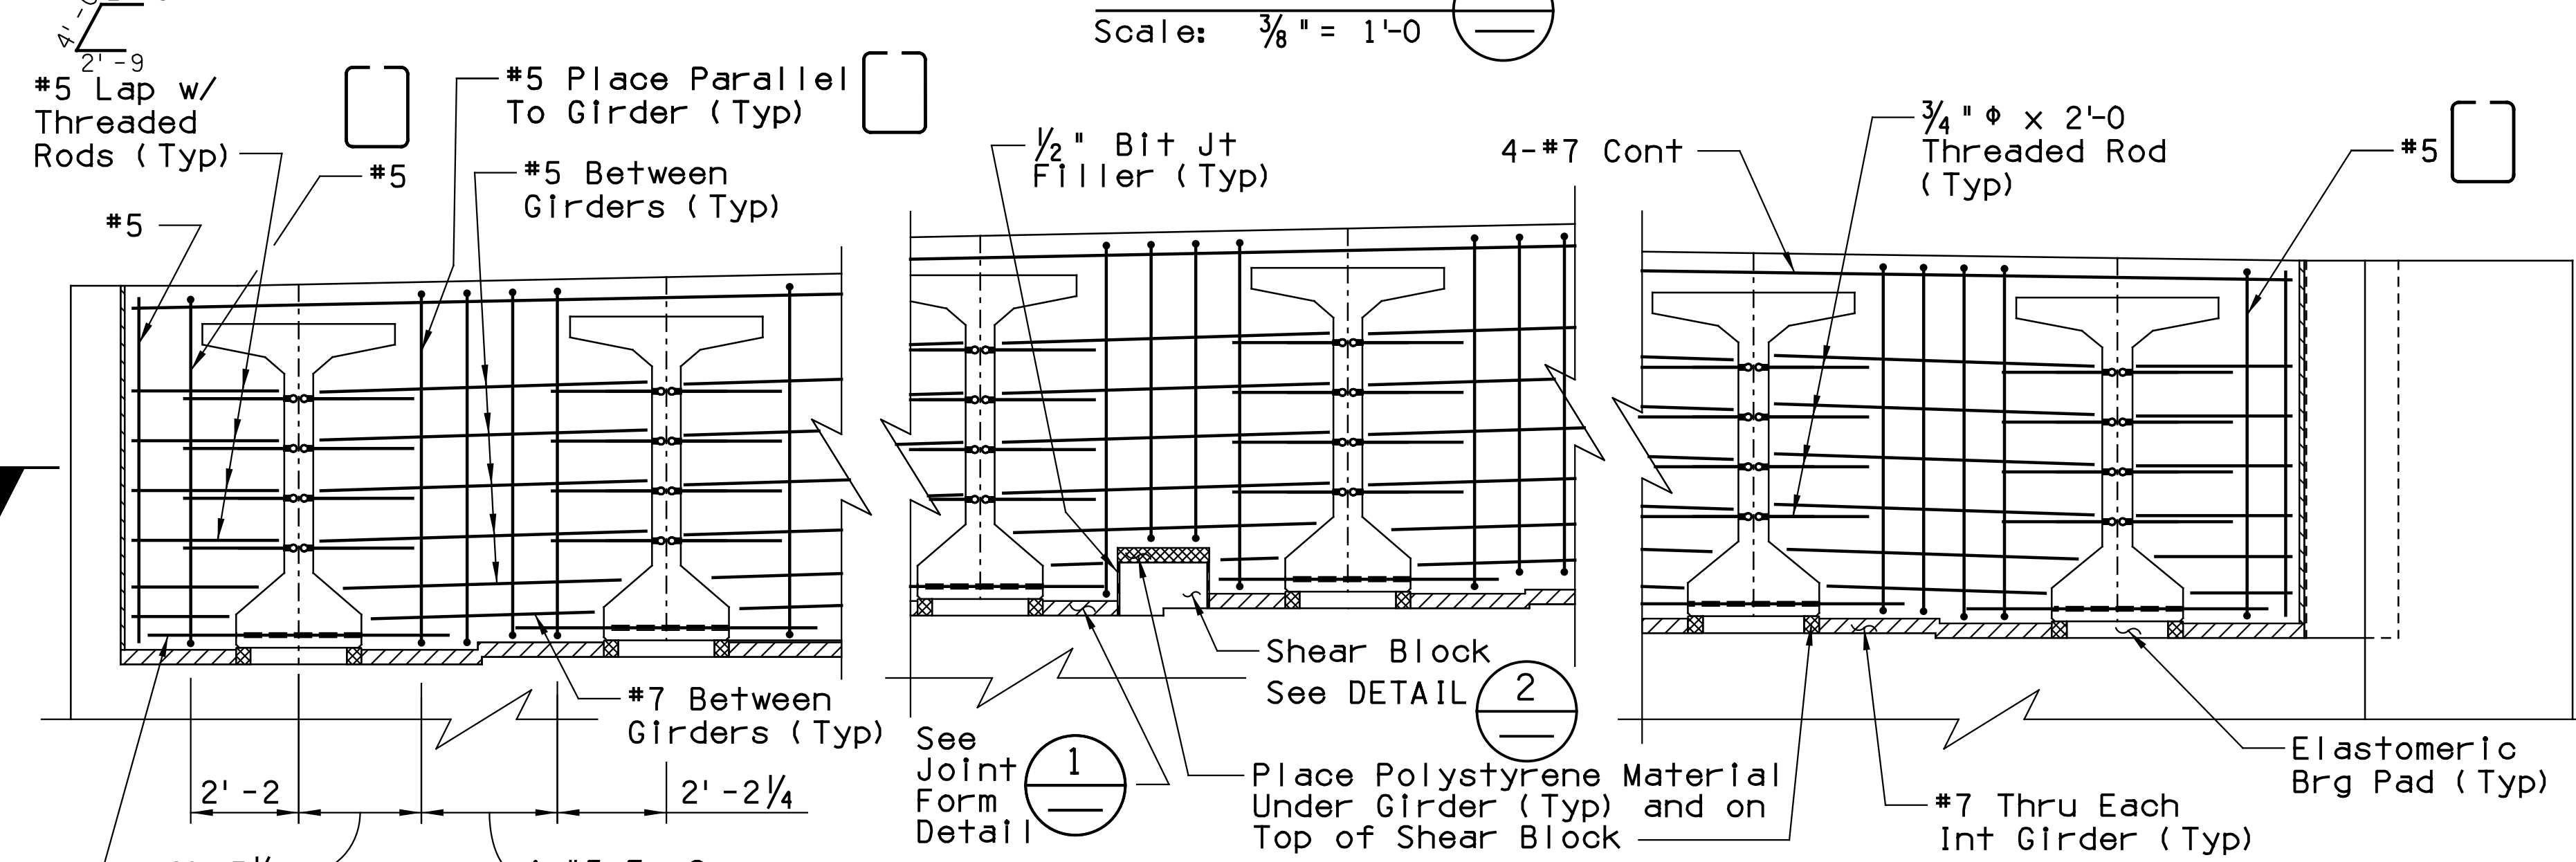

**PARTIAL DIAPHRAGM ELEVATION AT ABUTMENT 1**  
Scale: 3/8" = 1'-0"

**NOTE:**  
Hardboard to be used on any polystyrene face against which concrete is to be placed.


**JOINT FORM DETAIL 1**  
Not To Scale

DESIGN	KLH	DATE	03/19	ARIZONA DEPARTMENT OF TRANSPORTATION INFRASTRUCTURE DELIVERY AND OPERATIONS DIVISION <b>BRIDGE GROUP</b> Sta 103+ <b>RUTHRAUFF RD - UPRR OVERPASS</b> <b>ABUTMENT DIAPHRAGM DETAILS 1</b>	
DRAWN	AJM	03/19			
CHECKED	JRP	03/19			
<b>TY-LIN INTERNATIONAL</b> engineers   planners   scientists 60 E. Rio Salado Parkway, Suite 501 Tempe, Arizona 85281				LOCATION <b>RUTHRAUFF TI</b>	Exp. Press. 12/31/2019 DWG. S-2 .23
I-10	252.000	20160		TRACS NO. H8480 01C	010-D(213)S


Penable: ...TYLI PLTRVADOT PDF FULL.plt  
 Plot Driver: ...TYLI PLTRVADOT PDF FULL.plt  
 SURVEY NO. LOCATION: FINISHED PLANS-  
 REVISIONS-  
 DATE-  
 FINISHED PLANS-  
 SURVEY NO. LOCATION: FINISHED PLANS-  
 REVISIONS-  
 DATE-  
 FINISHED PLANS-  
 SURVEY NO. LOCATION: FINISHED PLANS-  
 REVISIONS-  
 DATE-  
 FINISHED PLANS-

F.H.W.A. REGION	STATE	PROJECT NO.	SHEET NO.	TOTAL SHEETS	RECORD DRAWING
9	ARIZ.	010-D(213)S	679	849	


010 PM 252

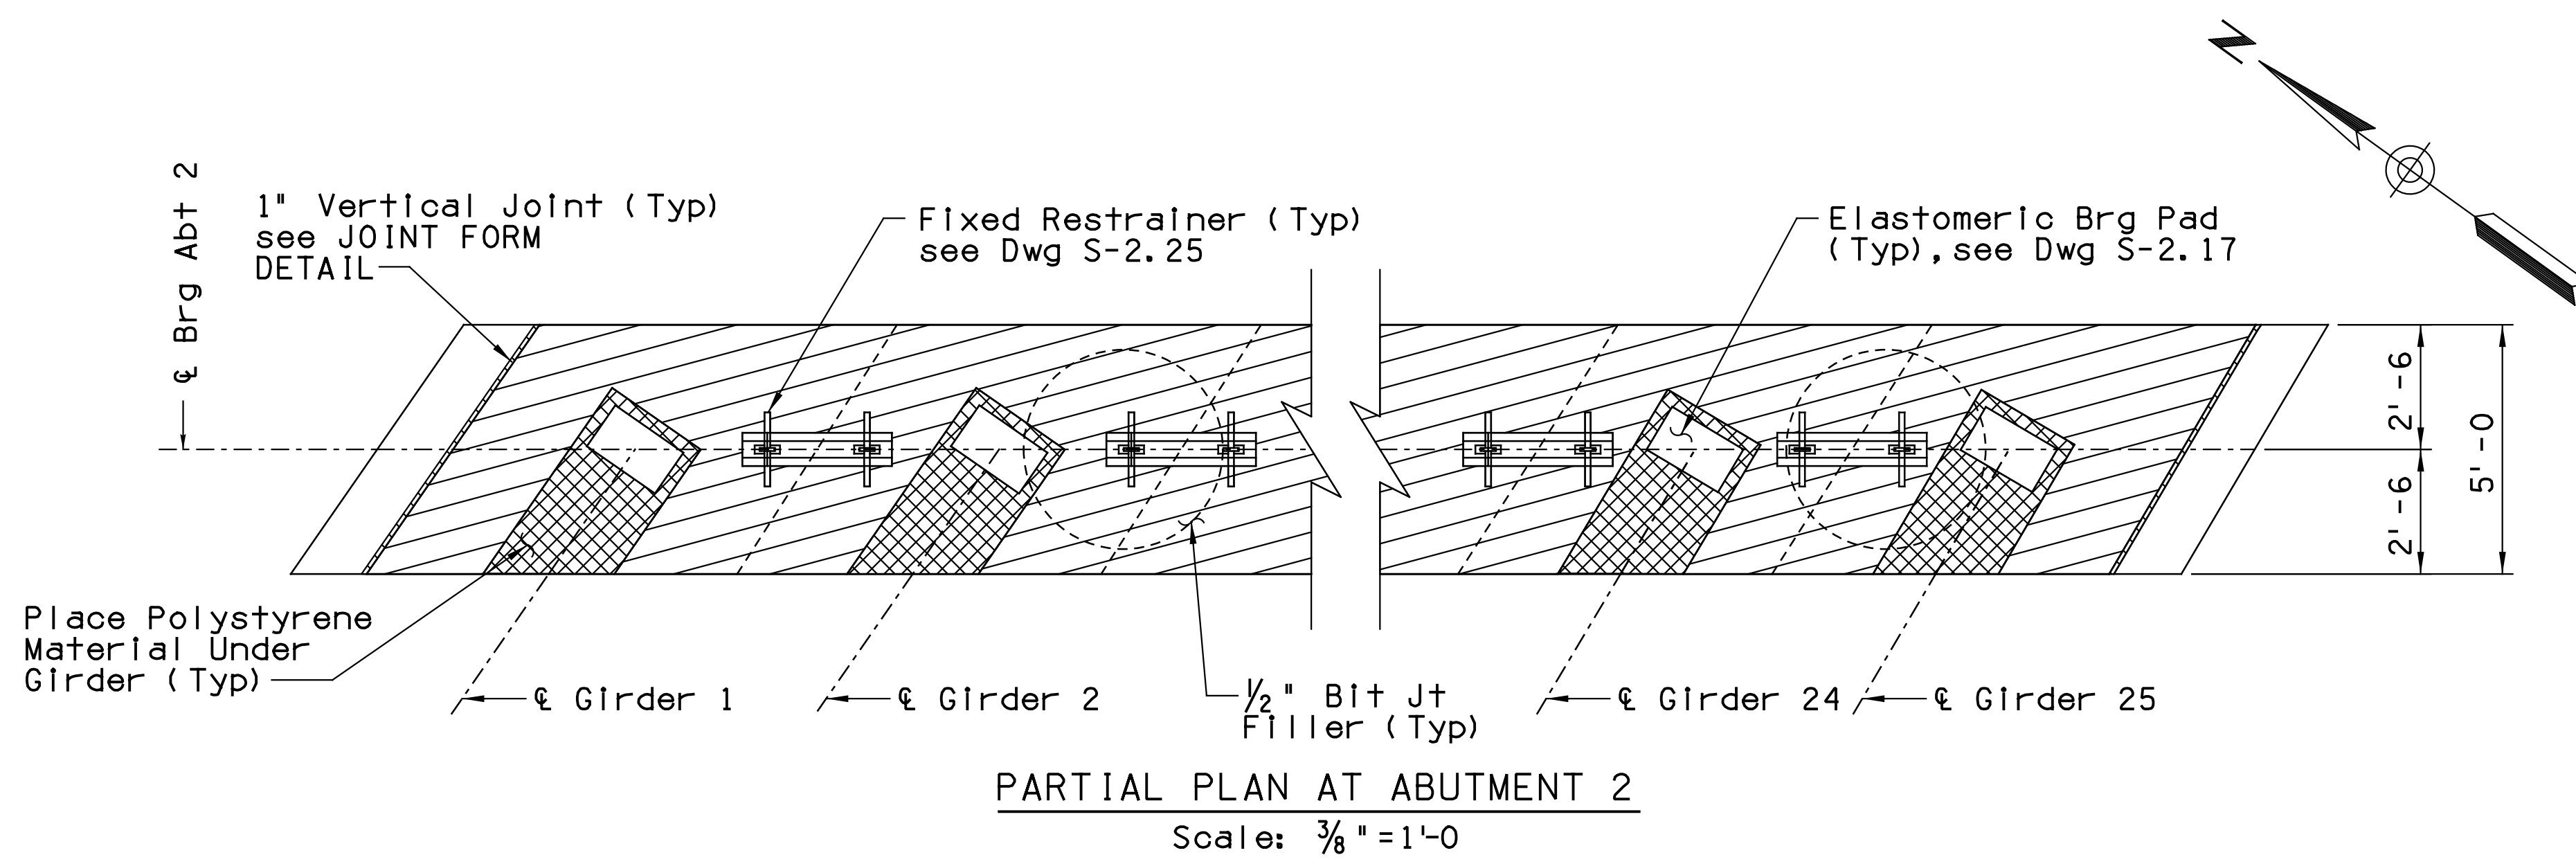


**PARTIAL PLAN AT ABUTMENT 2**  
Scale:  $\frac{3}{8}'' = 1'-0''$

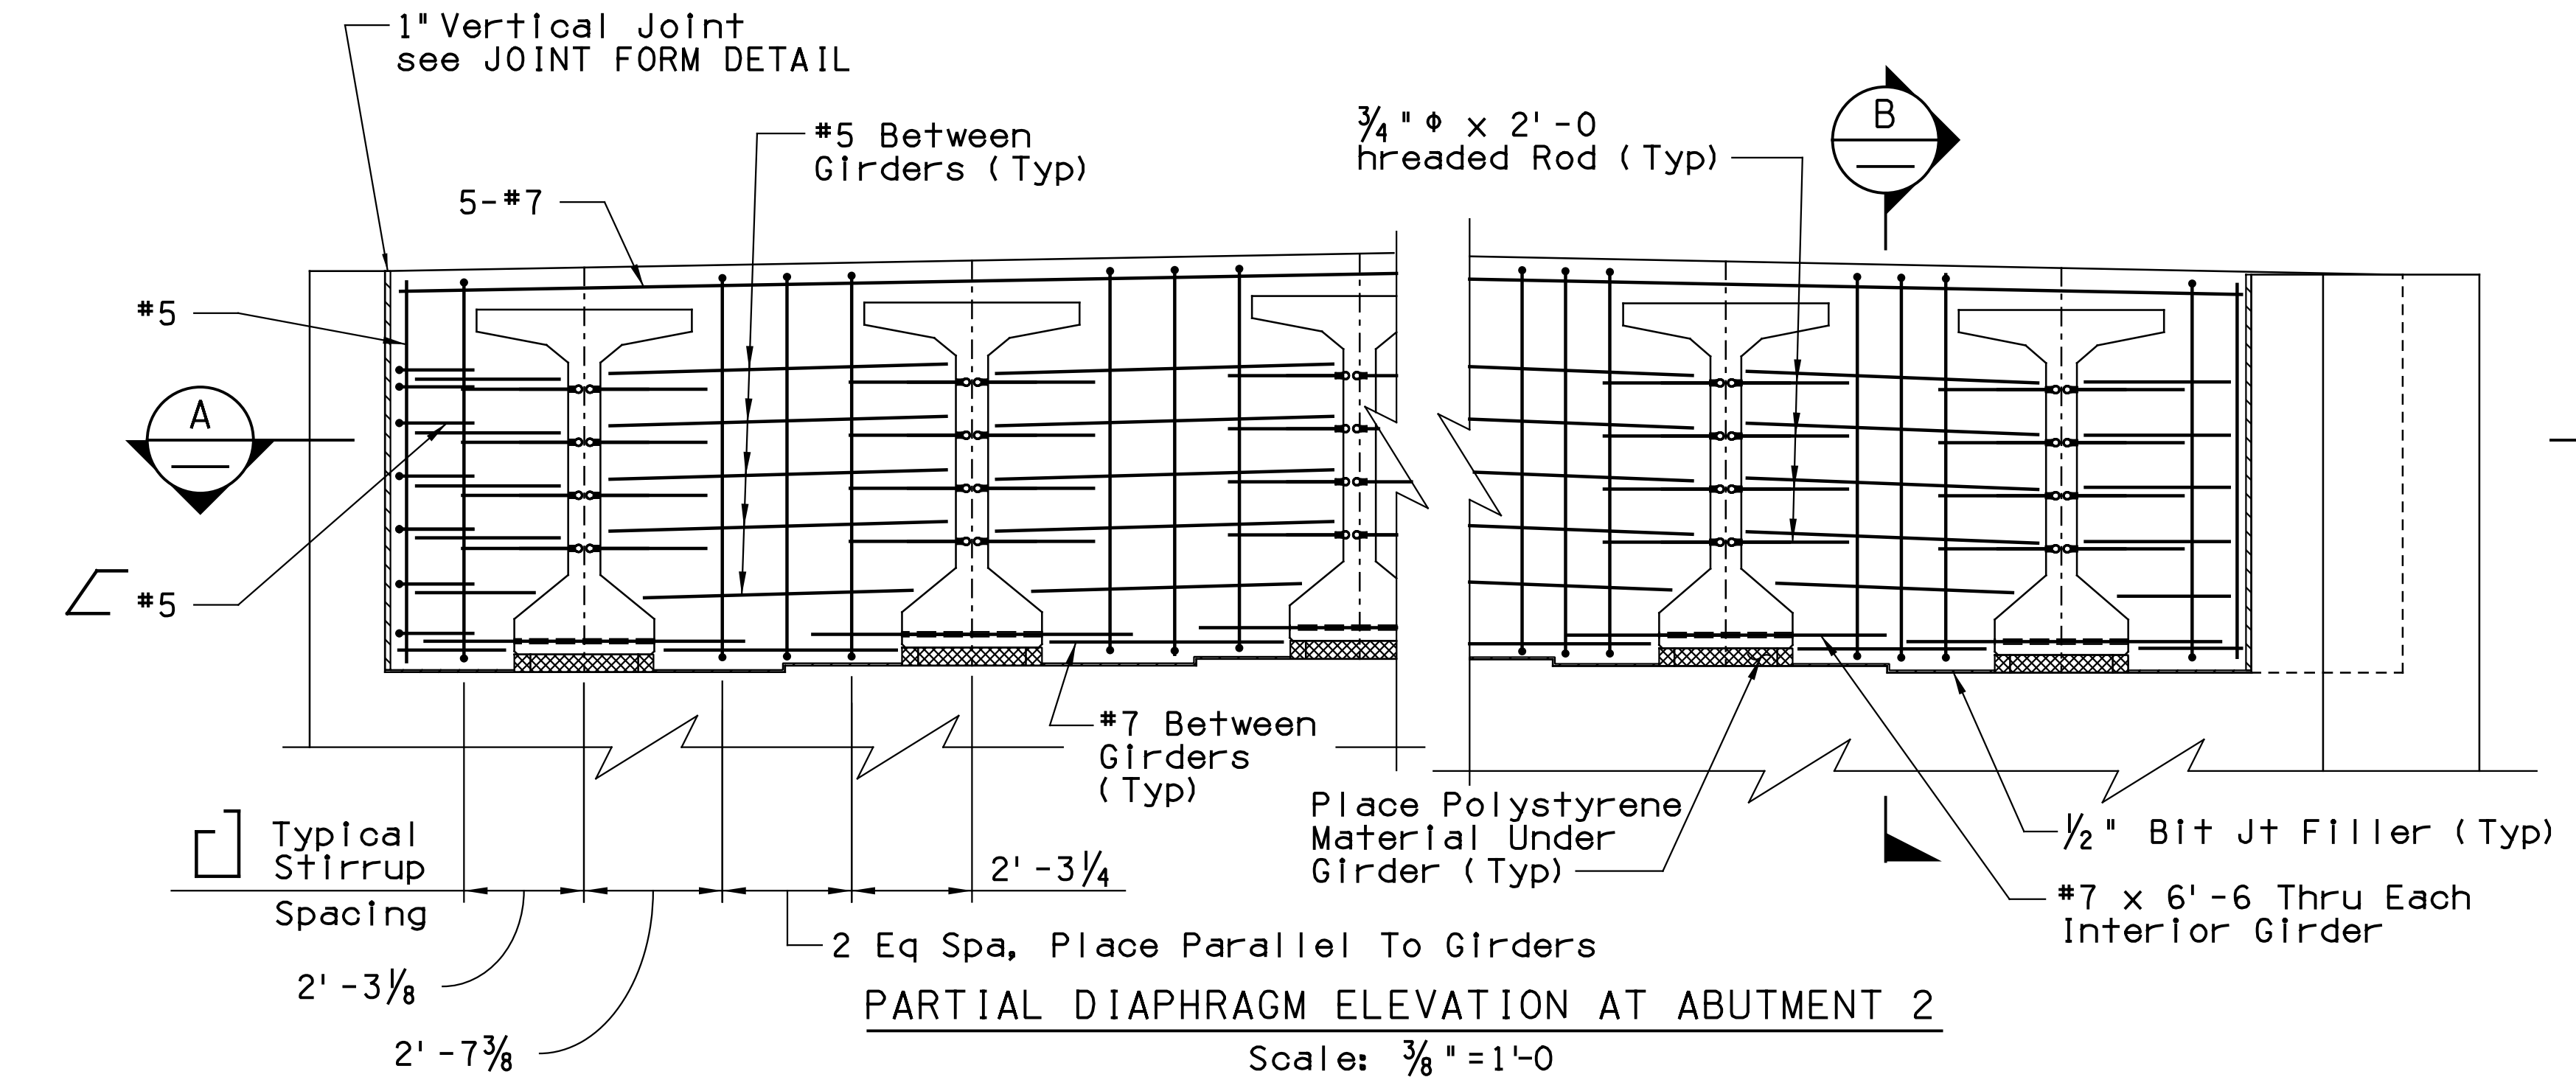


**PARTIAL DIAPHRAGM ELEVATION AT ABUTMENT 2**  
Scale:  $\frac{3}{8}'' = 1'-0''$

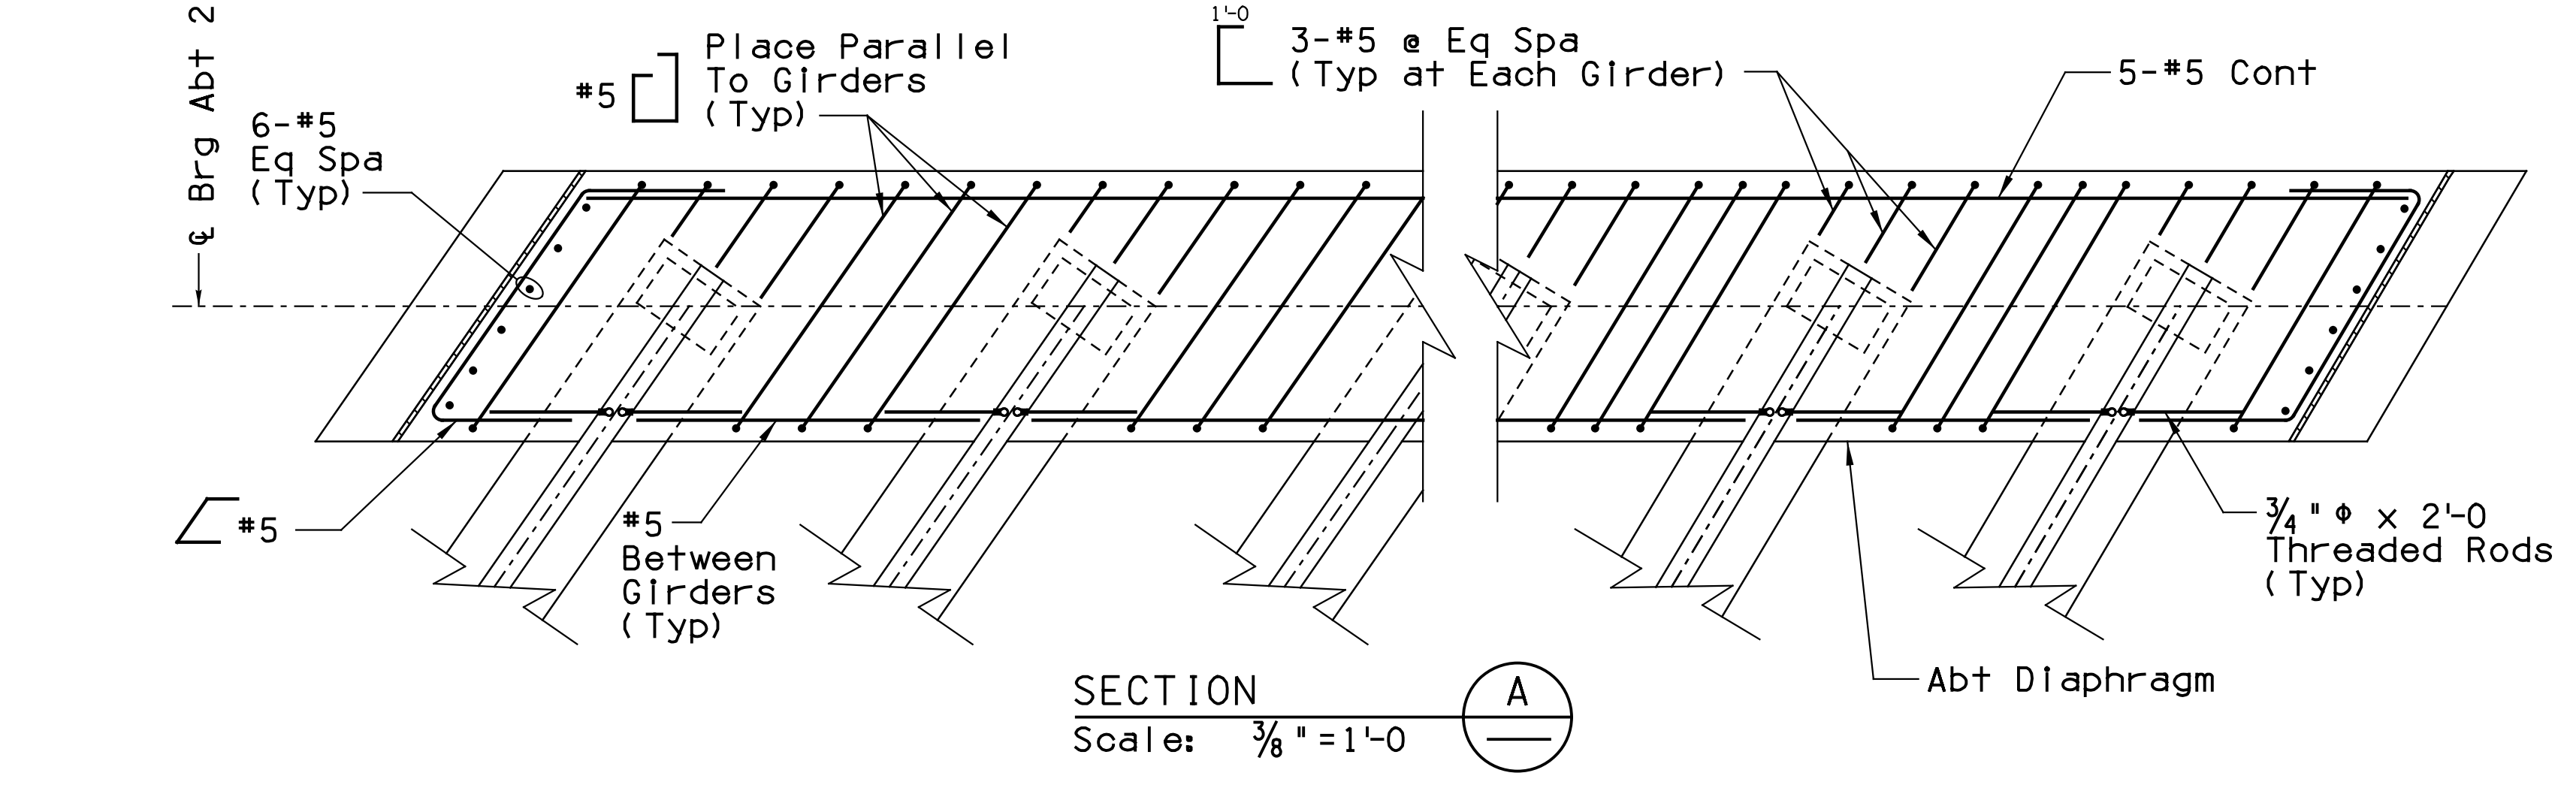

**SECTION A**  
Scale:  $\frac{3}{8}'' = 1'-0''$

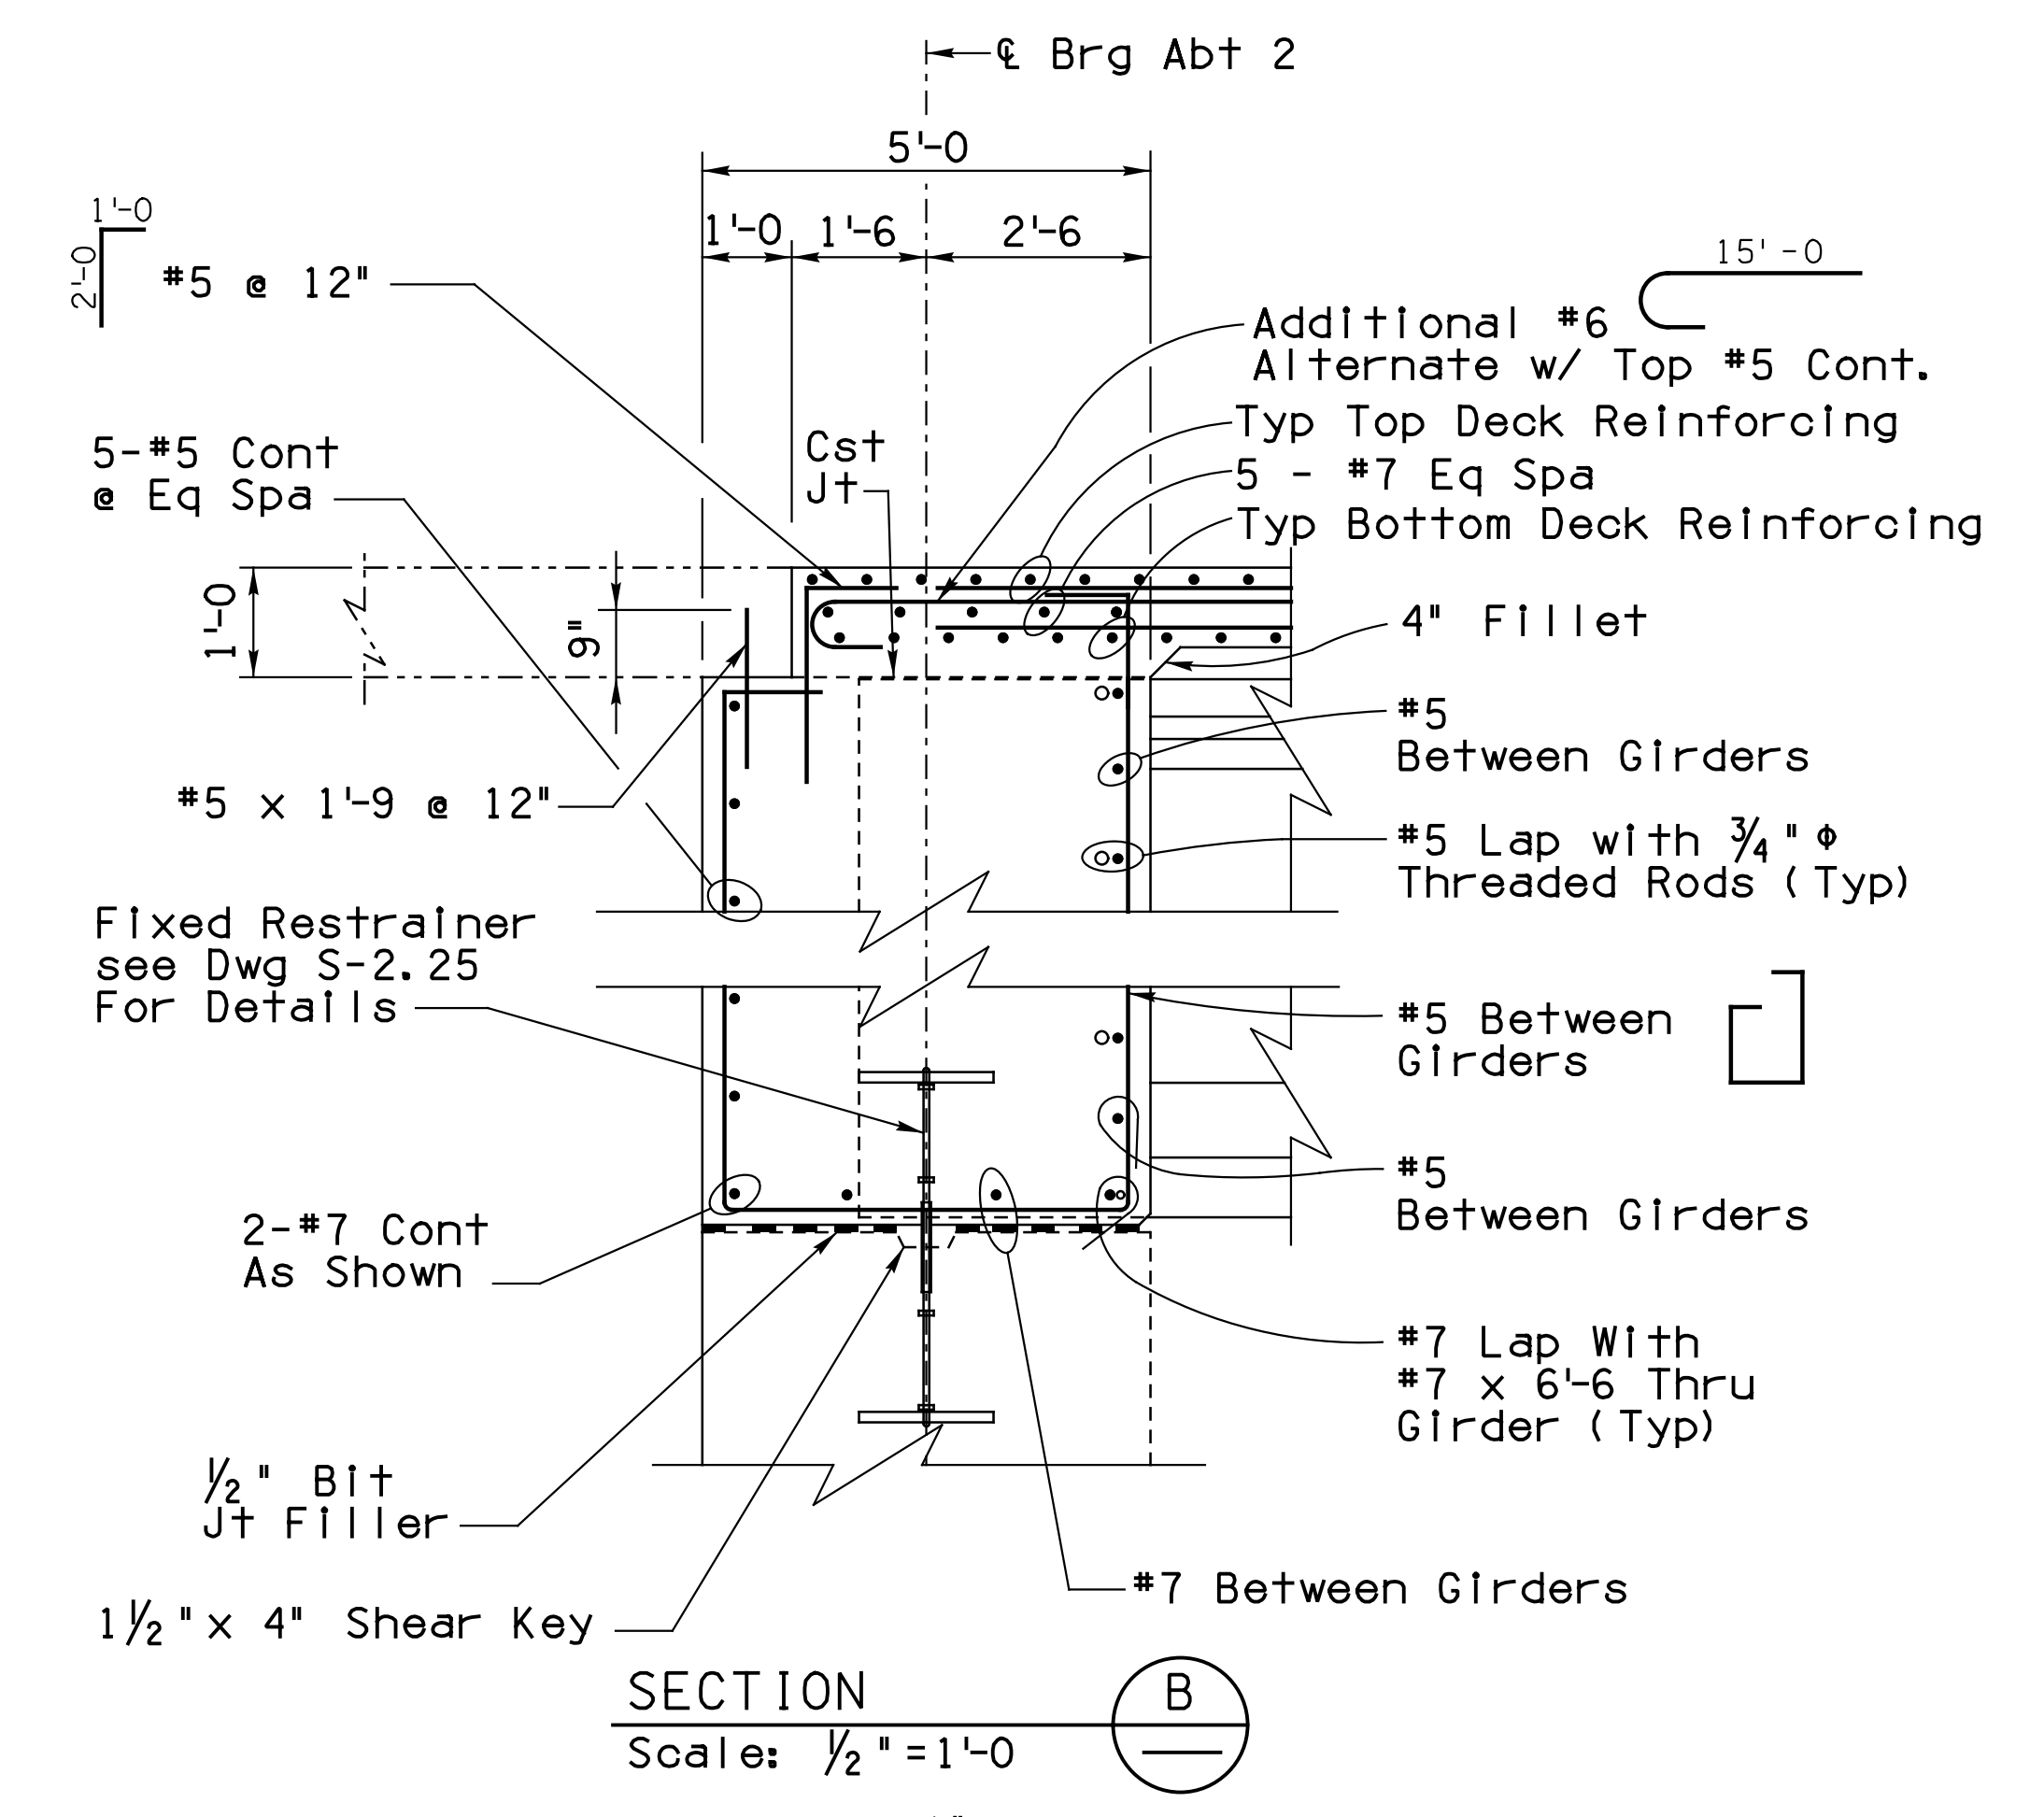

**SECTION B**  
Scale:  $\frac{1}{2}'' = 1'-0''$

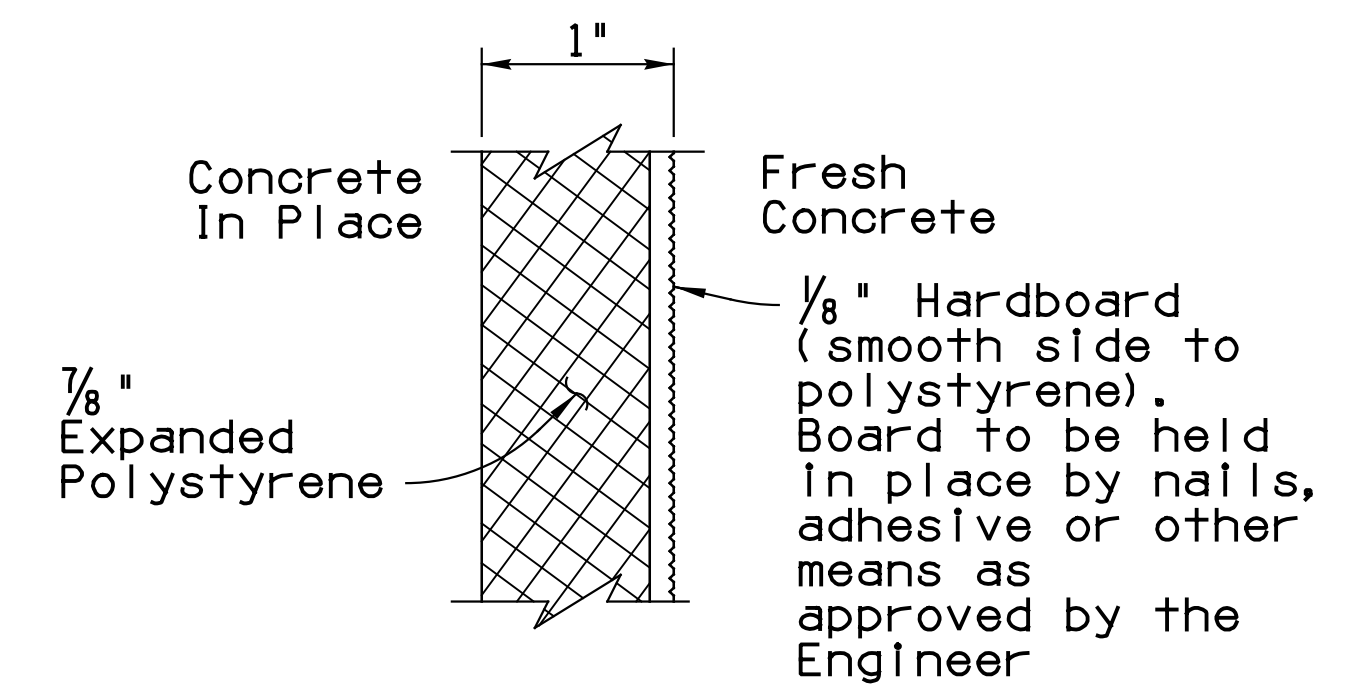

**VERTICAL**

**NOTE:**  
Hardboard to be used on any polystyrene face against which concrete is to be placed.


**JOINT FORM DETAIL**  
Not To Scale

DESIGN	KLH	DATE	03/19	ARIZONA DEPARTMENT OF TRANSPORTATION INFRASTRUCTURE DELIVERY AND OPERATIONS DIVISION <b>BRIDGE GROUP</b> Sta 103+ <b>RUTHRAUFF RD - UPRR OVERPASS          ABUTMENT DIAPHRAGM DETAILS 2</b>	
DRAWN	AJM	03/19			
CHECKED	JRP	03/19			
<b>TY LIN INTERNATIONAL</b> engineers   planners   scientists 60 E. Rio Salado Parkway, Suite 501 Tempe, Arizona 85281				LOCATION <b>RUTHRAUFF TI</b>	Expires 12/31/2019 DWG. S-2 .24
I-10	252.000	20160		ROUTE MILEPOST STRUCTURE NO.	TRACS NO. H8480 01C
			010-D(213)S		
			OF		




F.H.W.A. REGION	STATE	PROJECT NO.	SHEET NO.	TOTAL SHEETS	RECORD DRAWING
9	ARIZ.	010-D(213)S	680	849	

010 PM 252

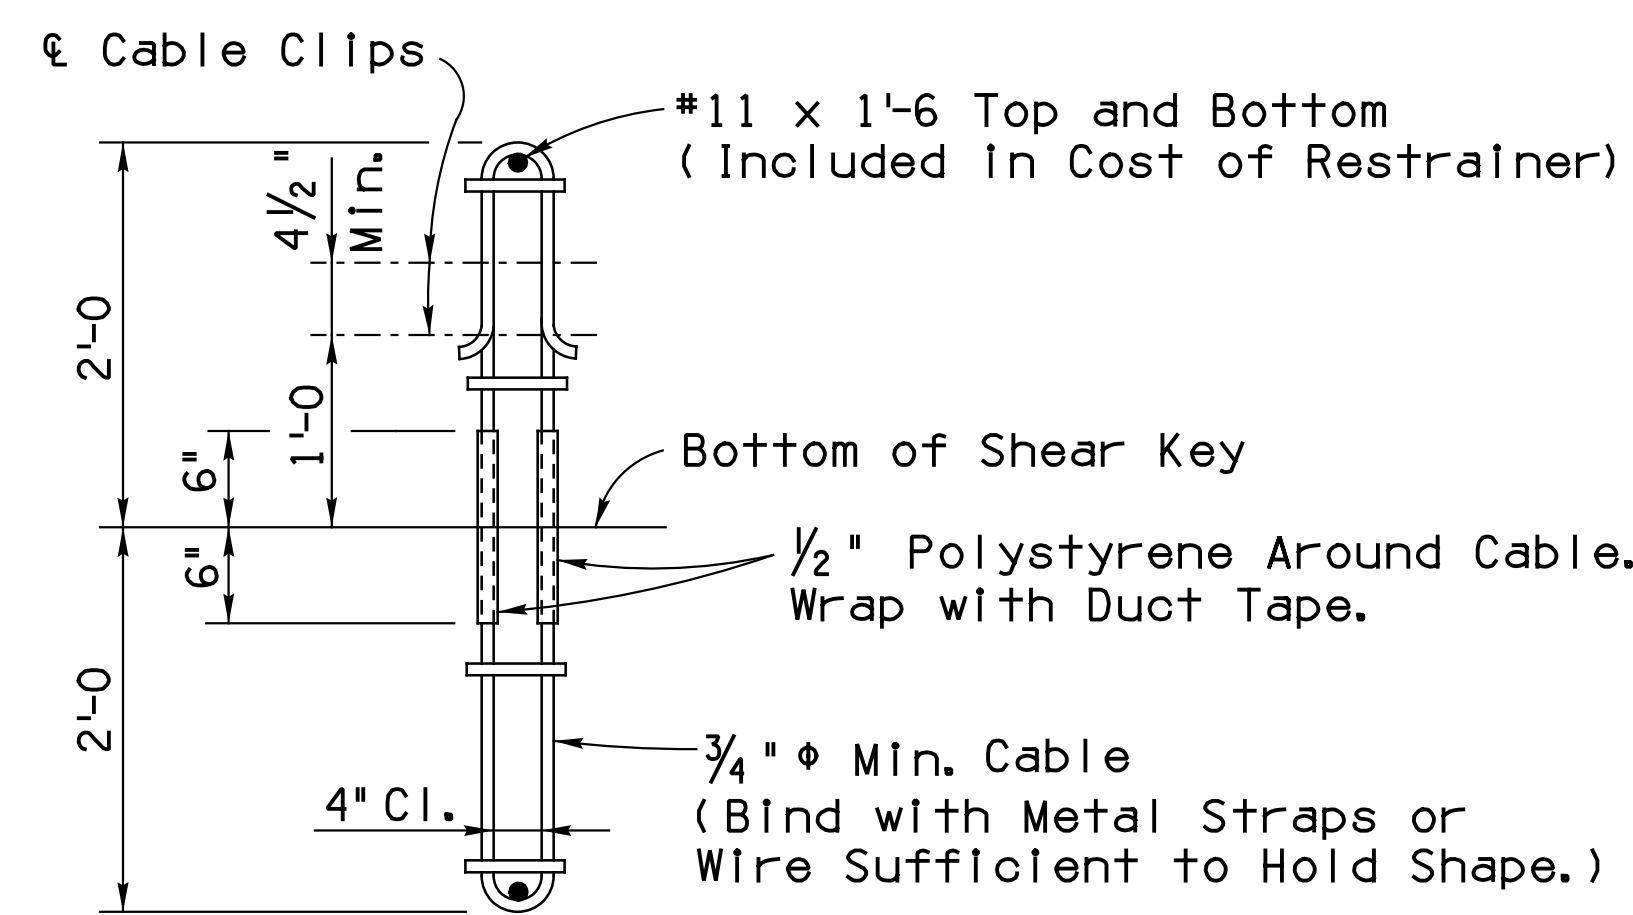


**FIXED RESTRAINER DETAIL**  
Not To Scale

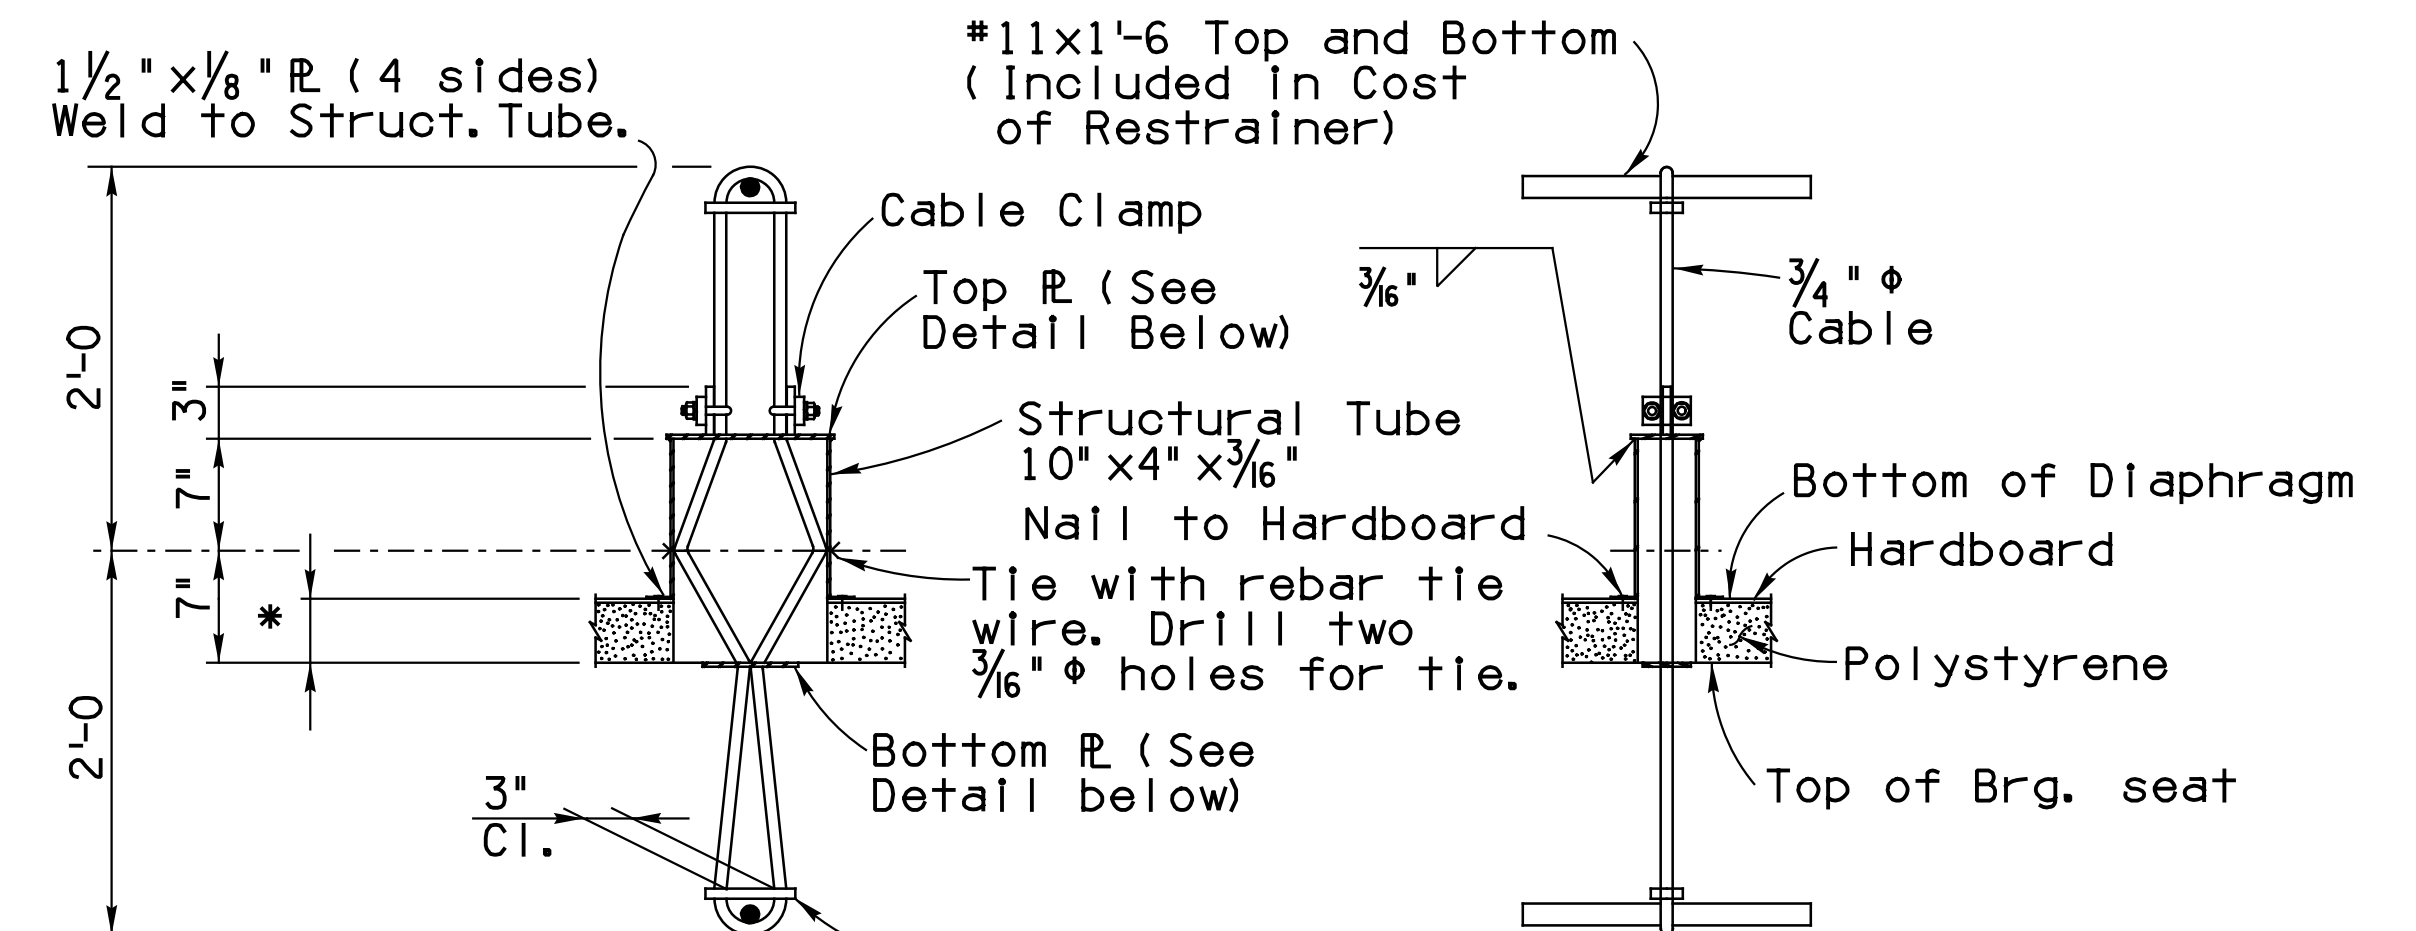

\* Refer Dwg S-2.17 for Bearing Pad thickness

**ELEVATION**


**SECTION**

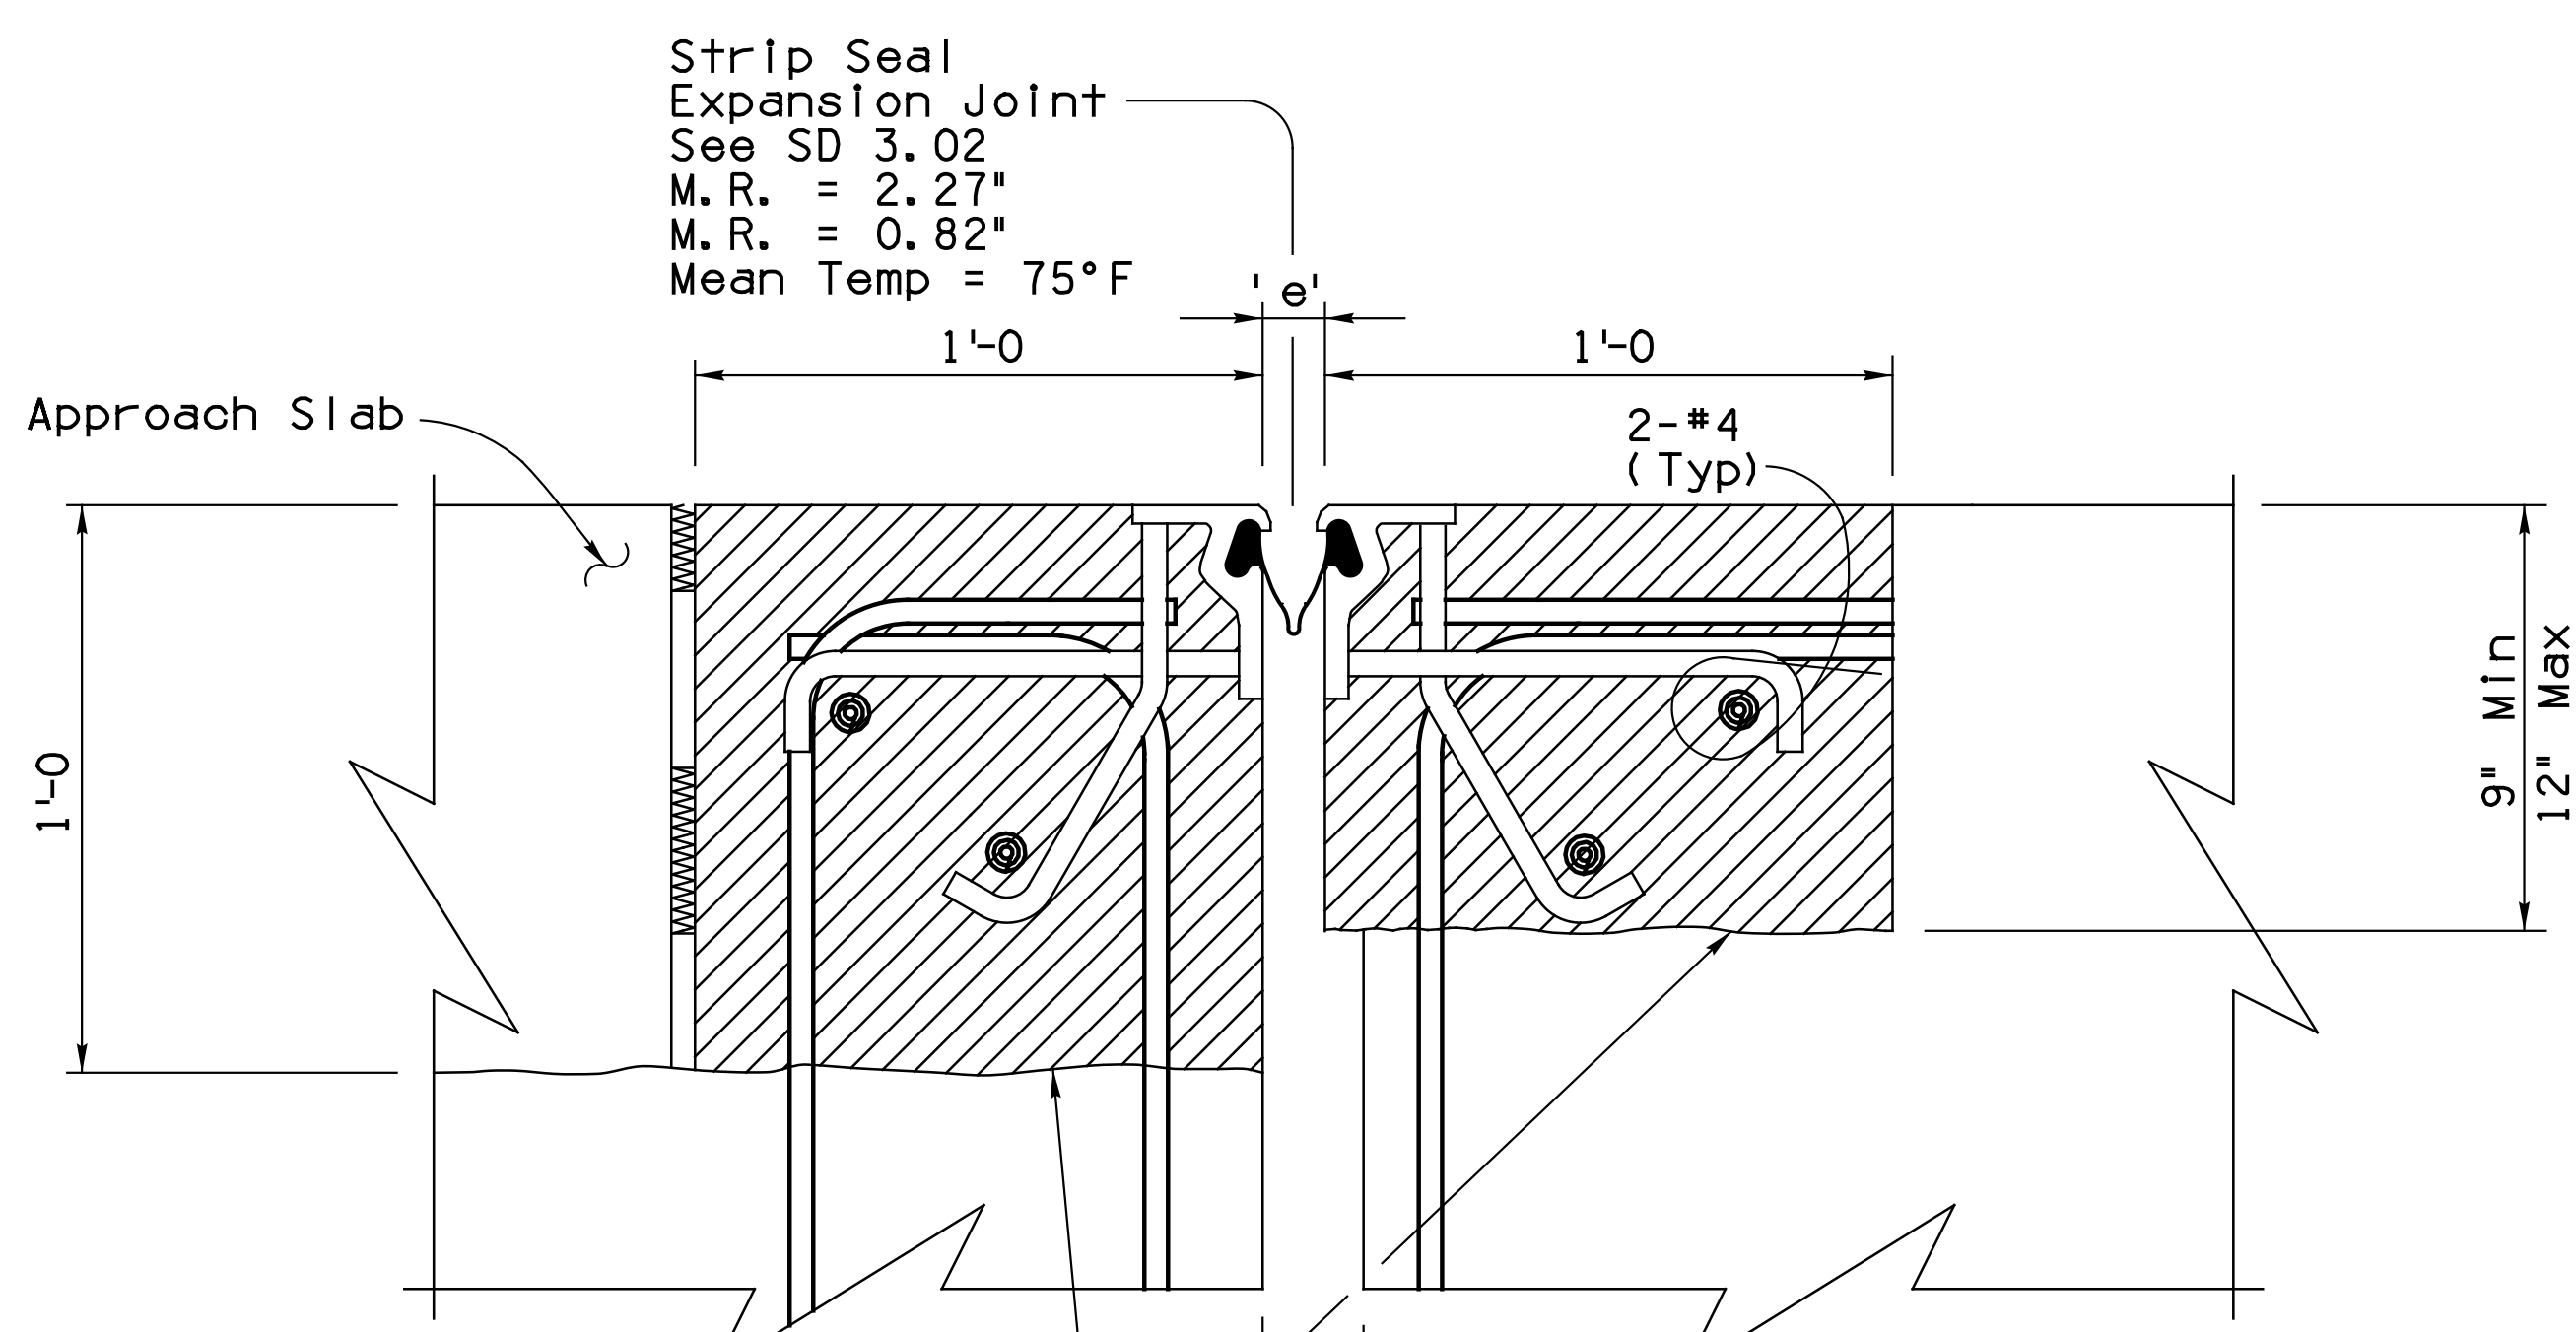


Strip Seal  
Expansion Joint  
See SD 3.02  
M. R. = 2.27"  
M. R. = 0.82"  
Mean Temp = 75°F

**EXPANSION JOINT DETAIL**  
(Abt 1 Only)  
Scale: 3" = 1'-0"

Ø 7/8" Ø holes (Round bottom edge of hole in R with 1/4" Radius.)

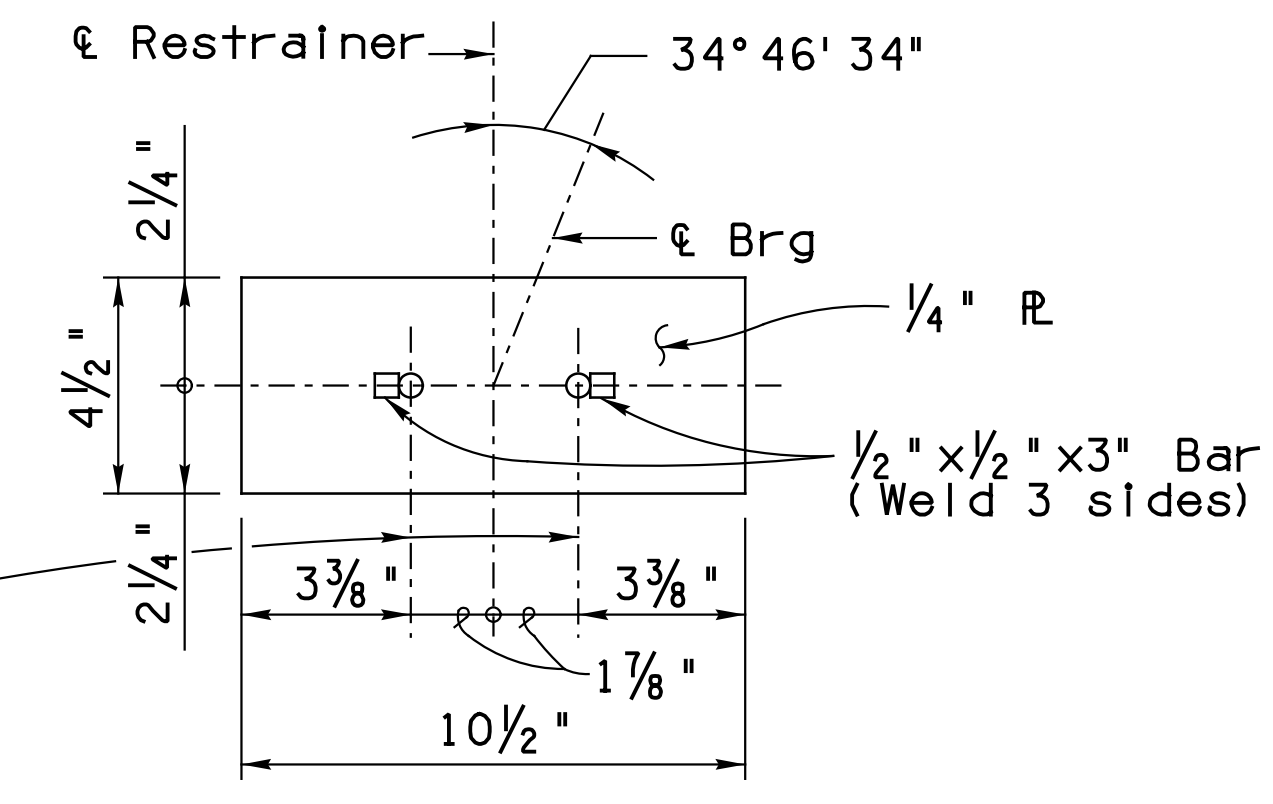

**TOP PLATE**

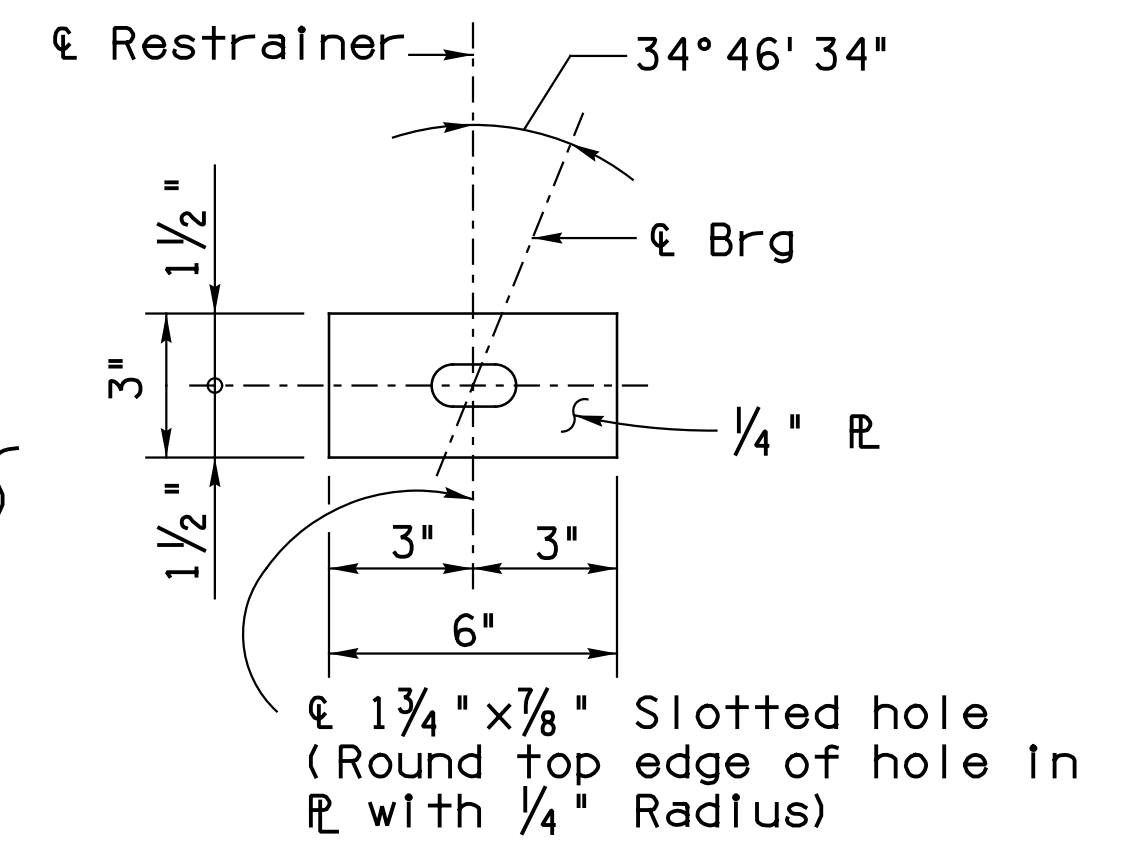

**BOTTOM PLATE**

**EXPANSION RESTRAINER**  
Not To Scale

	e' (In)
	Abt 1
105	2.23
95	2.32
85	2.41
75	2.50
65	2.59
55	2.68
45	2.77
35	2.86

**NOTES:**

- Seal all openings in structural tube to prohibit concrete intrusion.
- Restrainer Cables shall be 3/4" Ø preformed 6x19 galvanized with the minimum breaking strength of 42 kips. One sample of cable 3 feet in length shall be furnished to the Engineer for testing.

**NOTES FOR DECK JOINT DETAIL:**

The Contractor shall take due care in the placement of the concrete under the joint angles to ensure that proper consolidation is achieved. After placement, the Engineer shall inspect the joint for voids by sounding the angles with a hammer. All voids shall be repaired by the Contractor by epoxy injection at no cost to the State.

DESIGN	KLH	DATE	03/19	ARIZONA DEPARTMENT OF TRANSPORTATION INFRASTRUCTURE DELIVERY AND OPERATIONS DIVISION <b>BRIDGE GROUP</b>	
DRAWN	AJM	DATE	03/19		
CHECKED	JRP	DATE	03/19		
<b>TY LIN INTERNATIONAL</b> engineers   planners   scientists 60 E. Rio Salado Parkway, Suite 501 Tempe, Arizona 85281				Sta 103+ <b>RUTHRAUFF RD - UPRR OVERPASS</b> <b>MISCELLANEOUS DETAILS 1</b>	Expires 12/31/2019 DWG. S-2 .25
I-10	252.000	20160	LOCATION	RUTHRAUFF TI	
ROUTE	MILEPOST	STRUCTURE NO.			
TRACS NO. H8480 01C				010-D(213)S	OF








F.H.W.A. REGION	STATE	PROJECT NO.	SHEET NO.	TOTAL SHEETS	RECORD DRAWING
9	ARIZ.	010-D(213)S	683	849	

010 PM 252

CAMBER DEFLECTIONS G1-G14											
Deflection (Ft) at Tenth Points											
	¢ Brg	0.1	0.2	0.3	0.4	0.5	0.6	0.7	0.8	0.9	¢ Brg
Release	0.000	0.094	0.167	0.220	0.253	0.264	0.253	0.220	0.167	0.094	0.000
Initial	0.000	0.154	0.272	0.359	0.413	0.430	0.413	0.359	0.272	0.154	0.000
Final G1-G12	0.000	0.158	0.302	0.415	0.487	0.515	0.487	0.415	0.302	0.158	0.000
Final G13	0.000	0.155	0.295	0.405	0.476	0.502	0.475	0.405	0.294	0.154	0.000
Final G14	0.000	0.149	0.285	0.392	0.459	0.485	0.459	0.390	0.284	0.148	0.000

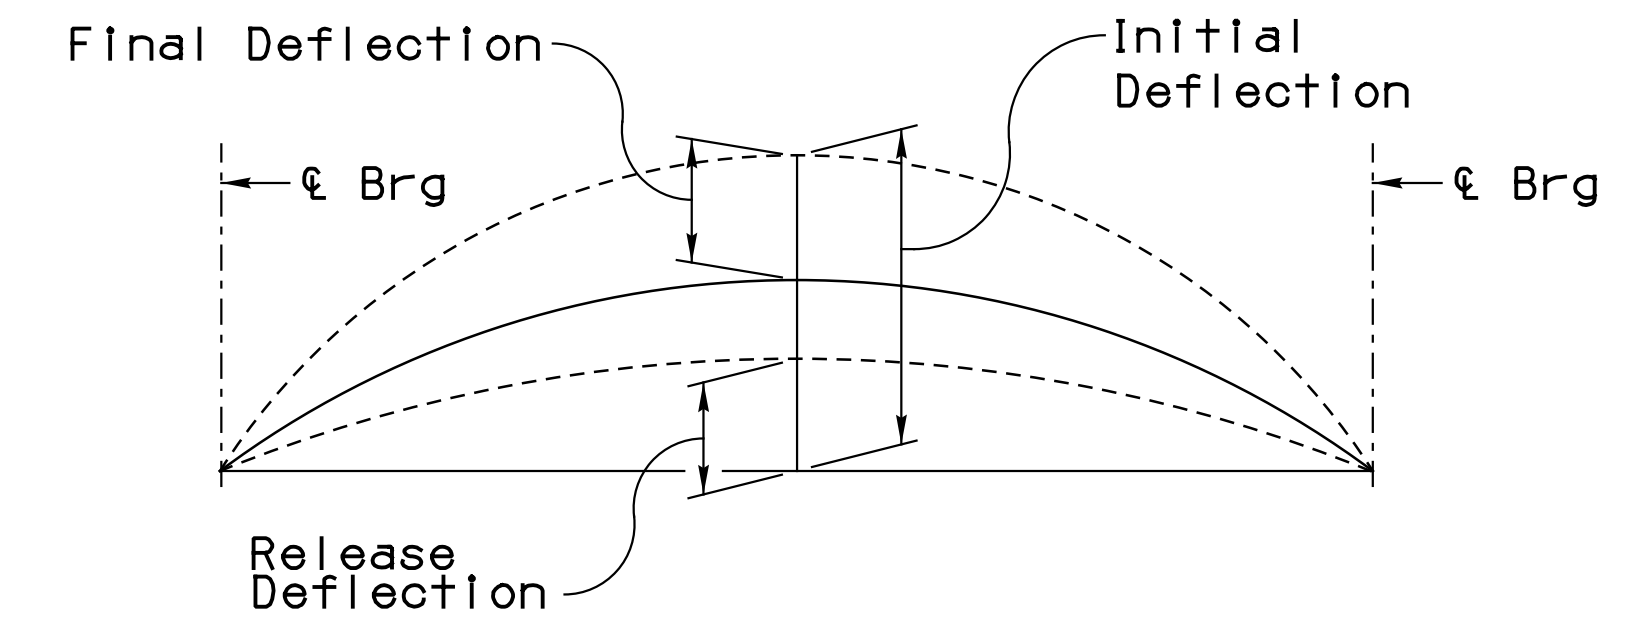

DEFLECTION DIAGRAM  
Not To Scale

CAMBER DEFLECTIONS G15-G20											
Deflection (Ft) at Tenth Points											
	¢ Brg	0.1	0.2	0.3	0.4	0.5	0.6	0.7	0.8	0.9	¢ Brg
Release	0.000	0.089	0.159	0.210	0.242	0.252	0.242	0.210	0.159	0.089	0.000
Initial	0.000	0.146	0.259	0.342	0.393	0.410	0.393	0.342	0.259	0.146	0.000
Final G15	0.000	0.154	0.294	0.404	0.473	0.500	0.473	0.402	0.293	0.153	0.000
Final G16	0.000	0.148	0.281	0.386	0.452	0.477	0.451	0.384	0.279	0.146	0.000
Final G17	0.000	0.141	0.268	0.368	0.431	0.455	0.430	0.366	0.266	0.139	0.000
Final G18	0.000	0.134	0.255	0.350	0.410	0.433	0.409	0.348	0.253	0.132	0.000
Final G19	0.000	0.127	0.242	0.332	0.389	0.411	0.388	0.330	0.240	0.125	0.000
Final G20	0.000	0.120	0.229	0.314	0.368	0.388	0.367	0.312	0.227	0.119	0.000

DEFLECTION NOTES:

1. Release Deflection equals the deflection that the prestressed girder undergoes at the time of strand release. The Release Deflection includes the dead load of the girder and the release prestressing force (including the effects of elastic shortening).
2. Initial Deflection equals the deflection the prestressed girder undergoes at the time of erection prior to the diaphragm and deck pours. The Initial Deflection includes the deflection due to the dead load of the girder, the initial prestressing and the effects of creep up to the time of erection (assumed at 60 days after release).
3. Final Deflection equals the deflection due to the dead load of the deck slab, diaphragms, parapets, sidewalks, and medians, and the effects of long term creep on the composite girders.

CAMBER DEFLECTIONS G21-G24											
Deflection (Ft) at Tenth Points											
	¢ Brg	0.1	0.2	0.3	0.4	0.5	0.6	0.7	0.8	0.9	¢ Brg
Release	0.000	0.083	0.149	0.197	0.228	0.237	0.228	0.197	0.149	0.083	0.000
Initial	0.000	0.136	0.242	0.321	0.370	0.386	0.370	0.321	0.242	0.136	0.000
Final G21	0.000	0.125	0.238	0.326	0.382	0.403	0.381	0.324	0.236	0.124	0.000
Final G22	0.000	0.123	0.234	0.321	0.376	0.397	0.375	0.319	0.232	0.122	0.000
Final G23	0.000	0.121	0.230	0.316	0.370	0.390	0.369	0.314	0.229	0.120	0.000
Final G24	0.000	0.119	0.227	0.311	0.364	0.384	0.363	0.309	0.225	0.118	0.000

CAMBER DEFLECTIONS G25											
Deflection (Ft) at Tenth Points											
	¢ Brg	0.1	0.2	0.3	0.4	0.5	0.6	0.7	0.8	0.9	¢ Brg
Release	0.000	0.083	0.149	0.197	0.228	0.238	0.228	0.197	0.149	0.083	0.000
Initial	0.000	0.136	0.243	0.322	0.371	0.387	0.371	0.322	0.243	0.136	0.000
Final G25	0.000	0.149	0.284	0.390	0.456	0.482	0.456	0.389	0.283	0.149	0.000

DESIGN	KLH	DATE	03/19	ARIZONA DEPARTMENT OF TRANSPORTATION INFRASTRUCTURE DELIVERY AND OPERATIONS DIVISION BRIDGE GROUP	
DRAWN	AJM	DATE	03/19		
CHECKED	JRP	DATE	03/19		
<b>TY-LIN INTERNATIONAL</b> engineers   planners   scientists 60 E. Rio Salado Parkway, Suite 501 Tempe, Arizona 85281				Sta 103+ <b>RUTHRAUFF RD - UPRR OVERPASS          CAMBER DETAILS</b>	
I-10	252.000	20160	LOCATION	RUTHRAUFF TI	
ROUTE	MILEPOST	STRUCTURE NO.			
TRACS NO. H8480 01C			010-D(213)S		
			Exp. Press 12/31/2019 DWG. S-2 .28		


F.H.W.A. REGION	STATE	PROJECT NO.	SHEET NO.	TOTAL SHEETS	RECORD DRAWING
9	ARIZ.	010-D(213)S	684	849	

010 PM 252

Penable: ...TYLI PLTDRV\open\ISTDPLOT.TBL  
 Plot Driver: ...TYLI PLTDRV\ADOT PDF FULL.plt  
 SURVEY NO. FINISHED PLANS- REVISIONS- LOCATION- DATE-

BRIDGE SCREED ELEVATIONS - G1-13											
Location	0.00	0.10	0.20	0.30	0.40	0.50	0.60	0.70	0.80	0.90	1.00
Lt Edge Deck	2282.25	2282.60	2282.91	2283.17	2283.37	2283.49	2283.54	2283.52	2283.44	2283.30	2283.12
Girder 1	2282.32	2282.67	2282.98	2283.24	2283.43	2283.55	2283.59	2283.57	2283.48	2283.34	2283.16
Girder 2	2282.47	2282.81	2283.11	2283.36	2283.54	2283.66	2283.70	2283.67	2283.58	2283.43	2283.25
Girder 3	2282.61	2282.94	2283.24	2283.48	2283.66	2283.77	2283.80	2283.77	2283.67	2283.51	2283.32
Girder 4	2282.75	2283.08	2283.37	2283.60	2283.78	2283.88	2283.91	2283.86	2283.76	2283.60	2283.40
Girder 5	2282.89	2283.21	2283.49	2283.72	2283.89	2283.99	2284.01	2283.96	2283.85	2283.68	2283.48
Girder 6	2283.03	2283.34	2283.62	2283.84	2284.00	2284.09	2284.11	2284.05	2283.93	2283.76	2283.55
Girder 7	2283.16	2283.47	2283.74	2283.96	2284.11	2284.20	2284.20	2284.14	2284.02	2283.84	2283.62
Girder 8	2283.30	2283.60	2283.86	2284.07	2284.22	2284.30	2284.30	2284.23	2284.10	2283.91	2283.69
Girder 9	2283.43	2283.69	2283.95	2284.16	2284.31	2284.39	2284.39	2284.32	2284.19	2284.00	2283.76
Girder 10	2283.56	2283.78	2284.04	2284.25	2284.40	2284.48	2284.48	2284.41	2284.28	2284.09	2283.83
Girder 11	2283.69	2283.83	2284.10	2284.32	2284.47	2284.56	2284.56	2284.50	2284.38	2284.20	2283.89
Girder 12	2283.81	2283.96	2284.22	2284.43	2284.58	2284.66	2284.66	2284.59	2284.46	2284.27	2283.95
Girder 13	2283.94	2284.04	2284.30	2284.51	2284.66	2284.74	2284.74	2284.67	2284.54	2284.36	2284.02
Cst CL	2283.95	2284.22	2284.45	2284.62	2284.74	2284.78	2284.75	2284.65	2284.49	2284.28	2284.02

BRIDGE SCREED ELEVATIONS - G14-25											
Location	0.00	0.10	0.20	0.30	0.40	0.50	0.60	0.70	0.80	0.90	1.00
Cst CL	2283.95	2284.22	2284.45	2284.62	2284.74	2284.78	2284.75	2284.65	2284.49	2284.28	2284.02
Girder 14	2283.90	2284.16	2284.38	2284.55	2284.65	2284.69	2284.66	2284.56	2284.40	2284.19	2283.94
Girder 15	2283.85	2284.10	2284.32	2284.48	2284.59	2284.62	2284.58	2284.48	2284.31	2284.09	2283.83
Girder 16	2283.78	2284.03	2284.23	2284.39	2284.48	2284.52	2284.47	2284.36	2284.20	2283.98	2283.73
Girder 17	2283.72	2283.95	2284.15	2284.29	2284.38	2284.41	2284.36	2284.25	2284.08	2283.87	2283.62
Girder 18	2283.66	2283.87	2284.06	2284.20	2284.27	2284.29	2284.24	2284.13	2283.97	2283.76	2283.51
Girder 19	2283.59	2283.80	2283.97	2284.10	2284.17	2284.18	2284.13	2284.02	2283.85	2283.64	2283.40
Girder 20	2283.52	2283.72	2283.88	2283.99	2284.06	2284.07	2284.01	2283.90	2283.74	2283.53	2283.29
Girder 21	2283.45	2283.65	2283.81	2283.92	2283.98	2283.99	2283.93	2283.81	2283.64	2283.42	2283.18
Girder 22	2283.38	2283.55	2283.71	2283.83	2283.89	2283.90	2283.84	2283.72	2283.56	2283.34	2283.06
Girder 23	2283.30	2283.46	2283.62	2283.74	2283.80	2283.81	2283.75	2283.64	2283.47	2283.26	2282.95
Girder 24	2283.23	2283.36	2283.52	2283.64	2283.71	2283.72	2283.67	2283.57	2283.41	2283.21	2282.83
Girder 25	2283.15	2283.31	2283.50	2283.64	2283.71	2283.73	2283.67	2283.55	2283.37	2283.13	2282.71
Rt Edge Deck	2283.11	2283.31	2283.47	2283.58	2283.63	2283.62	2283.54	2283.39	2283.19	2282.94	2282.65

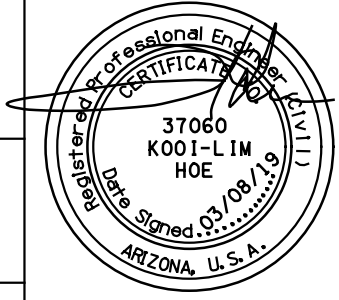DESIGN	KLH	DATE	03/19	ARIZONA DEPARTMENT OF TRANSPORTATION INFRASTRUCTURE DELIVERY AND OPERATIONS DIVISION <b>BRIDGE GROUP</b> Sta 103+ <b>RUTHRAUFF RD - UPRR OVERPASS          SCREED ELEVATIONS</b>	
DRAWN	AJM	03/19			
CHECKED	JRP	03/19			
<b>TY LIN INTERNATIONAL</b> engineers   planners   scientists 60 E. Rio Salado Parkway, Suite 501 Tempe, Arizona 85281				LOCATION <b>RUTHRAUFF TI</b>	Expires 12/31/2019 DWG. S-2 .29
I-10	252.000	20160		TRACS NO. H8480 01C	010-D(213)S
ROUTE	MILEPOST	STRUCTURE NO.			OF

Plot Driver: ...TYLI PLTDRVADOT.PDF FULL.plt  
 Survey No. ...TYLI PLTDRVADOT.PDF FULL.plt  
 Revisions- FINISHED PLANS-  
 Date-  
 Survey No. ...TYLI PLTDRVADOT.PDF FULL.plt  
 Revisions- FINISHED PLANS-  
 Date-  
 Location- ...TYLI PLTDRVADOT.PDF FULL.plt  
 Revisions- FINISHED PLANS-  
 Date-  
 Location- ...TYLI PLTDRVADOT.PDF FULL.plt  
 Revisions- FINISHED PLANS-  
 Date-

SCREED RAIL ELEVATIONS - LEFT DECK	
Location	Elevation
0.0	2282.25
2.50	2282.31
5.00	2282.37
7.50	2282.43
10.00	2282.49
12.50	2282.54
15.00	2282.60
17.50	2282.65
20.00	2282.70
22.50	2282.76
25.00	2282.81
27.50	2282.86
30.00	2282.91
32.50	2282.95
35.00	2283.00
37.50	2283.04
40.00	2283.08
42.50	2283.12
45.00	2283.16
47.50	2283.20
50.00	2283.23
52.50	2283.27
55.00	2283.30
57.50	2283.33
60.00	2283.36
62.50	2283.38
65.00	2283.41
67.50	2283.43
70.00	2283.45
72.50	2283.47
75.00	2283.49
77.50	2283.50
80.00	2283.51
82.50	2283.52
85.00	2283.53
87.50	2283.54
90.00	2283.54
92.50	2283.54
95.00	2283.54
97.50	2283.54
100.00	2283.54
102.50	2283.53
105.00	2283.53
107.50	2283.52
110.00	2283.51
112.50	2283.50
115.00	2283.48
117.50	2283.47
120.00	2283.45
122.50	2283.43
125.00	2283.41
127.50	2283.39
130.00	2283.37

SCREED RAIL ELEVATIONS - LEFT DECK (CONT.)	
Location	Elevation
132.50	2283.34
135.00	2283.32
137.50	2283.29
140.00	2283.27
142.50	2283.24
145.00	2283.21
147.50	2283.18
150.00	2283.15
152.25	2283.12

SCREED RAIL ELEVATIONS - CONST. CL	
Location	Elevation
0.0	2283.95
2.50	2284.00
5.00	2284.05
7.50	2284.09
10.00	2284.13
12.50	2284.18
15.00	2284.22
17.50	2284.26
20.00	2284.30
22.50	2284.34
25.00	2284.38
27.50	2284.41
30.00	2284.45
32.50	2284.48
35.00	2284.52
37.50	2284.55
40.00	2284.57
42.50	2284.60
45.00	2284.63
47.50	2284.65
50.00	2284.67
52.50	2284.69
55.00	2284.71
57.50	2284.73
60.00	2284.74
62.50	2284.76
65.00	2284.77
67.50	2284.78
70.00	2284.78
72.50	2284.79
75.00	2284.79
77.50	2284.79
80.00	2284.79
82.50	2284.79
85.00	2284.78
87.50	2284.78
90.00	2284.77
92.50	2284.76
95.00	2284.74
97.50	2284.73
100.00	2284.71
102.50	2284.69
105.00	2284.67
107.50	2284.65
110.00	2284.63
112.50	2284.60
115.00	2284.58
117.50	2284.55
120.00	2284.52
122.50	2284.49
125.00	2284.46
127.50	2284.42
130.00	2284.39


SCREED RAIL ELEVATIONS - CONST. CL (CONT.)	
Location	Elevation
132.50	2284.35
135.00	2284.31
137.50	2284.27
140.00	2284.23
142.50	2284.19
145.00	2284.15
147.50	2284.11
150.00	2284.06
152.25	2284.02

SCREED RAIL ELEVATIONS - RIGHT DECK	
Location	Elevation
0.0	2283.11
2.50	2283.15
5.00	2283.19
7.50	2283.22
10.00	2283.25
12.50	2283.29
15.00	2283.32
17.50	2283.35
20.00	2283.38
22.50	2283.40
25.00	2283.43
27.50	2283.46
30.00	2283.48
32.50	2283.50
35.00	2283.52
37.50	2283.54
40.00	2283.56
42.50	2283.58
45.00	2283.59
47.50	2283.60
50.00	2283.61
52.50	2283.62
55.00	2283.63
57.50	2283.63
60.00	2283.64
62.50	2283.64
65.00	2283.64
67.50	2283.64
70.00	2283.63
72.50	2283.62
75.00	2283.61
77.50	2283.60
80.00	2283.59
82.50	2283.57
85.00	2283.56
87.50	2283.54
90.00	2283.52
92.50	2283.49
95.00	2283.47
97.50	2283.44
100.00	2283.41
102.50	2283.38
105.00	2283.35
107.50	2283.32
110.00	2283.28
112.50	2283.25
115.00	2283.21
117.50	2283.17
120.00	2283.13
122.50	2283.08
125.00	2283.04
127.50	2282.99
130.00	2282.95

SCREED RAIL ELEVATIONS - RIGHT DECK (CONT.)	
Location	Elevation
132.50	2282.90
135.00	2282.85
137.50	2282.80
140.00	2282.75
142.50	2282.70
145.00	2282.65
145.11	2282.65

F.H.W.A. REGION	STATE	PROJECT NO.	SHEET NO.	TOTAL SHEETS	RECORD DRAWING
9	ARIZ.	010-D(213)S	685	849	

010 PM 252

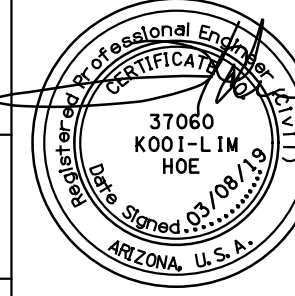DESIGN	KLH	DATE	03/19	ARIZONA DEPARTMENT OF TRANSPORTATION INFRASTRUCTURE DELIVERY AND OPERATIONS DIVISION <b>BRIDGE GROUP</b>  <b>Sta 103+</b> <b>RUTHRAUFF RD - UPRR OVERPASS</b> <b>SCREED RAIL ELEVATIONS</b>	
DRAWN	AJM	03/19			
CHECKED	JRP	03/19			
<b>TY L IN INTERNATIONAL</b> engineers   planners   scientists 60 E. Rio Salado Parkway, Suite 501 Tempe, Arizona 85281				LOCATION <b>RUTHRAUFF TI</b>	Exp: 12/31/2019 DWG. S-2 .30
I-10	252.000	20160		TRACS NO. H8480 01C	010-D(213)S
ROUTE	MILEPOST	STRUCTURE NO.			OF





F.H.W.A. REGION	STATE	PROJECT NO.	SHEET NO.	TOTAL SHEETS	RECORD DRAWING
9	ARIZ.	010-D(213)S	687	849	


010 PM 252



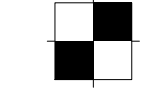
GENERAL NOTES

- General soil and rock (where encountered) strata descriptions and indicated boundaries are based on engineering interpretation of available subsurface information by the geotechnical engineer and may not reflect actual variation in subsurface conditions between borings and samples. The location of contacts between strata may be gradual rather than abrupt. Classification of soil material is in general accordance with ASTM D 2488-93 and is presented in the Geotechnical Report.
- The observed water levels and/or moisture conditions indicated on the boring logs are as recorded at the time of field investigation. These water levels and/or moisture conditions may vary considerably with time according to the prevailing climate, rainfall or other factors and are otherwise dependent upon the duration of and methods used in the field investigation program.
- Sound engineering judgment was exercised in preparing the subsurface information presented on these sheets. This information was prepared and is intended for design and estimating purposes. Its presentation on the plans or elsewhere is for the purpose of providing intended users with access to the same information as was provided to the State and its designers. Interpretations of subsurface information are presented in good faith and are not intended as a substitute for personal investigation, independent interpretations or judgment of the contractor.
- A 140 lb. hammer, 30-inch free-fall, was used to drive both the Standard Penetration Test (SPT) split-spoon sampler and the ring-lined sampler in general conformance with ASTM D 1586-96 and D 3550-01, respectively.
- For further information, refer to NCS report "Final Geotechnical Report; I-10, Ruthrauff Road Traffic Interchange," submitted to HDR on March 31, 2015 and any addenda.
- Reaction to dilute HCl (as per ASTM D 2488) does not necessarily correlate to the degree of carbonate cementation. For example, a "strong" reaction to HCl and a low SPT N-value may indicate that the soil particles are coated with calcium carbonate or lime but the voids are mostly clear, i.e. the particles are not significantly cemented to each other; therefore, the density is loose. In other cases, soil may exhibit "no" to "weak" reaction to HCl but appear to be strongly cemented due to induration. Thus, the user should consider the reported reaction to HCl and SPT N-values in conjunction with other relevant factors to evaluate the degree of cementation and its effect on construction activities.
- Refusal SPT N-values may be indicative of the presence of cobbles or boulders whose size cannot be determined by the investigative techniques used for this project. Cobbles and boulders will likely be encountered during the construction of the drilled shafts. Additionally, cemented layers may form cobble or boulder size pieces when broken up. The contractor should mobilize the appropriate equipment for removing this material.
- The site soils contain random zones of poorly graded sands and gravels. These soils are prone to caving. Therefore, localized caving should be anticipated during drilled shaft construction. These local zones may be up to 20-ft thick and can occur at various depths.
- The site soils contain random zones of gravels, cobbles and boulders. These materials experience large fluid loss during slurry-assisted drilled shaft construction.

BORING PLAN



SCALE 1:100

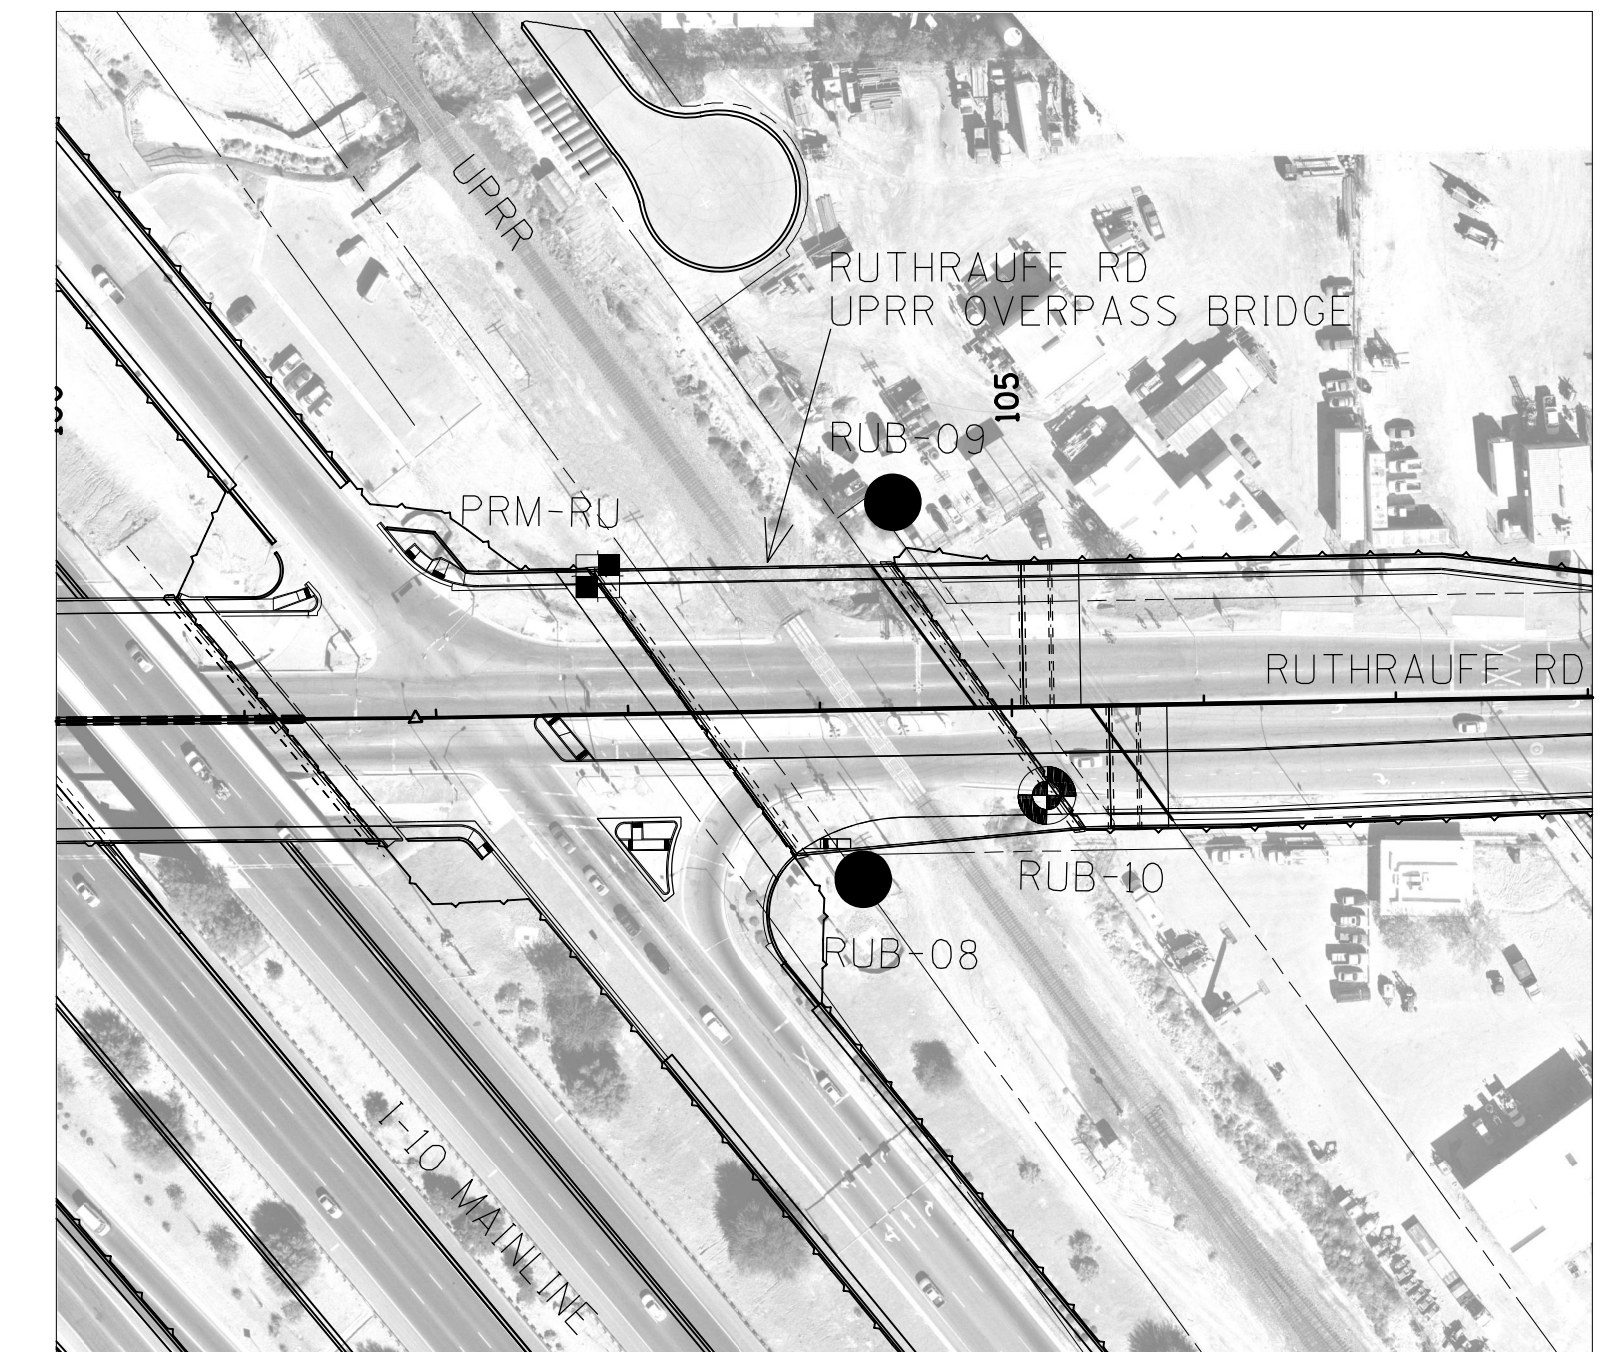

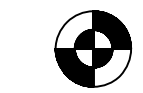-  PHASE 1 BORING LOCATION
-  PHASE 2 BORING LOCATION
-  PRESSUREMETER BORING LOCATION

OTHER TERMINOLOGY

<b>Quantity:</b>	<b>Reaction to HCl:</b>	
Trace < 5%	No reaction	No visible reaction
Few 5-10%	Weak reaction	Some reaction, with bubbles forming slowly
Little 15-25%	Strong reaction	Violent reaction, with bubbles forming immediately
Some 30-45%		
Mostly > 50%		

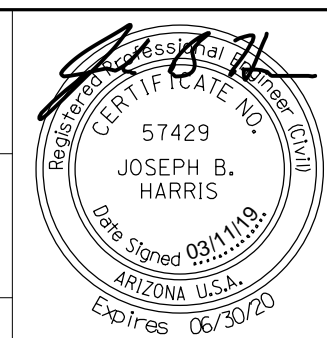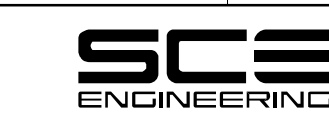DESIGN	JBH	3-19	<b>ARIZONA DEPARTMENT OF TRANSPORTATION</b> <b>INFRASTRUCTURE DELIVERY AND OPERATIONS DIVISION</b> <b>BRIDGE GROUP</b>	
DRAWN	JBH	3-19		
CHECKED	KW	3-19		
		510 E. 4TH STREET TUCSON, AZ 85705 520-405-1353	STA 103+ RUTHRAUFF RD - UPRR OVERPASS FOUNDATION DATA (1 OF 5)	
I-10	252.00	20160	LOCATION	RUTHRAUFF ROAD T.I.
ROUTE	MILEPOST	STRUCTURE NO.		DWG NO. S-2.32
TRACS NO. H8480 OIC				010-D(213)S
				OF



DATE- LOCATION- REVISIONS- FINISHED PLANS- SURVEY NO. DATE- LOCATION- REVISIONS- FINISHED PLANS- SURVEY NO.



F.H.W.A. REGION	STATE	PROJECT NO.	SHEET NO.	TOTAL SHEETS	RECORD DRAWING
9	ARIZ.	010-D(213)S	688	849	

010 PM 252

### SCE BORING LOG: PRM-RU (1 of 2)

5217+83, 286 Lt. (Ref. Al. I-10 CL)  
 NORTHING: 472,053 EASTING: 974,503  
 ELEV.: 2,247.5 TOTAL DEPTH: 129

CONTRACTOR: GSI  
 DRILLER: S. Bradshaw  
 INSPECTOR: JBH  
 RIG TYPE: Truck mt. CME 75  
 DRILLING METHOD: 8" OD HSA  
 HAMMER TYPE: Auto Hammer  
 SCE PROJECT #: J2009-14/J2012-07

STARTED: 08/29/2012 06:20 AM  
 FINISHED: 08/30/2012 03:50 PM

DEPTH (FT)	ELEV. (FT)	GRAPHIC	SAMPLE			SAMPLER TYPES	Type	Symbol	Description	I.D.	O.D.	Length	VISUAL SOIL IDENTIFICATION / DESCRIPTION AND REMARKS
			TYPE	SYMBOL	BLOWS								
			S	⊗		S	⊗	Split Spoon	1.375"	2"	18"		
			R	■		R	■	Ring Sampler	2.5"	3"	18"		
			U	□		U	□	Shelby Tube					
5	2245		S	⊗	5-3-3	S	⊗	SANDY SILT (native), soft, dry, brown, nonplastic SILT, some fine to coarse sand, trace fine gravel, weak cementation, strong reaction with HCl, max. particle size 0.75". (ML)					
10	2240		R	■	16-19	R	■	SILTY SAND, medium dense, dry, brown, fine SAND, some low plasticity fines, weak cementation, strong reaction with HCl. (SM) No recovery. Sent split spoon sampler to recover lost soil. Recovered 12". Placed catcher in ring sampler. Attempted pressuremeter test at 12.5'. Attempted pressuremeter test at 8'.					
15	2235		S	⊗	3-6-8	S	⊗	POORLY-GRADED SAND, medium dense, dry, brown, fine to medium SAND, trace nonplastic fines, no cementation, no reaction with HCl. (SP)					
20	2230		S	⊗	4-5-8	S	⊗	POORLY-GRADED SAND WITH SILT, medium dense, dry, brown, fine SAND, few nonplastic fines, trace fine subrounded gravel, no cementation, no reaction with HCl, max. particle size 0.5". (SP-SM)					
25	2225		R	■	12-35	R	■	Added 1 gallon of water to boring at 20'. Attempted pressuremeter test at 22.5'. Difficult drilling from 23' to 24'. Attempted pressuremeter test at 17.5'.					
30	2220		S	⊗	12-19-19	S	⊗	SILTY SAND, medium dense, dry, brown, fine to medium SAND, little fine subrounded to subangular gravel, little nonplastic fines, no cementation, no reaction with HCl, max. particle size 0.75". (SM) Rock in sampler tip. Difficult drilling from 28' to 60'.					
35	2215		S	⊗	16-21-18	S	⊗	WELL-GRADED SAND WITH SILT AND GRAVEL, dense, dry, brown, fine to coarse SAND, some fine to coarse subrounded to subangular gravel, few nonplastic fines, no cementation, no reaction with HCl, max. particle size 1". (SW-SM)					
40	2210		CU	□	50/5	CU	□	Placed catcher in split spoon sampler. WELL-GRADED GRAVEL WITH SILT AND SAND, dense, dry to moist, brown, fine to coarse subrounded to subangular GRAVEL, some fine to coarse sand, few low plasticity fines, no cementation, no reaction with HCl, max. particle size 1.5". (GW-GM)					
45	2205		R	■	26-50/6	R	■	Rock in sampler tip at 35'. Added 1 gallon of water to boring at 35'. Attempted pressuremeter test at 36'. Becomes very dense. No recovery.					
50	2200		S	⊗	16-28-27	S	⊗	SILTY SAND WITH GRAVEL, very dense, dry to moist, brown, fine to coarse SAND, little fine subrounded to subangular gravel, little low plasticity fines, weak cementation, no reaction with HCl, max. particle size 0.75". (SM) Noted 2" gravel in cuttings. Removed catchers from samplers.					
55	2195		R	■	50/1	R	■	POORLY-GRADED SAND WITH CLAY AND GRAVEL, very dense, moist, brown, fine to coarse SAND, some fine to coarse subrounded to subangular gravel, few medium plasticity fines, weak cementation, no reaction with HCl, max. particle size 1", strong hydro-carbon odor. (SP-SC)					
60	2190		S	⊗	23-30-32	S	⊗	CLAYEY SAND WITH GRAVEL, very dense, moist, brown, fine to coarse SAND, some fine to coarse subrounded to subangular gravel, little high plasticity fines, weak cementation, no reaction with HCl, max. particle size 1", faint hydro-carbon odor. (SC)					
65	2185		S	⊗	14-21-19	S	⊗	Attempted pressuremeter test at 57'. Attempted pressuremeter test at 65'. Added 5 gallons of water to boring at 65'. Becomes dense, little medium plasticity fines.					
70	2180												

### SCE BORING LOG: PRM-RU (2 of 2)

5217+83, 286 Lt. (Ref. Al. I-10 CL)  
 NORTHING: 472,053 EASTING: 974,503  
 ELEV.: 2,247.5 TOTAL DEPTH: 129


CONTRACTOR: GSI  
 DRILLER: S. Bradshaw  
 INSPECTOR: JBH  
 RIG TYPE: Truck mt. CME 75  
 DRILLING METHOD: 8" OD HSA  
 HAMMER TYPE: Auto Hammer  
 SCE PROJECT #: J2009-14/J2012-07

STARTED: 08/29/2012 06:20 AM  
 FINISHED: 08/30/2012 03:50 PM

DEPTH (FT)	ELEV. (FT)	GRAPHIC	SAMPLE			SAMPLER TYPES	Type	Symbol	Description	I.D.	O.D.	Length	VISUAL SOIL IDENTIFICATION / DESCRIPTION AND REMARKS
			TYPE	SYMBOL	BLOWS								
75	2175		S	⊗	22-24-23	S	⊗	Becomes dry to moist, little fine subrounded to subangular gravel, max. particle size 0.75". Added 5 gallons of water to boring at 70'. Attempted pressuremeter test at 73'.					
80	2170		R	■	27-50/4	R	■	Becomes very dense, moist, little fine to coarse subrounded to subangular gravel, max. particle size 1". Added 5 gallons of water to boring at 75'.					
85	2165		S	⊗	31-34-34	S	⊗	Becomes dry to moist, little fine subrounded to subangular gravel, max. particle size 0.75", very faint hydro-carbon odor. Added 5 gallons of water to boring at 80'.					
90	2160		S	⊗	12-19-26	S	⊗	Becomes dense, little fine to coarse subrounded to subangular gravel, max. particle size 1", no noted hydro-carbon odor. Added 5 gallons of water to boring at 85'.					
95	2155		S	⊗	19-27-30	S	⊗	Becomes very dense, some fine to coarse subrounded to subangular gravel. Added 5 gallons of water to boring at 90'. Attempted pressuremeter test at 93'.					
100	2150		R	■	50/5	R	■	Becomes little fine subrounded to subangular gravel, max. particle size 0.75". Added 5 gallons of water to boring at 95'.					
105	2145		S	⊗	27-40-50/3	S	⊗	Becomes little low plasticity fines. Added 10 gallons of water to boring at 100'.					
110	2140		S	⊗	30-50/4	S	⊗	CLAYEY GRAVEL WITH SAND, very dense, dry to moist, brown, fine to coarse subrounded to subangular GRAVEL, some fine to coarse sand, little medium plasticity fines, weak cementation, no reaction with HCl, max. particle size 1". (GC) Added 5 gallons of water to boring at 105'.					
115	2135		S	⊗	23-22-37	S	⊗	CLAYEY SAND WITH GRAVEL, very dense, dry to moist, brown, fine to coarse SAND, little fine subrounded to subangular gravel, little medium plasticity fines, weak cementation, no reaction with HCl, max. particle size 0.75". (SC) Added 5 gallons of water to boring at 110'.					
120	2130		R	■	50/6	R	■	SILTY SAND WITH GRAVEL, very dense, dry to moist, brown, fine to coarse SAND, little fine subrounded to subangular gravel, little nonplastic fines, weak cementation, no reaction with HCl, max. particle size 0.75". (SM) Attempted pressuremeter test at 113'. Added 5 gallons of water to boring at 115'.					
125	2125		S	⊗	36-50/6	S	⊗	CLAYEY SAND WITH GRAVEL, very dense, dry to moist, brown, fine to coarse SAND, some fine to coarse subrounded to subangular gravel, little medium plasticity fines, weak cementation, no reaction with HCl, max. particle size 1.5" (SC) Added 5 gallons of water to boring at 120'.					
130	2120		S	⊗	15-25-45	S	⊗	Becomes little fine subrounded to subangular gravel, max. particle size 0.75". Attempted pressuremeter test at 128'. End of boring with 8" OD HSA at 125'. Advanced boring to 129' with 3" air rotary for pressuremeter test at 128'. No groundwater encountered. Backfilled with neat cement grout.					
135	2115												
140	2110												

### BORING PLAN

SCALE 1:100

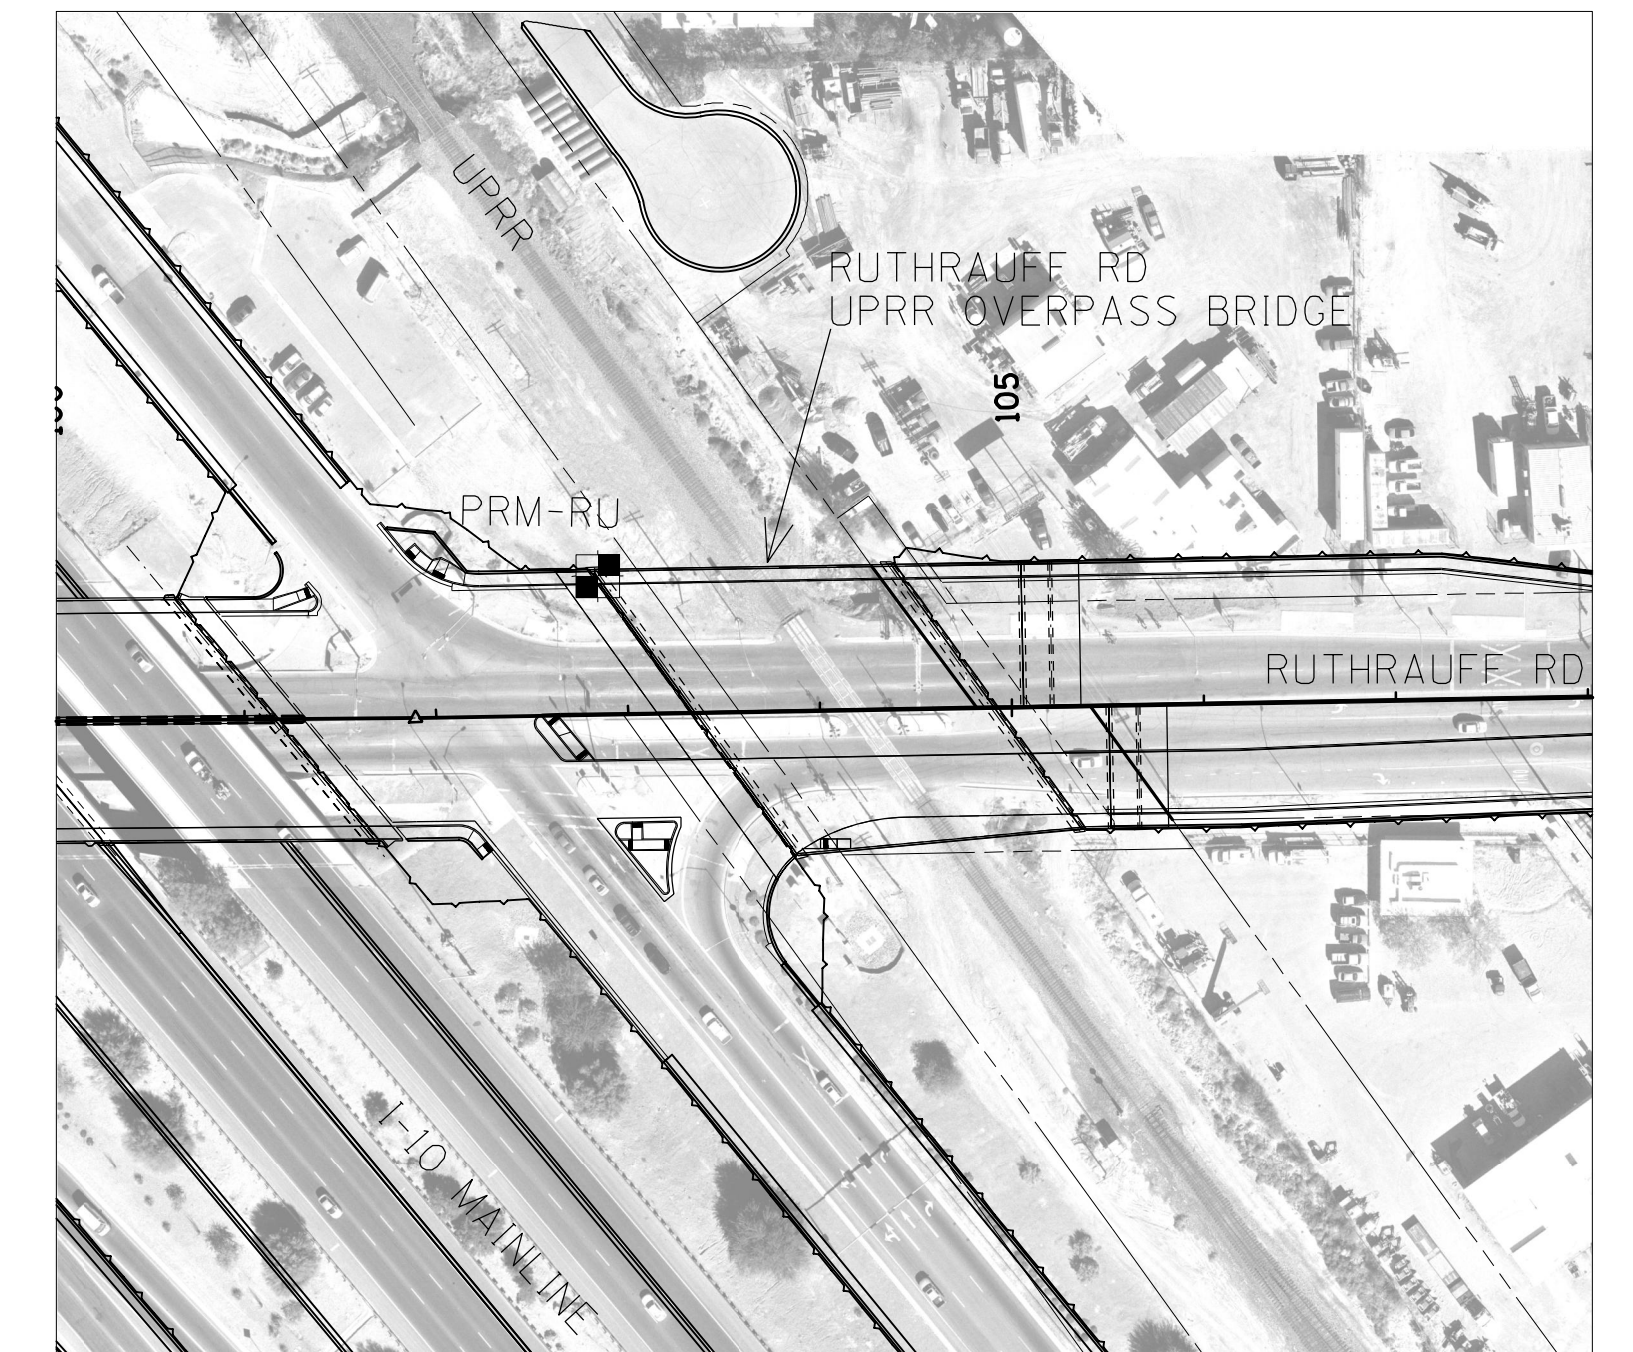

- PHASE 1 BORING LOCATION
- PHASE 2 BORING LOCATION
- PRESSUREMETER BORING LOCATION

DESIGN	JBH	DATE	3-19	<b>ARIZONA DEPARTMENT OF TRANSPORTATION</b> <b>INFRASTRUCTURE DELIVERY AND OPERATIONS DIVISION</b> <b>BRIDGE GROUP</b> STA 103+ RUTHRAUFF RD - UPRR OVERPASS FOUNDATION DATA (2 OF 5)	
DRAWN	JBH	3-19			
CHECKED	KW	3-19			
<b>SCE ENGINEERING</b> 510 E. 4TH STREET TUCSON, AZ 85705 520-405-1353		LOCATION RUTHRAUFF ROAD T.I.		DWG NO.	S-2.33
ROUTE 1-10 MILEPOST 252.00 STRUCTURE NO. 20160		TRACS NO. H8480 OIC		010-D(213)S OF	





DATE: LOCATION: REVISIONS: FINISHED PLANS: SURVEY NO. DATE: LOCATION: REVISIONS: FINISHED PLANS: SURVEY NO.

**SCE BORING LOG: RUB-08 (1 of 2)**  
 104+21, 88 Rt. (Ref. Al. Ruthrauff CL)  
 NORTHING: 471,894 EASTING: 974,641  
 ELEV.: 2,248.2 TOTAL DEPTH: 120.8

CONTRACTOR: GSI  
 DRILLER: R. Quezada  
 INSPECTOR: E. Everts  
 RIG TYPE: Truck mt. CME 95  
 DRILLING METHOD: 8" OD HSA  
 HAMMER TYPE: Auto Hammer  
 SCE PROJECT #: J2009-14/J2012-07

STARTED: 08/28/2013 07:00 AM  
 FINISHED: 08/29/2013 12:00 PM

DEPTH (FT)	ELEV. (FT)	GRAPHIC	SAMPLE			SAMPLER TYPES	Type	Symbol	Description	I.D.	O.D.	Length	VISUAL SOIL IDENTIFICATION / DESCRIPTION AND REMARKS
			TYPE	SYMBOL	BLOWS								
						S	⊗	Split Spoon	1.375"	2"	18"		
						R	■	Ring Sampler	2.5"	3"	18"		
						U	□	Shelby Tube					
5	2245		S	⊗	7-10-6			CLAYEY SAND WITH GRAVEL (native), medium dense, dry, brown, fine to coarse SAND, some medium plasticity fines, little fine to coarse subrounded to subangular gravel, no cementation, strong reaction with HCl, max. particle size 1". (SC)					
			CU	■	12-8			Becomes loose.					
10	2240		R	■	9-11			SANDY LEAN CLAY, stiff, moist, dark brown, medium plasticity CLAY, some fine to medium sand, few fine subrounded to subangular gravel, no cementation, strong reaction with HCl, max. particle size 0.75". (CL)					
			S	⊗	5-9-9			SILTY SAND, loose, moist, brown, fine SAND, some nonplastic fines, no cementation, no reaction with HCl. (SM)					
15	2235		S	⊗	6-12-10			WELL-GRADED SAND WITH SILT, medium dense, moist, brown, fine to medium SAND, little fine subrounded to subangular gravel, few nonplastic fines, no cementation, no reaction with HCl, max. particle size 0.75". (SW-SM)					
20	2230		S	⊗	7-8-9			Becomes dry, little fine to coarse subrounded to subangular gravel, max. particle size 1".					
25	2225		R	■	5-8			WELL-GRADED GRAVEL WITH SILT AND SAND, loose, moist, brown, fine to coarse subrounded GRAVEL, some fine to coarse sand, few low plasticity fines, no cementation, no reaction with HCl, max. particle size 1.5". (GW-GM)					
30	2220		S	⊗	16-20-25			Becomes dense. Noted 4" cobbles in cuttings.					
35	2215		S	⊗	11-22-35			Becomes very dense.					
40	2210		R	■	50/1			CLAYEY GRAVEL WITH SAND, very dense, moist, brown, fine to coarse subangular GRAVEL, some fine to coarse sand, little low plasticity fines, no cementation, no reaction with HCl, max. particle size 1.5". (GC) No recovery.					
45	2205		S	⊗	50/4								
50	2200		S	⊗	6-27-38			Becomes gray-brown, noted hydrocarbon odor at 55'.					
55	2195		S	⊗	10-22-29			CLAYEY SAND WITH GRAVEL, very dense, moist, gray-brown, fine to coarse SAND, some fine subrounded to subangular gravel, little low plasticity fines, no cementation, no reaction with HCl, max. particle size 0.75", noted hydrocarbon odor at 60'. (SC)					
60	2190		S	⊗	26-19-13			Becomes dense, little fine subrounded to subangular gravel. Added 5 gallons of water to boring at 65'.					
65	2185												
70	2180												

**SCE BORING LOG: RUB-08 (2 of 2)**  
 104+21, 88 Rt. (Ref. Al. Ruthrauff CL)  
 NORTHING: 471,894 EASTING: 974,641  
 ELEV.: 2,248.2 TOTAL DEPTH: 120.8

CONTRACTOR: GSI  
 DRILLER: R. Quezada  
 INSPECTOR: E. Everts  
 RIG TYPE: Truck mt. CME 95  
 DRILLING METHOD: 8" OD HSA  
 HAMMER TYPE: Auto Hammer  
 SCE PROJECT #: J2009-14/J2012-07

STARTED: 08/28/2013 07:00 AM  
 FINISHED: 08/29/2013 12:00 PM


DEPTH (FT)	ELEV. (FT)	GRAPHIC	SAMPLE			SAMPLER TYPES	Type	Symbol	Description	I.D.	O.D.	Length	VISUAL SOIL IDENTIFICATION / DESCRIPTION AND REMARKS
			TYPE	SYMBOL	BLOWS								
75	2175		R	■	30-22			Becomes medium dense, brown, no noted hydrocarbon odor. Added 5 gallons of water to boring at 70'.					
			S	⊗	15-29-30			Becomes very dense.					
80	2170		S	⊗	32-32-36			Becomes little medium plasticity fines.					
			S	⊗	20-28-27			Added 5 gallons of water to boring at 85'.					
85	2165		S	⊗	12-14-20			Becomes dense, max. particle size 0.5".					
90	2160		S	⊗	19-25-27			Becomes very dense, max. particle size 0.75".					
95	2155		R	■	50/6			Becomes some fine to coarse subrounded to subangular gravel, max. particle size 1".					
100	2150		S	⊗	26-34-34								
105	2145		S	⊗	26-31-21								
110	2140		S	⊗	32-37-50/5								
115	2135		S	⊗	46-50/4								
120	2130							End of boring at 120'. Stopped sampler at 120.8'. No groundwater encountered. Backfilled with portland cement and sand mixture.					
125	2125												
130	2120												
135	2115												
140	2110												

F.H.W.A. REGION	STATE	PROJECT NO.	SHEET NO.	TOTAL SHEETS	RECORD DRAWING
9	ARIZ.	010-D(213)S	689	849	

010 PM 252

**BORING PLAN**

SCALE 1:100

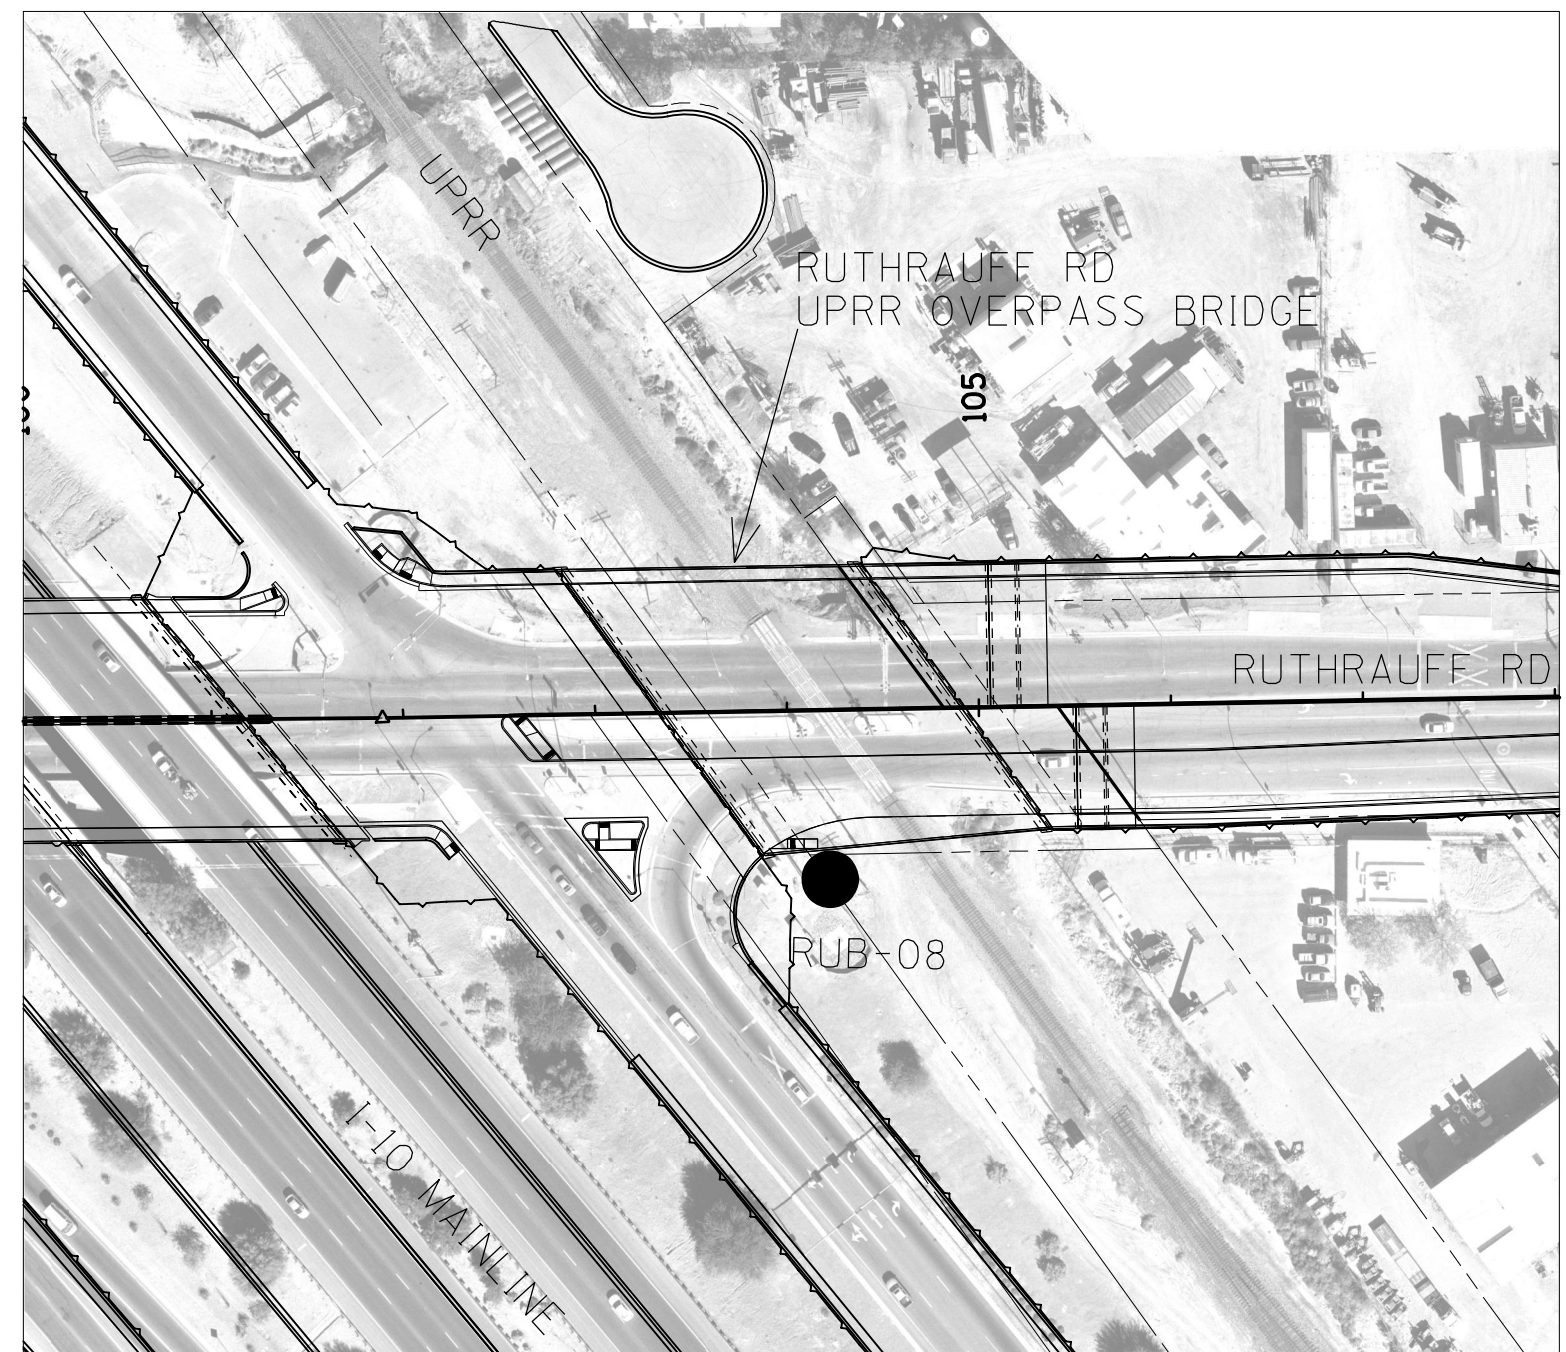

- PHASE 1 BORING LOCATION
- PHASE 2 BORING LOCATION
- PRESSUREMETER BORING LOCATION

DESIGN	JBH	DATE	3-19	<b>ARIZONA DEPARTMENT OF TRANSPORTATION</b> <b>INFRASTRUCTURE DELIVERY AND OPERATIONS DIVISION</b> <b>BRIDGE GROUP</b> STA 103+ RUTHRAUFF RD - UPRR OVERPASS FOUNDATION DATA (3 OF 5)	
DRAWN	JBH	3-19			
CHECKED	KW	3-19			
		510 E. 4TH STREET TUCSON, AZ 85705 520-405-1353		LOCATION RUTHRAUFF ROAD T.I.	DWG NO. S-2.34
I-10 ROUTE		252.00 MILEPOST	20160 STRUCTURE NO.	TRACS NO. H8480 OIC	010-D(213)S



F.H.W.A. REGION	STATE	PROJECT NO.	SHEET NO.	TOTAL SHEETS	RECORD DRAWING
9	ARIZ.	010-D(213)S	690	849	

010 PM 252

**SCE BORING LOG: RUB-09 (1 of 2)**  
 104+40, 108 Lt. (Ref. Al. Ruthrauff CL)  
 NORTHING: 472,091 EASTING: 974,657  
 ELEV.: 2,246.7 TOTAL DEPTH: 130.4  
 STARTED: 08/26/2013 08:05 AM  
 FINISHED: 08/26/2013 03:00 PM  
 CONTRACTOR: GSI  
 DRILLER: S. Bradshaw  
 INSPECTOR: C. Lavayen  
 RIG TYPE: Truck mt. CME 75  
 DRILLING METHOD: 8" OD HSA  
 HAMMER TYPE: Auto Hammer  
 SCE PROJECT #: J2009-14/J2012-07


DEPTH (FT)	ELEV. (FT)	GRAPHIC	SAMPLE			SAMPLER TYPES	Type	Symbol	Description	I.D.	O.D.	Length	VISUAL SOIL IDENTIFICATION / DESCRIPTION AND REMARKS
			TYPE	SYMBOL	BLOWS								
			S	⊗		S	⊗	Split Spoon	1.375"	2"	18"		
			R	■		R	■	Ring Sampler	2.5"	3"	18"		
			U	□		U	□	Shelby Tube					
2245			S	⊗	4-4-5	S	⊗	SANDY LEAN CLAY (native), stiff, moist, dark brown, medium plasticity CLAY, little fine to coarse sand, few fine to coarse gravel, no cementation, weak reaction with HCl, max. particle size 1". (CL)					
5	2240		CU	■	8-10	CU	■	Becomes medium stiff, light brown, strong reaction with HCl.					
10	2235		S	⊗	5-4-6	S	⊗	SILTY, CLAYEY SAND, loose, dry to moist, light brown, fine SAND, some low plasticity fines, no cementation, strong reaction with HCl. (SC-SM)					
15	2230		R	■	6-10	R	■	FAT CLAY, medium stiff, moist, black, high plasticity CLAY, few fine sand, no cementation, weak reaction with HCl, lensed with fine to medium sand approximately 5" to 6" thick. (CH)					
20	2225		S	⊗	4-4-5	S	⊗	WELL-GRADED SAND WITH SILT, loose, dry to moist, light brown, fine to coarse SAND, few fine subrounded to subangular gravel, few nonplastic fines, no cementation, no reaction with HCl, max. particle size 0.25". (SW-SM)					
25	2220		S	⊗	6-6-6	S	⊗	WELL-GRADED GRAVEL WITH SILT AND SAND, medium dense, dry to moist, light brown, fine to coarse subrounded GRAVEL, little fine to coarse sand, few low plasticity fines, no cementation, weak reaction with HCl, max. particle size 1.5". (GW-GM) Noted 4" cobbles in cuttings. Auger chatter and difficult drilling from 23' to 48'.					
30	2215		R	■	40-50/1	R	■	Becomes very dense, max. particle size 2.5". Rock in sampler tip.					
35	2210		S	⊗	17-15-24	S	⊗	Becomes dense.					
40	2205		S	⊗	30-50/5	S	⊗	WELL-GRADED SAND WITH SILTY CLAY AND GRAVEL, very dense, dry to moist, light brown, fine to coarse SAND, some fine to coarse subrounded gravel, few low plasticity fines, no cementation, weak reaction with HCl, max. particle size 1". (SW-SC)					
45	2200		S	⊗	50/5	S	⊗						
50	2195		R	■	50/3	R	■	CLAYEY SAND WITH GRAVEL, very dense, moist, brown, fine to coarse SAND, little fine subrounded to subangular gravel, little low to medium plasticity fines, no cementation, strong reaction with HCl, max. particle size 0.25". (SC) Noted 3" gravel in cuttings.					
55	2190		S	⊗	50/5	S	⊗						
60	2185		S	⊗	14-18-23	S	⊗	Becomes dense, little fine to coarse subrounded to subangular gravel, weak reaction with HCl, max. particle size 1.5". Noted hydrocarbon odor at 60'.					
65	2180		S	⊗	21-34-40	S	⊗	Becomes very dense, dry to moist, some fine to coarse subangular to angular gravel, little medium plasticity fines, weak cementation.					
70													

**SCE BORING LOG: RUB-09 (2 of 2)**  
 104+40, 108 Lt. (Ref. Al. Ruthrauff CL)  
 NORTHING: 472,091 EASTING: 974,657  
 ELEV.: 2,246.7 TOTAL DEPTH: 130.4  
 STARTED: 08/26/2013 08:05 AM  
 FINISHED: 08/26/2013 03:00 PM  
 CONTRACTOR: GSI  
 DRILLER: S. Bradshaw  
 INSPECTOR: C. Lavayen  
 RIG TYPE: Truck mt. CME 75  
 DRILLING METHOD: 8" OD HSA  
 HAMMER TYPE: Auto Hammer  
 SCE PROJECT #: J2009-14/J2012-07

DEPTH (FT)	ELEV. (FT)	GRAPHIC	SAMPLE			SAMPLER TYPES	Type	Symbol	Description	I.D.	O.D.	Length	VISUAL SOIL IDENTIFICATION / DESCRIPTION AND REMARKS
			TYPE	SYMBOL	BLOWS								
2175			R	■	43-45	R	■	Becomes dense, max. particle size 2". No noted hydrocarbon odor at 70'.					
75	2170		S	⊗	7-10-23	S	⊗	WELL-GRADED SAND WITH CLAY AND GRAVEL, dense, moist, brown, fine to coarse SAND, little fine subangular to angular gravel, few low plasticity fines, weak cementation, weak reaction with HCl, max. particle size 0.25". (SW-SC)					
80	2165		S	⊗	29-12-21	S	⊗	Becomes trace fine subangular to angular gravel, no cementation.					
85	2160		S	⊗	16-20-28	S	⊗	Added 5 gallons of water to boring at 85'.					
90	2155		R	■	50/6	R	■	Becomes very dense, redish brown, weak cementation. Added 5 gallons of water to boring at 90'.					
95	2150		S	⊗	18-21-38	S	⊗	CLAYEY SAND, very dense, moist, brown, fine to coarse SAND, little low plasticity fines, few fine subangular to angular gravel, weak cementation, weak reaction with HCl, max. particle size 0.25". (SC)					
100	2145		S	⊗	37-44-50/3	S	⊗	Becomes CLAYEY SAND WITH GRAVEL, dry to moist, some fine subangular to angular gravel, little medium plasticity fines, max. particle size 0.75".					
105	2140		S	⊗	40-43-44	S	⊗	Becomes yellow-brown, trace fine subangular to angular gravel, max. particle size 0.25".					
110	2135		S	⊗	23-17-47	S	⊗	SILTY, CLAYEY SAND, very dense, dry to moist, brown, fine to coarse SAND, little low plasticity fines, trace fine subangular to angular gravel, no cementation, no reaction with HCl, max. particle size 0.25". (SC-SM)					
115	2130		S	⊗	23-26-40	S	⊗	CLAYEY SAND WITH GRAVEL, very dense, dry to moist, brown, fine to coarse SAND, little fine to coarse subangular to angular gravel, little medium plasticity fines, weak cementation, no reaction with HCl, max. particle size 1". (SC)					
120	2125		R	■	50/4	R	■						
125	2120		S	⊗	50/4	S	⊗	Becomes CLAYEY SAND, orange-brown, few fine to coarse subangular to angular gravel.					
130	2115		S	⊗	50/5	S	⊗	Becomes CLAYEY SAND WITH GRAVEL, little fine to coarse subangular to angular gravel. End of boring at 130'. Stopped sampler at 130.4'. No groundwater encountered. Backfilled with portland cement and sand mixture.					
135	2110												
140													

**BORING PLAN**

SCALE 1:100

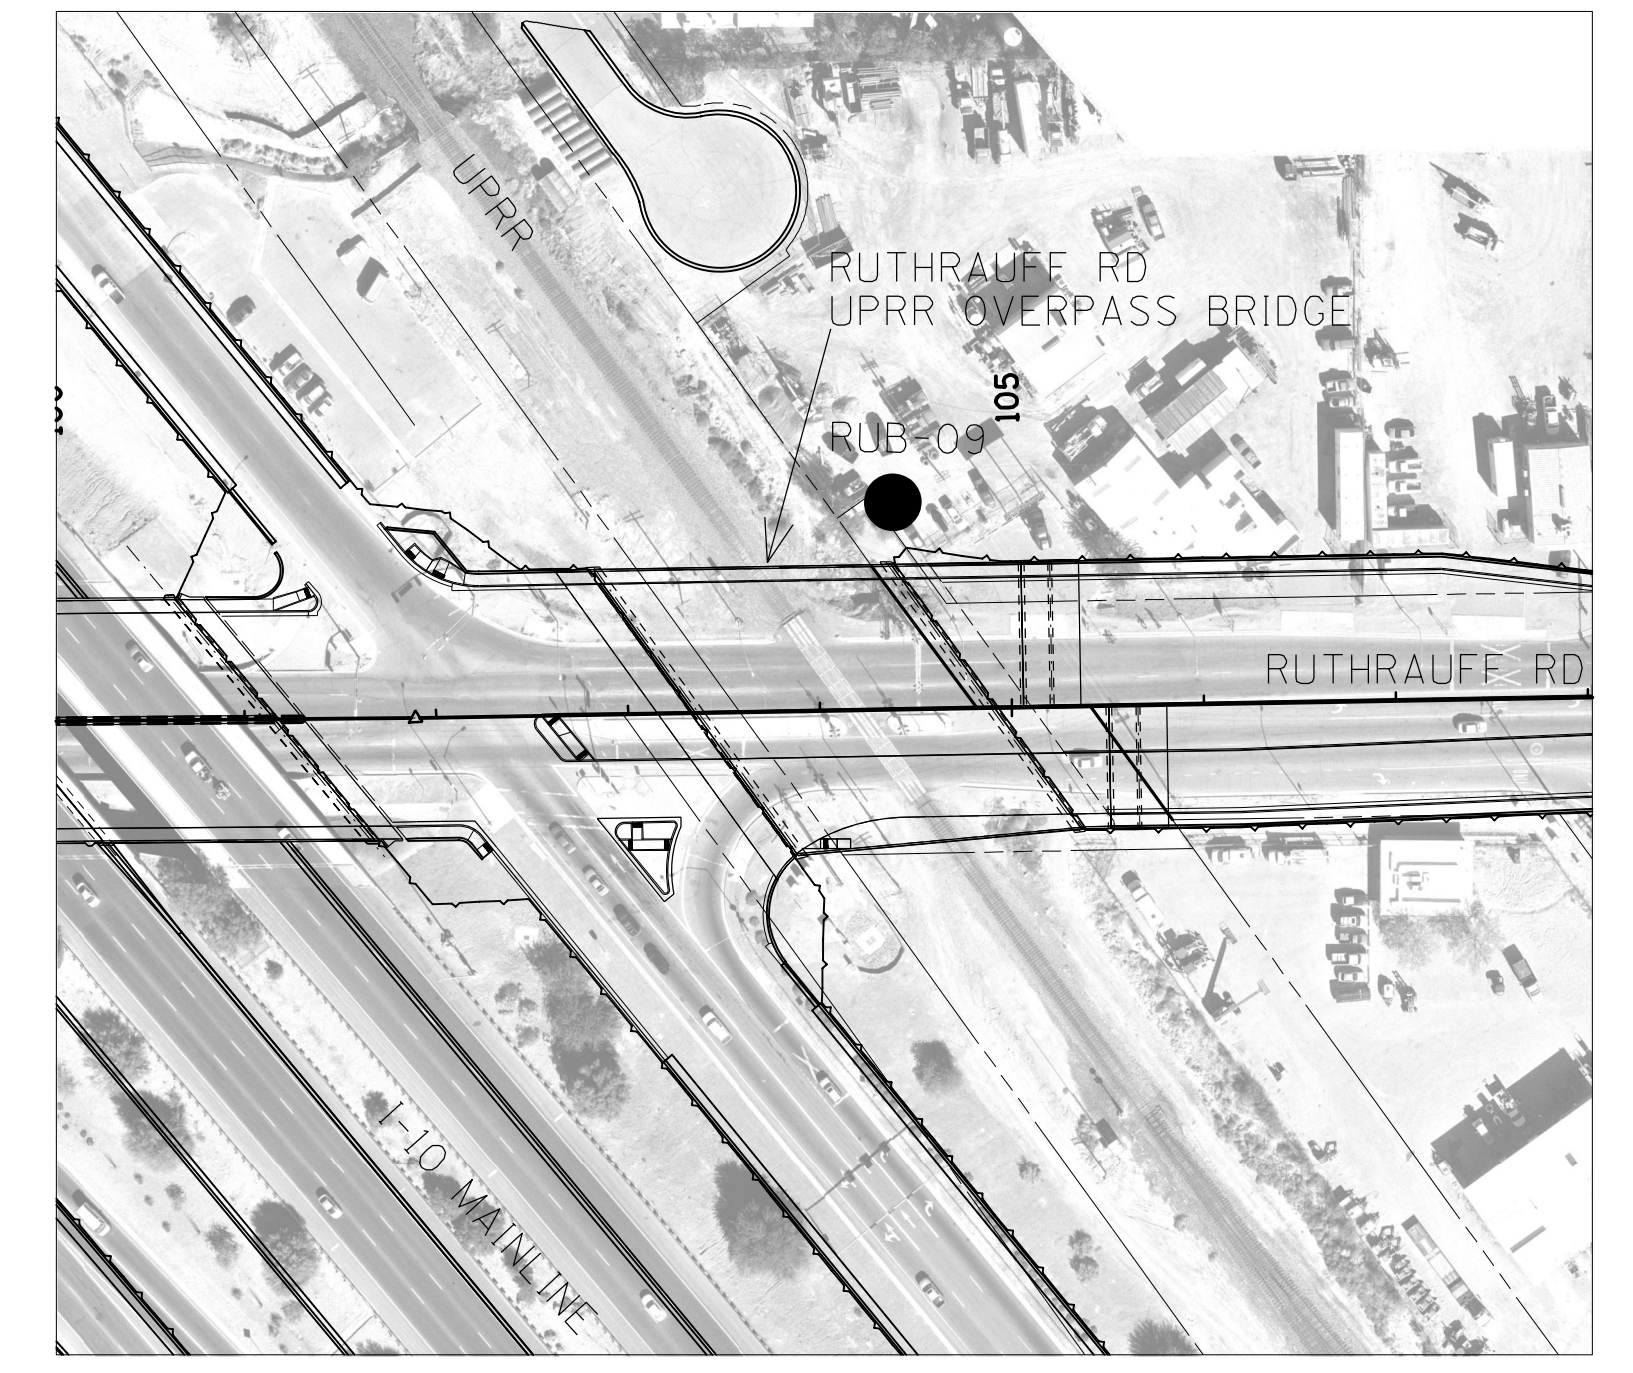

- PHASE 1 BORING LOCATION
- PHASE 2 BORING LOCATION
- PRESSUREMETER BORING LOCATION

DESIGN	JBH	DATE	3-19	<b>ARIZONA DEPARTMENT OF TRANSPORTATION</b> <b>INFRASTRUCTURE DELIVERY AND OPERATIONS DIVISION</b> <b>BRIDGE GROUP</b> STA 103+ <b>RUTHRAUFF RD - UPRR OVERPASS</b> <b>FOUNDATION DATA (4 OF 5)</b>	
DRAWN	JBH	3-19			
CHECKED	KW	3-19			
<b>SCE ENGINEERING</b> 510 E. 4TH STREET TUCSON, AZ 85705 520-405-1353		LOCATION <b>RUTHRAUFF ROAD T.I.</b>		DWG NO.	S-2.35
I-10 ROUTE 252.00 MILEPOST 20160 STRUCTURE NO.		TRACS NO. H8480 OIC		010-D(213)S	










CASA GRANDE - TUCSON HIGHWAY (I-10)  
DAVIS AVENUE FRAME  
PIMA COUNTY

F.H.W.A. REGION	STATE	PROJECT NO.	SHEET NO.	TOTAL SHEETS	RECORD DRAWING
9	ARIZ.	010-D(213)S	692	849	

010 PM 252

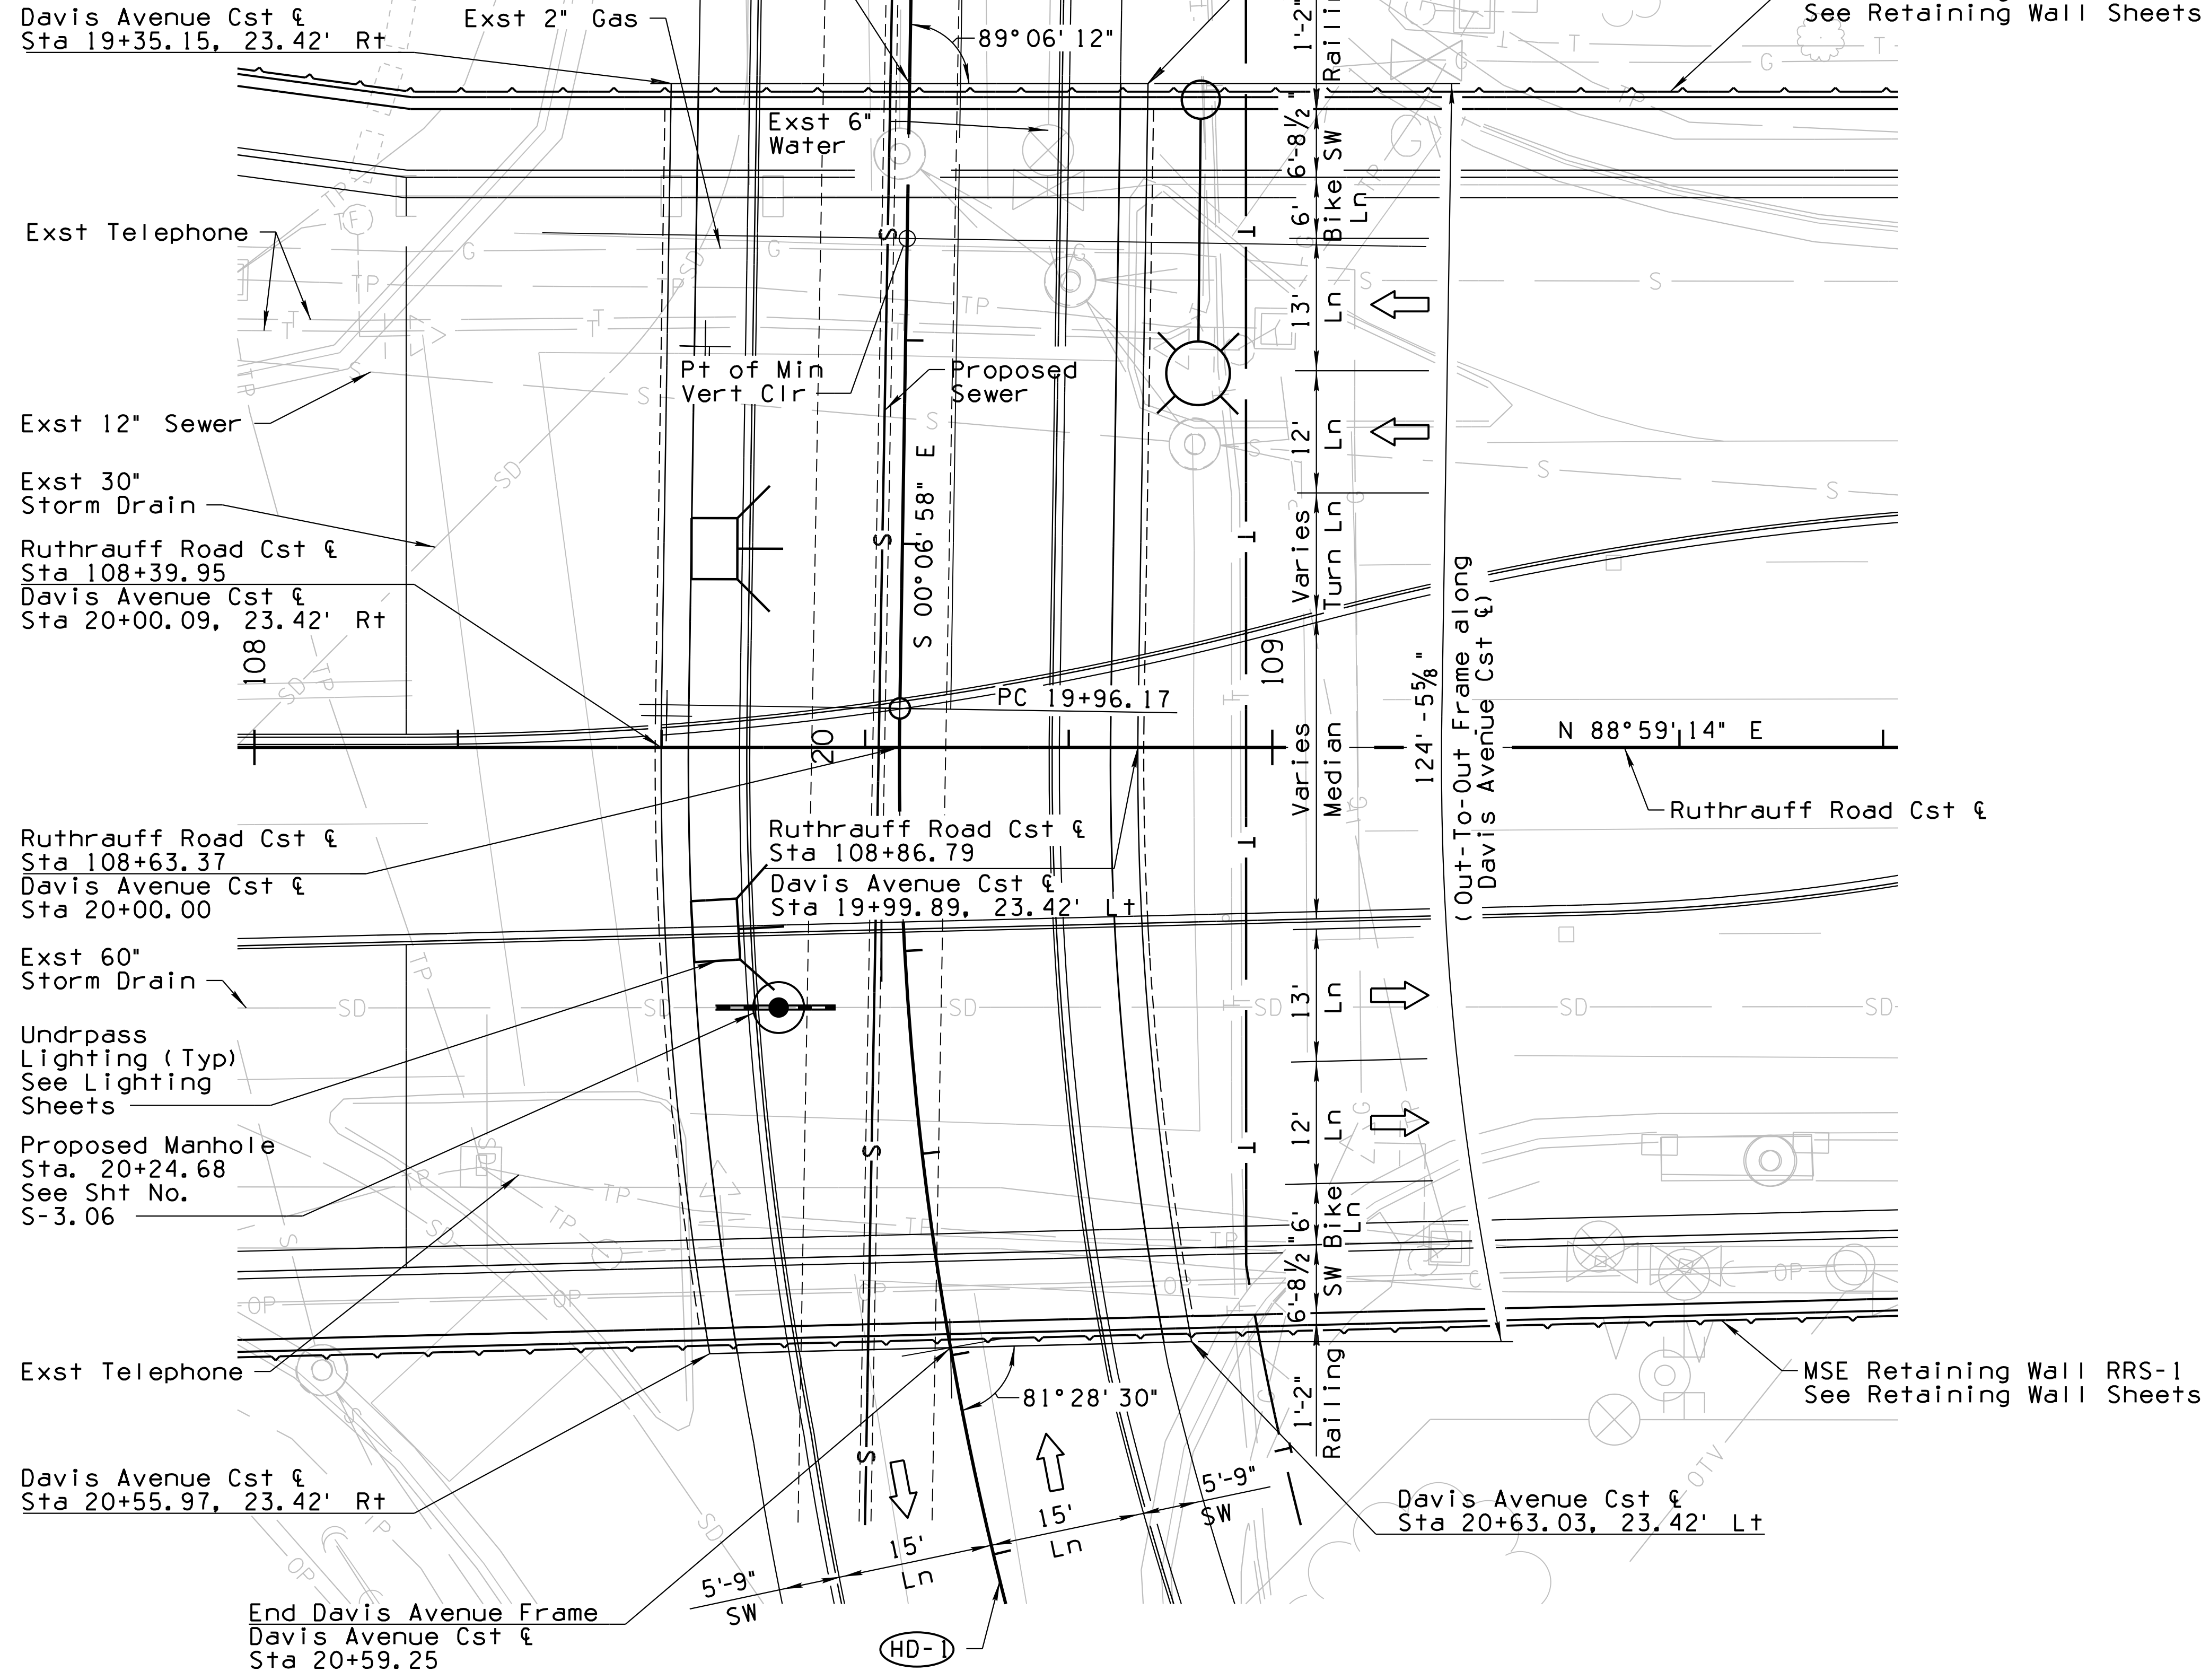

INDEX OF DRAWINGS


DWG NO	TITLE
S-3.01	GENERAL PLAN
S-3.02	ELEVATIONS AND TYPICAL SECTION
S-3.03	GENERAL NOTES & QUANTITIES
S-3.04	FOUNDATION PLAN
S-3.05	FRAME DETAILS
S-3.06	MISCELLANEOUS DETAILS

(HD-1) Davis Avenue Curve Data

PC Sta 19+96.17  
 PI Sta 21+02.95  
 PT Sta 22+02.84  
 $\Delta = 35^{\circ}33'34''$  Lt  
 $D = 17^{\circ}12'21''$   
 $R = 333.00'$   
 $L = 206.67'$   
 $T = 106.78'$   
 EXIT BEARING =  $S35^{\circ}40'32''$  E

NOTE:

Frame Stations, Length and Elevations measured along or perpendicular to Ruthrauff Road Cst & or Davis Avenue Cst &, unless noted otherwise.

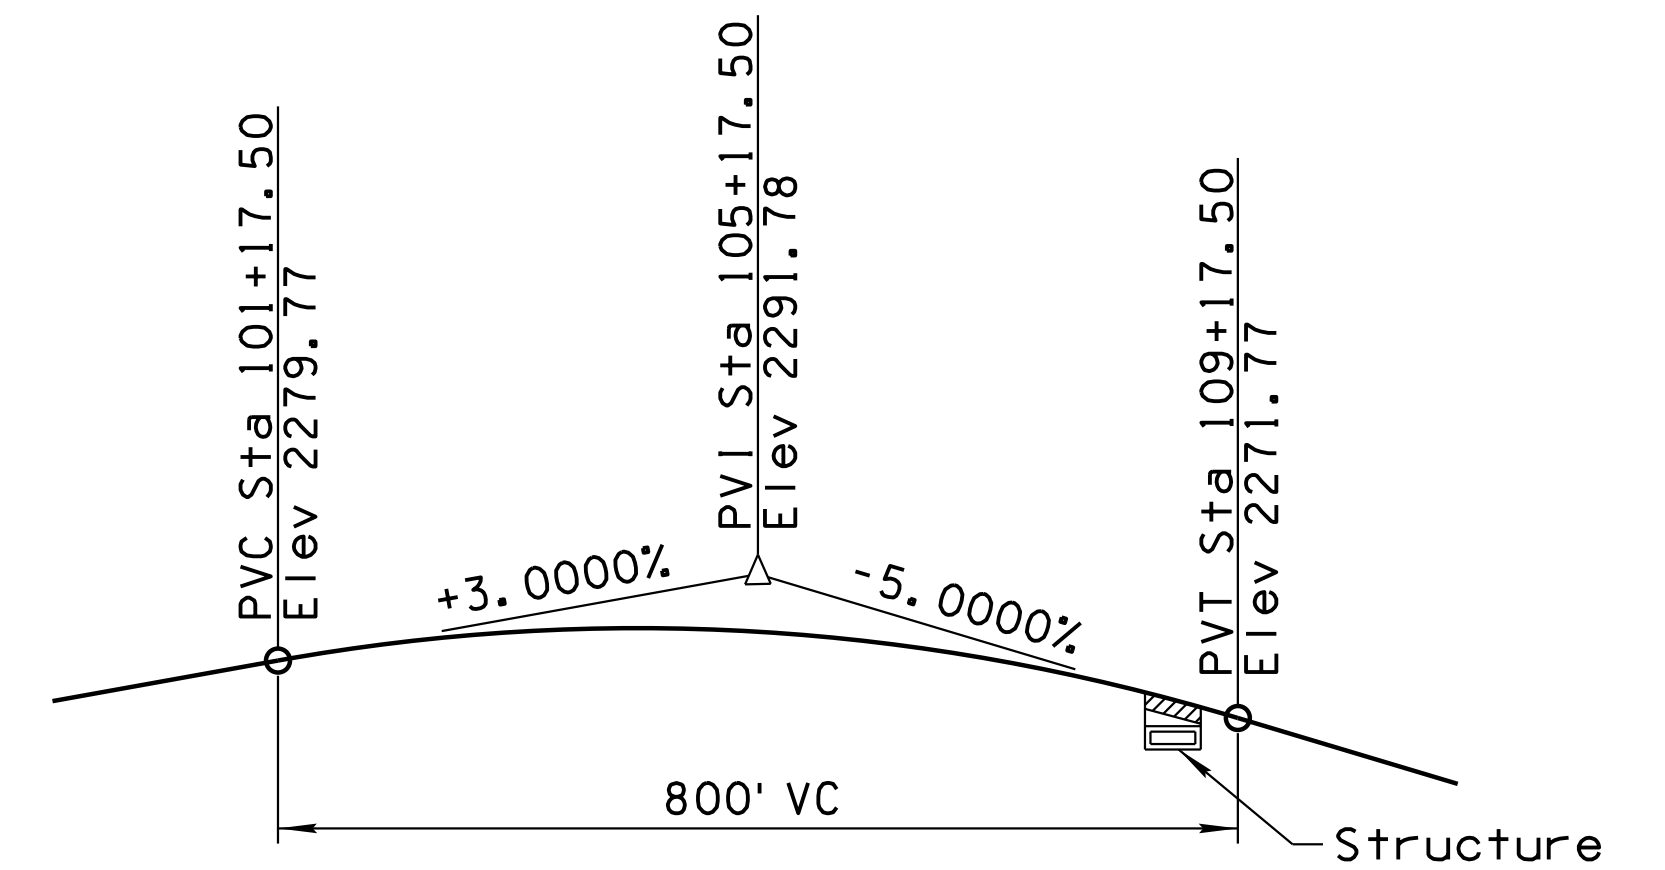

RUTHRAUFF ROAD CST & PROFILE GRADE LINE

No Scale


PLAN

New Concrete Frame Structure  
 Skew =  $00^{\circ}53'48''$   
 1' Contour Interval  
 Scale: 1" = 10'

DESIGN	NAME	DATE	ARIZONA DEPARTMENT OF TRANSPORTATION INFRASTRUCTURE DELIVERY AND OPERATIONS DIVISION BRIDGE GROUP
CR		3-19	
DRAWN	DAY	3-19	
CHECKED	JAC	3-19	
WSP USA Inc. 177 N. Church Avenue Suite 1105 Tucson, AZ 85701			STA 20+ DAVIS AVENUE FRAME GENERAL PLAN
I-10	252.00	11551	LOCATION DAVIS AVENUE
ROUTE	MILEPOST	STRUCTURE NO.	DWG NO. S-3.01
TRACS NO. H 8480 OIC			010-D(213)S
			OF


F.H.W.A. REGION	STATE	PROJECT NO.	SHEET NO.	TOTAL SHEETS	RECORD DRAWING
9	ARIZ.	010-D(213)S	693	849	

010 PM 252

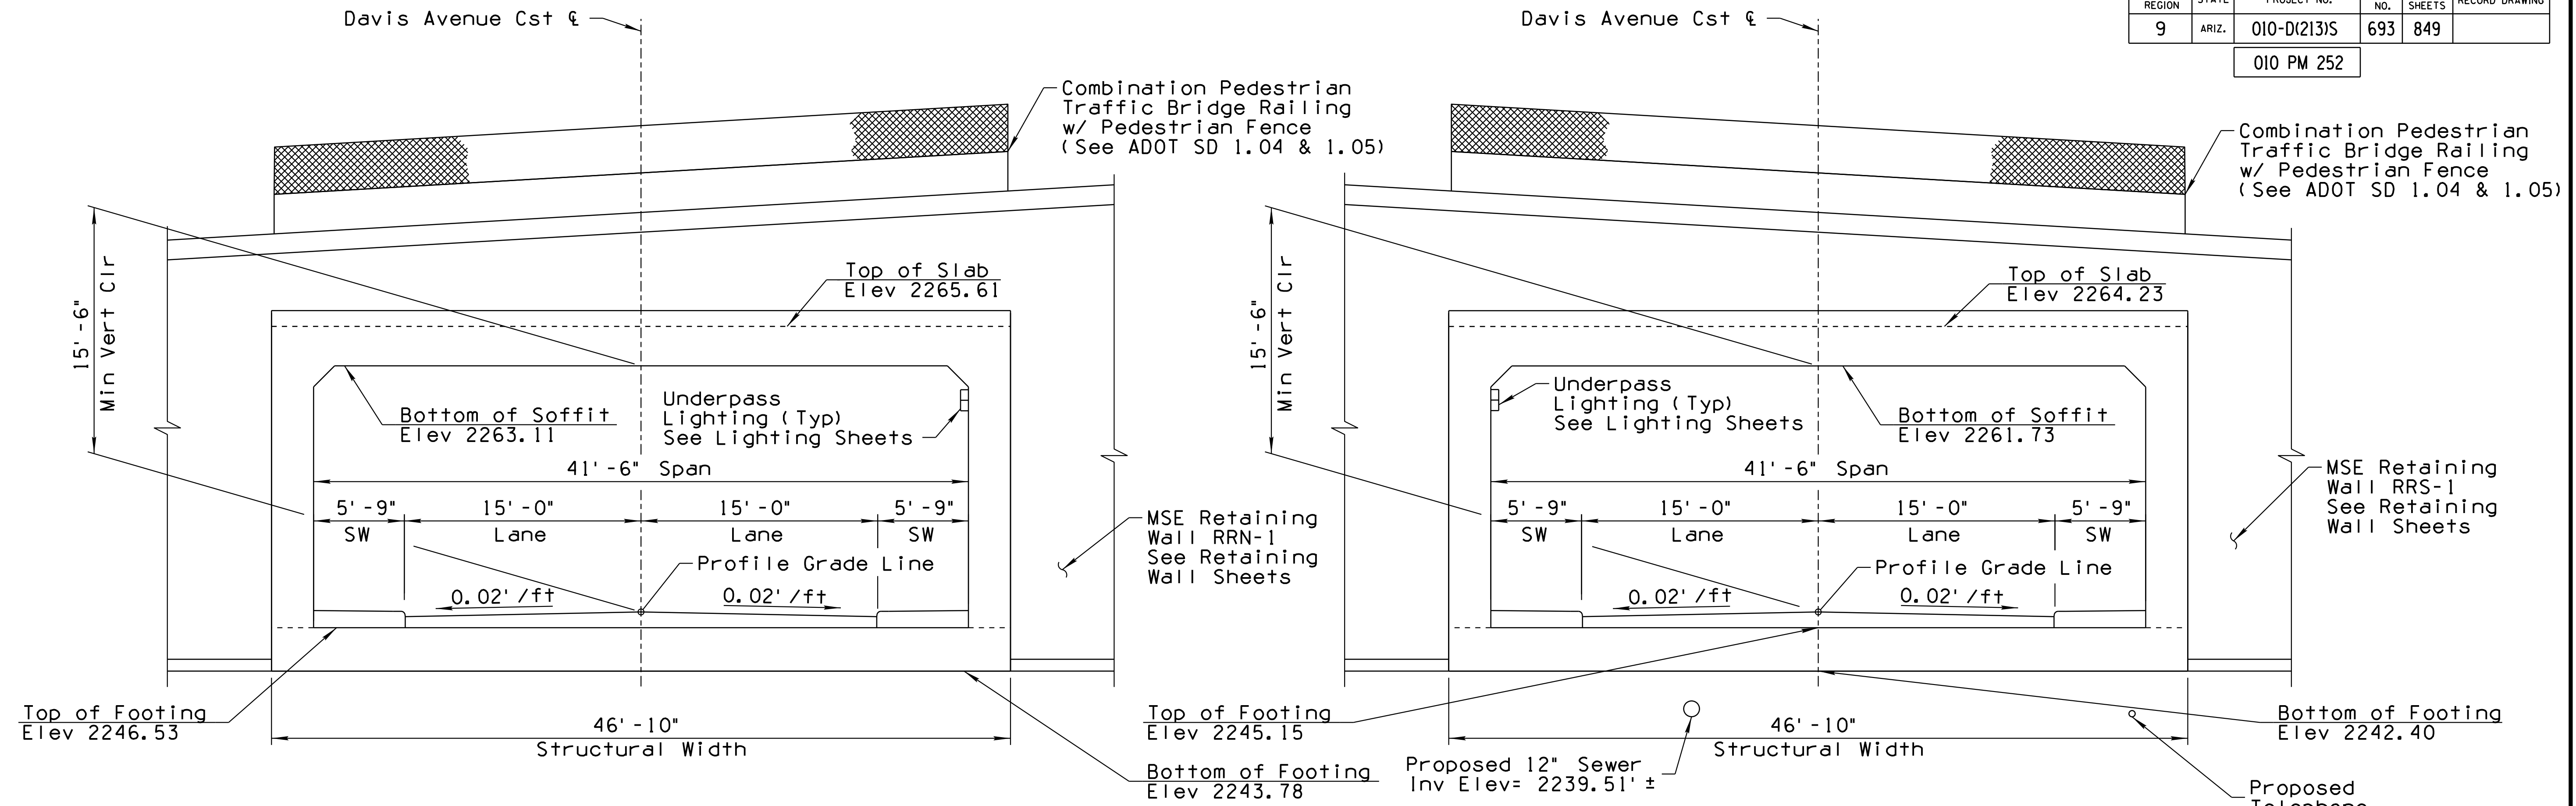


ELEVATION - NORTH PORTAL  
No Scale

ELEVATION - SOUTH PORTAL  
No Scale

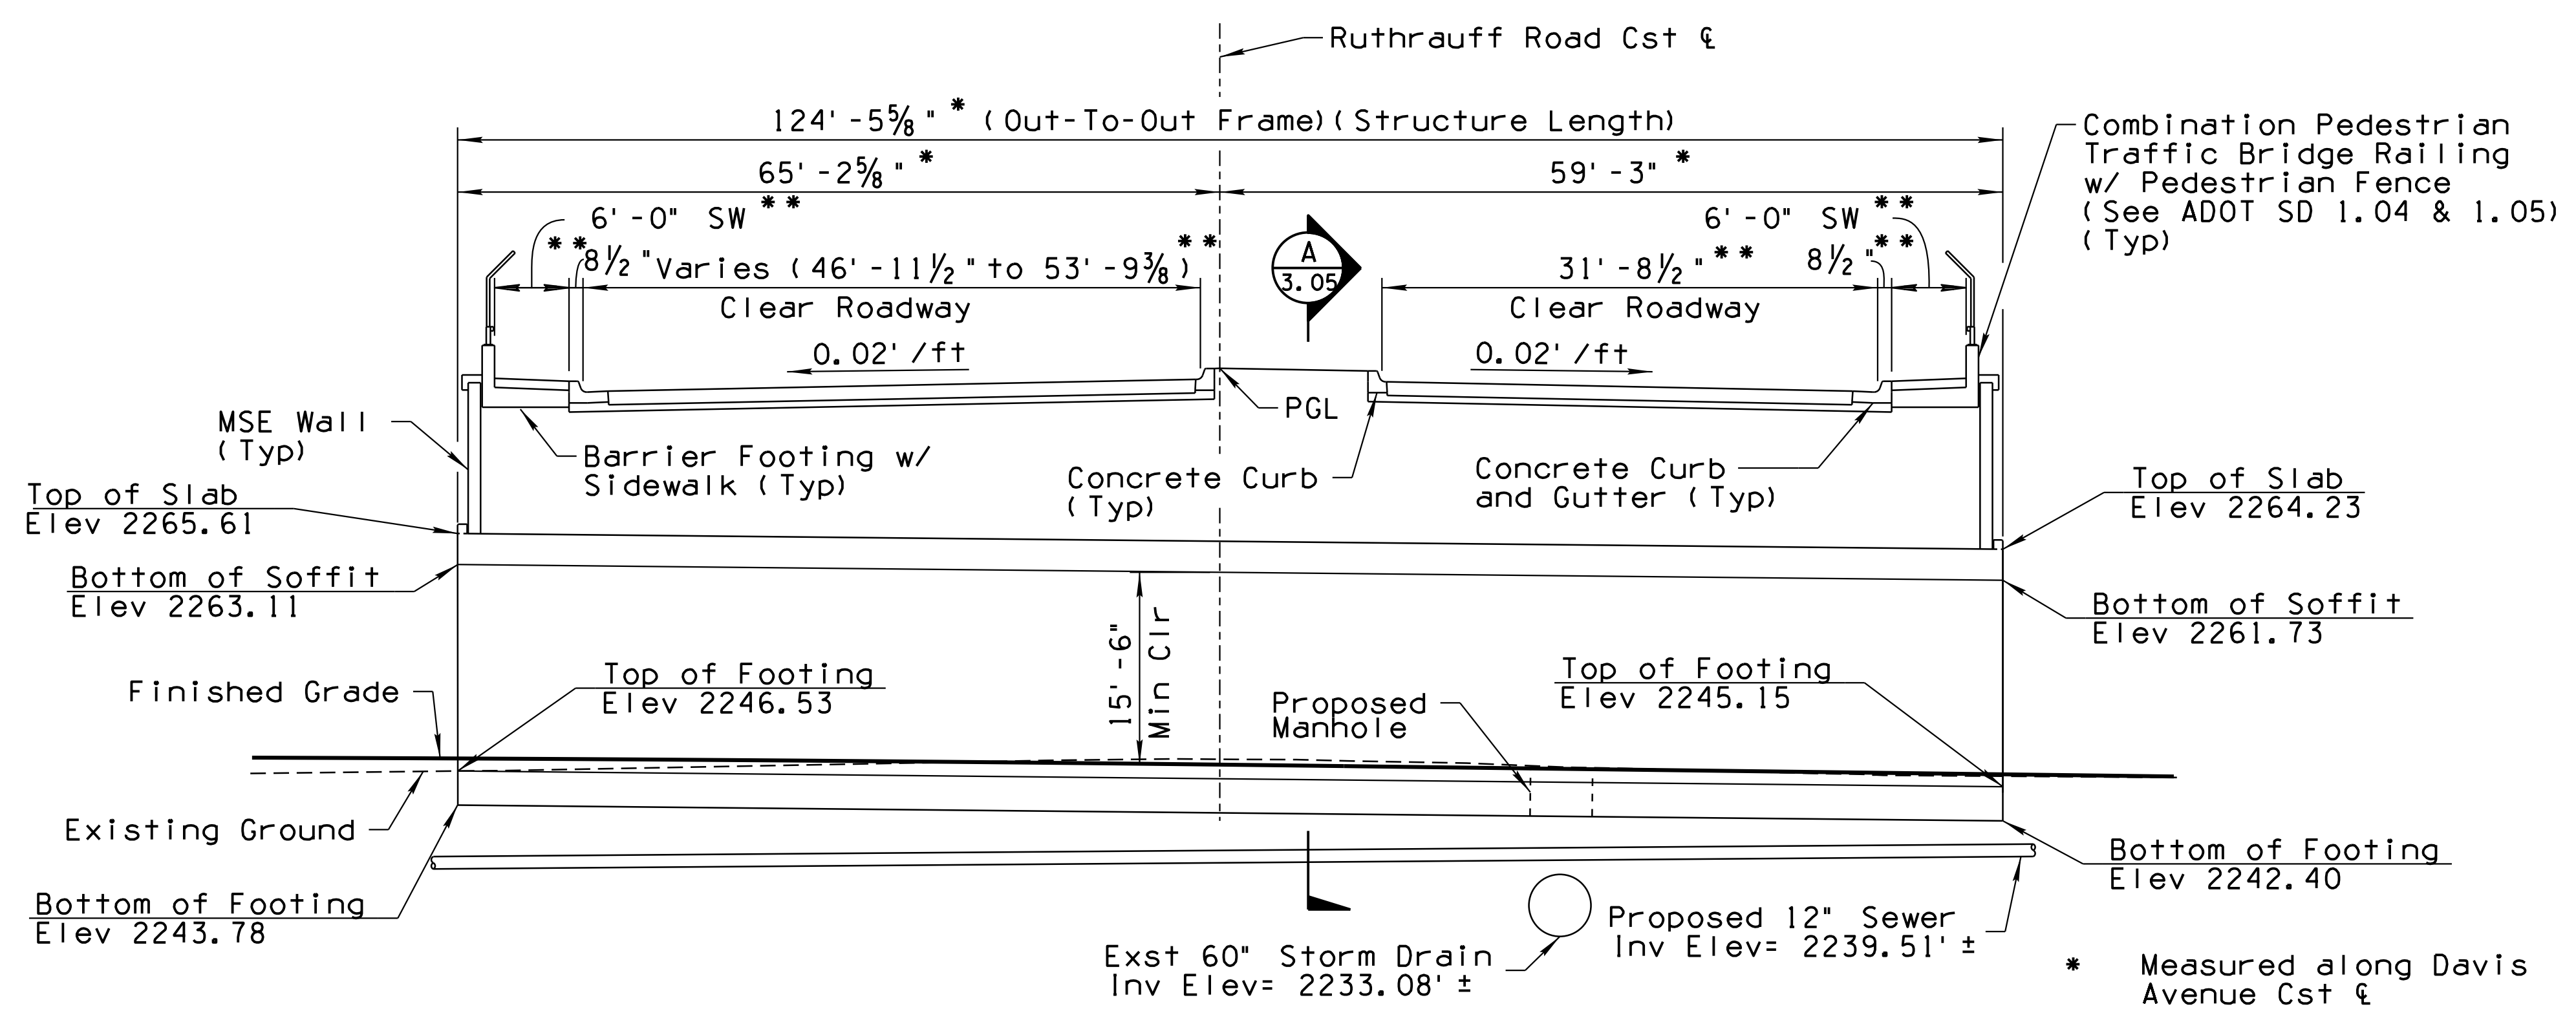


TYPICAL SECTION ALONG DAVIS AVENUE CONSTRUCTION &  
Scale: 1" = 10'

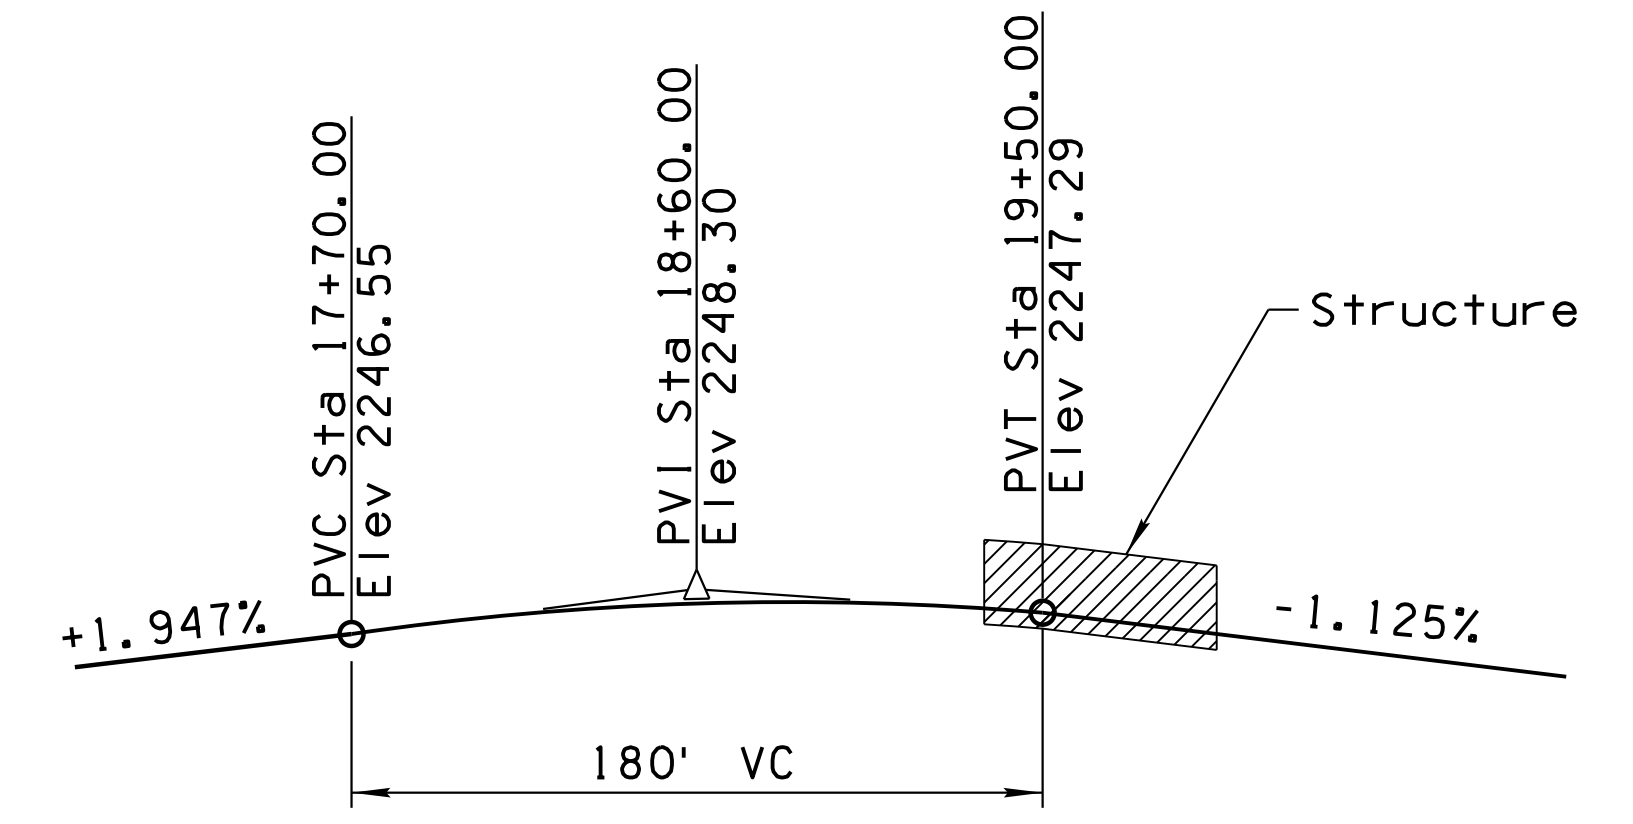

DAVIS AVENUE CST & PROFILE GRADE LINE  
No Scale

DESIGN	CR	DATE	3-19	ARIZONA DEPARTMENT OF TRANSPORTATION INFRASTRUCTURE DELIVERY AND OPERATIONS DIVISION BRIDGE GROUP
DRAWN	DAY	DATE	3-19	
CHECKED	JAC	DATE	3-19	
WSP		WSP USA Inc. 177 N. Church Avenue Suite 1105 Tucson, AZ 85701		STA 20+ DAVIS AVENUE FRAME ELEVATIONS AND TYPICAL SECTION LOCATION DAVIS AVENUE
I-10	252.00	11551	STRUCTURE NO.	
TRACS NO. H 8480 OIC			010-D(213)S	DWG NO. S-3.02 OF

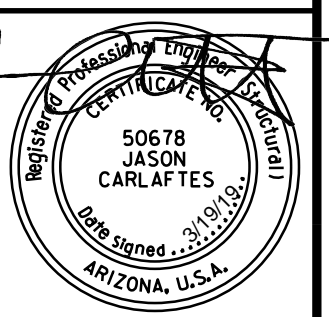

DATE- LOCATION- REVISIONS- FINISHED PLANS- SURVEY NO. DATE- LOCATION- REVISIONS- FINISHED PLANS- SURVEY NO.

**GENERAL NOTES:**

Construction Specification

Arizona Department of Transportation Standard Specifications for Road and Bridge Construction, Edition of 2008 and Special Provisions.

Design Specifications

AASHTO LRFD Bridge Design Specifications, 7th Edition 2014, with 2015 and 2016 Interim Revisions.

Dead Load

Dead Loads are per AASHTO Table 3.5.1-1, Except as noted.

Live Load

Loading Class - HL - 93

Earth Load

Parameters are based on the Final Geotechnical Report by NCS Consultants, Inc. Dated March 31, 2015.

Soil Density = 0.130 kcf

Active Earth Pressure 0.035 kcf

At Rest Earth Pressure 0.055 kcf

Passive Earth Pressure 0.200 kcf

Maximum Factored Bearing Resistance (Strength Limit) = 3.0 ksf

Seismic

Bridge Site is classified as Seismic Zone 1, Site Class D with Peak Ground Acceleration (PGA)  $A_s = 0.120g$  and Spectral Acceleration at 0.2 sec.  $S_{0.2} = 0.278g$  and at 1.0 sec.  $S_{1.0} = 0.118g$  as modified by the appropriate Site Factors.

Inventory and Operating

Ratings for HL-93 and HS-20 are in accordance with the AASHTO Manual for Bridge Evaluation, 2nd Edition with Interim Revisions through 2016 and in accordance with the Load and Resistance Factor Rating (LRFR) method and the Load Factor Resistance (LFR) method.

Inventory Load Rating: 2.66 (LFR) 1.60 (LRFR)

Operating Load Rating: 4.45 (LFR) 2.00 (LRFR)

Concrete

All concrete shall be Class "S" unless noted otherwise.

Reinforcing Steel

Reinforcing steel shall conform to ASTM Specification A615 (AASHTO M31). All reinforcing shall be furnished as Grade 60.

All bends and hooks shall meet the requirements of AASHTO Article 5.10.2 unless noted otherwise. All bend dimensions for reinforcing steel shall be out-to-out of bars. All placement dimensions for reinforcing steel shall be to center of bars unless noted otherwise.

All reinforcing steel shall have 2" clear cover unless noted otherwise.

All mechanical splices shall conform to the requirements for mechanical connections in Section 605-3.02 of the Specifications.

**GENERAL NOTES (CONT'D):**

Material Strengths

Walls, Top Slab and Bottom Slab . . . . . f'c = 3.5 ksi  
 Other Class "S" Concrete . . . . . f'c = 3.5 ksi  
 Grade 60 reinforcement . . . . . fy = 60.0 ksi

Chamfer

Chamfer all exposed corners  $\frac{3}{4}$ " unless noted otherwise.

Dimensions

Dimensions shall not be scaled from the drawings.

Rustication and Paint

Bridge shall be rusticated and painted in accordance with the Architectural Drawings and Specifications.

Electrical

Lighting and ITS conduit and fixture mounting details and locations shall be in accordance with the Lighting and ITS Sheets.


Standard List

ADOT Bridge Group Structure Detail (SD)



Drawings: 1.01, 1.04, 1.05, 5.01 & 5.02

**LEGEND:**

DETAIL Marker

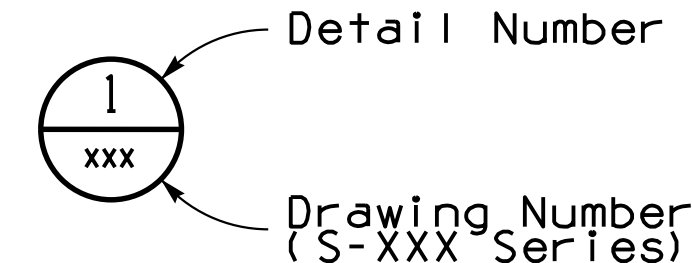

SECTION Marker

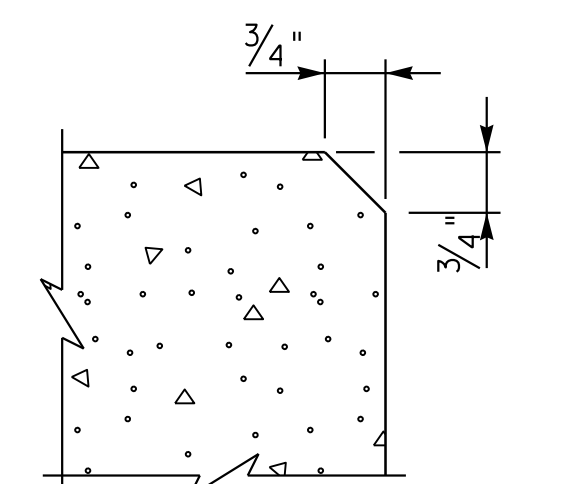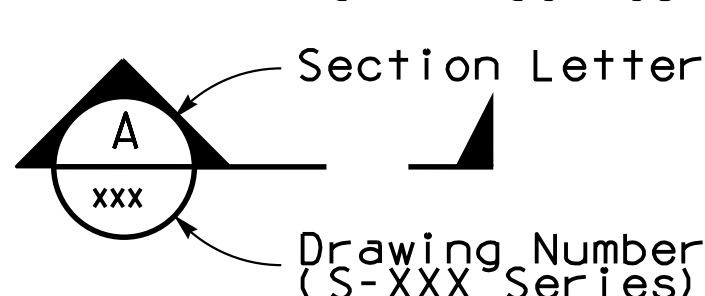

CHAMFER DETAIL 1  
No Scale


DAVIS AVENUE FRAME APPROXIMATE QUANTITIES				
ITEM	STRUCT EX	STRUCT BACKFILL	CLASS "S" CONCRETE	REINFORCING STEEL
			f'c=3,500psi	
UNIT	CY	CY	CY	LB
Total	885	740	1596	448,525
As-Built Total				

The cost of Overexcavation is considered included with the cost of the Structural Excavation work and will not be paid for separately.  
 Estimated Quantity of Overexcavation is 945 CY.


The cost of Damproofing and Waterproofing is included in the cost of the Concrete and will not be paid for separately.  
 Estimated Quantity of Damproofing is 5435 sf.  
 Estimated Quantity of Waterproofing is 5830 sf.

F.H.W.A. REGION	STATE	PROJECT NO.	SHEET NO.	TOTAL SHEETS	RECORD DRAWING
9	ARIZ.	010-D(213)S	694	849	

010 PM 252

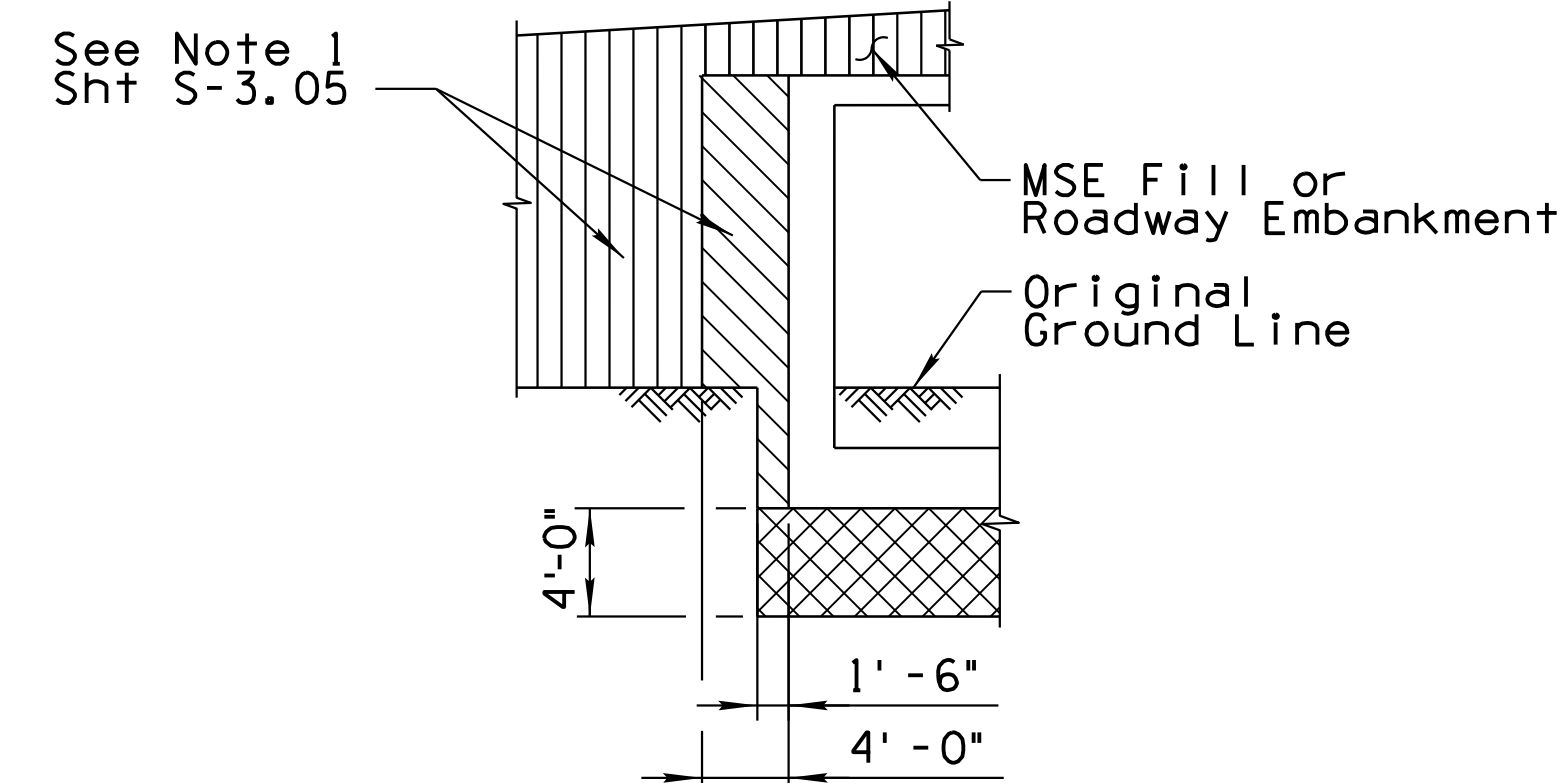

STRUCTURE BACKFILL PAYMENT LIMITS

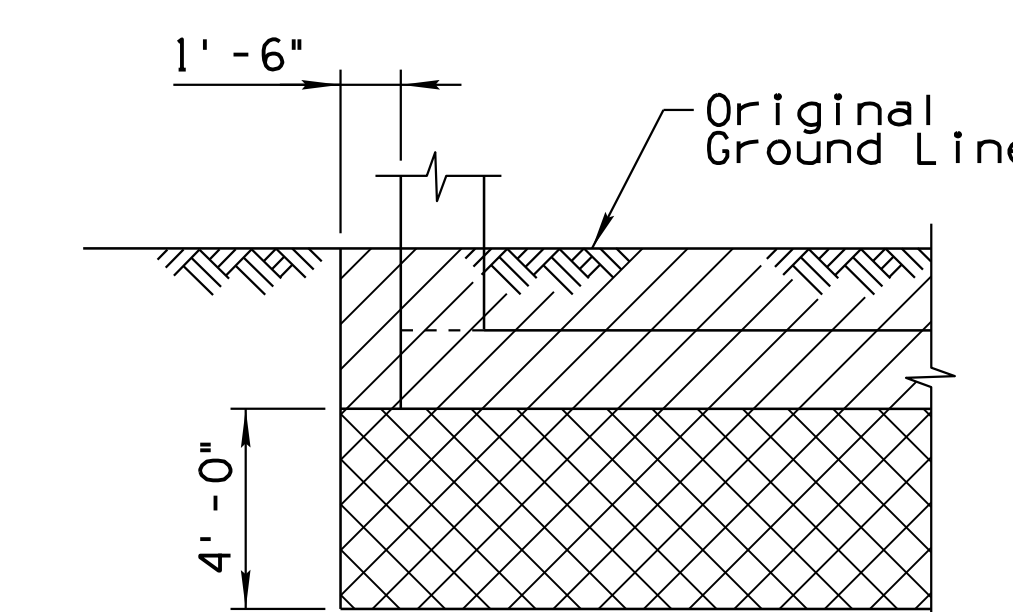

STRUCTURAL EXCAVATION PAYMENT LIMITS

**LEGEND**

- Limits of Structural Excavation
- Indicates Over Excavation for Engineered Fill See Sheet S-3.04 for Detail
- Limits of Structure Backfill
- Indicates MSE or Roadway Embankment Fill

**NOTES:**




1. Cost of temporary shoring is incidental to cost of Frame Structure contract items.
2. See Construction Phasing Details for limits of phased bridge construction.

DESIGN	CR	DATE	3-19	ARIZONA DEPARTMENT OF TRANSPORTATION INFRASTRUCTURE DELIVERY AND OPERATIONS DIVISION <b>BRIDGE GROUP</b>	
DRAWN	DAY	DATE	3-19		
CHECKED	JAC	DATE	3-19		
		WSP USA Inc. 177 N. Church Avenue Suite 1105 Tucson, AZ 85701		<b>STA 20+ DAVIS AVENUE FRAME GENERAL NOTES &amp; QUANTITIES</b>	
I-10 ROUTE	252.00 MILEPOST	11551 STRUCTURE NO.	LOCATION	DAVIS AVENUE	DWG NO. S-3.03
TRACS NO. H 8480 OIC			010-D(213)S		OF



F.H.W.A. REGION	STATE	PROJECT NO.	SHEET NO.	TOTAL SHEETS	RECORD DRAWING
9	ARIZ.	010-D(213)S	695	849	

010 PM 252

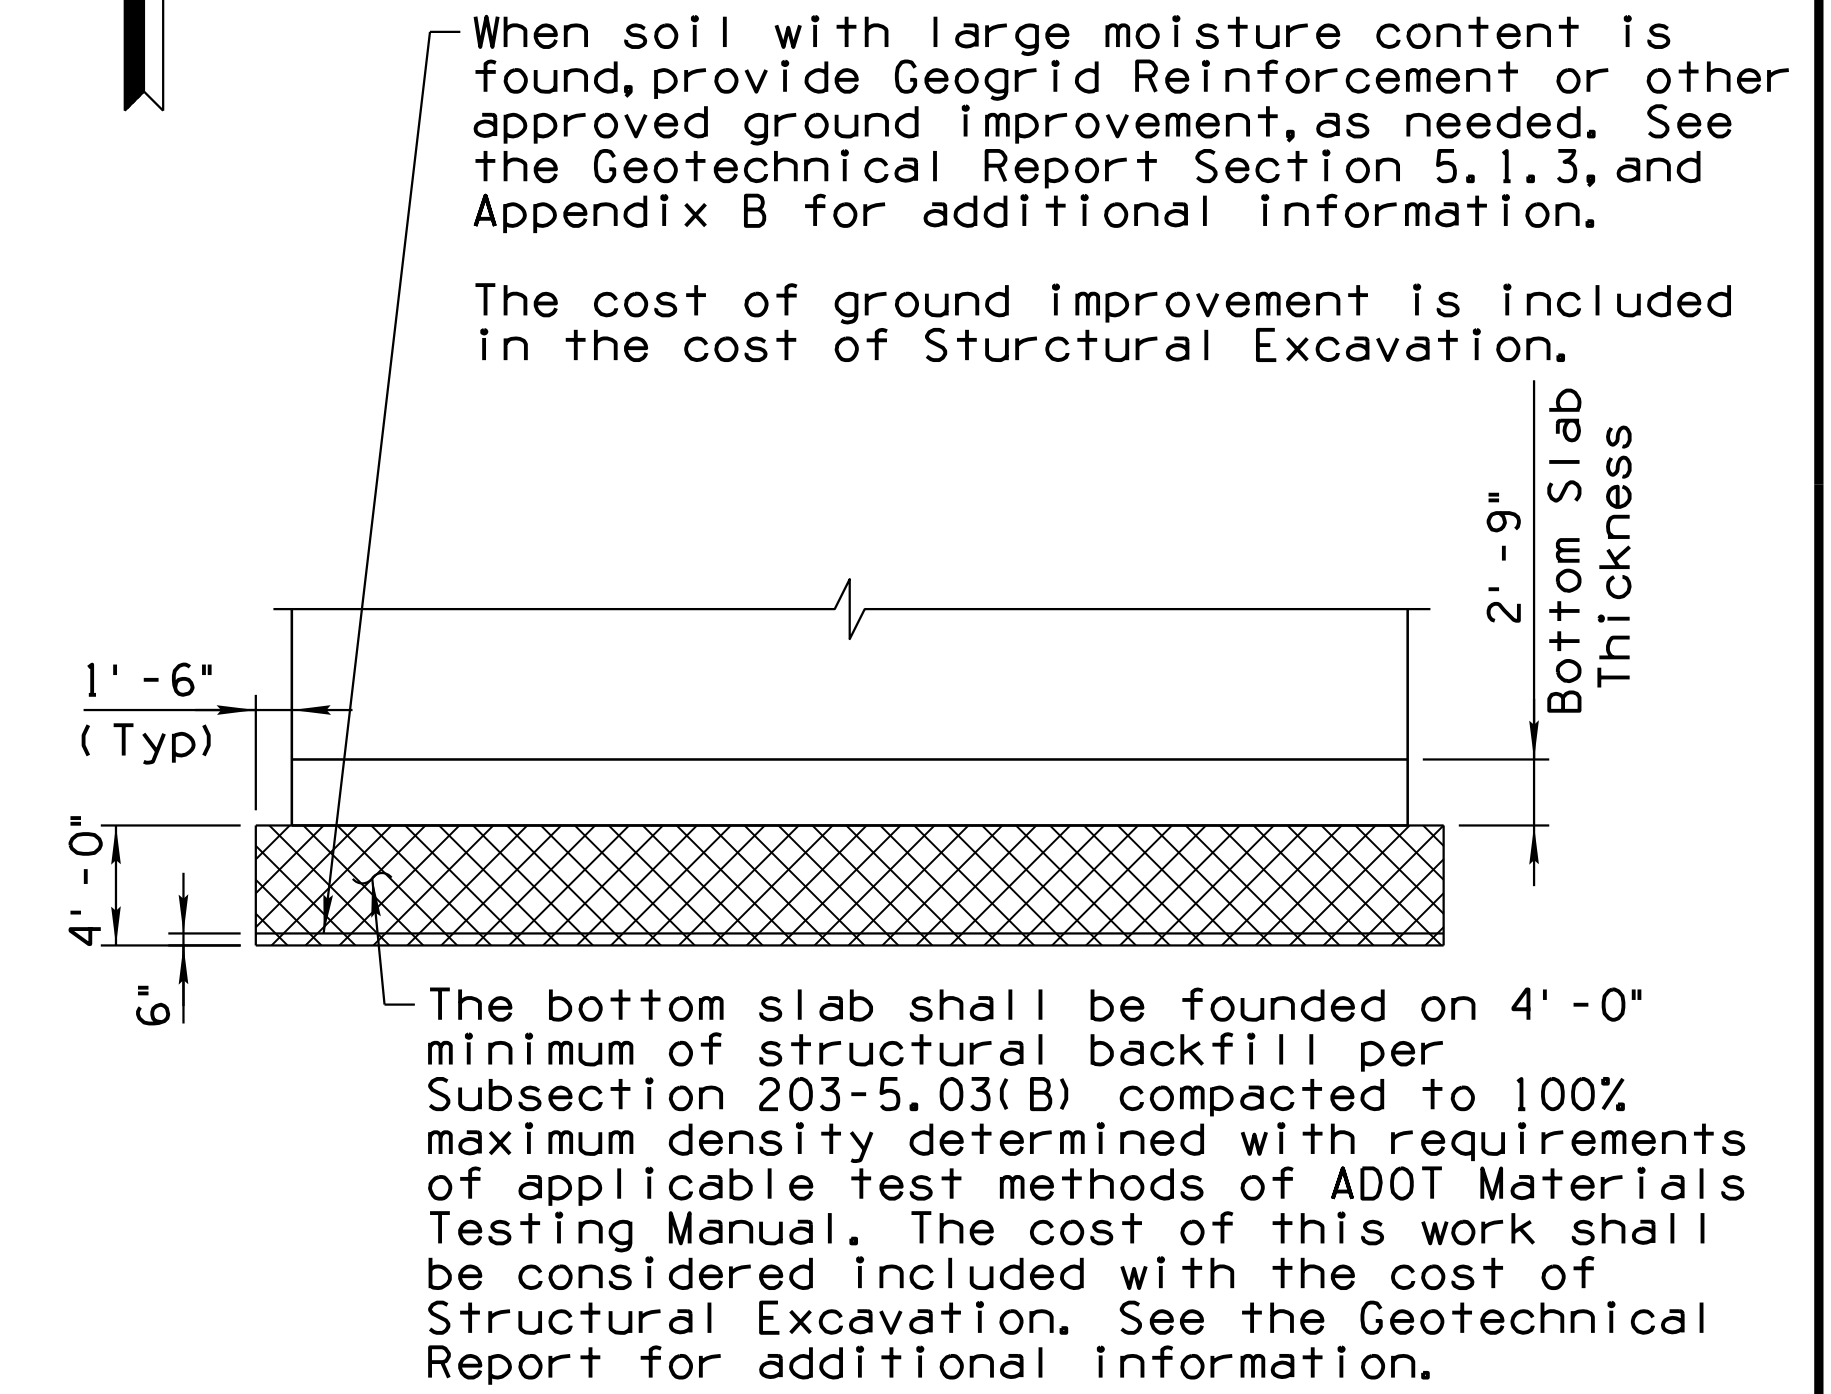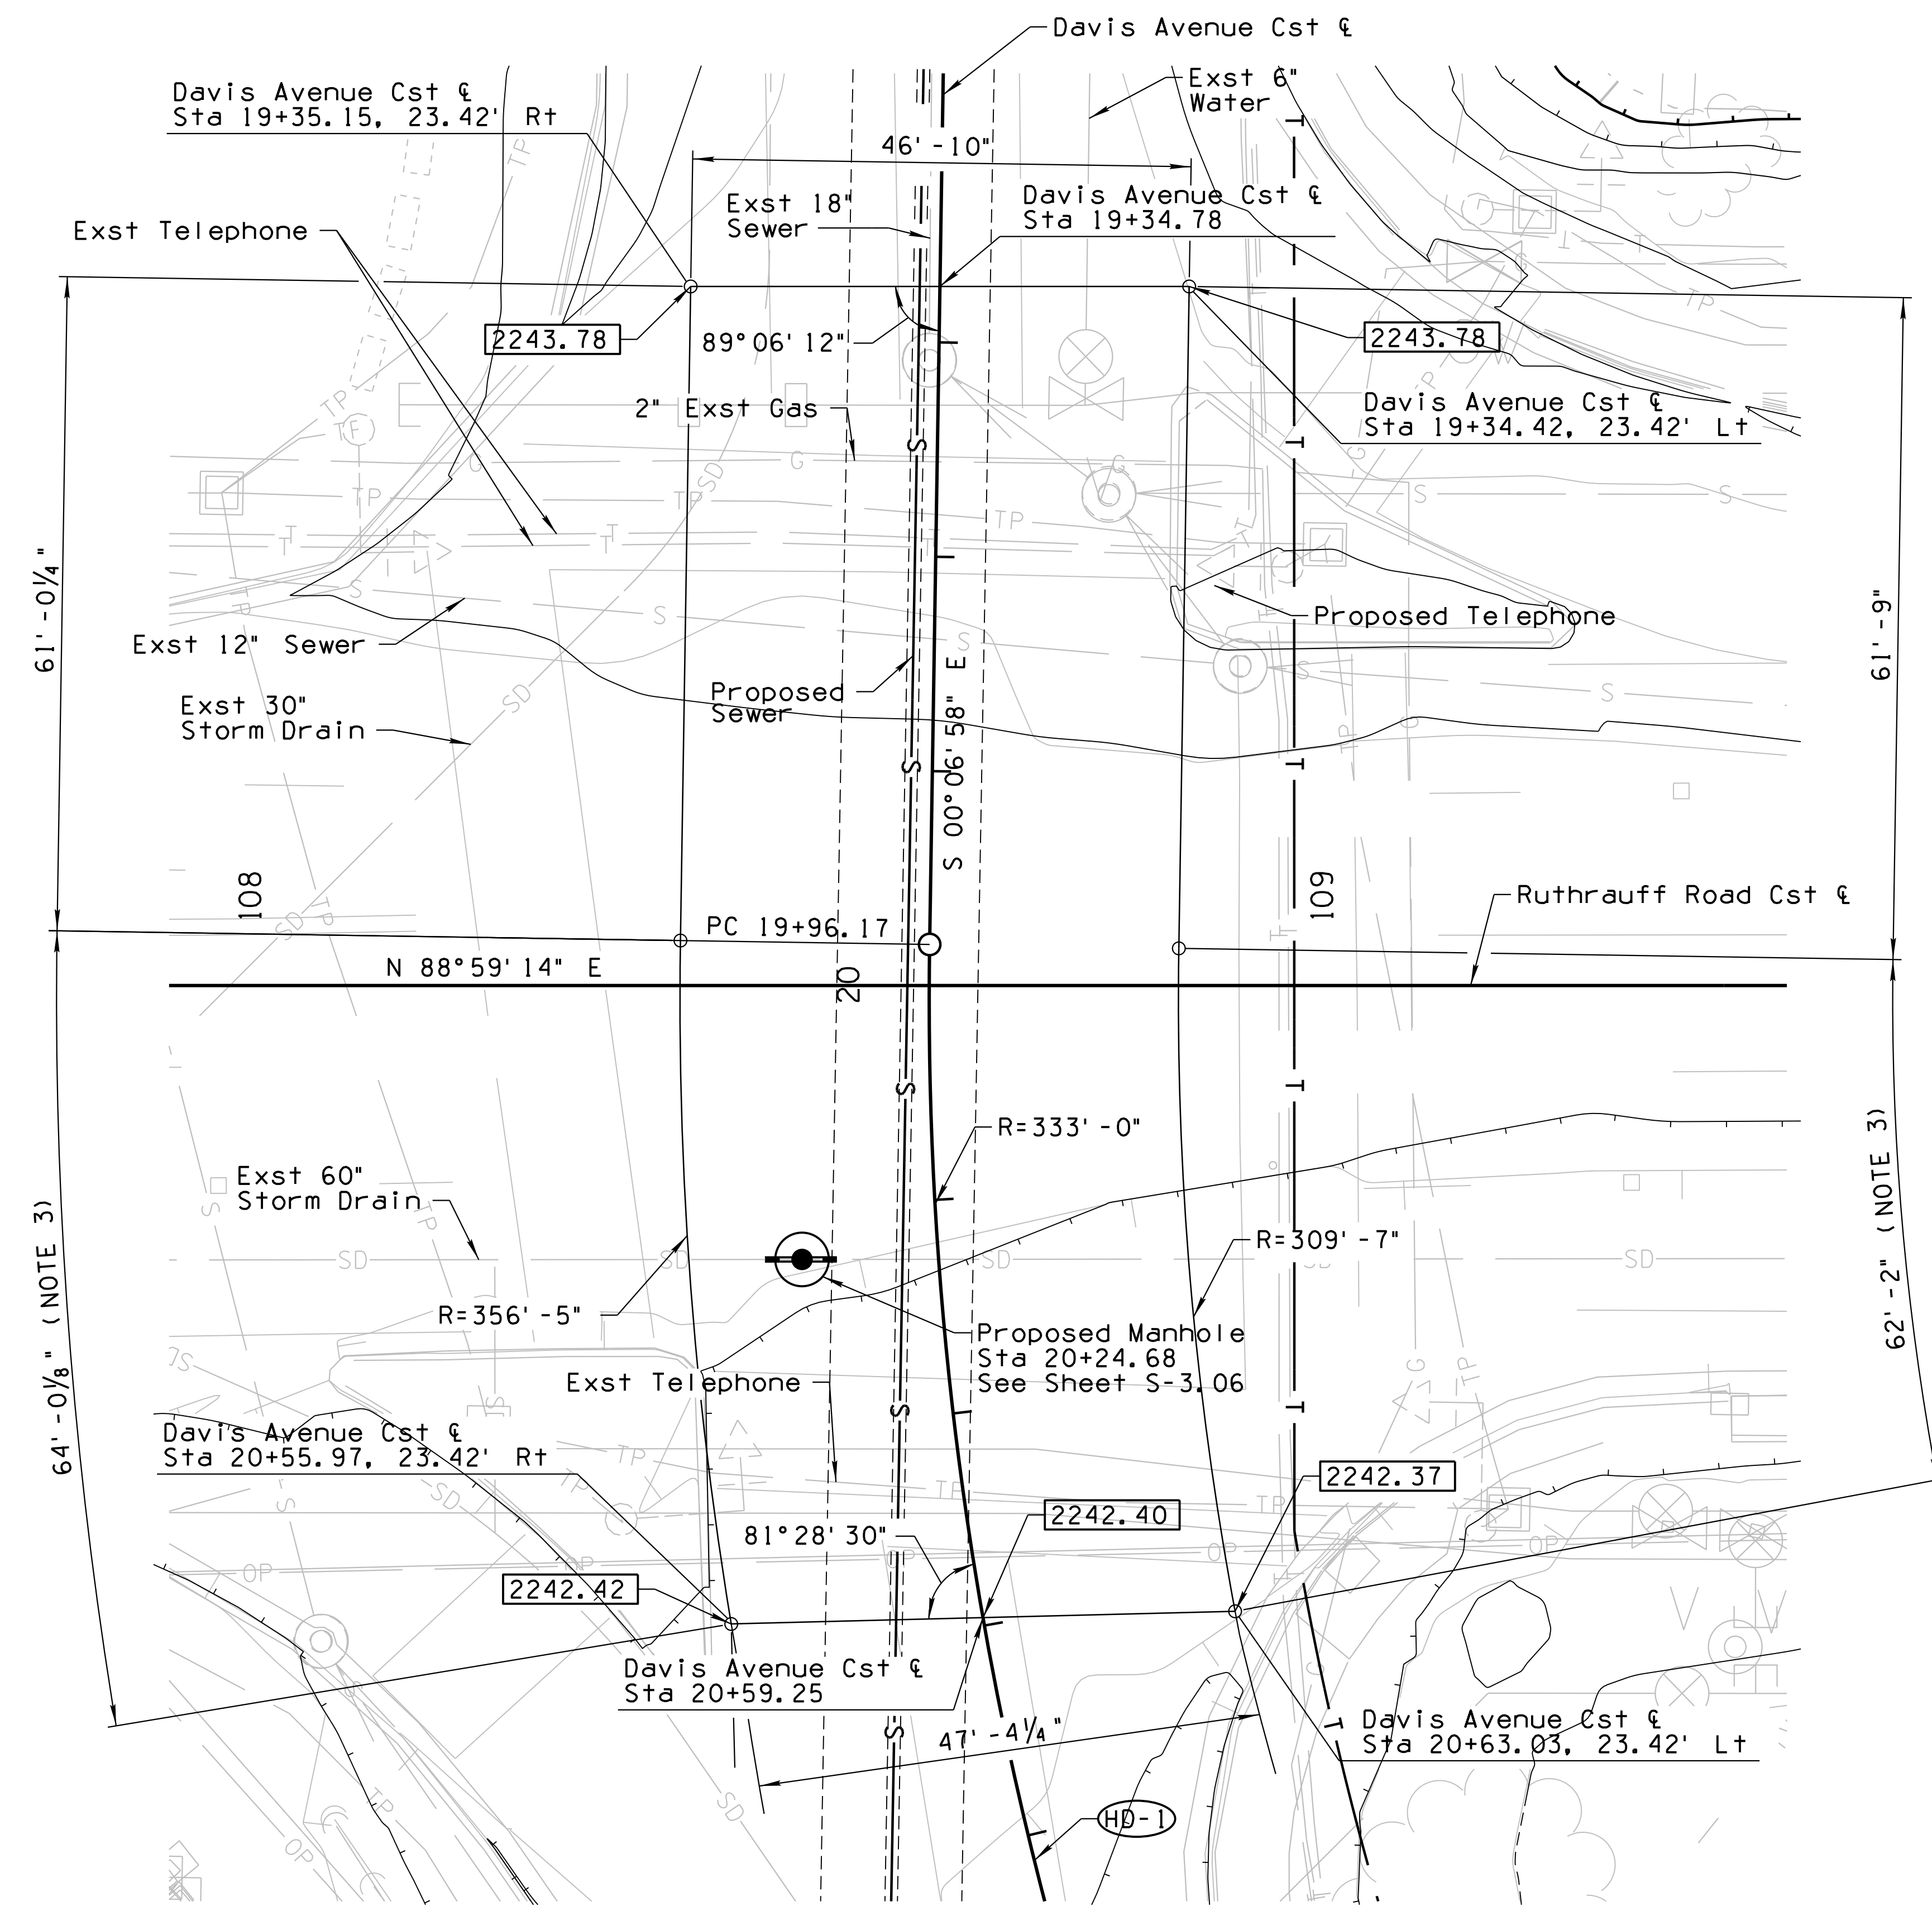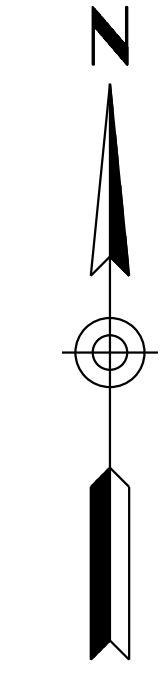

OVER EXCAVATION AND ENGINEERED FILL DETAIL  
No Scale

NOTES:

1. The location of all Utilities is approximate and reflects findings from survey and substructure utility exploration. Contractor is responsible for field verification prior to construction.
2. XXXX.XX indicates bottom of footing elevation.
3. Length is measured along the curve.


FOUNDATION PLAN  
1' Contour Interval  
Scale: 1"=10'

DESIGN	NAME	DATE	ARIZONA DEPARTMENT OF TRANSPORTATION INFRASTRUCTURE DELIVERY AND OPERATIONS DIVISION BRIDGE GROUP		
DRAWN	CER	3-19			
CHECKED	JAC	3-19			
			<b>STA 20+ DAVIS AVENUE FRAME FOUNDATION PLAN</b>		
I-10	252.00	11551	LOCATION	DAVIS AVENUE	
TRACS NO. H 8480 OIC			010-D(213)S		
			DWG NO. S-3.04		
			OF		

DATE LOCATION REVISIONS FINISHED PLANS SURVEY NO. DATE LOCATION REVISIONS FINISHED PLANS SURVEY NO.

F.H.W.A. REGION	STATE	PROJECT NO.	SHEET NO.	TOTAL SHEETS	RECORD DRAWING
9	ARIZ.	010-D(213)S	696	849	


010 PM 252

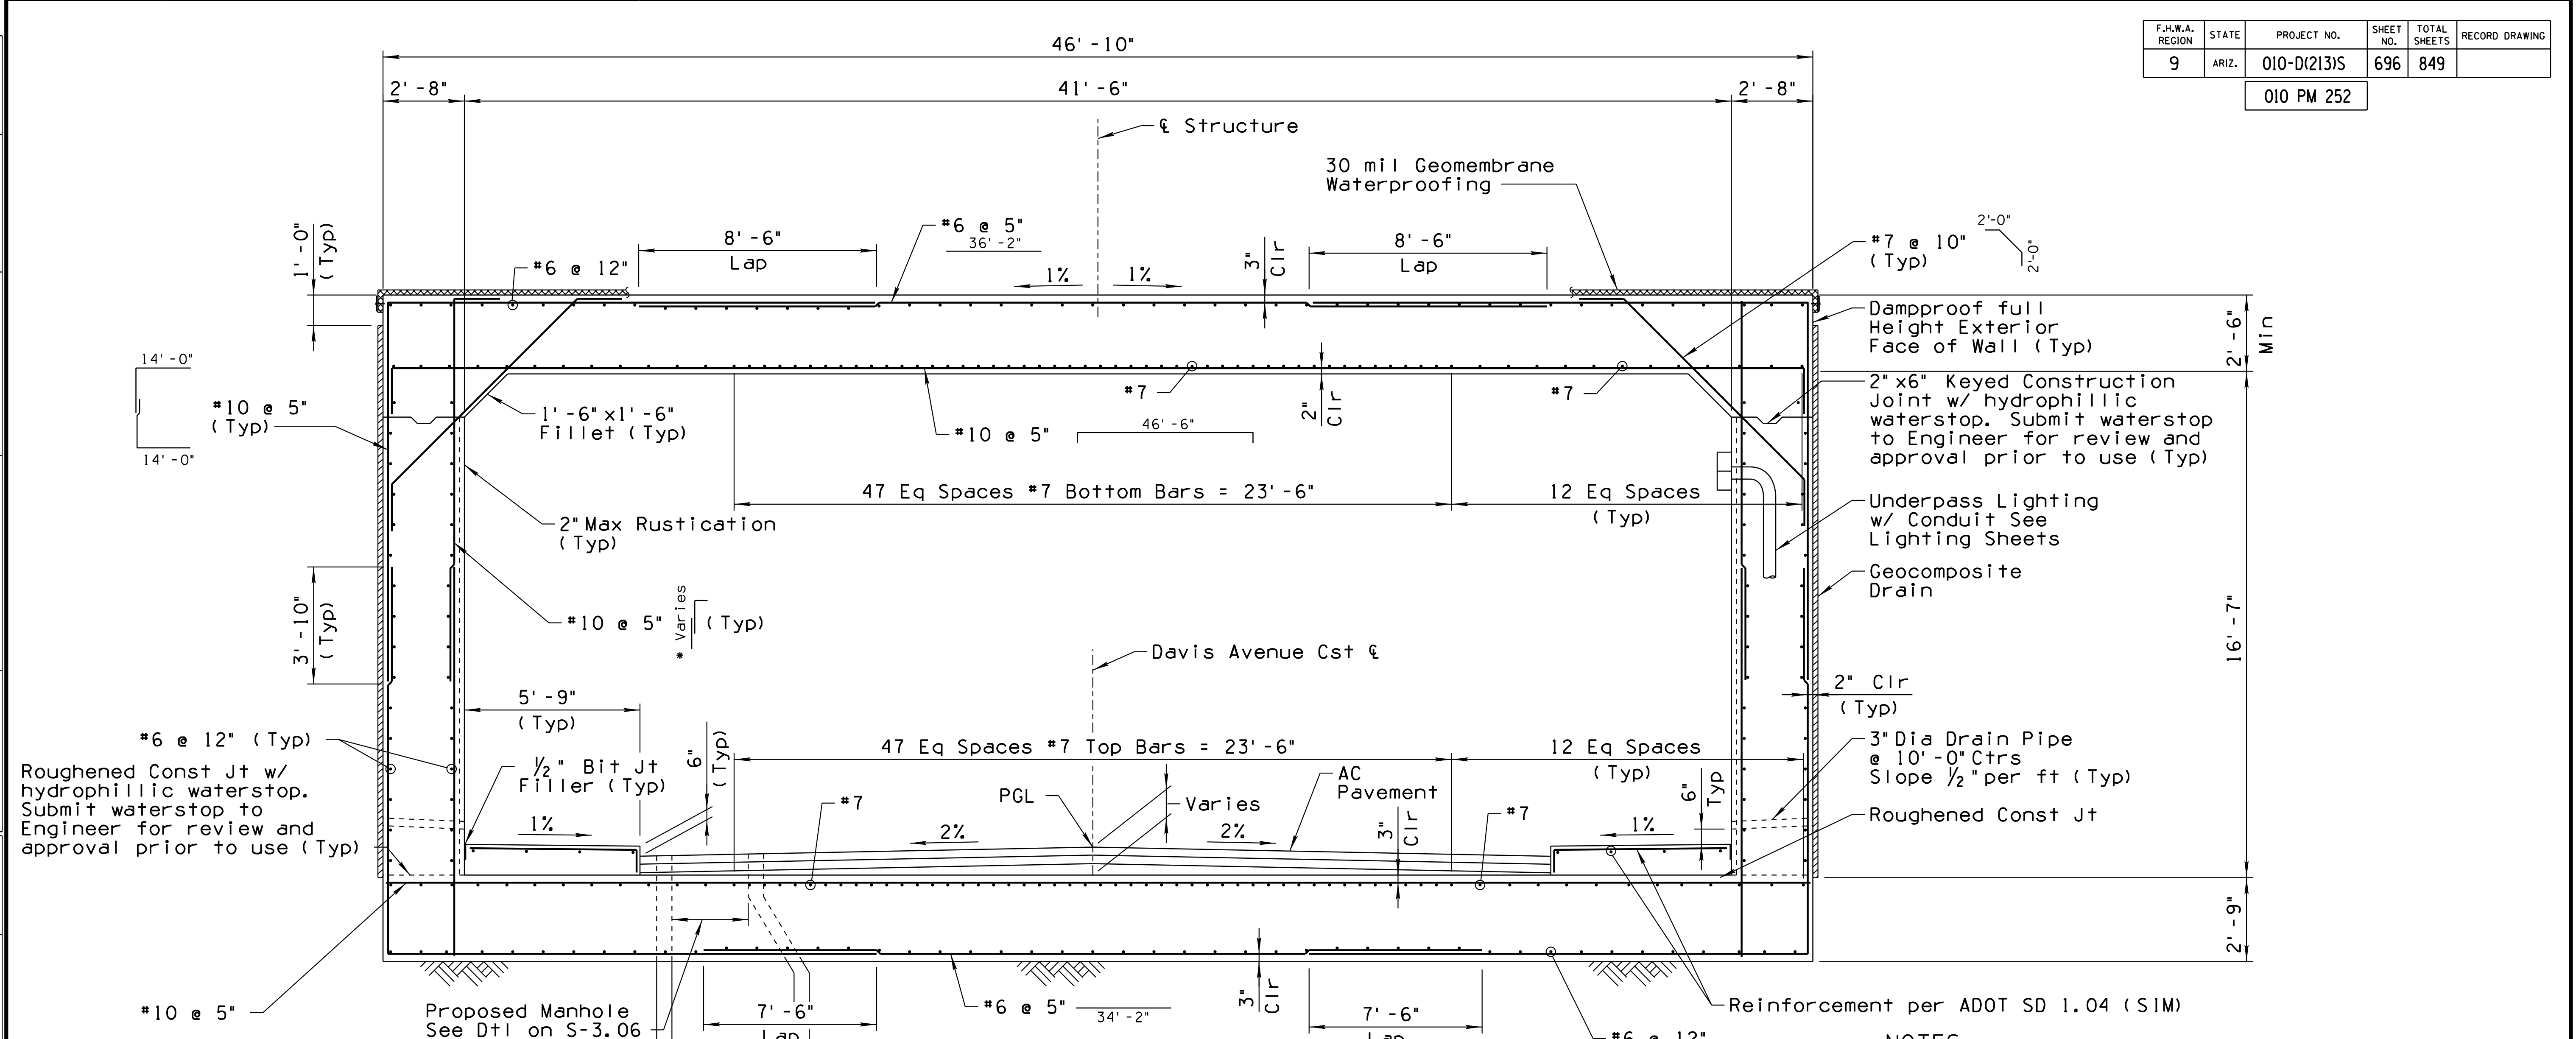


**TYPICAL SECTION A**  
Scale: 3/8" = 1'-0"

**NOTES:**

1. Backfill around box in a manner to minimize differences in fill height. The maximum difference between any two points, same and opposite side of box, is 16 inches. See the Geotechnical Report for additional requirements. Backfill shall not begin prior to top slab achieving 70% of the 28-day compressive strength.
2. Top Slab is Cambered. See Camber Diagram.
3. Dampproofing and geomembrane water proofing are considered incidental to the cost of the structure.
4. #6 bars shall be spliced 2'-3 min. as required. #7 bars shall be spliced 2'-10" min. as required. Adjacent bars shall not be spliced @ the same location and shall be staggered.
5. See Architectural Treatment Details for rustication/formliner information.

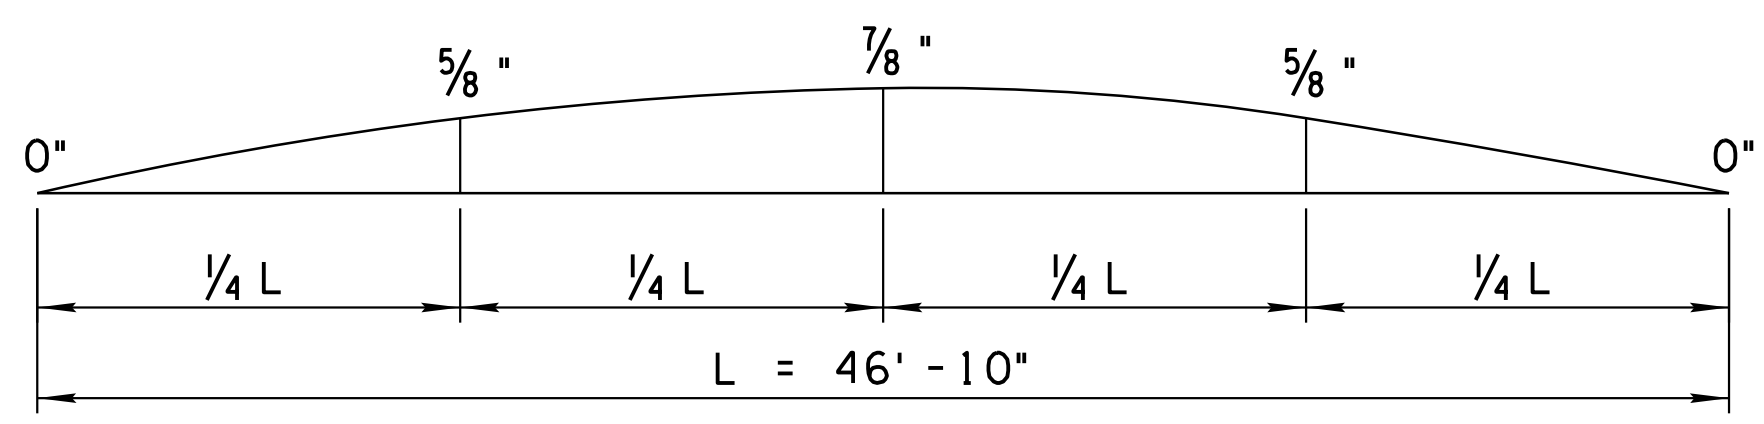

**DETAIL - TOP SLAB CAMBER DIAGRAM**  
No Scale

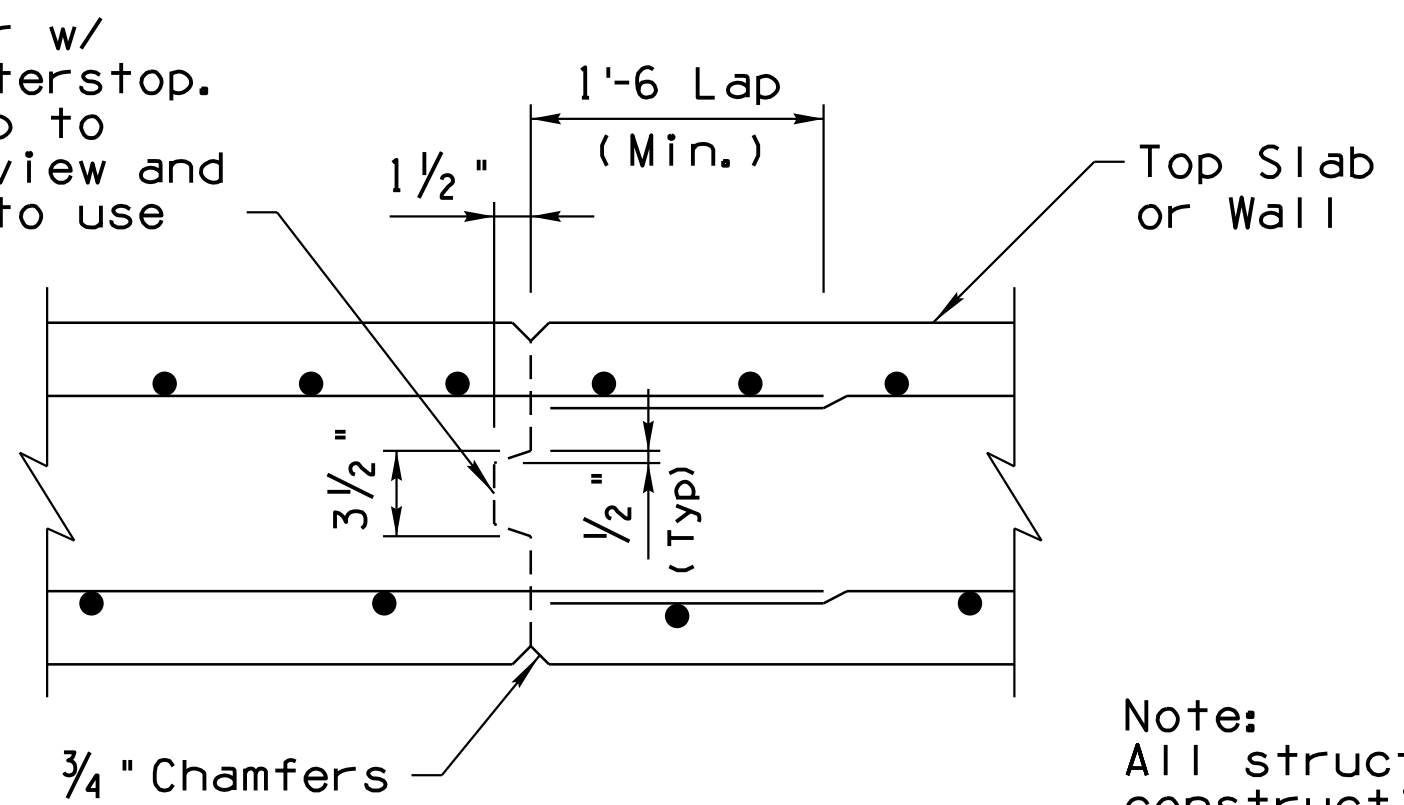


**DETAIL - CONSTRUCTION JOINT**  
No Scale

Note:  
All structures shall have formed construction joints in the top slab and walls (optional in floor slab) and spaced not more than 60'-0" apart. Joints shall be perpendicular to the centerline of the box.


DESIGN	CER	DATE	3-19	ARIZONA DEPARTMENT OF TRANSPORTATION INFRASTRUCTURE DELIVERY AND OPERATIONS DIVISION BRIDGE GROUP
DRAWN	DAY	DATE	3-19	
CHECKED	JAC	DATE	3-19	
<b>WSP</b> WSP USA Inc. 177 N. Church Avenue Suite 1105 Tucson, AZ 85701				STA 20+ DAVIS AVENUE FRAME FRAME DETAILS
I-10	252.00	11551	LOCATION	DAVIS AVENUE
TRACS NO. H 8480 OIC			010-D(213)S	
				DWG NO. S-3.05 OF

F.H.W.A. REGION	STATE	PROJECT NO.	SHEET NO.	TOTAL SHEETS	RECORD DRAWING
9	ARIZ.	010-D(213)S	697	849	

010 PM 252

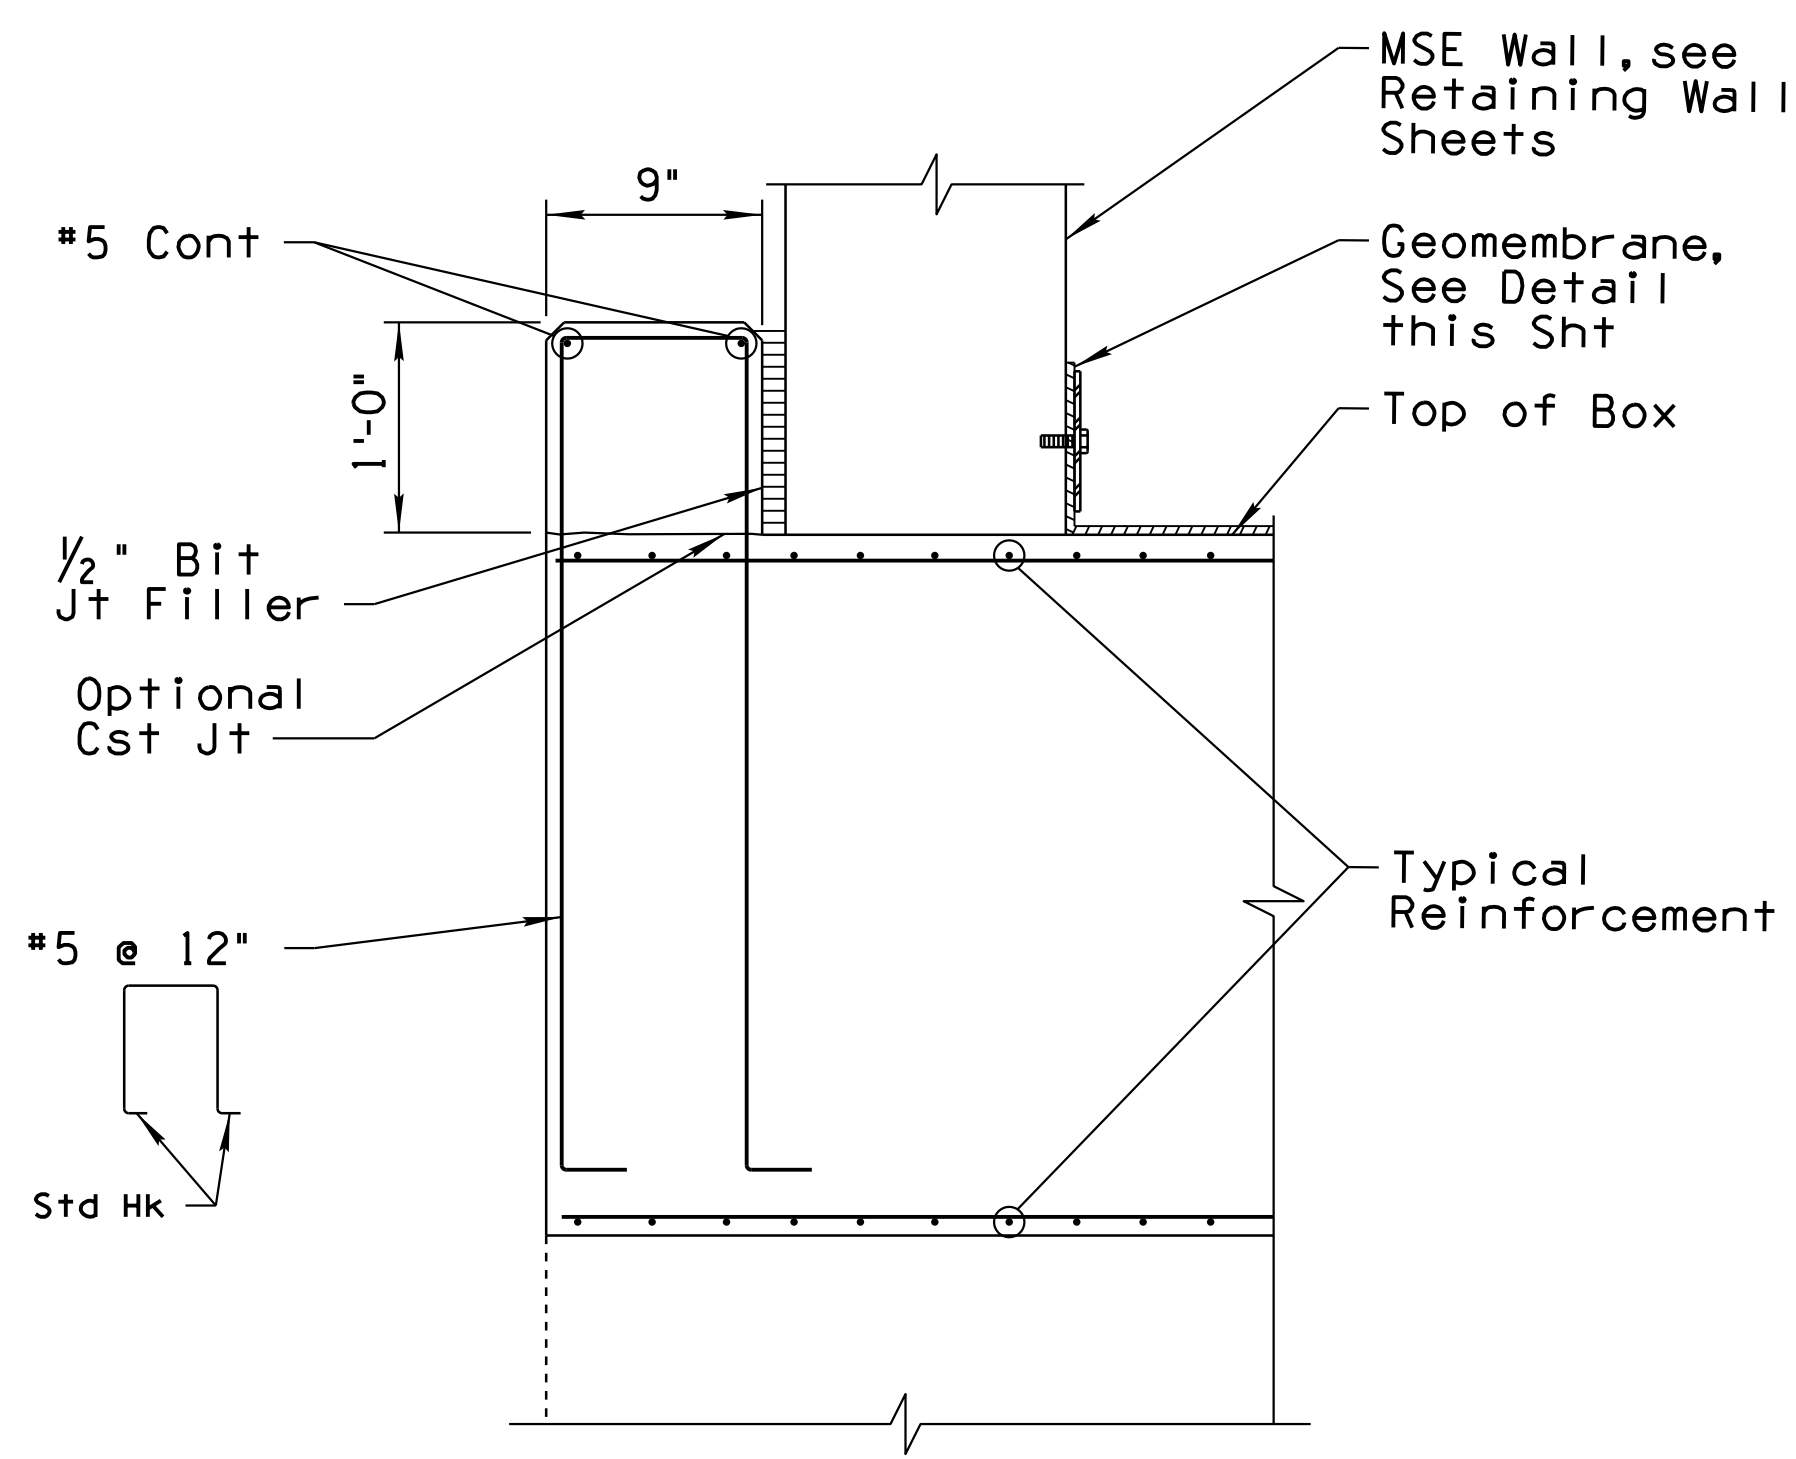


**DETAIL - PORTAL CURB**  
No Scale

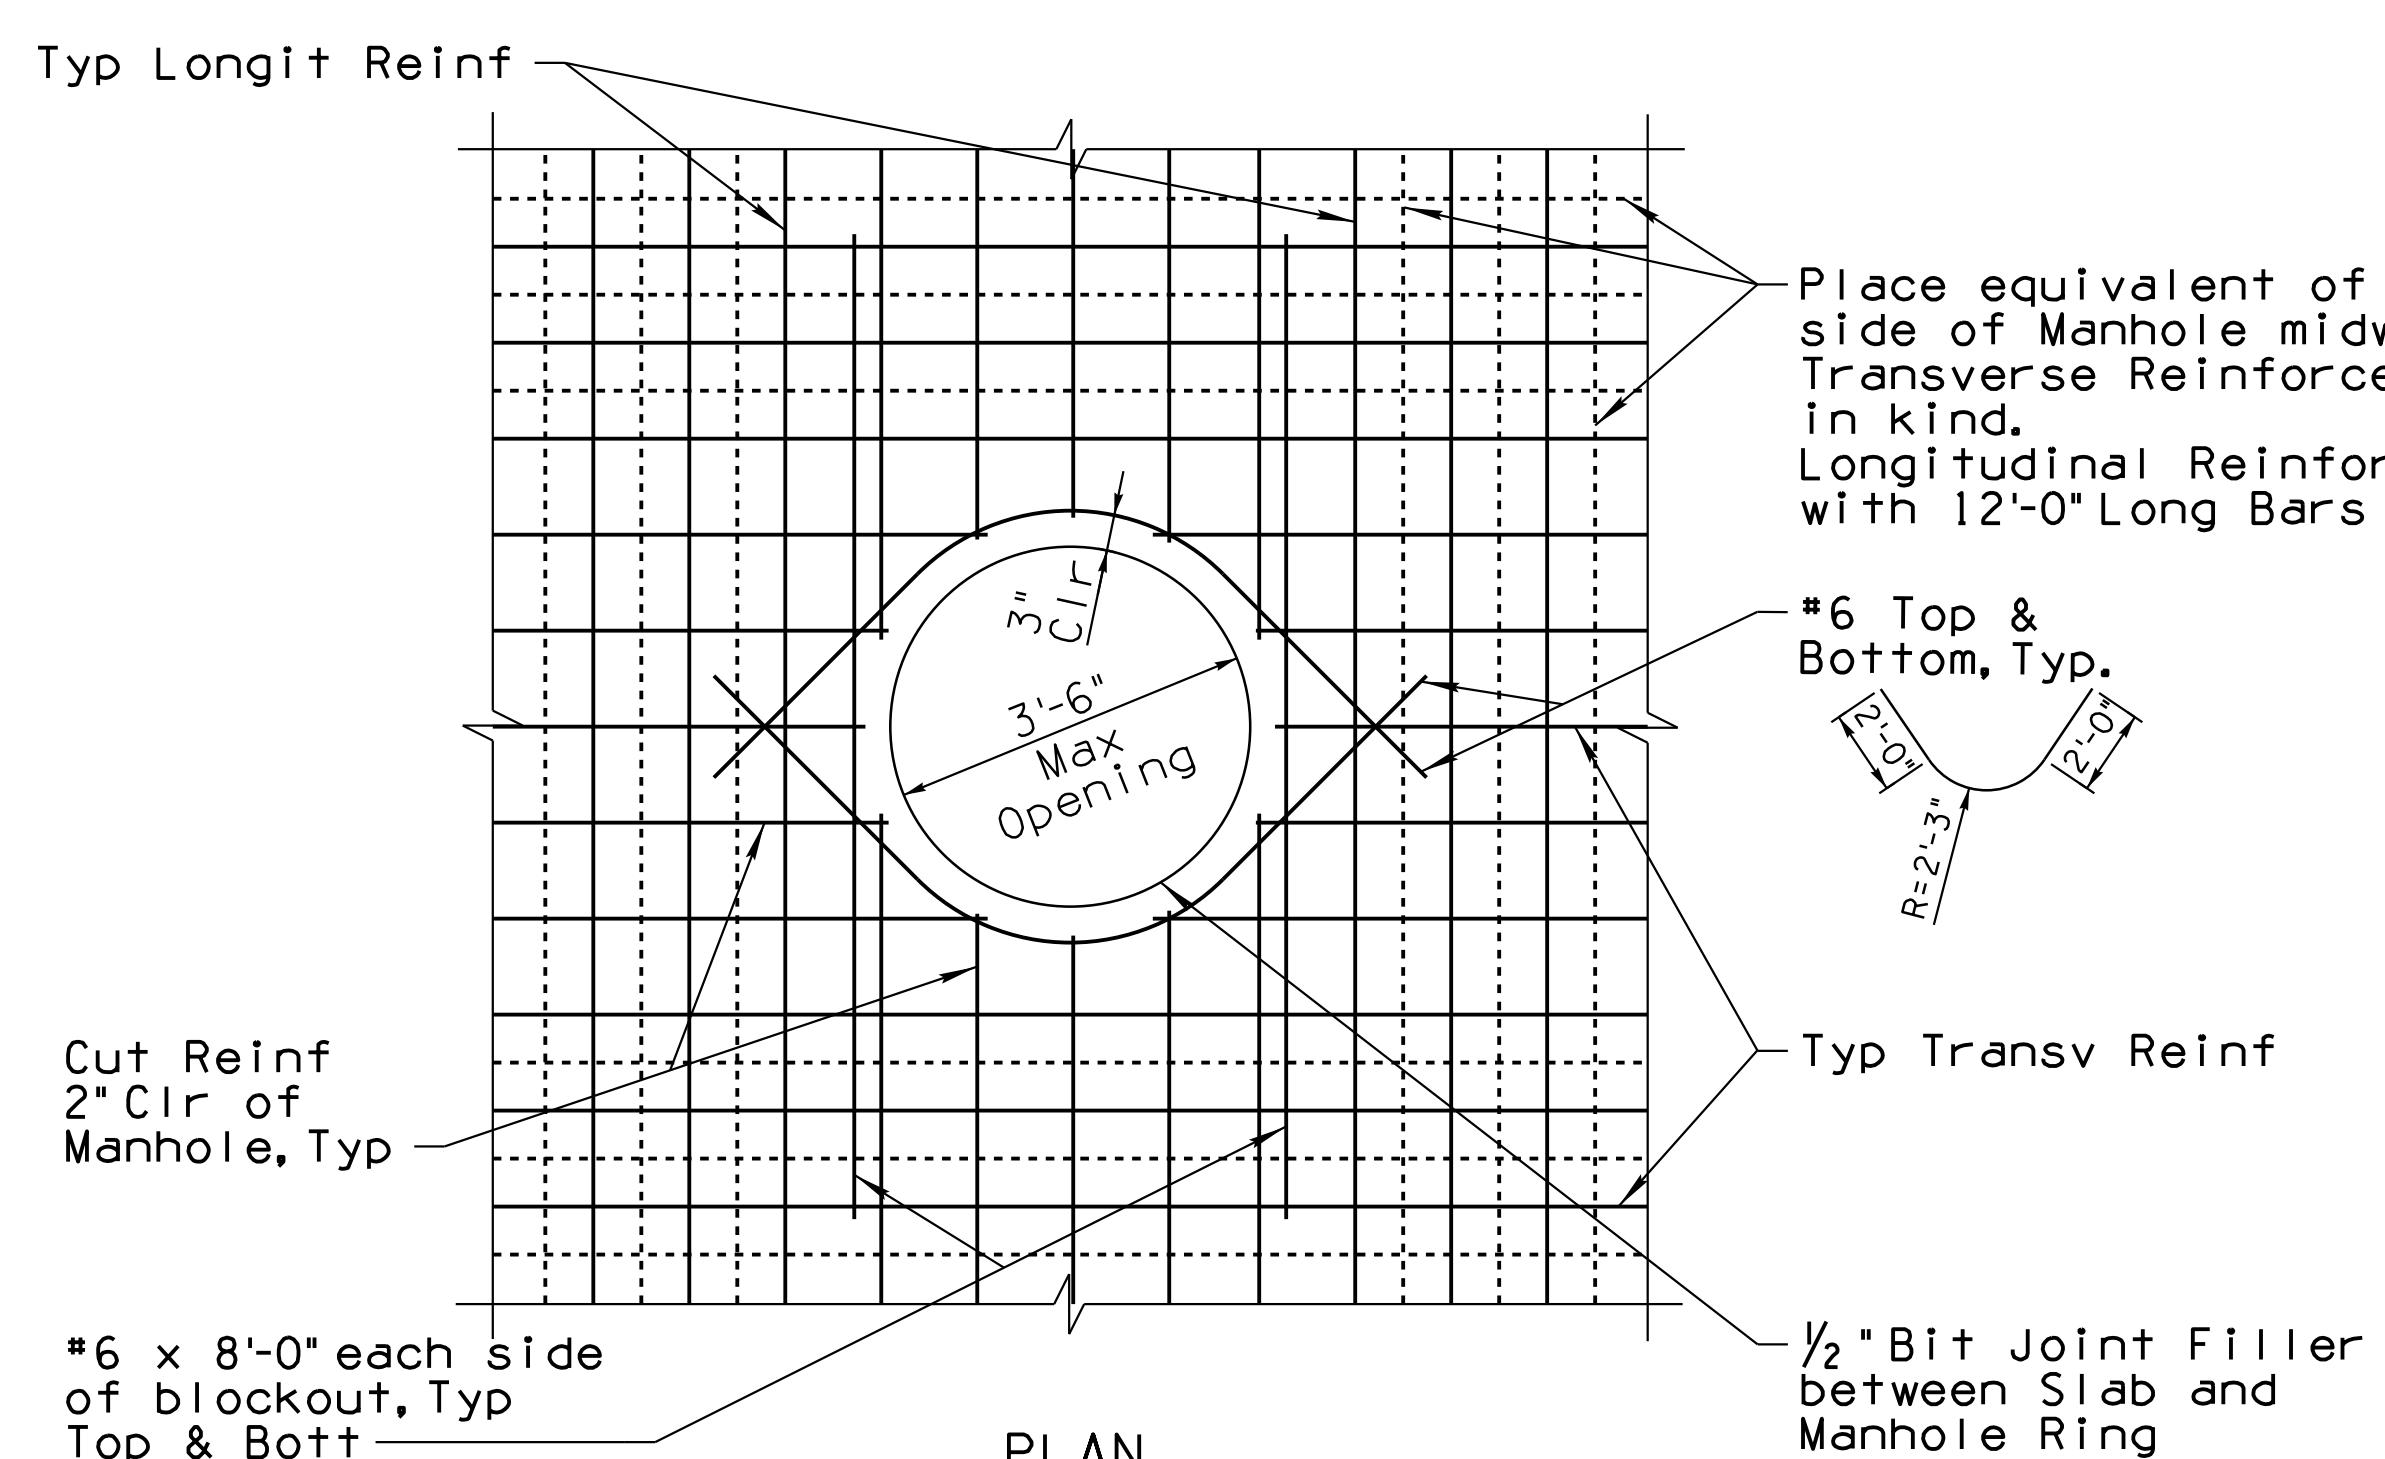


**DETAIL - MANHOLE BLOCKOUT**  
No Scale

Place equivalent of 1/2 of cut Bars each side of Manhole midway btwn Typ Reinf. Transverse Reinforcement shall be replaced in kind. Longitudinal Reinforcement shall be replaced with 12'-0" Long Bars centered on Manhole.

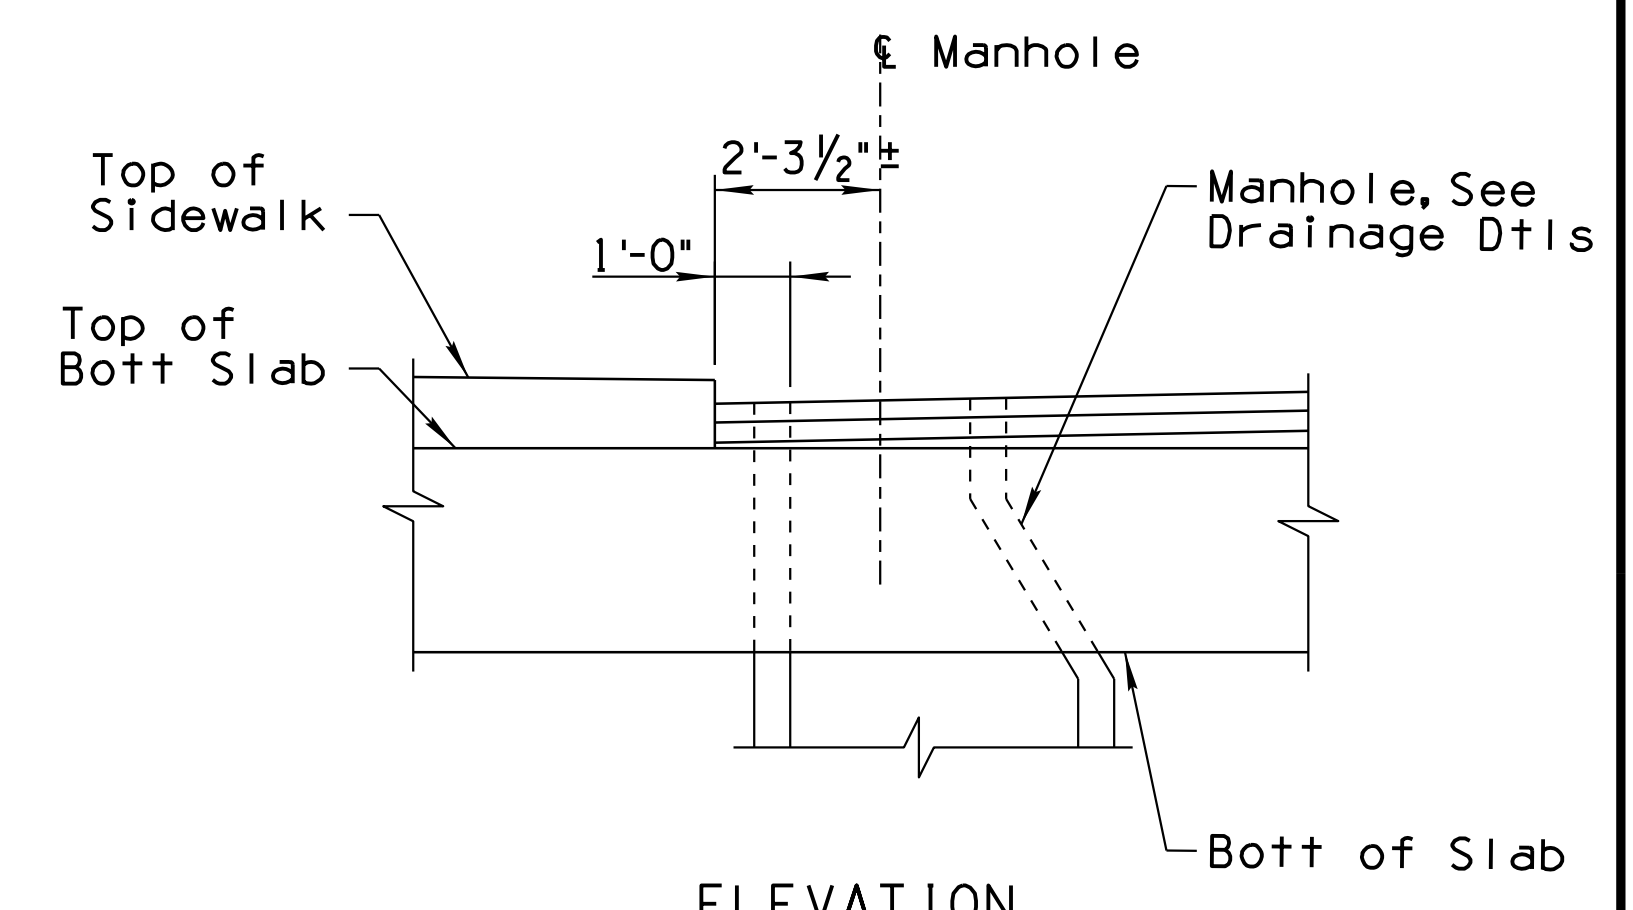

**DETAIL - MANHOLE BLOCKOUT**  
No Scale

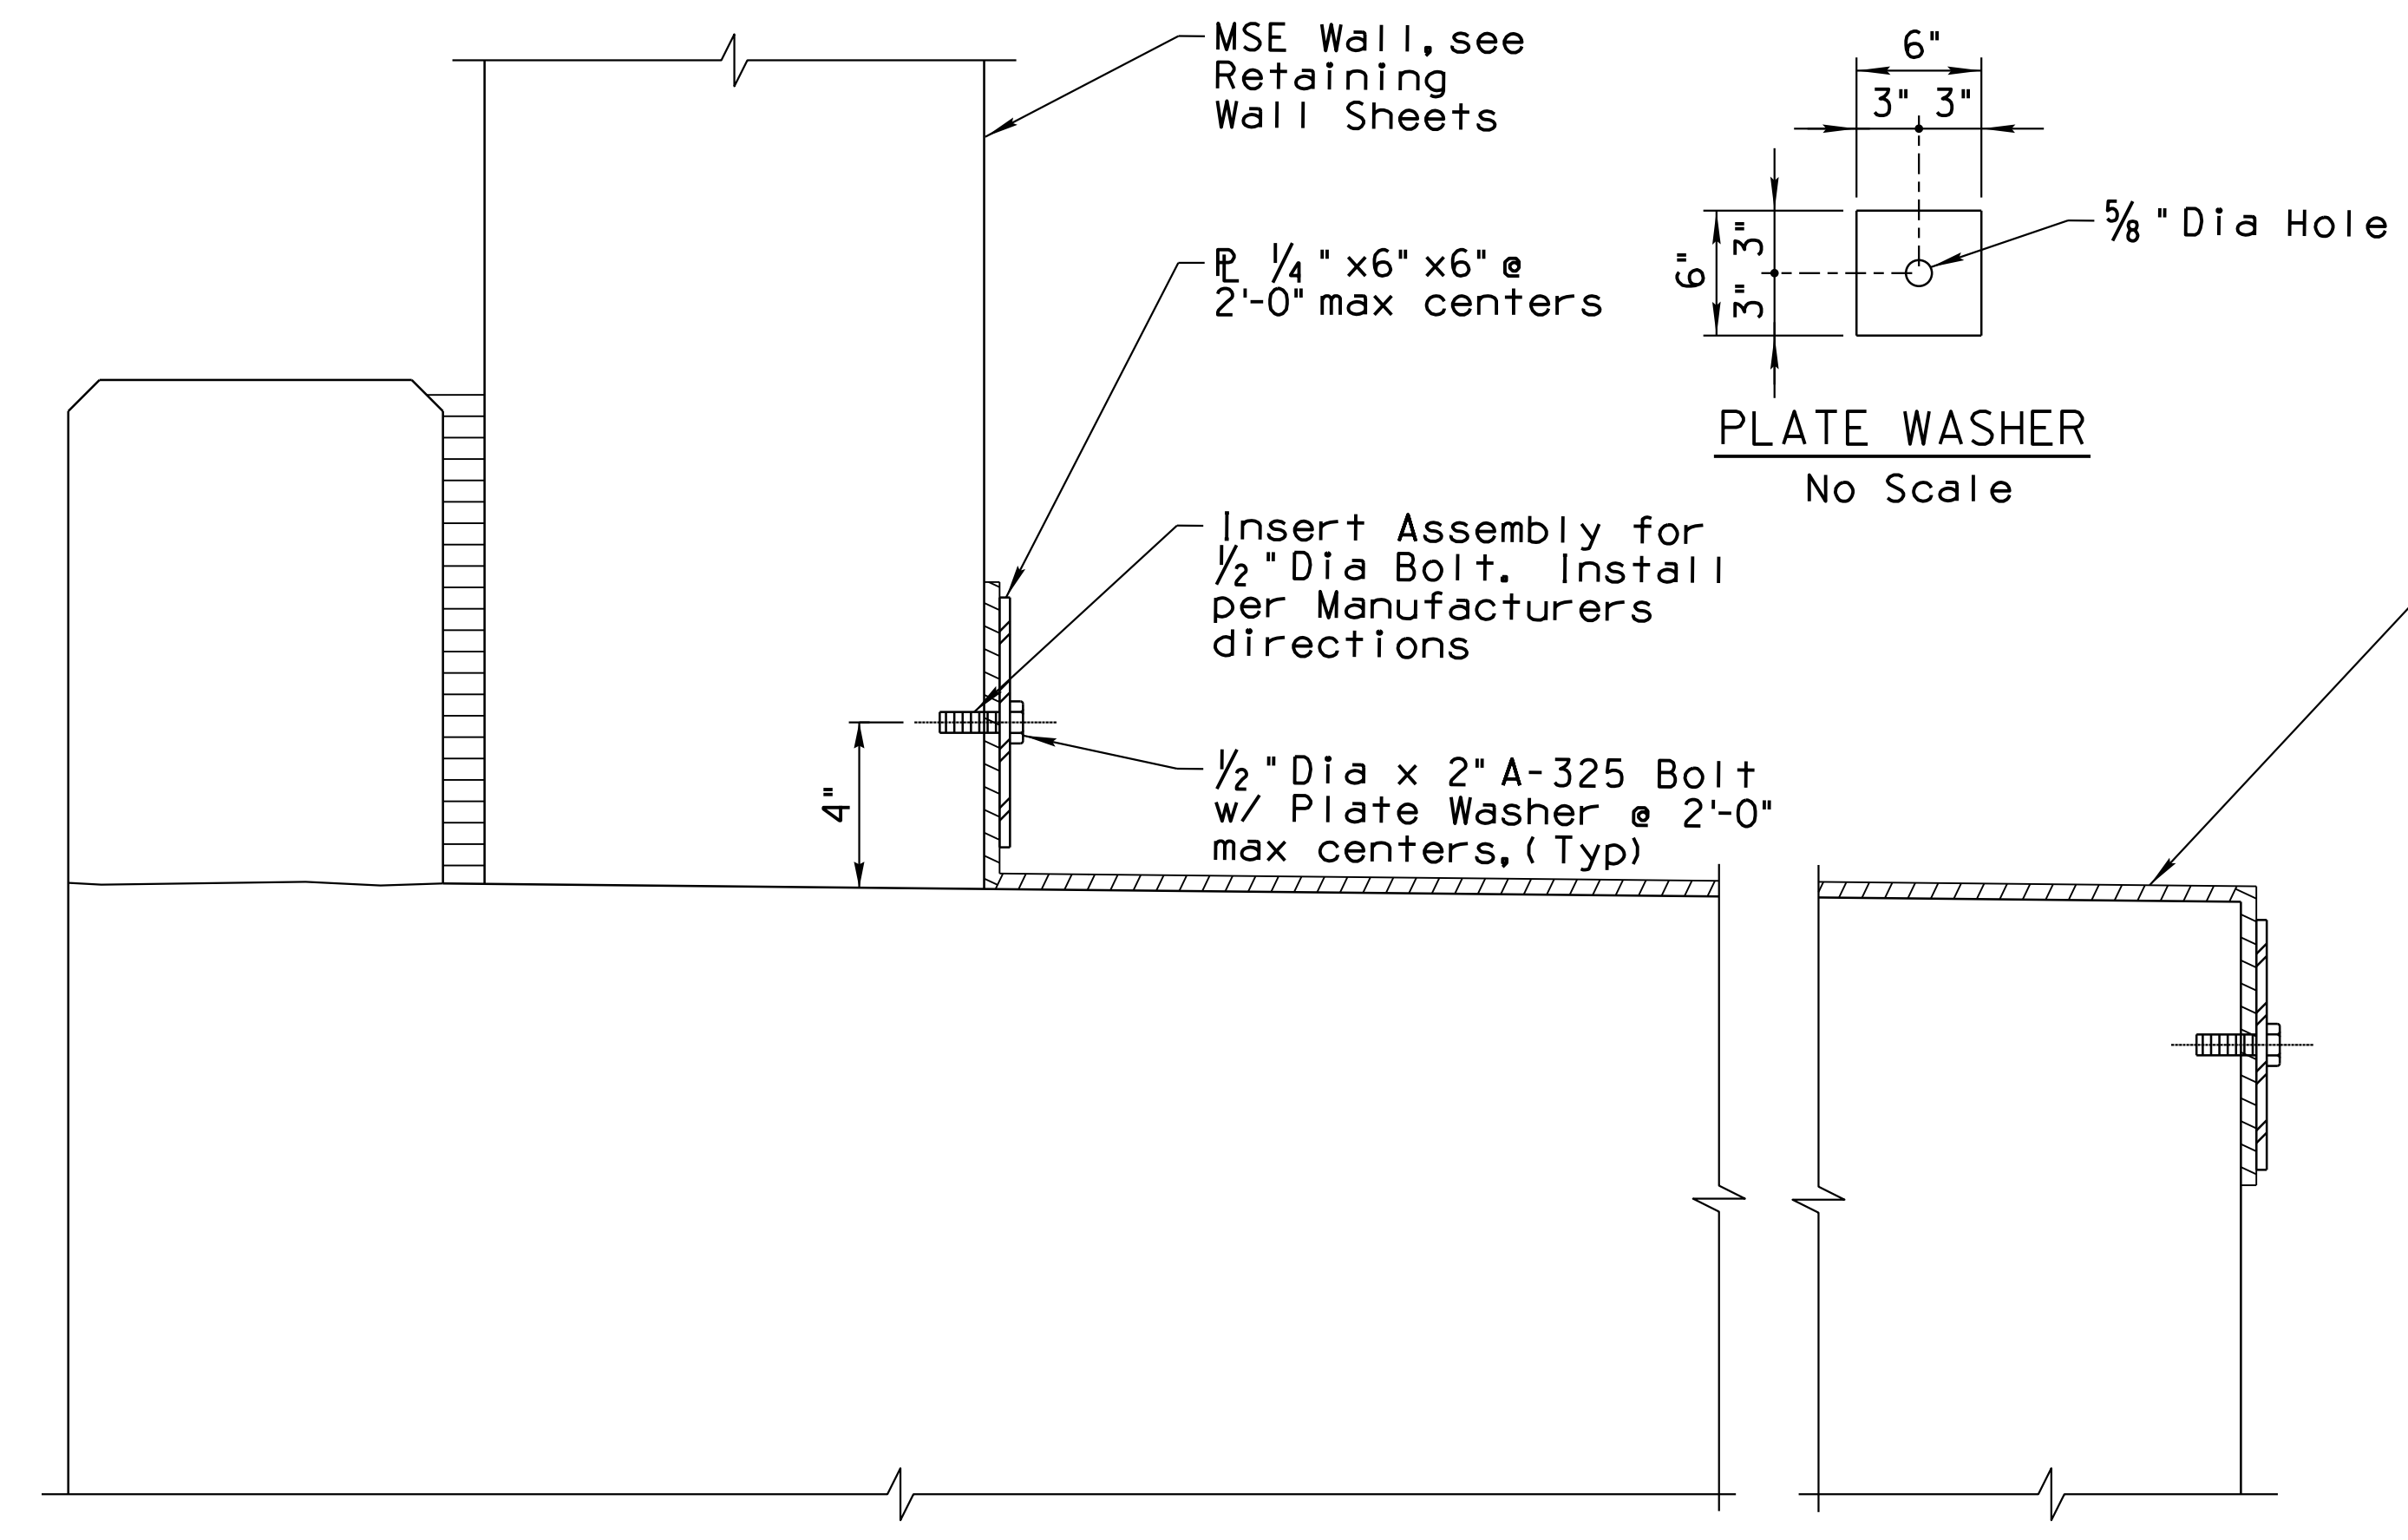


**DETAIL - GEOMEMBRANE**  
No Scale

30mil Geomembrane Waterproofing, Typ. Installation and Splices shall be per Manufacturers directions

**Note:**  
1. Plate Washers shall be galvanized.

DESIGN	CER	DATE	3-19	ARIZONA DEPARTMENT OF TRANSPORTATION INFRASTRUCTURE DELIVERY AND OPERATIONS DIVISION BRIDGE GROUP
DRAWN	DAY	DATE	3-19	
CHECKED	JAC	DATE	3-19	
		WSP USA Inc. 177 N. Church Avenue Suite 1105 Tucson, AZ 85701		STA 20+ DAVIS AVENUE FRAME MISCELLANEOUS DETAILS
I-10	252.00	11551	LOCATION	
ROUTE	MILEPOST	STRUCTURE NO.	010-D(213)S	
TRACS NO. H 8480 OIC			DWG NO. S-3.06	

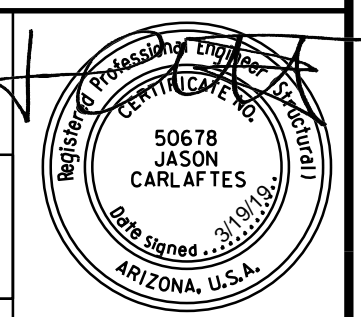



F.H.W.A. REGION	STATE	PROJECT NO.	SHEET NO.	TOTAL SHEETS	RECORD DRAWING
9	ARIZ.	010-D(213)S	698	849	


010 PM 252



GENERAL NOTES

- General soil and rock (where encountered) strata descriptions and indicated boundaries are based on engineering interpretation of available subsurface information by the geotechnical engineer and may not reflect actual variation in subsurface conditions between borings and samples. The location of contacts between strata may be gradual rather than abrupt. Classification of soil material is in general accordance with ASTM D 2488-93 and is presented in the Geotechnical Report.
- The observed water levels and/or moisture conditions indicated on the boring logs are as recorded at the time of field investigation. These water levels and/or moisture conditions may vary considerably with time according to the prevailing climate, rainfall or other factors and are otherwise dependent upon the duration of and methods used in the field investigation program.
- Sound engineering judgment was exercised in preparing the subsurface information presented on these sheets. This information was prepared and is intended for design and estimating purposes. Its presentation on the plans or elsewhere is for the purpose of providing intended users with access to the same information as was provided to the State and its designers. Interpretations of subsurface information are presented in good faith and are not intended as a substitute for personal investigation, independent interpretations or judgment of the contractor.
- A 140 lb. hammer, 30-inch free-fall, was used to drive both the Standard Penetration Test (SPT) split-spoon sampler and the ring-lined sampler in general conformance with ASTM D 1586-96 and D 3550-01, respectively.
- For further information, refer to NCS report "Final Geotechnical Report; I-10, Ruthrauff Road Traffic Interchange," submitted to HDR on March 31, 2015 and any addenda.
- Reaction to dilute HCl (as per ASTM D 2488) does not necessarily correlate to the degree of carbonate cementation. For example, a "strong" reaction to HCl and a low SPT N-value may indicate that the soil particles are coated with calcium carbonate or lime but the voids are mostly clear, i.e. the particles are not significantly cemented to each other; therefore, the density is loose. In other cases, soil may exhibit "no" to "weak" reaction to HCl but appear to be strongly cemented due to induration. Thus, the user should consider the reported reaction to HCl and SPT N-values in conjunction with other relevant factors to evaluate the degree of cementation and its effect on construction activities.
- Refusal SPT N-values may be indicative of the presence of cobbles or boulders whose size cannot be determined by the investigative techniques used for this project. Cobbles and boulders will likely be encountered during the construction of the drilled shafts. Additionally, cemented layers may form cobble or boulder size pieces when broken up. The contractor should mobilize the appropriate equipment for removing this material.
- The site soils contain random zones of poorly graded sands and gravels. These soils are prone to caving. Therefore, localized caving should be anticipated during drilled shaft construction. These local zones may be up to 20-ft thick and can occur at various depths.
- The site soils contain random zones of gravels, cobbles and boulders. These materials experience large fluid loss during slurry-assisted drilled shaft construction.

BORING PLAN

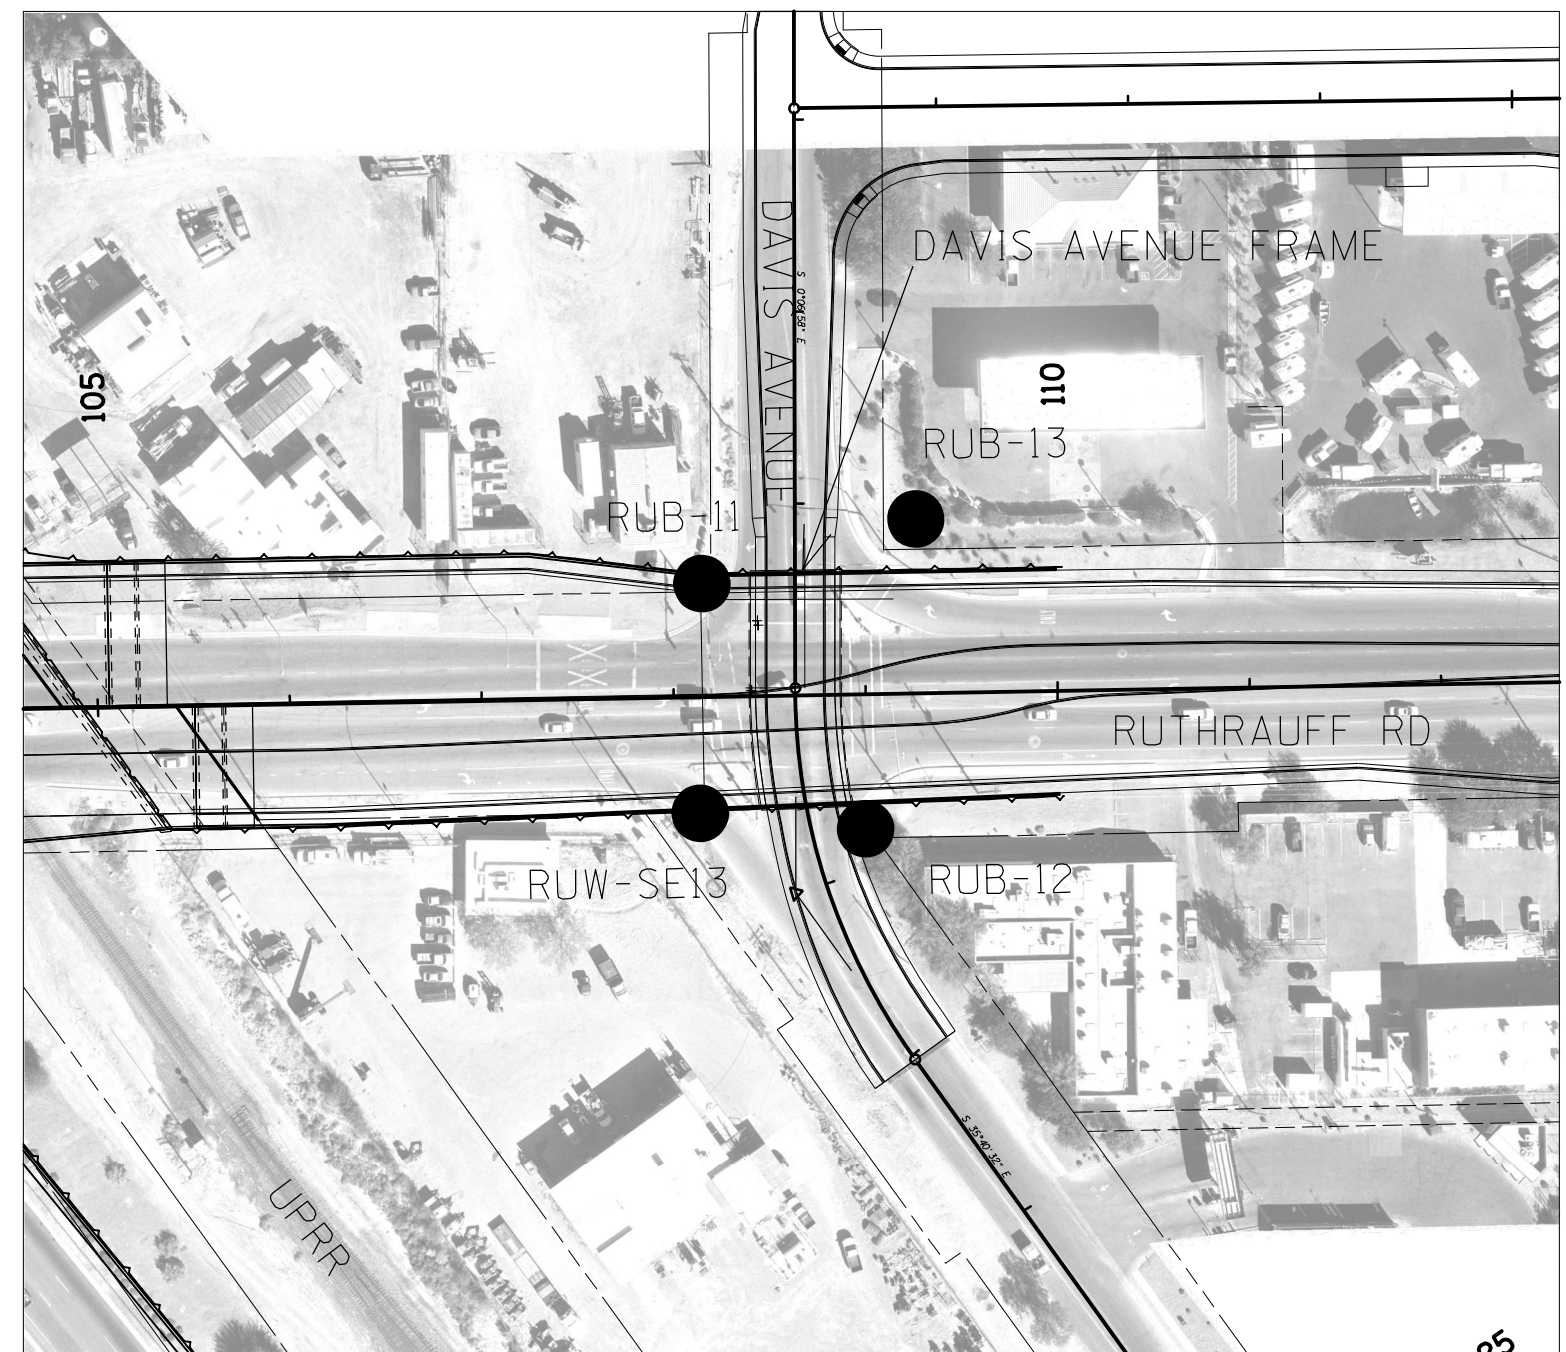
SCALE 1:100



-  PHASE 1 BORING LOCATION
-  PHASE 2 BORING LOCATION

OTHER TERMINOLOGY

<u>Quantity:</u>	<u>Reaction to HCl:</u>	
Trace < 5%	No reaction	No visible reaction
Few 5-10%	Weak reaction	Some reaction, with bubbles forming slowly
Little 15-25%	Strong reaction	Violent reaction, with bubbles forming immediately
Some 30-45%		
Mostly > 50%		

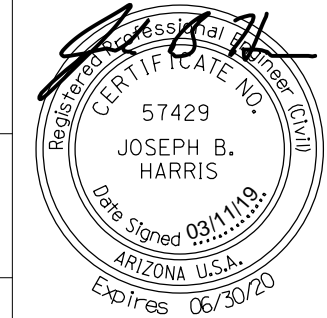DESIGN	JBH	DATE	3-19	<b>ARIZONA DEPARTMENT OF TRANSPORTATION</b> <b>INFRASTRUCTURE DELIVERY AND OPERATIONS DIVISION</b> <b>BRIDGE GROUP</b>	
DRAWN	JBH	DATE	3-19		
CHECKED	KW	DATE	3-19		
<b>SCE ENGINEERING</b>		510 E. 4TH STREET TUCSON, AZ 85705 520-405-1353		<b>STA 20+</b> <b>DAVIS AVENUE FRAME</b> <b>FOUNDATION DATA (1 OF 5)</b>	
I-10	252.00	11551	LOCATION	RUTHRAUFF ROAD T.I.	DWG NO. S-3.07
TRACS NO. H8480 OIC			010-D(213)S		



DATE- LOCATION- REVISIONS- FINISHED PLANS- SURVEY NO. DATE- LOCATION- REVISIONS- FINISHED PLANS- SURVEY NO.

F.H.W.A. REGION	STATE	PROJECT NO.	SHEET NO.	TOTAL SHEETS	RECORD DRAWING
9	ARIZ.	010-D(213)S	699	849	

010 PM 252

### SCE BORING LOG: RUB-11 (1 of 2)

108+16, 59 Lt. (Ref. Al. Ruthrauff CL)  
 NORTHING: 472,049 EASTING: 975,033  
 ELEV.: 2,247.3 TOTAL DEPTH: 99.5

STARTED: 08/28/2013 12:15 PM  
 FINISHED: 08/28/2013 04:30 PM

CONTRACTOR: GSI  
 DRILLER: S. Bradshaw  
 INSPECTOR: C. Lavayen  
 RIG TYPE: Truck mt. CME 75  
 DRILLING METHOD: 8" OD HSA  
 HAMMER TYPE: Auto Hammer  
 SCE PROJECT #: J2009-14/J2012-07

DEPTH (FT)	ELEV. (FT)	GRAPHIC	SAMPLE			SAMPLER TYPES	Type	Symbol	Description	I.D.	O.D.	Length
			TYPE	SYMBOL	BLOWS							
VISUAL SOIL IDENTIFICATION / DESCRIPTION AND REMARKS												
	2245		S	×	2-3-11			LEAN CLAY WITH SAND (native), stiff, moist, dark brown, low to medium plasticity CLAY, little fine to medium sand, no cementation, strong reaction with HCl. (CL)	1.375"	2"	18"	
5			S	×	2-3-3			Becomes medium stiff.				
	2240		R	■	5-5			CLAYEY SAND, loose, moist, brown, fine to coarse SAND, little medium plasticity fines, weak cementation, strong reaction with HCl. (SC)	2.5"	3"	18"	
10			S	×	4-5-10			FAT CLAY, stiff, moist, dark brown, high plasticity CLAY, few fine to coarse sand, no cementation, strong reaction with HCl. (CH)				
	2235		R	■	5-6			Becomes medium stiff, little fine to coarse sand.				
15			S	×	4-6-11			SILTY SAND WITH GRAVEL, medium dense, moist, brown, fine to coarse SAND, little fine subrounded to subangular gravel, little nonplastic fines, no cementation, no reaction with HCl, max. particle size 0.75". (SM)				
	2230		S	×	4-7-13							
20			S	×	17-12-26			SILTY GRAVEL WITH SAND, dense, moist, brown, fine to coarse subrounded to subangular GRAVEL, some fine to coarse sand, little nonplastic fines, no cementation, no reaction with HCl, max. particle size 1.5". (GM)				
	2225		R	■	5-6			CLAYEY SAND, loose, moist, brown, fine to coarse SAND, little medium plasticity fines, no cementation, strong reaction with HCl. (SC)				
25			S	×	5-9-12			Becomes medium dense, fine to medium SAND, trace fine subrounded to subangular gravel, no reaction with HCl, max. particle size 0.25".				
	2220		S		50/3			Becomes very dense.				
30			S		50/5			SILTY GRAVEL WITH SAND, very dense, dry to moist, brown, fine to coarse subrounded to subangular GRAVEL, some fine to coarse sand, little nonplastic fines, no cementation, no reaction with HCl, max. particle size 1.5". (GM) Rock in sampler tip.				
	2215		S		50/1			CLAYEY SAND, very dense, moist, brown, fine to coarse SAND, little high plasticity fines, trace fine subrounded gravel, no cementation, no reaction with HCl, max. particle size 0.5". (SC)				
35			S	×	10-19-20			Becomes CLAYEY SAND WITH GRAVEL, dense, some fine subrounded to subangular gravel, max. particle size 0.75".				
	2210		R	■	43-50/4			Becomes very dense.				
40												
45												
50												
55												
60												
65												
70												

### SCE BORING LOG: RUB-11 (2 of 2)

108+16, 59 Lt. (Ref. Al. Ruthrauff CL)  
 NORTHING: 472,049 EASTING: 975,033  
 ELEV.: 2,247.3 TOTAL DEPTH: 99.5


STARTED: 08/28/2013 12:15 PM  
 FINISHED: 08/28/2013 04:30 PM

CONTRACTOR: GSI  
 DRILLER: S. Bradshaw  
 INSPECTOR: C. Lavayen  
 RIG TYPE: Truck mt. CME 75  
 DRILLING METHOD: 8" OD HSA  
 HAMMER TYPE: Auto Hammer  
 SCE PROJECT #: J2009-14/J2012-07

DEPTH (FT)	ELEV. (FT)	GRAPHIC	SAMPLE			SAMPLER TYPES	Type	Symbol	Description	I.D.	O.D.	Length
			TYPE	SYMBOL	BLOWS							
VISUAL SOIL IDENTIFICATION / DESCRIPTION AND REMARKS												
	2175		S	×	16-30-27			Added 5 gallons of water to boring at 70'.				
75			S	×	18-19-12			Becomes dense, little fine subangular to angular gravel, little low to medium plasticity fines. Added 5 gallons of water to boring at 75'.				
	2170		S	×	10-12-21			Becomes CLAYEY SAND, few fine subangular to angular gravel. Added 5 gallons of water to boring at 80'.				
80			S	×	18-18-38			Becomes CLAYEY SAND WITH GRAVEL, very dense, little fine subangular to angular gravel, little medium plasticity fines. Added 5 gallons of water to boring at 85'.				
	2165		R	■	5-35			Becomes medium dense. Added 5 gallons of water to boring at 90'.				
85			S	×	21-25-30			Becomes very dense.				
	2160		S	×	23-26-18			Becomes dense.				
90								End of boring at 98'. Stopped sampler at 99.5'. No groundwater encountered. Backfilled with portland cement and sand mixture.				
	2155											
95												
	2150											
100												
	2145											
105												
	2140											
110												
	2135											
115												
	2130											
120												
	2125											
125												
	2120											
130												
	2115											
135												
	2110											
140												

### BORING PLAN

SCALE 1:100

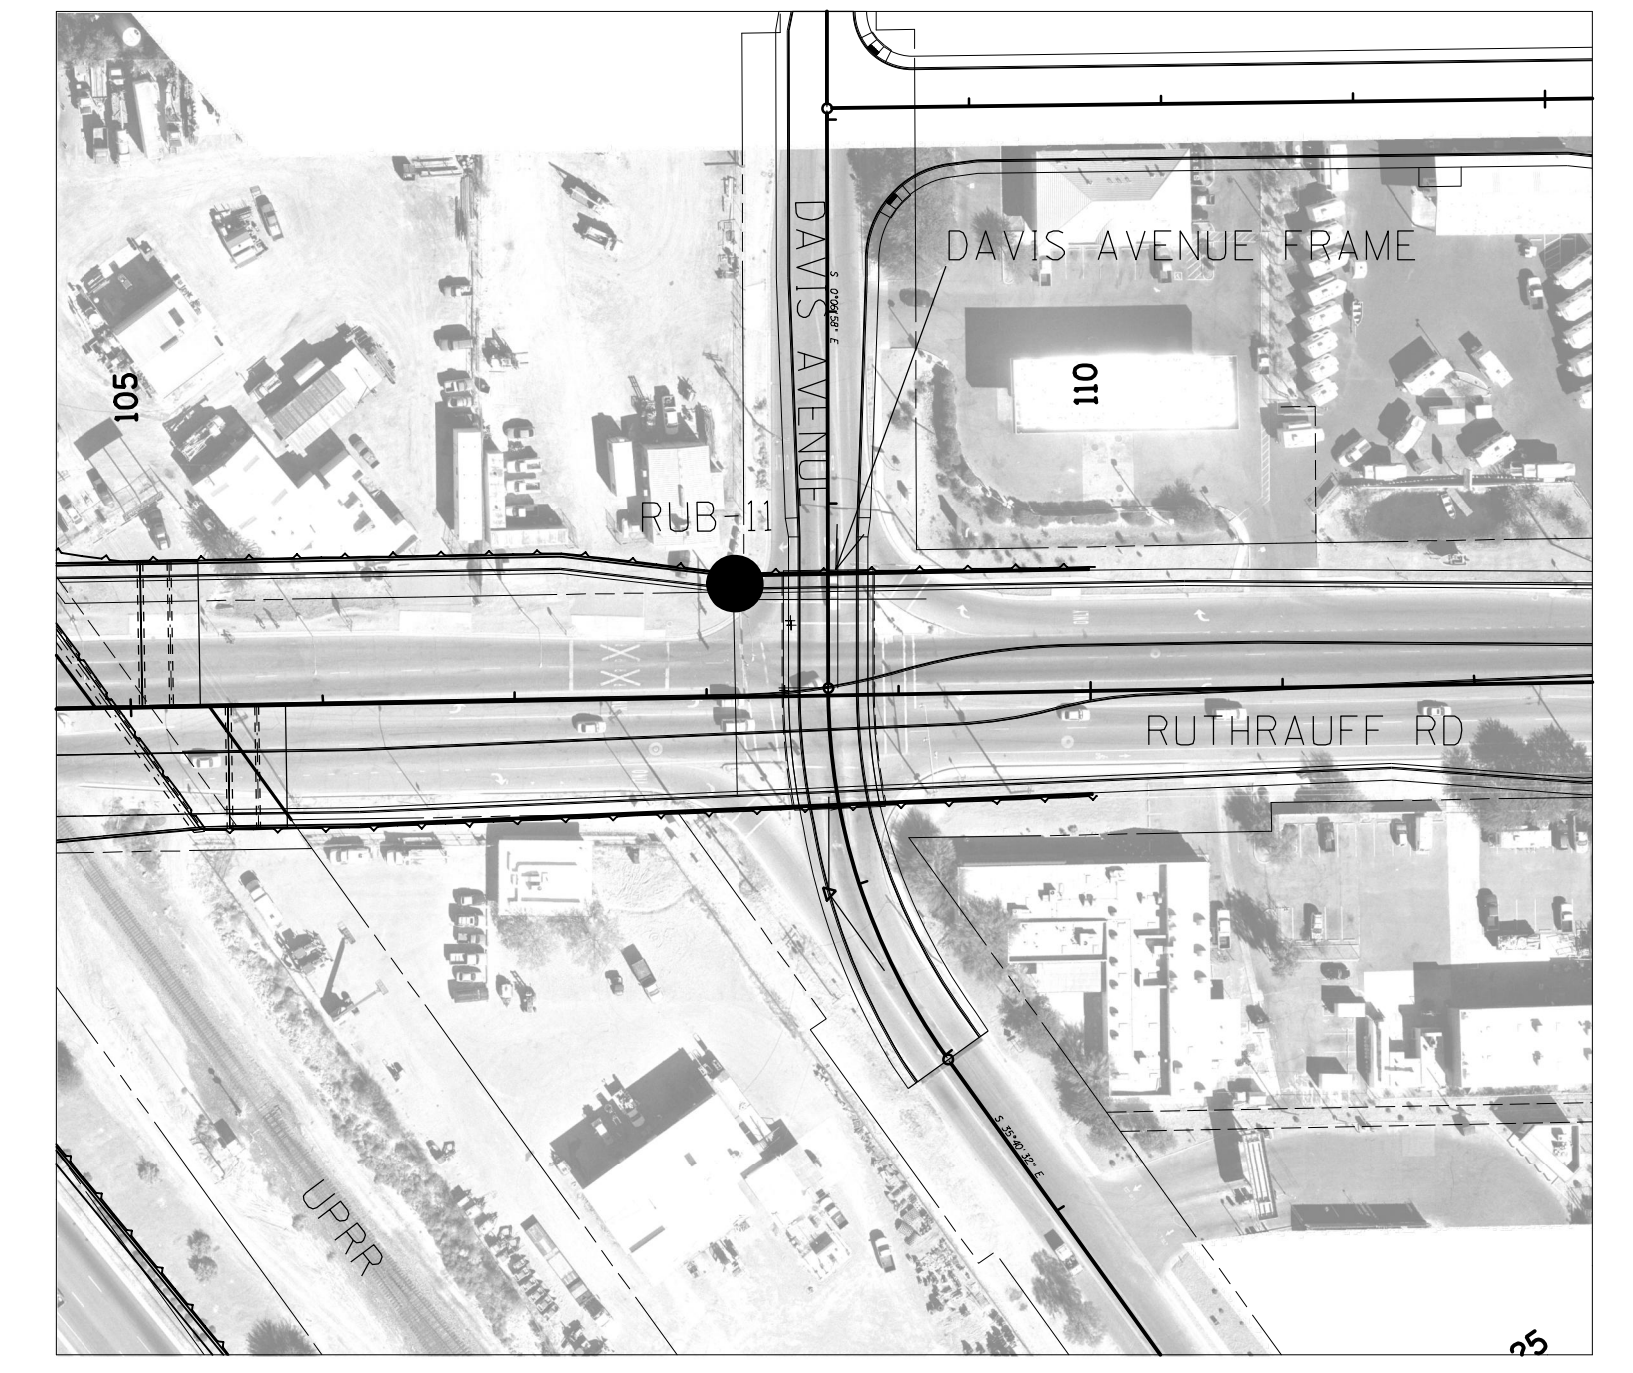

- PHASE 1 BORING LOCATION
- PHASE 2 BORING LOCATION

DESIGN	JBH	DATE	3-19	<b>ARIZONA DEPARTMENT OF TRANSPORTATION</b> <b>INFRASTRUCTURE DELIVERY AND OPERATIONS DIVISION</b> <b>BRIDGE GROUP</b>	
DRAWN	JBH	DATE	3-19		
CHECKED	KW	DATE	3-19		
<b>SCE ENGINEERING</b>		510 E. 4TH STREET TUCSON, AZ 85705 520-405-1353		<b>STA 20+ DAVIS AVENUE FRAME FOUNDATION DATA (2 OF 5)</b>	
I-10 ROUTE	252.00 MILEPOST	11551 STRUCTURE NO.	LOCATION	RUTHRAUFF ROAD T.I.	
TRACS NO. H8480 OIC			010-D(213)S		DWG NO. S-3.08





F.H.W.A. REGION	STATE	PROJECT NO.	SHEET NO.	TOTAL SHEETS	RECORD DRAWING
9	ARIZ.	010-D(213)S	700	849	

010 PM 252

### SCE BORING LOG: RUB-12 (1 of 2)

108+99, 70 Rt. (Ref. Al. Ruthrauff CL)  
 NORTHING: 471,921 EASTING: 975,119  
 ELEV.: 2,246.9 TOTAL DEPTH: 99.5

CONTRACTOR: GSI  
 DRILLER: R. Quezada  
 INSPECTOR: C. Lavayen  
 RIG TYPE: Truck mt. CME 95  
 DRILLING METHOD: 8" OD HSA  
 HAMMER TYPE: Auto Hammer  
 SCE PROJECT #: J2009-14/J2012-07

STARTED: 09/04/2013 07:15 AM  
 FINISHED: 09/04/2013 02:45 PM

DEPTH (FT)	ELEV. (FT)	GRAPHIC	SAMPLE			SAMPLER TYPES	Type	Symbol	Description	I.D.	O.D.	Length	VISUAL SOIL IDENTIFICATION / DESCRIPTION AND REMARKS
			TYPE	SYMBOL	BLOWS								
						S	⊗	Split Spoon	1.375"	2"	18"		
						R	■	Ring Sampler	2.5"	3"	18"		
						U	□	Shelby Tube					
2245			R	■	6-6			LEAN CLAY (native), medium stiff, moist, brown, medium plasticity CLAY, few fine to coarse sand, no cementation, strong reaction with HCl. (CL)					
2240			CU	⊗	2-3-5								
2235			R	■	4-12								
2230			S	⊗	4-6-9			Becomes LEAN CLAY WITH SAND, stiff, little fine to coarse sand, weak cementation.					
2225			S	⊗	9-11-9			Becomes very stiff, no cementation.					
2220			S	⊗	16-24-27			SILTY SAND WITH GRAVEL, very dense, dry, gray-brown, fine to coarse SAND, some fine to coarse subrounded to subangular gravel, little low plasticity fines, no cementation, no reaction with HCl, max. particle size 1.5". (SM)					
2215			R	■	5-12			LEAN CLAY, medium stiff, moist, dark brown, low to medium plasticity CLAY, few fine to medium sand, weak cementation, strong reaction with HCl. (CL)					
2210			S	⊗	17-25-37			WELL-GRADED GRAVEL WITH SILT AND SAND, very dense, dry, gray, fine to coarse subrounded to subangular GRAVEL, some fine to coarse sand, few nonplastic fines, no cementation, weak reaction with HCl, max. particle size 1.5". (GW-GM)					
2205			S	⊗	23-50/2			Becomes few low plasticity fines.					
2200			S	⊗	50/6			No recovery.					
2195			S	⊗	15-8-27			CLAYEY SAND WITH GRAVEL, dense, dry, gray-brown, fine to coarse SAND, some fine to coarse subangular to angular gravel, little low to medium plasticity fines, no cementation, no reaction with HCl, max. particle size 1". (SC)					
2190			S	⊗	18-21-25			Becomes moist, brown.					
2185			R	■	16-25			Becomes CLAYEY SAND, medium dense, little medium plasticity fines, few fine subrounded to subangular gravel, max. particle size 0.75".					
2180			S	⊗	20-22-28			Becomes CLAYEY SAND WITH GRAVEL, dense, little fine subrounded to subangular gravel, max. particle size 0.5".					

### SCE BORING LOG: RUB-12 (2 of 2)

108+99, 70 Rt. (Ref. Al. Ruthrauff CL)  
 NORTHING: 471,921 EASTING: 975,119  
 ELEV.: 2,246.9 TOTAL DEPTH: 99.5


CONTRACTOR: GSI  
 DRILLER: R. Quezada  
 INSPECTOR: C. Lavayen  
 RIG TYPE: Truck mt. CME 95  
 DRILLING METHOD: 8" OD HSA  
 HAMMER TYPE: Auto Hammer  
 SCE PROJECT #: J2009-14/J2012-07

STARTED: 09/04/2013 07:15 AM  
 FINISHED: 09/04/2013 02:45 PM

DEPTH (FT)	ELEV. (FT)	GRAPHIC	SAMPLE			SAMPLER TYPES	Type	Symbol	Description	I.D.	O.D.	Length	VISUAL SOIL IDENTIFICATION / DESCRIPTION AND REMARKS
			TYPE	SYMBOL	BLOWS								
2175			S	⊗	21-23-22			Becomes some fine subrounded to subangular gravel, max. particle size 0.75".					
2170			S	⊗	29-31-27			Becomes very dense, dry, light brown, little fine subrounded to subangular gravel.					
2165			S	⊗	25-23-18			Becomes dense, moist.					
2160			S	⊗	38-50/5			Becomes very dense, brown, little fine subangular to angular gravel, max. particle size 0.5".					
2155			R	■	50/5			Added 5 gallons of water to boring at 90'.					
2150			S	⊗	20-25-24			Becomes dense.					
2145			S	⊗	24-44-37			Becomes very dense, some fine subrounded to subangular gravel, little low plasticity fines. End of boring at 98'. Stopped sampler at 99.5'. No groundwater encountered. Backfilled with portland cement and sand mixture.					

### BORING PLAN

SCALE 1:100

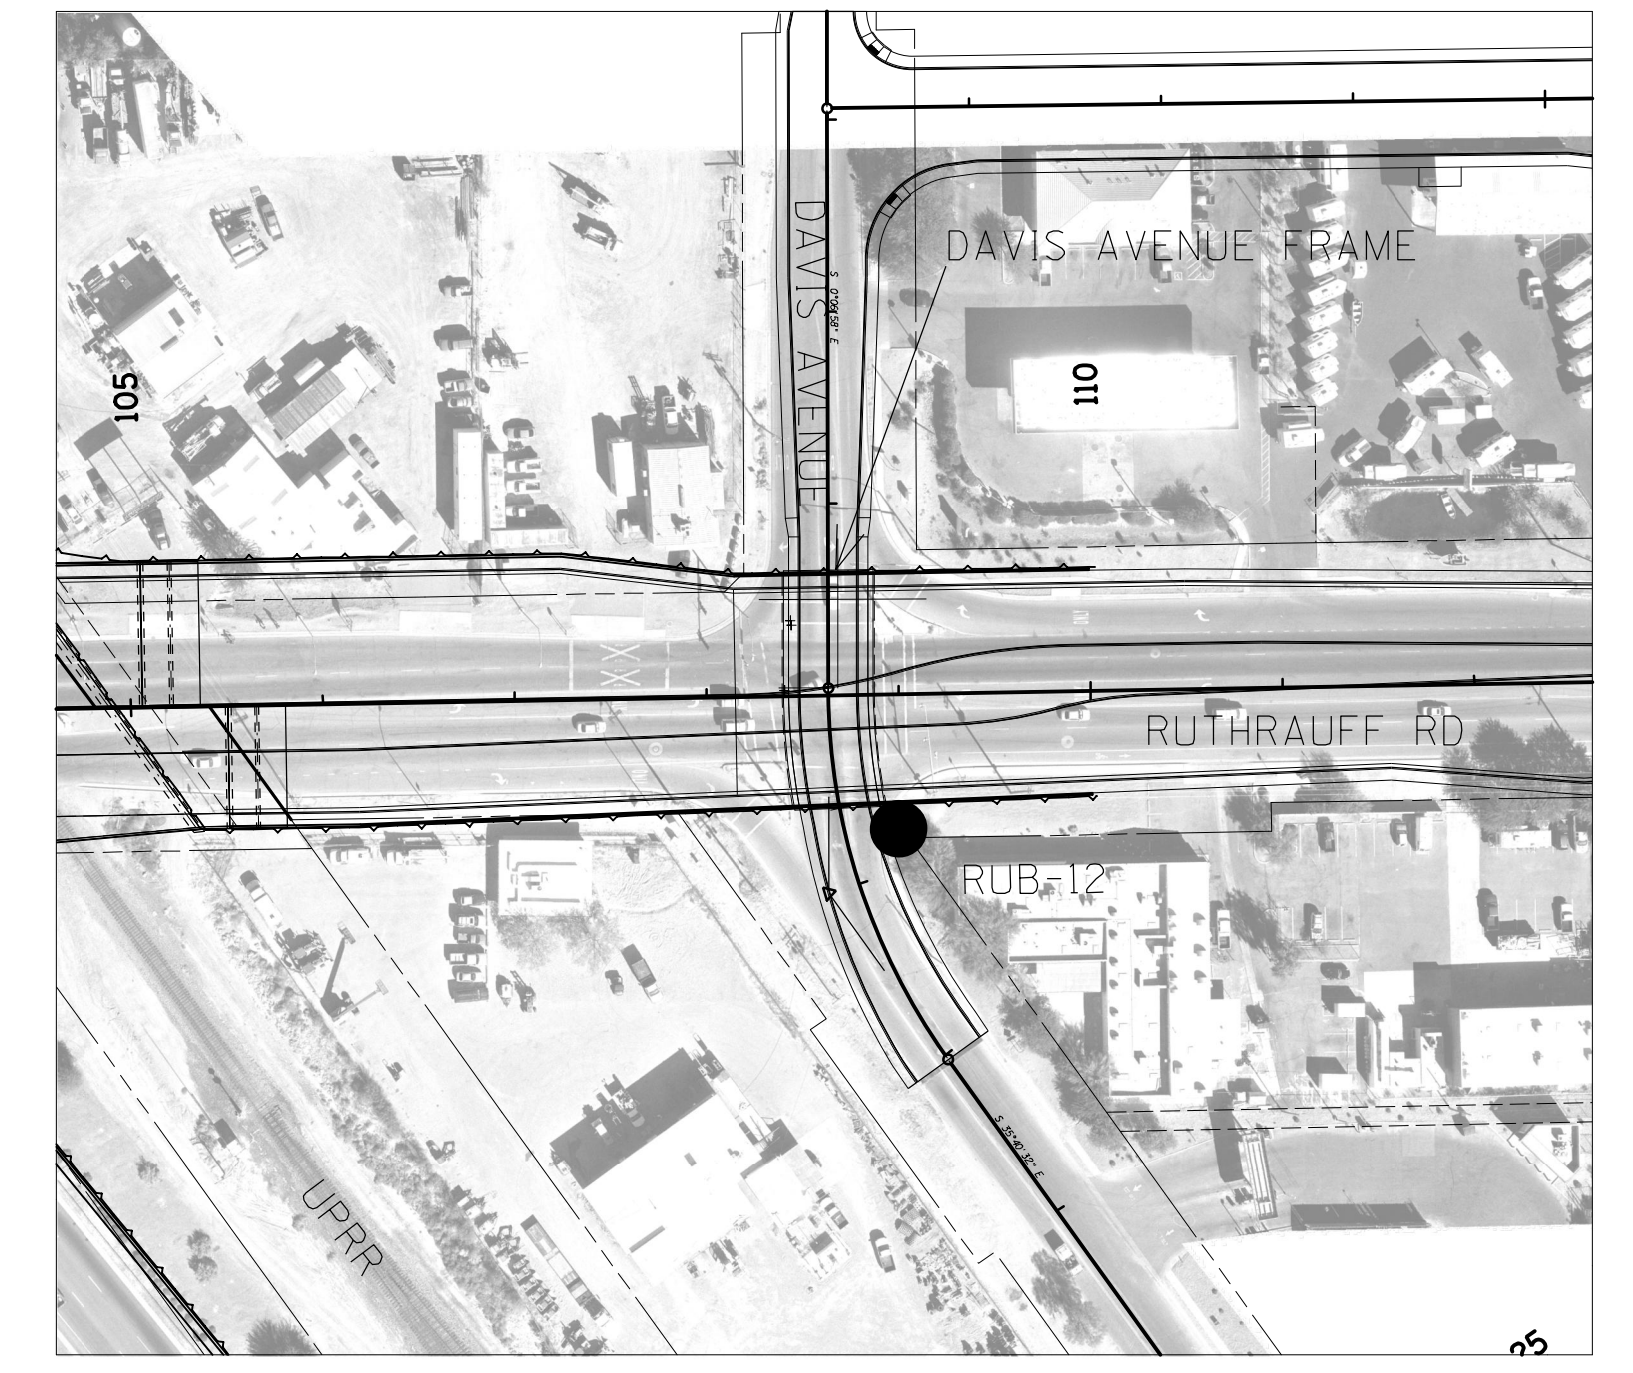

- PHASE 1 BORING LOCATION
- PHASE 2 BORING LOCATION

DESIGN	JBH	DATE	3-19	<b>ARIZONA DEPARTMENT OF TRANSPORTATION</b> <b>INFRASTRUCTURE DELIVERY AND OPERATIONS DIVISION</b> <b>BRIDGE GROUP</b>  <b>STA 20+</b> <b>DAVIS AVENUE FRAME</b> <b>FOUNDATION DATA (3 OF 5)</b>	
DRAWN	JBH	3-19			
CHECKED	KW	3-19			
		510 E. 4TH STREET TUCSON, AZ 85705 520-405-1353		LOCATION <b>RUTHRAUFF ROAD T.I.</b>	DWG NO. <b>S-3.09</b>
I-10 ROUTE	252.00 MILEPOST	11551 STRUCTURE NO.	<b>TRACS NO. H8480 OIC</b>	<b>010-D(213)S</b>	<b>OF</b>





F.H.W.A. REGION	STATE	PROJECT NO.	SHEET NO.	TOTAL SHEETS	RECORD DRAWING
9	ARIZ.	010-D(213)S	701	849	


010 PM 252

SCE BORING LOG: RUB-13 (1 of 2)						CONTRACTOR: GSI DRILLER: S. Bradshaw INSPECTOR: E. Everts RIG TYPE: Truck mt. CME 75 DRILLING METHOD: 8" OD HSA HAMMER TYPE: Auto Hammer SCE PROJECT #: J2009-14/J2012-07					
109+28, 91 Lt. (Ref. Al. Ruthrauff CL) NORTHING: 472,082 EASTING: 975,145 ELEV.: 2,244.8 TOTAL DEPTH: 99.5						109+28, 91 Lt. (Ref. Al. Ruthrauff CL) NORTHING: 472,082 EASTING: 975,145 ELEV.: 2,244.8 TOTAL DEPTH: 99.5					
STARTED: 08/30/2013 06:30 AM FINISHED: 08/30/2013 11:30 AM						STARTED: 08/30/2013 06:30 AM FINISHED: 08/30/2013 11:30 AM					
DEPTH (FT)	ELEV. (FT)	GRAPHIC	SAMPLE		SAMPLER TYPES	Type	Symbol	Description	I.D.	O.D.	Length
			TYPE	SYMBOL							
						S	⊗	Split Spoon	1.375"	2"	18"
						R	■	Ring Sampler	2.5"	3"	18"
						U	□	Shelby Tube			
VISUAL SOIL IDENTIFICATION / DESCRIPTION AND REMARKS											
5	2240		R	■	6-9			LEAN CLAY WITH SAND (native), moist, dark brown, medium plasticity CLAY, little fine sand, no cementation, weak reaction with HCl. (CL)			
			CU	⊗	4-5-6			SILTY, CLAYEY SAND, loose, moist, brown, fine SAND, some low plasticity fines, no cementation, weak reaction with HCl. (SC-SM)			
10	2235		R	■	5-12			SANDY LEAN CLAY, stiff, moist, dark brown, medium plasticity CLAY, some fine sand, no cementation, strong reaction with HCl, some calcium carbonates. (CL) Becomes medium stiff.			
			S	⊗	7-11-17			Becomes very stiff, some fine to medium sand.			
15	2230		S	⊗	3-7-8			SILTY SAND, medium dense, moist, light brown, fine to medium SAND, little nonplastic fines, trace fine subrounded to subangular gravel, no cementation, no reaction with HCl, max. particle size 0.5". (SM)			
20	2225		R	■	11-14			Becomes fine to coarse SAND, few fine subrounded to subangular gravel, max. particle size 0.75".			
25	2220		S	⊗	4-12-13			Becomes SILTY SAND WITH GRAVEL, brown, little fine to coarse subrounded to subangular gravel, max. particle size 1".			
30	2215		S	⊗	3-19-50/5			Becomes very dense.			
35	2210		S	⊗	16-50/6			SILTY GRAVEL WITH SAND, very dense, moist, brown, fine to coarse subrounded to subangular GRAVEL, some fine to coarse sand, little nonplastic fines, no cementation, no reaction with HCl, max. particle size 1.5". (GM) Noted 4" to 6" cobbles in cuttings from 31' to 42'.			
40	2205		R	■	27-50/4			CLAYEY GRAVEL WITH SAND, very dense, moist, brown, fine to coarse subrounded to subangular GRAVEL, some fine to coarse sand, little low to medium plasticity fines, no cementation, no reaction with HCl, max. particle size 1.5". (GC)			
45	2200		S	⊗	31-50/1			Added 2.5 gallons of water to boring at 45'.			
50	2195		S	⊗	17-30-33			CLAYEY SAND WITH GRAVEL, very dense, moist, brown, fine to coarse SAND, some fine to coarse subrounded to subangular gravel, little medium plasticity fines, no cementation, no reaction with HCl, max. particle size 1.5". (SC)			
55	2190		S	⊗	21-24-29						
60	2185		R	■	50/4			Added 2.5 gallons of water to boring at 60'.			
65	2180		S	⊗	34-50/6			Added 2.5 gallons of water to boring at 65'.			
70	2175										


SCE BORING LOG: RUB-13 (2 of 2)						CONTRACTOR: GSI DRILLER: S. Bradshaw INSPECTOR: E. Everts RIG TYPE: Truck mt. CME 75 DRILLING METHOD: 8" OD HSA HAMMER TYPE: Auto Hammer SCE PROJECT #: J2009-14/J2012-07					
109+28, 91 Lt. (Ref. Al. Ruthrauff CL) NORTHING: 472,082 EASTING: 975,145 ELEV.: 2,244.8 TOTAL DEPTH: 99.5						109+28, 91 Lt. (Ref. Al. Ruthrauff CL) NORTHING: 472,082 EASTING: 975,145 ELEV.: 2,244.8 TOTAL DEPTH: 99.5					
STARTED: 08/30/2013 06:30 AM FINISHED: 08/30/2013 11:30 AM						STARTED: 08/30/2013 06:30 AM FINISHED: 08/30/2013 11:30 AM					
DEPTH (FT)	ELEV. (FT)	GRAPHIC	SAMPLE		SAMPLER TYPES	Type	Symbol	Description	I.D.	O.D.	Length
			TYPE	SYMBOL							
75	2170		S	⊗	24-34-33			Becomes little fine subangular gravel, max. particle size 0.75". Added 2.5 gallons of water to boring at 70'.			
			S	⊗	34-37-30			Becomes some fine to coarse subangular gravel, max. particle size 1.5". Added 2.5 gallons of water to boring at 75'.			
80	2165		S	⊗	16-16-32			Becomes dense, max. particle size 1". Added 2.5 gallons of water to boring at 80'.			
85	2160		R	■	31-50/5			Becomes very dense. Added 2.5 gallons of water to boring at 85'.			
90	2155		S	⊗	33-40-50/4			Added 2.5 gallons of water to boring at 90'.			
95	2150		S	⊗	22-45-48			Added 2.5 gallons of water to boring at 95'.			
100	2145		S	⊗	32-37-36			End of boring at 98'. Stopped sampler at 99.5'. No groundwater encountered. Backfilled with portland cement and sand mixture.			
105	2140										
110	2135										
115	2130										
120	2125										
125	2120										
130	2115										
135	2110										
140	2105										

### BORING PLAN

SCALE 1:100

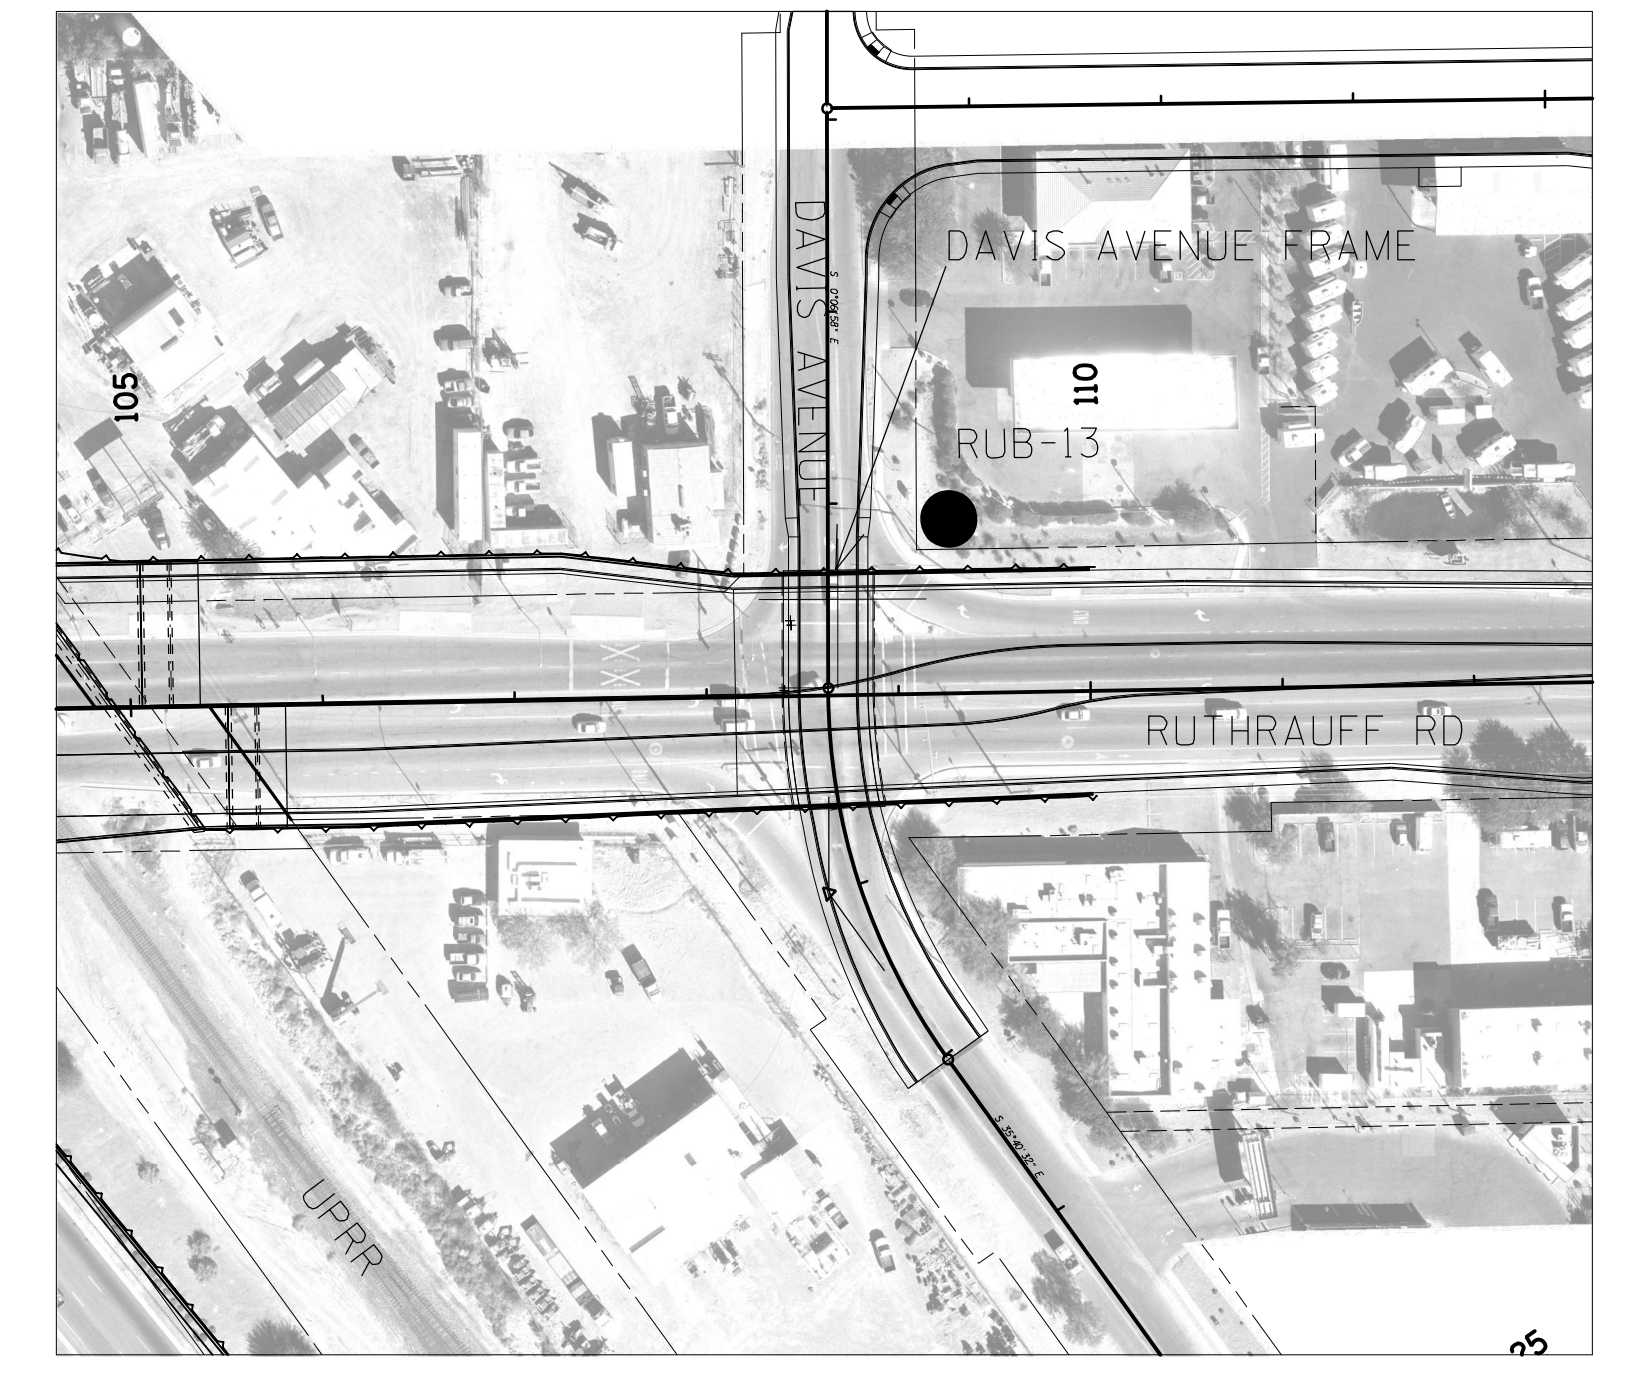

- PHASE 1 BORING LOCATION
- PHASE 2 BORING LOCATION

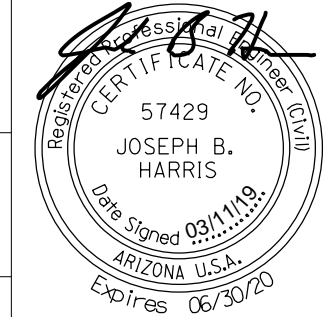DESIGN	JBH	DATE	3-19	<b>ARIZONA DEPARTMENT OF TRANSPORTATION</b> <b>INFRASTRUCTURE DELIVERY AND OPERATIONS DIVISION</b> <b>BRIDGE GROUP</b>			
DRAWN	JBH	3-19	<b>STA 20+</b> <b>DAVIS AVENUE FRAME</b> <b>FOUNDATION DATA (4 OF 5)</b>				
CHECKED	KW	3-19	LOCATION <b>RUTHRAUFF ROAD T.I.</b>				
<b>SCE ENGINEERING</b> 510 E. 4TH STREET TUCSON, AZ 85705 520-405-1353		ROUTE <b>I-10</b> <b>252.00</b> <b>11551</b>		MILEPOST    STRUCTURE NO.		DWG NO.	<b>S-3.10</b>
TRACS NO. <b>H8480 OIC</b>				<b>010-D(213)S</b>			



F.H.W.A. REGION	STATE	PROJECT NO.	SHEET NO.	TOTAL SHEETS	RECORD DRAWING
9	ARIZ.	010-D(213)S	702	849	

010 PM 252

**SCE BORING LOG: RUW-SE13 (1 of 2)**  
 108+13, 61 Rt. (Ref. Al. Ruthrauff CL)  
 NORTHING: 471,929 EASTING: 975,032  
 ELEV.: 2,246.3 TOTAL DEPTH: 98.1  
 STARTED: 09/03/2013 07:00 AM  
 FINISHED: 09/03/2013 02:20 PM  
 CONTRACTOR: GSI  
 DRILLER: R. Quezada  
 INSPECTOR: C. Lavayen  
 RIG TYPE: Truck mt. CME 95  
 DRILLING METHOD: 8" OD HSA  
 HAMMER TYPE: Auto Hammer  
 SCE PROJECT #: J2009-14/J2012-07


DEPTH (FT)	ELEV. (FT)	GRAPHIC	SAMPLE			SAMPLER TYPES	Type	Symbol	Description	I.D.	O.D.	Length	VISUAL SOIL IDENTIFICATION / DESCRIPTION AND REMARKS
			TYPE	SYMBOL	BLOWS								
							S	⊗	Split Spoon	1.375"	2"	18"	
							R	■	Ring Sampler	2.5"	3"	18"	
							U	□	Shelby Tube				
2245			R	■	3-13								FAT CLAY WITH SAND (native), medium stiff, moist, brown, high plasticity CLAY, little fine to coarse sand, few fine subrounded to subangular gravel, weak cementation, strong reaction with HCl, max. particle size 0.75". (CH)
2240			CU	⊗	5-2-2								Becomes soft.
2235			S	⊗	5-5-6								LEAN CLAY WITH SAND, stiff, moist, brown, medium plasticity CLAY, little fine sand, weak cementation, strong reaction with HCl. (CL)
2230			R	■	6-8								Becomes medium stiff.
2225			S	⊗	5-7-10								WELL-GRADED SAND WITH CLAY, medium dense, dry to moist, dark orange, fine to coarse SAND, few fine subrounded to subangular gravel, few medium plasticity fines, no cementation, no reaction with HCl, max. particle size 0.25". (SW-SC)
2220			S	⊗	7-4-4								Becomes loose.
2215			R	■	22-20								WELL-GRADED GRAVEL WITH SILTY CLAY AND SAND, medium dense, dry to moist, brown, fine to coarse subrounded to subangular GRAVEL, some fine to coarse sand, few low plasticity fines, no cementation, weak reaction with HCl, max. particle size 1.5". (GW-GC)
2210			S	⊗	23-29-50/4								Becomes very dense, max. particle size 1".
2205			S	⊗	50/6								Becomes dry, gray-brown, fine subrounded to subangular GRAVEL, no reaction with HCl, max. particle size 0.5".
2200			S	⊗	50/5								CLAYEY SAND WITH GRAVEL, very dense, dry, gray, fine to coarse SAND, little fine subangular to angular gravel, little medium plasticity fines, no cementation, no reaction with HCl, max. particle size 0.5". (SC)
2195			S	⊗	50/2								Becomes CLAYEY SAND, moist, brown, few fine to coarse subrounded to subangular gravel, max. particle size 1".
2190			S	⊗	40-24-23								Becomes CLAYEY SAND WITH GRAVEL, dense, some fine to coarse subrounded to subangular gravel, max. particle size 1.5".
2185			R	■	19-30								WELL-GRADED SAND WITH CLAY AND GRAVEL, medium dense, moist, brown, fine to coarse SAND, little fine subrounded to subangular gravel, few medium plasticity fines, no cementation, no reaction with HCl, max. particle size 0.5". (SW-SC)
2180			S	⊗	20-23-27								Becomes dense.

**SCE BORING LOG: RUW-SE13 (2 of 2)**  
 108+13, 61 Rt. (Ref. Al. Ruthrauff CL)  
 NORTHING: 471,929 EASTING: 975,032  
 ELEV.: 2,246.3 TOTAL DEPTH: 98.1  
 STARTED: 09/03/2013 07:00 AM  
 FINISHED: 09/03/2013 02:20 PM  
 CONTRACTOR: GSI  
 DRILLER: R. Quezada  
 INSPECTOR: C. Lavayen  
 RIG TYPE: Truck mt. CME 95  
 DRILLING METHOD: 8" OD HSA  
 HAMMER TYPE: Auto Hammer  
 SCE PROJECT #: J2009-14/J2012-07

DEPTH (FT)	ELEV. (FT)	GRAPHIC	SAMPLE			SAMPLER TYPES	Type	Symbol	Description	I.D.	O.D.	Length	VISUAL SOIL IDENTIFICATION / DESCRIPTION AND REMARKS
			TYPE	SYMBOL	BLOWS								
2175			S	⊗	26-25-25								Becomes dry to moist, weak reaction with HCl, max. particle size 0.75".
2170			S	⊗	24-26-35								Becomes very dense.
2165			R	■	35-45								POORLY-GRADED GRAVEL WITH CLAY AND SAND, dense, dry to moist, brown, fine subrounded to subangular GRAVEL, some fine to coarse sand, few medium plasticity fines, no cementation, no reaction with HCl, max. particle size 0.5". (GP-GC)
2160			S	⊗	38-50/6								Becomes very dense. Added 5 gallons of water to boring at 85'.
2155			S	⊗	21-29-48								CLAYEY SAND WITH GRAVEL, very dense, moist, brown, fine to coarse SAND, little fine subrounded to subangular gravel, little medium plasticity fines, weak cementation, no reaction with HCl, max. particle size 0.75". (SC)
2150			S	⊗	22-30-45								Becomes no cementation.
2145			R	■	50/1								No recovery. End of boring at 98'. Stopped sampler at 98.1'. No groundwater encountered. Backfilled with portland cement and sand mixture.

**BORING PLAN**

SCALE 1:100

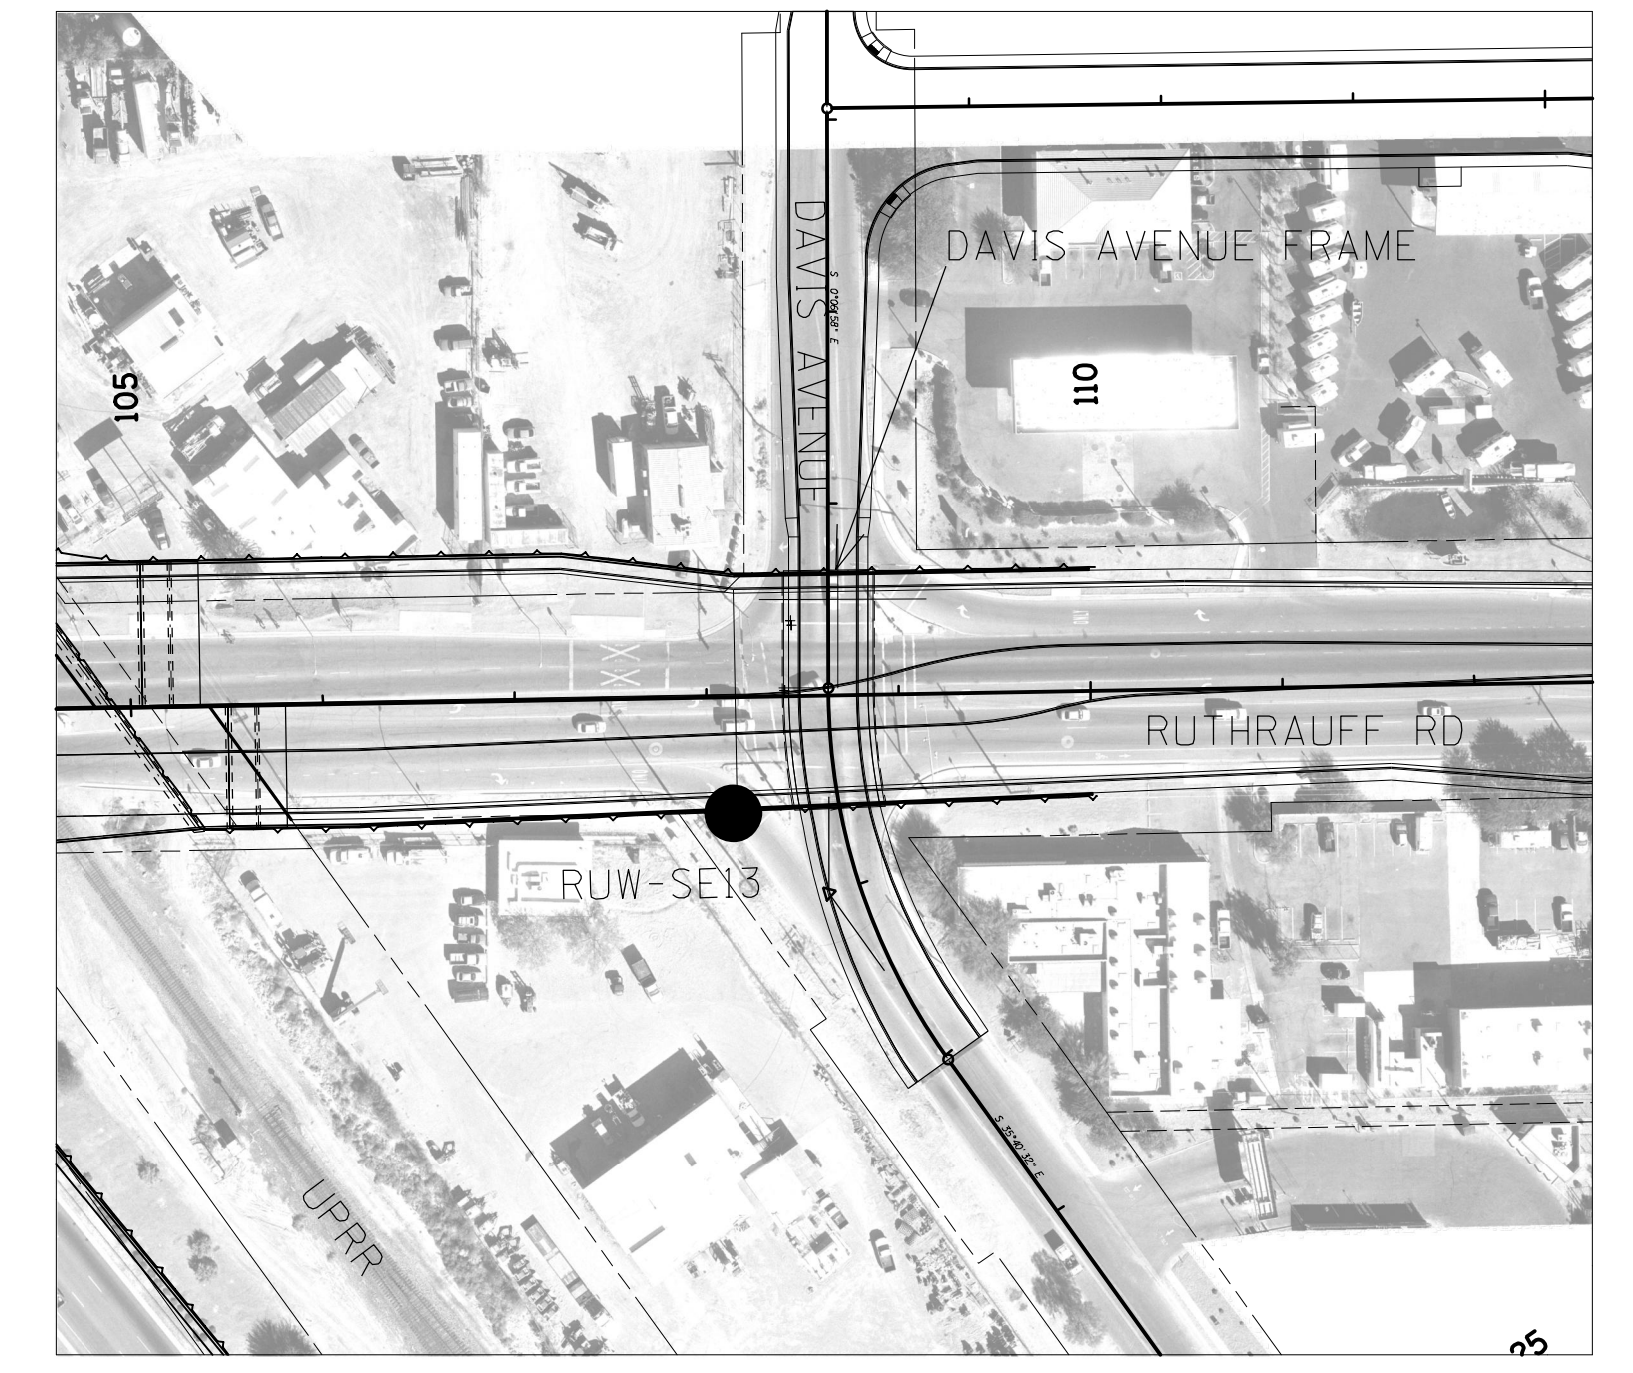

- PHASE 1 BORING LOCATION
- PHASE 2 BORING LOCATION

DESIGN	JBH	DATE	3-19	<b>ARIZONA DEPARTMENT OF TRANSPORTATION</b> <b>INFRASTRUCTURE DELIVERY AND OPERATIONS DIVISION</b> <b>BRIDGE GROUP</b>  <b>STA 20+ DAVIS AVENUE FRAME</b> <b>FOUNDATION DATA (5 OF 5)</b>	
DRAWN	JBH	3-19			
CHECKED	KW	3-19			
<b>SCE ENGINEERING</b> 510 E. 4TH STREET TUCSON, AZ 85705 520-405-1353		LOCATION	RUTHRAUFF ROAD T.I.	DWG NO.	S-3.11
I-10 ROUTE 252.00 MILEPOST 11551 STRUCTURE NO.		TRACS NO. H8480 OIC		010-D(213)S OF	






INDEX OF DRAWINGS

Dwg. No.	Drawing Name
S-7.01	Retaining Wall - Key Plan & Index
S-7.02	Retaining Wall - General Notes & Quantities
S-7.03	Retaining Wall - Plan & Elevation - Wall WB-1 (1 of 3)
S-7.04	Retaining Wall - Plan & Elevation - Wall WB-1 (2 of 3)
S-7.05	Retaining Wall - Plan & Elevation - Wall WB-1 (3 of 3)
S-7.06	Retaining Wall - Plan & Elevation - Wall WB-2
S-7.07	Retaining Wall - Plan & Elevation - Wall WB-3 (1 of 4)
S-7.08	Retaining Wall - Plan & Elevation - Wall WB-3 (2 of 4)
S-7.09	Retaining Wall - Plan & Elevation - Wall WB-3 (3 of 4)
S-7.10	Retaining Wall - Plan & Elevation - Wall WB-3 (4 of 4)
S-7.11	Retaining Wall - Plan & Elevation - Wall WB-4 (1 of 3)
S-7.12	Retaining Wall - Plan & Elevation - Wall WB-4 (2 of 3)
S-7.13	Retaining Wall - Plan & Elevation - Wall WB-4 (3 of 3)
S-7.14	Retaining Wall - Plan & Elevation - Wall EB-1
S-7.15	Retaining Wall - Plan & Elevation - Wall EB-2 (1 of 3)
S-7.16	Retaining Wall - Plan & Elevation - Wall EB-2 (2 of 3)
S-7.17	Retaining Wall - Plan & Elevation - Wall EB-2 (3 of 3)
S-7.18	Retaining Wall - Plan & Elevation - Wall RRN-1 (1 of 2)
S-7.19	Retaining Wall - Plan & Elevation - Wall RRN-1 (2 of 2)
S-7.20	Retaining Wall - Plan & Elevation - Wall RRS-1 (1 of 2)
S-7.21	Retaining Wall - Plan & Elevation - Wall RRS-1 (2 of 2)
S-7.22	Retaining Wall - Plan & Elevation - Wall RR-1
S-7.23	Retaining Wall - Plan & Elevation - Wall RR-2
S-7.24	Retaining Wall - Plan & Elevation - Wall RR-3
S-7.25	Retaining Wall - Plan & Elevation - Wall RR-4
S-7.26	Retaining Wall - Details (1 of 6)
S-7.27	Retaining Wall - Details (2 of 6)
S-7.28	Retaining Wall - Details (3 of 6)
S-7.29	Retaining Wall - Details (4 of 6)
S-7.30	Retaining Wall - Details (5 of 6)
S-7.31	Retaining Wall - Details (6 of 6)

F.H.W.A. REGION	STATE	PROJECT NO.	SHEET NO.	TOTAL SHEETS	AS BUILT
9	ARIZ.	010-D(213)S	703	849	

010 PM 252

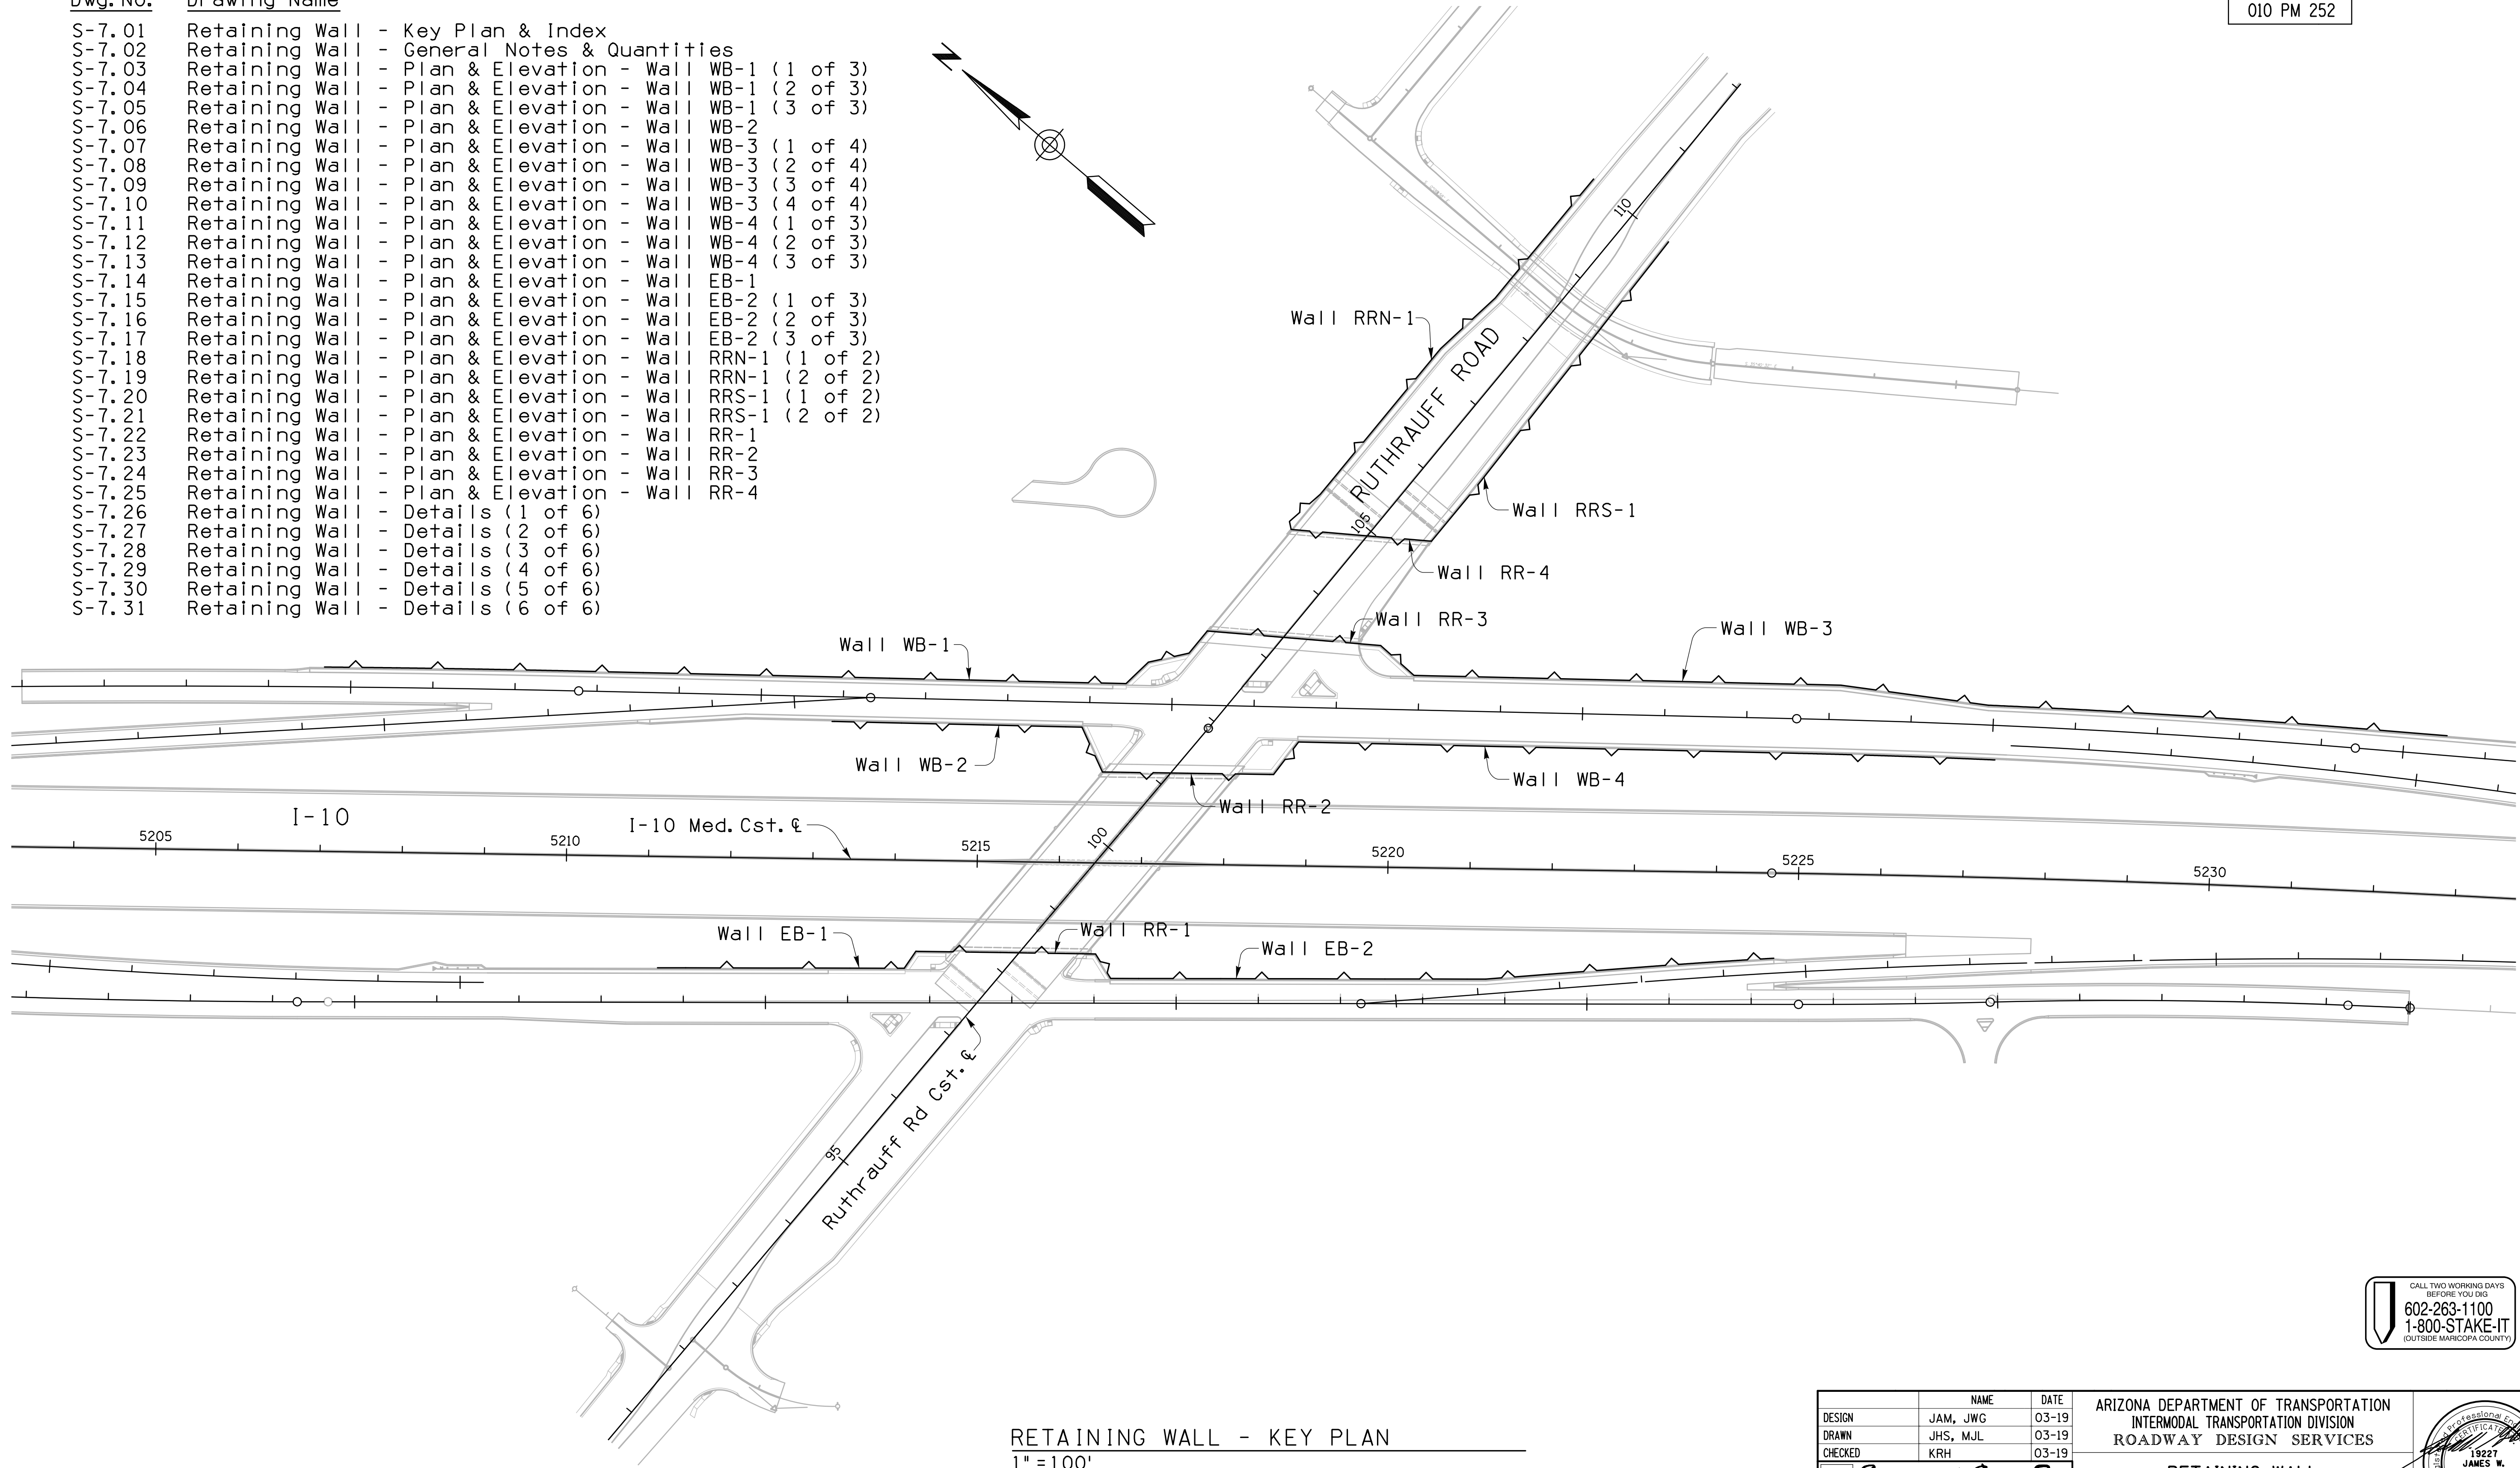


RETAINING WALL - KEY PLAN

1" = 100'

CALL TWO WORKING DAYS BEFORE YOU DIG  
602-263-1100  
1-800-STAKE-IT  
(OUTSIDE MARICOPA COUNTY)

DESIGN	JAM, JWG	03-19	ARIZONA DEPARTMENT OF TRANSPORTATION INTERMODAL TRANSPORTATION DIVISION ROADWAY DESIGN SERVICES
DRAWN	JHS, MJL	03-19	
CHECKED	KRH	03-19	
			RETAINING WALL KEY PLAN & INDEX Expires: 12/31/20
ROUTE	LOCATION		
I-10	RUTHRAUFF ROAD TI		DWG NO. S-7.01
TRACS NO. H 8480 01C		010-D(213)S	

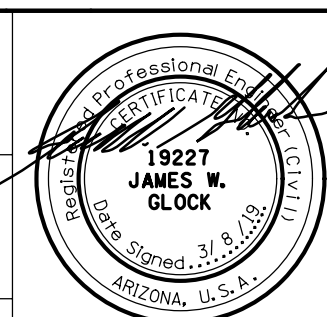



DATE- LOCATION- REVISIONS- FINISHED PLANS- SURVEY NO. DATE- LOCATION- REVISIONS- FINISHED PLANS- SURVEY NO.

**GENERAL NOTES**

Construction Specification:  
 Arizona Department of Transportation Standard Specifications for Road and Bridge Construction, 2008 Edition and the Special Provisions.

Design Specifications:  
 AASHTO LRFD Bridge Design Specifications, 6th Edition 2012.

The site is classified as Site Class D with Peak Ground Acceleration (PGA) = 0.120 and Spectrum Acceleration Coefficients: at Period 0.2 sec ( $S_s$ ) = 0.278 and at Period 1.0 sec ( $S_1$ ) = 0.118. The site is assigned to Seismic Zone 1.

Soil Properties - See Final Geotechnical Report by NCS Consultants, LLC, March 31, 2015.

All concrete shall be Class "S" ( $f'c \geq 3000$  psi).

Reinforcing steel shall conform to ASTM Specification A615. All reinforcing shall be furnished as Grade 60.

All bends and hooks for reinforcing steel shall meet the requirements of AASHTO LRFD Section 5.10.2. All bend dimensions for reinforcing steel shall be out-to-out of bars. All placement dimensions for reinforcing steel shall be to center of bars unless noted otherwise.

All reinforcing shall have 2 inches clear cover unless noted otherwise.

All mechanical splices shall conform to the requirements for mechanical connections in Section 605-3.02 of the Standard Specifications.

Utilities - The Contractor shall coordinate all existing conditions during construction of the project. Utility information & locations shown on the plans are approximate and may not be complete or accurately depict the location of all existing, new, relocated and abandoned utilities with the project plans and notify respective owners before commencing the work of excavation and any temporary shoring construction. Conflicts shall be brought to the attention of the Engineer and resolved prior to proceeding with the work. See roadway and utility drawings for additional information.

Temporary Shoring - The Contractor shall be responsible for providing temporary shoring as required to maintain traffic, to protect utilities, for protection of workers, or as otherwise needed to accomplish the work. The Contractor will submit a plan outlining construction procedures, shoring requirements, and design to the Engineer for review and approval prior to proceeding with the work. See Standard Specifications and Special Provisions for additional information.

**GENERAL NOTES (CONT'D)**

Geometry for all retaining walls is referenced to the Wall Layout Line.

Length of wall segments is measured along the Wall Layout Line.

Refer to roadway drawings for flowline elevations, roadway horizontal alignment and roadway typical section information.

The thickness of the rustication shall be considered as an addition to the wall thickness. Rustication and surface texture shall extend to a minimum of 1'-0" below final grade.

All exposed surfaces of walls shall be painted to a minimum depth of 1'-0" below final grade. Retaining walls shall be painted in accordance with the Standard Specifications and Special Provisions unless noted otherwise.

Rustication shall be provided for all walls in accordance with the Architectural Treatment Details and Special Provisions.

Mechanically Stabilized Earth (MSE) retaining walls are to be designed by the MSE wall manufacturer and constructed in accordance with the Manufacturer's recommendations and the Special Provisions.

Reinforced backfill and retained backfill for MSE Walls shall be paid under Item No. 2030509 Structure Backfill (MSE Wall Backfill).

Dimensions shall not be scaled from drawings.

Chamfer all exposed corners 3/4" unless noted otherwise.

RETAINING WALL APPROXIMATE QUANTITIES		
Retaining Wall Mark	Retaining Wall 5 1/2" (MSE Wall) (SF)	Retaining Wall 30" (MSE Wall) (SF)
WB-1	23,003	
WB-2	5,352	
WB-3	6,591	21,897
WB-4	18,529	
EB-1	4,296	
EB-2	10,931	
RRN-1	17,830	
RRS-1	13,839	
RR-1	5,421	
RR-2	7,194	
RR-3	3,661	4,586
RR-4	2,775	3,813
<b>TOTAL</b>	<b>119,423</b>	<b>30,296</b>
<b>AS-BUILT TOTAL</b>		


Approximate quantities for overexcavation and structural excavation for MSE walls will not be paid for separately. The cost for those items is considered included in the square foot cost of the walls.

F.H.W.A. REGION	STATE	PROJECT NO.	SHEET NO.	TOTAL SHEETS	AS BUILT
9	ARIZ.	010-D(213)S	704	849	


010 PM 252

**LEGEND:**

Detail Marker

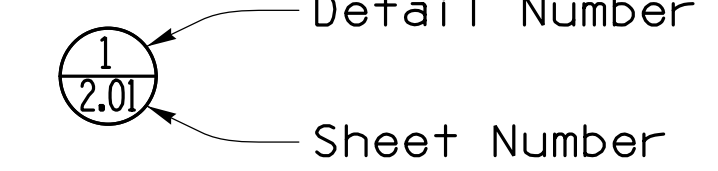

Section Marker

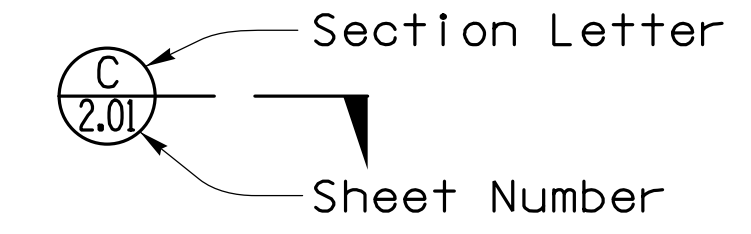

**Note:**

A line (-) in place of the Sheet number indicates that the SECTION or DETAIL is located on the same Sheet that the SECTION or DETAIL is cut.




DESIGN	JAM, JWG	03-19	ARIZONA DEPARTMENT OF TRANSPORTATION INTERMODAL TRANSPORTATION DIVISION ROADWAY DESIGN SERVICES	
DRAWN	JHS, MJL	03-19		
CHECKED	KRH	03-19		
			<b>RETAINING WALL GENERAL NOTES &amp; QUANTITIES</b>	
ROUTE	LOCATION		RUTHRAUFF ROAD TI	
I-10			TRACS NO. H 8480 01C	010-D(213)S
				DWG NO. S-7.02 <b>OF</b>

F.H.W.A. REGION	STATE	PROJECT NO.	SHEET NO.	TOTAL SHEETS	AS BUILT
9	ARIZ.	010-D(213)S	705	849	

010 PM 252

**CURVE DATA**

①	②
$\Delta = 0^{\circ}46'27''$	$\Delta = 1^{\circ}41'39''$
$R = 22942.44'$	$R = 22918.31'$
$L = 310.00'$	$L = 677.65'$
$T = 155.00'$	$T = 338.85'$

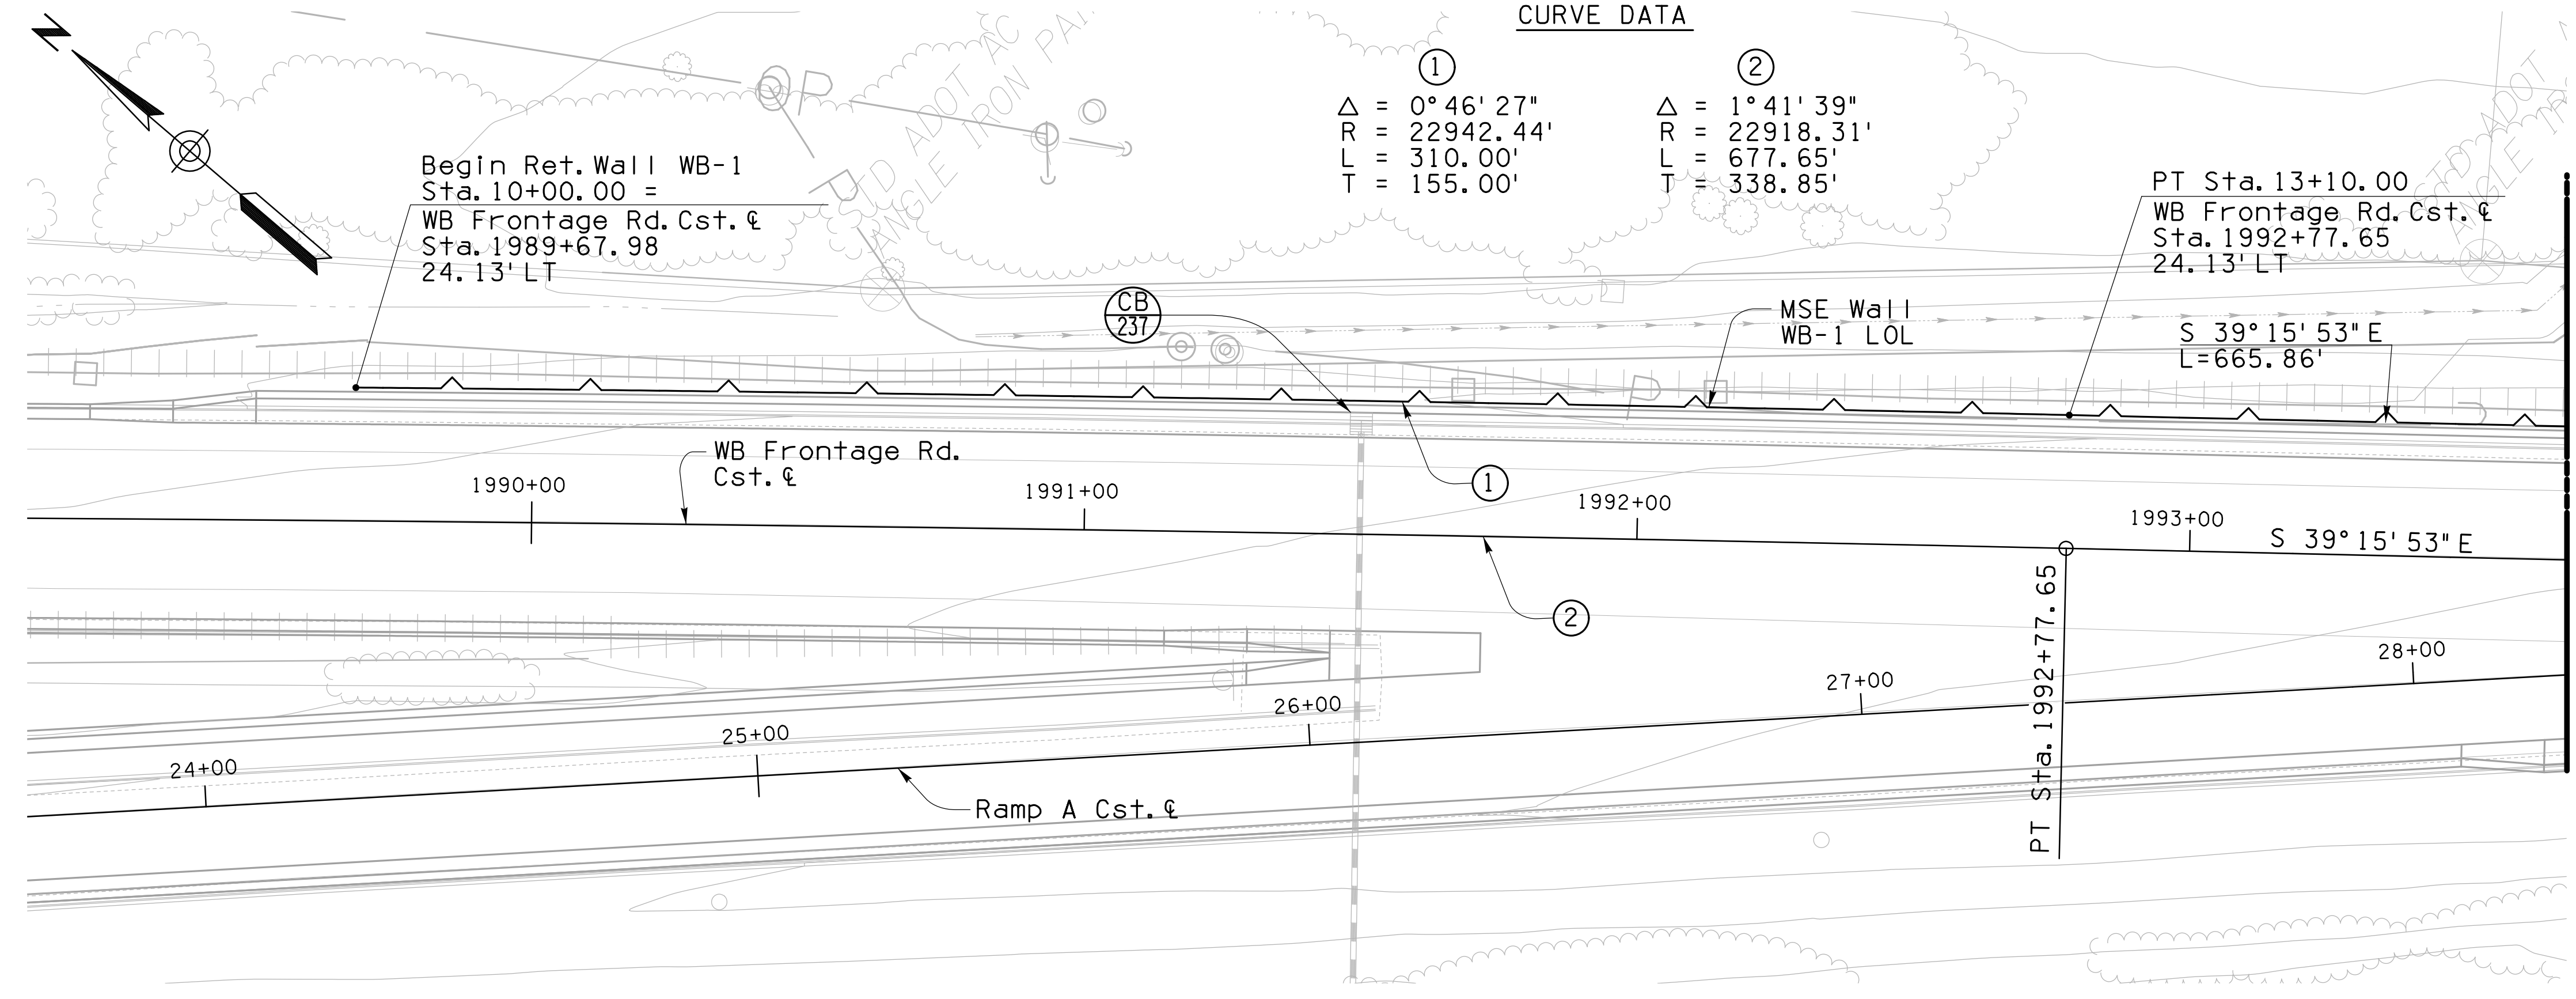


**PLAN - WALL WB-1 (MSE)**  
1" = 20'

**Note:**  
Contractor shall see Architectural Treatment Plans for the MSE icon designs, vertical rustication pattern and blank panel requirements. Full-scale mock-ups are required for each specific design.

Slip joints shall be positioned such that they do not bisect the architectural wall treatments. Not all of the slip joints are shown on the plans. The Contractor shall follow the Special Provisions for placement of the other required slip joint locations, plus other locations required per the wall manufacturer's design.

The location of all utilities is approximate. The contractor shall review the utility plans and potholing information to confirm the location of new and existing utilities prior to construction.

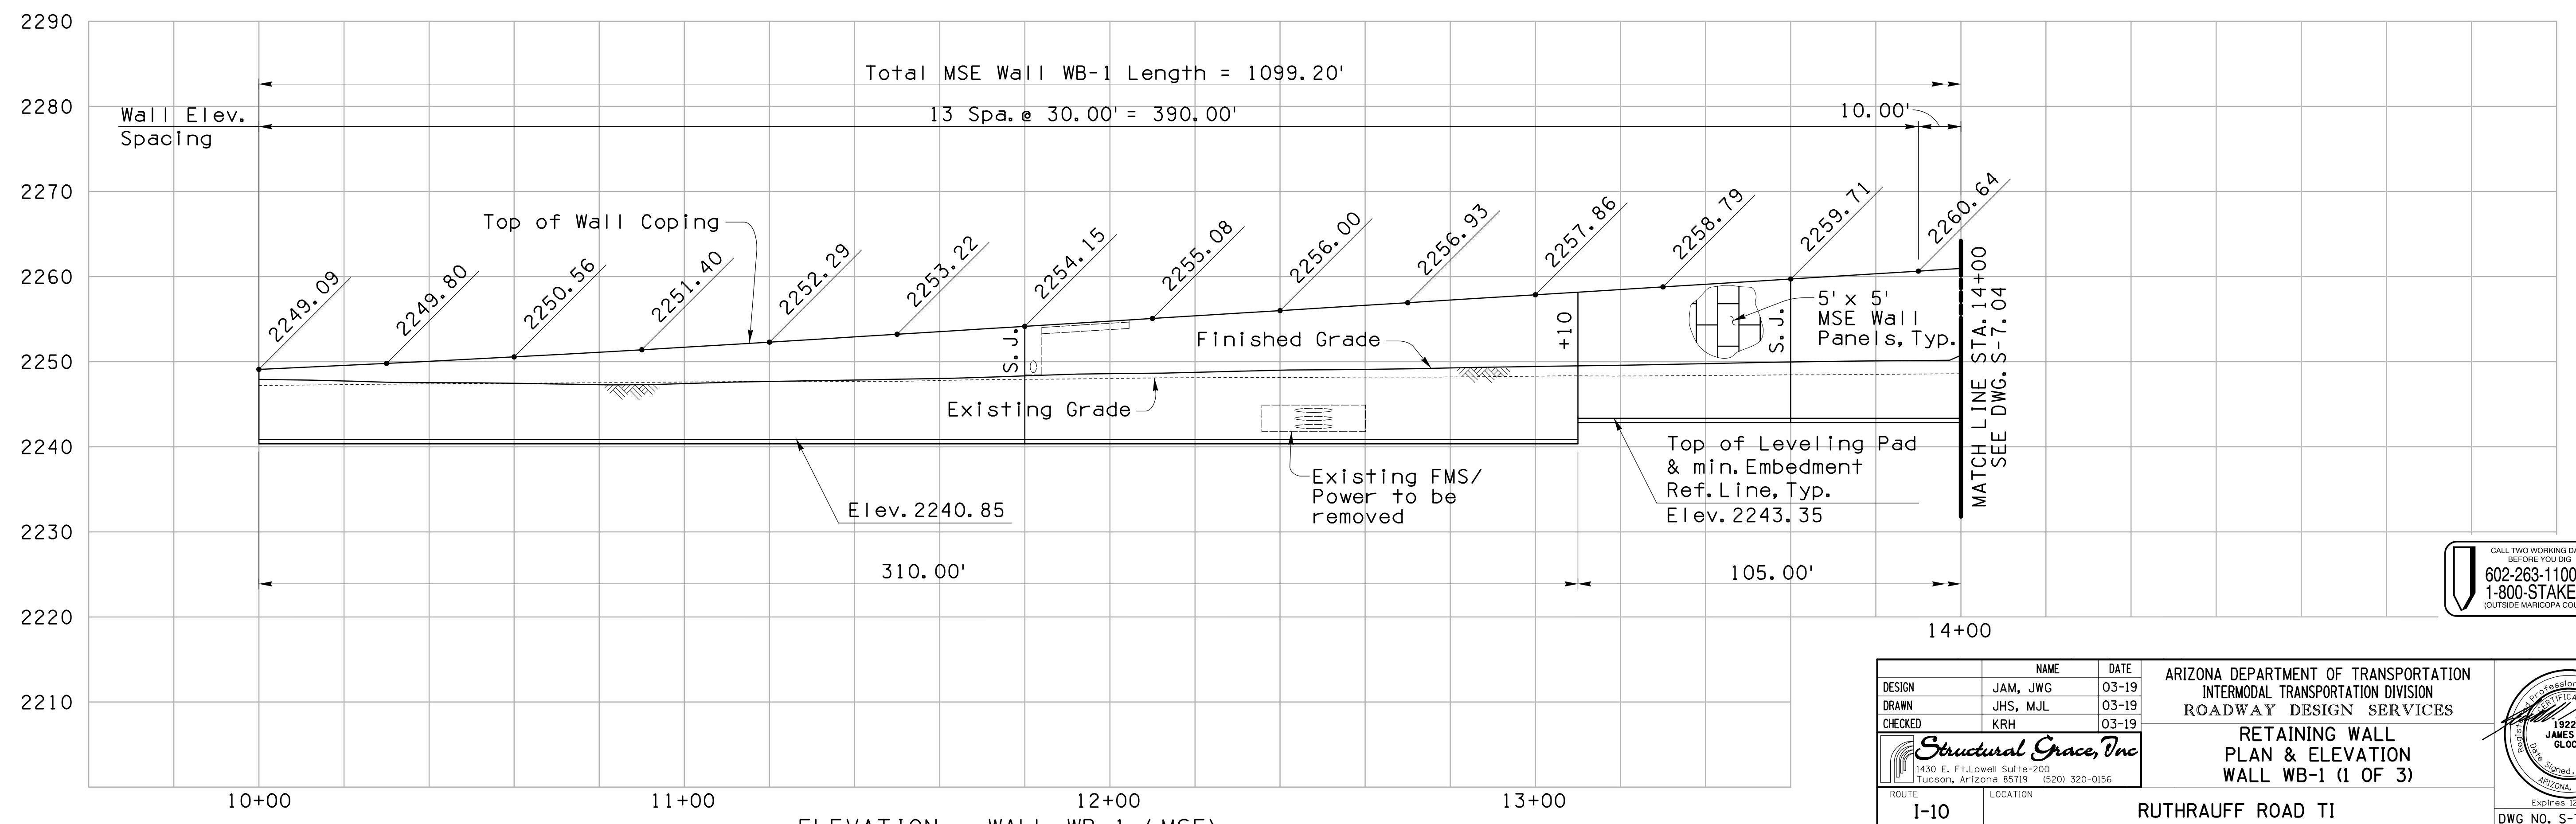


**ELEVATION - WALL WB-1 (MSE)**  
Horiz. : 1" = 20' ; Vert. 1" = 10'



DESIGN	JAM, JWG	03-19	ARIZONA DEPARTMENT OF TRANSPORTATION INTERMODAL TRANSPORTATION DIVISION ROADWAY DESIGN SERVICES
DRAWN	JHS, MJL	03-19	
CHECKED	KRH	03-19	
			<b>RETAINING WALL PLAN &amp; ELEVATION WALL WB-1 (1 OF 3)</b>
ROUTE	LOCATION		
I-10	RUTHRAUFF ROAD TI		
TRACS NO. H 8480 01C			
010-D(213)S			DWG NO. S-7.03

F.H.W.A. REGION	STATE	PROJECT NO.	SHEET NO.	TOTAL SHEETS	AS BUILT
9	ARIZ.	010-D(213)S	706	849	

010 PM 252

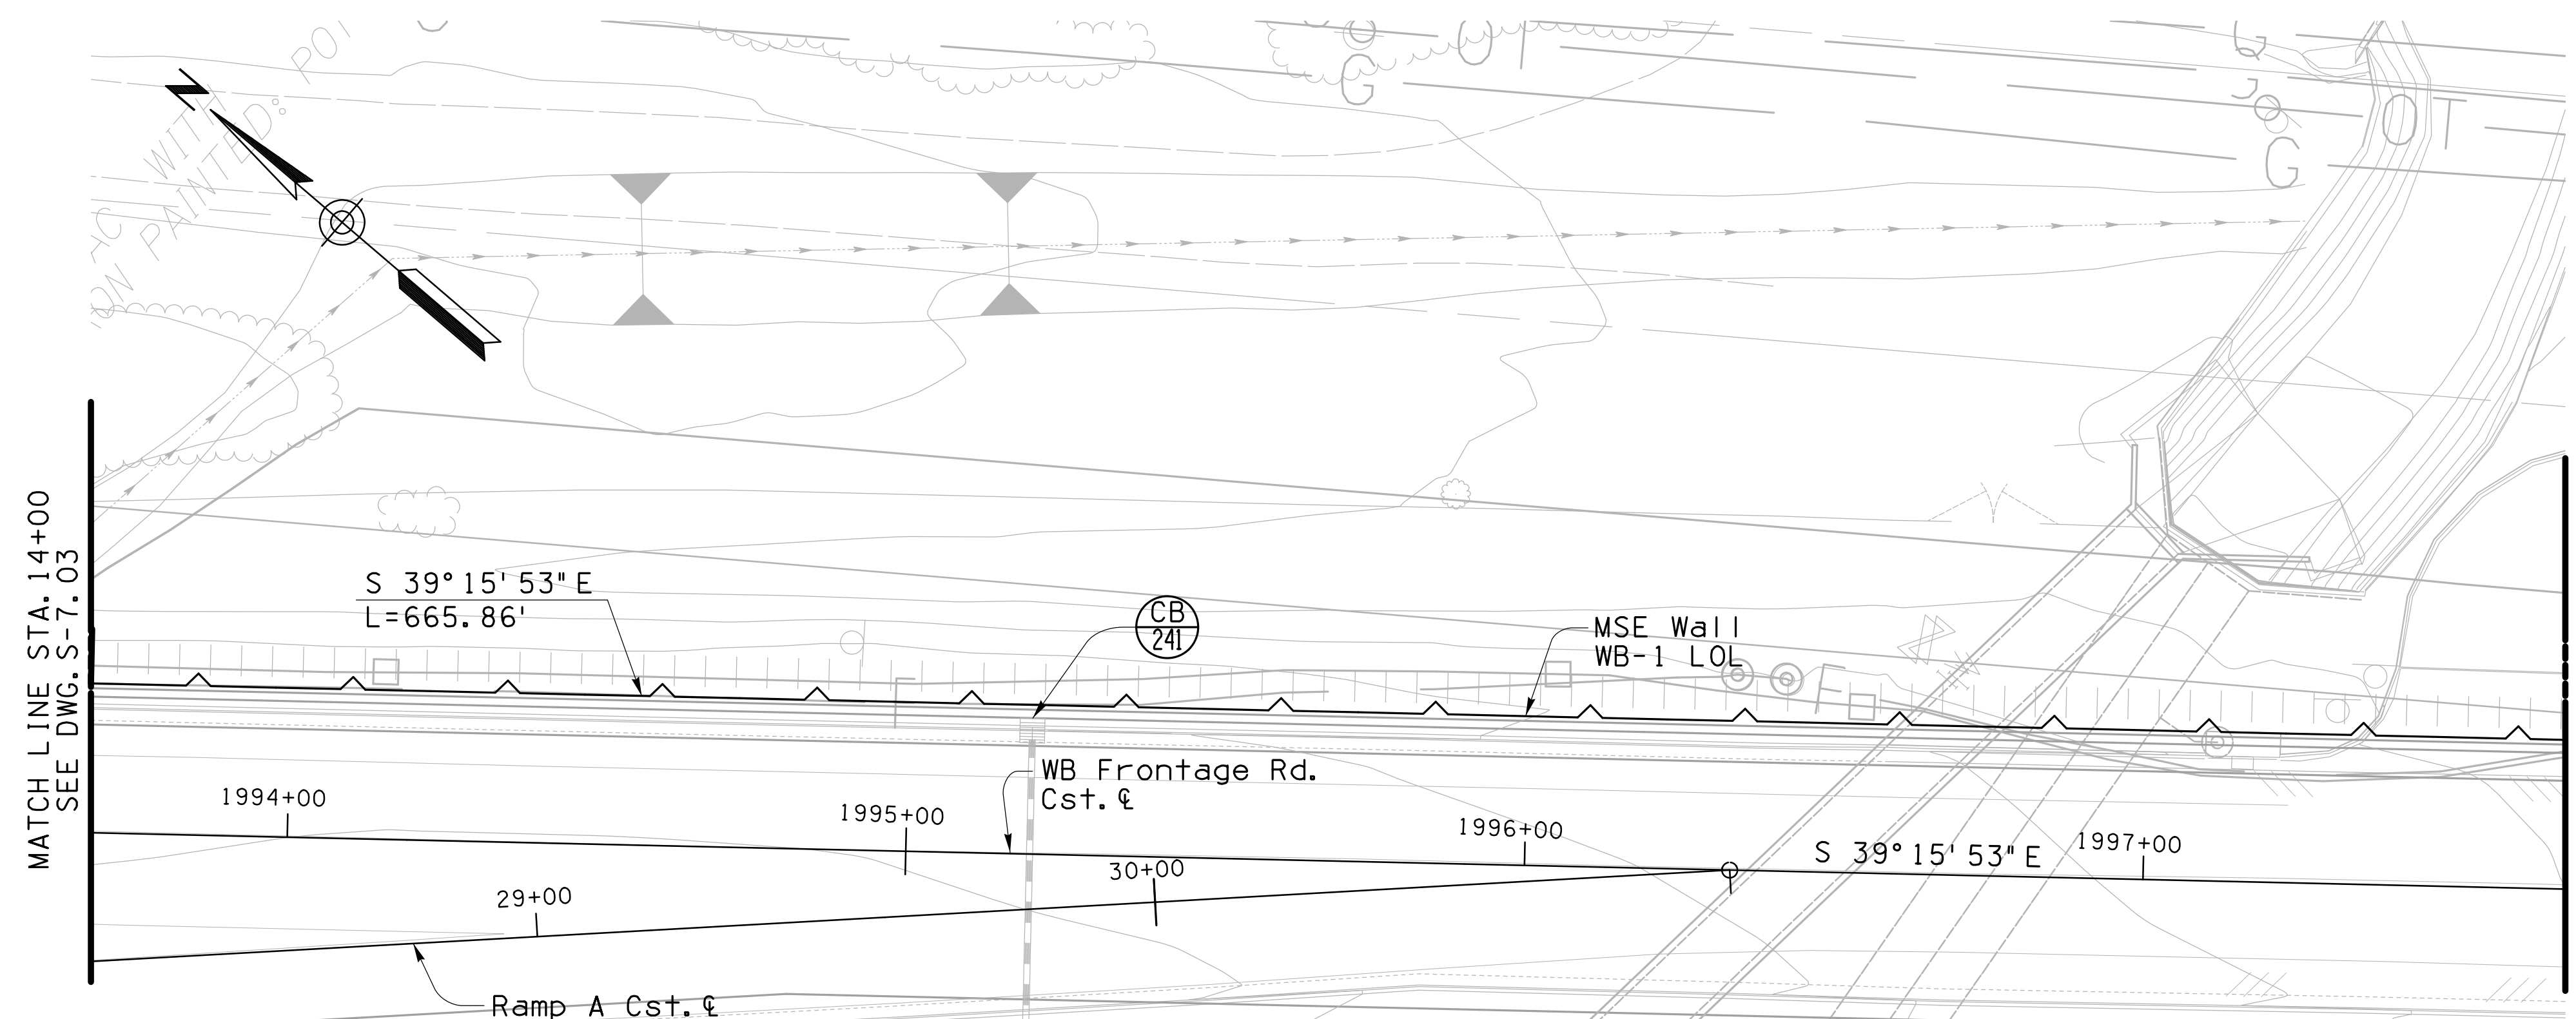


PLAN - WALL WB-1 (MSE)  
1" = 20'

**Note:**

Contractor shall see Architectural Treatment Plans for the MSE icon designs, vertical rustication pattern and blank panel requirements. Full-scale mock-ups are required for each specific design.

Slip Joints shall be positioned such that they do not bisect the architectural wall treatments. Not all of the slip joints are shown on the plans. The Contractor shall follow the Special Provisions for placement of the other required slip joint locations, plus other locations required per the wall manufacturer's design.


The location of all utilities is approximate. The contractor shall review the utility plans and potholing information to confirm the location of new and existing utilities prior to construction.

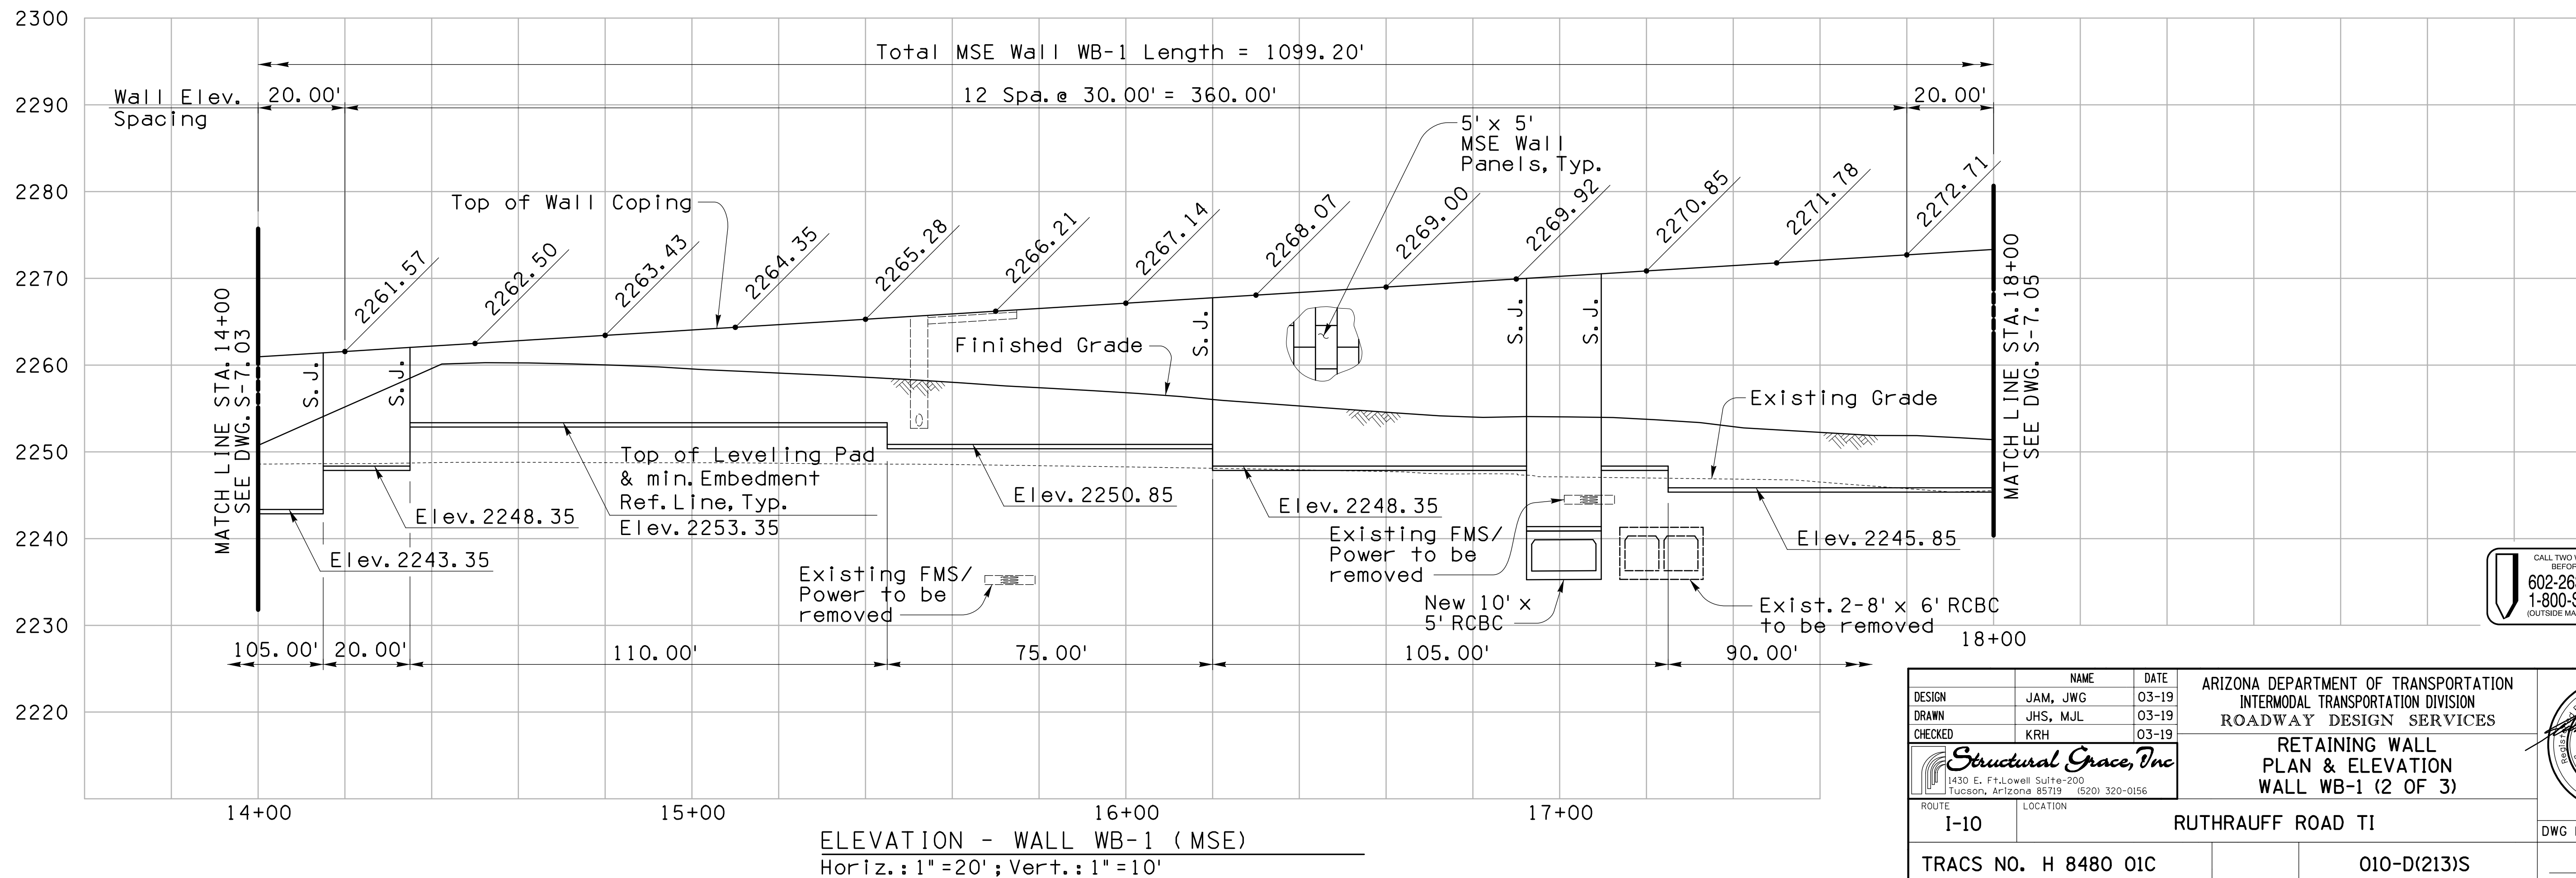

ELEVATION - WALL WB-1 (MSE)  
Horiz.: 1" = 20'; Vert.: 1" = 10'

CALL TWO WORKING DAYS BEFORE YOU DIG  
602-263-1100  
1-800-STAKE-IT  
(OUTSIDE MARICOPA COUNTY)

DESIGN	JAM, JWJ	03-19	ARIZONA DEPARTMENT OF TRANSPORTATION INTERMODAL TRANSPORTATION DIVISION ROADWAY DESIGN SERVICES
DRAWN	JHS, MJL	03-19	
CHECKED	KRH	03-19	
 1430 E. Ft. Lowell Suite 200 Tucson, Arizona 85719 (520) 320-0156			<b>RETAINING WALL PLAN &amp; ELEVATION WALL WB-1 (2 OF 3)</b>
ROUTE	I-10	LOCATION	RUTHRAUFF ROAD TI
TRACS NO.	H 8480 01C	PROJECT NO.	010-D(213)S
DATE	3/8/2019	DWG NO.	S-7.04

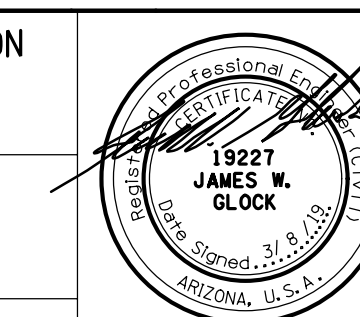


SURVEY NO. FINISHED PLANS DATE REVISIONS LOCATION DATE





F.H.W.A. REGION	STATE	PROJECT NO.	SHEET NO.	TOTAL SHEETS	AS BUILT
9	ARIZ.	010-D(213)S	708	849	

010 PM 252

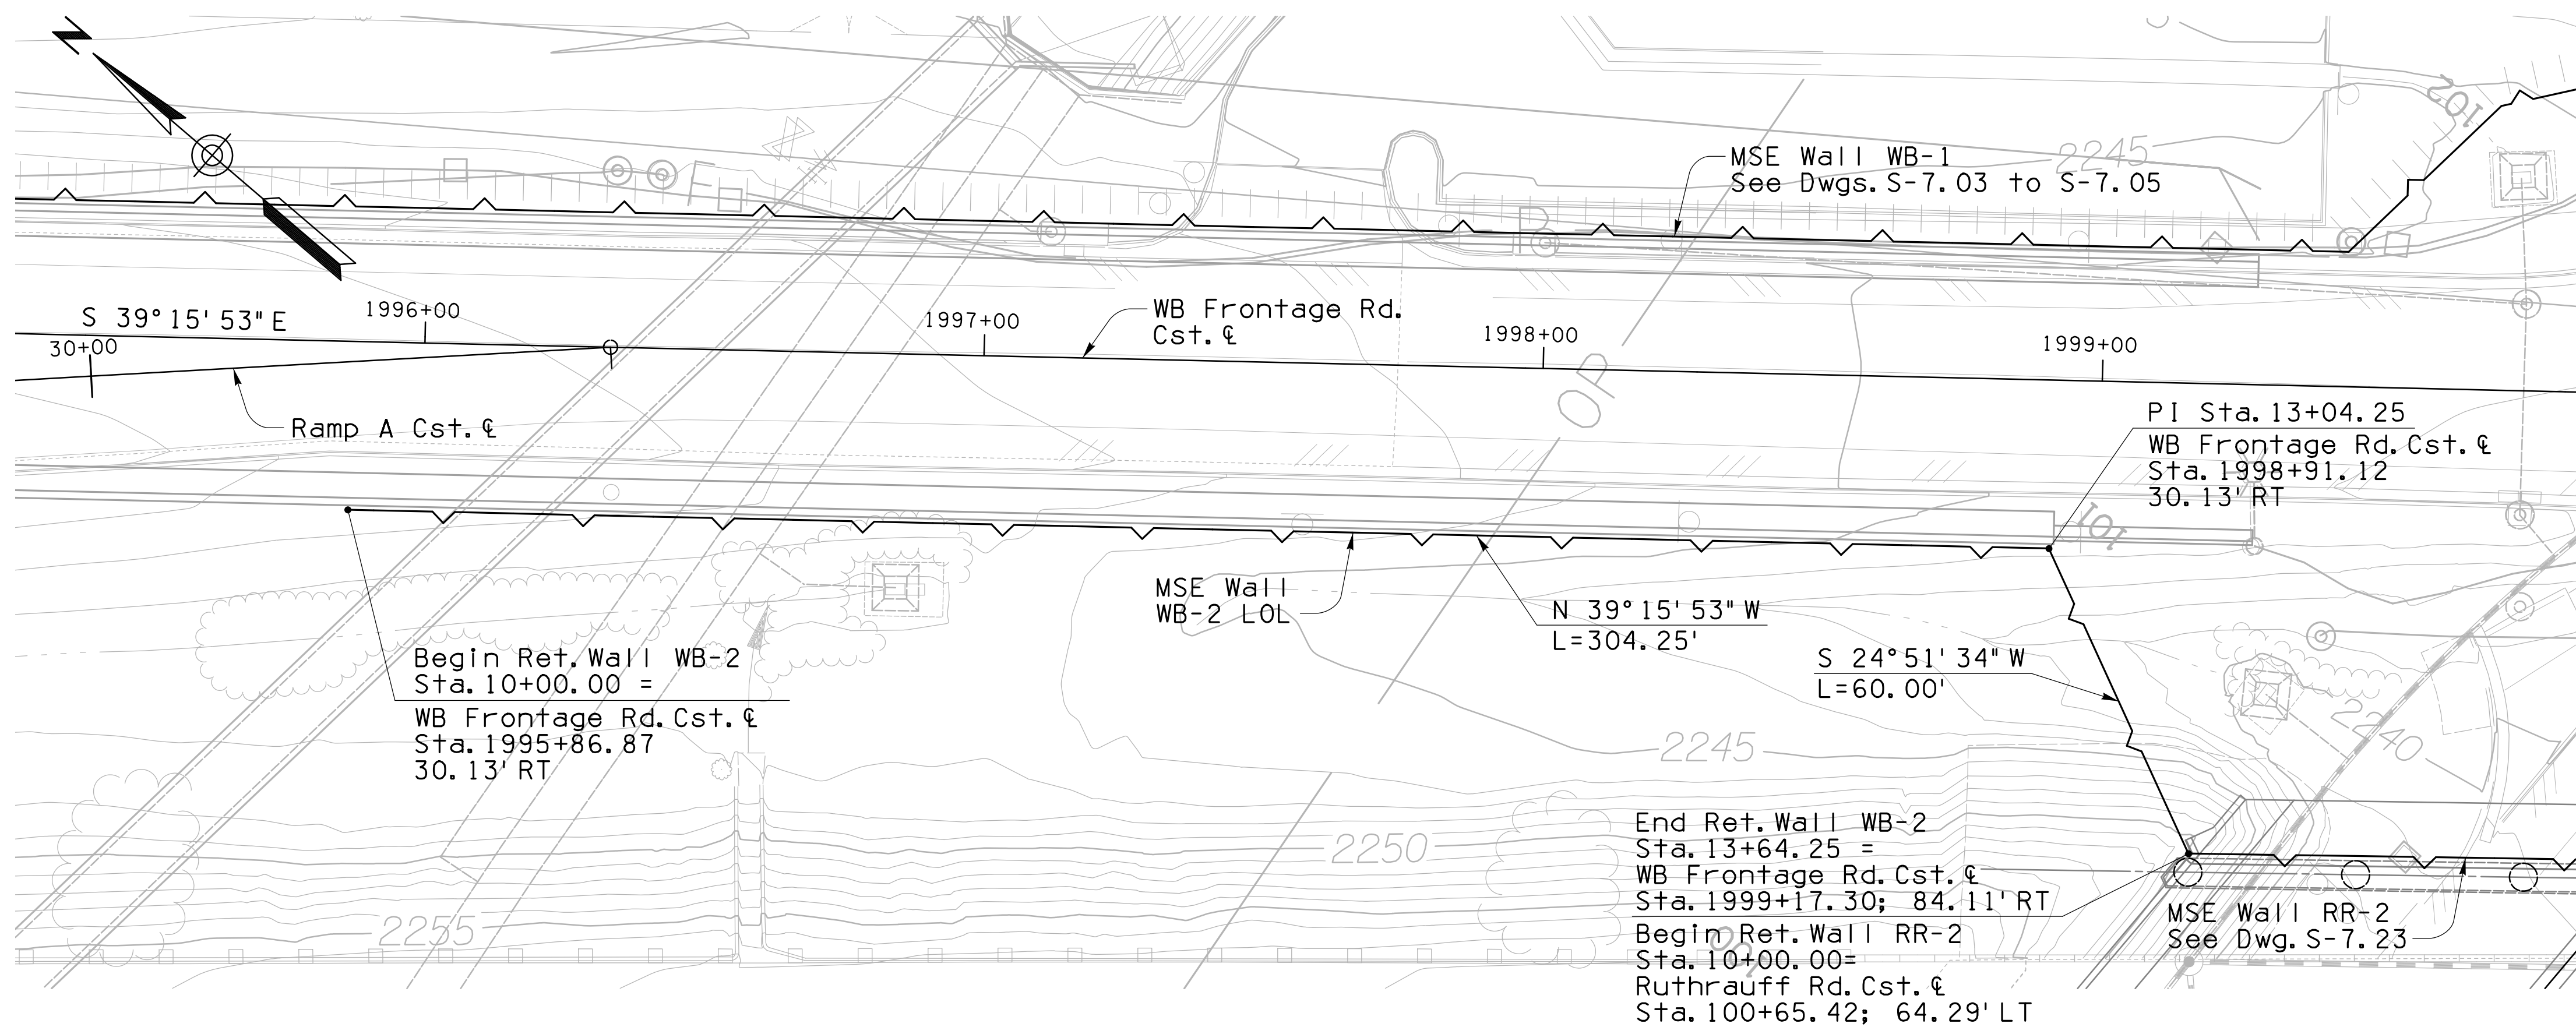


PLAN - WALL WB-2 (MSE)  
1" = 20'

**Note:**

Contractor shall see Architectural Treatment Plans for the MSE Icon designs, vertical rustication pattern and blank panel requirements. Full-scale mock-ups are required for each specific design.

Slip Joints shall be positioned such that they do not bisect the architectural wall treatments. Not all of the slip joints are shown on the plans. The Contractor shall follow the Special Provisions for placement of the other required slip joint locations, plus other locations required per the wall manufacturer's design.


The location of all utilities is approximate. The contractor shall review the utility plans and potholing information to confirm the location of new and existing utilities prior to construction.

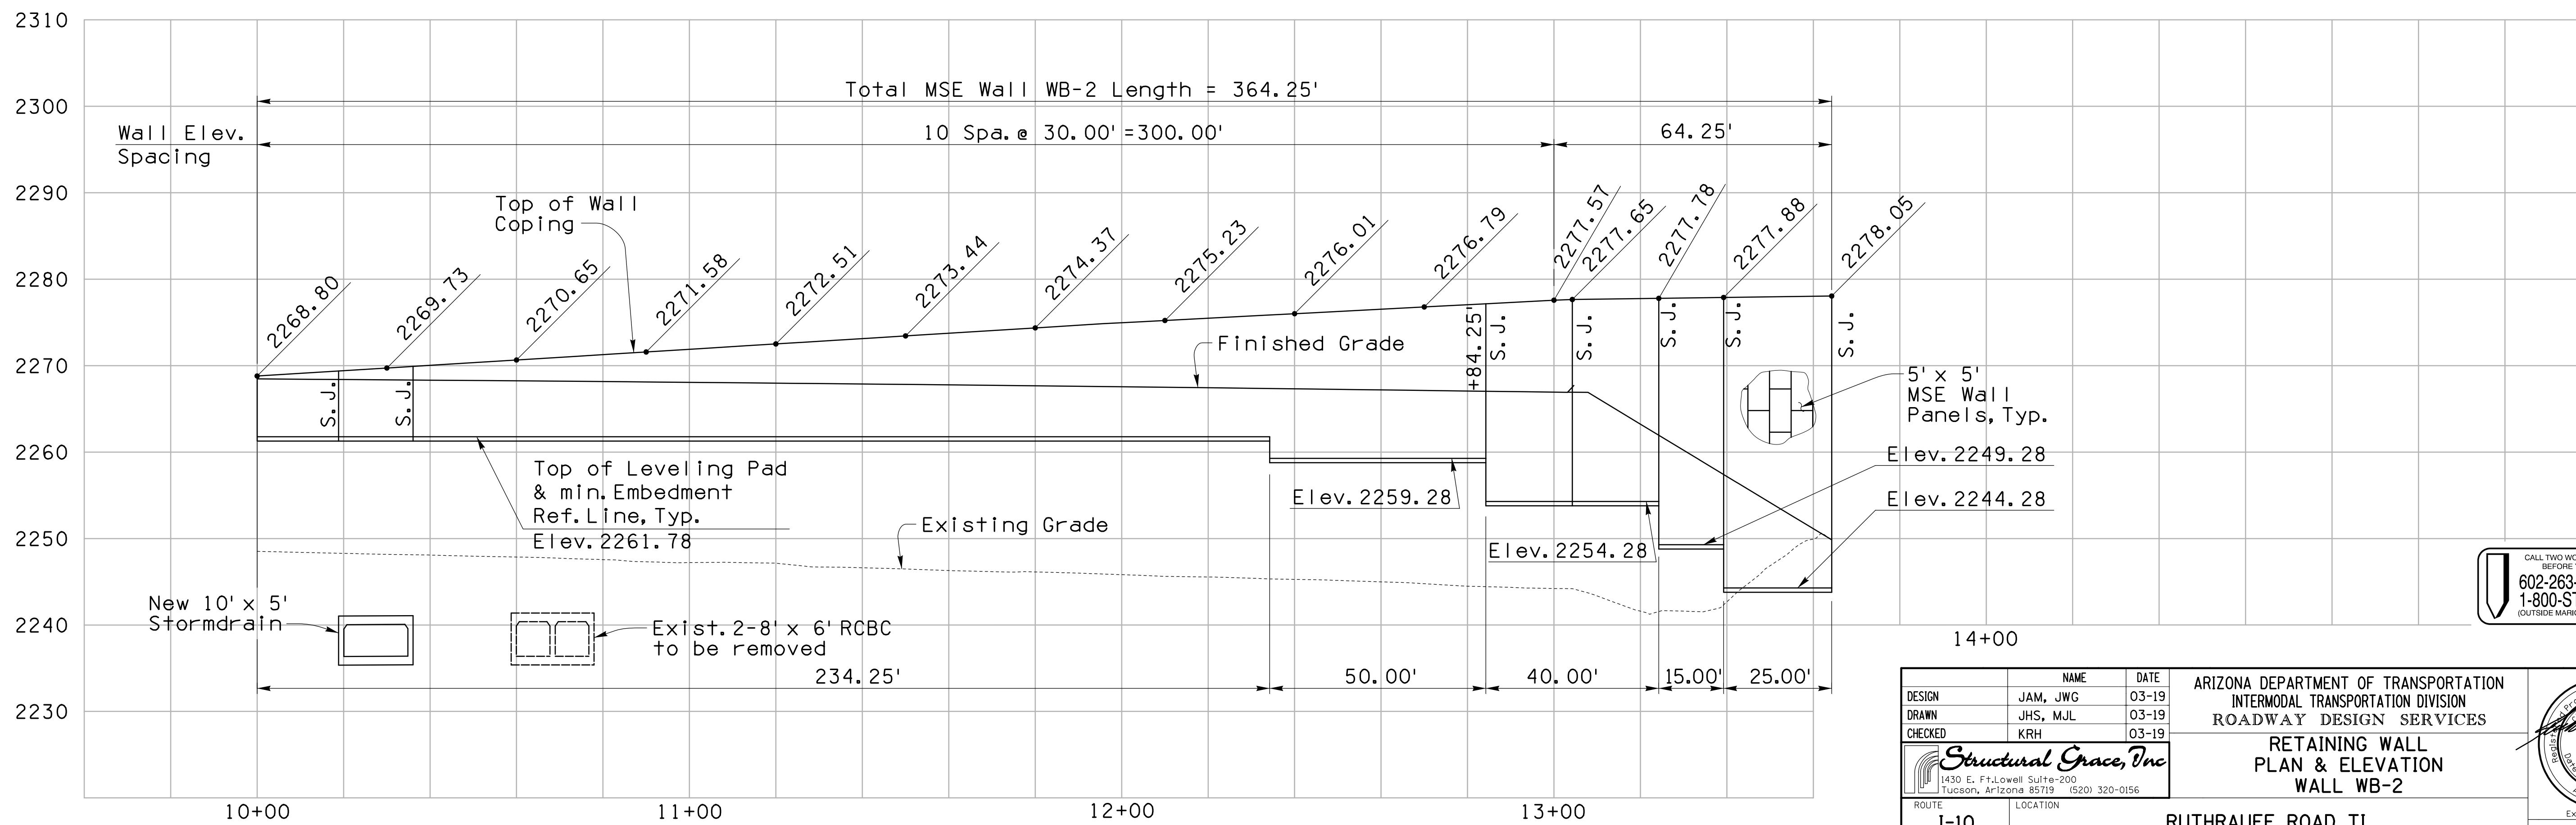

ELEVATION - WALL WB-2 (MSE)  
Horiz.: 1" = 20'; Vert.: 1" = 10'

CALL TWO WORKING DAYS BEFORE YOU DIG  
602-263-1100  
1-800-STAKE-IT  
(OUTSIDE MARICOPA COUNTY)

DESIGN	JAM, JWJ	03-19	ARIZONA DEPARTMENT OF TRANSPORTATION INTERMODAL TRANSPORTATION DIVISION ROADWAY DESIGN SERVICES
DRAWN	JHS, MJL	03-19	
CHECKED	KRH	03-19	
			<b>RETAINING WALL PLAN &amp; ELEVATION WALL WB-2</b>
ROUTE	I-10	LOCATION	
TRACS NO. H 8480 01C			010-D(213)S

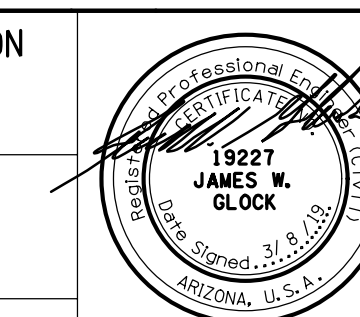


DWG NO. S-7.06

OF

F.H.W.A. REGION	STATE	PROJECT NO.	SHEET NO.	TOTAL SHEETS	AS BUILT
9	ARIZ.	010-D(213)S	709	849	

010 PM 252

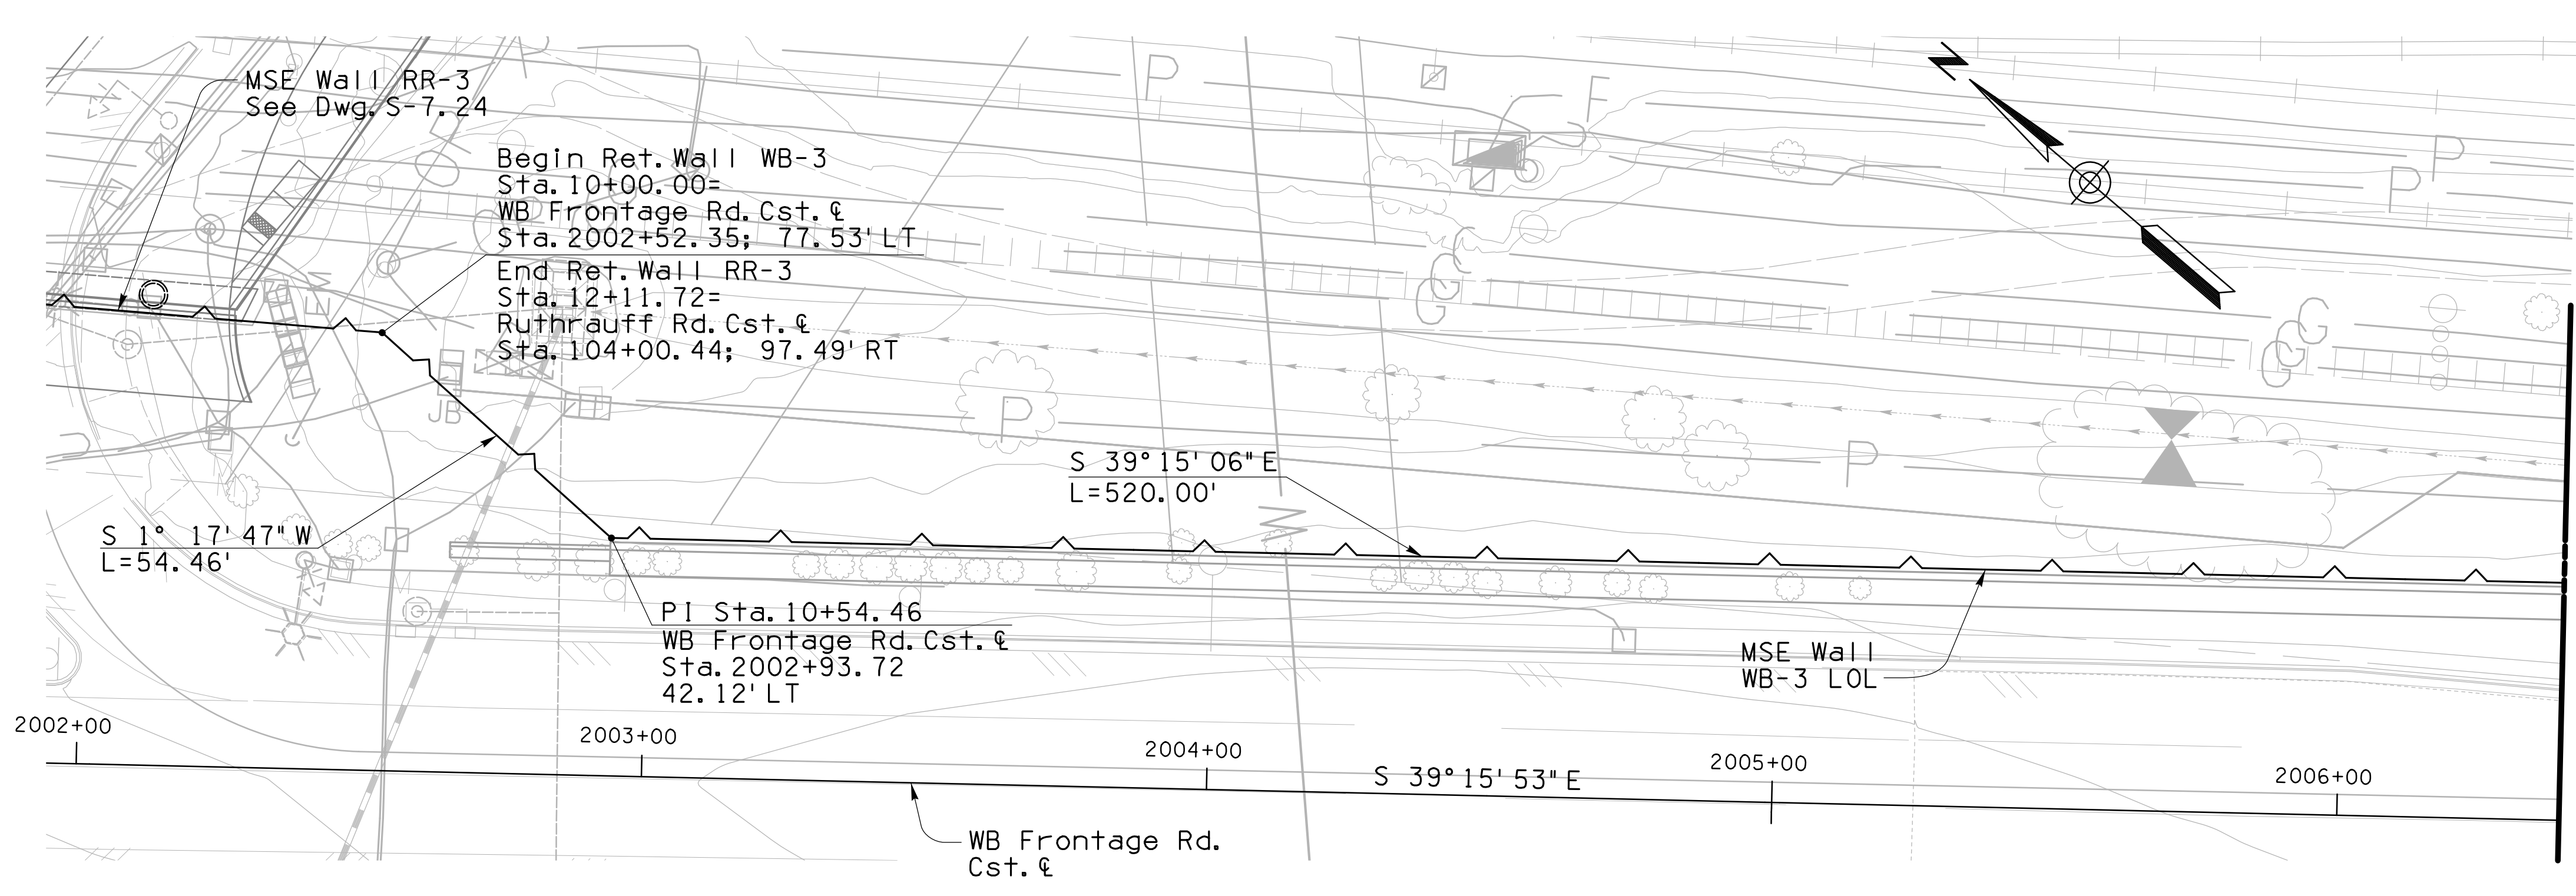


**Note:**

Contractor shall see Architectural Treatment Plans for the MSE icon designs, vertical rustication pattern and blank panel requirements. Full-scale mock-ups are required for each specific design.

Slip Joints shall be positioned such that they do not bisect the architectural wall treatments. Not all of the slip joints are shown on the plans. The Contractor shall follow the Special Provisions for placement of the other required slip joint locations, plus other locations required per the wall manufacturer's design.

The location of all utilities is approximate. The contractor shall review the utility plans and potholing information to confirm the location of new and existing utilities prior to construction.


PLAN - WALL WB-3 (MSE)  
1" = 20'

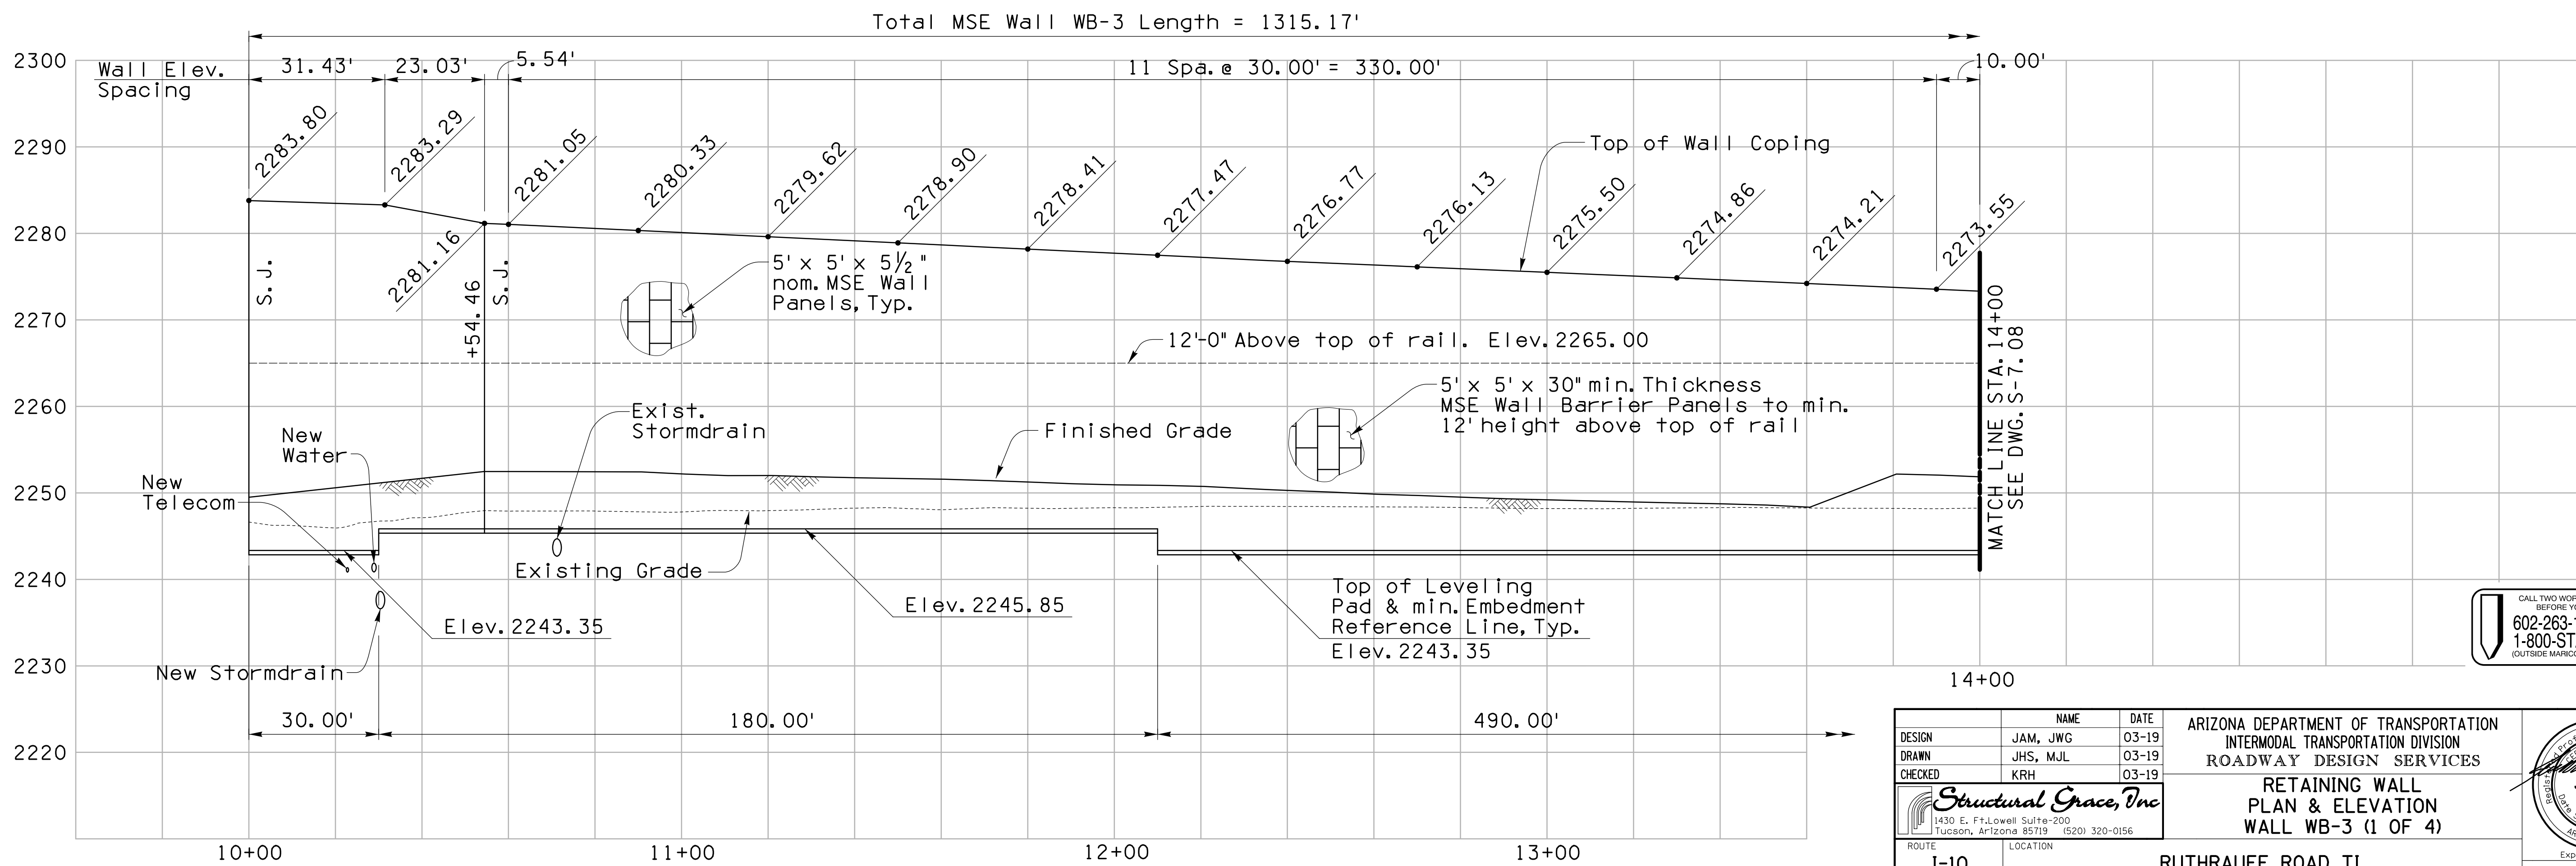

ELEVATION - WALL WB-3 (MSE)  
Horiz.: 1" = 20'; Vert.: 1" = 10'



DESIGN	JAM, JWJ	03-19	ARIZONA DEPARTMENT OF TRANSPORTATION INTERMODAL TRANSPORTATION DIVISION ROADWAY DESIGN SERVICES
DRAWN	JHS, MJL	03-19	
CHECKED	KRH	03-19	
			<b>RETAINING WALL PLAN &amp; ELEVATION WALL WB-3 (1 OF 4)</b>
ROUTE	I-10	LOCATION	
TRACS NO. H 8480 01C		010-D(213)S	

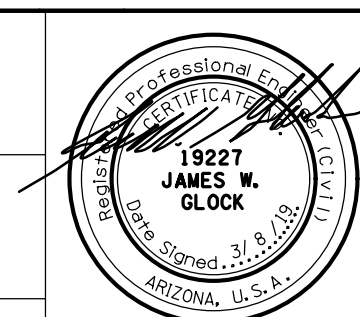

SURVEY NO. FINISHED PLANS DATE REVISIONS LOCATION DATE FINISHED PLANS SURVEY NO.




F.H.W.A. REGION	STATE	PROJECT NO.	SHEET NO.	TOTAL SHEETS	AS BUILT
9	ARIZ.	010-D(213)S	710	849	

010 PM 252

**CURVE DATA**

①	②
Δ = 2°14'31"	Δ = 3°24'16"
R = 11483.28'	R = 11459.16'
L = 449.31'	L = 681.43'
T = 224.69'	T = 340.81'

UNION PACIFIC R.R.

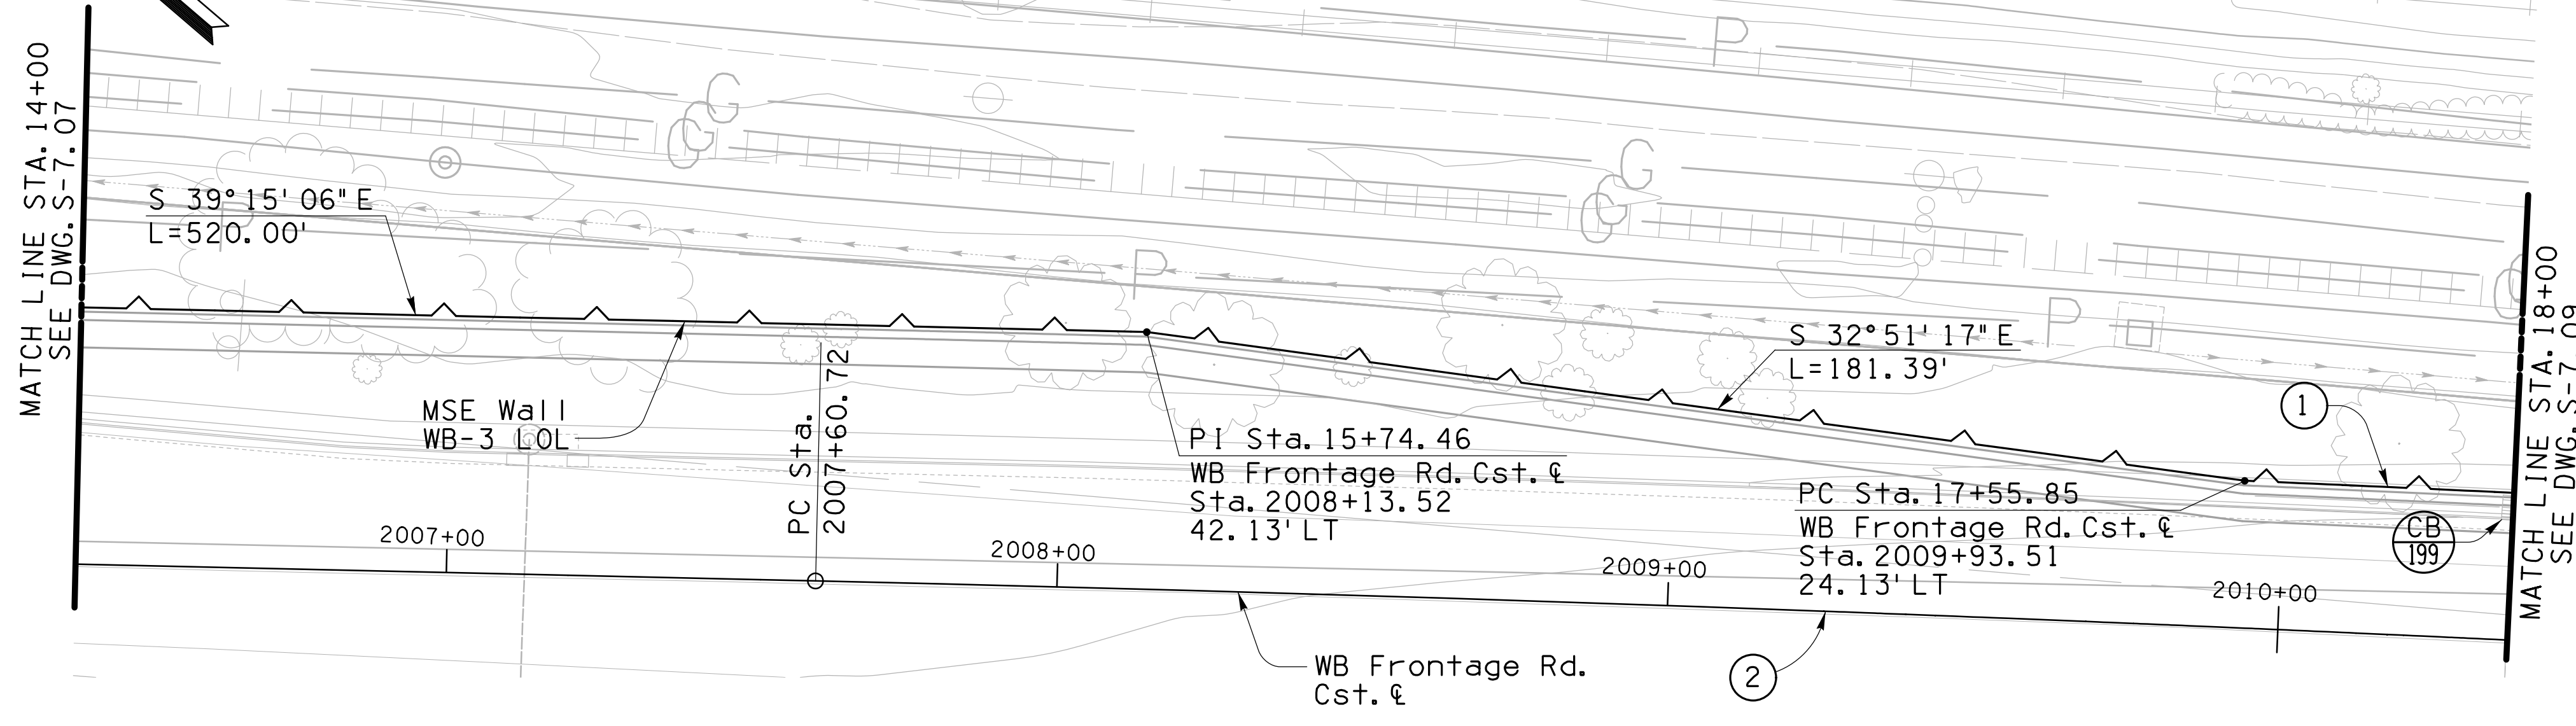


**PLAN - WALL WB-3 (MSE)**  
1" = 20'

**Note:**  
Contractor shall see Architectural Treatment Plans for the MSE Icon designs, vertical rustication pattern and blank panel requirements. Full-scale mock-ups are required for each specific design.

Slip Joints shall be positioned such that they do not bisect the architectural wall treatments. Not all of the slip joints are shown on the plans. The Contractor shall follow the Special Provisions for placement of the other required slip joint locations, plus other locations required per the wall manufacturer's design.

The location of all utilities is approximate. The contractor shall review the utility plans and potholing information to confirm the location of new and existing utilities prior to construction.

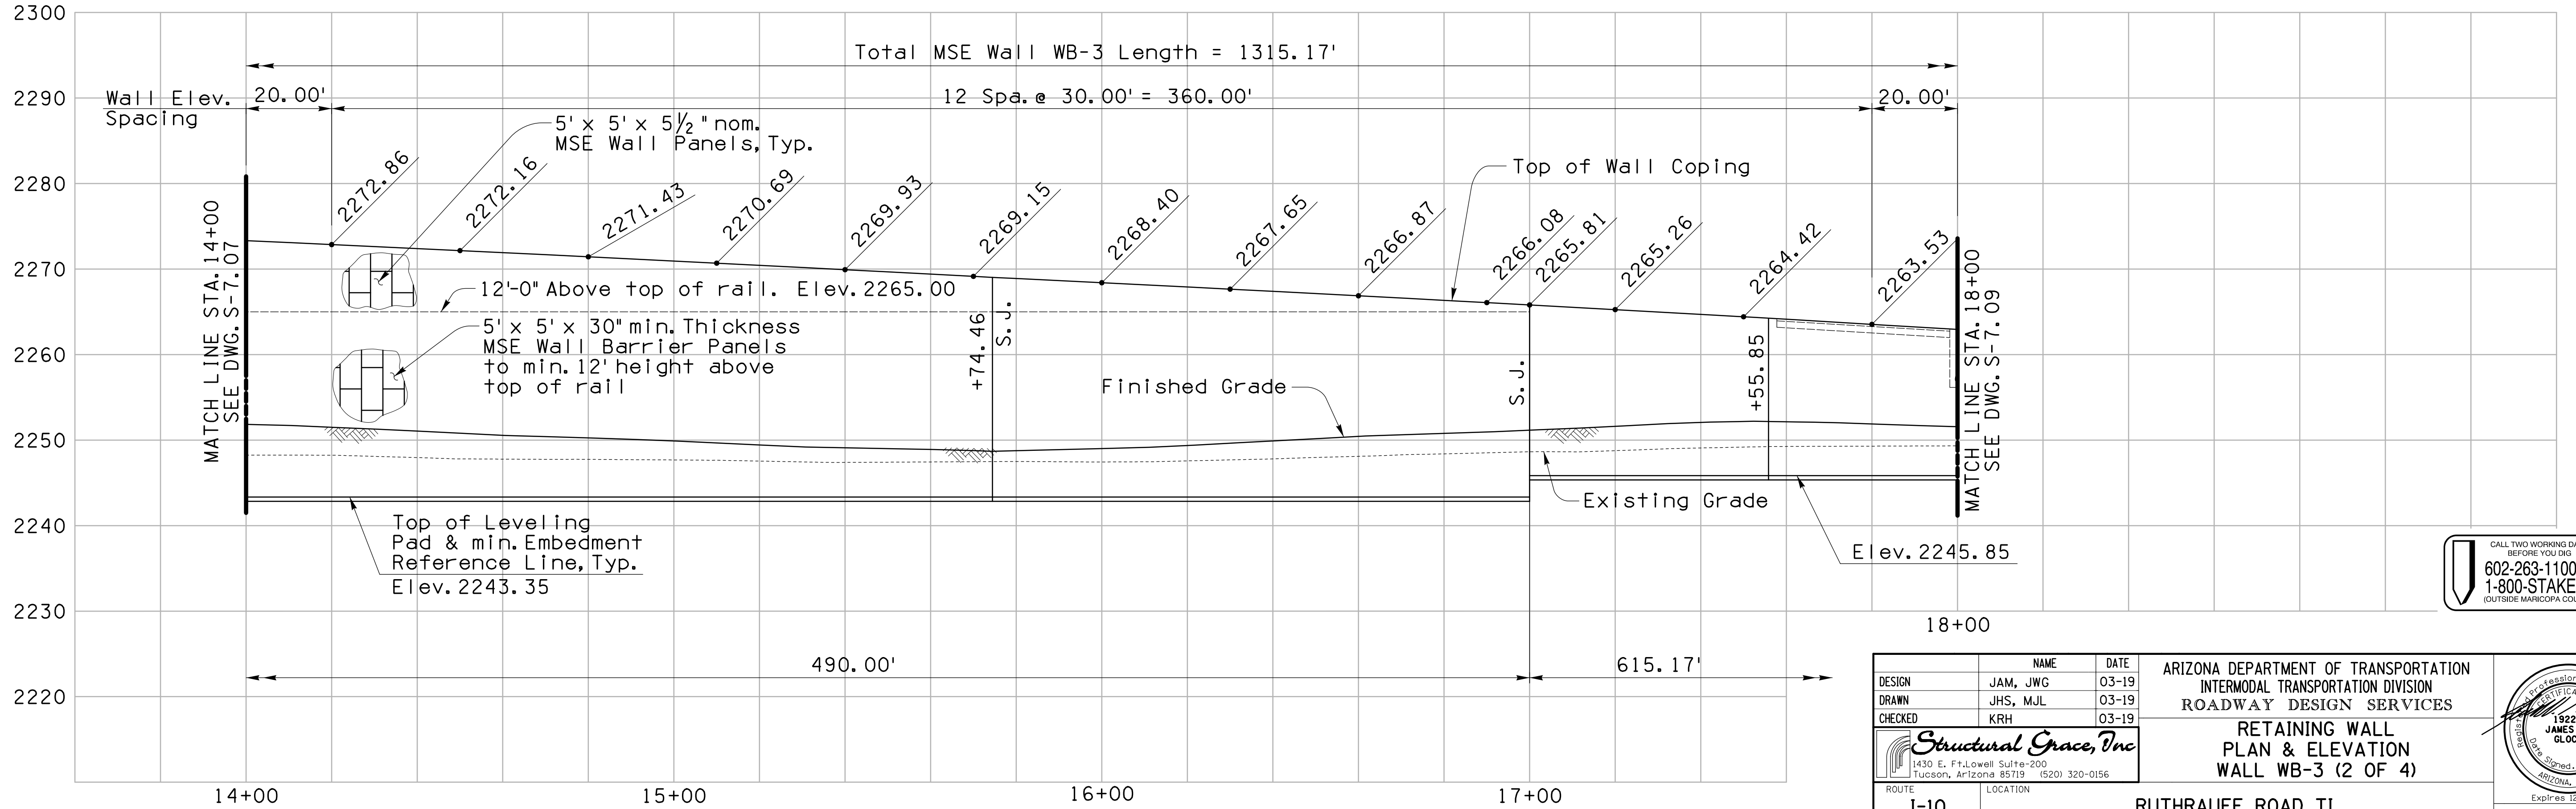

**ELEVATION - WALL WB-3 (MSE)**  
Horiz. : 1" = 20' ; Vert. : 1" = 10'

CALL TWO WORKING DAYS BEFORE YOU DIG  
602-263-1100  
1-800-STAKE-IT  
(OUTSIDE MARICOPA COUNTY)


DESIGN	JAM, JWG	03-19	ARIZONA DEPARTMENT OF TRANSPORTATION INTERMODAL TRANSPORTATION DIVISION ROADWAY DESIGN SERVICES
DRAWN	JHS, MJL	03-19	
CHECKED	KRH	03-19	
			<b>RETAINING WALL PLAN &amp; ELEVATION WALL WB-3 (2 OF 4)</b>
ROUTE	LOCATION		
I-10	RUTHRAUFF ROAD TI		
TRACS NO. H 8480 01C			
010-D(213)S			OF

F.H.W.A. REGION	STATE	PROJECT NO.	SHEET NO.	TOTAL SHEETS	AS BUILT
9	ARIZ.	010-D(213)S	711	849	

010 PM 252

**CURVE DATA**

①	Δ = 2° 14' 31"	Δ = 3° 24' 16"
	R = 11483.28'	R = 11459.16'
	L = 449.31'	L = 681.43'
	T = 224.69'	T = 340.81'

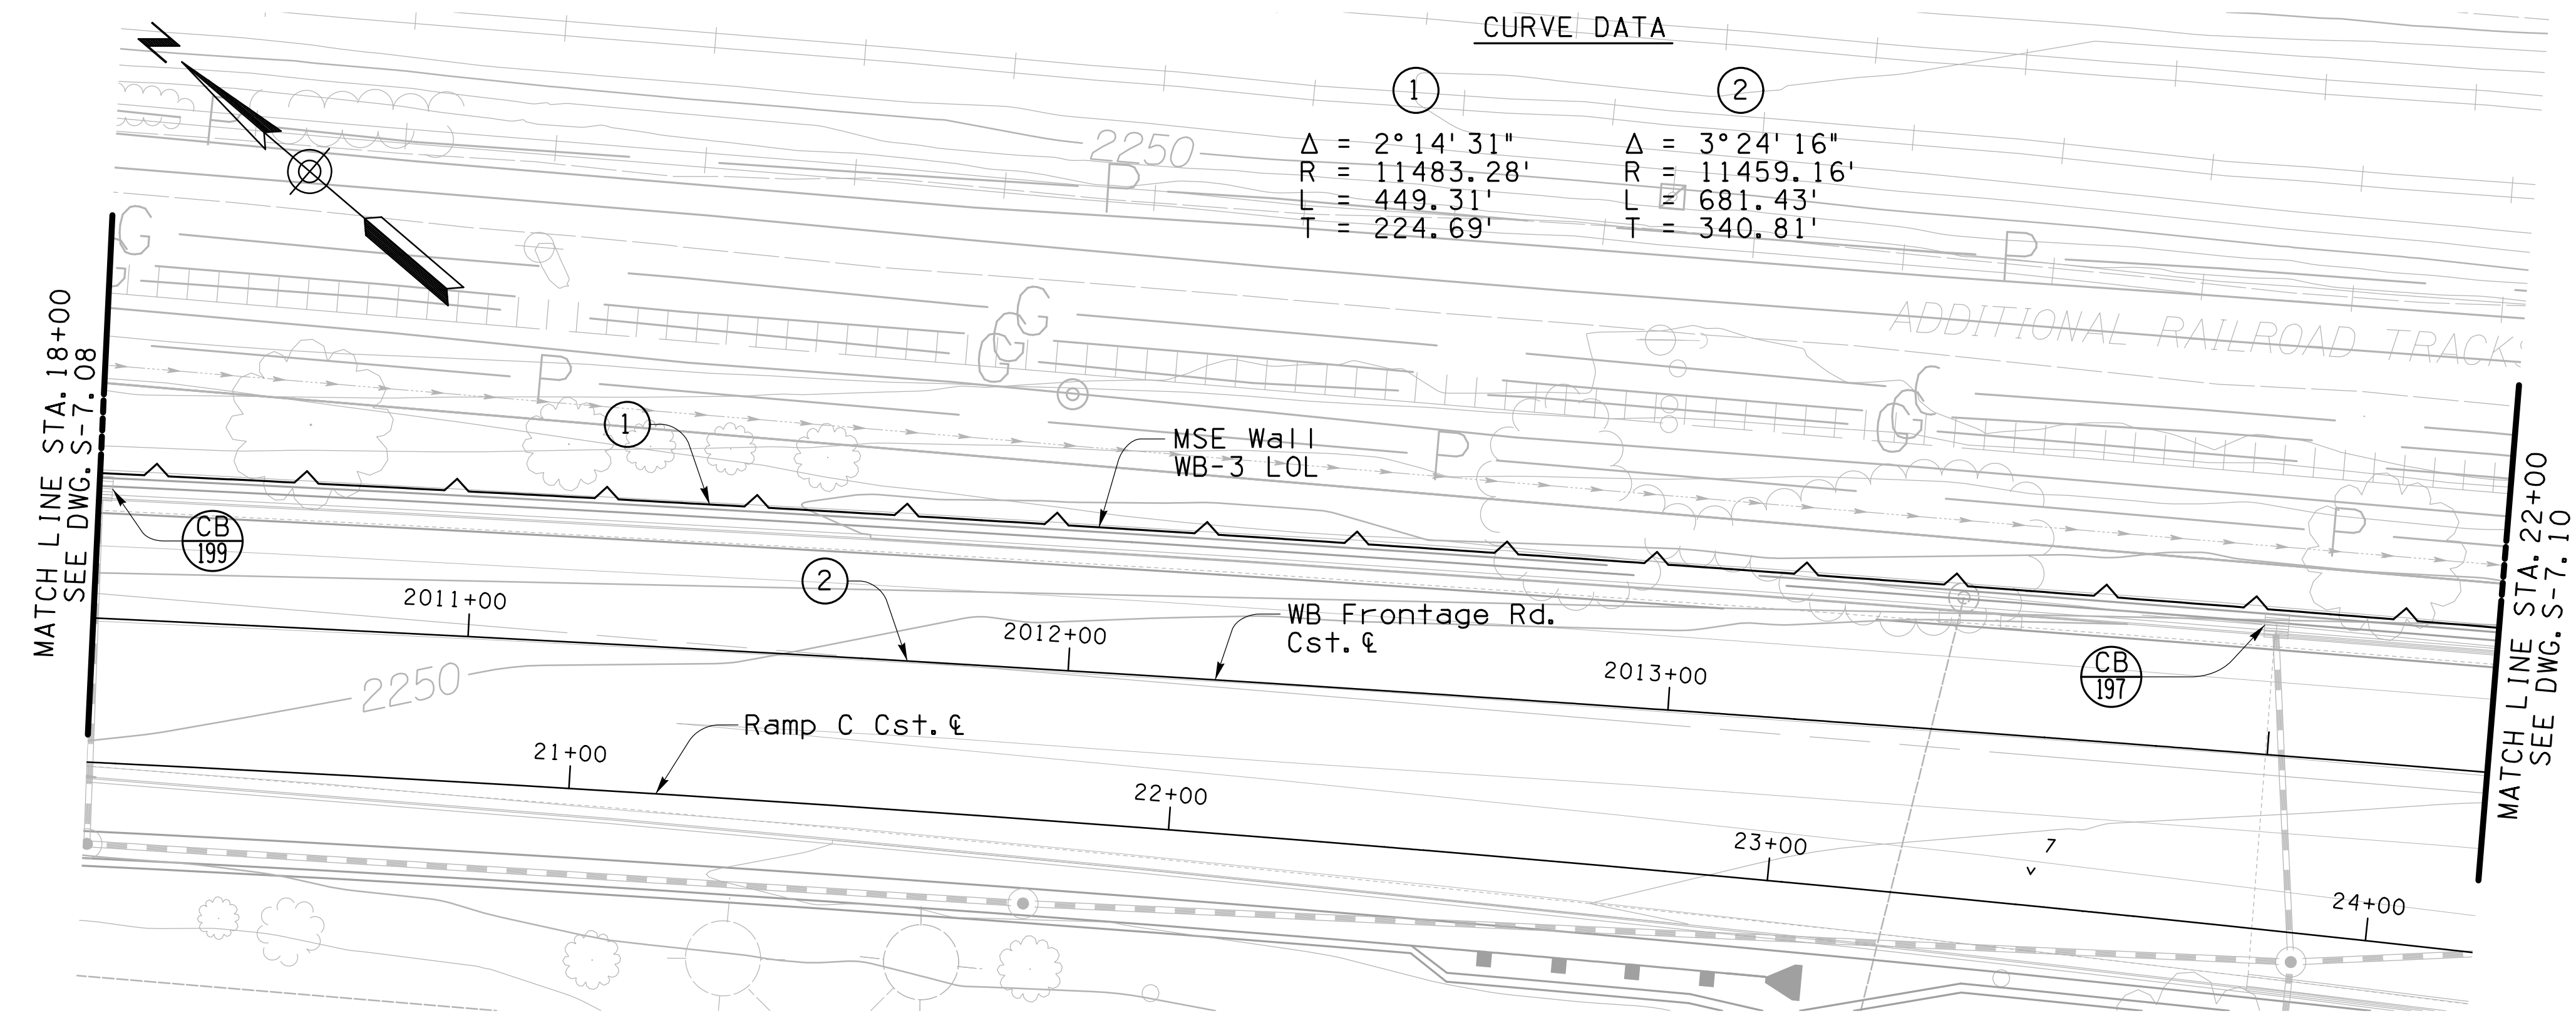


**PLAN - WALL WB-3 (MSE)**  
1" = 20'

**Note:**  
Contractor shall see Architectural Treatment Plans for the MSE icon designs, vertical rustication pattern and blank panel requirements. Full-scale mock-ups are required for each specific design.

Slip Joints shall be positioned such that they do not bisect the architectural wall treatments. Not all of the slip joints are shown on the plans. The Contractor shall follow the Special Provisions for placement of the other required slip joint locations, plus other locations required per the wall manufacturer's design.


The location of all utilities is approximate. The contractor shall review the utility plans and potholing information to confirm the location of new and existing utilities prior to construction.

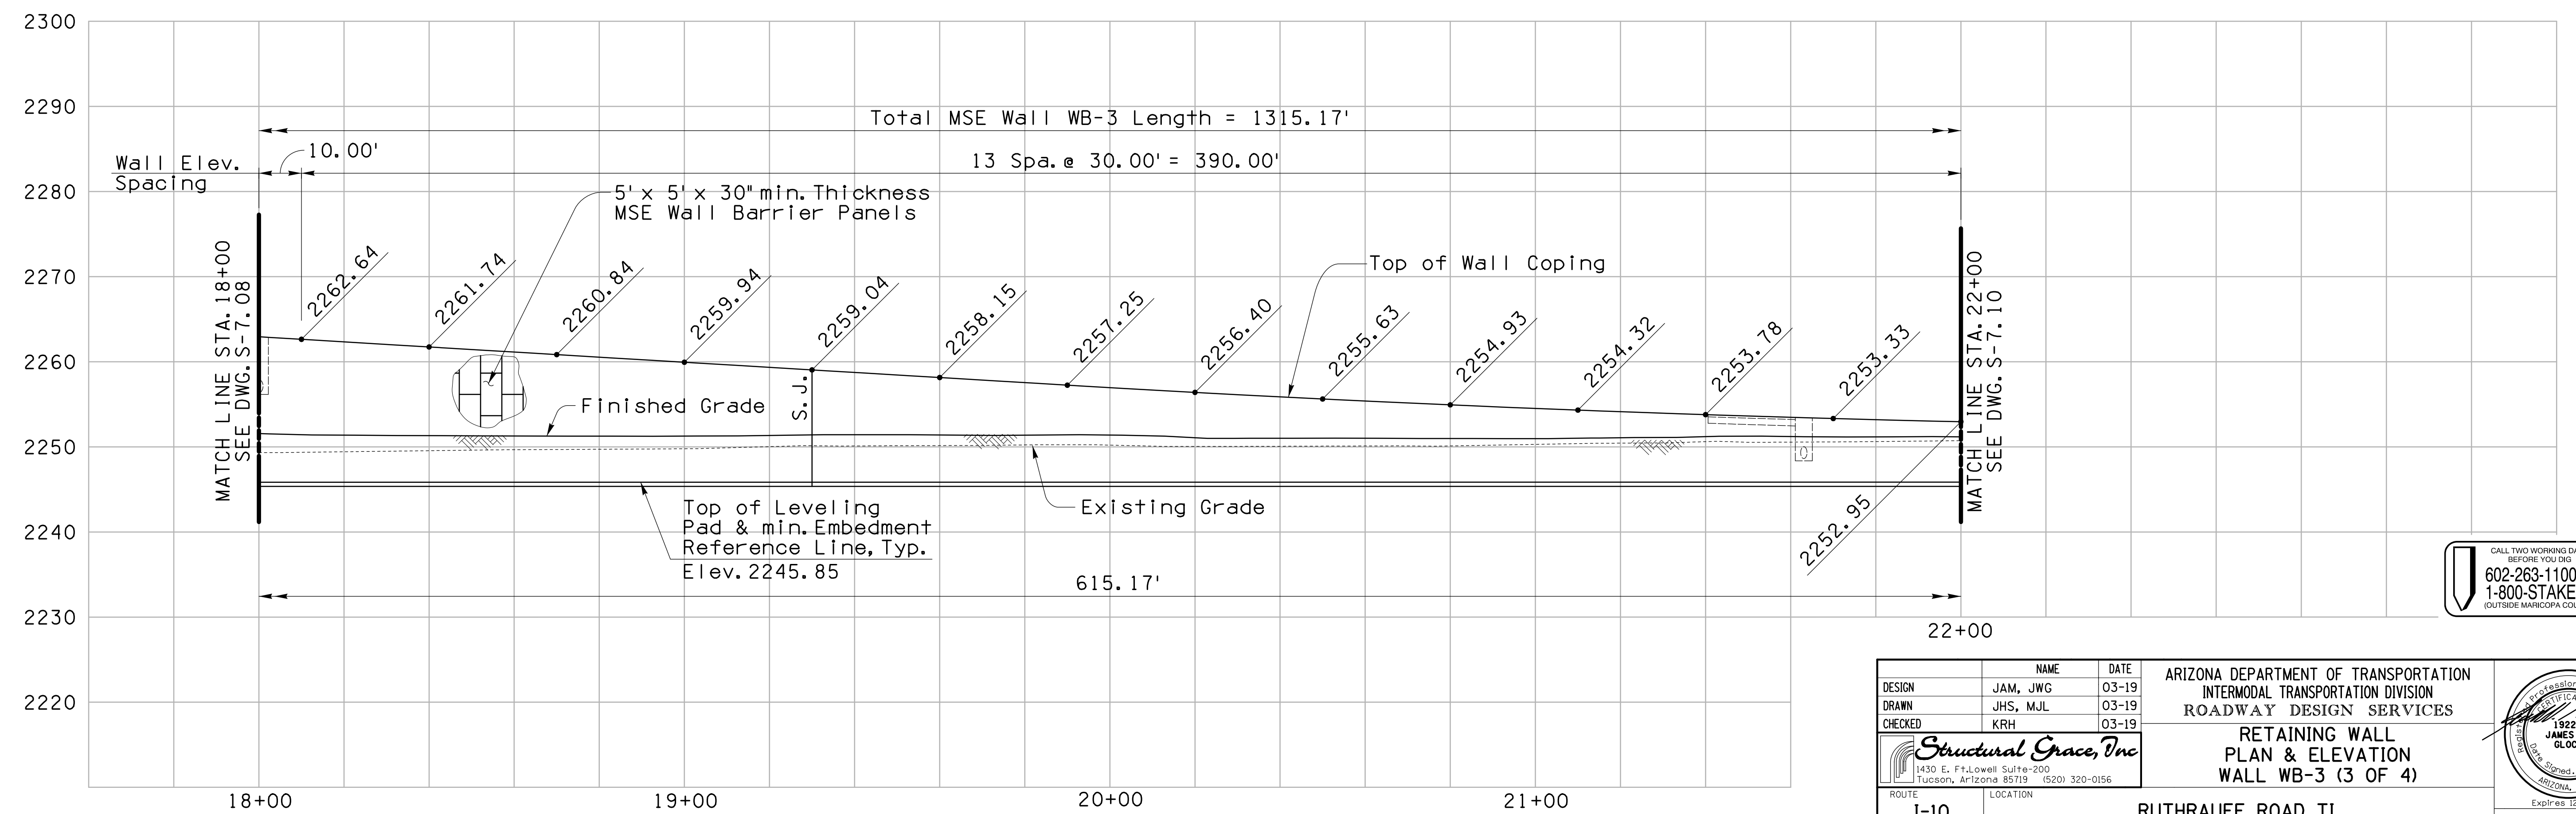

**ELEVATION - WALL WB-3 (MSE)**  
Horiz.: 1" = 20'; Vert.: 1" = 10'



DESIGN	JAM, JWG	03-19	ARIZONA DEPARTMENT OF TRANSPORTATION INTERMODAL TRANSPORTATION DIVISION ROADWAY DESIGN SERVICES
DRAWN	JHS, MJL	03-19	
CHECKED	KRH	03-19	
			<b>RETAINING WALL PLAN &amp; ELEVATION WALL WB-3 (3 OF 4)</b>
ROUTE	I-10	LOCATION	
TRACS NO. H 8480 01C			010-D(213)S


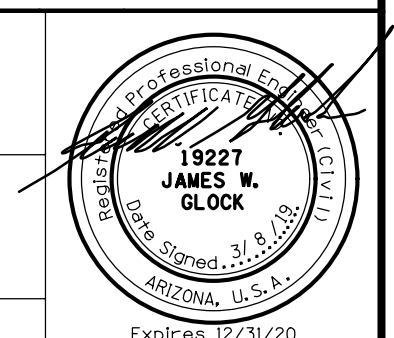


F.H.W.A. REGION	STATE	PROJECT NO.	SHEET NO.	TOTAL SHEETS	AS BUILT
9	ARIZ.	010-D(213)S	712	849	

010 PM 252

**CURVE DATA**

①	②
$\Delta = 2^{\circ}14'31''$	$\Delta = 3^{\circ}24'16''$
$R = 11483.28$	$R = 11459.16'$
$L = 449.31'$	$L = 681.43'$
$T = 224.69'$	$T = 340.81'$

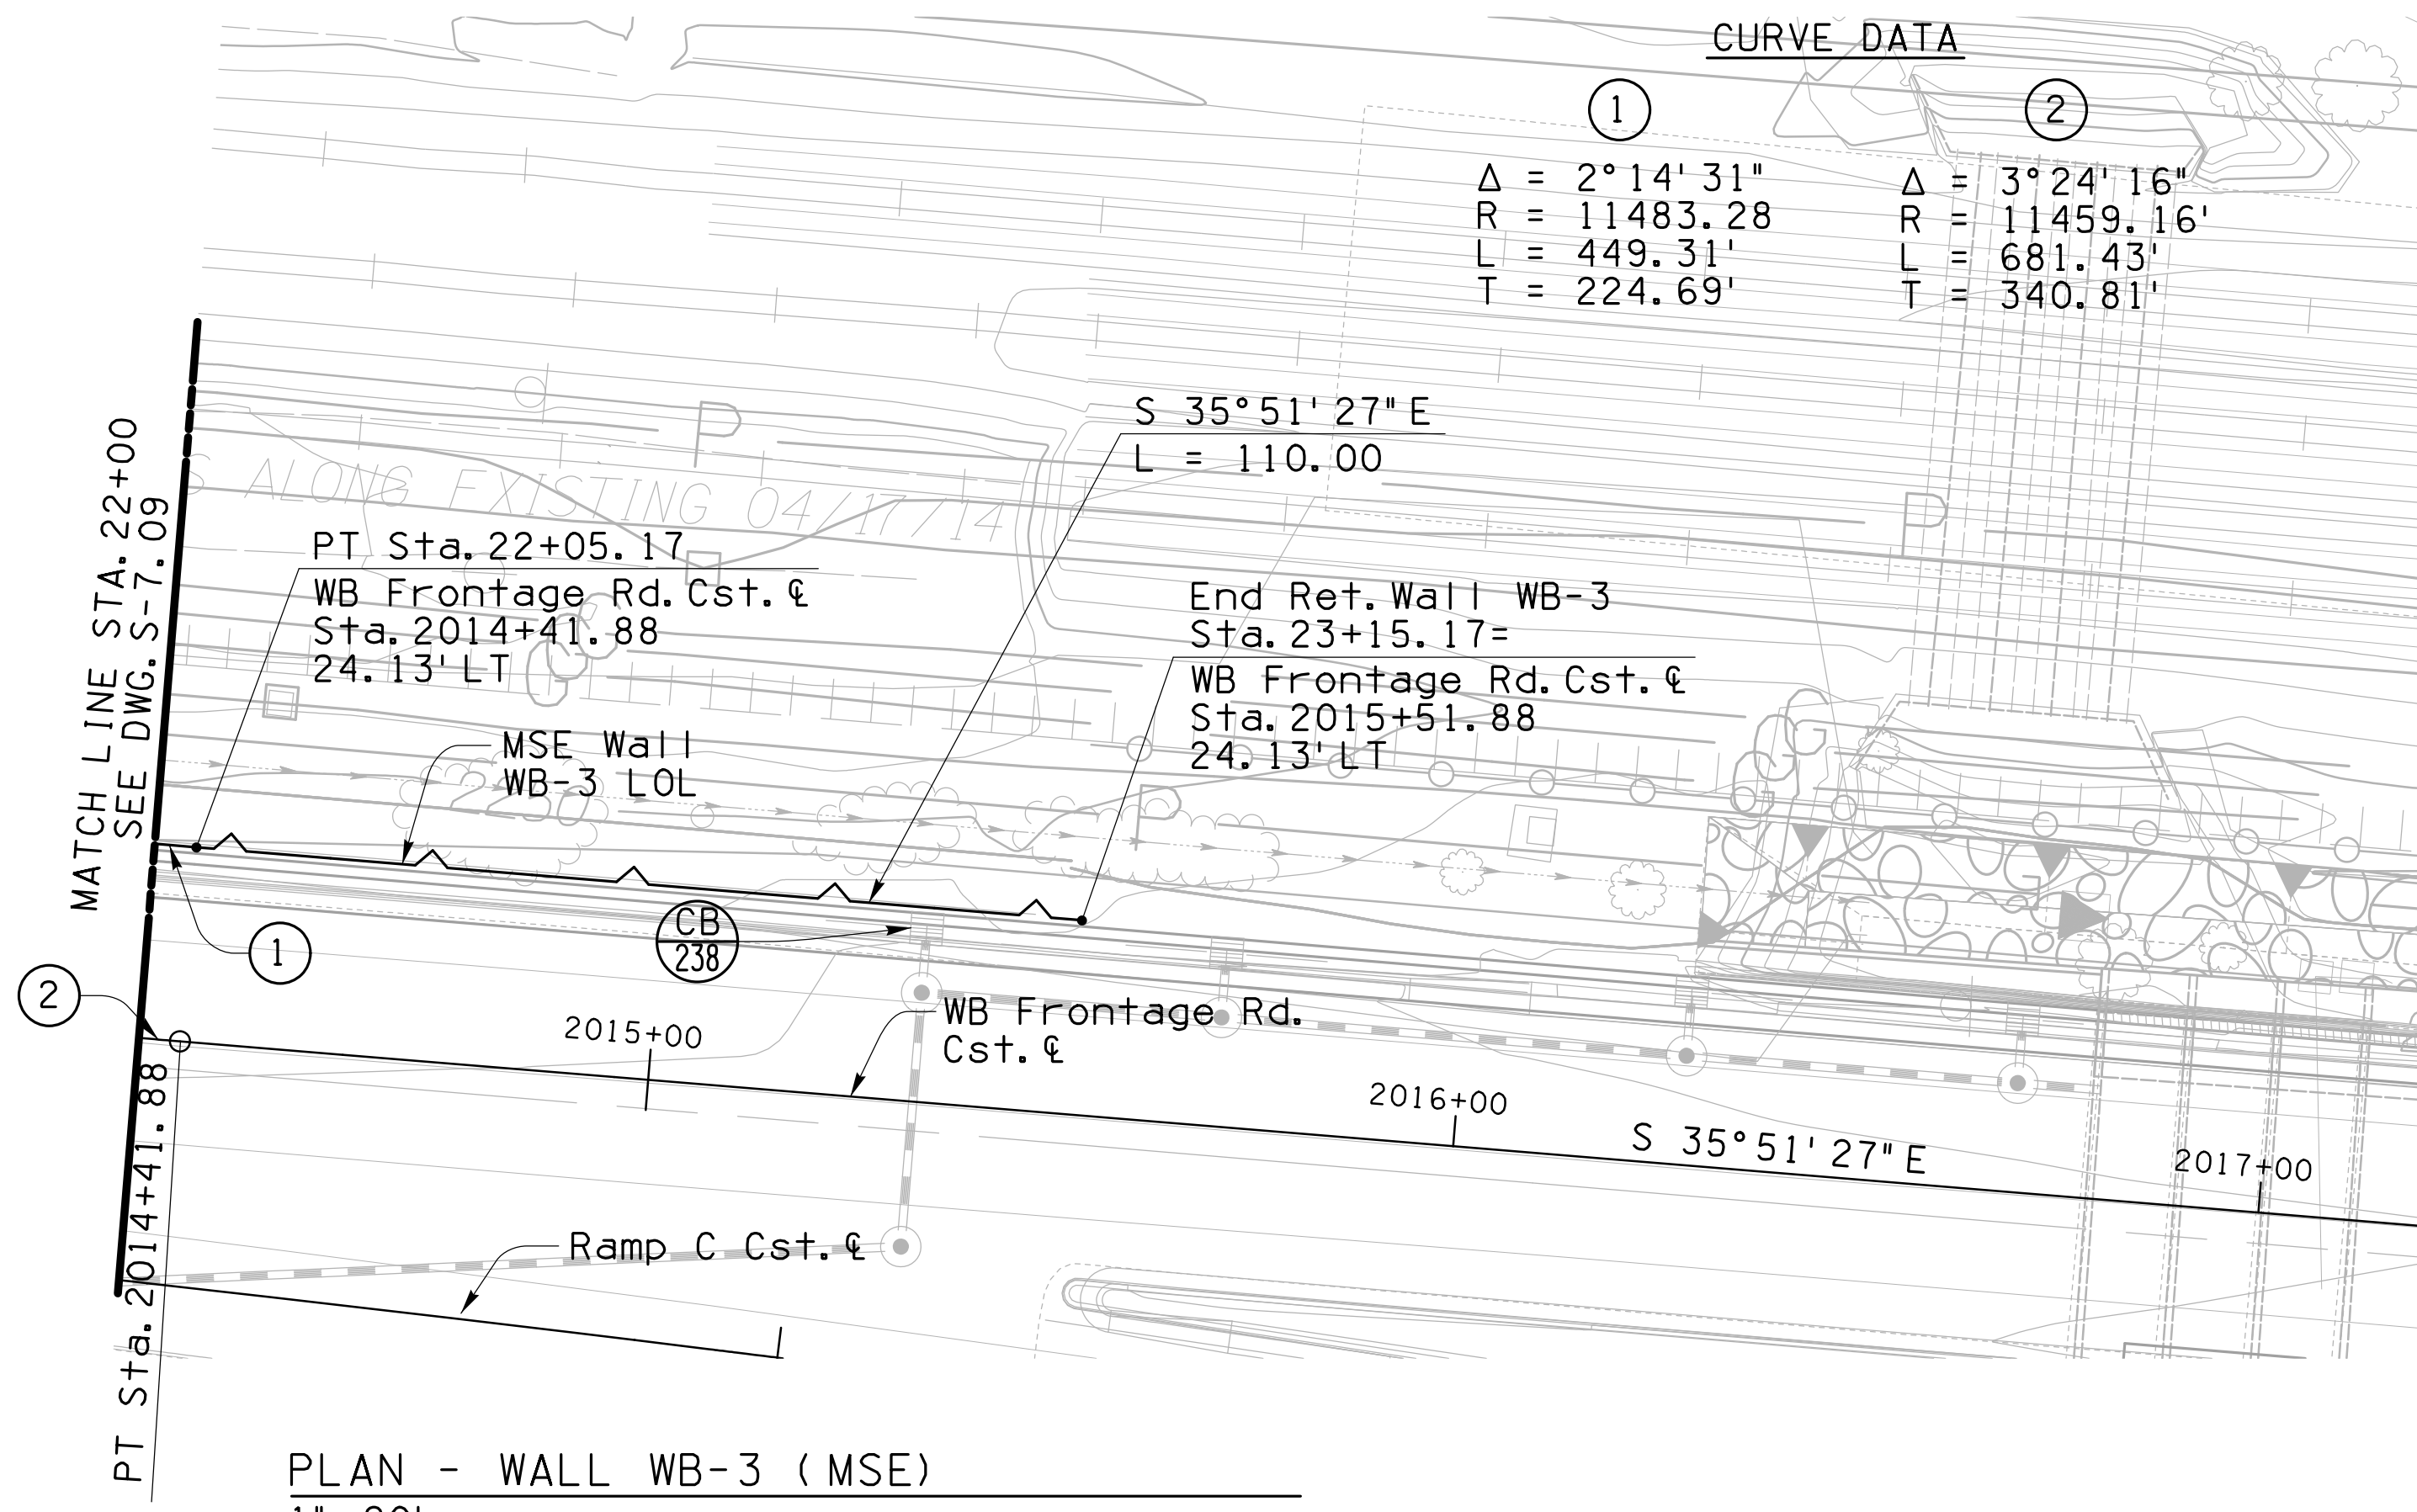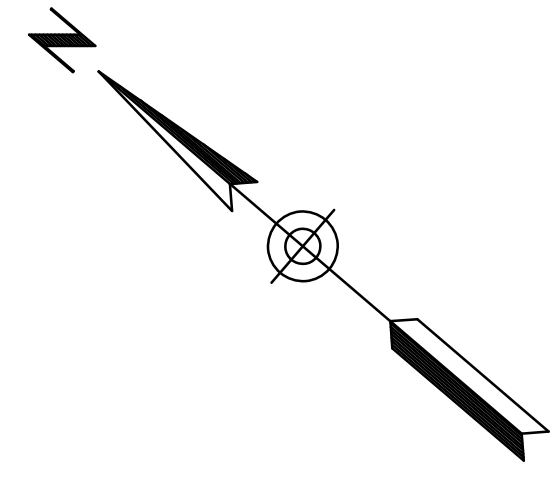


**PLAN - WALL WB-3 (MSE)**  
1" = 20'

**Note:**

Contractor shall see Architectural Treatment Plans for the MSE icon designs, vertical rustication pattern and blank panel requirements. Full-scale mock-ups are required for each specific design.

Slip Joints shall be positioned such that they do not bisect the architectural wall treatments. Not all of the slip joints are shown on the plans. The Contractor shall follow the Special Provisions for placement of the other required slip joint locations, plus other locations required per the wall manufacturer's design.

The location of all utilities is approximate. The contractor shall review the utility plans and potholing information to confirm the location of new and existing utilities prior to construction.

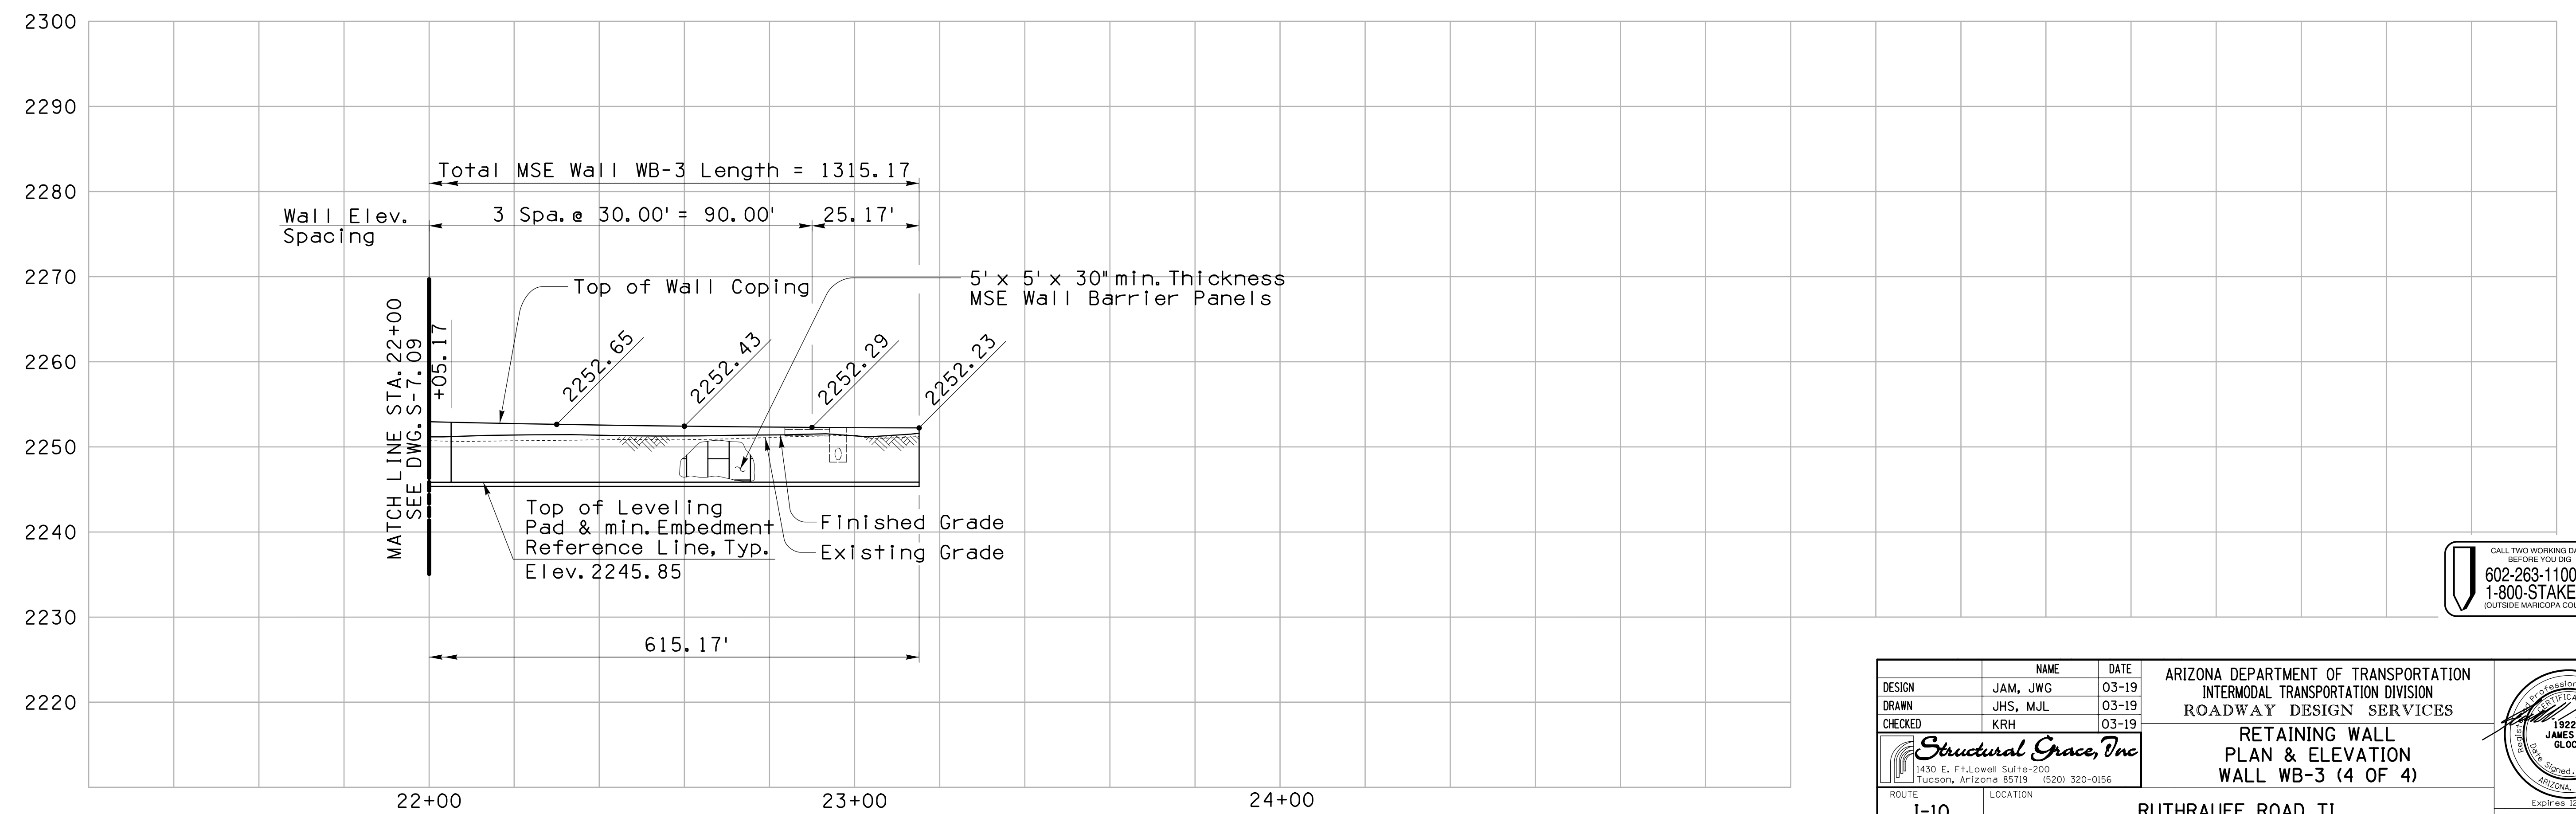

**ELEVATION - WALL WB-3 (MSE)**  
Horiz.: 1" = 20'; Vert.: 1" = 10'




DESIGN	JAM, JWG	03-19	ARIZONA DEPARTMENT OF TRANSPORTATION INTERMODAL TRANSPORTATION DIVISION ROADWAY DESIGN SERVICES
DRAWN	JHS, MJL	03-19	
CHECKED	KRH	03-19	
			<b>RETAINING WALL PLAN &amp; ELEVATION WALL WB-3 (4 OF 4)</b>
ROUTE	I-10	LOCATION	RUTHRAUFF ROAD TI
TRACS NO. H 8480 01C		010-D(213)S	
			DWG NO. S-7.10
			OF



F.H.W.A. REGION	STATE	PROJECT NO.	SHEET NO.	TOTAL SHEETS	AS BUILT
9	ARIZ.	010-D(213)S	713	849	


010 PM 252

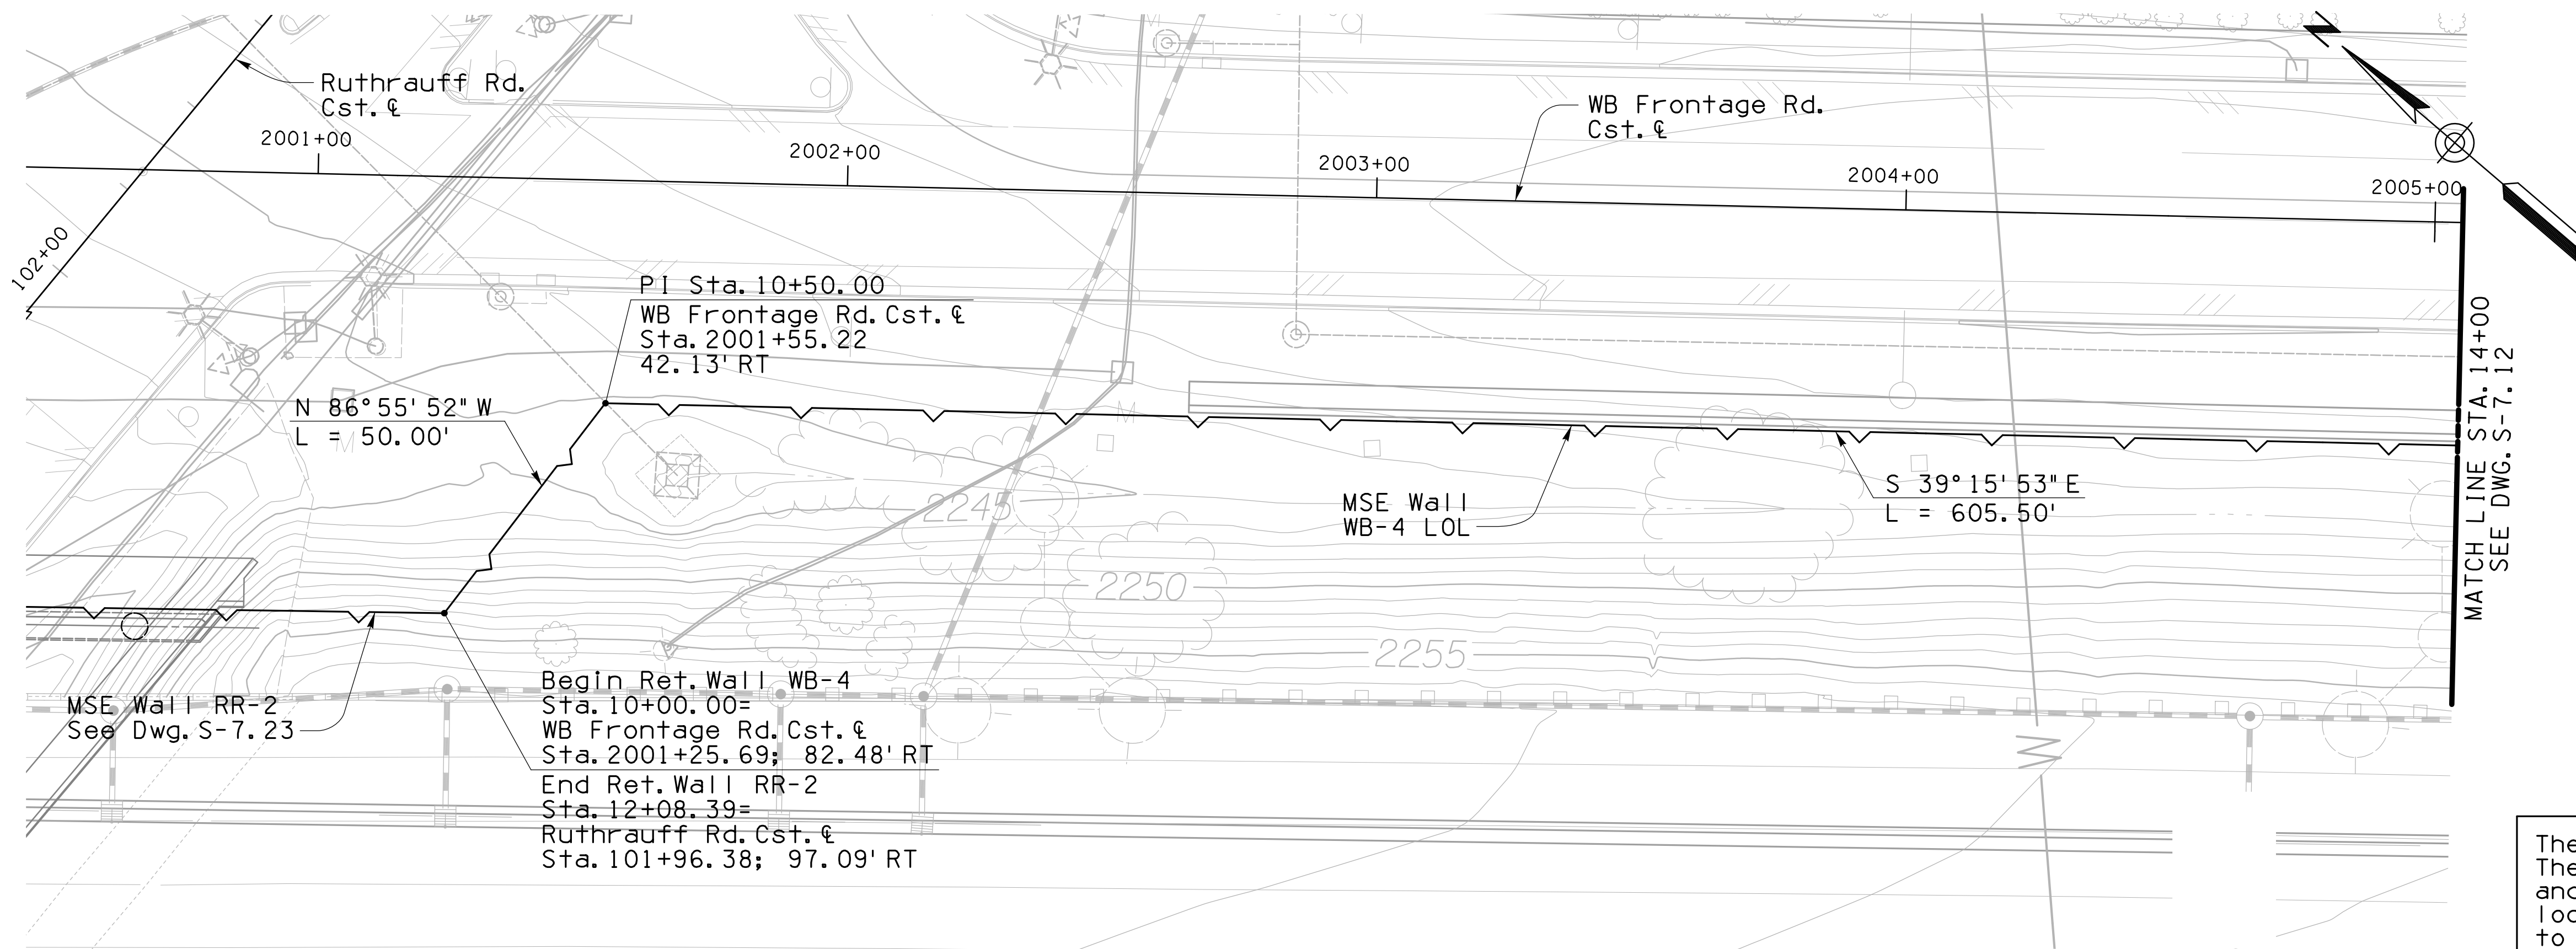

**Note:**  
Contractor shall see Architectural Treatment Plans for the MSE icon designs, vertical rustication pattern and blank panel requirements. Full-scale mock-ups are required for each specific design.

Slip Joints shall be positioned such that they do not bisect the architectural wall treatments. Not all of the slip joints are shown on the plans. The Contractor shall follow the Special Provisions for placement of the other required slip joint locations, plus other locations required per the wall manufacturer's design.

The location of all utilities is approximate. The contractor shall review the utility plans and potholing information to confirm the location of new and existing utilities prior to construction.

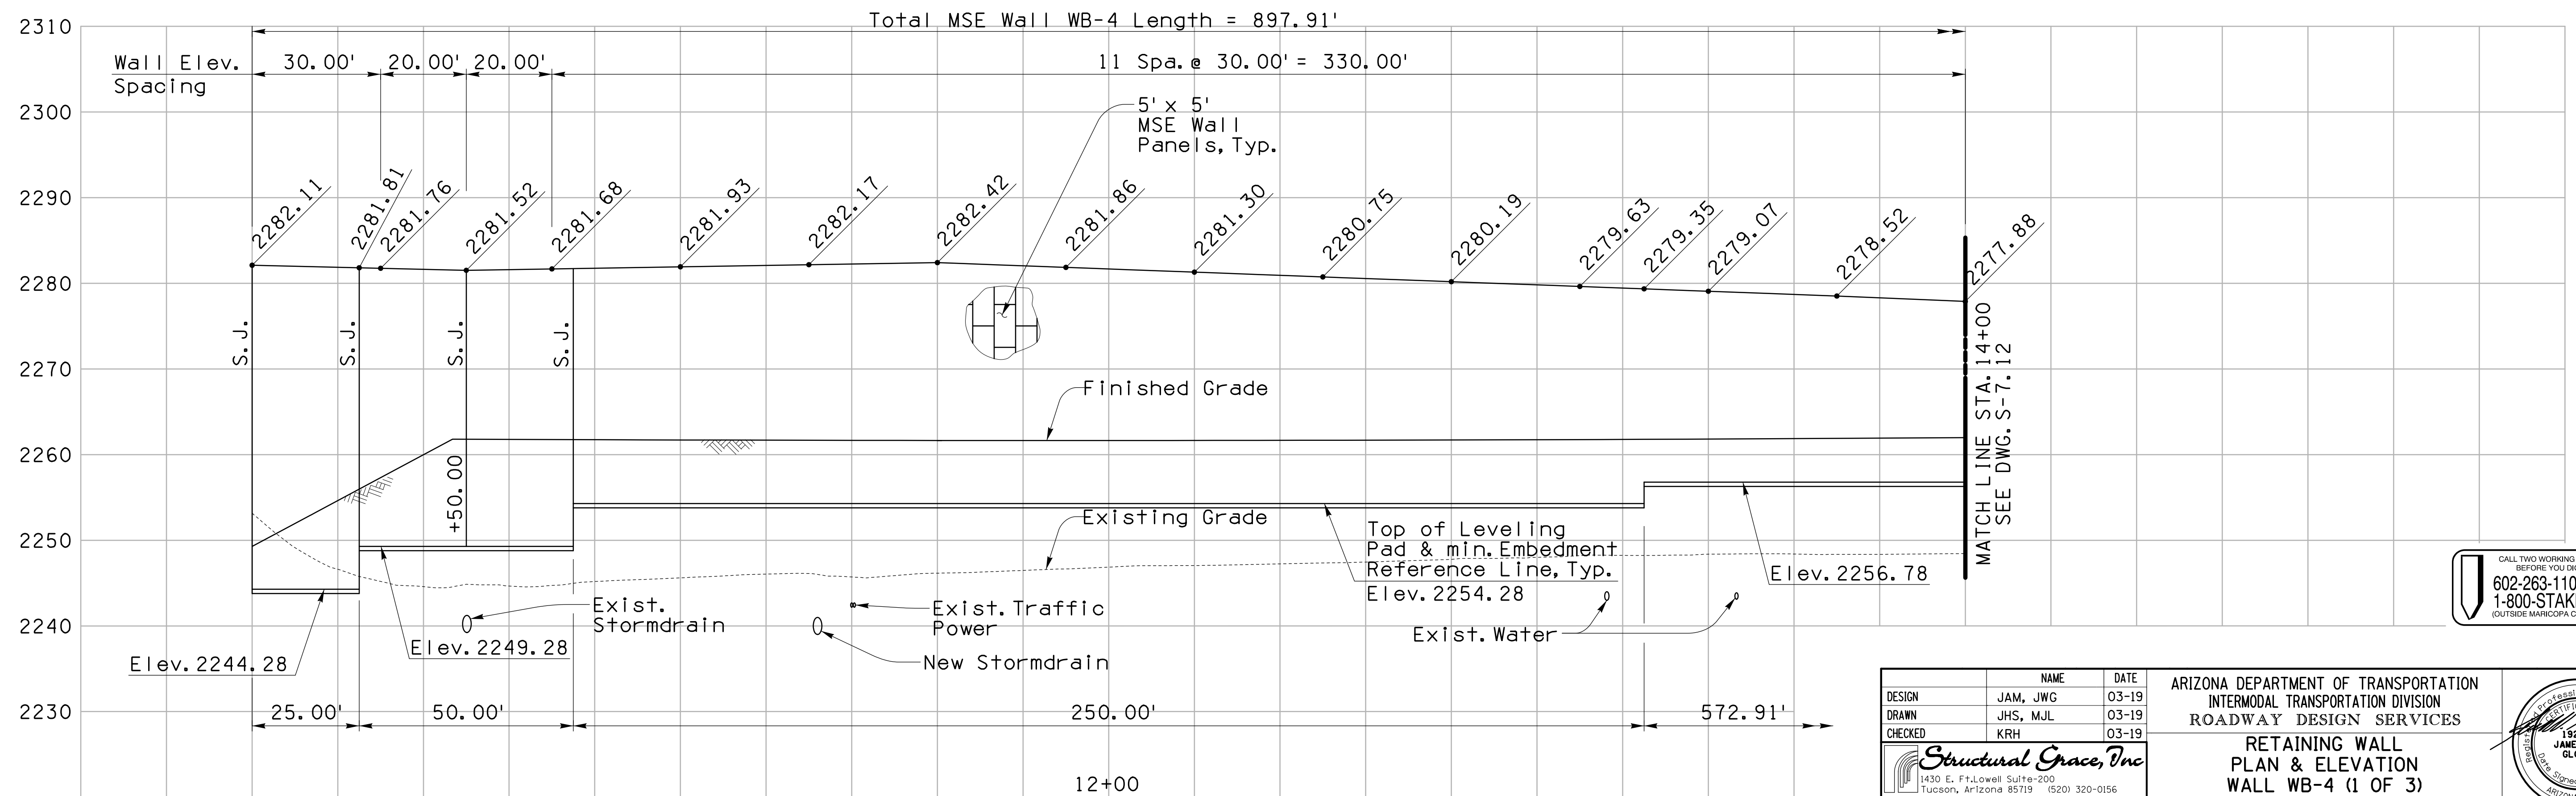


CALL TWO WORKING DAYS BEFORE YOU DIG  
602-263-1100  
1-800-STAKE-IT  
(OUTSIDE MARICOPA COUNTY)

DESIGN	NAME	DATE	ARIZONA DEPARTMENT OF TRANSPORTATION INTERMODAL TRANSPORTATION DIVISION ROADWAY DESIGN SERVICES
DRAWN	JAM, JWJ	03-19	
CHECKED	JHS, MJL	03-19	
			<b>RETAINING WALL PLAN &amp; ELEVATION WALL WB-4 (1 OF 3)</b>
ROUTE	LOCATION	DATE	
I-10	RUTHRAUFF ROAD TI	03-19	DWG NO. S-7.11
TRACS NO. H 8480 01C		010-D(213)S	OF

F.H.W.A. REGION	STATE	PROJECT NO.	SHEET NO.	TOTAL SHEETS	AS BUILT
9	ARIZ.	010-D(213)S	714	849	

010 PM 252

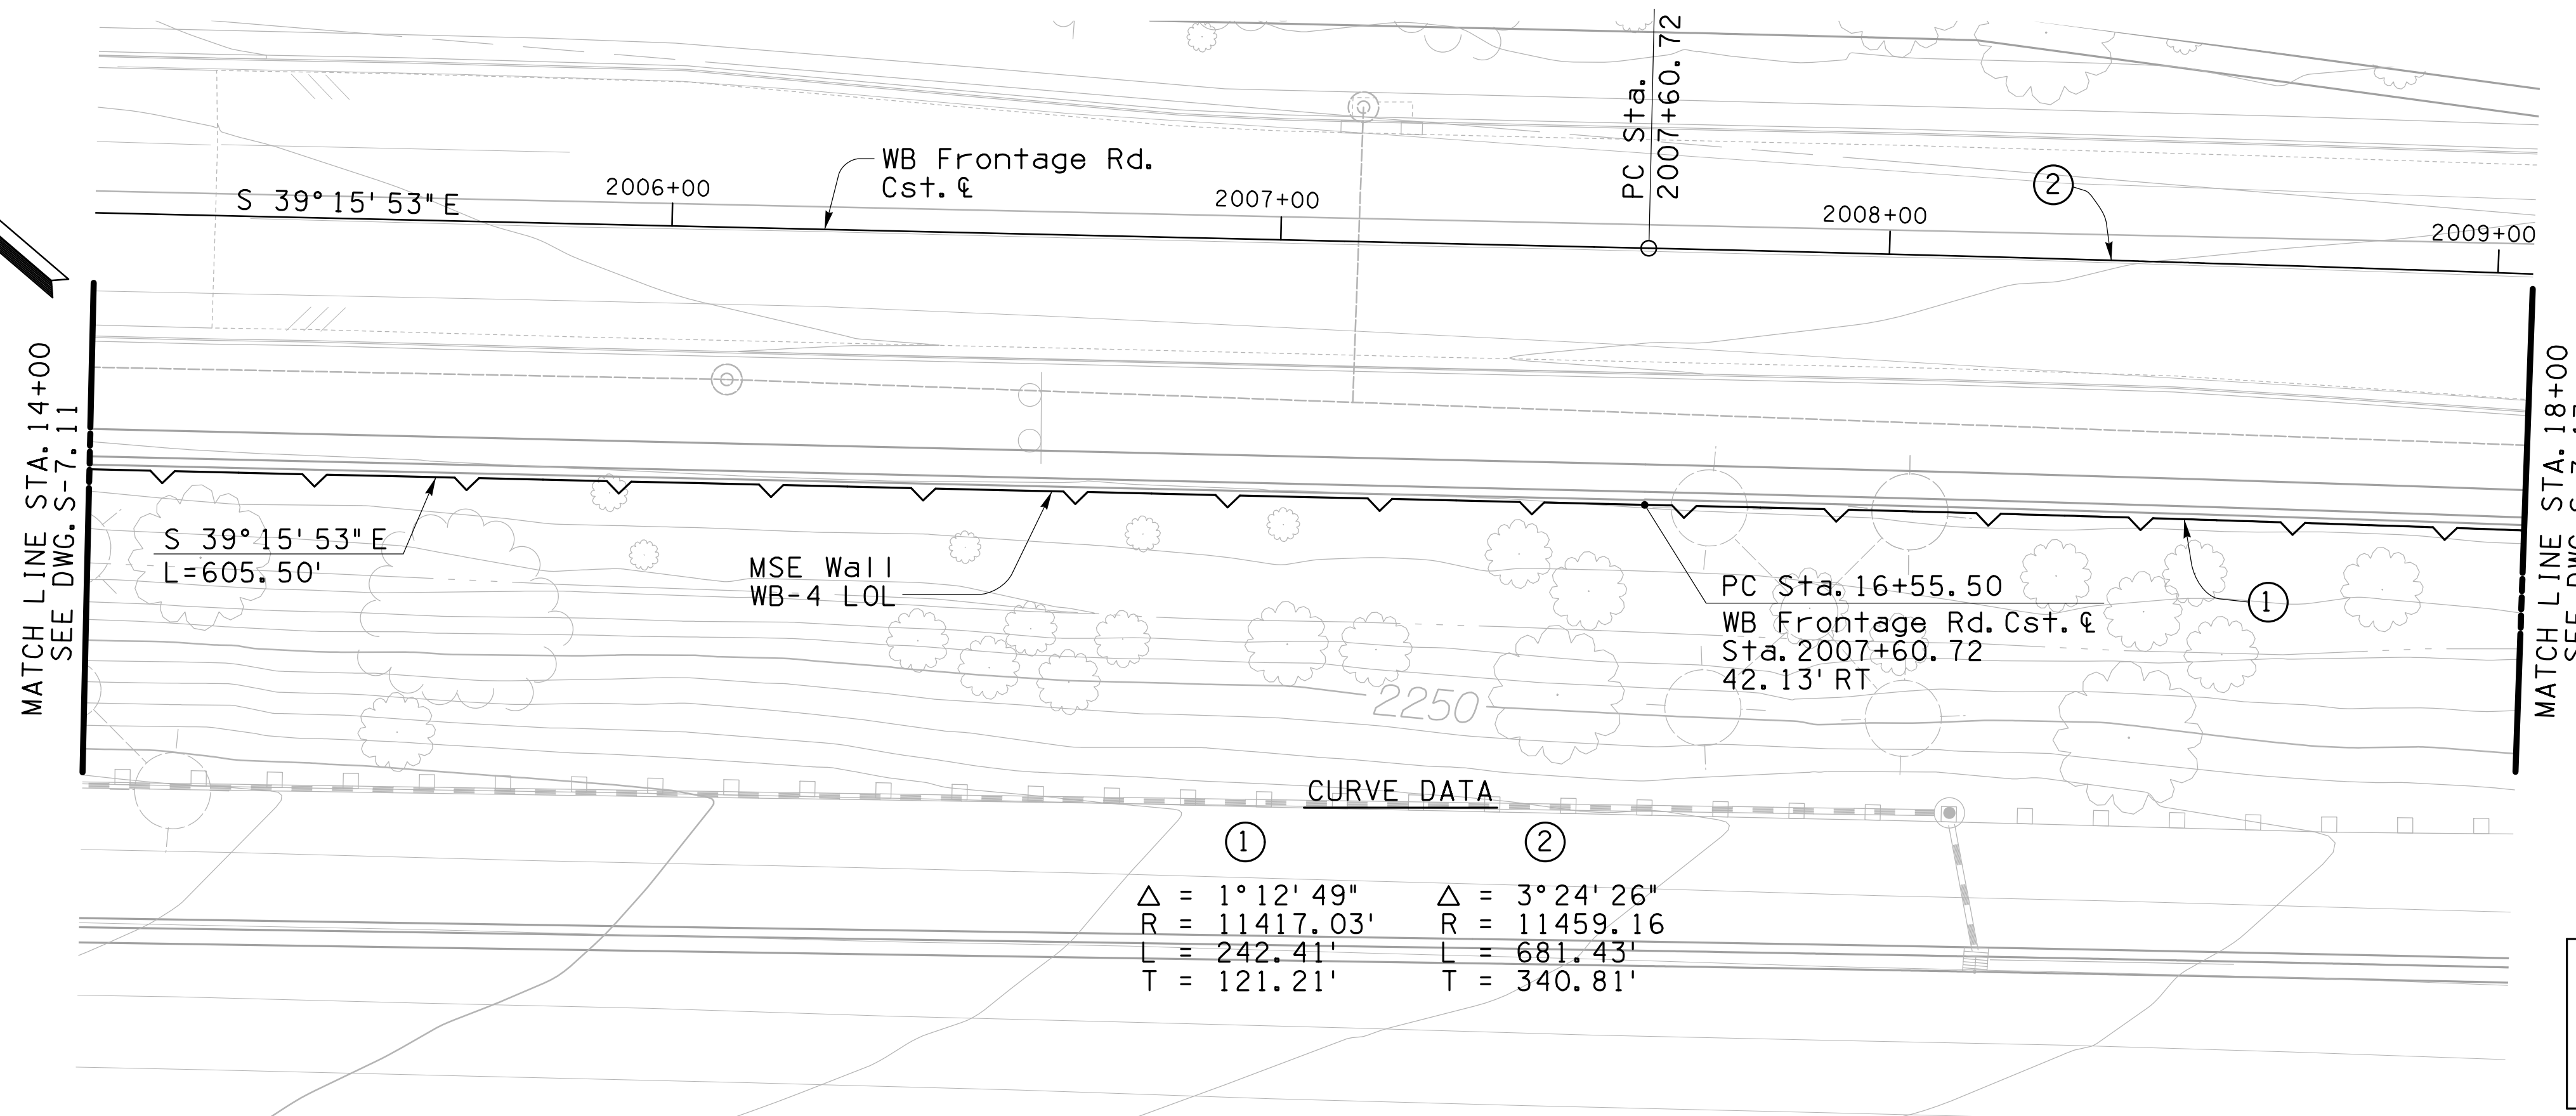


PLAN - WALL WB-4 (MSE)  
1" = 20'

**Note:**  
Contractor shall see Architectural Treatment Plans for the MSE icon designs, vertical rustication pattern and blank panel requirements. Full-scale mock-ups are required for each specific design.

Slip Joints shall be positioned such that they do not bisect the architectural wall treatments. Not all of the slip joints are shown on the plans. The Contractor shall follow the Special Provisions for placement of the other required slip joint locations, plus other locations required per the wall manufacturer's design.

The location of all utilities is approximate. The contractor shall review the utility plans and potholing information to confirm the location of new and existing utilities prior to construction.

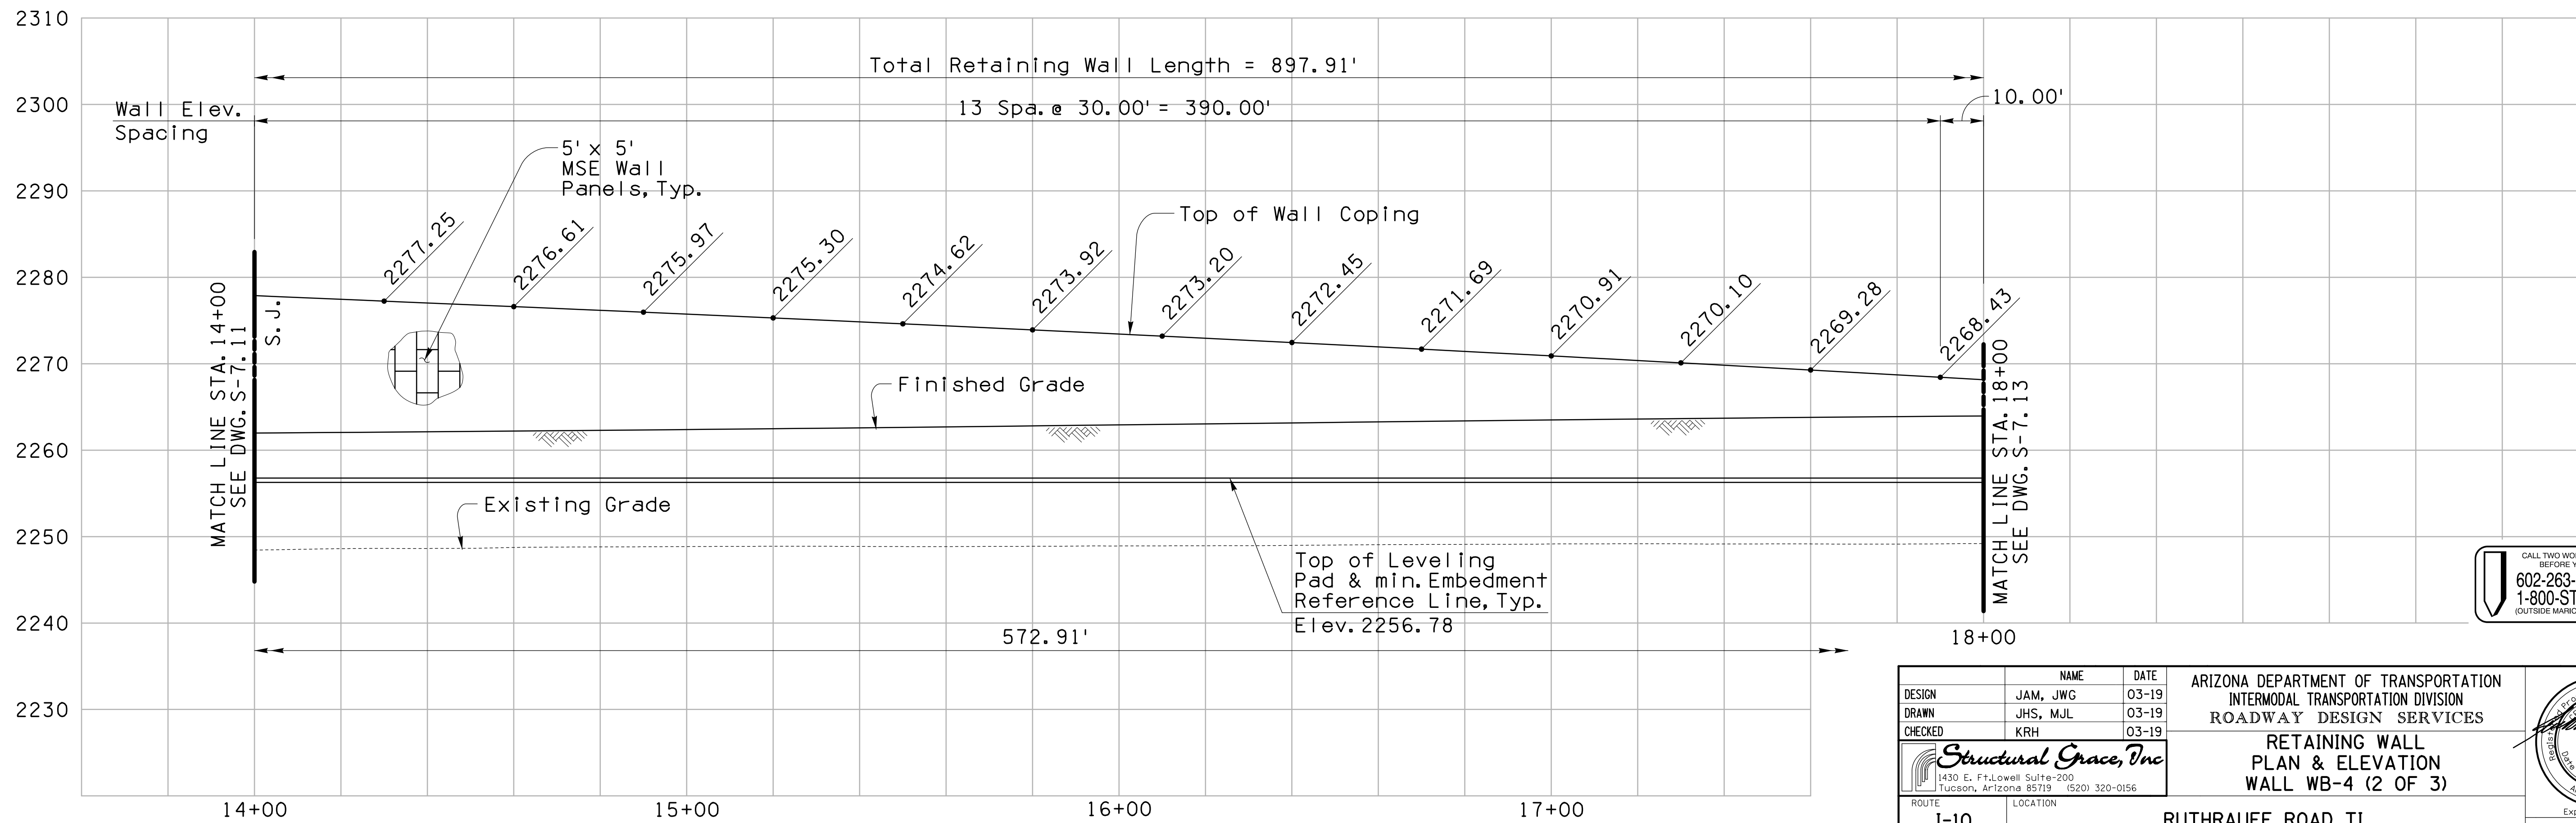

ELEVATION - WALL WB-4 (MSE)  
Horiz. : 1" = 20' ; Vert. 1" = 10'

CALL TWO WORKING DAYS BEFORE YOU DIG  
602-263-1100  
1-800-STAKE-IT  
(OUTSIDE MARICOPA COUNTY)

DESIGN	NAME	DATE	ARIZONA DEPARTMENT OF TRANSPORTATION INTERMODAL TRANSPORTATION DIVISION ROADWAY DESIGN SERVICES
DRAWN	JAM, JWJ	03-19	
CHECKED	KRH	03-19	

<b>Structural Grace, Inc</b>		<b>RETAINING WALL PLAN &amp; ELEVATION WALL WB-4 (2 OF 3)</b>	
1430 E. Ft. Lowell Suite 200 Tucson, Arizona 85719 (520) 320-0156			
ROUTE	LOCATION	RUTHRAUFF ROAD TI	
I-10			
TRACS NO. H 8480 01C		010-D(213)S	OF

F.H.W.A. REGION	STATE	PROJECT NO.	SHEET NO.	TOTAL SHEETS	AS BUILT
9	ARIZ.	010-D(213)S	715	849	

010 PM 252

**CURVE DATA**

①  
 $\Delta = 1^{\circ}12'49''$   
 $R = 11417.03'$   
 $L = 242.41'$   
 $T = 121.21'$


②  
 $\Delta = 3^{\circ}24'26''$   
 $R = 11459.16'$   
 $L = 681.43'$   
 $T = 340.81'$

**Note:**


Contractor shall see Architectural Treatment Plans for the MSE icon designs, vertical rustication pattern and blank panel requirements. Full-scale mock-ups are required for each specific design.

Slip Joints shall be positioned such that they do not bisect the architectural wall treatments. Not all of the slip joints are shown on the plans. The Contractor shall follow the Special Provisions for placement of the other required slip joint locations, plus other locations required per the wall manufacturer's design.

The location of all utilities is approximate. The contractor shall review the utility plans and potholing information to confirm the location of new and existing utilities prior to construction.

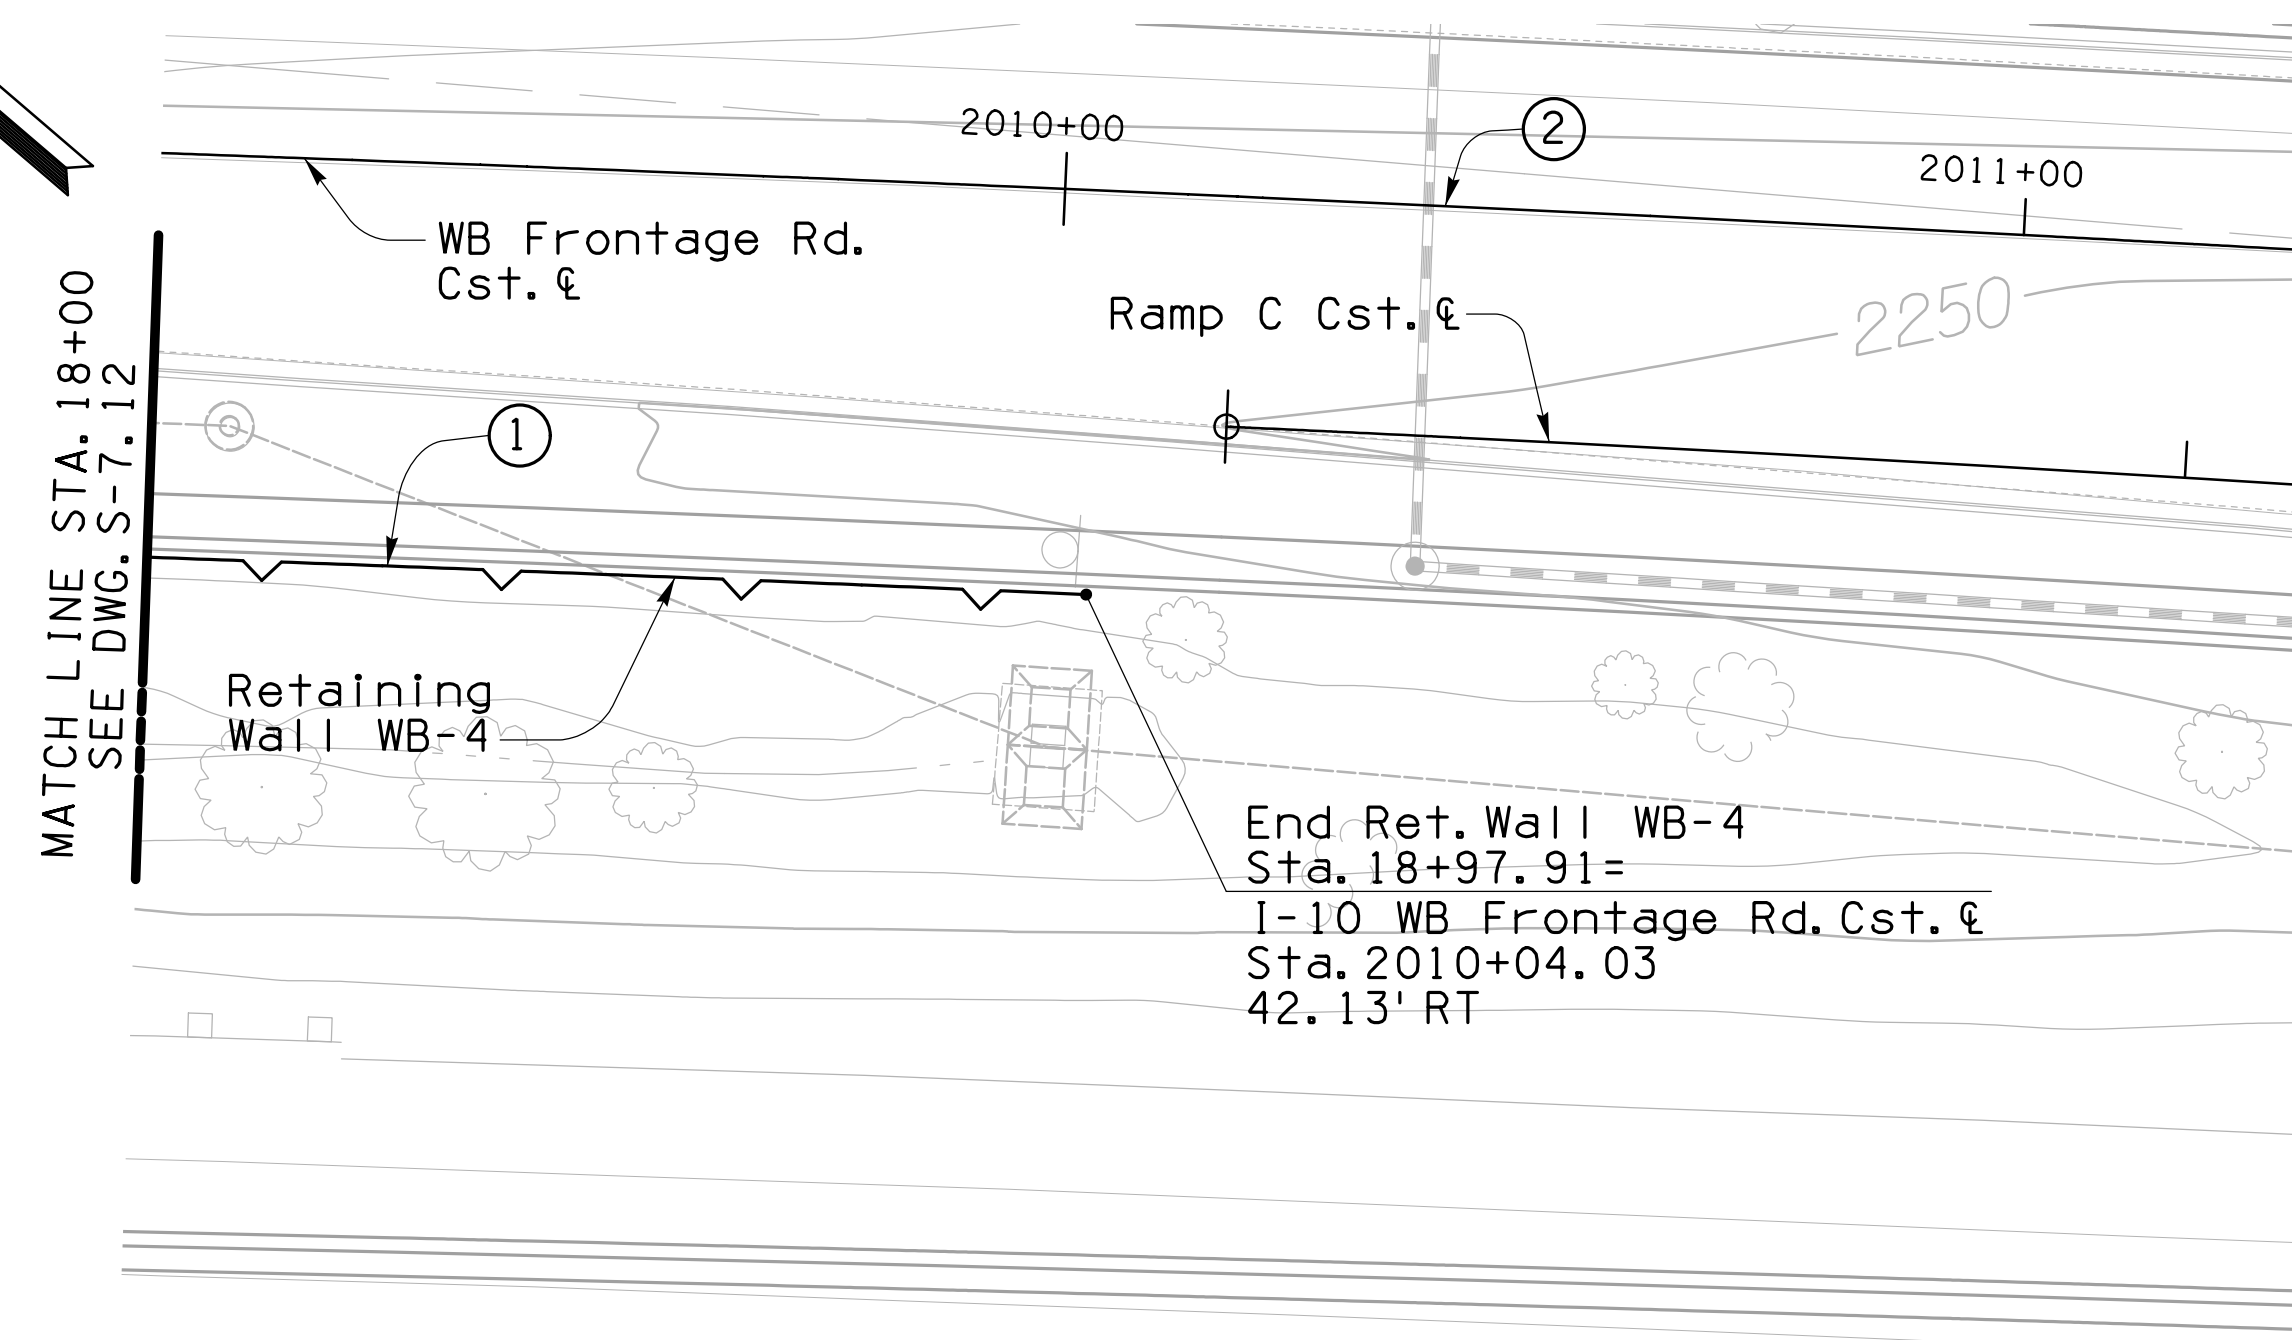


**PLAN - WALL WB-4 (MSE)**  
 1" = 20'

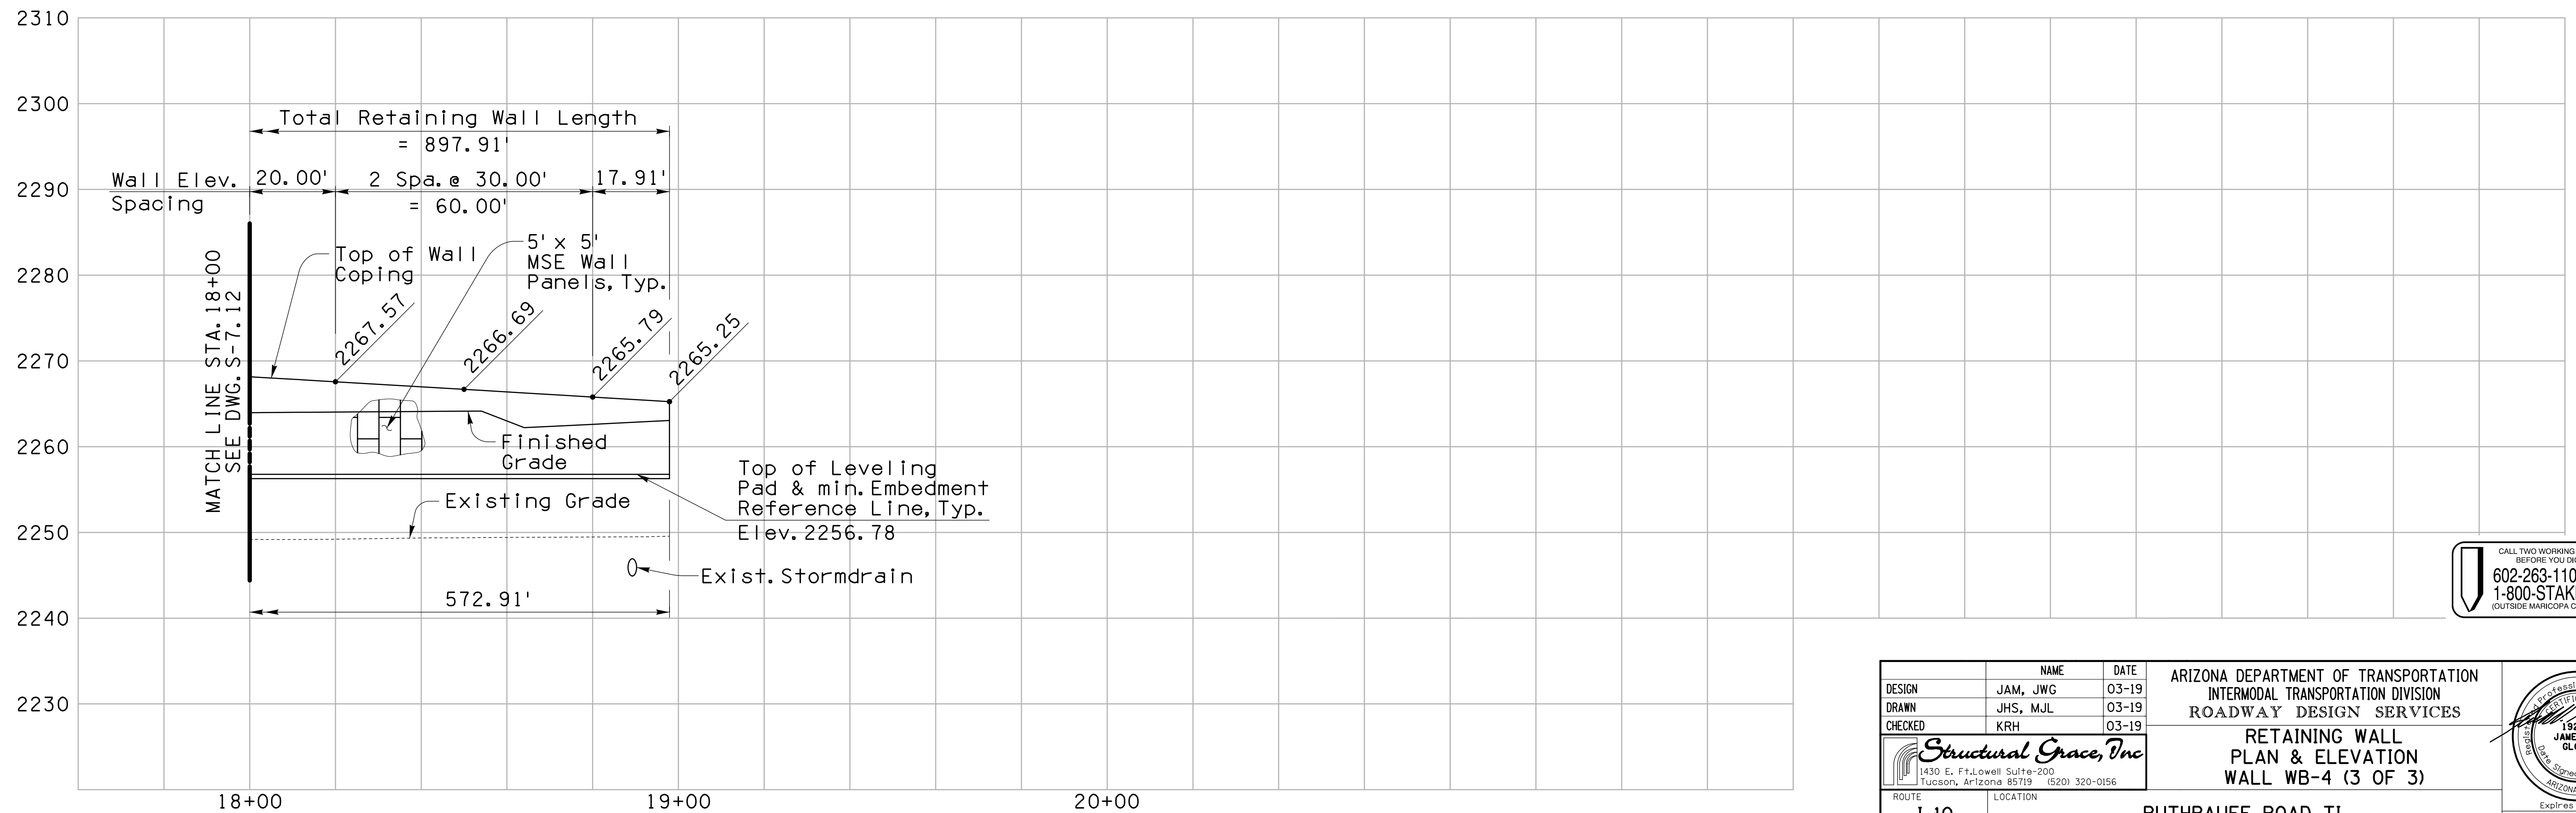

**ELEVATION - WALL WB-4 (MSE)**  
 Horiz.: 1" = 20'; Vert.: 1" = 10'



DESIGN	JAM, JWG	03-19	ARIZONA DEPARTMENT OF TRANSPORTATION INTERMODAL TRANSPORTATION DIVISION ROADWAY DESIGN SERVICES
DRAWN	JHS, MJL	03-19	
CHECKED	KRH	03-19	
			<b>RETAINING WALL PLAN &amp; ELEVATION WALL WB-4 (3 OF 3)</b>
ROUTE	I-10	LOCATION	
TRACS NO. H 8480 01C			010-D(213)S

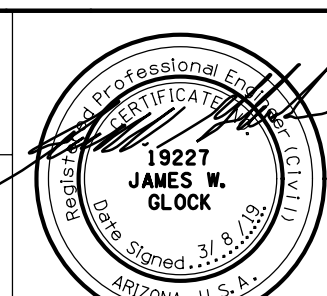



F.H.W.A. REGION	STATE	PROJECT NO.	SHEET NO.	TOTAL SHEETS	AS BUILT
9	ARIZ.	010-D(213)S	716	849	


010 PM 252

**Note:**


Contractor shall see Architectural Treatment Plans for the MSE icon designs, vertical rustication pattern and blank panel requirements. Full-scale mock-ups are required for each specific design.

Slip Joints shall be positioned such that they do not bisect the architectural wall treatments. Not all of the slip joints are shown on the plans. The Contractor shall follow the Special Provisions for placement of the other required slip joint locations, plus other locations required per the wall manufacturer's design.

The location of all utilities is approximate. The contractor shall review the utility plans and potholing information to confirm the location of new and existing utilities prior to construction.

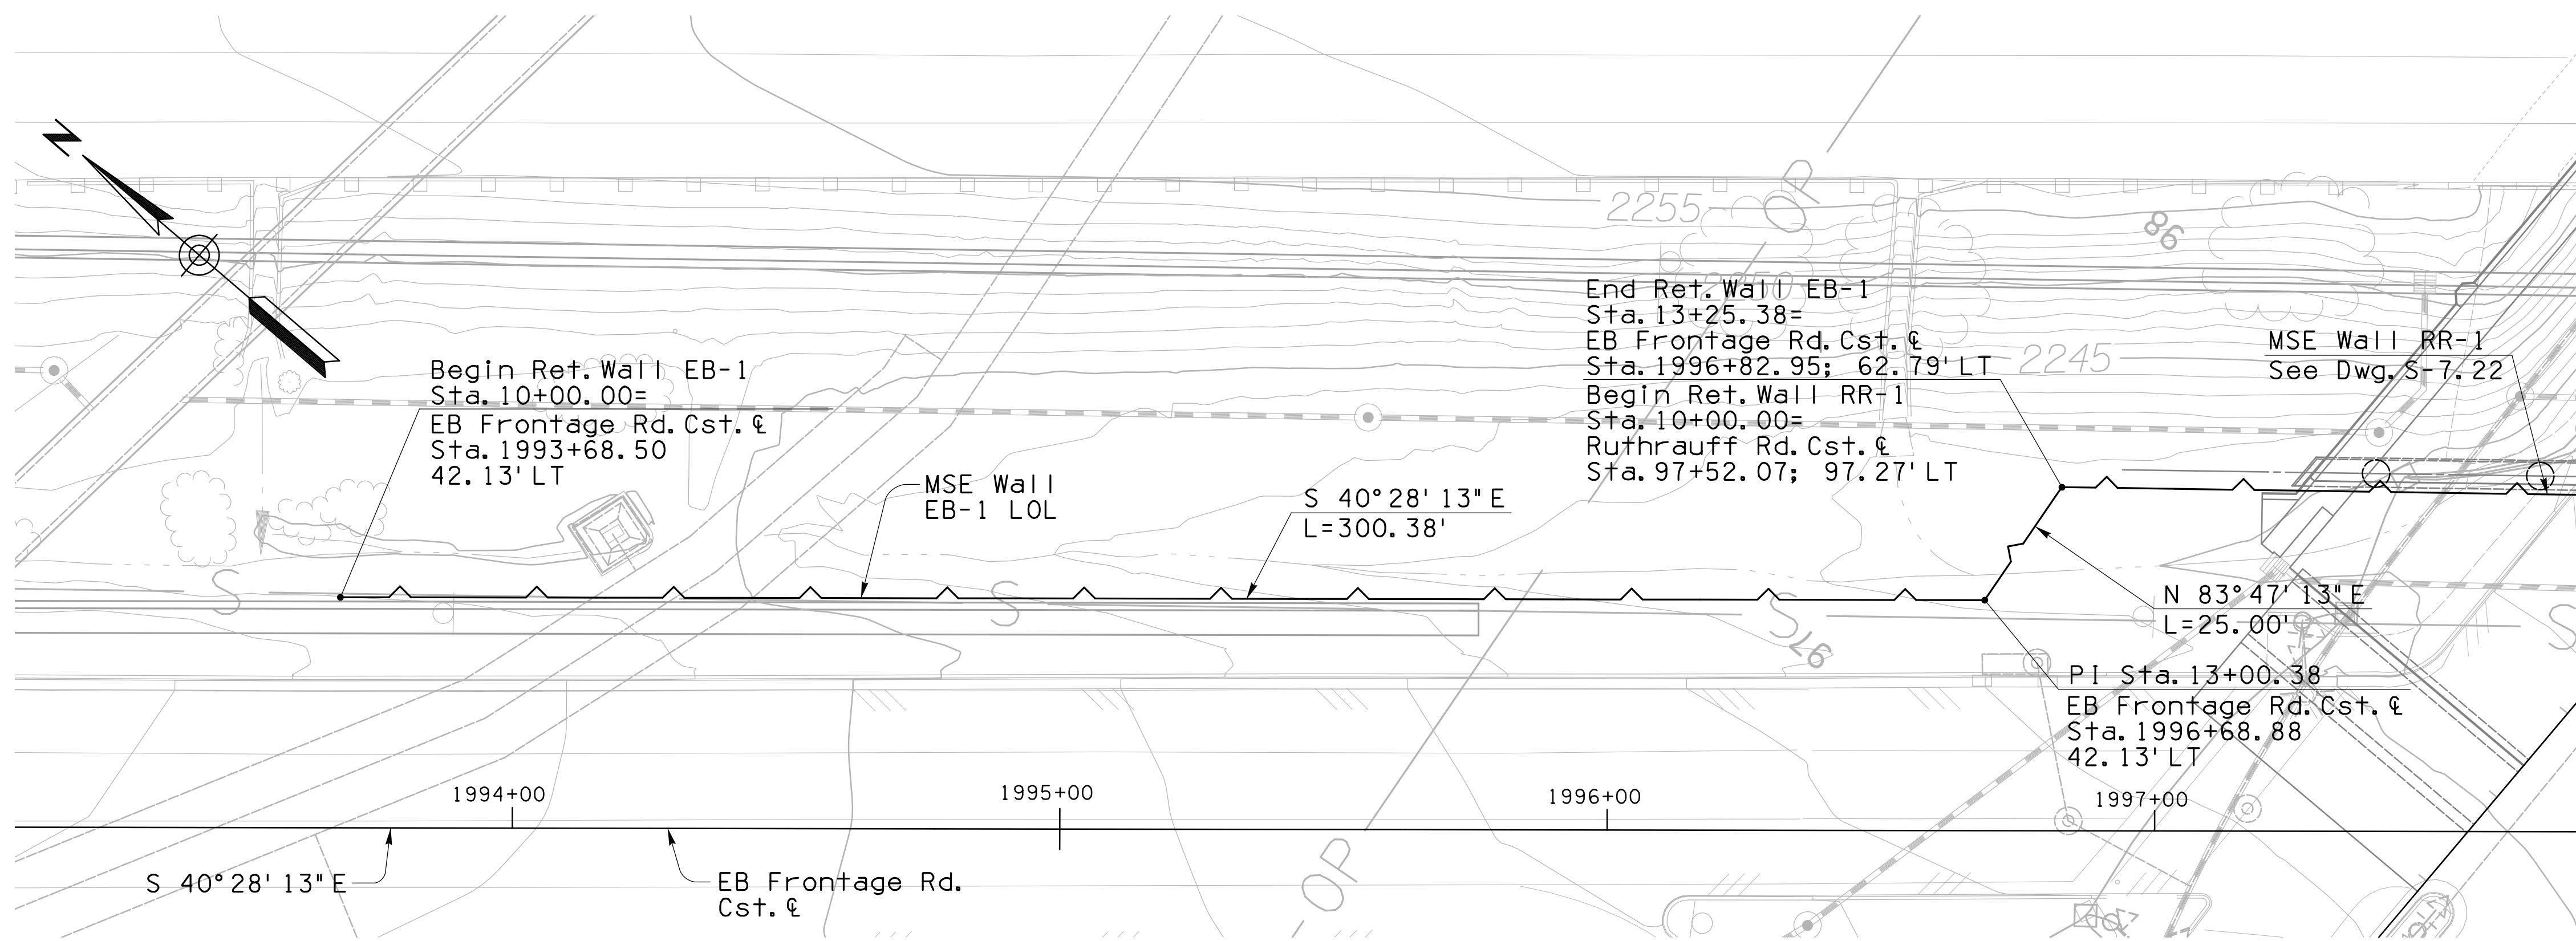

PLAN - WALL EB-1 (MSE)  
1" = 20'

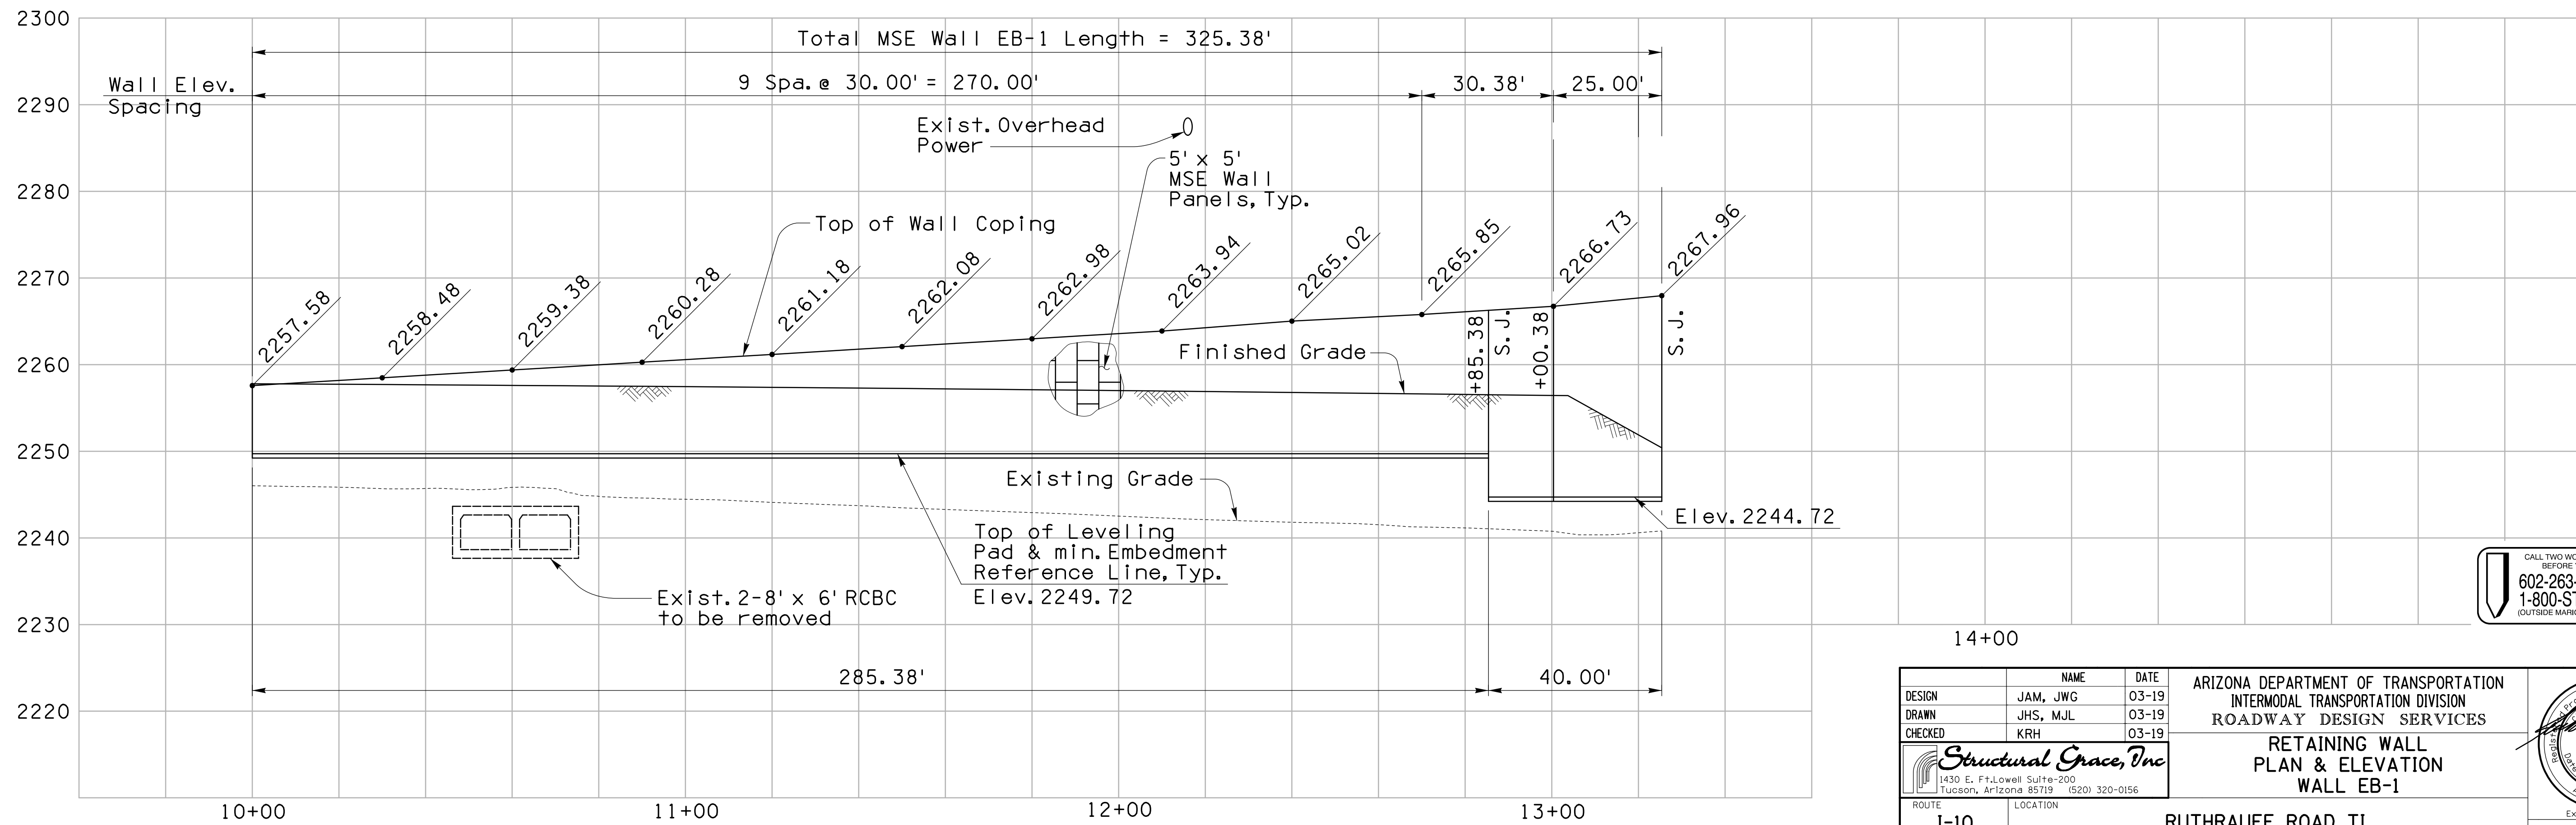

ELEVATION - WALL EB-1 (MSE)  
Horiz. : 1" = 20'; Vert. : 1" = 10'




DESIGN	NAME	DATE	ARIZONA DEPARTMENT OF TRANSPORTATION INTERMODAL TRANSPORTATION DIVISION ROADWAY DESIGN SERVICES
DRAWN	JHS, MJL	03-19	
CHECKED	KRH	03-19	

 1430 E. Ft. Lowell Suite 200 Tucson, Arizona 85719 (520) 320-0156		
ROUTE	LOCATION	
I-10	RUTHRAUFF ROAD TI	RETAINING WALL PLAN & ELEVATION WALL EB-1
TRACS NO. H 8480 01C		010-D(213)S
		DF

F.H.W.A. REGION	STATE	PROJECT NO.	SHEET NO.	TOTAL SHEETS	AS BUILT
9	ARIZ.	010-D(213)S	717	849	

010 PM 252

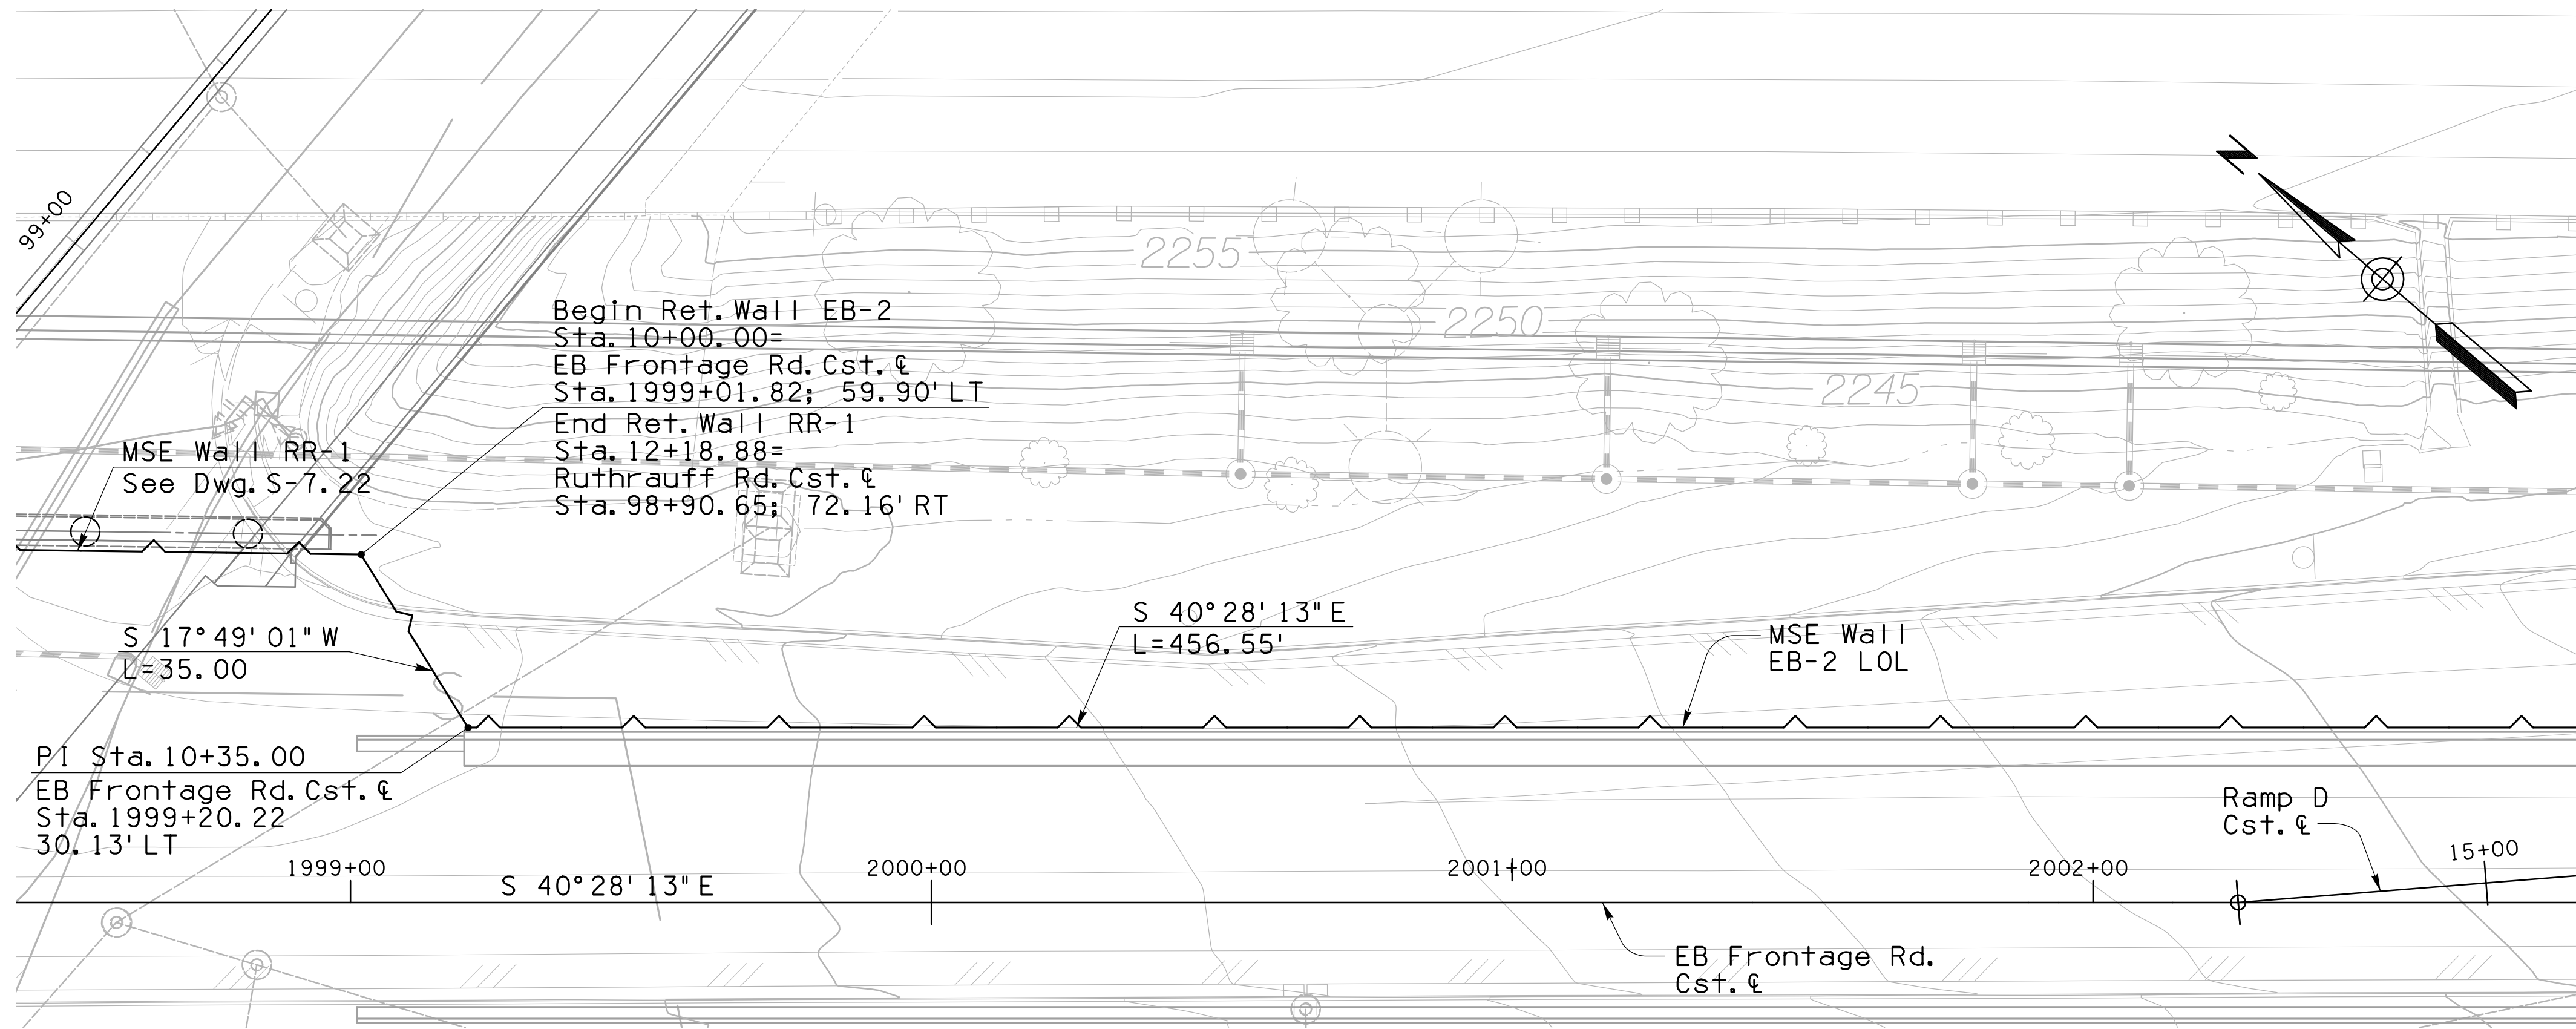


**Note:**

Contractor shall see Architectural Treatment Plans for the MSE icon designs, vertical rustication pattern and blank panel requirements. Full-scale mock-ups are required for each specific design.

Slip Joints shall be positioned such that they do not bisect the architectural wall treatments. Not all of the slip joints are shown on the plans. The Contractor shall follow the Special Provisions for placement of the other required slip joint locations, plus other locations required per the wall manufacturer's design.

The location of all utilities is approximate. The contractor shall review the utility plans and potholing information to confirm the location of new and existing utilities prior to construction.

PLAN - WALL EB-2 (MSE)  
1" = 20'

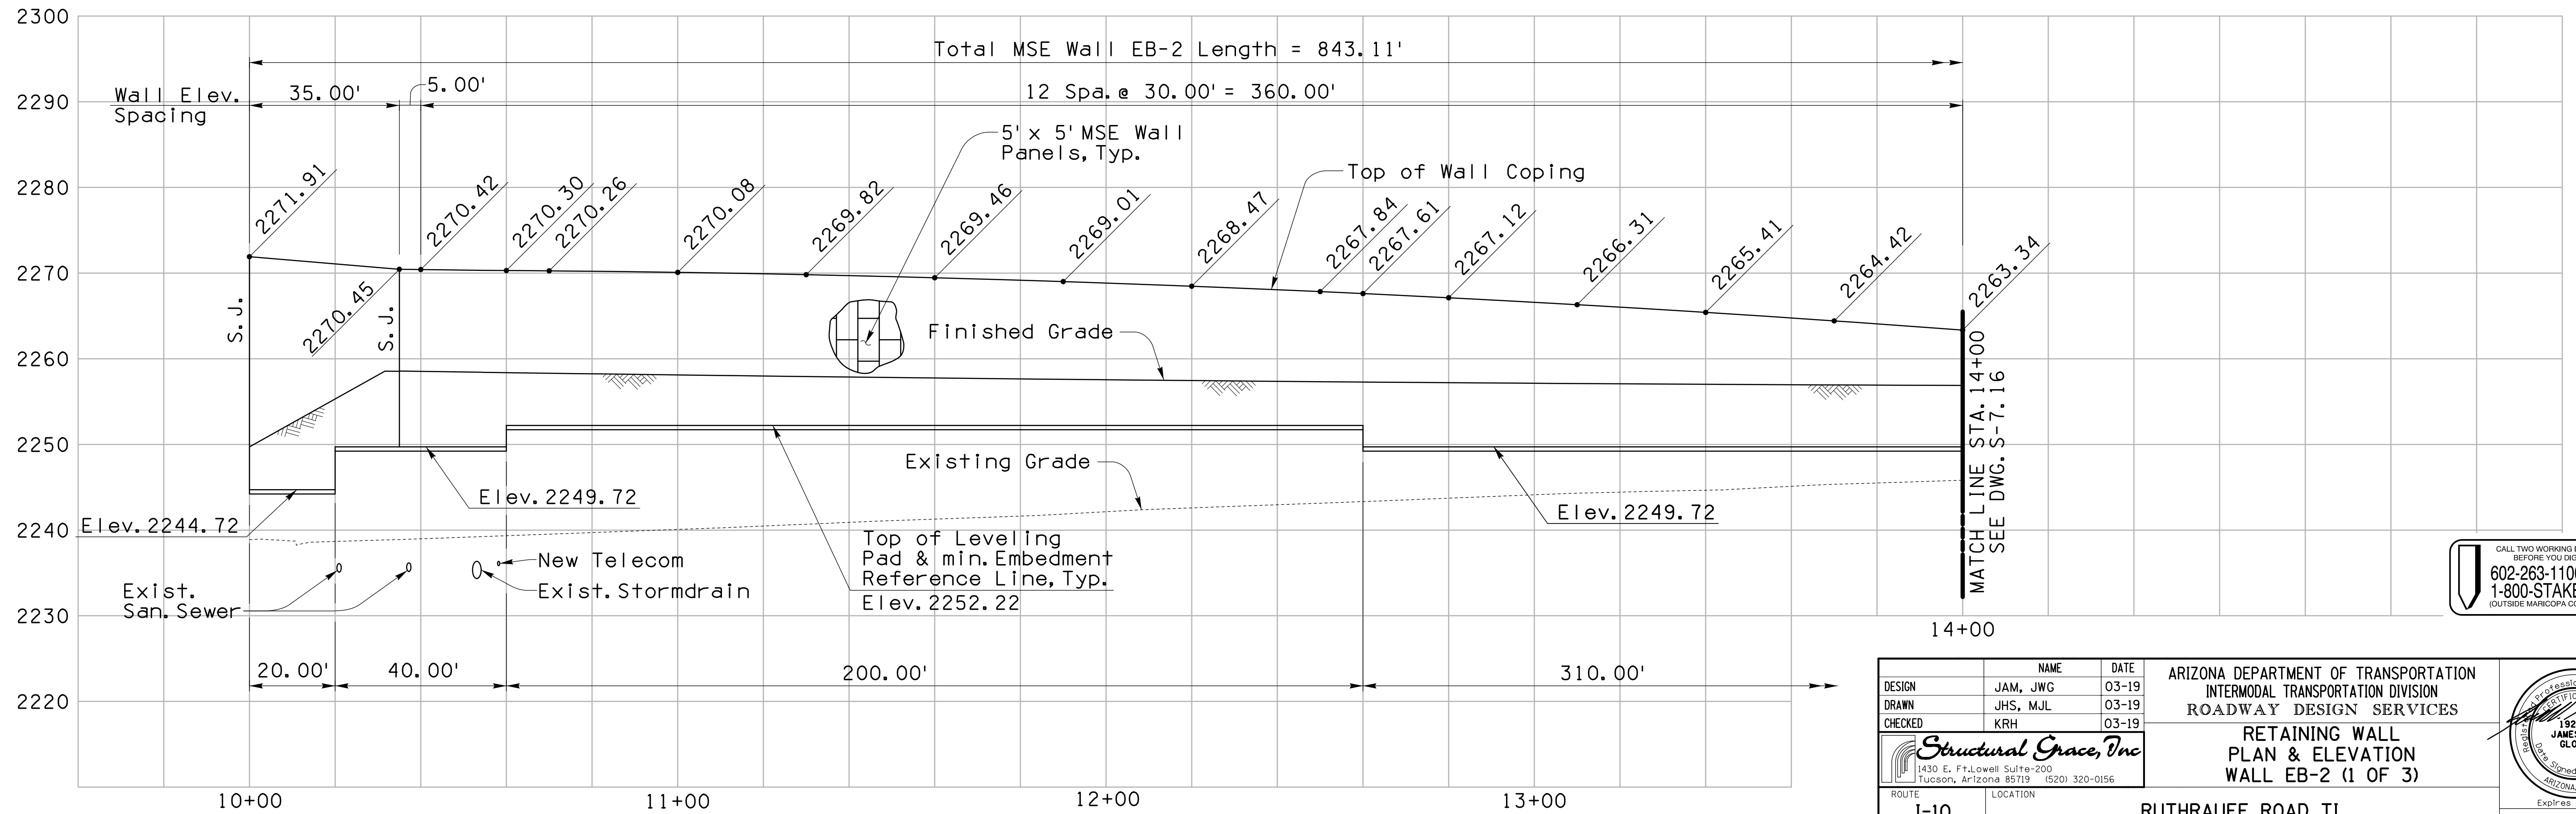

ELEVATION - WALL EB-2 (MSE)  
Horiz.: 1" = 20'; Vert.: 1" = 10'




DESIGN	NAME	DATE	ARIZONA DEPARTMENT OF TRANSPORTATION INTERMODAL TRANSPORTATION DIVISION ROADWAY DESIGN SERVICES
DRAWN	JAM, JWJ	03-19	
CHECKED	KRH	03-19	

 1430 E. Ft. Lowell Suite 200 Tucson, Arizona 85719 (520) 320-0156		<b>RETAINING WALL PLAN &amp; ELEVATION WALL EB-2 (1 OF 3)</b>	 Expires: 12/31/20
ROUTE	LOCATION		
I-10	RUTHRAUFF ROAD TI	010-D(213)S	OF

SURVEY NO. FINISHED PLANS DATE REVISIONS LOCATION DATE

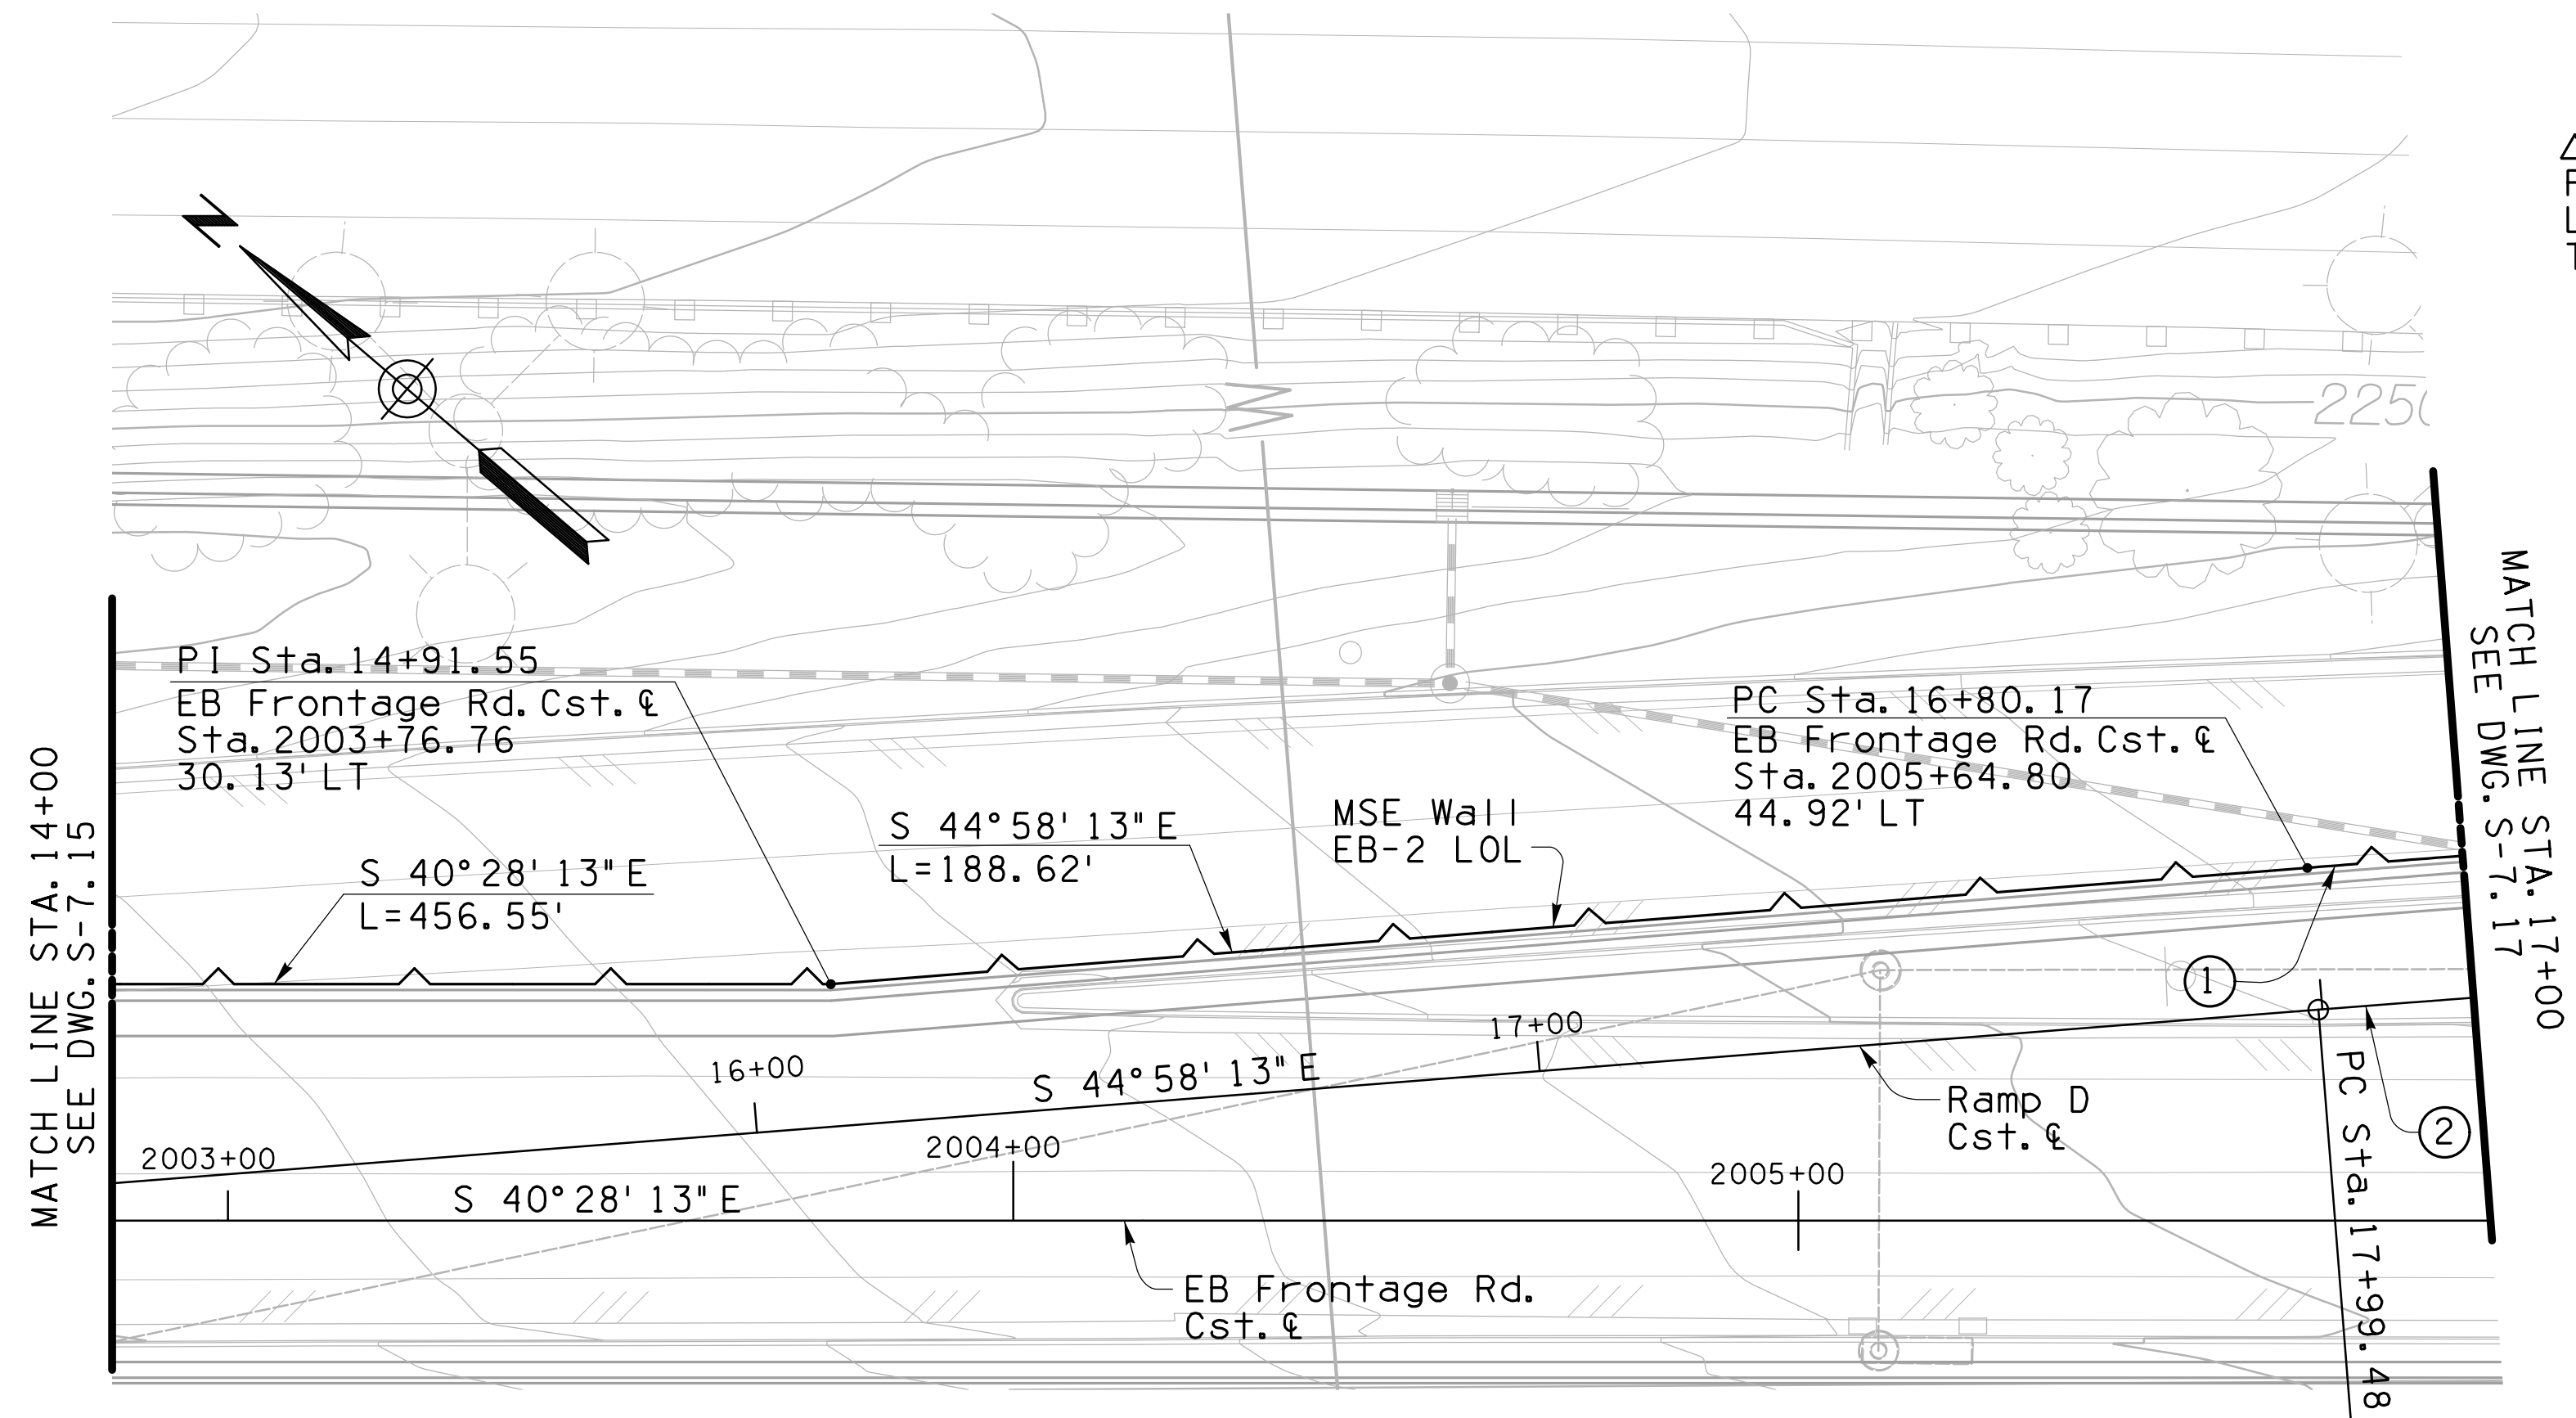

PLAN - WALL EB-2 (MSE)  
1" = 20'

CURVE DATA

①	②
$\Delta = 1^{\circ}05'3''$	$\Delta = 3^{\circ}09'55''$
$R = 8612.49'$	$R = 8594.67'$
$L = 162.95'$	$L = 474.78'$
$T = 81.47'$	$T = 237.39'$

F.H.W.A. REGION	STATE	PROJECT NO.	SHEET NO.	TOTAL SHEETS	AS BUILT
9	ARIZ.	010-D(213)S	718	849	


010 PM 252

Note:

Contractor shall see Architectural Treatment Plans for the MSE Icon designs, vertical rustication pattern and blank panel requirements. Full-scale mock-ups are required for each specific design.

Slip Joints shall be positioned such that they do not bisect the architectural wall treatments. Not all of the slip joints are shown on the plans. The Contractor shall follow the Special Provisions for placement of the other required slip joint locations, plus other locations required per the wall manufacturer's design.

The location of all utilities is approximate. The contractor shall review the utility plans and potholing information to confirm the location of new and existing utilities prior to construction.

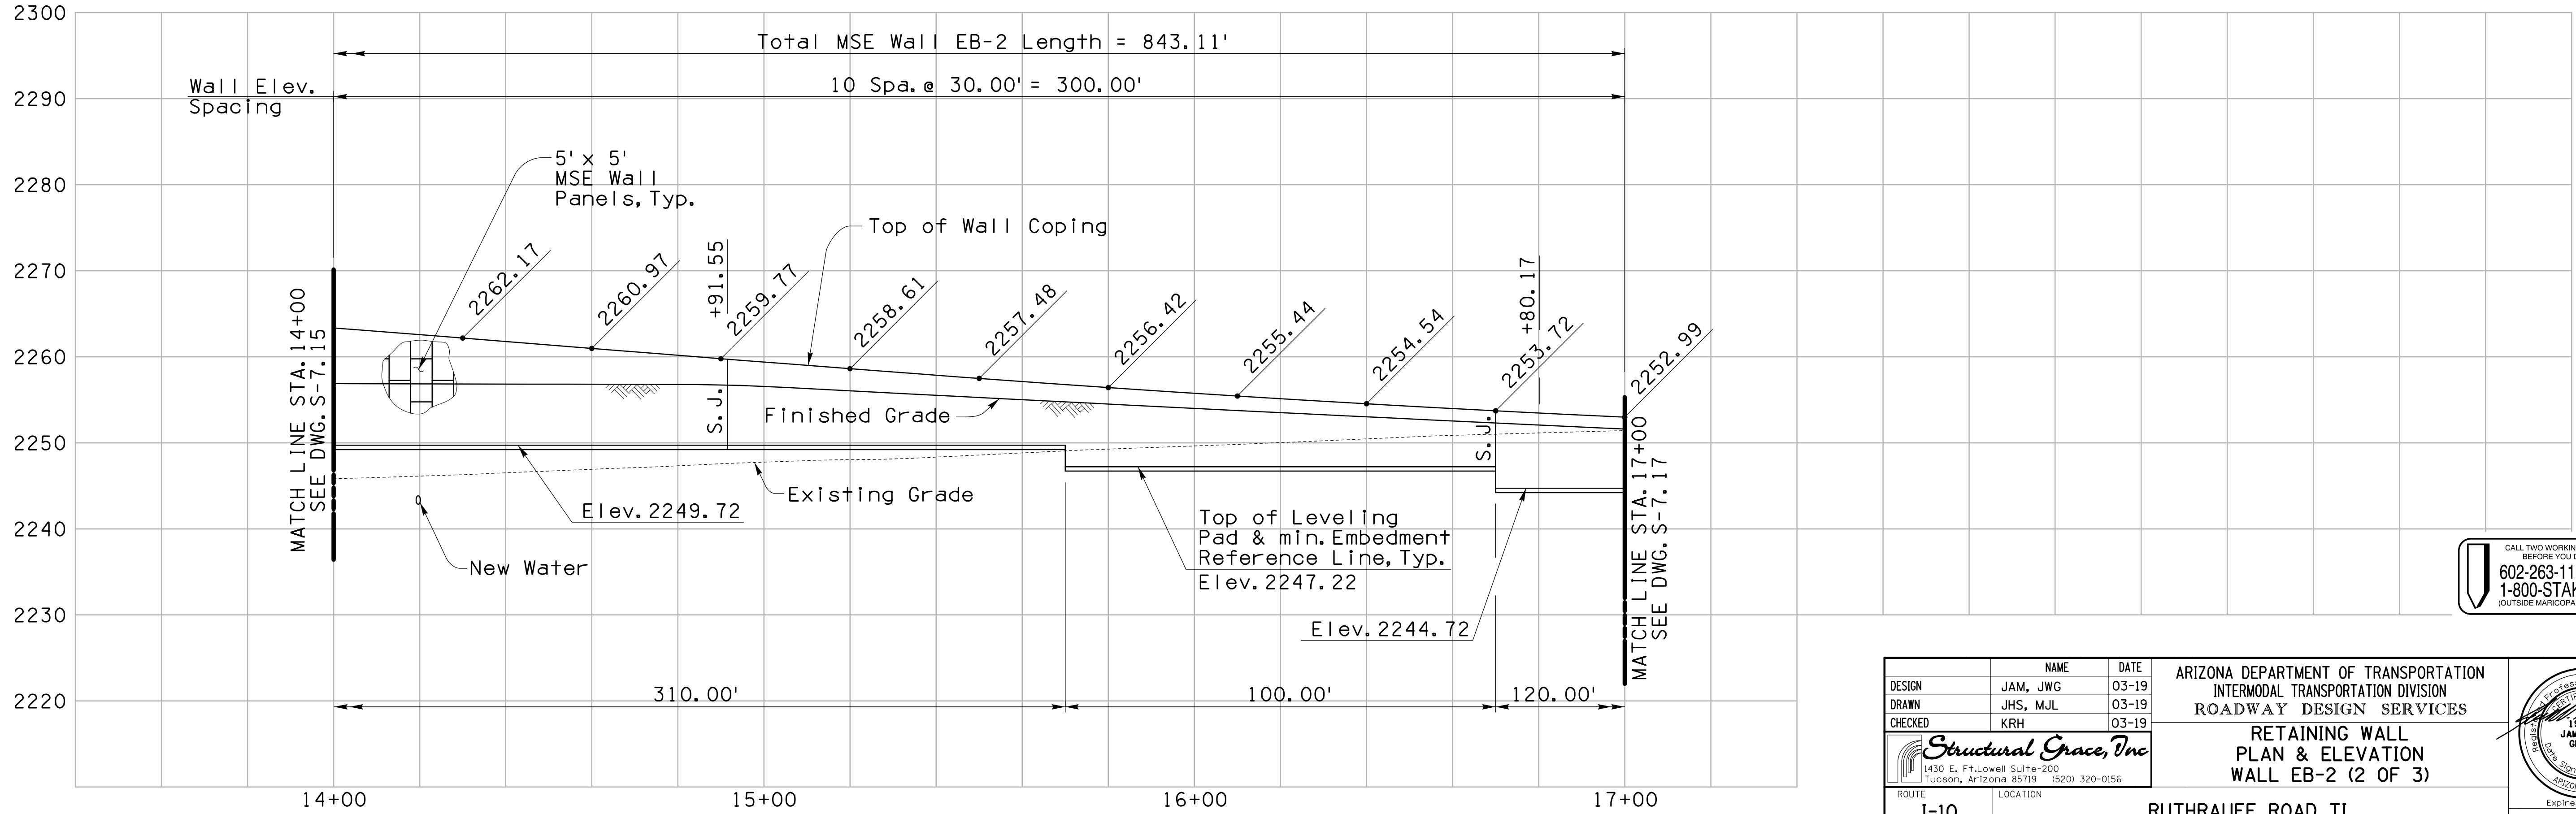


ELEVATION - WALL EB-2 (MSE)  
Horiz.: 1" = 20'; Vert.: 1" = 10'




DESIGN	JAM, JWJ	03-19	ARIZONA DEPARTMENT OF TRANSPORTATION INTERMODAL TRANSPORTATION DIVISION ROADWAY DESIGN SERVICES	
DRAWN	JHS, MJL	03-19		
CHECKED	KRH	03-19		
			RETAINING WALL PLAN & ELEVATION WALL EB-2 (2 OF 3)	Expires: 12/31/20 DWG NO. S-7.16
ROUTE	I-10	LOCATION	RUTHRAUFF ROAD TI	TRACS NO. H 8480 01C
			010-D(213)S	OF



SURVEY NO. FINISHED PLANS DATE REVISIONS LOCATION DATE FINISHED PLANS SURVEY NO.

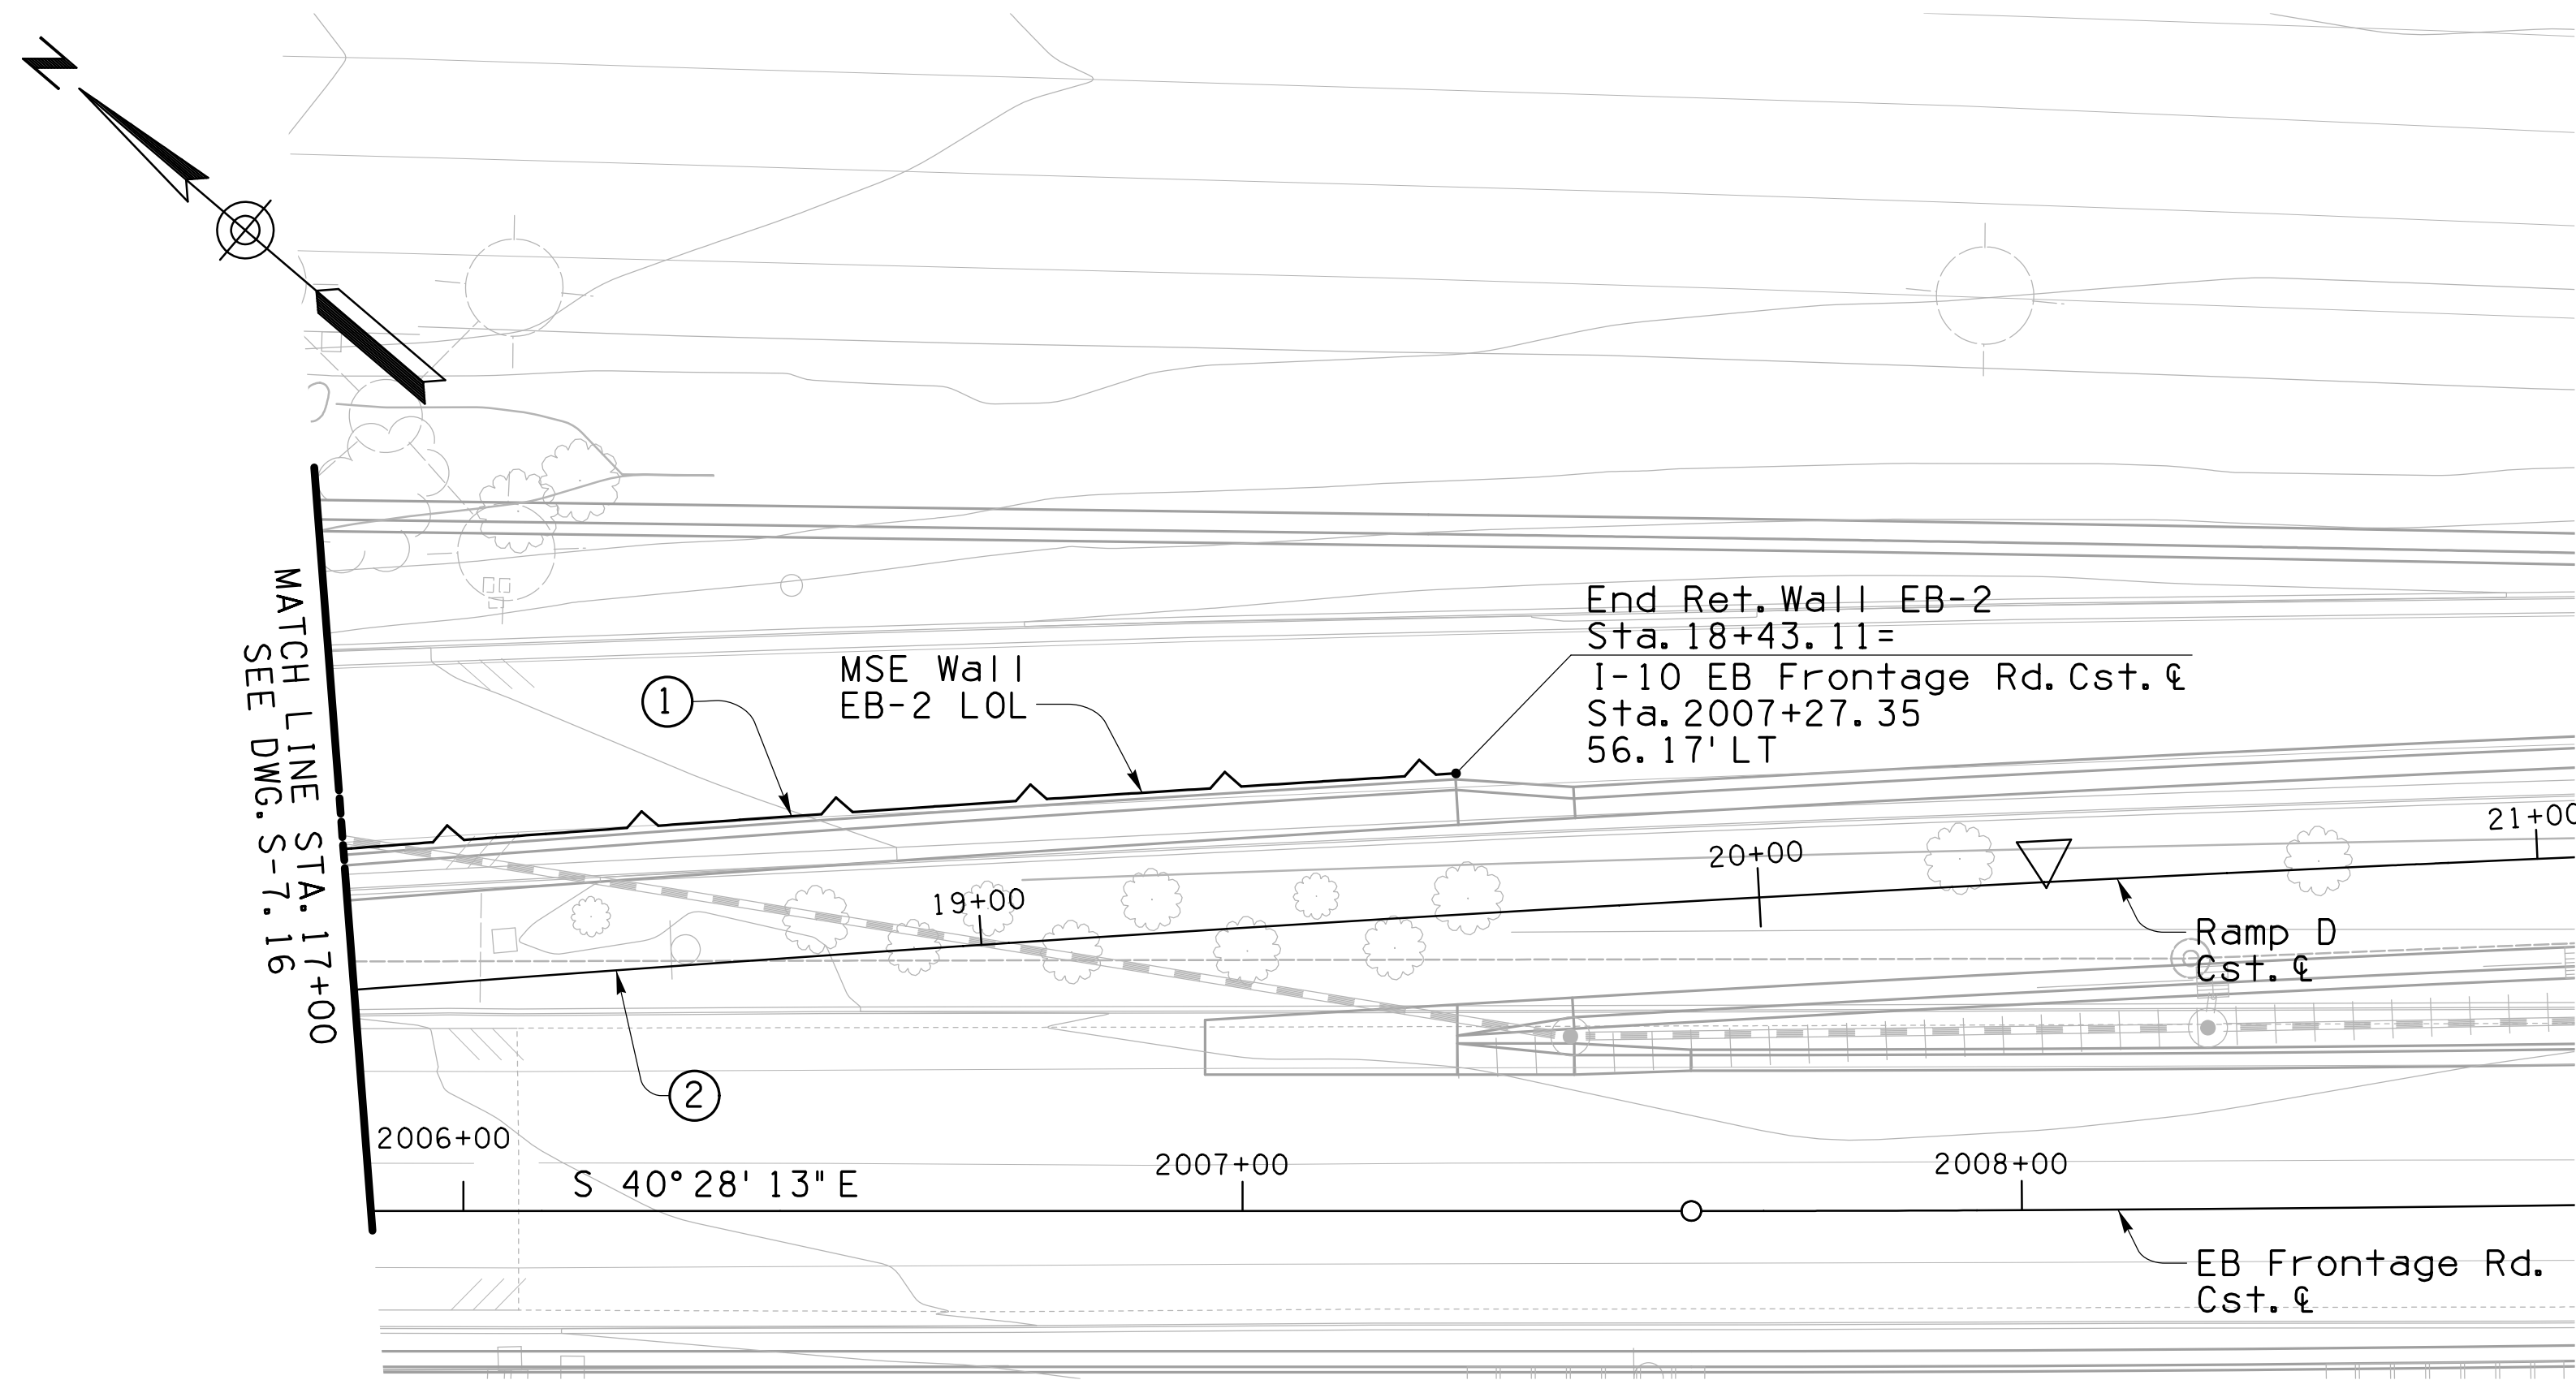

PLAN - WALL EB-2 (MSE)  
1" = 20'

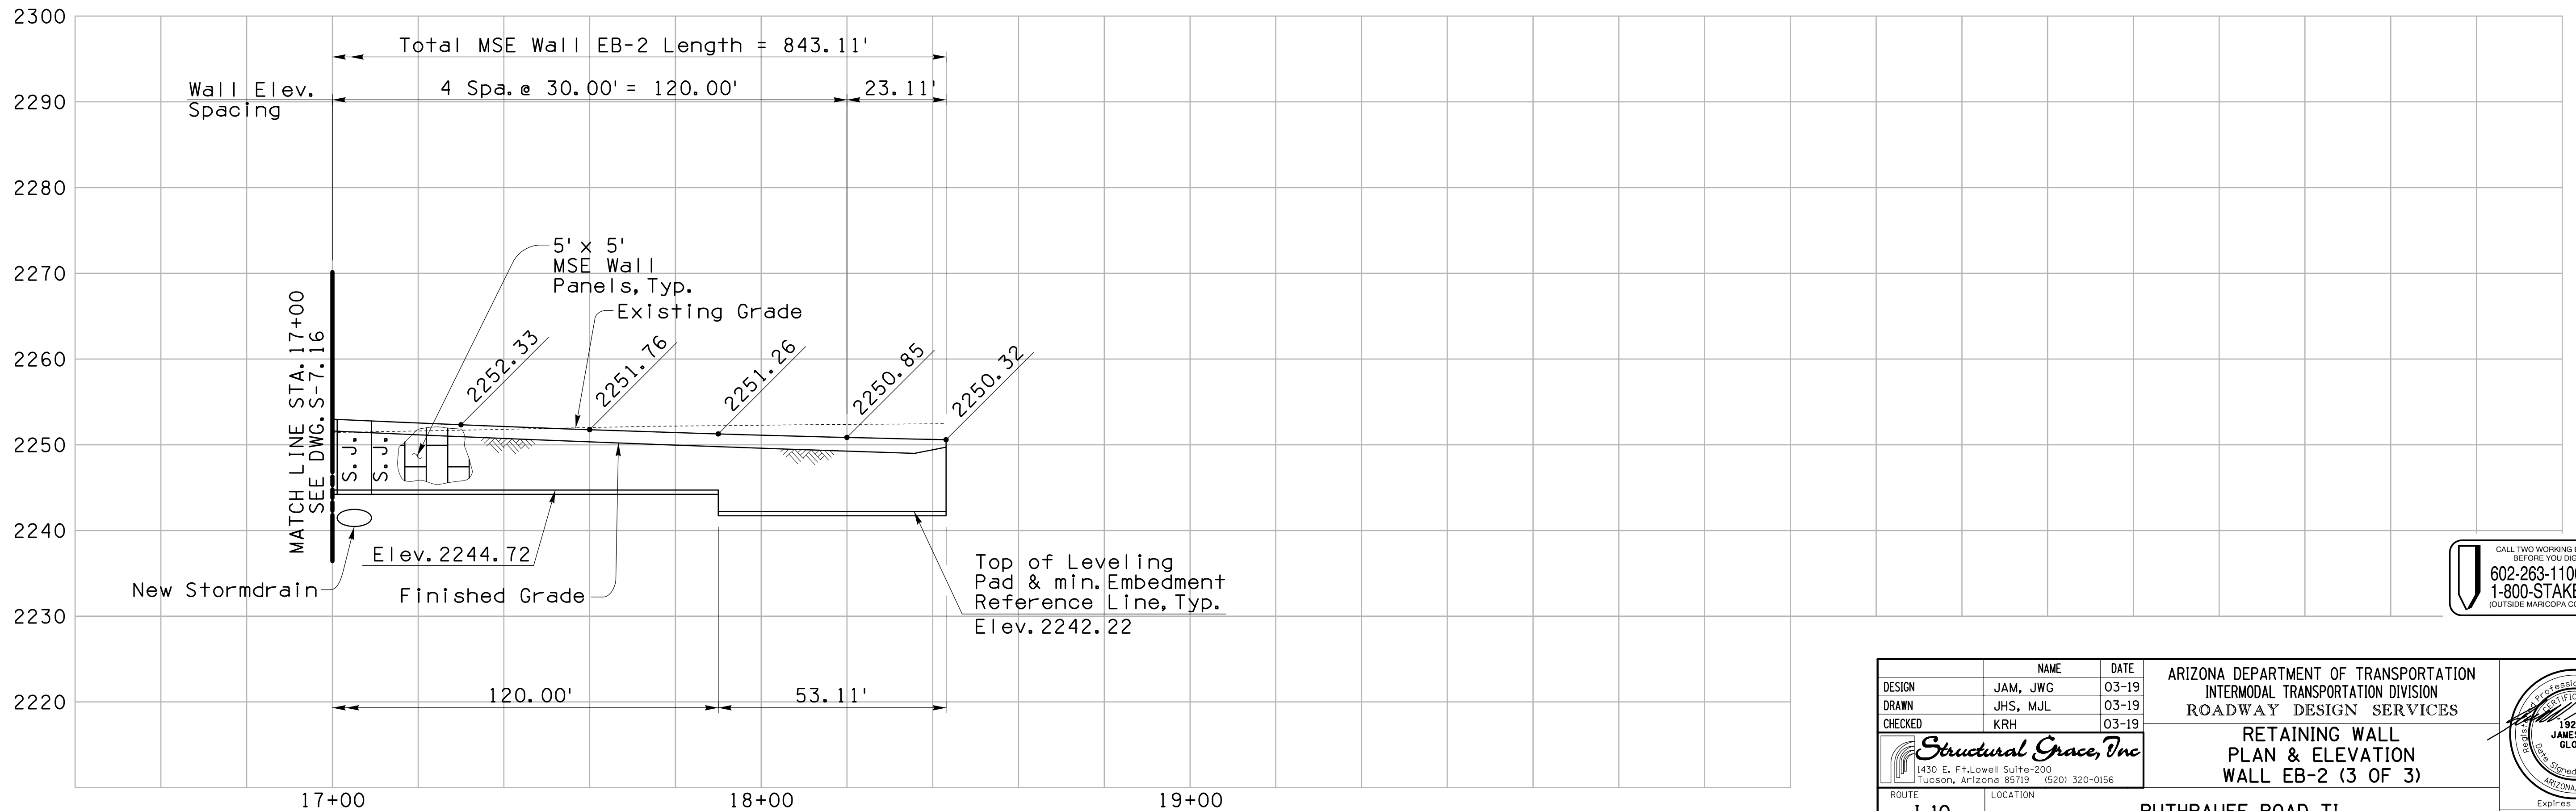

ELEVATION - WALL EB-2 (MSE)  
Horiz. : 1" = 20' ; Vert. : 1" = 10'

CURVE DATA

①	②
$\Delta = 1^{\circ}05'3''$	$\Delta = 3^{\circ}09'55''$
$R = 8612.49'$	$R = 8594.67'$
$L = 162.95'$	$L = 474.78'$
$T = 81.47'$	$T = 237.39'$

F.H.W.A. REGION	STATE	PROJECT NO.	SHEET NO.	TOTAL SHEETS	AS BUILT
9	ARIZ.	010-D(213)S	719	849	

010 PM 252

Note:

Contractor shall see Architectural Treatment Plans for the MSE Icon designs, vertical rustication pattern and blank panel requirements. Full-scale mock-ups are required for each specific design.

Slip Joints shall be positioned such that they do not bisect the architectural wall treatments. Not all of the slip joints are shown on the plans. The Contractor shall follow the Special Provisions for placement of the other required slip joint locations, plus other locations required per the wall manufacturer's design.


The location of all utilities is approximate. The contractor shall review the utility plans and potholing information to confirm the location of new and existing utilities prior to construction.

CALL TWO WORKING DAYS BEFORE YOU DIG  
602-263-1100  
1-800-STAKE-IT  
(OUTSIDE MARICOPA COUNTY)

DESIGN	JAM, JWG	03-19	ARIZONA DEPARTMENT OF TRANSPORTATION INTERMODAL TRANSPORTATION DIVISION ROADWAY DESIGN SERVICES	
DRAWN	JHS, MJL	03-19		
CHECKED	KRH	03-19		
			RETAINING WALL PLAN & ELEVATION WALL EB-2 (3 OF 3)	Expires: 12/31/20 DWG NO. S-7.17
ROUTE	I-10	LOCATION	RUTHRAUFF ROAD TI	
TRACS NO. H 8480 01C		010-D(213)S		OF

F.H.W.A. REGION	STATE	PROJECT NO.	SHEET NO.	TOTAL SHEETS	AS BUILT
9	ARIZ.	010-D(213)S	720	849	

010 PM 252

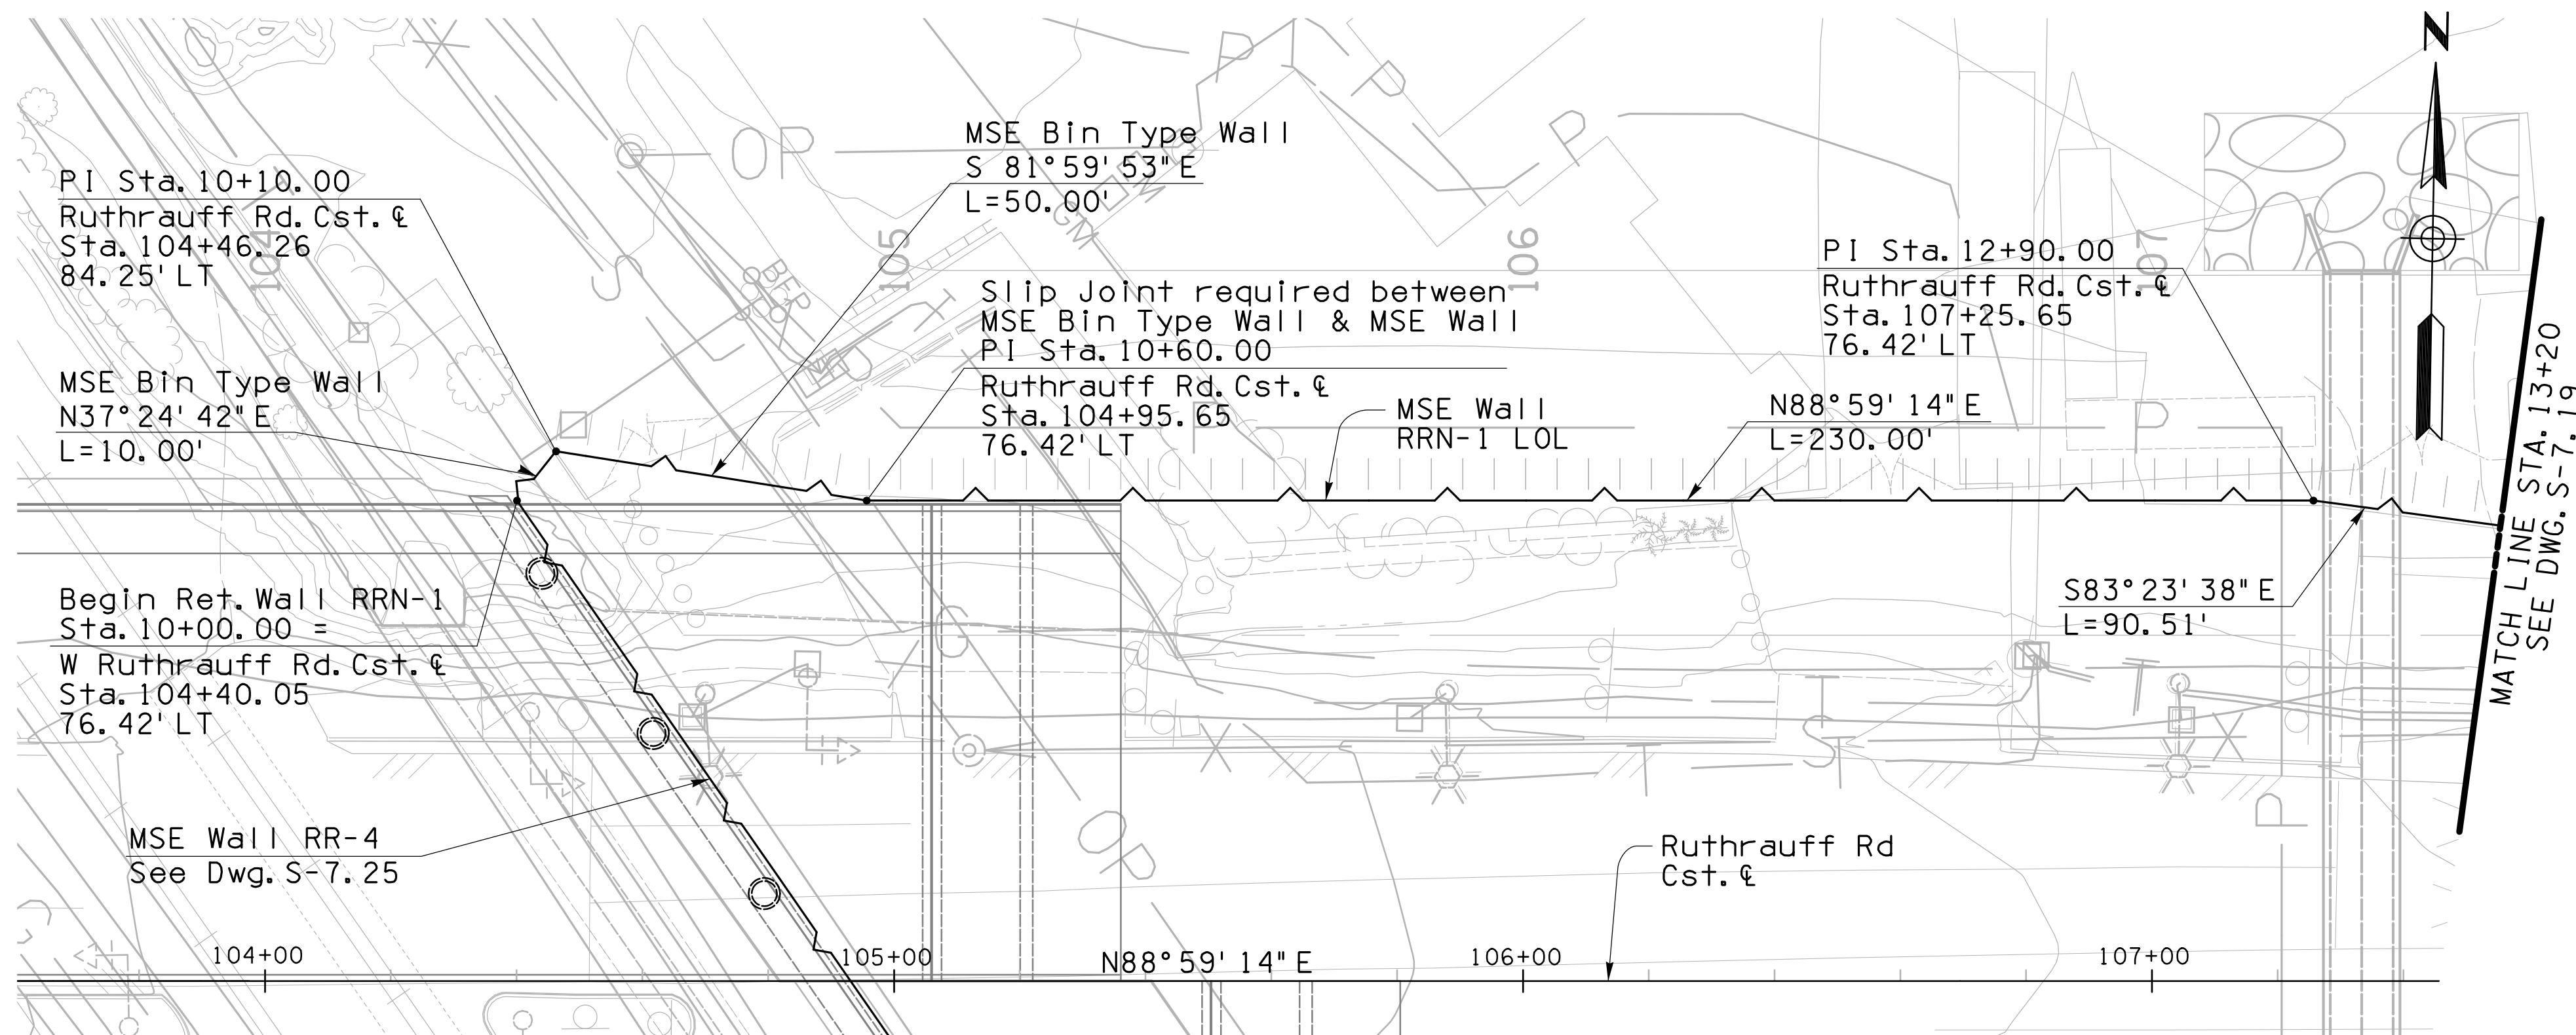

**Notes:**


Contractor shall see Architectural Treatment Plans for the MSE Icon designs, vertical rustication pattern and blank panel requirements. Full-scale mock-ups are required for each specific design.

Measurement and Payment for MSE Bin Type wall shall be the same as MSE wall.

Slip Joints shall be positioned such that they do not bisect the architectural wall treatments. Not all of the slip joints are shown on the plans. The Contractor shall follow the Special Provisions for placement of the other required slip joint locations, plus other locations required per the wall manufacturer's design.

The location of all utilities is approximate. The contractor shall review the utility plans and potholing information to confirm the location of new and existing utilities prior to construction.

PLAN - WALL RRN-1 (MSE)  
1" = 20'

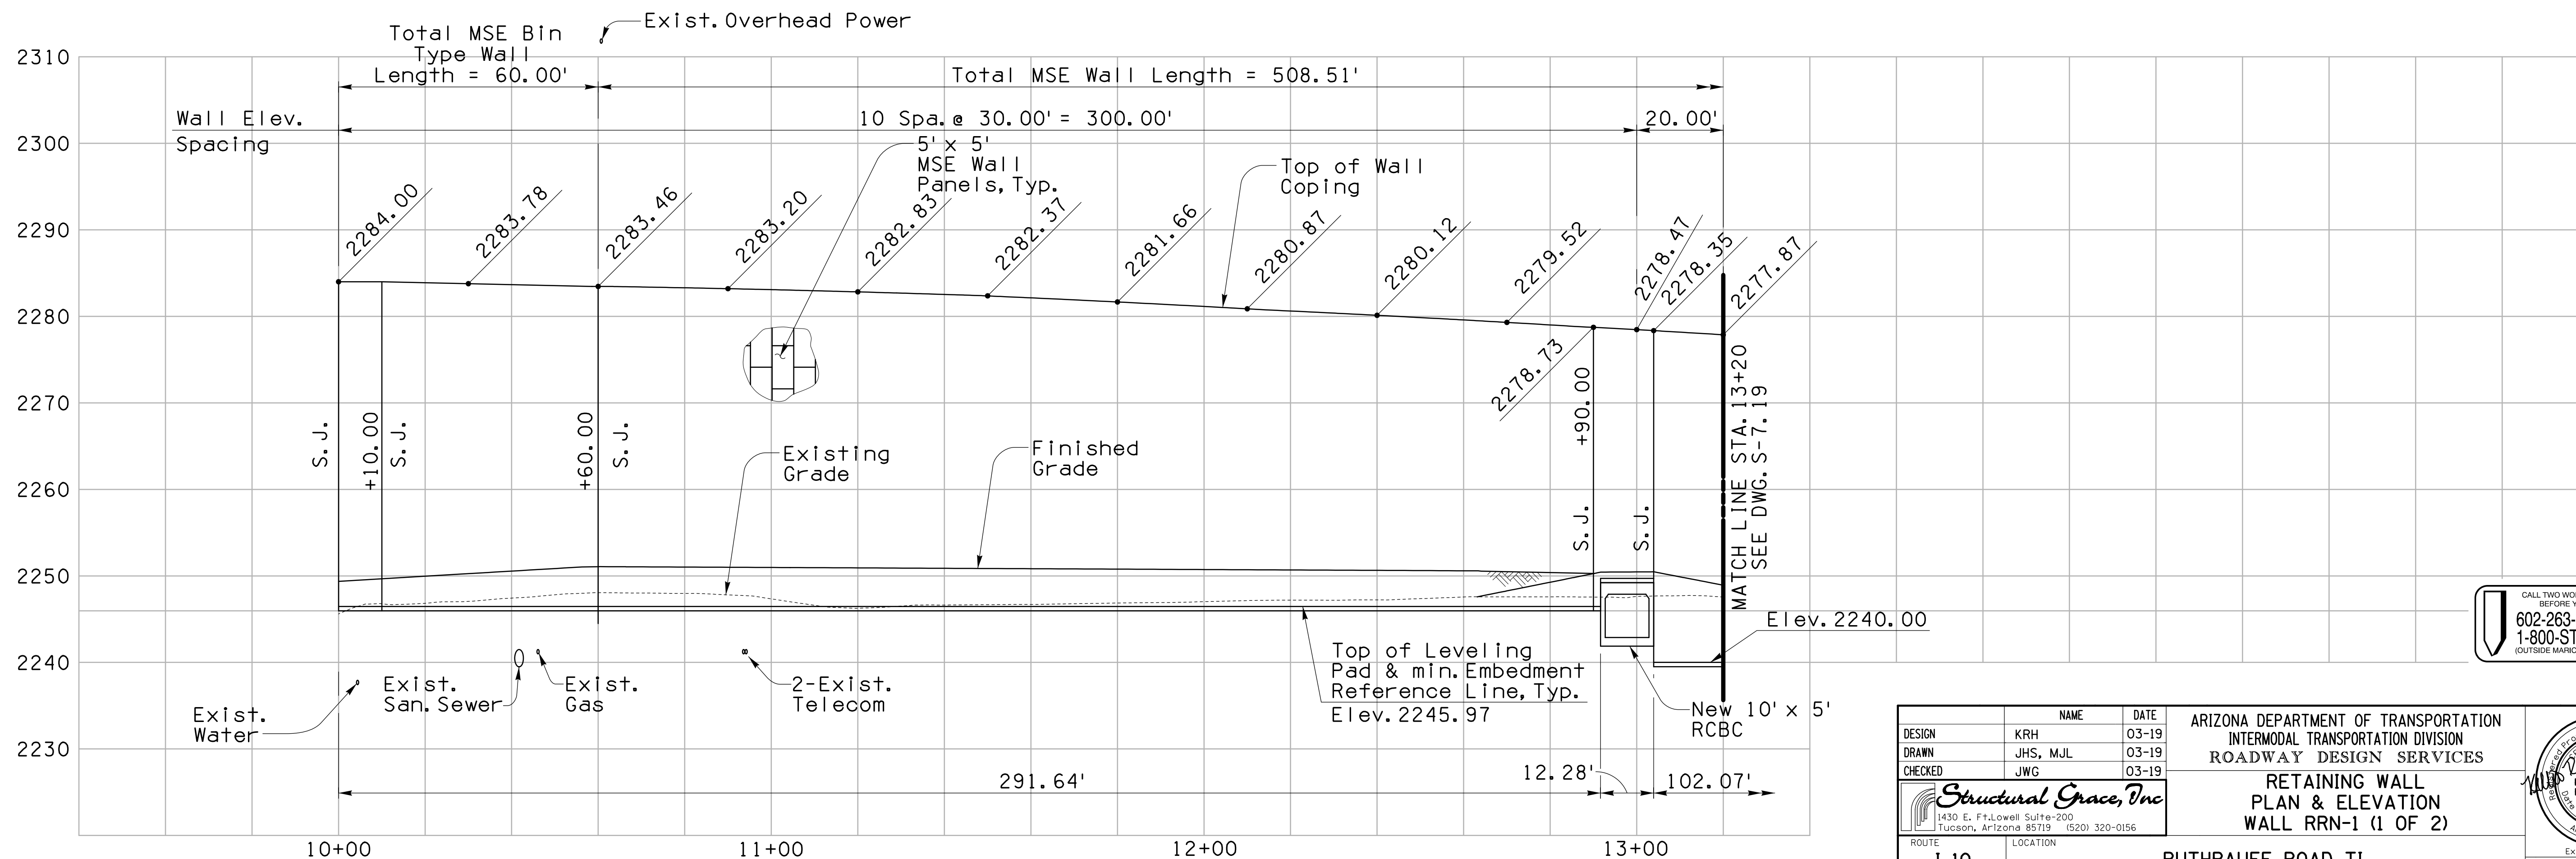


ELEVATION - WALL RRN-1 (MSE)  
Horiz.: 1" = 20'; Vert.: 1" = 10'

CALL TWO WORKING DAYS BEFORE YOU DIG  
602-263-1100  
1-800-STAKE-IT  
(OUTSIDE MARICOPA COUNTY)

DESIGN	NAME	DATE	ARIZONA DEPARTMENT OF TRANSPORTATION INTERMODAL TRANSPORTATION DIVISION ROADWAY DESIGN SERVICES	
DRAWN	JHS, MJL	03-19		
CHECKED	JWG	03-19		
			<b>RETAINING WALL PLAN &amp; ELEVATION WALL RRN-1 (1 OF 2)</b>	
ROUTE	LOCATION	I-10 RUTHRAUFF ROAD TI		
TRACS NO. H 8480 01C			010-D(213)S	DWG NO. S-7.18
				OF

F.H.W.A. REGION	STATE	PROJECT NO.	SHEET NO.	TOTAL SHEETS	AS BUILT
9	ARIZ.	010-D(213)S	721	849	

010 PM 252

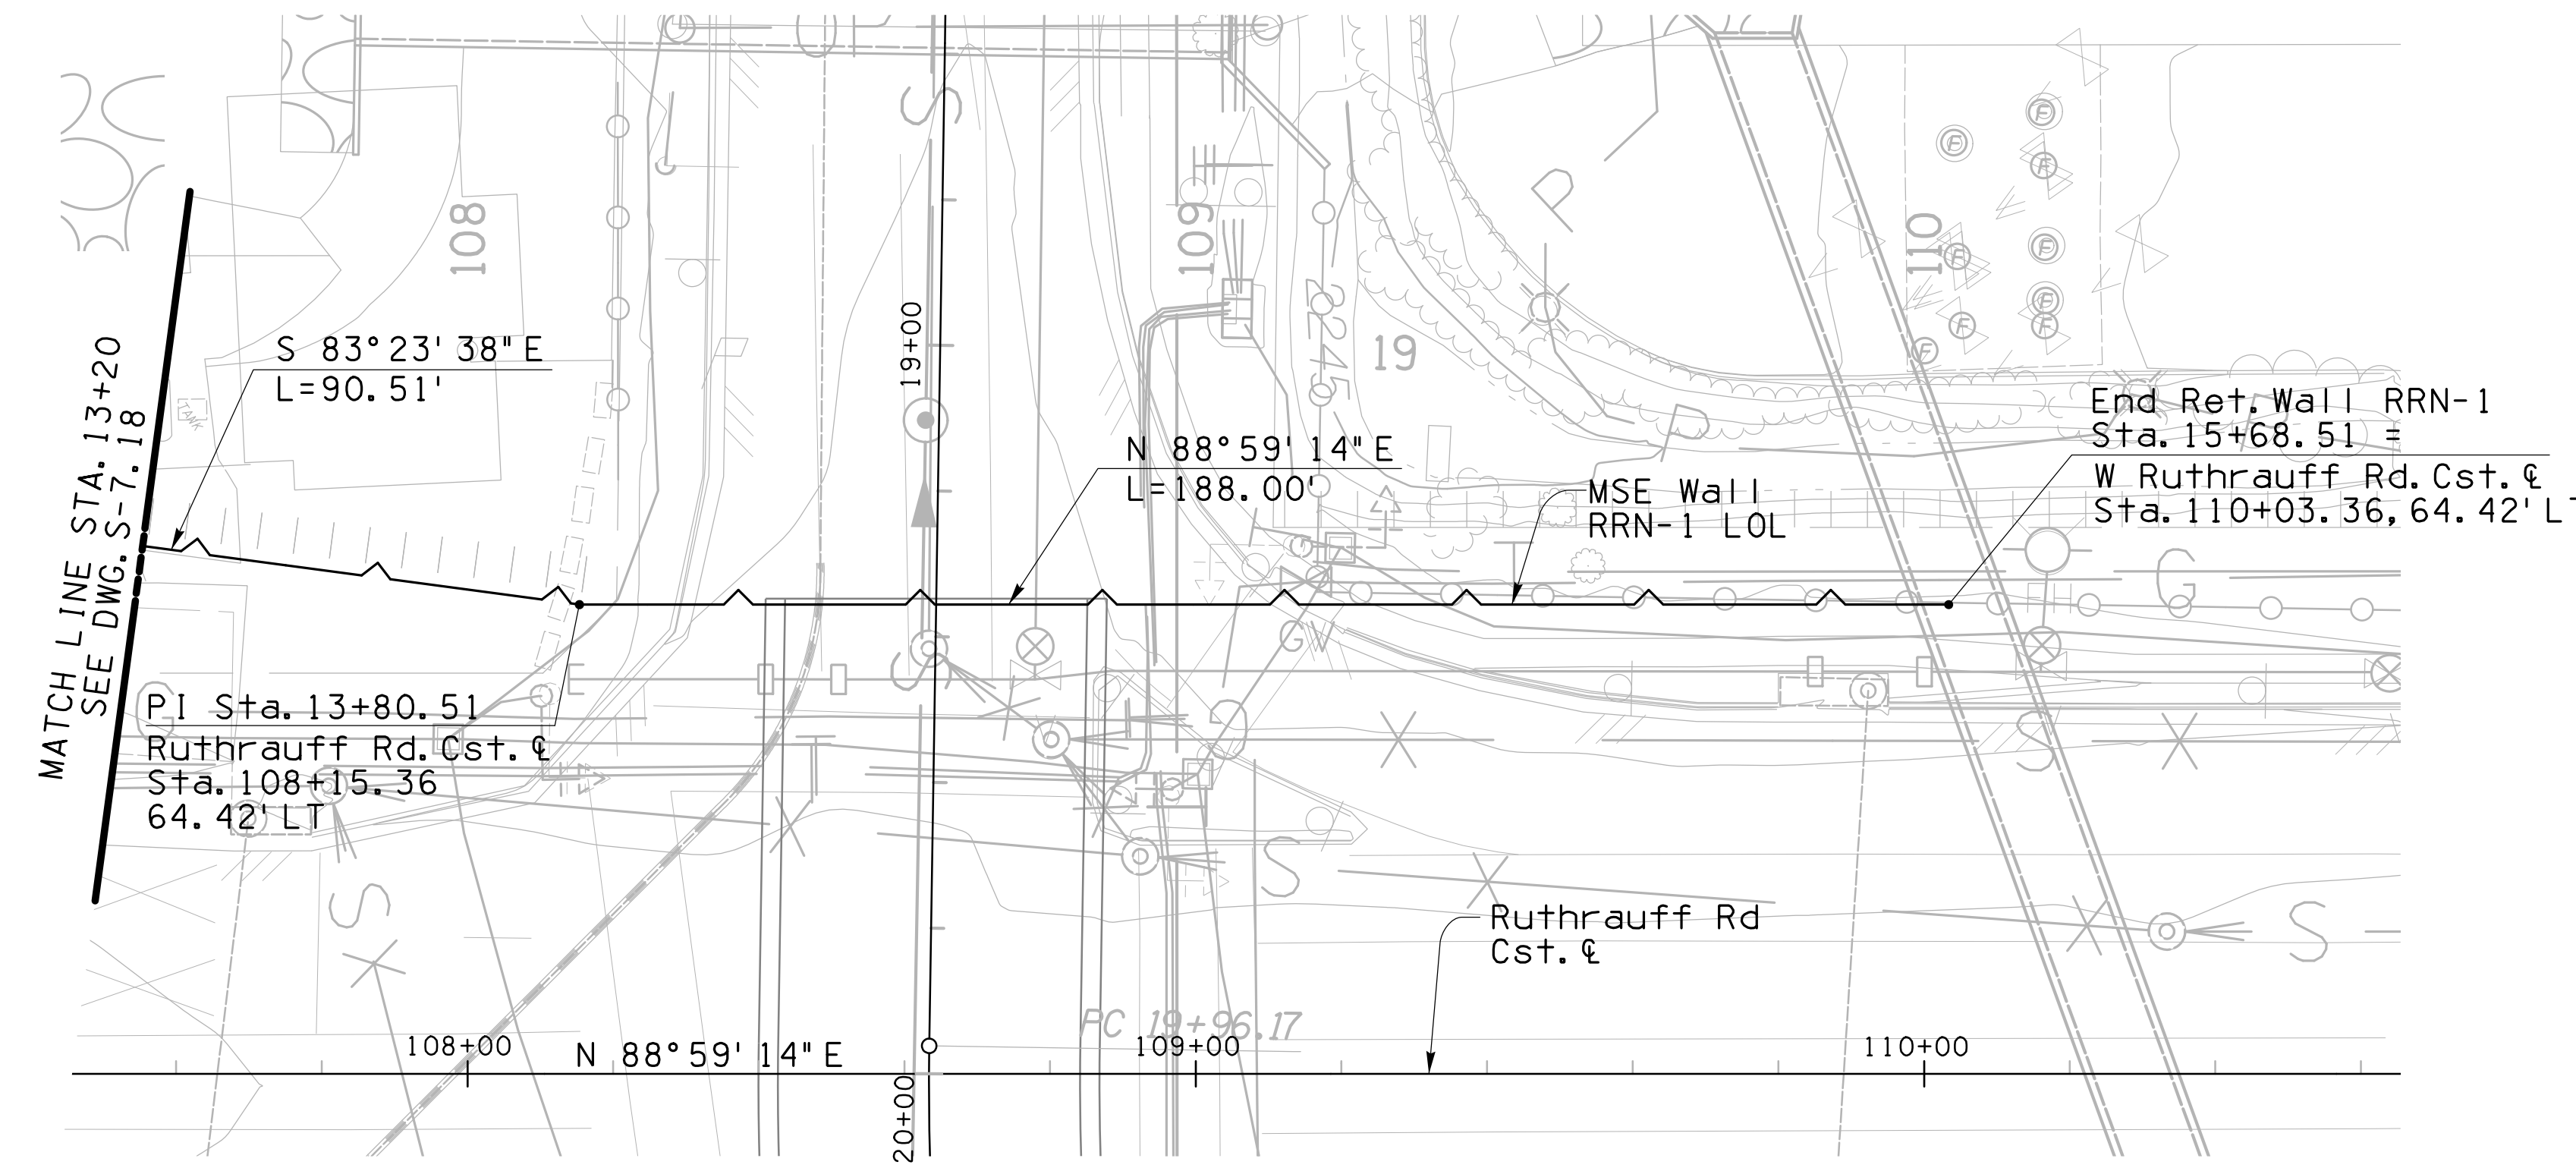


**Note:**  
Contractor shall see Architectural Treatment Plans for the MSE icon designs, vertical rustication pattern and blank panel requirements. Full-scale mock-ups are required for each specific design.

Slip Joints shall be positioned such that they do not bisect the architectural wall treatments. Not all of the slip joints are shown on the plans. The Contractor shall follow the Special Provisions for placement of the other required slip joint locations, plus other locations required per the wall manufacturer's design.

The location of all utilities is approximate. The contractor shall review the utility plans and potholing information to confirm the location of new and existing utilities prior to construction.

PLAN - WALL RRN-1 (MSE)  
1" = 20'

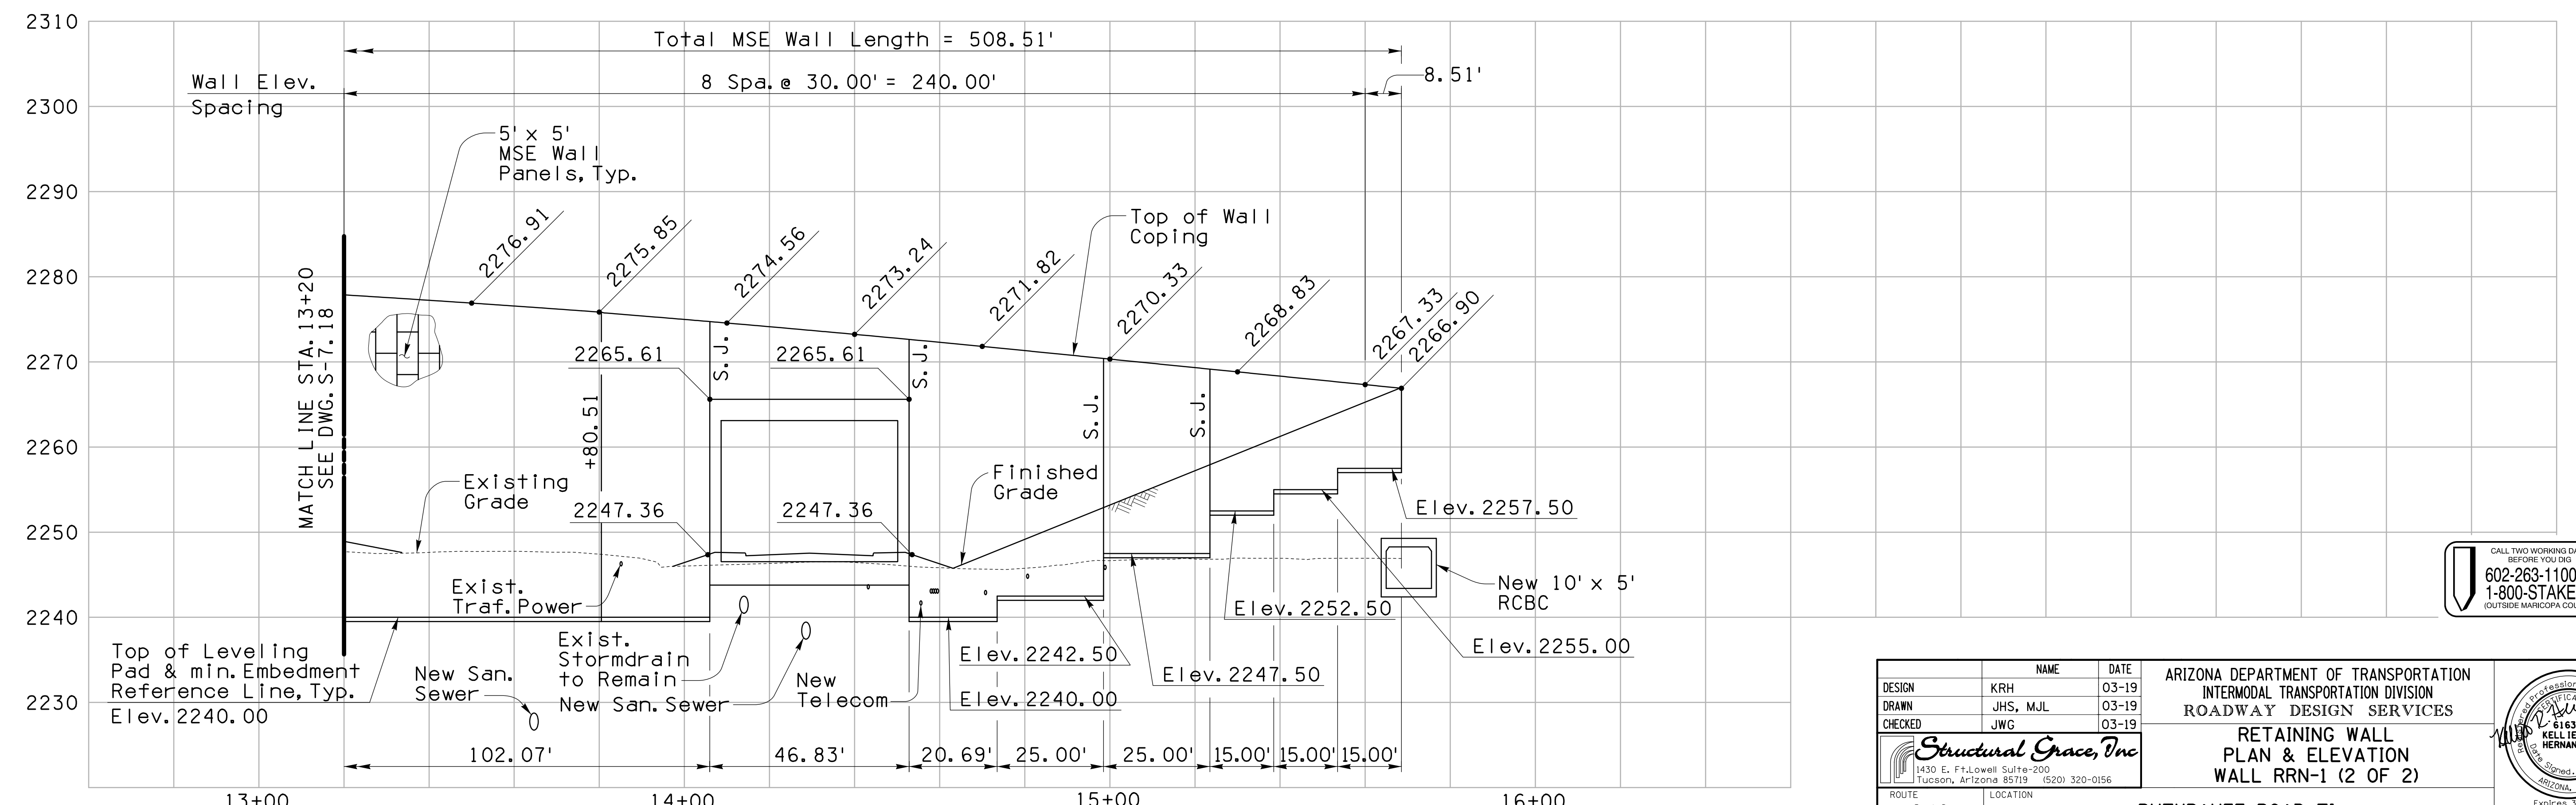

ELEVATION - WALL RRN-1 (MSE)  
Horiz.: 1" = 20'; Vert.: 1" = 10'


CALL TWO WORKING DAYS BEFORE YOU DIG  
602-263-1100  
1-800-STAKE-IT  
(OUTSIDE MARICOPA COUNTY)

DESIGN	KRH	DATE	03-19	ARIZONA DEPARTMENT OF TRANSPORTATION INTERMODAL TRANSPORTATION DIVISION ROADWAY DESIGN SERVICES
DRAWN	JHS, MJL	03-19		
CHECKED	JWG	03-19		
<b>RETAINING WALL PLAN &amp; ELEVATION WALL RRN-1 (2 OF 2)</b>				
ROUTE	I-10	LOCATION	RUTHRAUFF ROAD TI	Expires 3/31/22
TRACS NO.	H 8480 01C		010-D(213)S	DWG NO. S-7.19



F.H.W.A. REGION	STATE	PROJECT NO.	SHEET NO.	TOTAL SHEETS	AS BUILT
9	ARIZ.	010-D(213)S	722	849	

010 PM 252

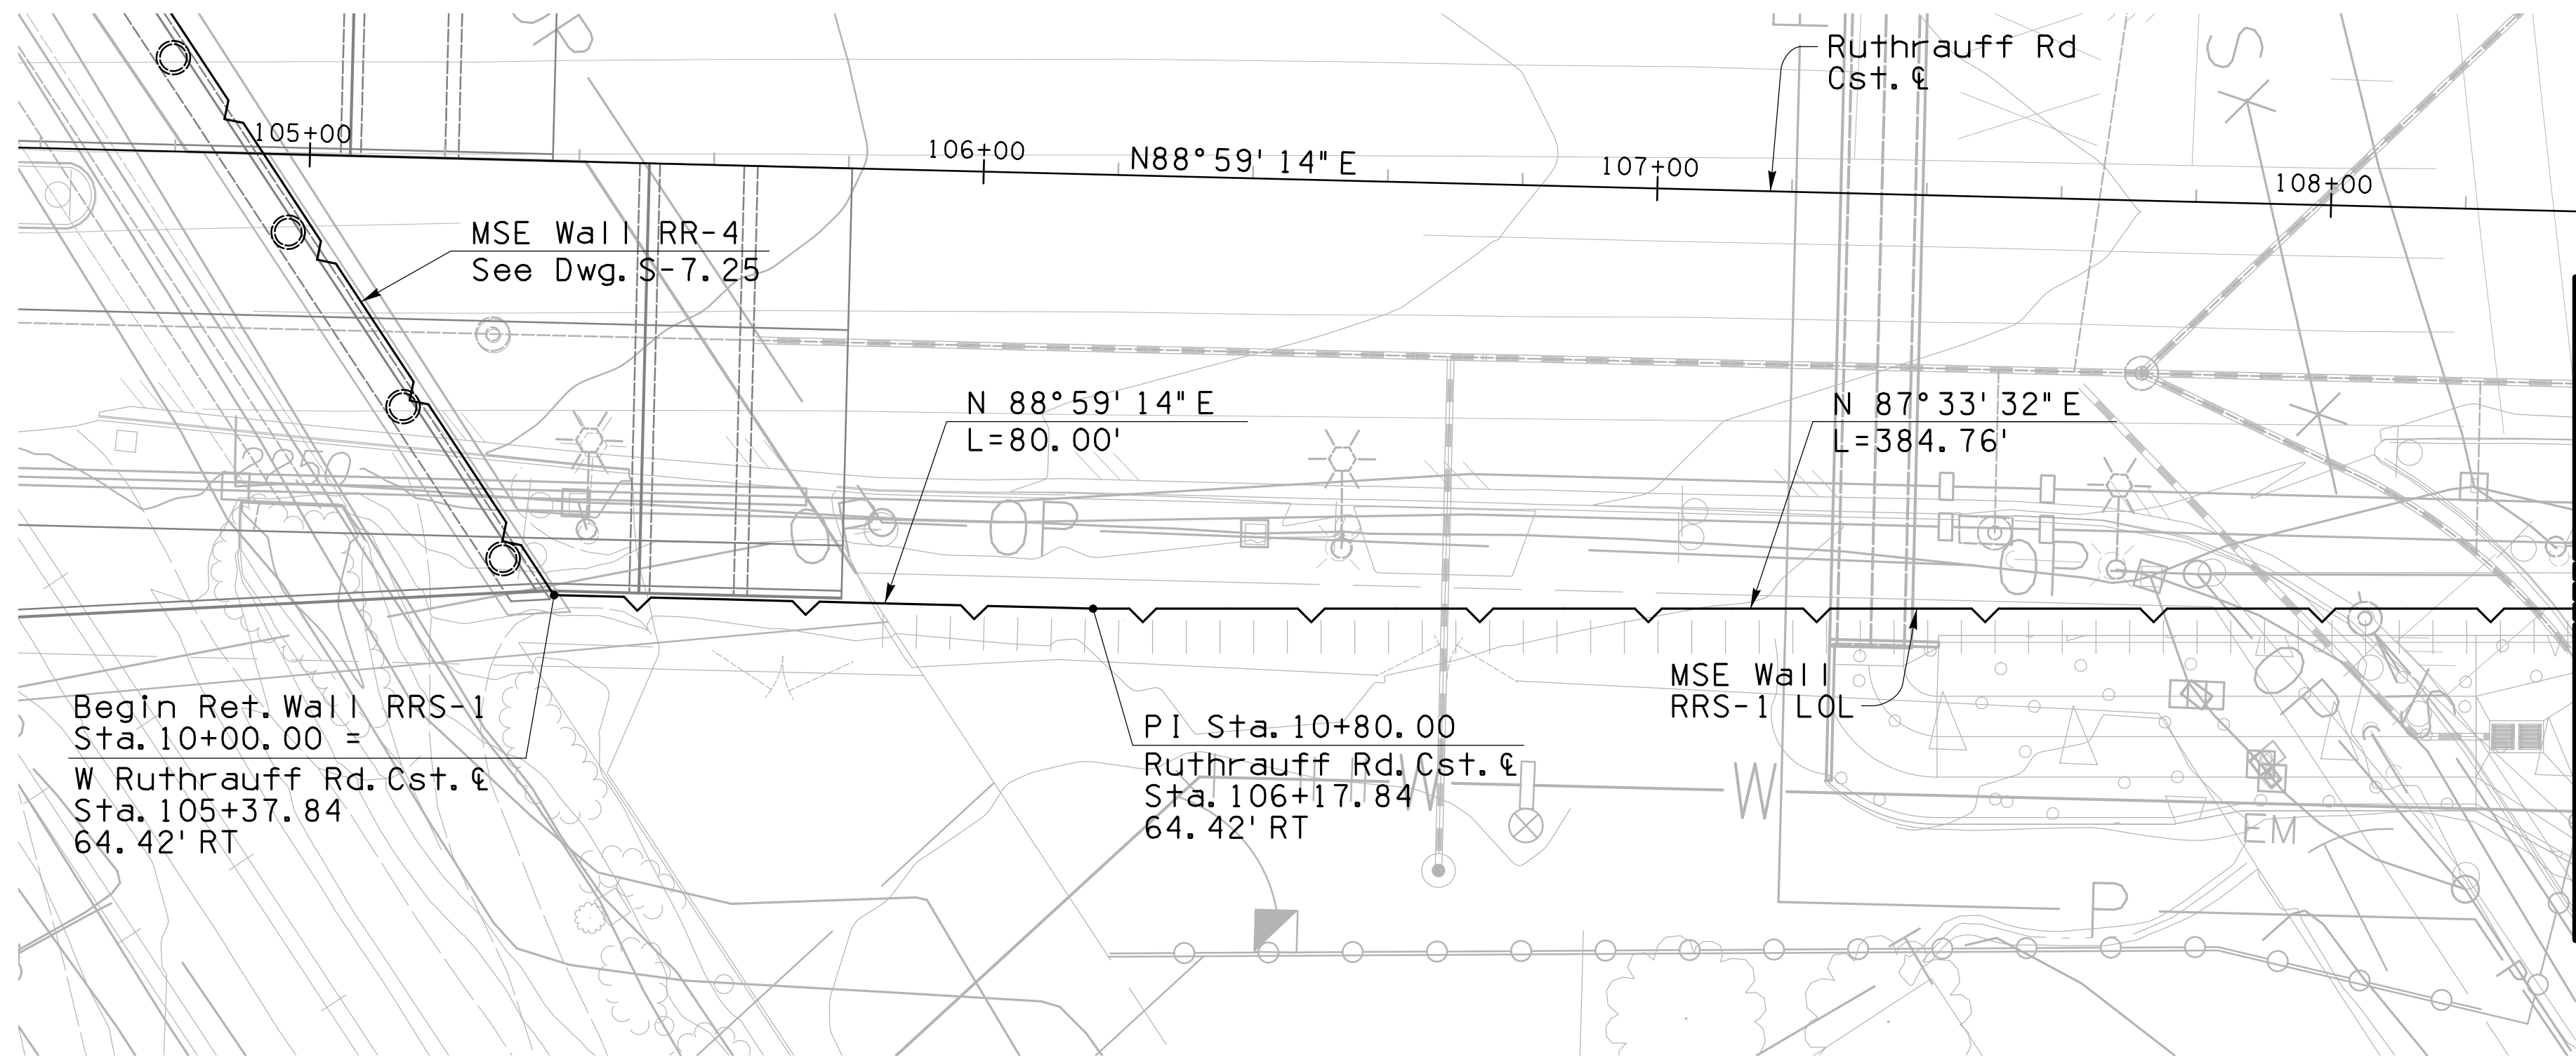


**Note:**

Contractor shall see Architectural Treatment Plans for the MSE icon designs, vertical rustication pattern and blank panel requirements. Full-scale mock-ups are required for each specific design.

Slip Joints shall be positioned such that they do not bisect the architectural wall treatments. Not all of the slip joints are shown on the plans. The Contractor shall follow the Special Provisions for placement of the other required slip joint locations, plus other locations required per the wall manufacturer's design.

The location of all utilities is approximate. The contractor shall review the utility plans and potholing information to confirm the location of new and existing utilities prior to construction.

**PLAN - WALL RRS-1 (MSE)**  
1" = 20'

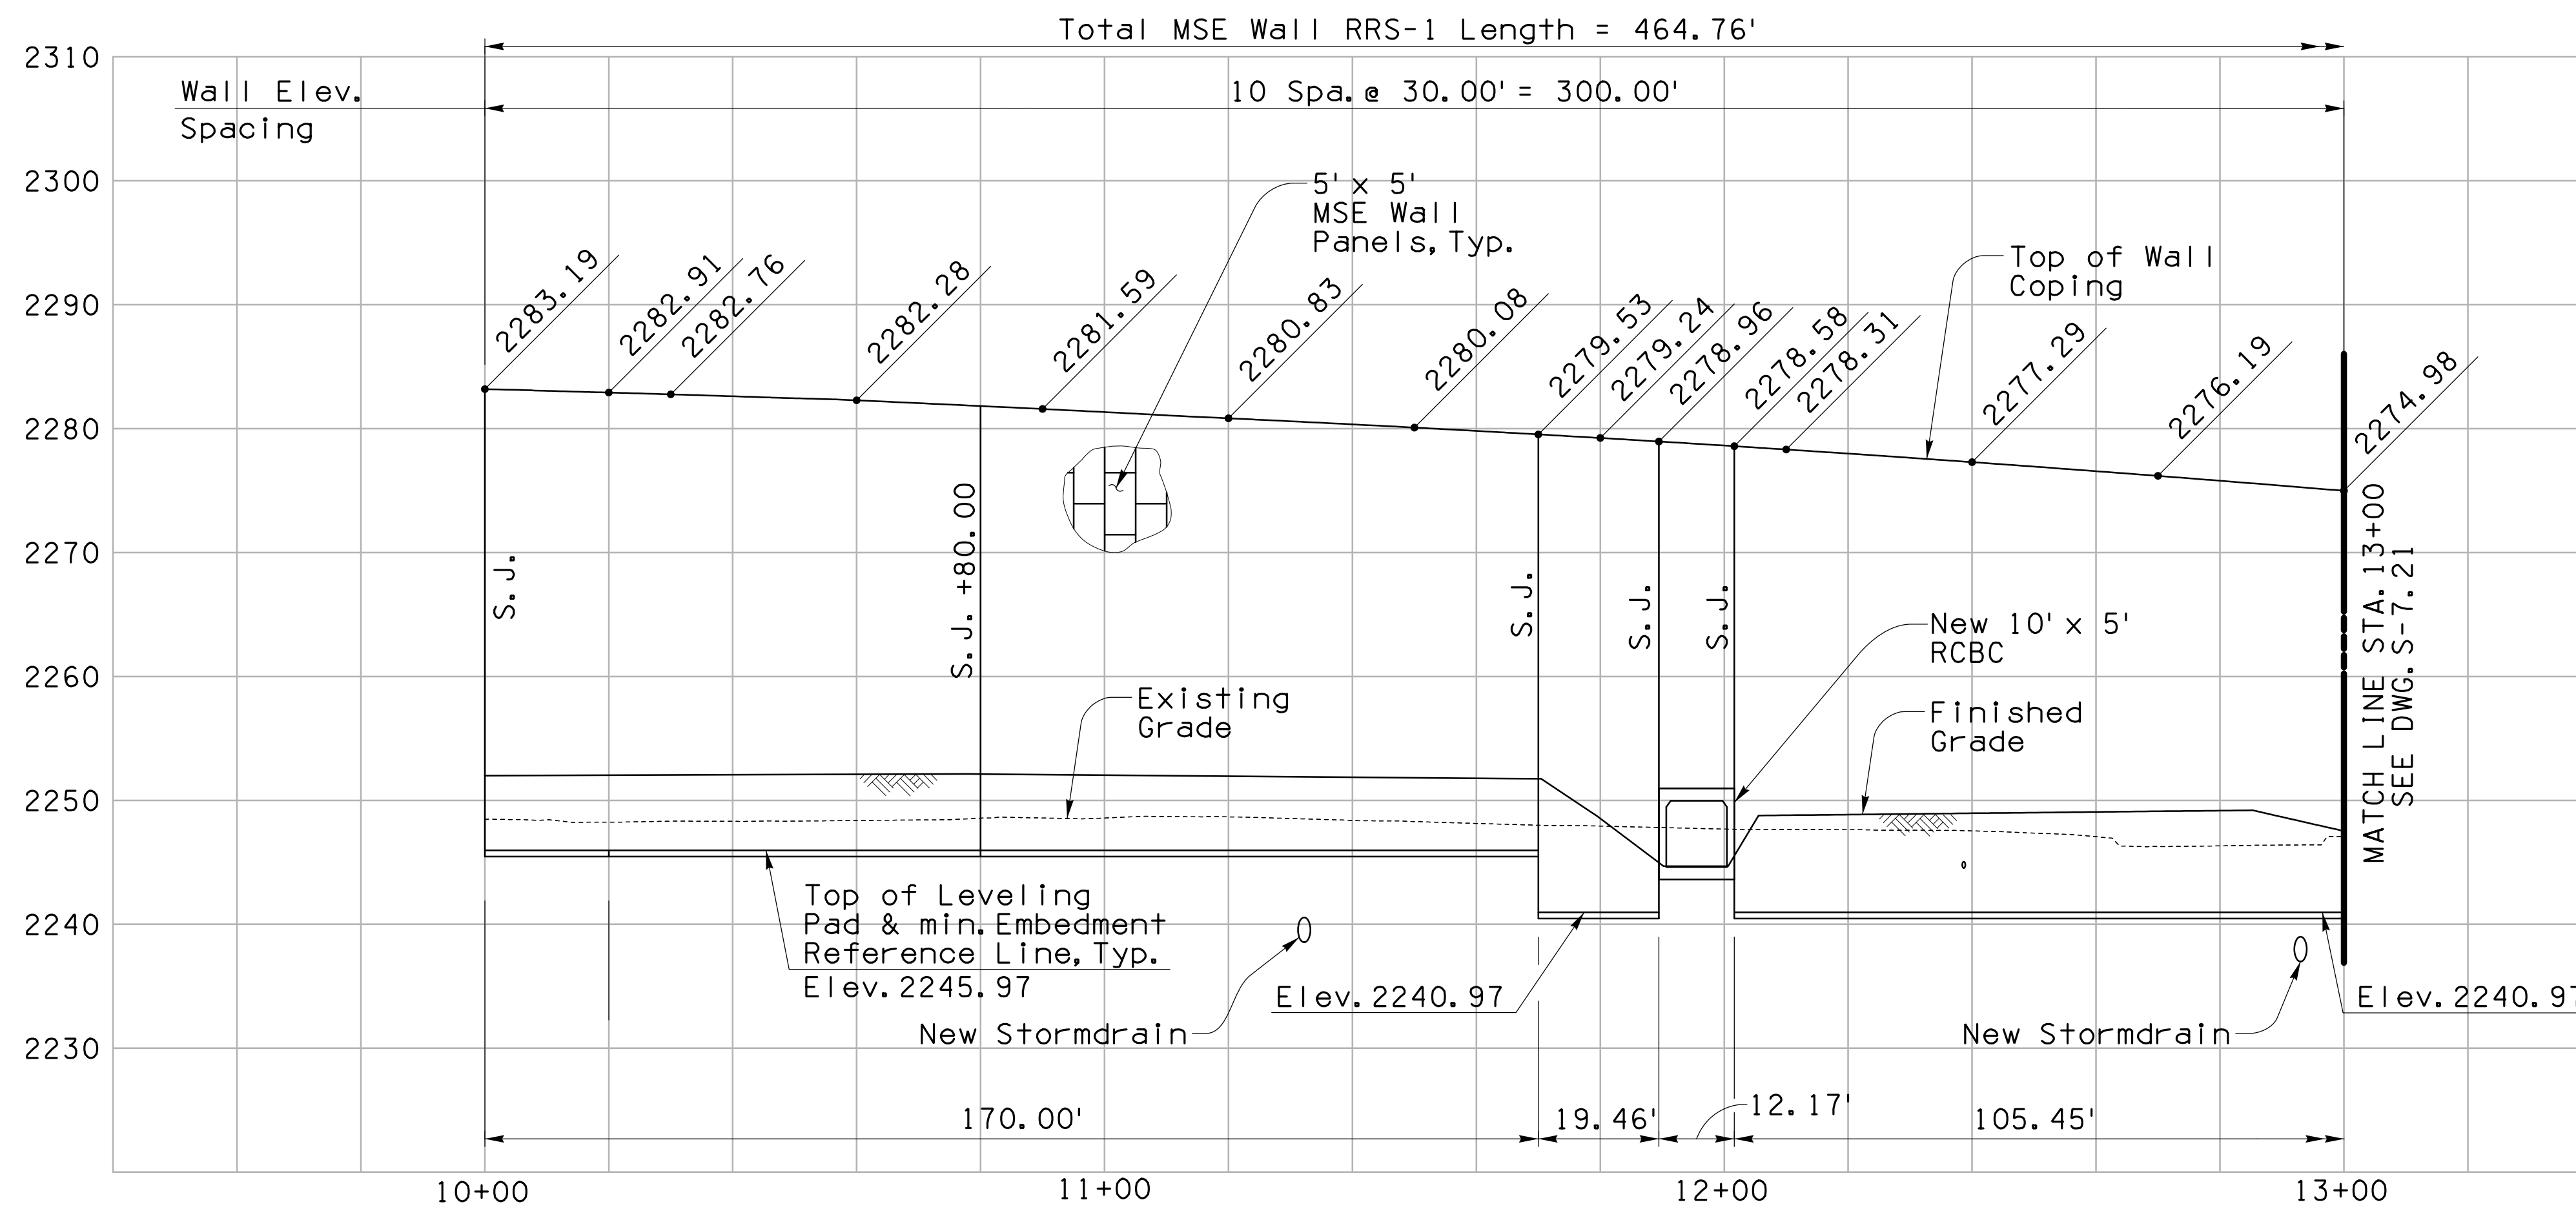



**ELEVATION - WALL RRS-1 (MSE)**  
Horiz.: 1" = 20'; Vert.: 1" = 10'

CALL TWO WORKING DAYS BEFORE YOU DIG  
602-263-1100  
1-800-STAKE-IT  
(OUTSIDE MARICOPA COUNTY)

DESIGN	NAME	DATE	ARIZONA DEPARTMENT OF TRANSPORTATION INTERMODAL TRANSPORTATION DIVISION ROADWAY DESIGN SERVICES	
DRAWN	JHS, MJL	03-19		
CHECKED	JWG	03-19		
			<b>RETAINING WALL PLAN &amp; ELEVATION WALL RRS-1 (1 OF 2)</b>	
ROUTE	LOCATION			
I-10	RUTHRAUFF ROAD TI		Expires 3/31/22	
TRACS NO. H 8480 01C			010-D(213)S	DWG NO. S-7.20
			OF	

F.H.W.A. REGION	STATE	PROJECT NO.	SHEET NO.	TOTAL SHEETS	AS BUILT
9	ARIZ.	010-D(213)S	723	849	

010 PM 252

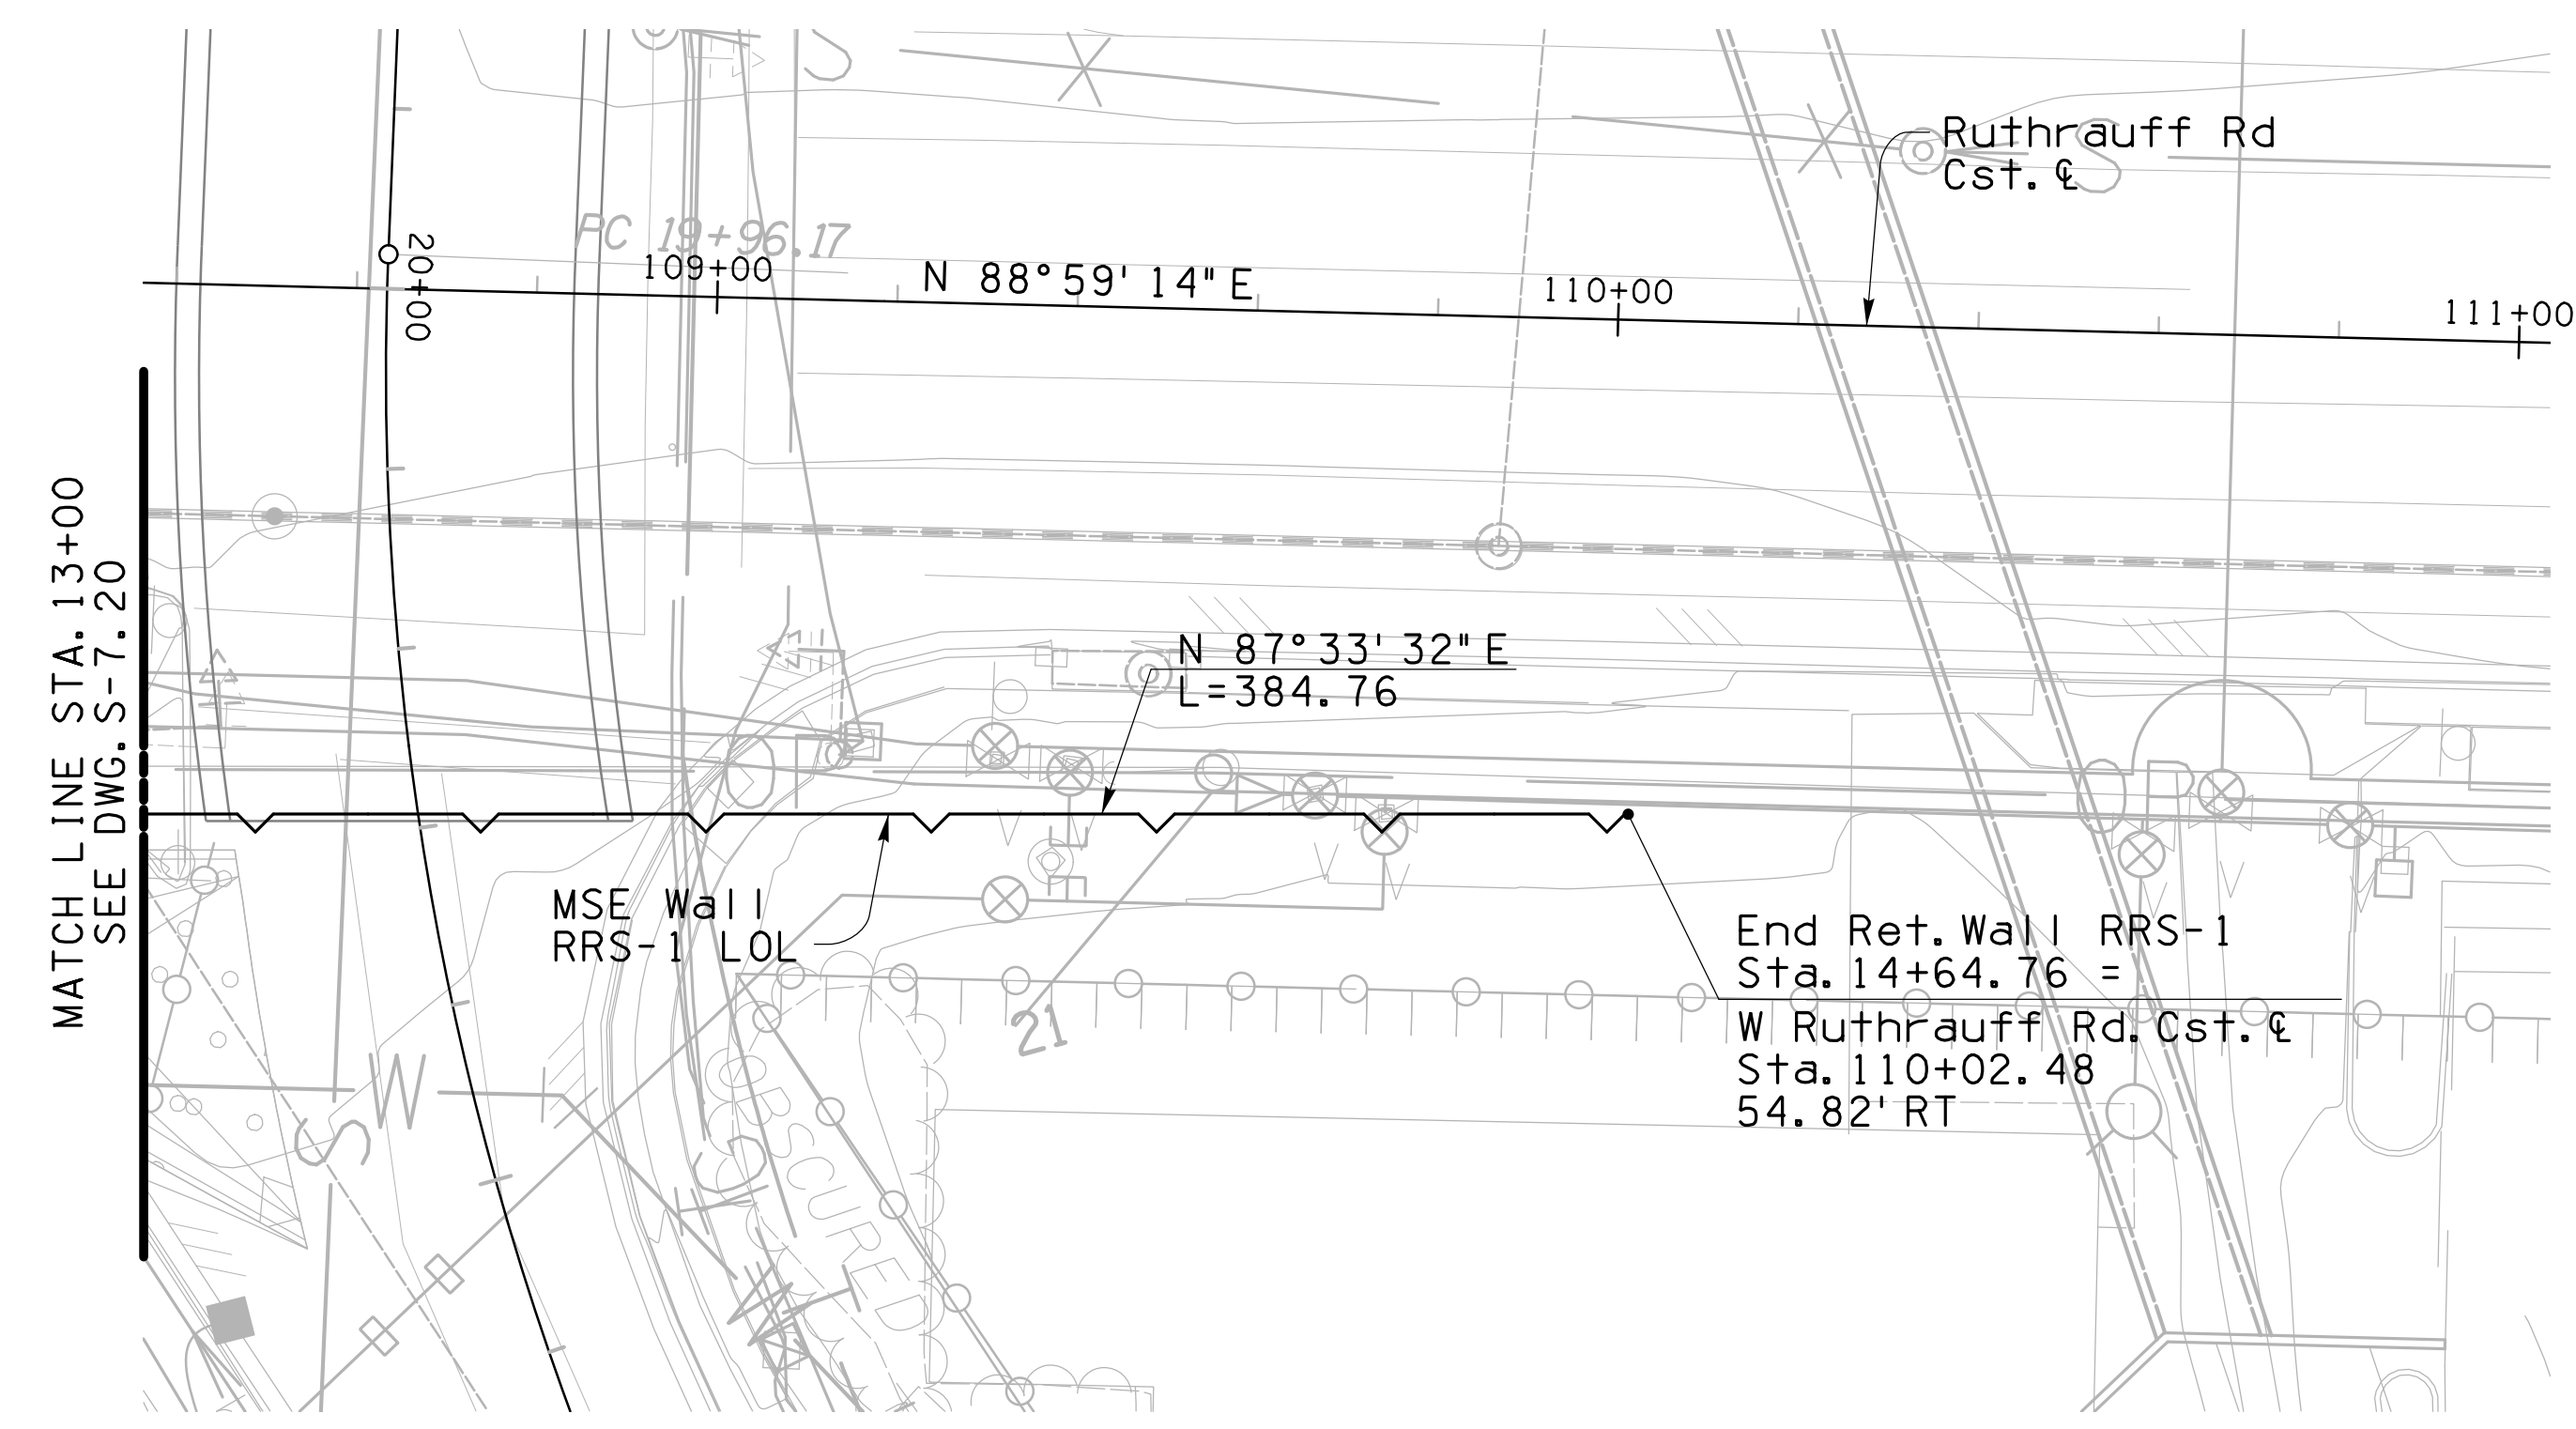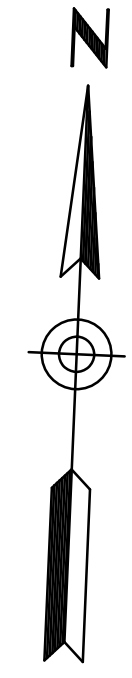


PLAN - WALL RRS-1 (MSE)  
1" = 20'

**Note:**

Contractor shall see Architectural Treatment Plans for the MSE Icon designs, vertical rustication pattern and blank panel requirements. Full-scale mock-ups are required for each specific design.

Slip Joints shall be positioned such that they do not bisect the architectural wall treatments. Not all of the slip joints are shown on the plans. The Contractor shall follow the Special Provisions for placement of the other required slip joint locations, plus other locations required per the wall manufacturer's design.

The location of all utilities is approximate. The contractor shall review the utility plans and potholing information to confirm the location of new and existing utilities prior to construction.

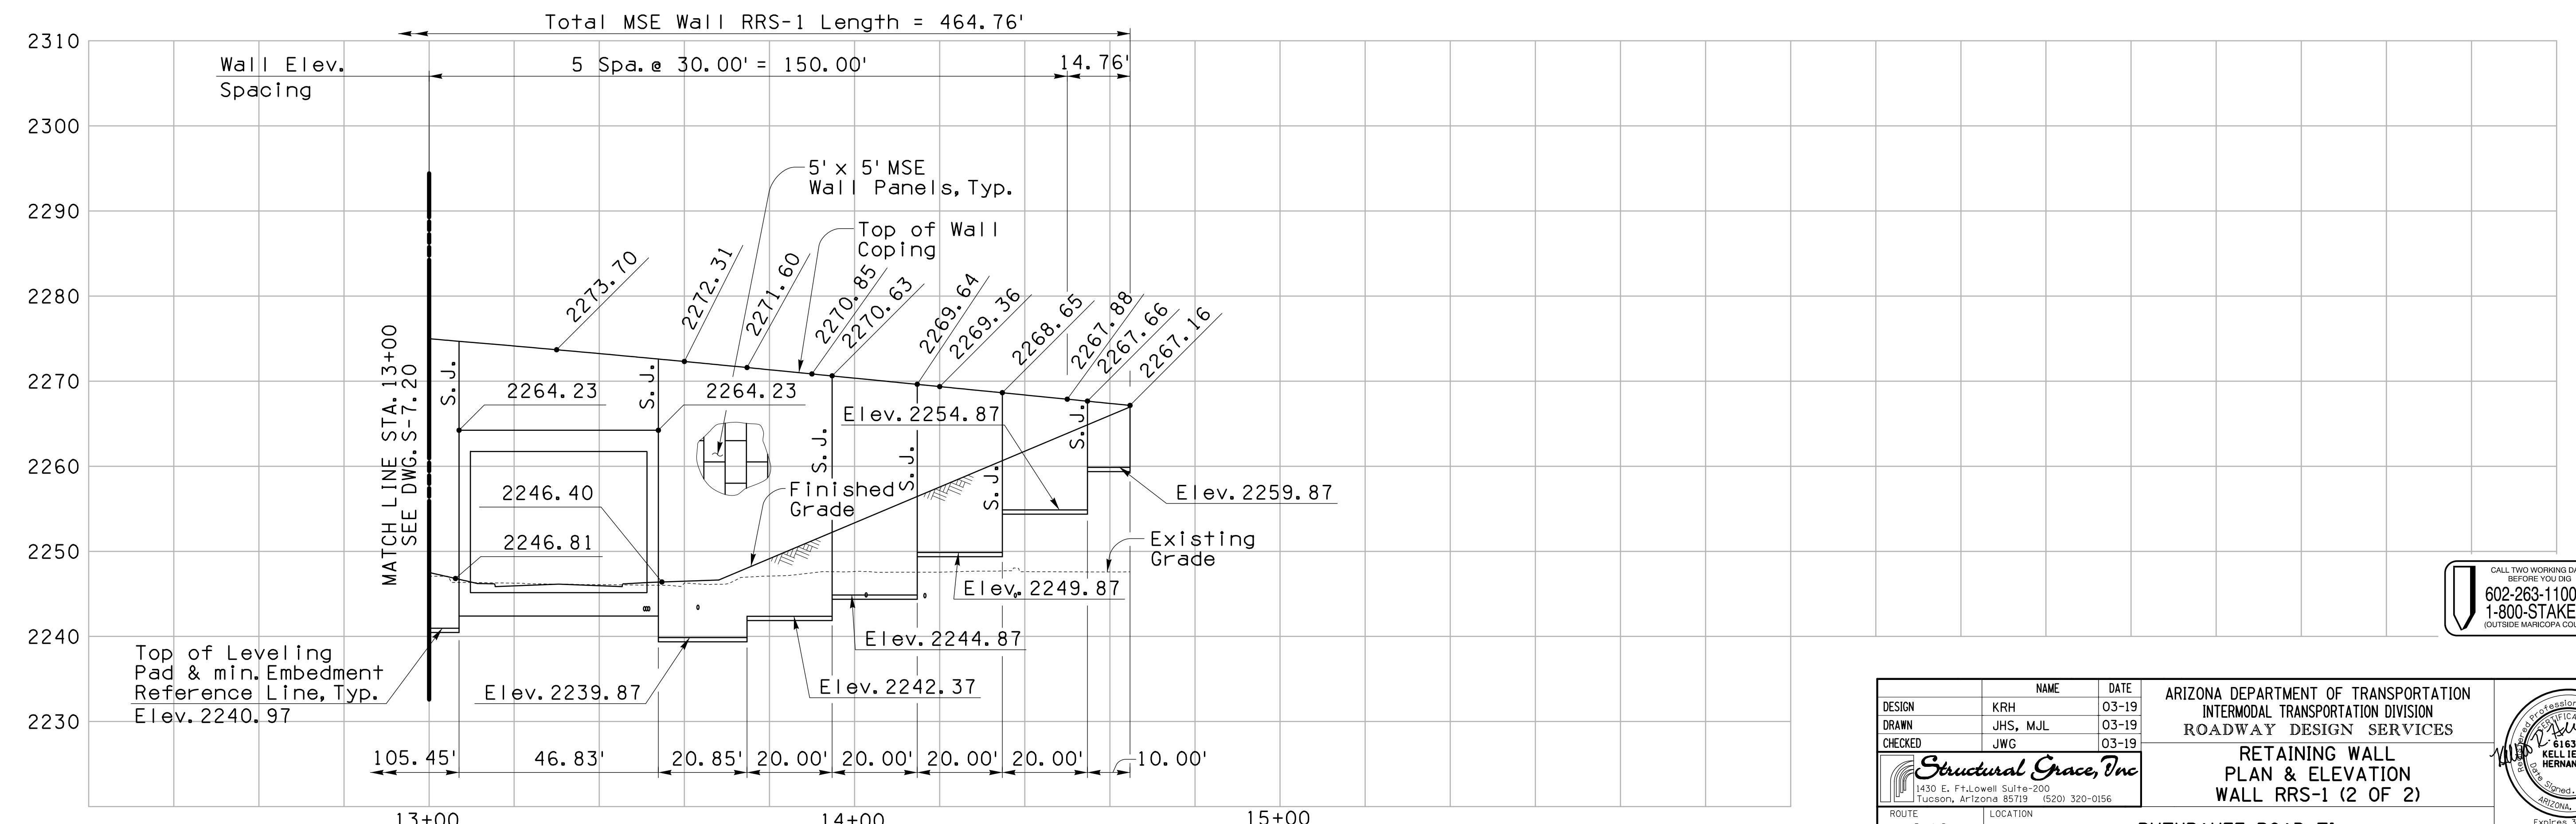

ELEVATION - WALL RRS-1 (MSE)  
Horiz.: 1" = 20'; Vert.: 1" = 10'



DESIGN	NAME	DATE	ARIZONA DEPARTMENT OF TRANSPORTATION INTERMODAL TRANSPORTATION DIVISION ROADWAY DESIGN SERVICES
DRAWN	JHS, MJL	03-19	
CHECKED	JWG	03-19	
RETAINING WALL PLAN & ELEVATION WALL RRS-1 (2 OF 2)			
ROUTE	LOCATION		Expires 3/31/22
I-10	RUTHRAUFF ROAD TI		DWG NO. S-7.21
TRACS NO. H 8480 01C			010-D(213)S
			OF

F.H.W.A. REGION	STATE	PROJECT NO.	SHEET NO.	TOTAL SHEETS	AS BUILT
9	ARIZ.	010-D(213)S	724	849	



010 PM 252

**Note:**

Contractor shall see Architectural Treatment Plans for the MSE icon designs, vertical rustication pattern and blank panel requirements. Full-scale mock-ups are required for each specific design.

Slip Joints shall be positioned such that they do not bisect the architectural wall treatments. Not all of the slip joints are shown on the plans. The Contractor shall follow the Special Provisions for placement of the other required slip joint locations, plus other locations required per the wall manufacturer's design.

The location of all utilities is approximate. The contractor shall review the utility plans and potholing information to confirm the location of new and existing utilities prior to construction.

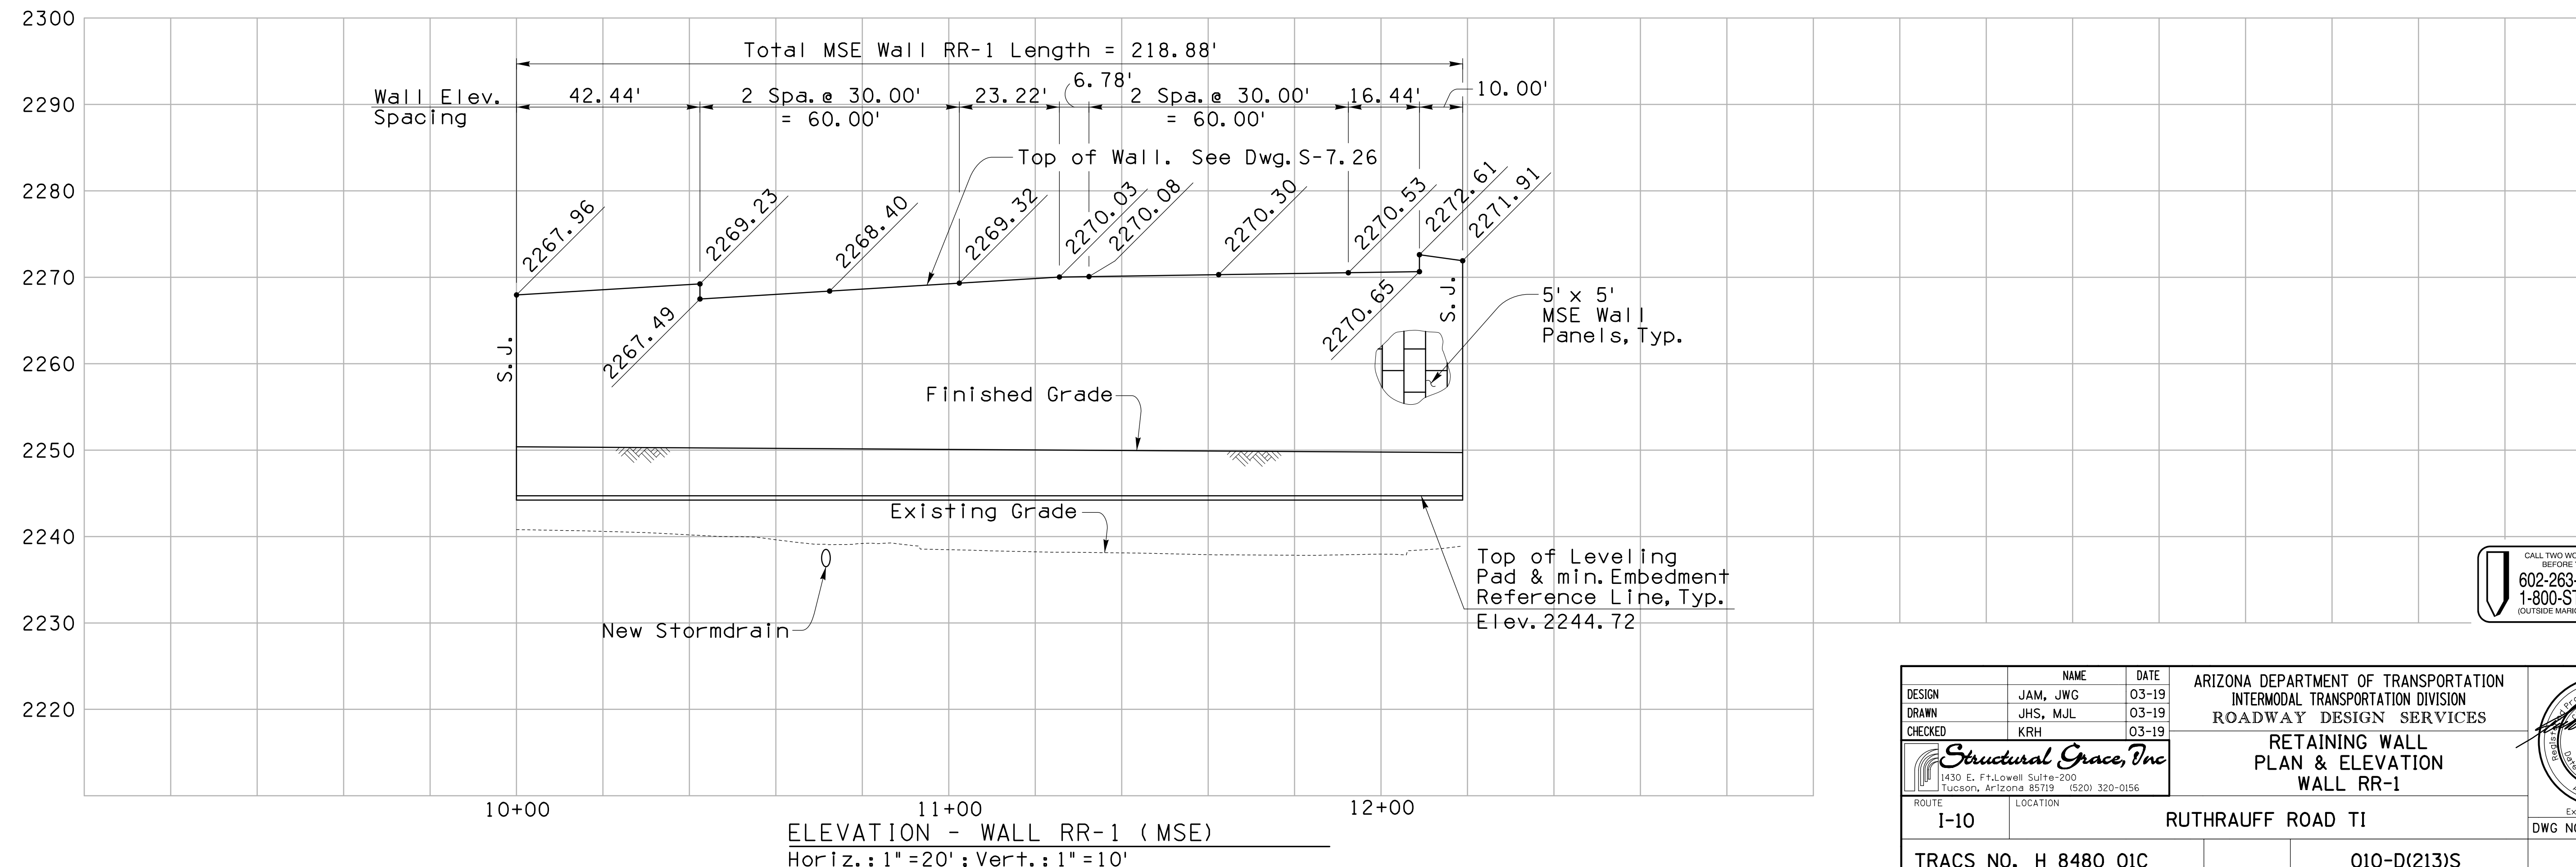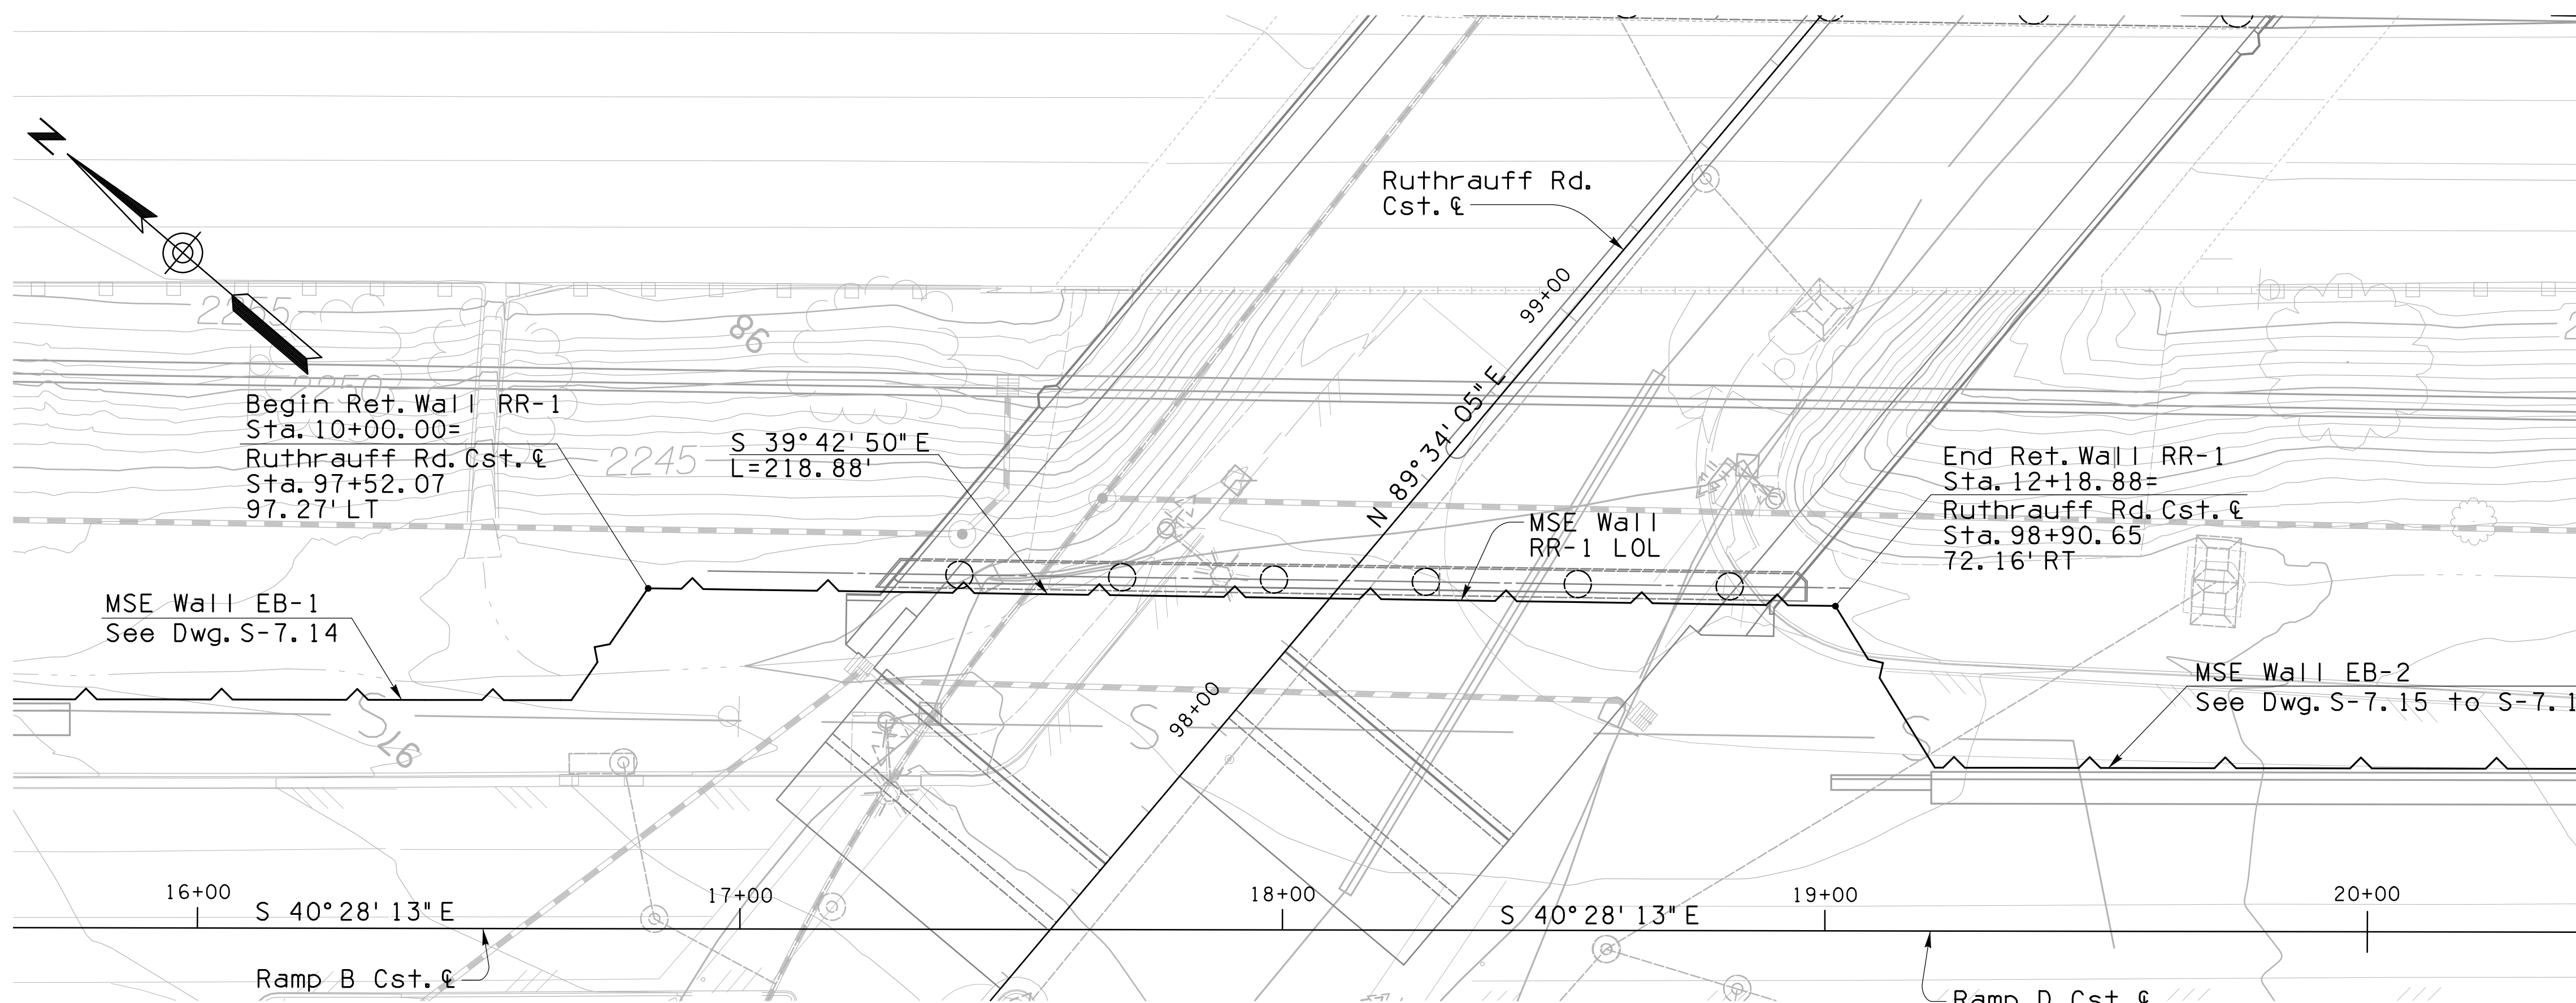

DESIGN	NAME	DATE	ARIZONA DEPARTMENT OF TRANSPORTATION INTERMODAL TRANSPORTATION DIVISION ROADWAY DESIGN SERVICES
DRAWN	JAM, JWG	03-19	
CHECKED	KRH	03-19	

 1430 E. Ft. Lowell, Suite 200 Tucson, Arizona 85719 (520) 320-0156		<b>RETAINING WALL PLAN &amp; ELEVATION WALL RR-1</b>	 DWG NO. S-7.22
ROUTE	LOCATION		
I-10	RUTHRAUFF ROAD TI		



F.H.W.A. REGION	STATE	PROJECT NO.	SHEET NO.	TOTAL SHEETS	AS BUILT
9	ARIZ.	010-D(213)S	725	849	


010 PM 252

**Note:**

Contractor shall see Architectural Treatment Plans for the MSE icon designs, vertical rustication pattern and blank panel requirements. Full-scale mock-ups are required for each specific design.


Slip Joints shall be positioned such that they do not bisect the architectural wall treatments. Not all of the slip joints are shown on the plans. The Contractor shall follow the Special Provisions for placement of the other required slip joint locations, plus other locations required per the wall manufacturer's design.

The location of all utilities is approximate. The contractor shall review the utility plans and potholing information to confirm the location of new and existing utilities prior to construction.

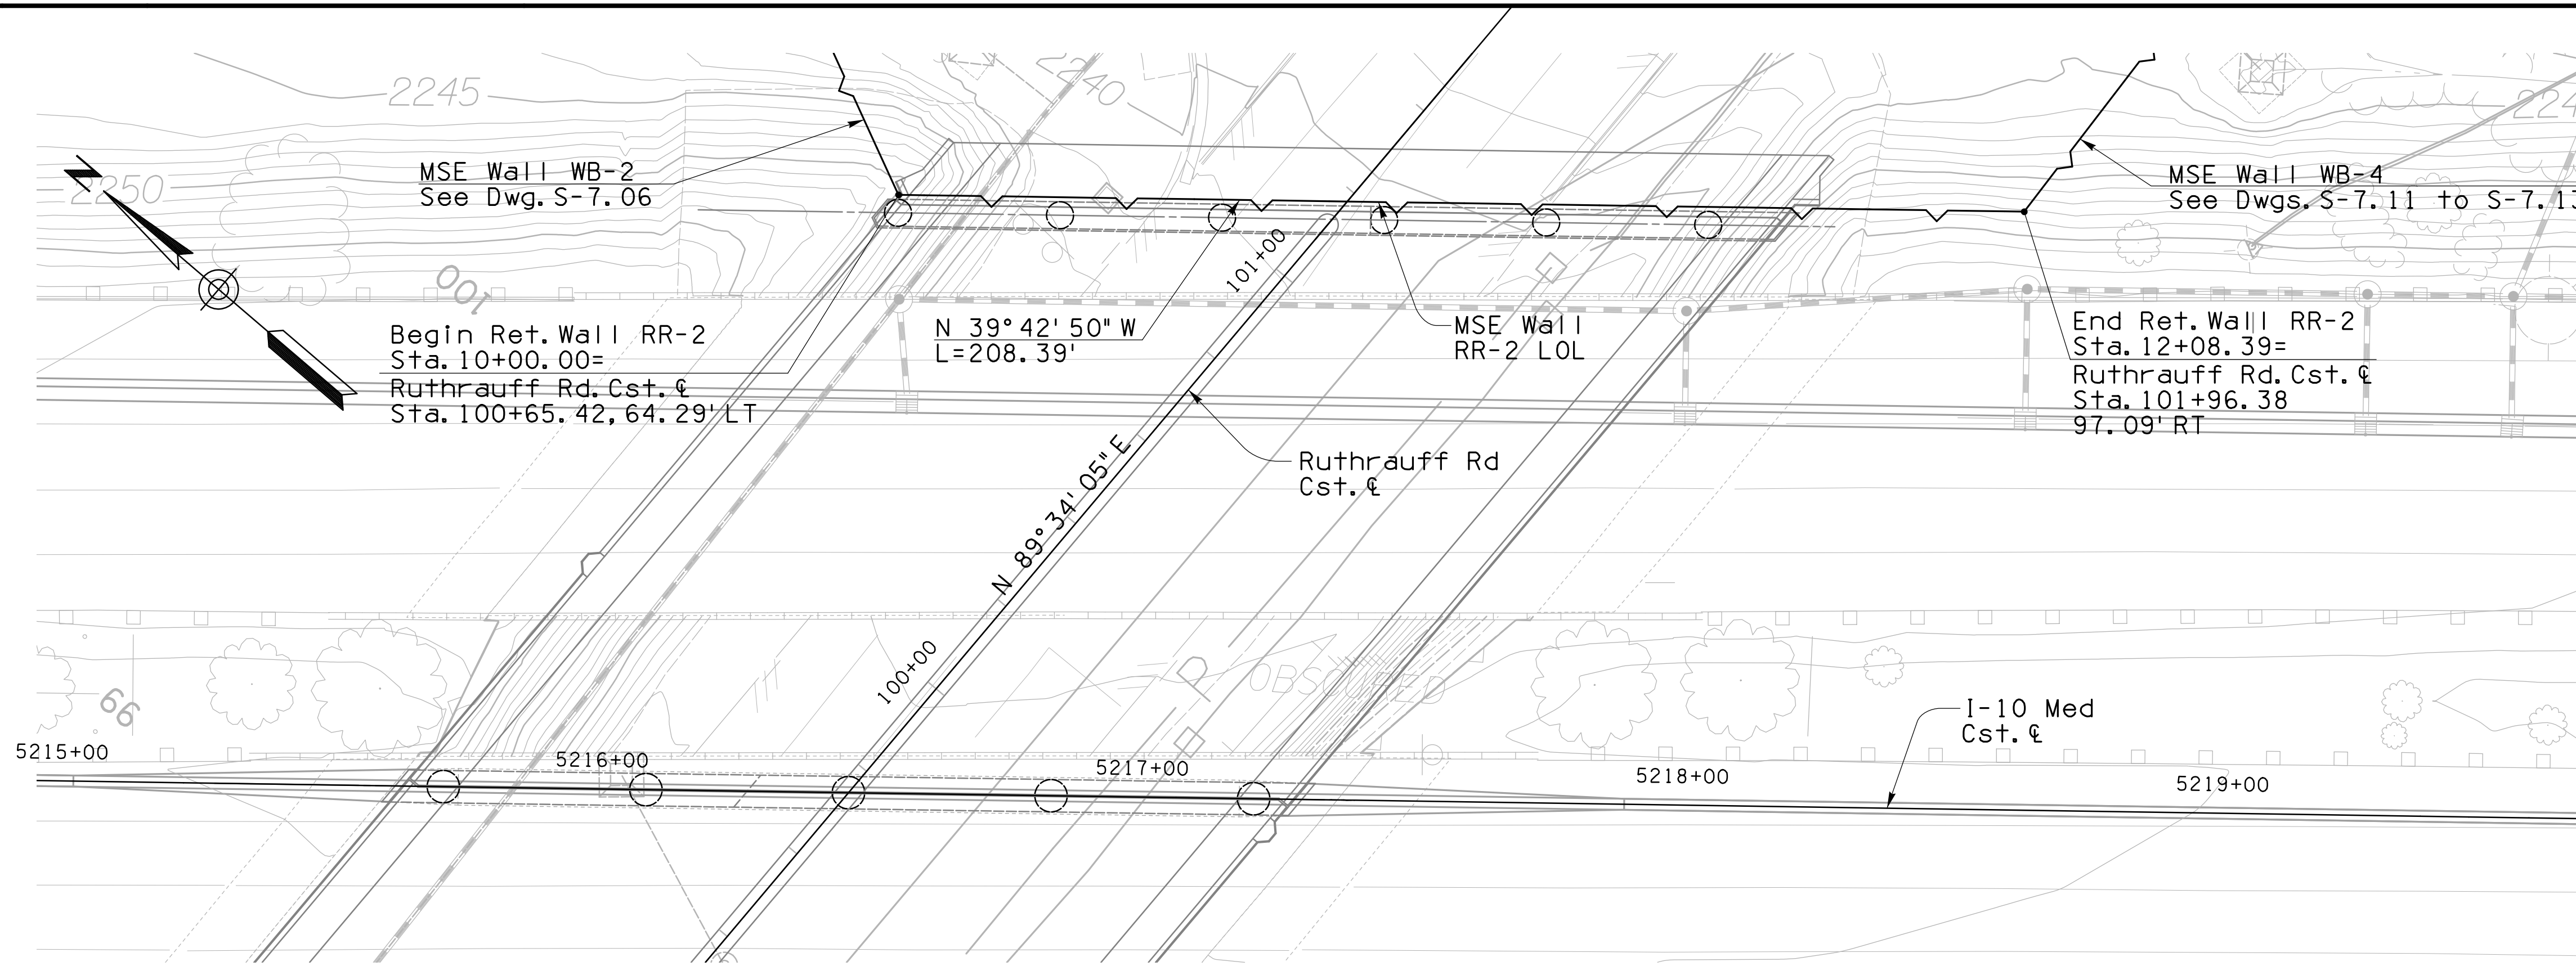

PLAN - WALL RR-2 (MSE)  
1" = 20'

See detail on Dwg. T-14.13 for Conduits through wall to cross bridge

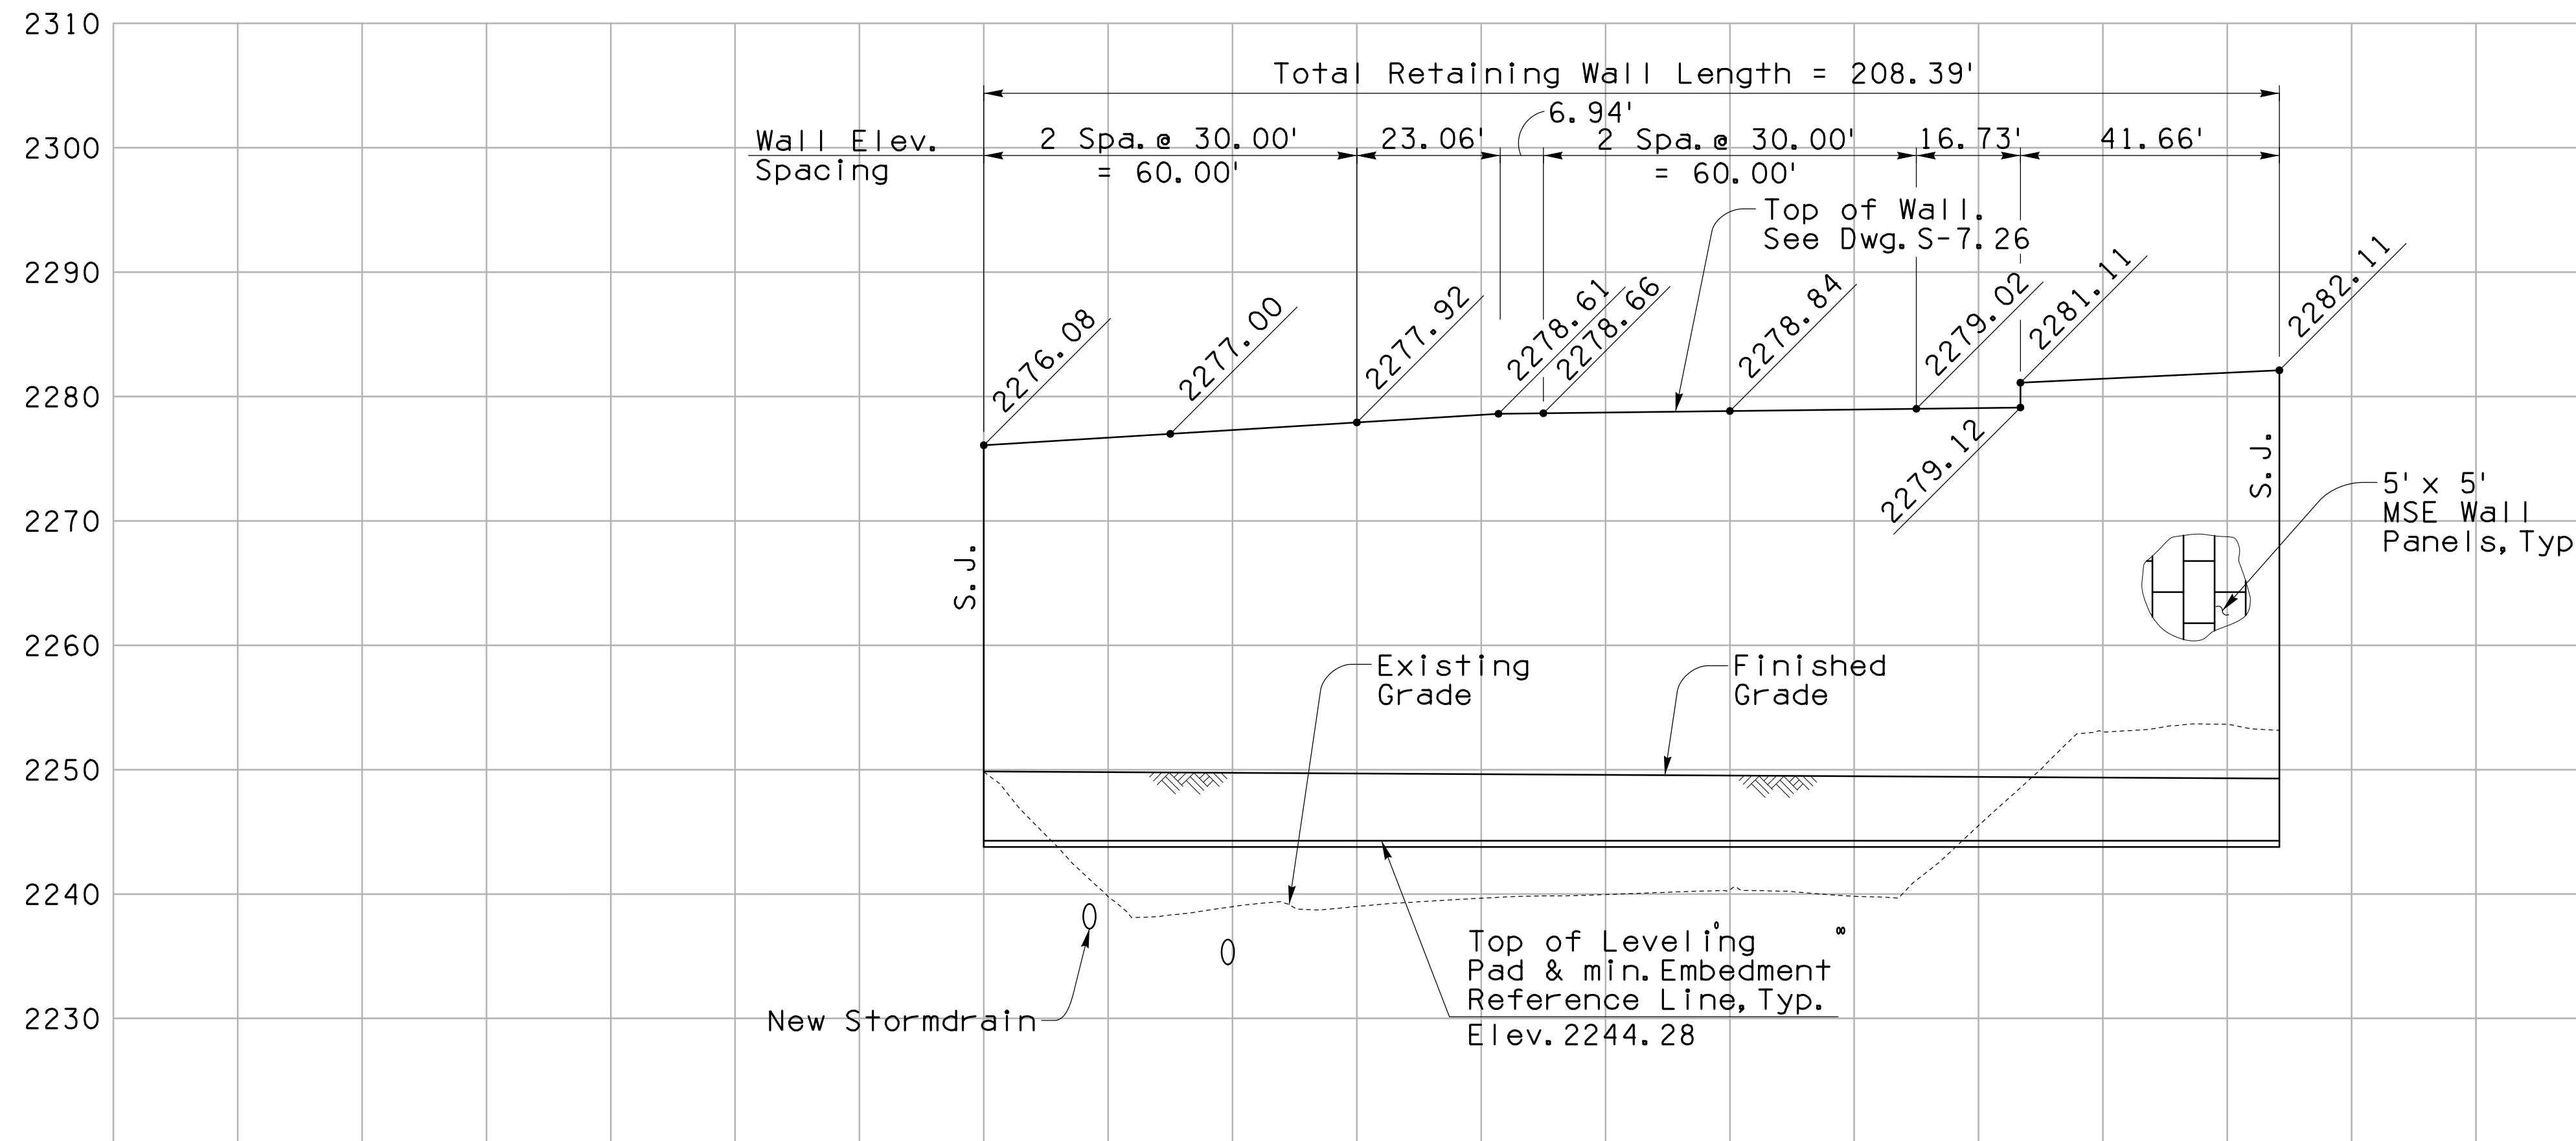

ELEVATION - WALL RR-2 (MSE)  
Horiz.: 1" = 20'; Vert.: 1" = 10'




DESIGN	NAME	DATE	ARIZONA DEPARTMENT OF TRANSPORTATION INTERMODAL TRANSPORTATION DIVISION ROADWAY DESIGN SERVICES
DRAWN	JAM, MJL	03-19	
CHECKED	KRH	03-19	

		<b>RETAINING WALL PLAN &amp; ELEVATION WALL RR-2</b>	
ROUTE	LOCATION		
I-10	RUTHRAUFF ROAD TI		
TRACS NO. H 8480 01C		010-D(213)S	OF

F.H.W.A. REGION	STATE	PROJECT NO.	SHEET NO.	TOTAL SHEETS	AS BUILT
9	ARIZ.	010-D(213)S	726	849	

010 PM 252

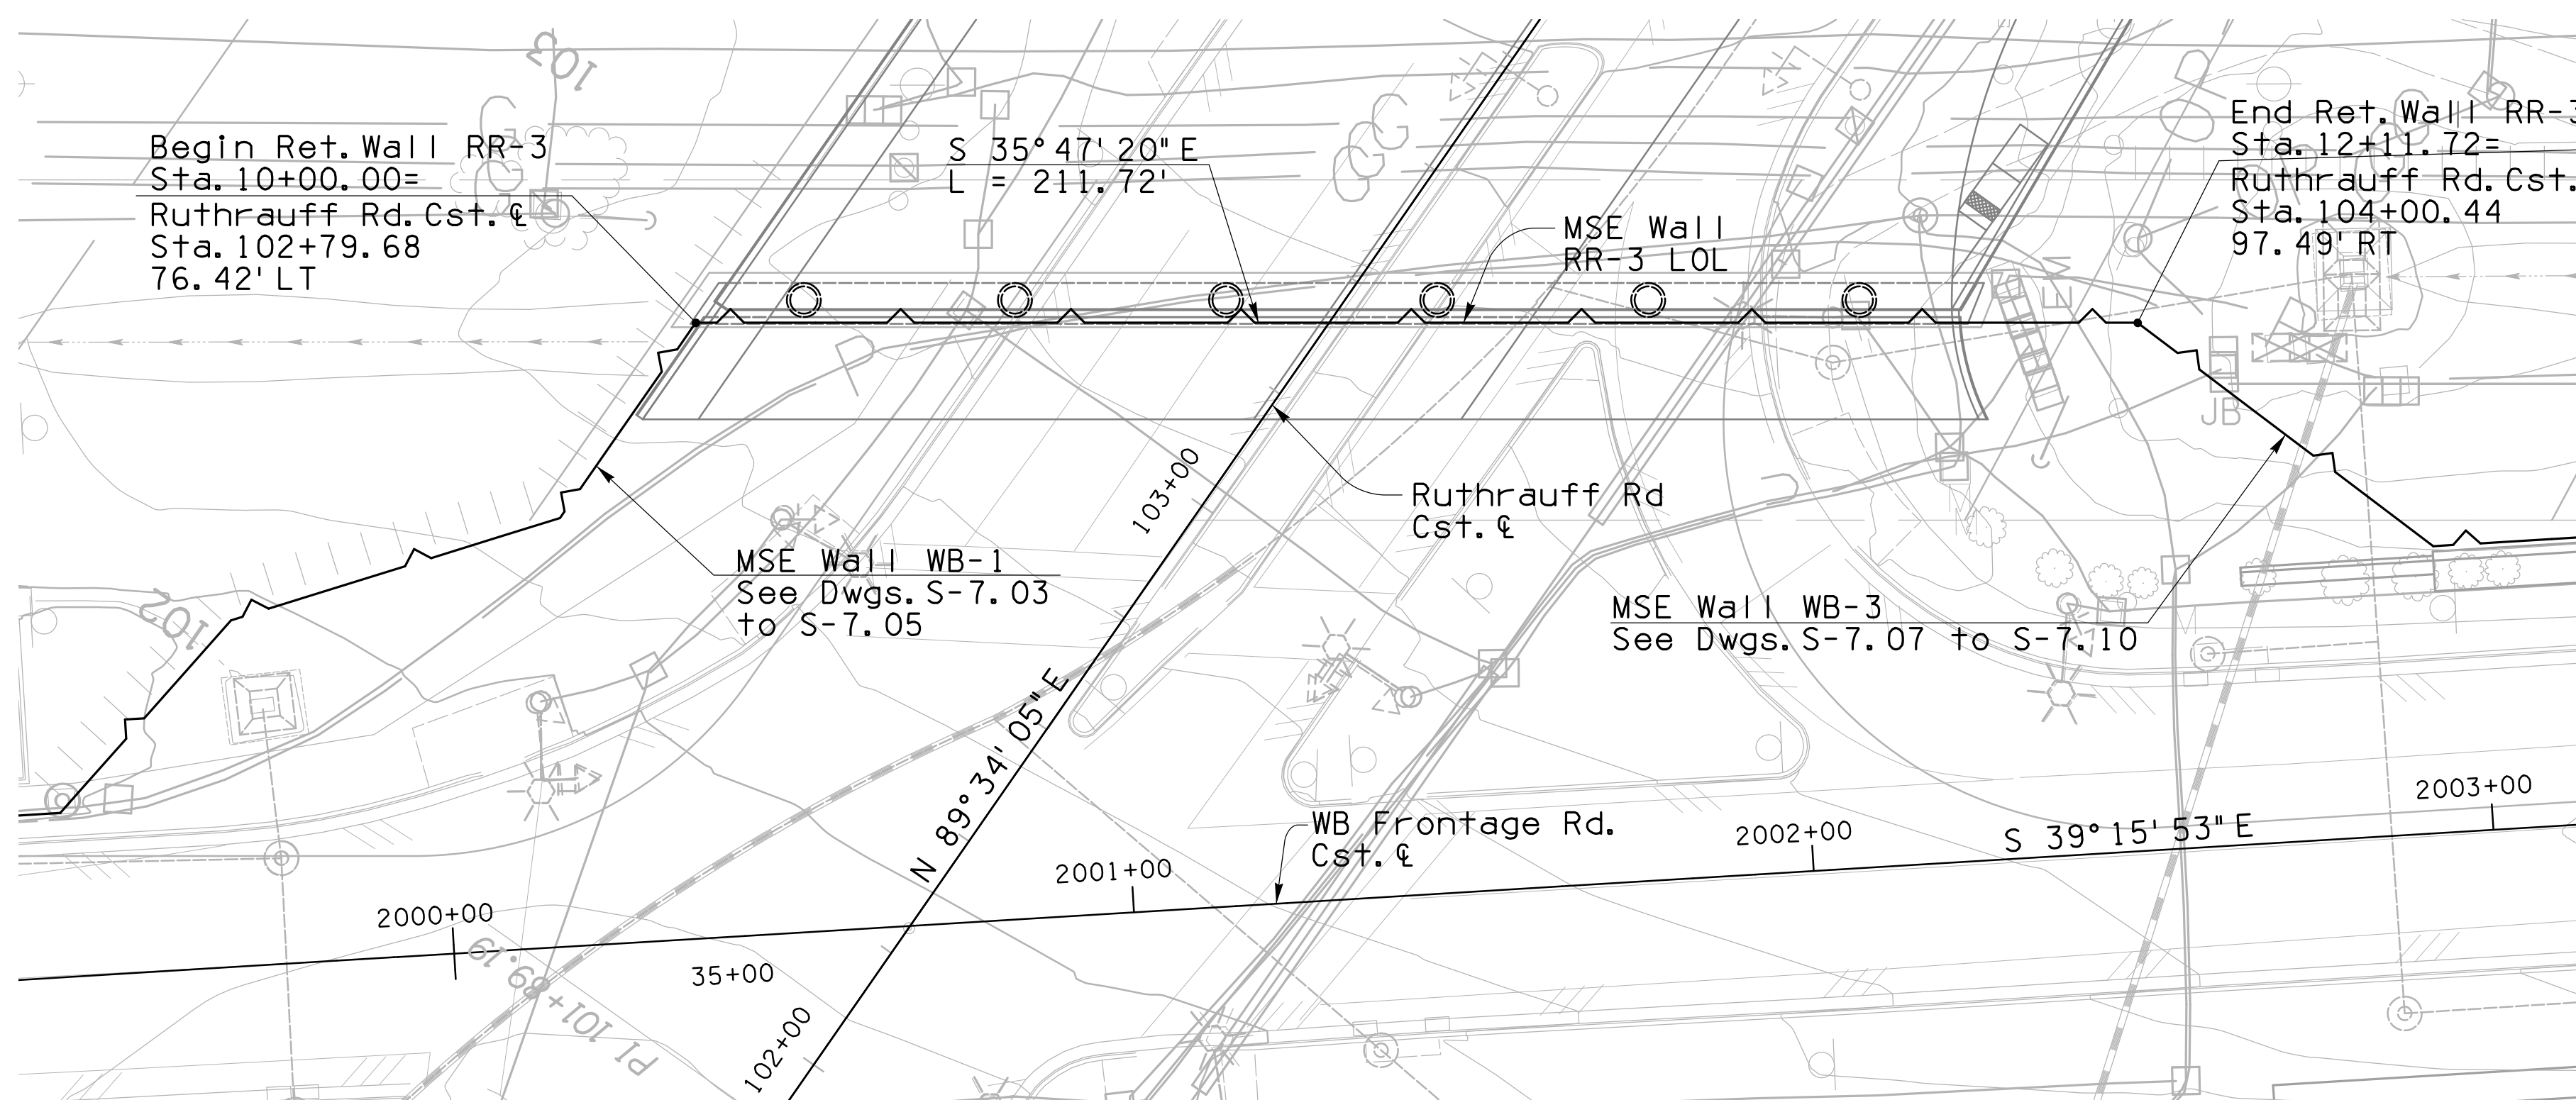

**Note:**


Contractor shall see Architectural Treatment Plans for the MSE icon designs, vertical rustication pattern and blank panel requirements. Full-scale mock-ups are required for each specific design.

Slip Joints shall be positioned such that they do not bisect the architectural wall treatments. Not all of the slip joints are shown on the plans. The Contractor shall follow the Special Provisions for placement of the other required slip joint locations, plus other locations required per the wall manufacturer's design.

The location of all utilities is approximate. The contractor shall review the utility plans and potholing information to confirm the location of new and existing utilities prior to construction.

PLAN - WALL RR-3 (MSE)  
1" = 20'

See detail on Dwg. T-14.14 for Conduits through wall to cross bridge

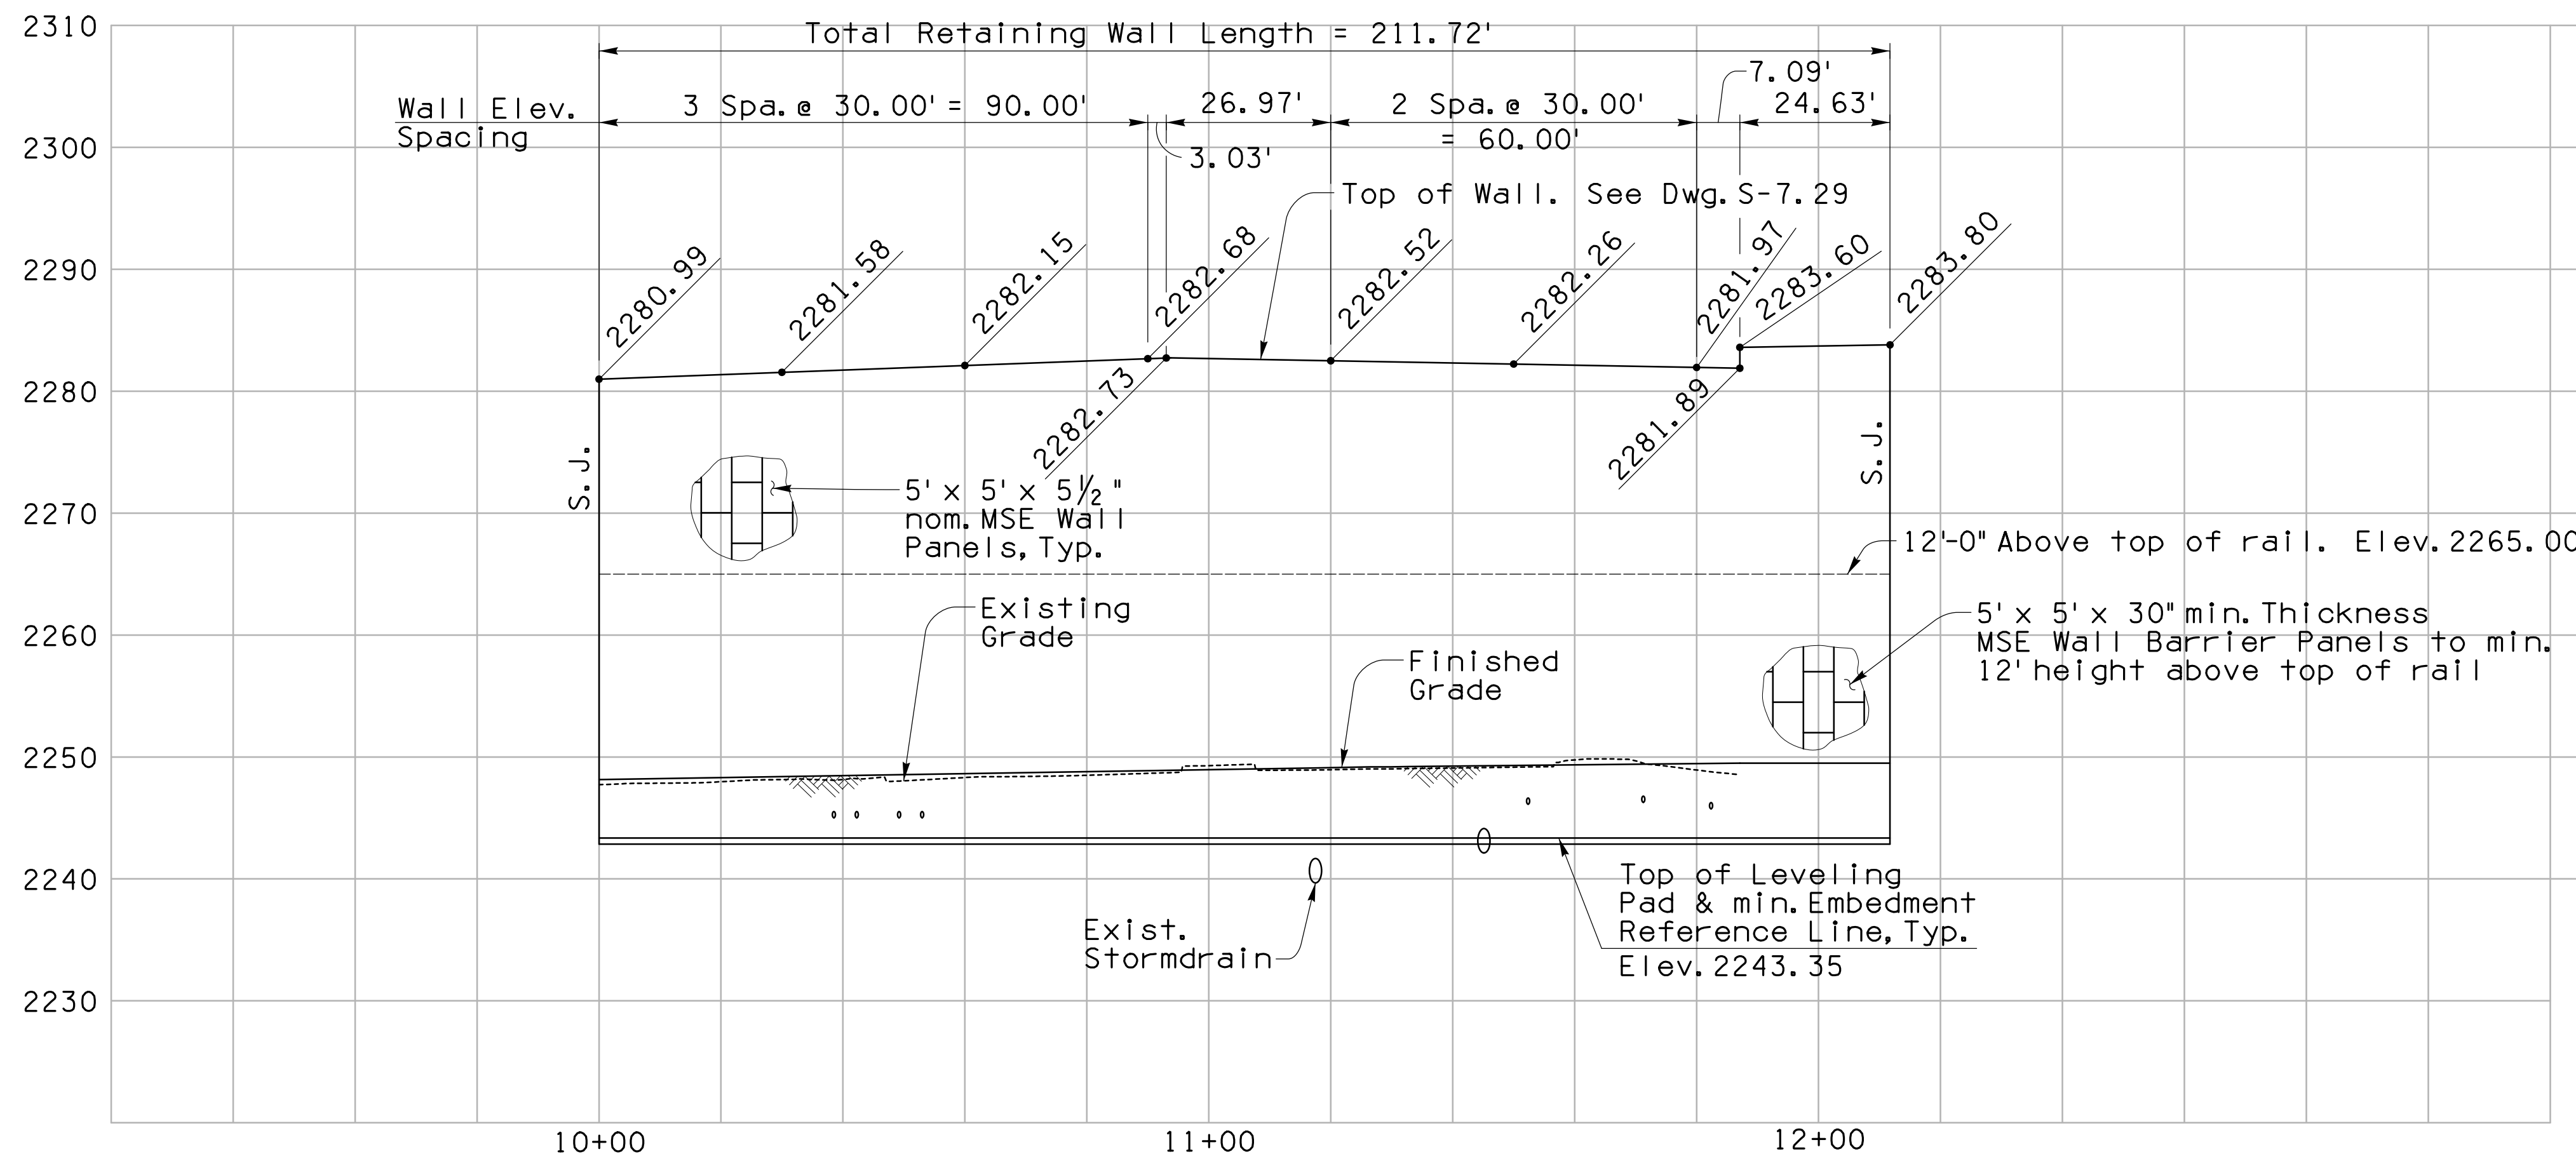


ELEVATION - WALL RR-3 (MSE)  
1" = 20'



DESIGN	NAME	DATE	ARIZONA DEPARTMENT OF TRANSPORTATION INTERMODAL TRANSPORTATION DIVISION ROADWAY DESIGN SERVICES		
DRAWN	JHS, MJL	03-19			
CHECKED	KRH	03-19			
			<b>RETAINING WALL PLAN &amp; ELEVATION WALL RR-3</b>		
ROUTE	LOCATION		RUTHRAUFF ROAD TI		
TRACS NO. H 8480 01C			010-D(213)S		DWG NO. S-7.24 <b>OF</b>

F.H.W.A. REGION	STATE	PROJECT NO.	SHEET NO.	TOTAL SHEETS	AS BUILT
9	ARIZ.	010-D(213)S	727	849	

010 PM 252

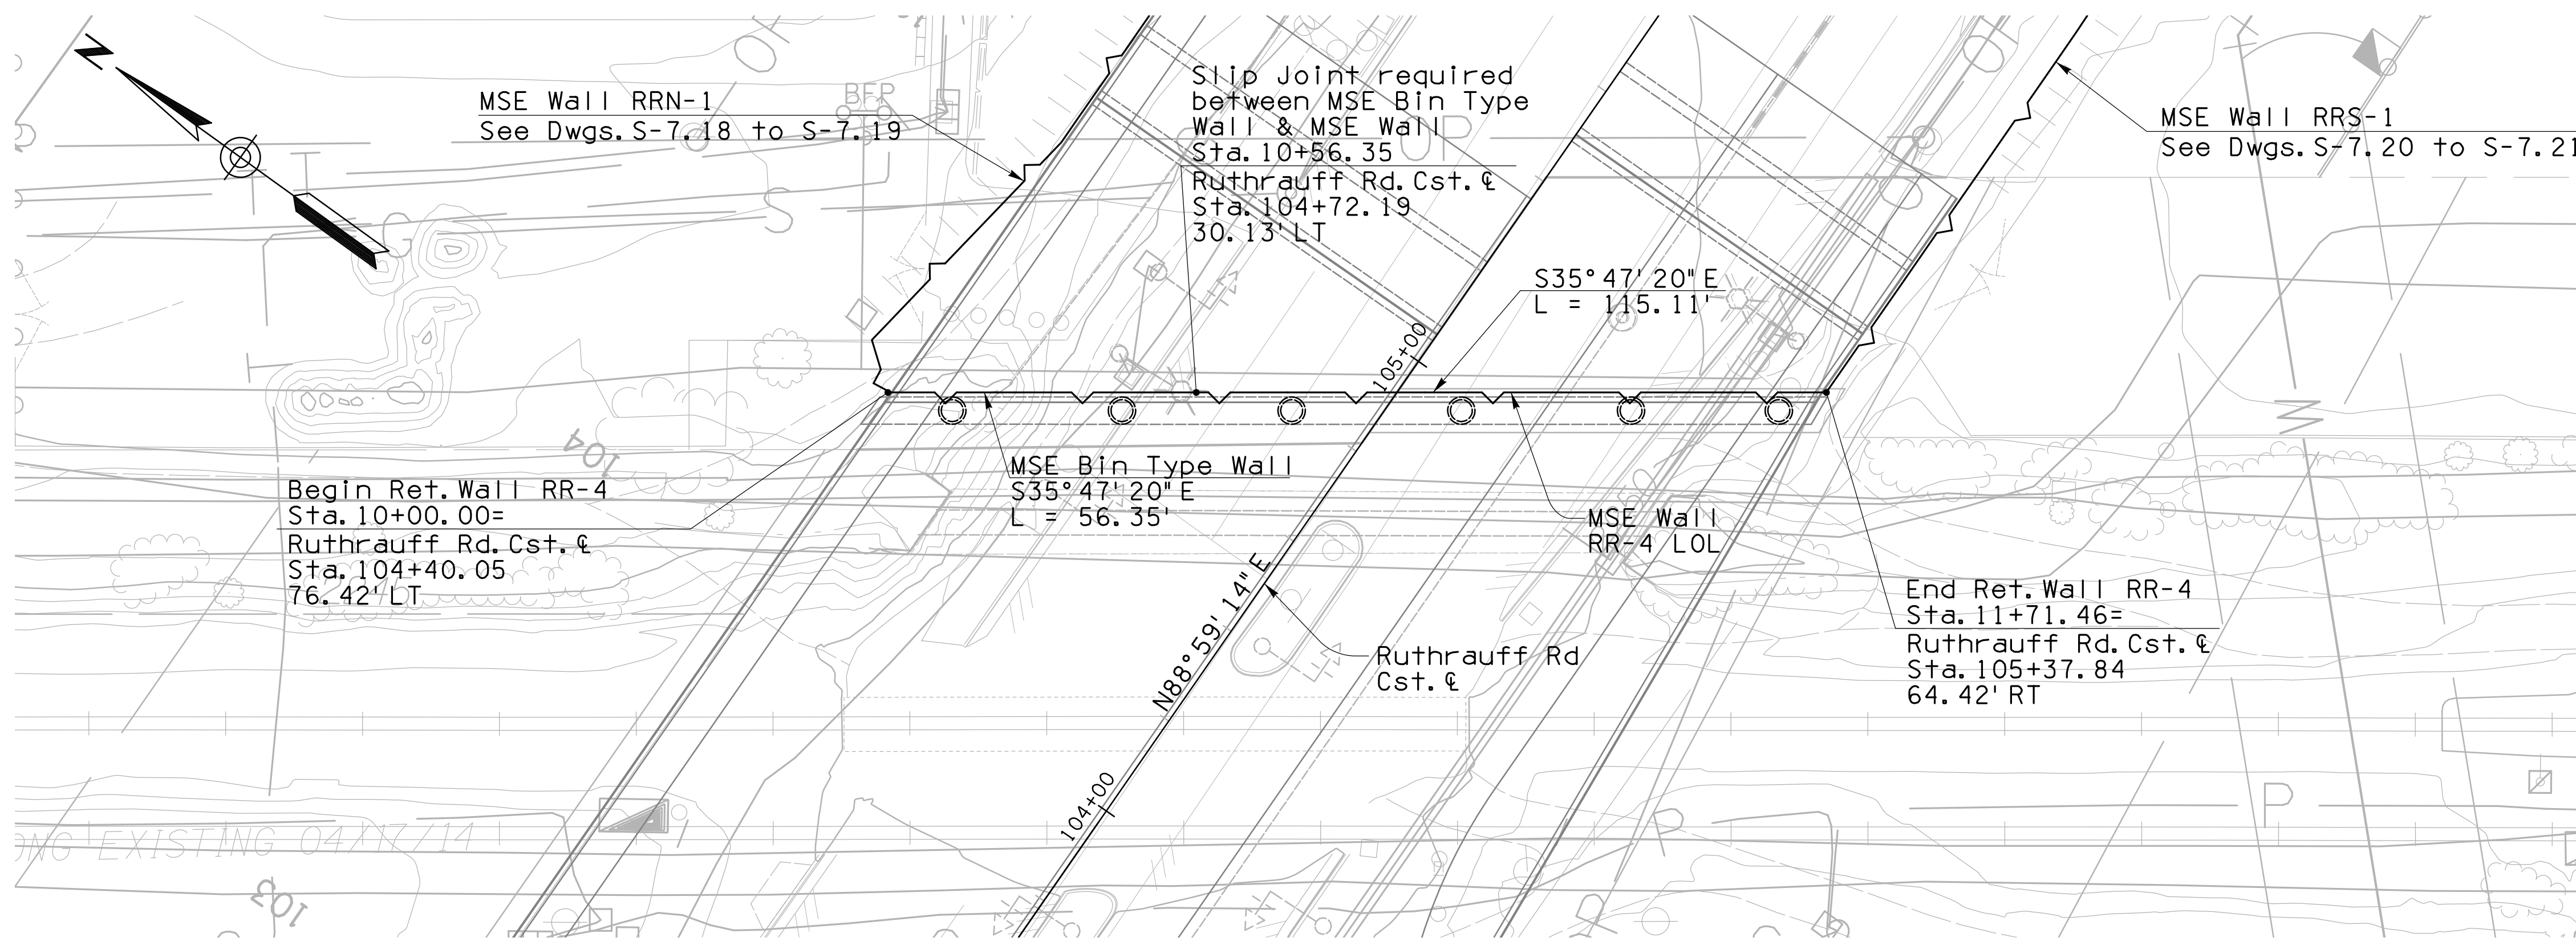


**Notes:**  
 Contractor shall see Architectural Treatment Plans for the MSE icon designs, vertical rustication pattern and blank panel requirements. Full-scale mock-ups are required for each specific design.

Measurement and Payment for MSE Bin Type wall shall be the same as MSE wall.

Slip Joints shall be positioned such that they do not bisect the architectural wall treatments. Not all of the slip joints are shown on the plans. The Contractor shall follow the Special Provisions for placement of the other required slip joint locations, plus other locations required per the wall manufacturer's design.

The location of all utilities is approximate. The contractor shall review the utility plans and potholing information to confirm the location of new and existing utilities prior to construction.

PLAN - WALL RR-4 (MSE)  
 1" = 20'

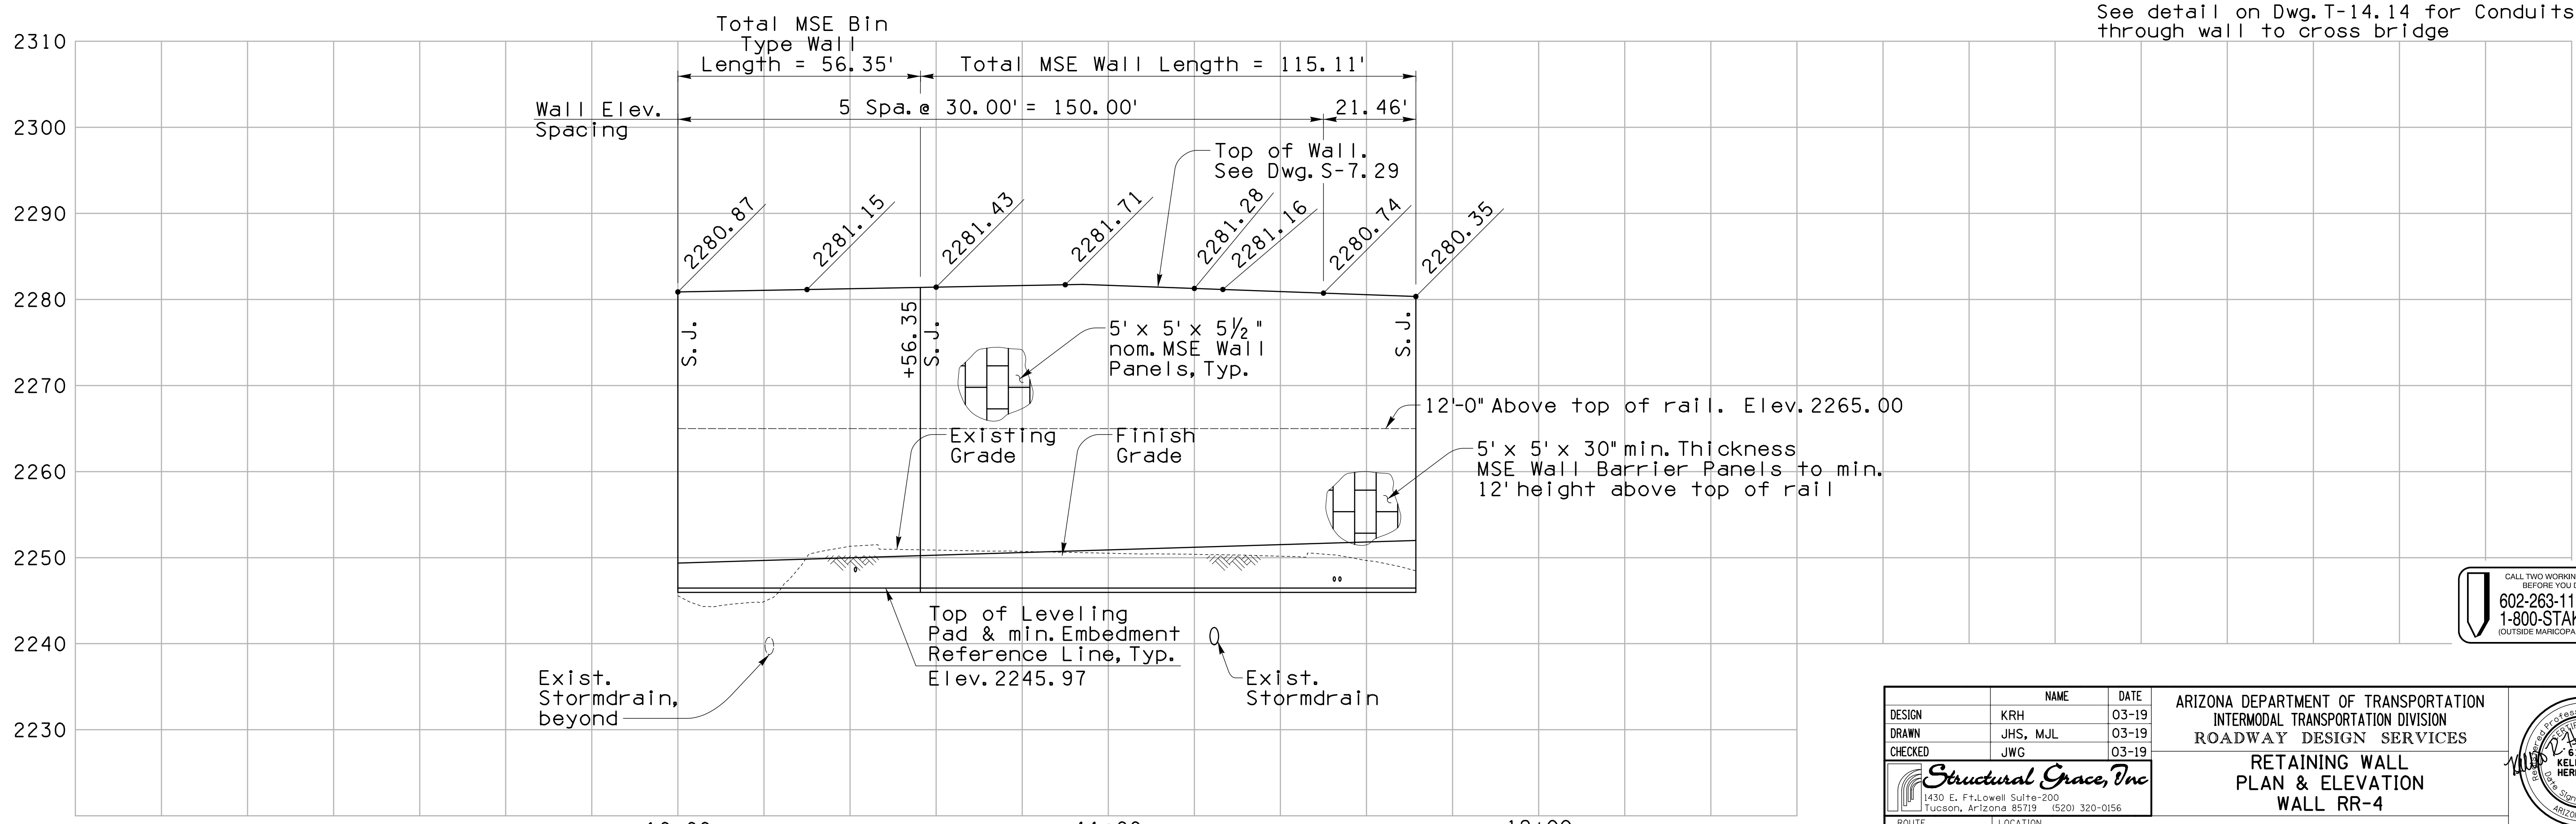

See detail on Dwg. T-14.14 for Conduits through wall to cross bridge


CALL TWO WORKING DAYS BEFORE YOU DIG  
 602-263-1100  
 1-800-STAKE-IT  
 (OUTSIDE MARICOPA COUNTY)

DESIGN	KRH	DATE	03-19	ARIZONA DEPARTMENT OF TRANSPORTATION INTERMODAL TRANSPORTATION DIVISION ROADWAY DESIGN SERVICES
DRAWN	JHS, MJL	03-19		
CHECKED	JWG	03-19		
				<b>RETAINING WALL          PLAN &amp; ELEVATION          WALL RR-4</b>
ROUTE	I-10	LOCATION	RUTHRAUFF ROAD TI	
TRACS NO. H 8480 01C				010-D(213)S
				DWG NO. S-7.25
				OF




F.H.W.A. REGION	STATE	PROJECT NO.	SHEET NO.	TOTAL SHEETS	AS BUILT
9	ARIZ.	010-D(213)S	728	849	

010 PM 252

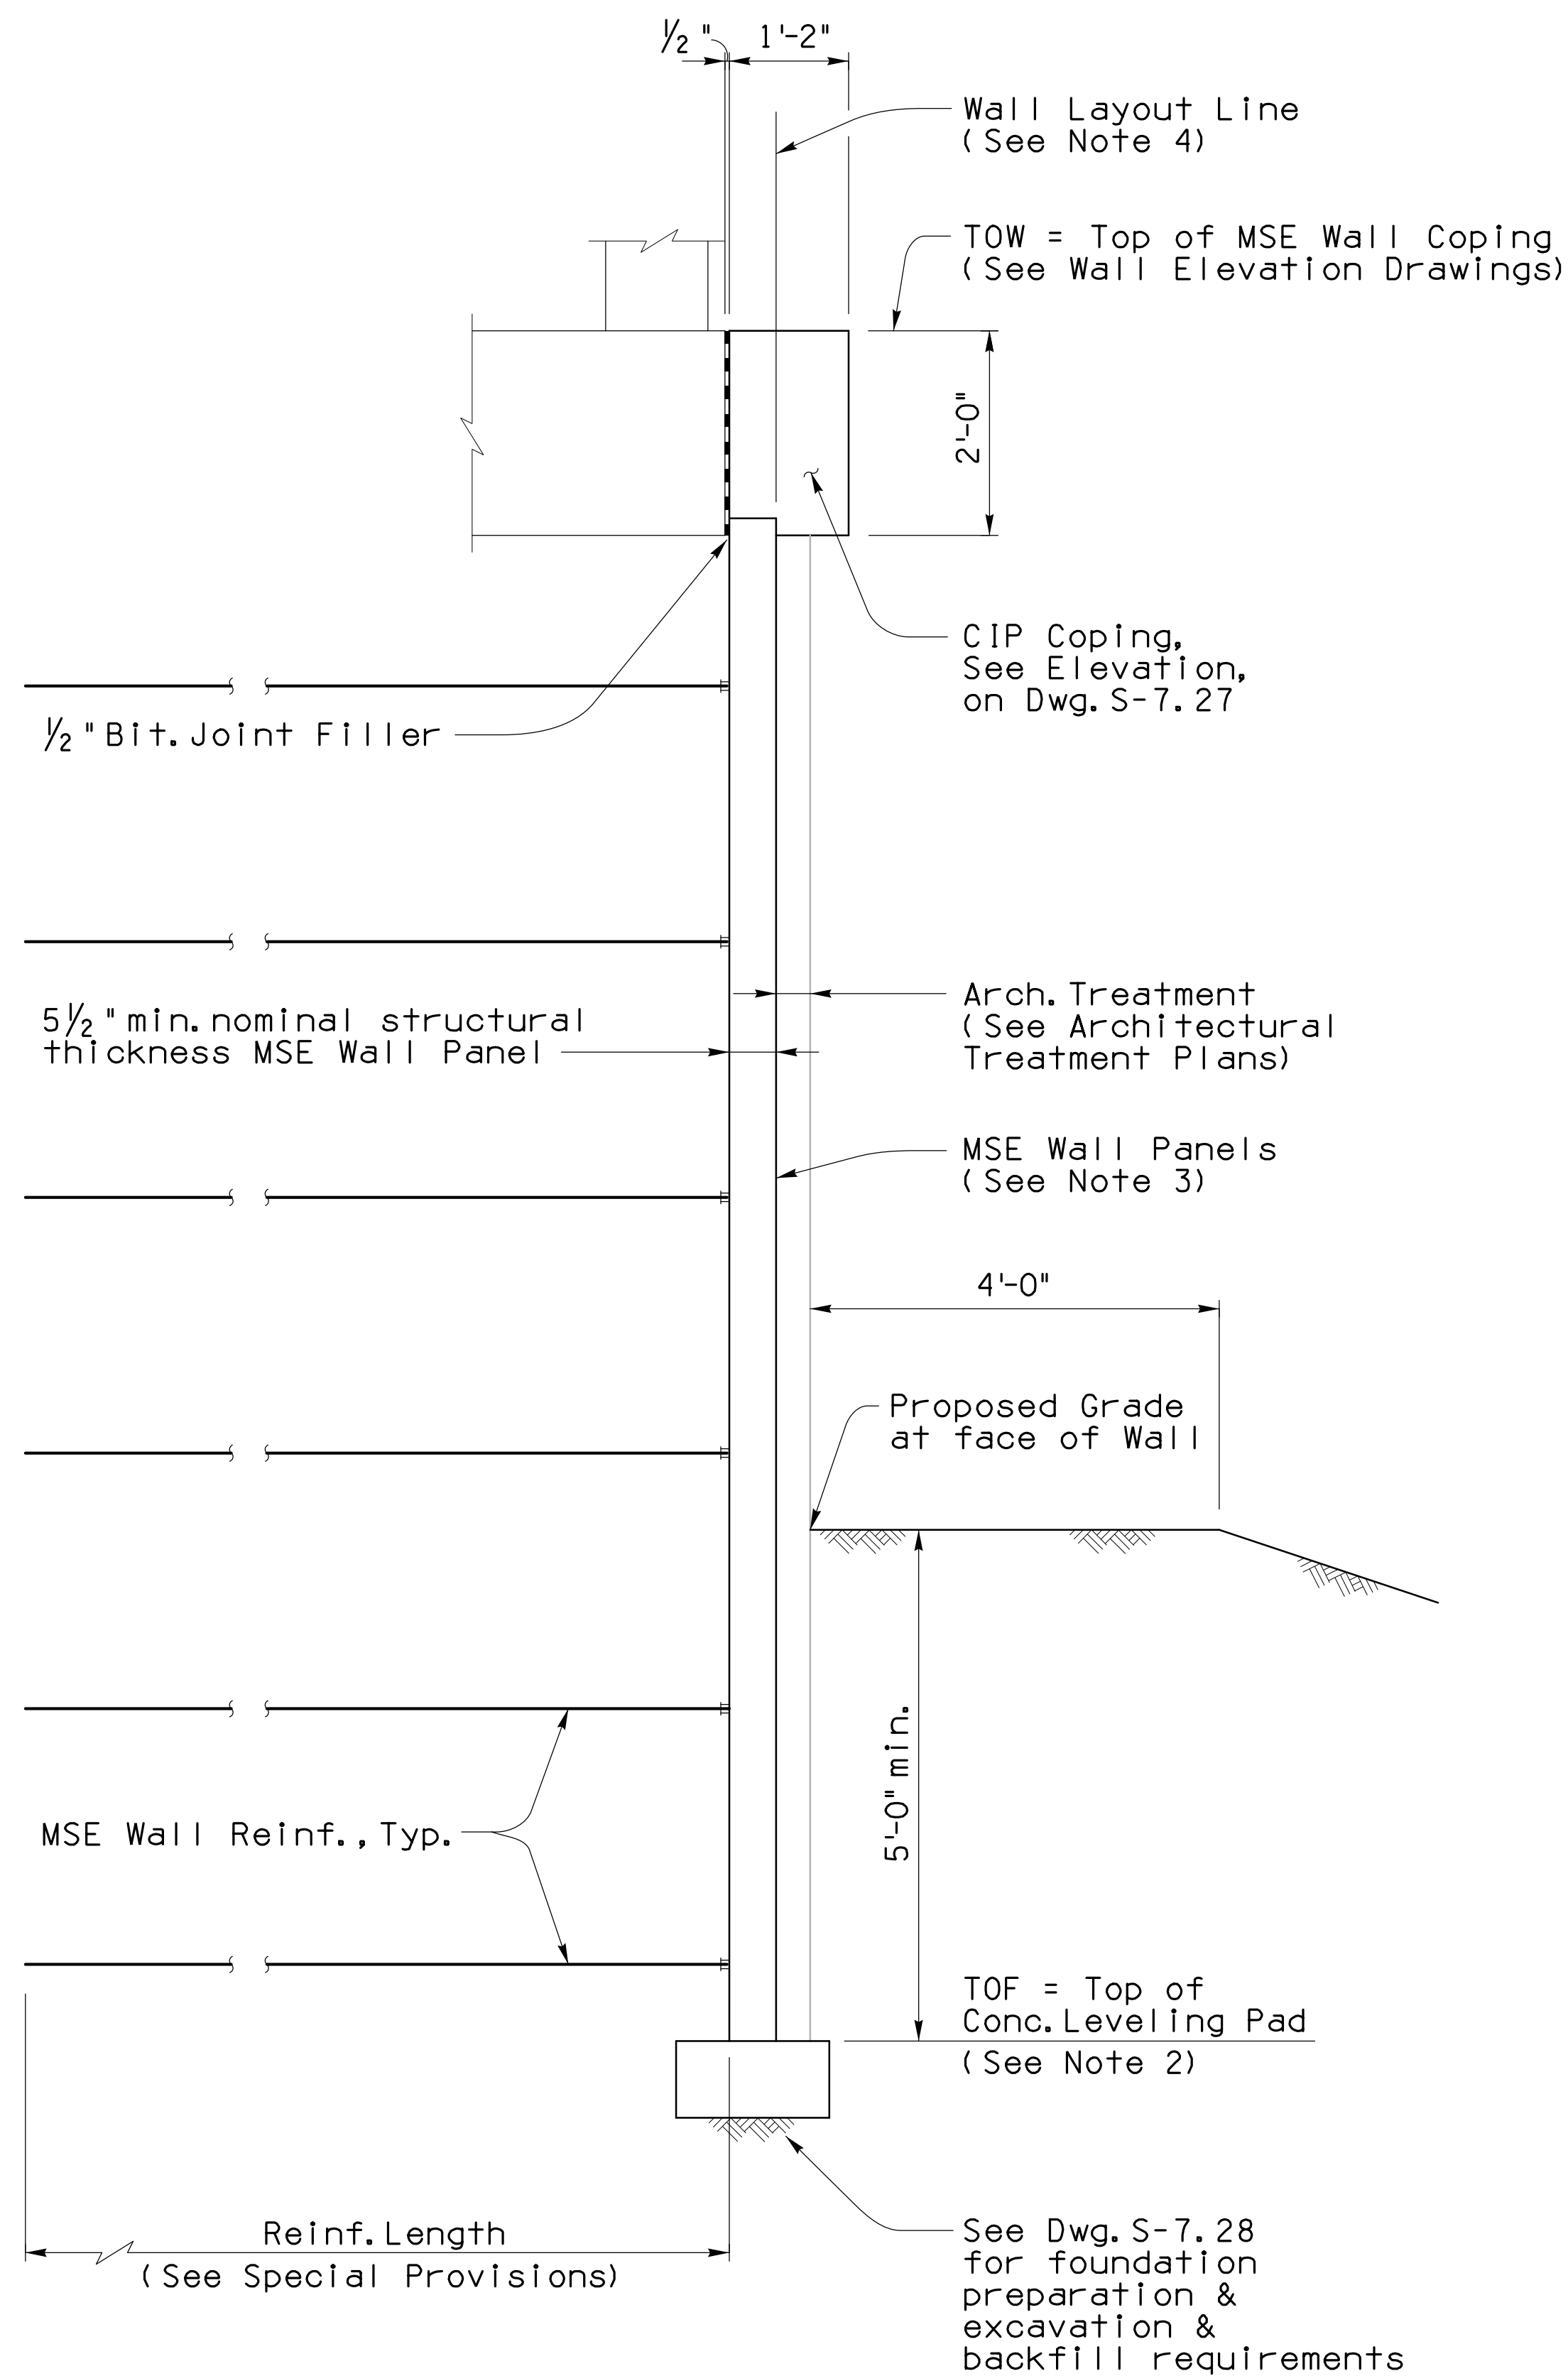

MSE RETAINING WALL - TYPICAL SECTION  
3/4" = 1'-0"

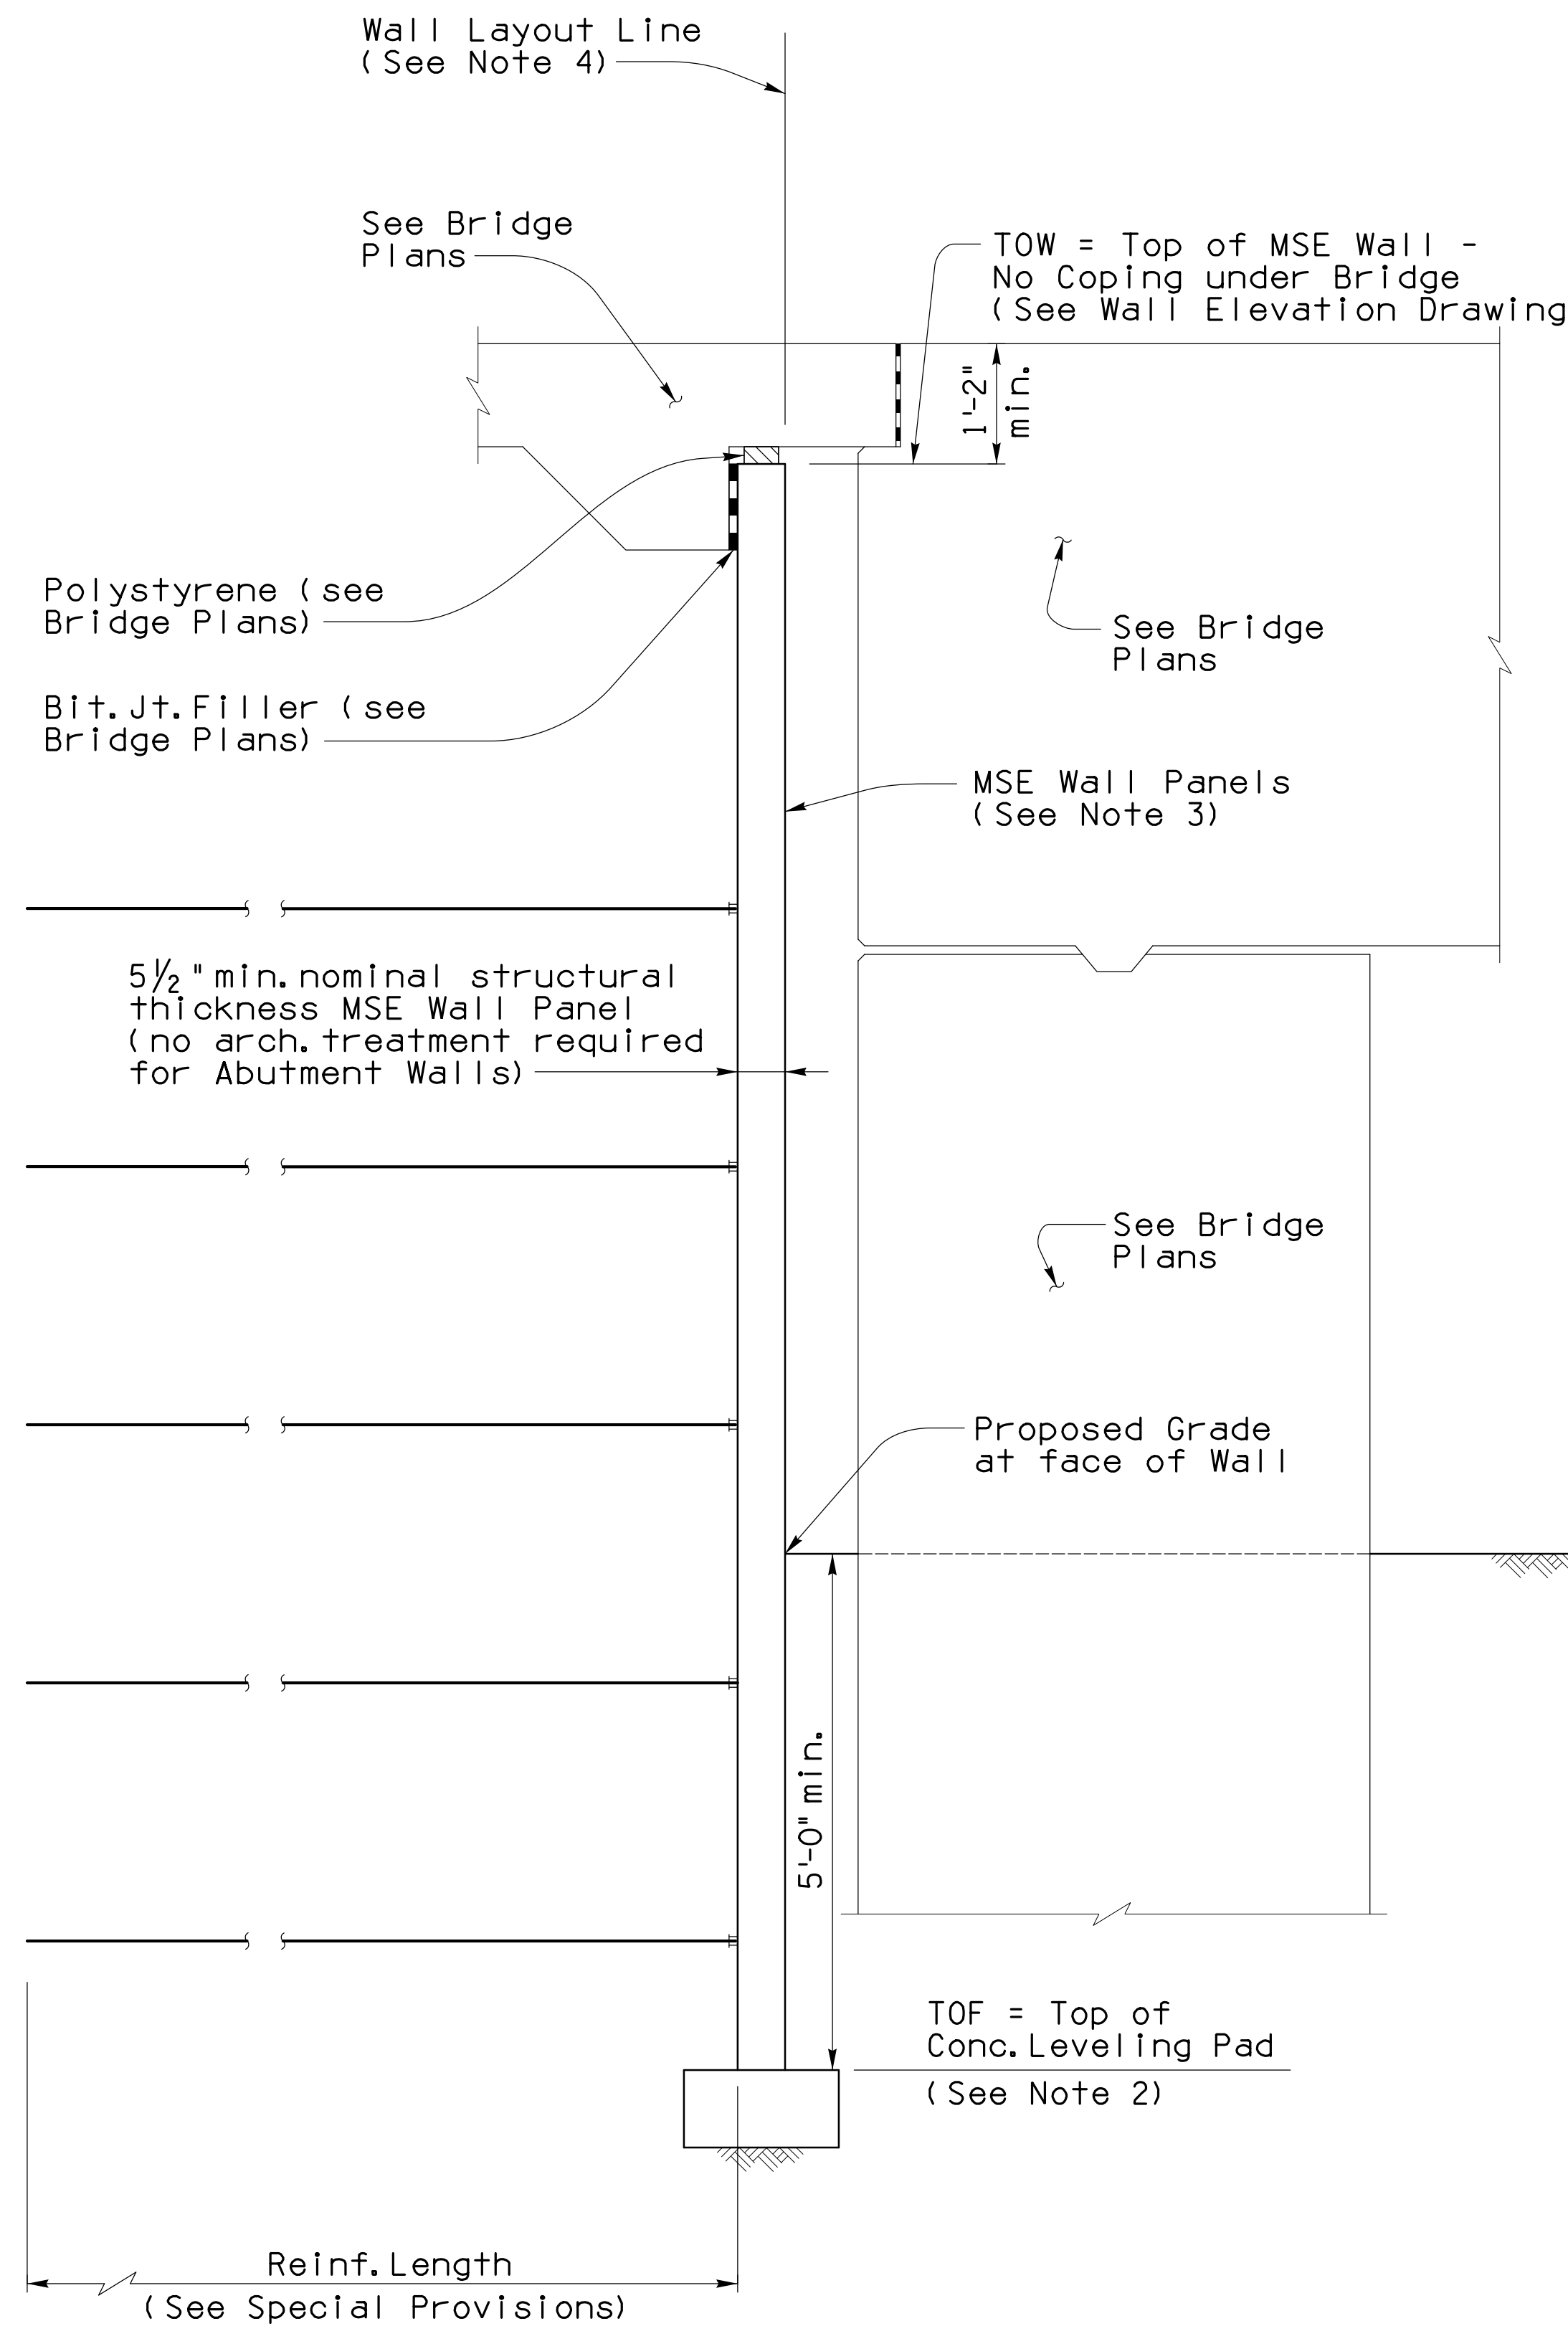

MSE RETAINING WALL - AT I-10 BRIDGE ABUTMENT  
3/4" = 1'-0"

**Notes:**


1. The MSE wall Manufacturer is responsible for designing the MSE walls to accommodate obstructions located within the reinforced backfill zone. These obstructions include catch basins, pole foundations and other items as shown on the project plans.
2. See Wall Elevation Plans for top of leveling pad elevations. The leveling pad size shall be determined by the MSE wall Manufacturer's requirements (6" deep x 12" wide minimum) for 5 1/2" min. nominal structural thickness MSE wall panels.
3. MSE wall panels shall be 5' wide x 5' tall, nominal.
4. Wall layout line is based on an assumed minimum nominal structure MSE wall panel thickness excluding rustication as shown.




DESIGN	NAME	DATE	ARIZONA DEPARTMENT OF TRANSPORTATION INTERMODAL TRANSPORTATION DIVISION ROADWAY DESIGN SERVICES
DRAWN	JAM, JWJ	03-19	<b>RETAINING WALL DETAILS (1 OF 6)</b> 
CHECKED	JHS, MJL	03-19	
	KRH	03-19	
ROUTE	LOCATION	RUTHRAUFF ROAD TI	
TRACS NO. H 8480 01C		010-D(213)S	
		DWG NO. S-7.26	

F.H.W.A. REGION	STATE	PROJECT NO.	SHEET NO.	TOTAL SHEETS	AS BUILT
9	ARIZ.	010-D(213)S	729	849	

010 PM 252

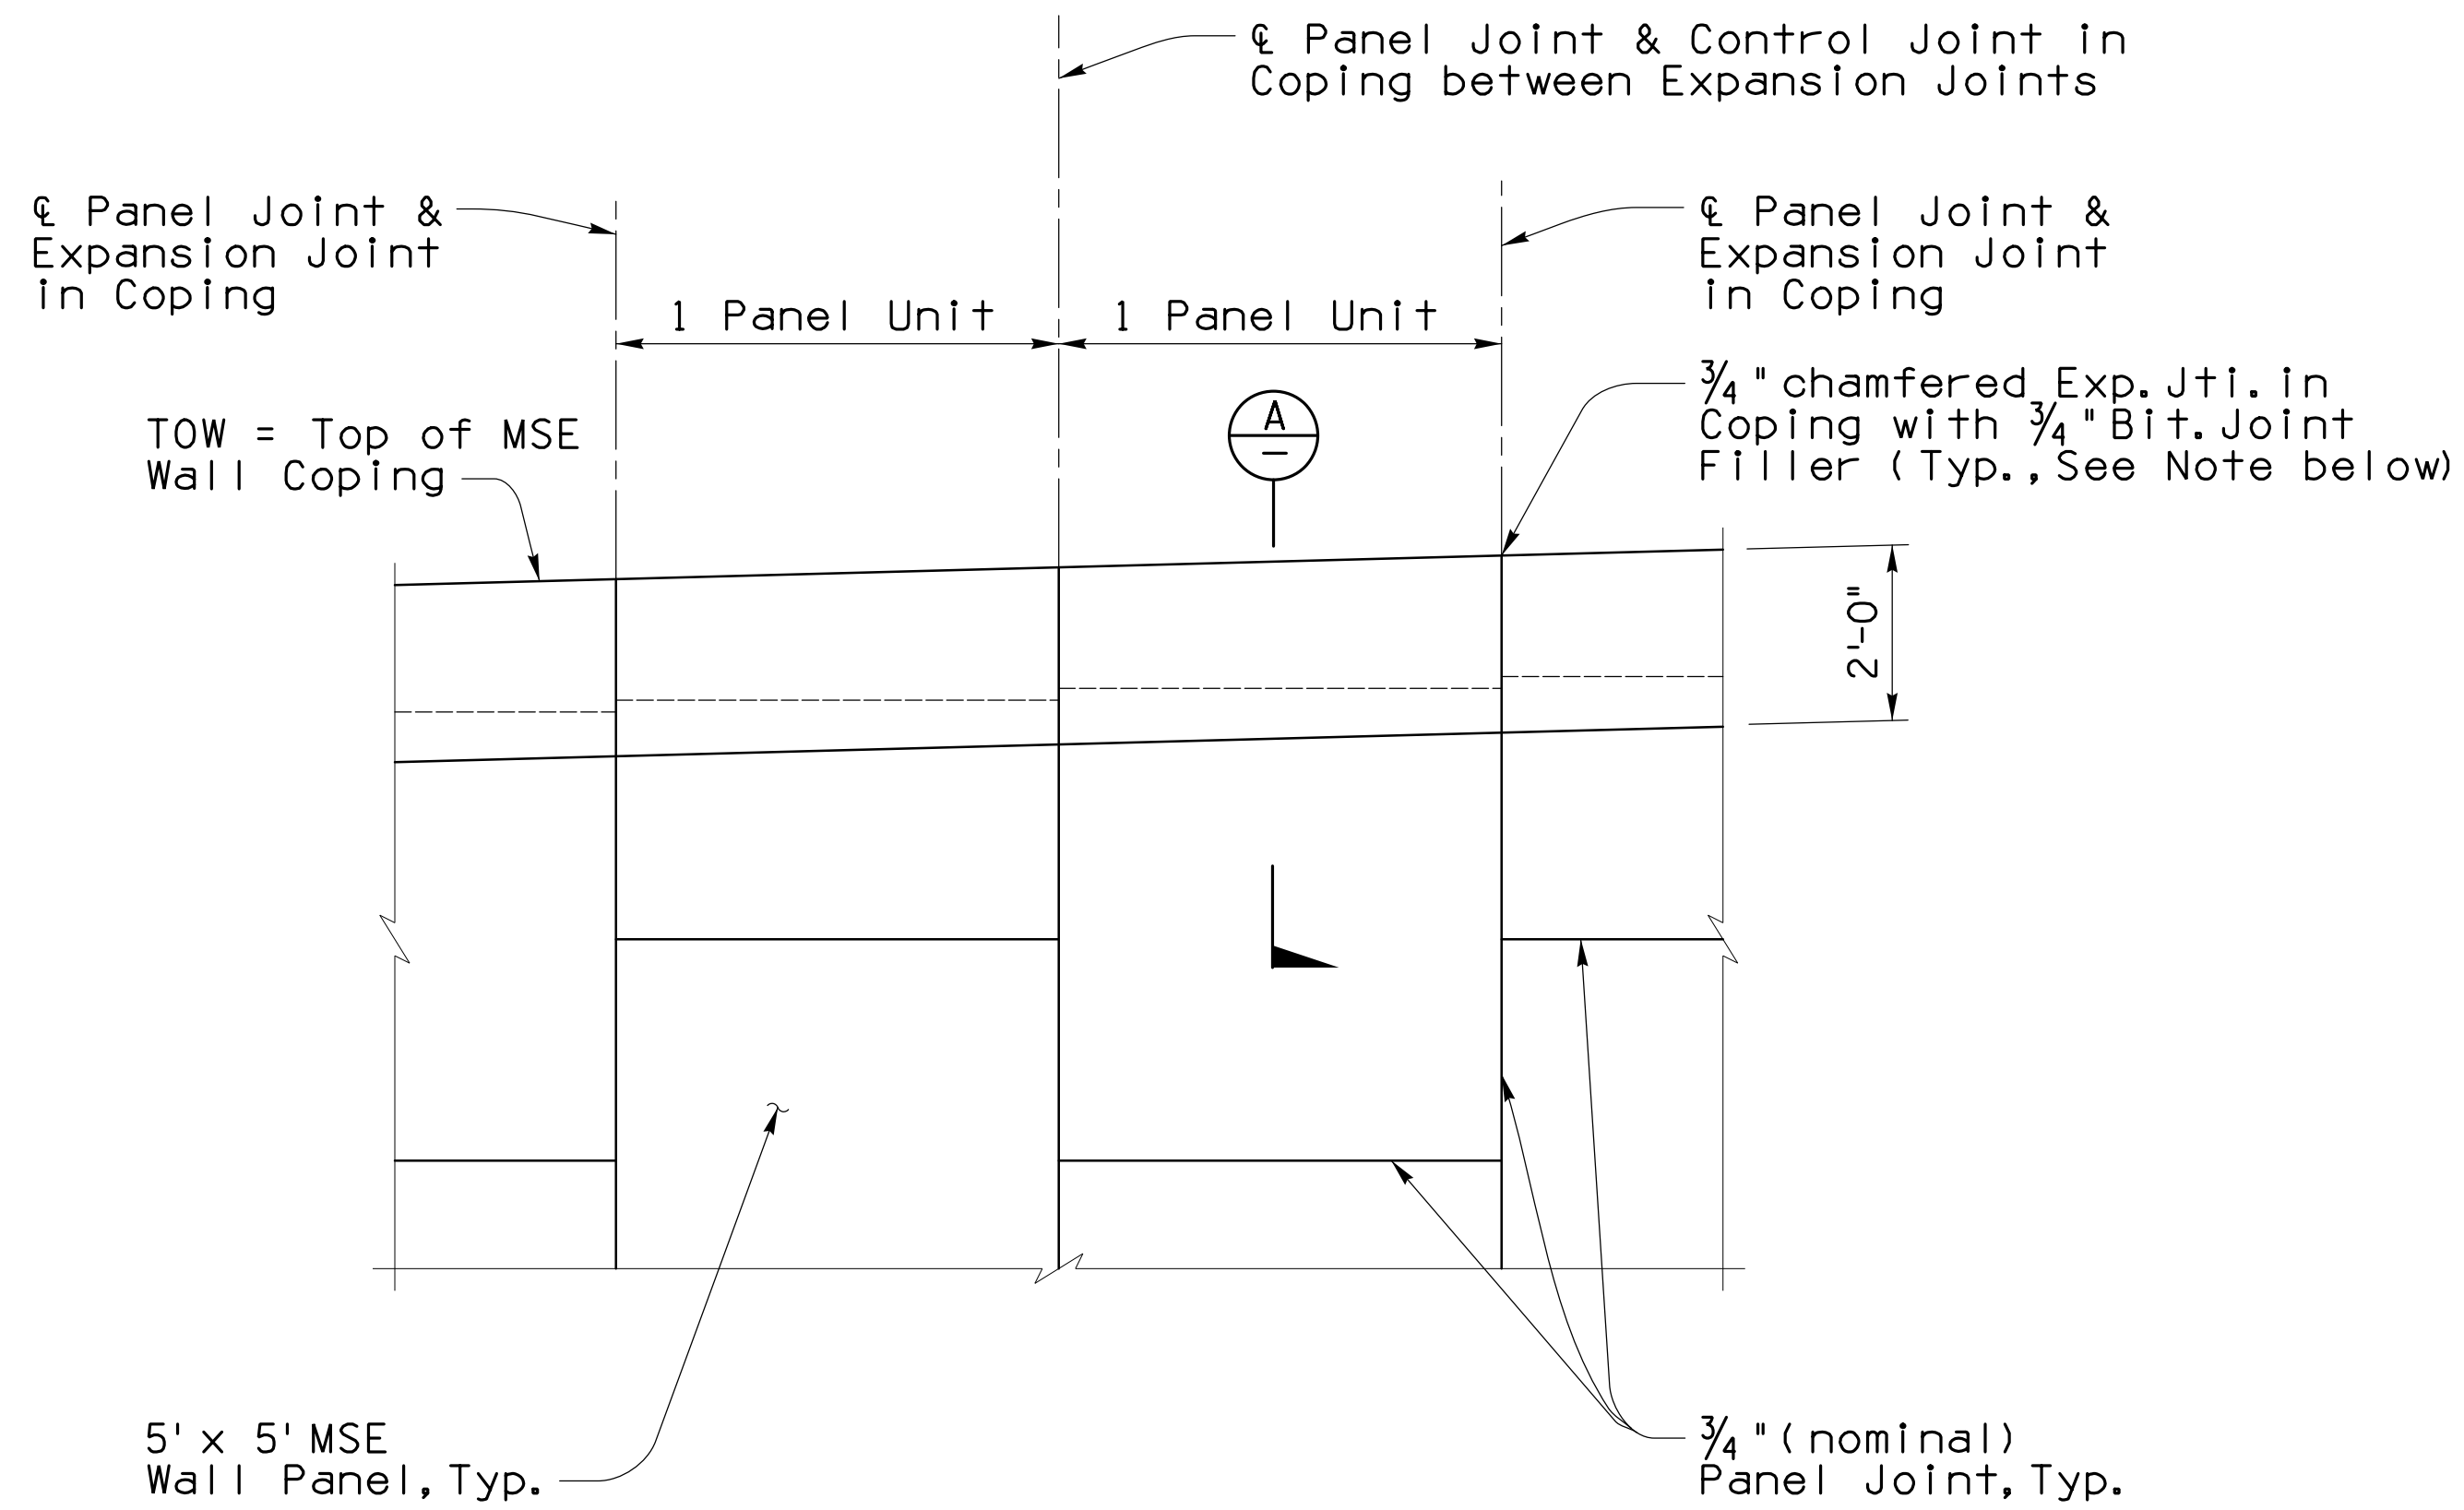


**Note:**  
Coping longitudinal reinforcement shall be cut 2" clear of each side of the expansion joints.

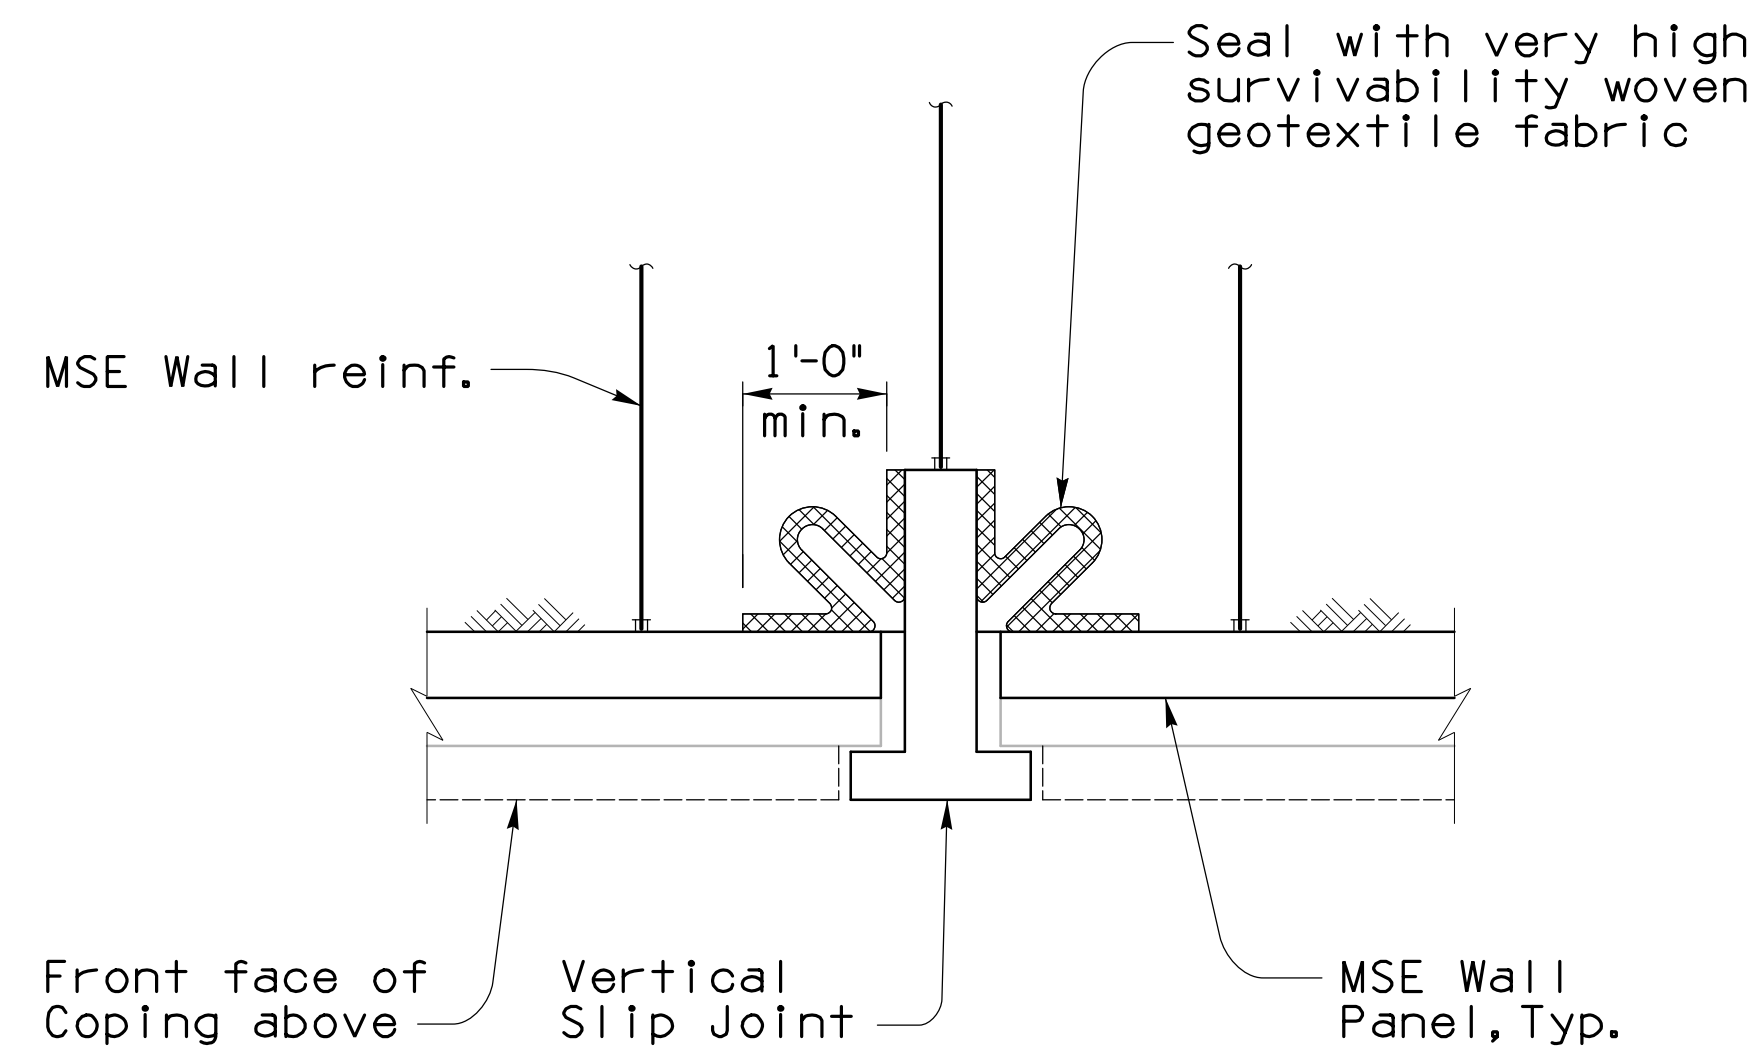


**VERTICAL SLIP JOINT (SJ) DETAIL**  
3/4" = 1'-0"

**Notes:**  
1. See wall plans for approximate slip joint locations (90' max. except as shown).

**ELEVATION**  
1/2" = 1'-0"

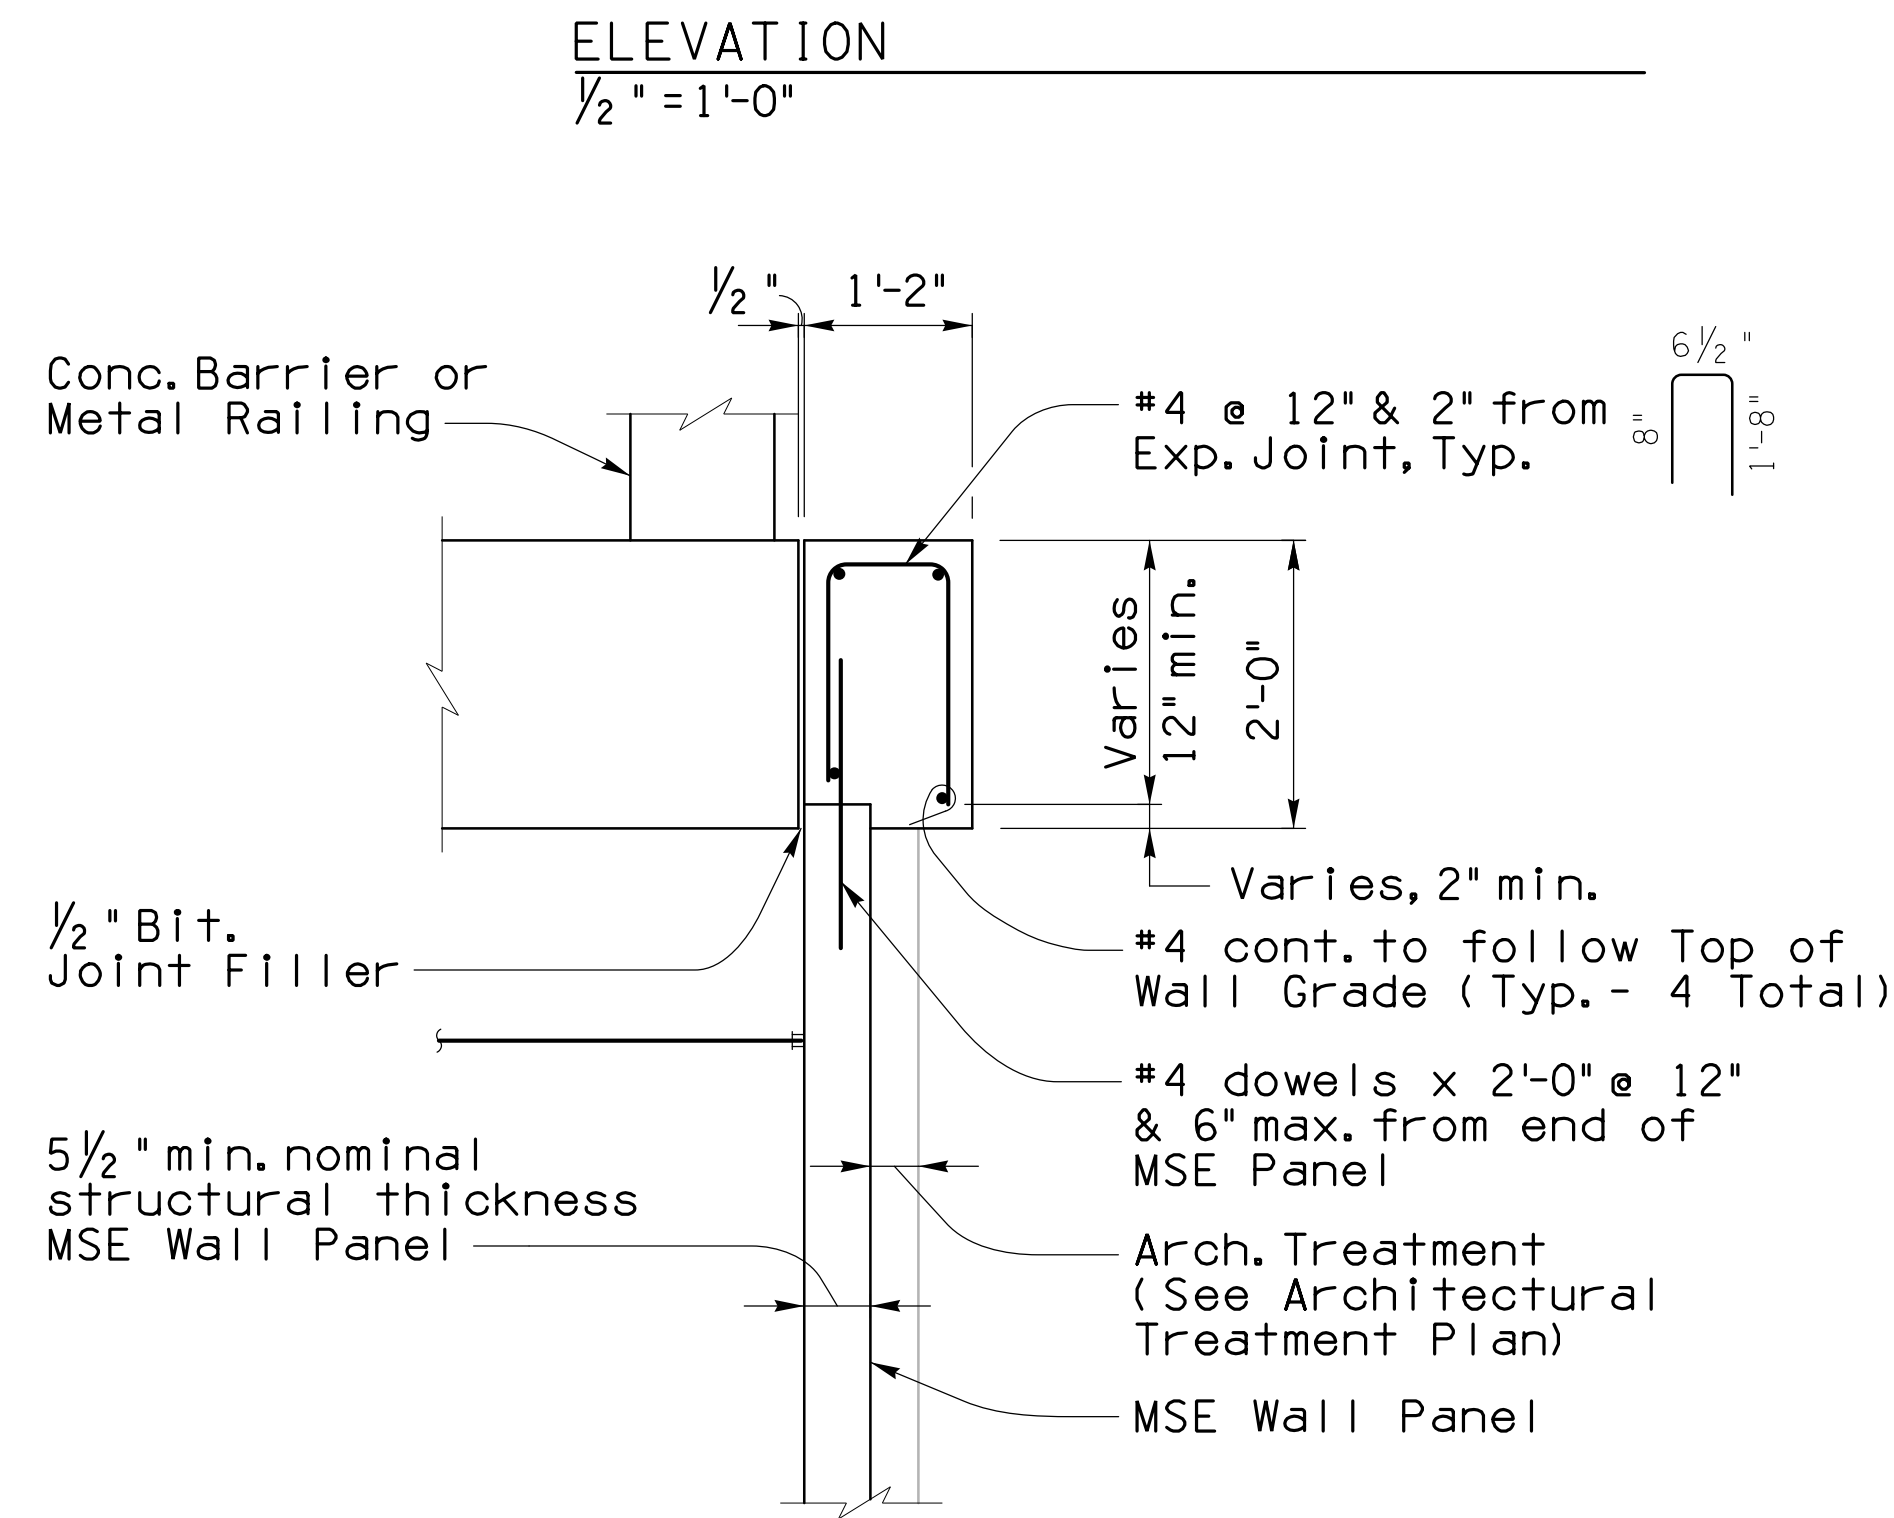

**MSE WALL COPING BEAM SECTION**  
3/4" = 1'-0"

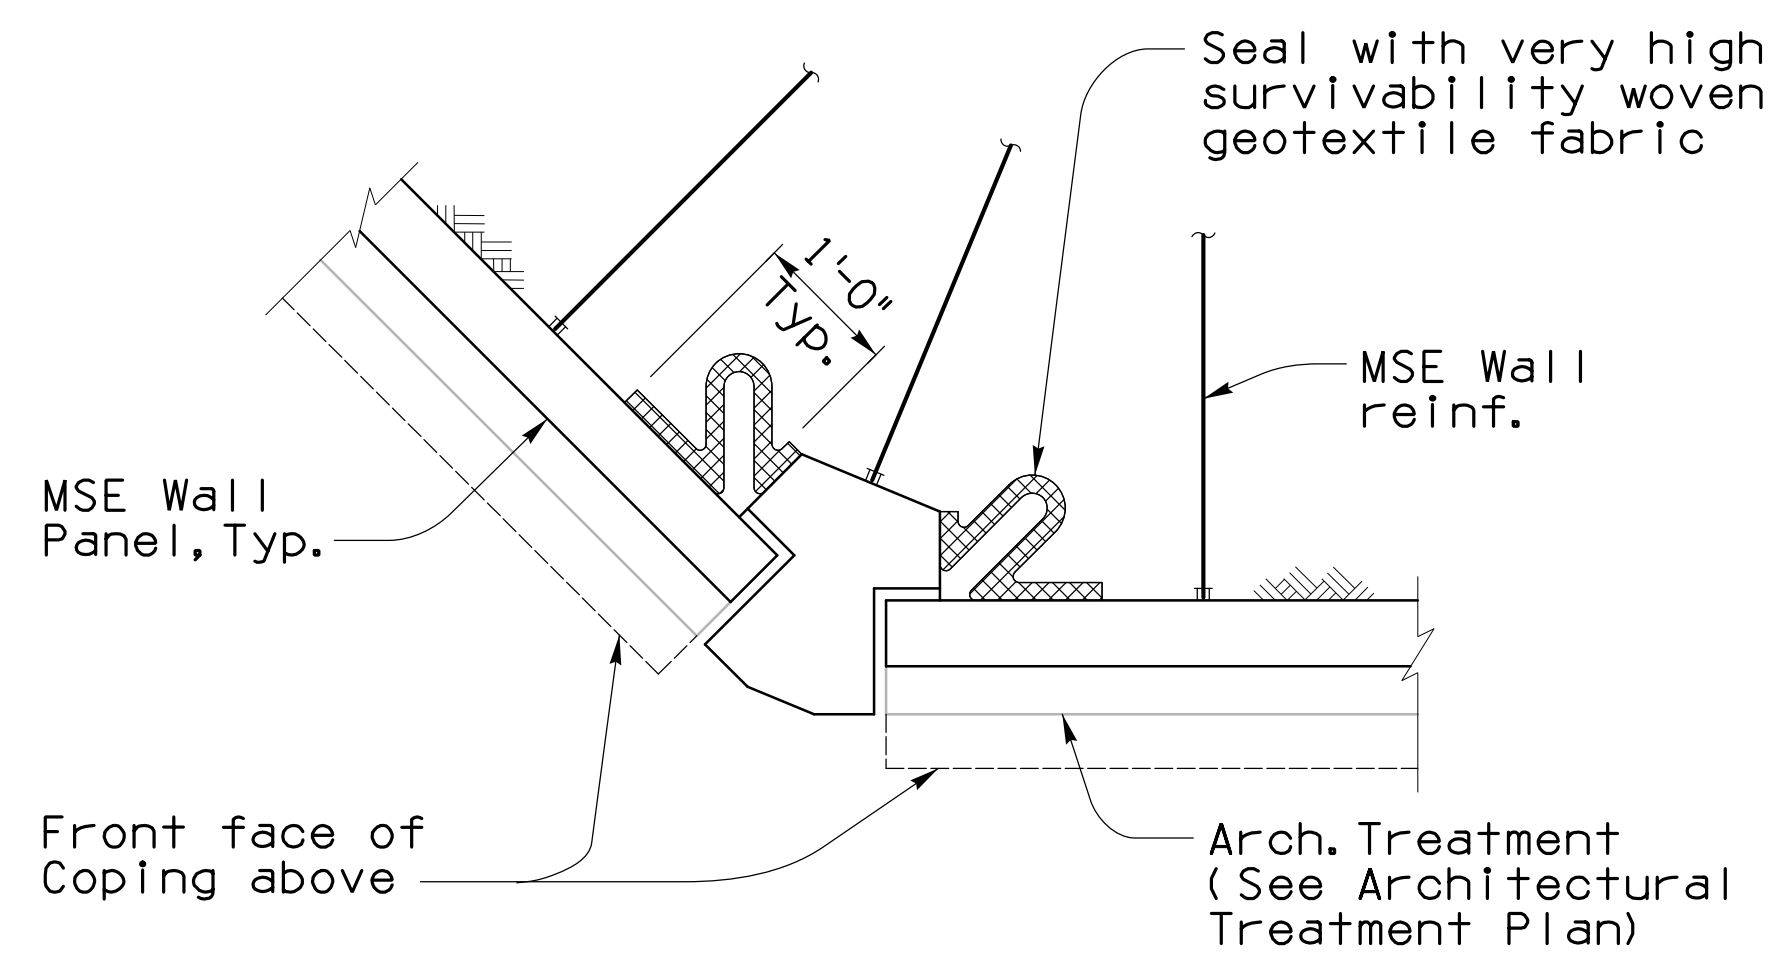


**ANGLE POINT (AP) DETAIL (90° TO 270°)**  
3/4" = 1'-0"



DESIGN	NAME	DATE	ARIZONA DEPARTMENT OF TRANSPORTATION INTERMODAL TRANSPORTATION DIVISION ROADWAY DESIGN SERVICES		
DRAWN	JAM, JWJ	03-19	<b>RETAINING WALL DETAILS (2 OF 6)</b>		
CHECKED	JHS, MJL	03-19			
	KRH	03-19			
<b>Structural Grace, Inc</b> <small>1430 E. Ft. Lowell, Suite 200 Tucson, Arizona 85719 (520) 320-0156</small>					
ROUTE	LOCATION	RUTHRAUFF ROAD TI			Expires: 12/31/20
I-10					DWG NO. S-7.27
TRACS NO. H 8480 01C		010-D(213)S		OF	


F.H.W.A. REGION	STATE	PROJECT NO.	SHEET NO.	TOTAL SHEETS	AS BUILT
9	ARIZ.	010-D(213)S	730	849	

010 PM 252

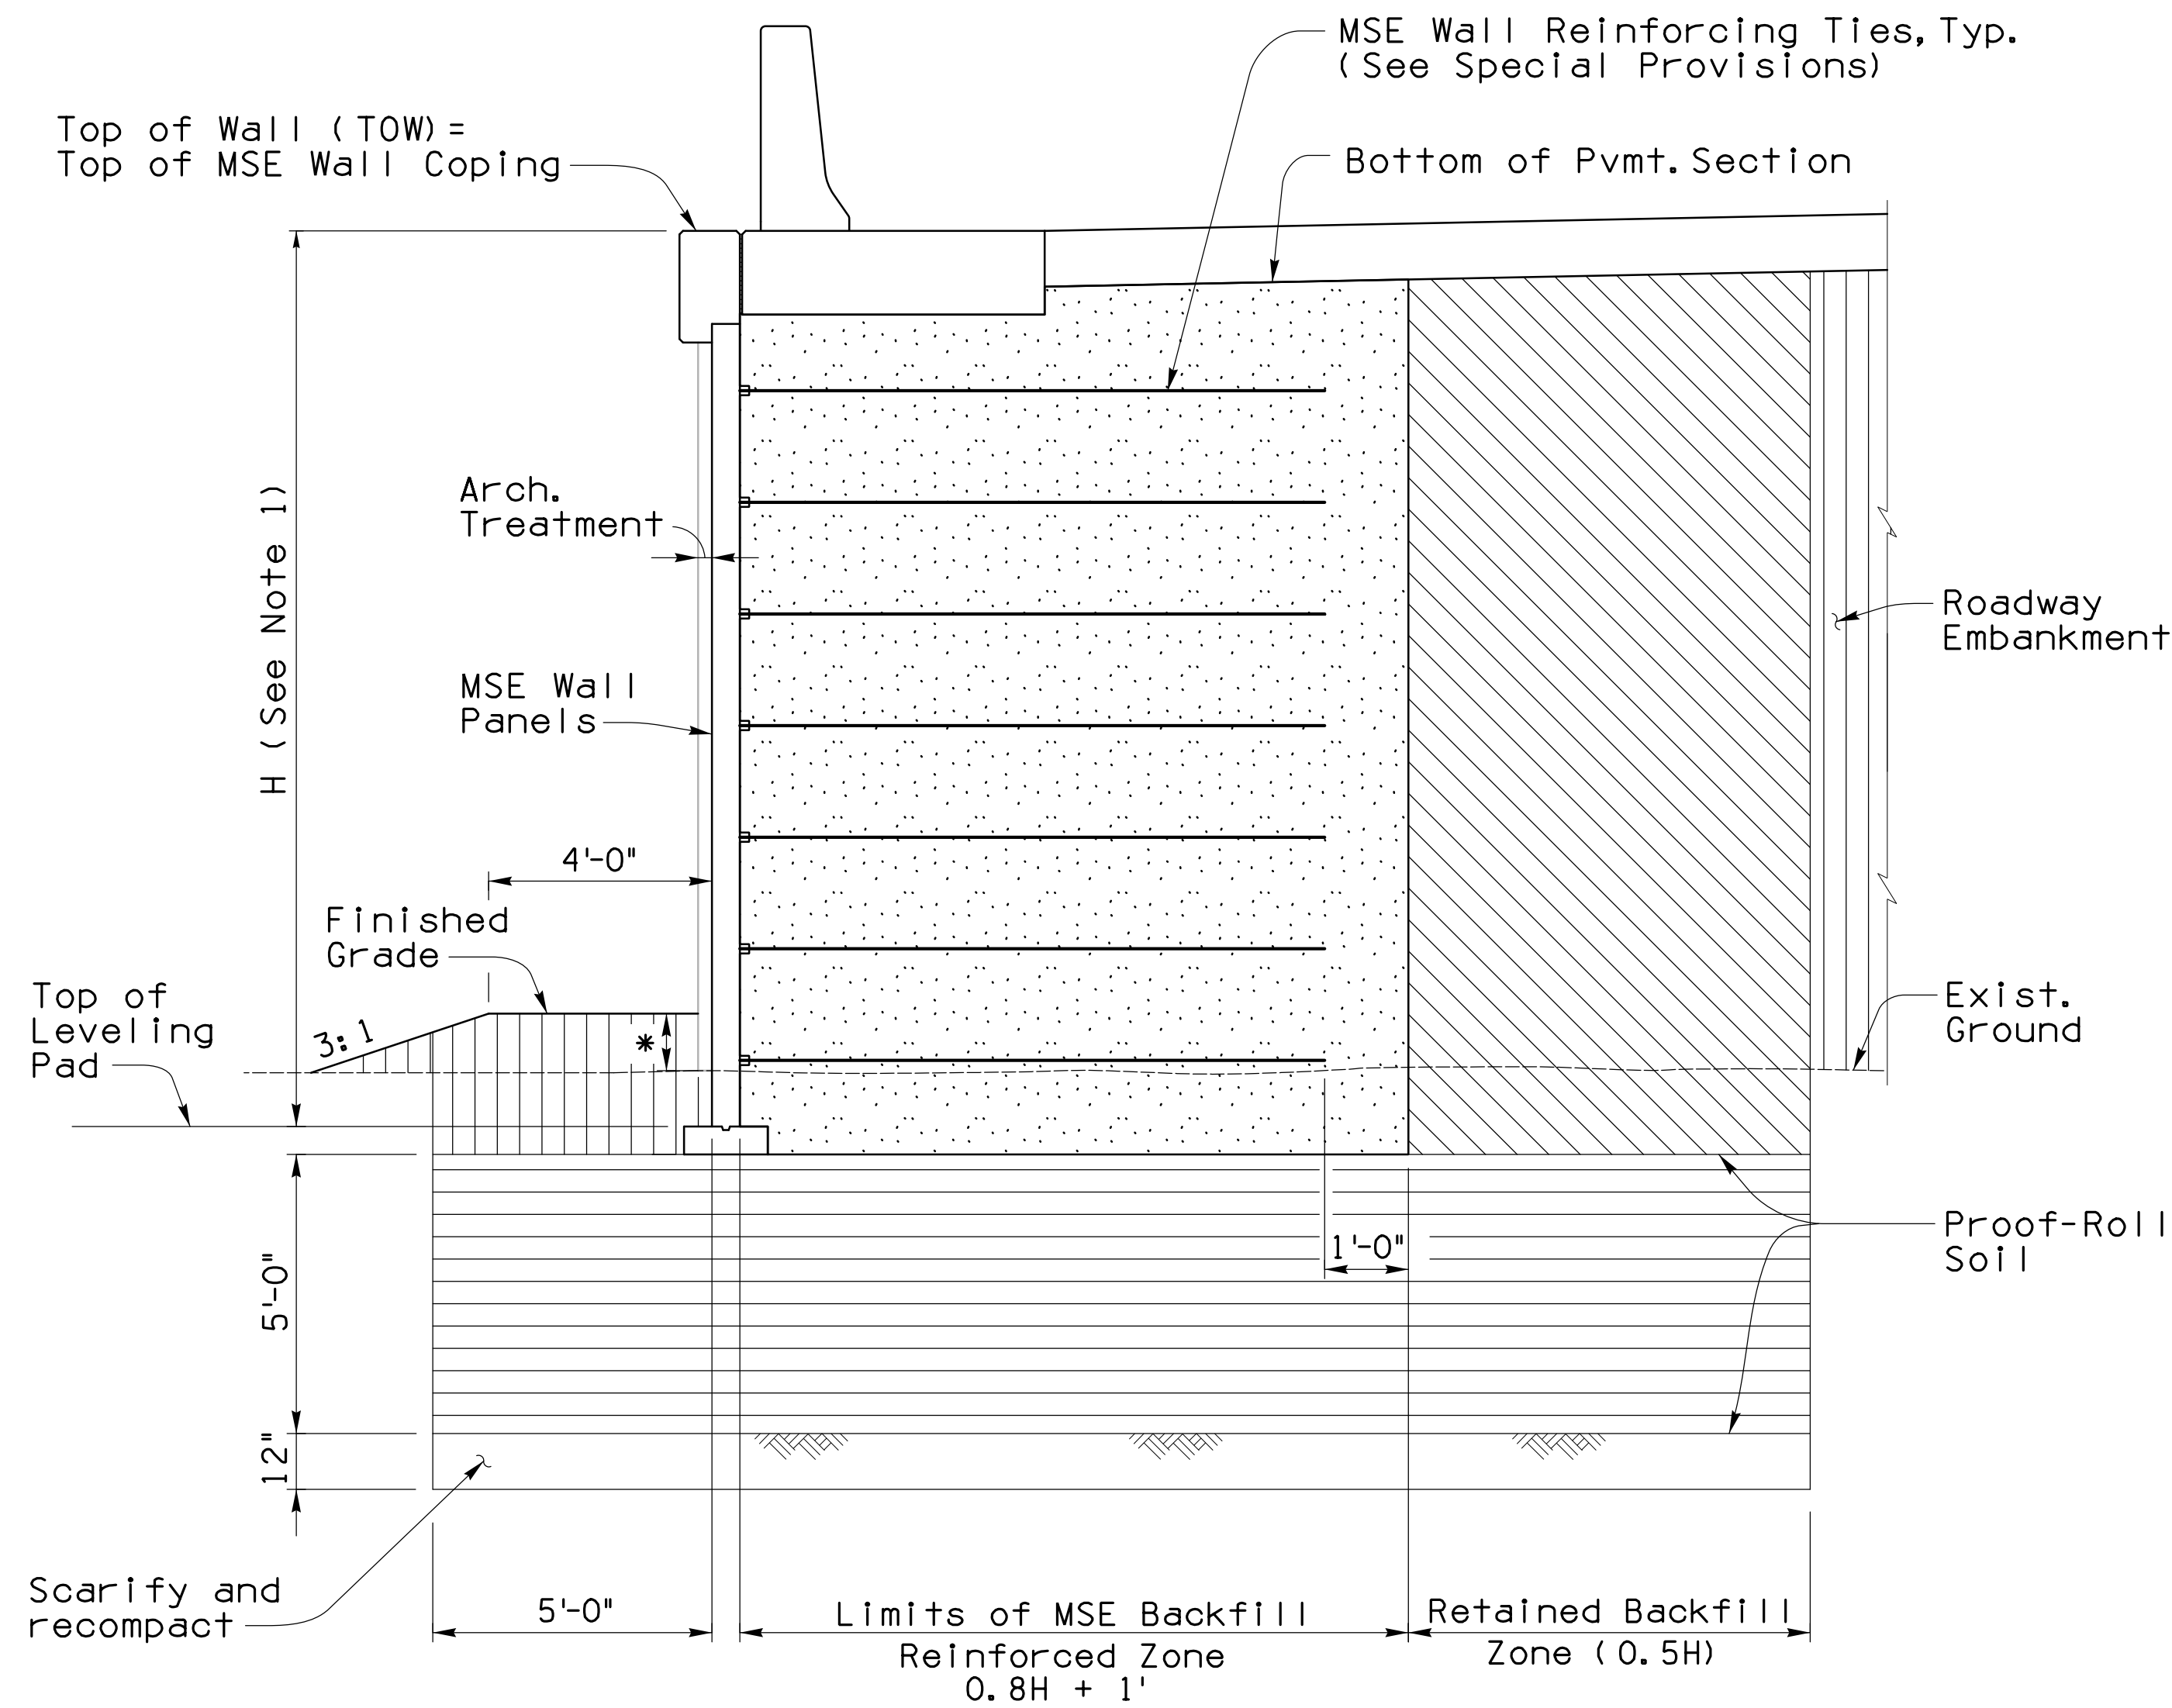

\* Extend Architectural Treatment 1'-0" min. below Finish Grade


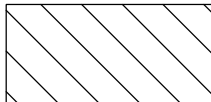
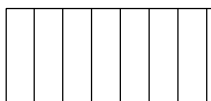
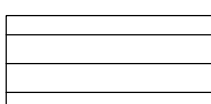
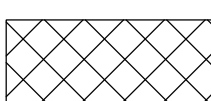
MSE WALL SECTION IN CUT  
No Scale

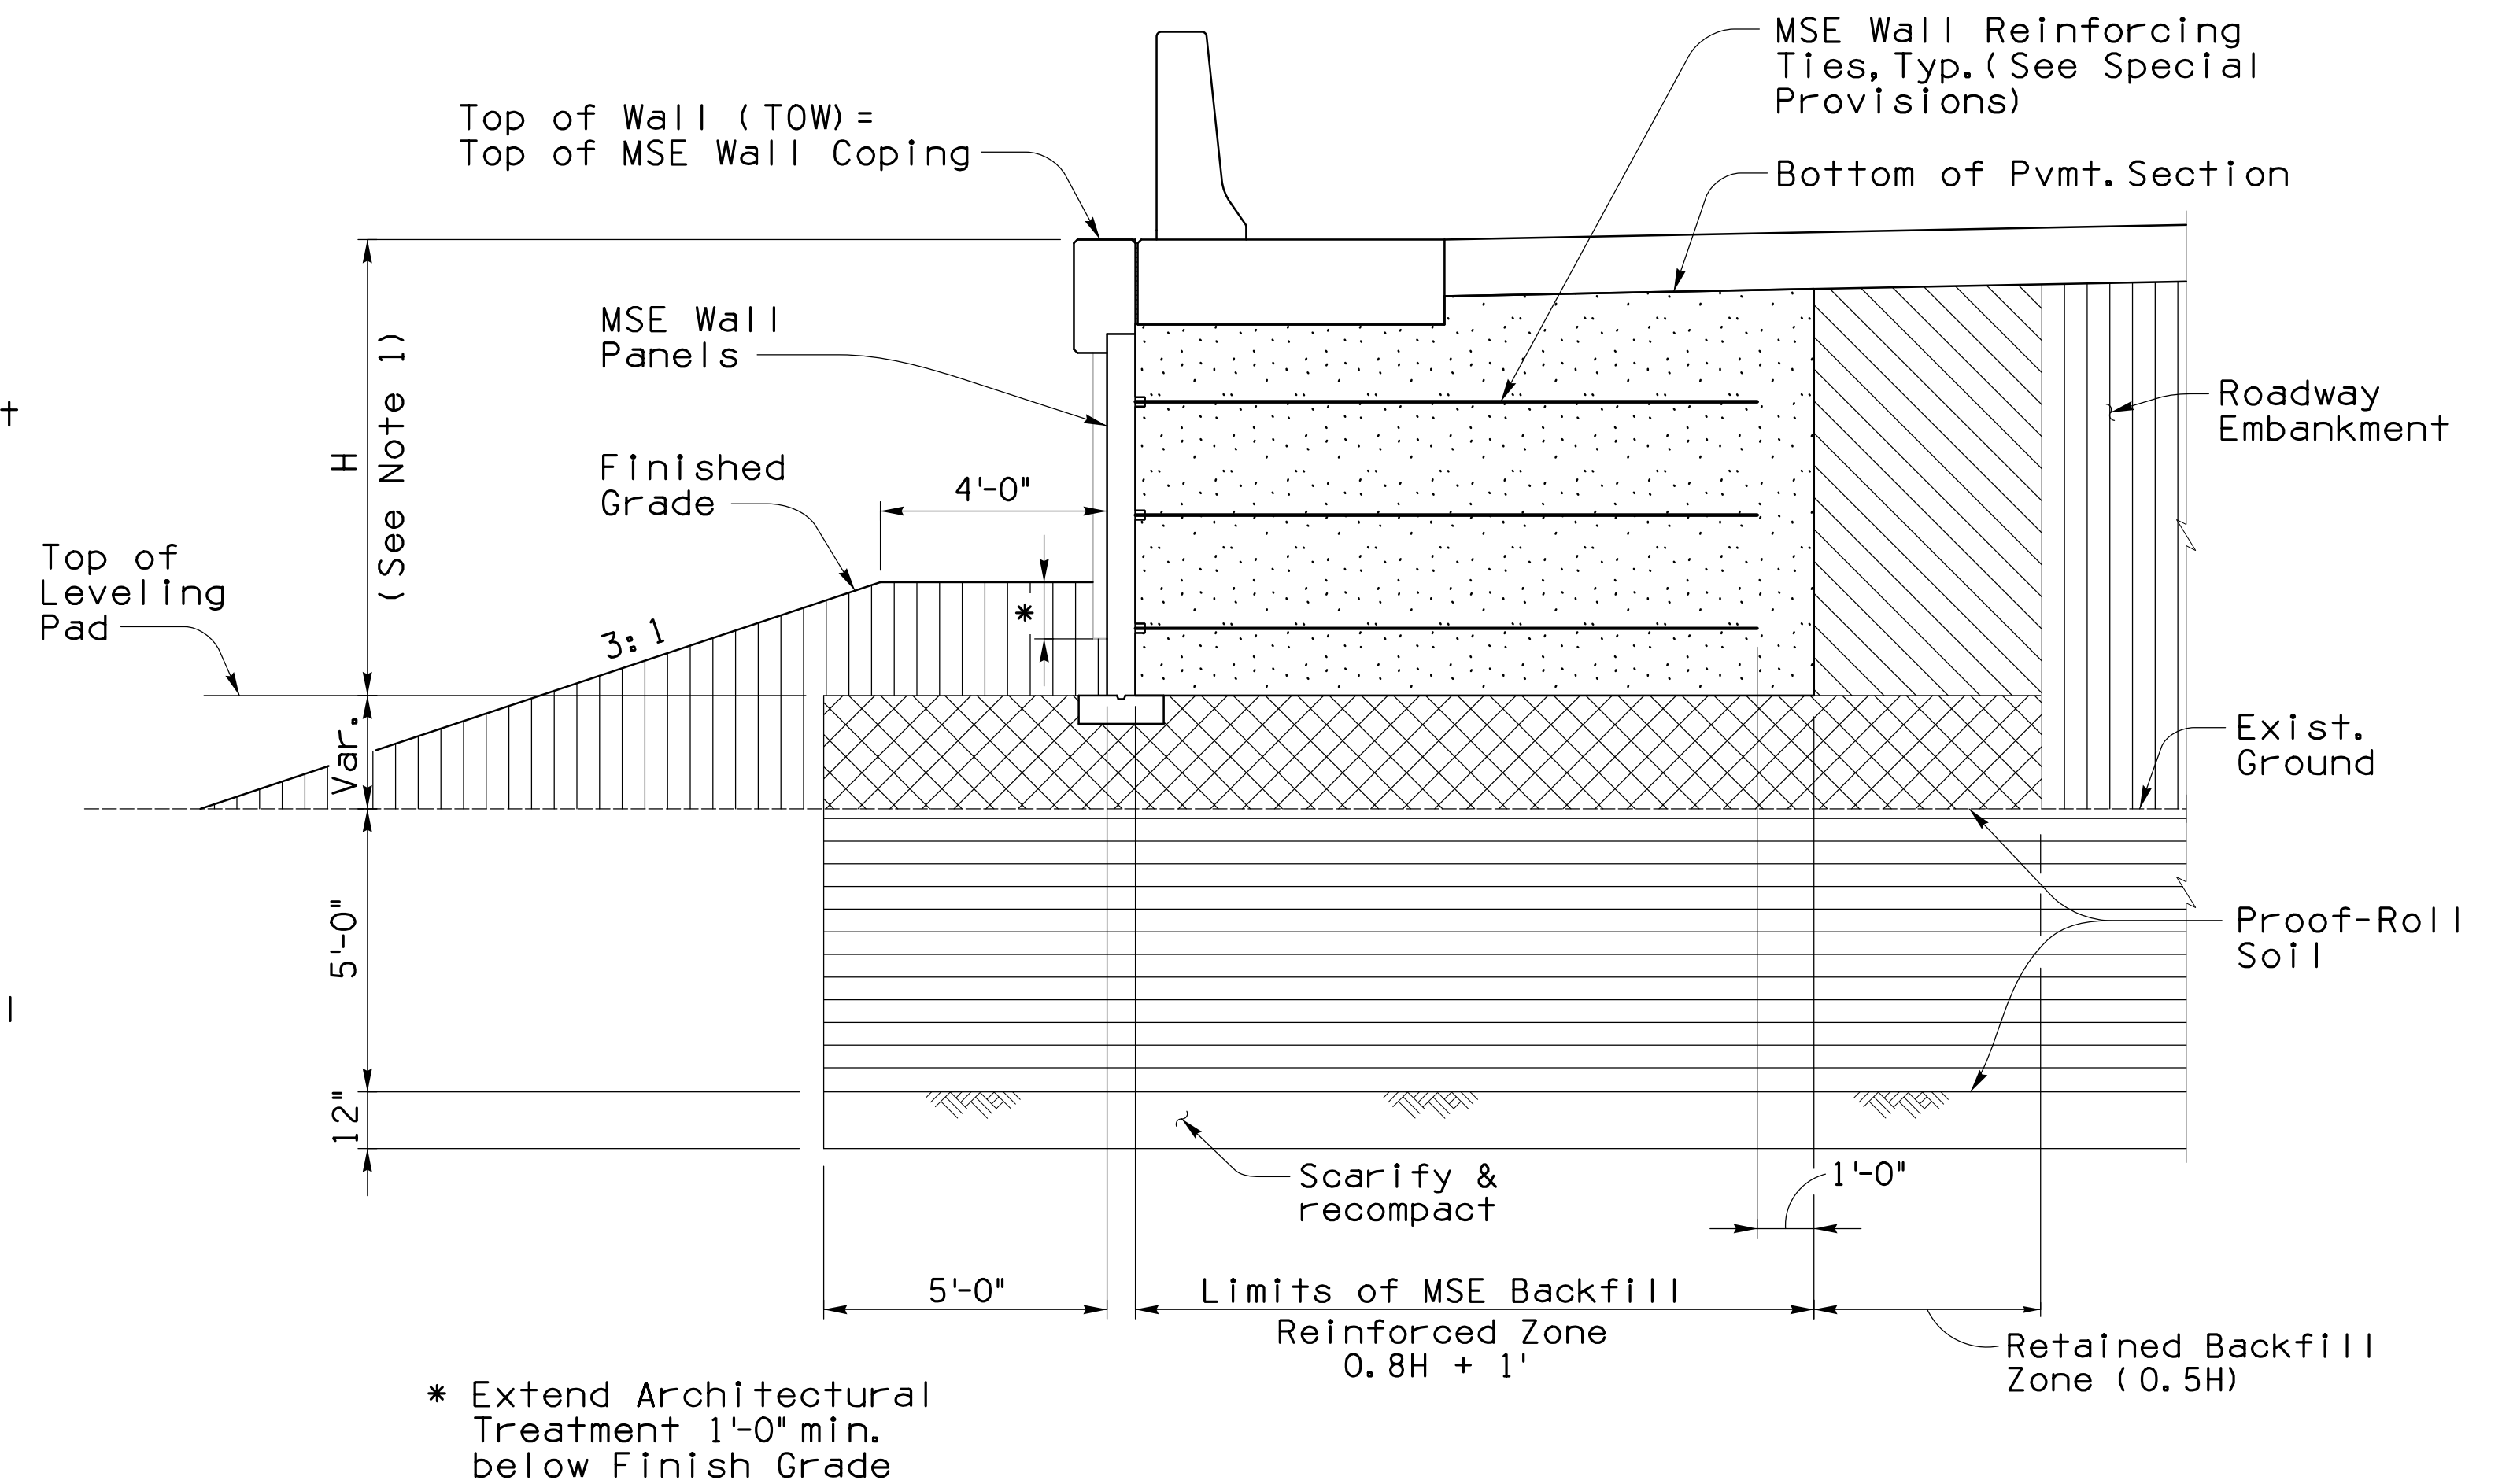

\* Extend Architectural Treatment 1'-0" min. below Finish Grade

MSE WALL SECTION IN FILL  
No Scale


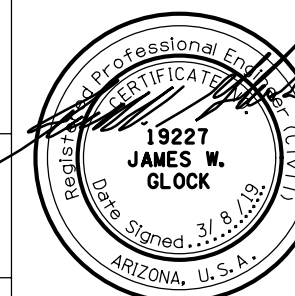
LEGEND:

-  Reinforced Backfill
-  Retained Backfill
-  Roadway Embankment
-  Overexcavation & Recompaction
-  Special Foundation Backfill

Notes:

- H = Wall height measured from top of coping beam to top of concrete leveling pad.
- Roadway embankment and Special Foundation Backfill shall be constructed to top of leveling pad prior to construction of leveling pad.
- Roadway embankment shall be constructed to finished grade at front face of wall before MSE wall is constructed to 0.5H.




DESIGN	NAME	DATE	ARIZONA DEPARTMENT OF TRANSPORTATION INTERMODAL TRANSPORTATION DIVISION ROADWAY DESIGN SERVICES
DRAWN	JAM, JWG	03-19	
CHECKED	JHS, MJL	03-19	
			<b>RETAINING WALL DETAILS (3 OF 6)</b>
ROUTE	LOCATION		
I-10	RUTHRAUFF ROAD TI		
TRACS NO. H 8480 01C		010-D(213)S	DWG NO. S-7.28




F.H.W.A. REGION	STATE	PROJECT NO.	SHEET NO.	TOTAL SHEETS	AS BUILT
9	ARIZ.	010-D(213)S	731	849	

010 PM 252

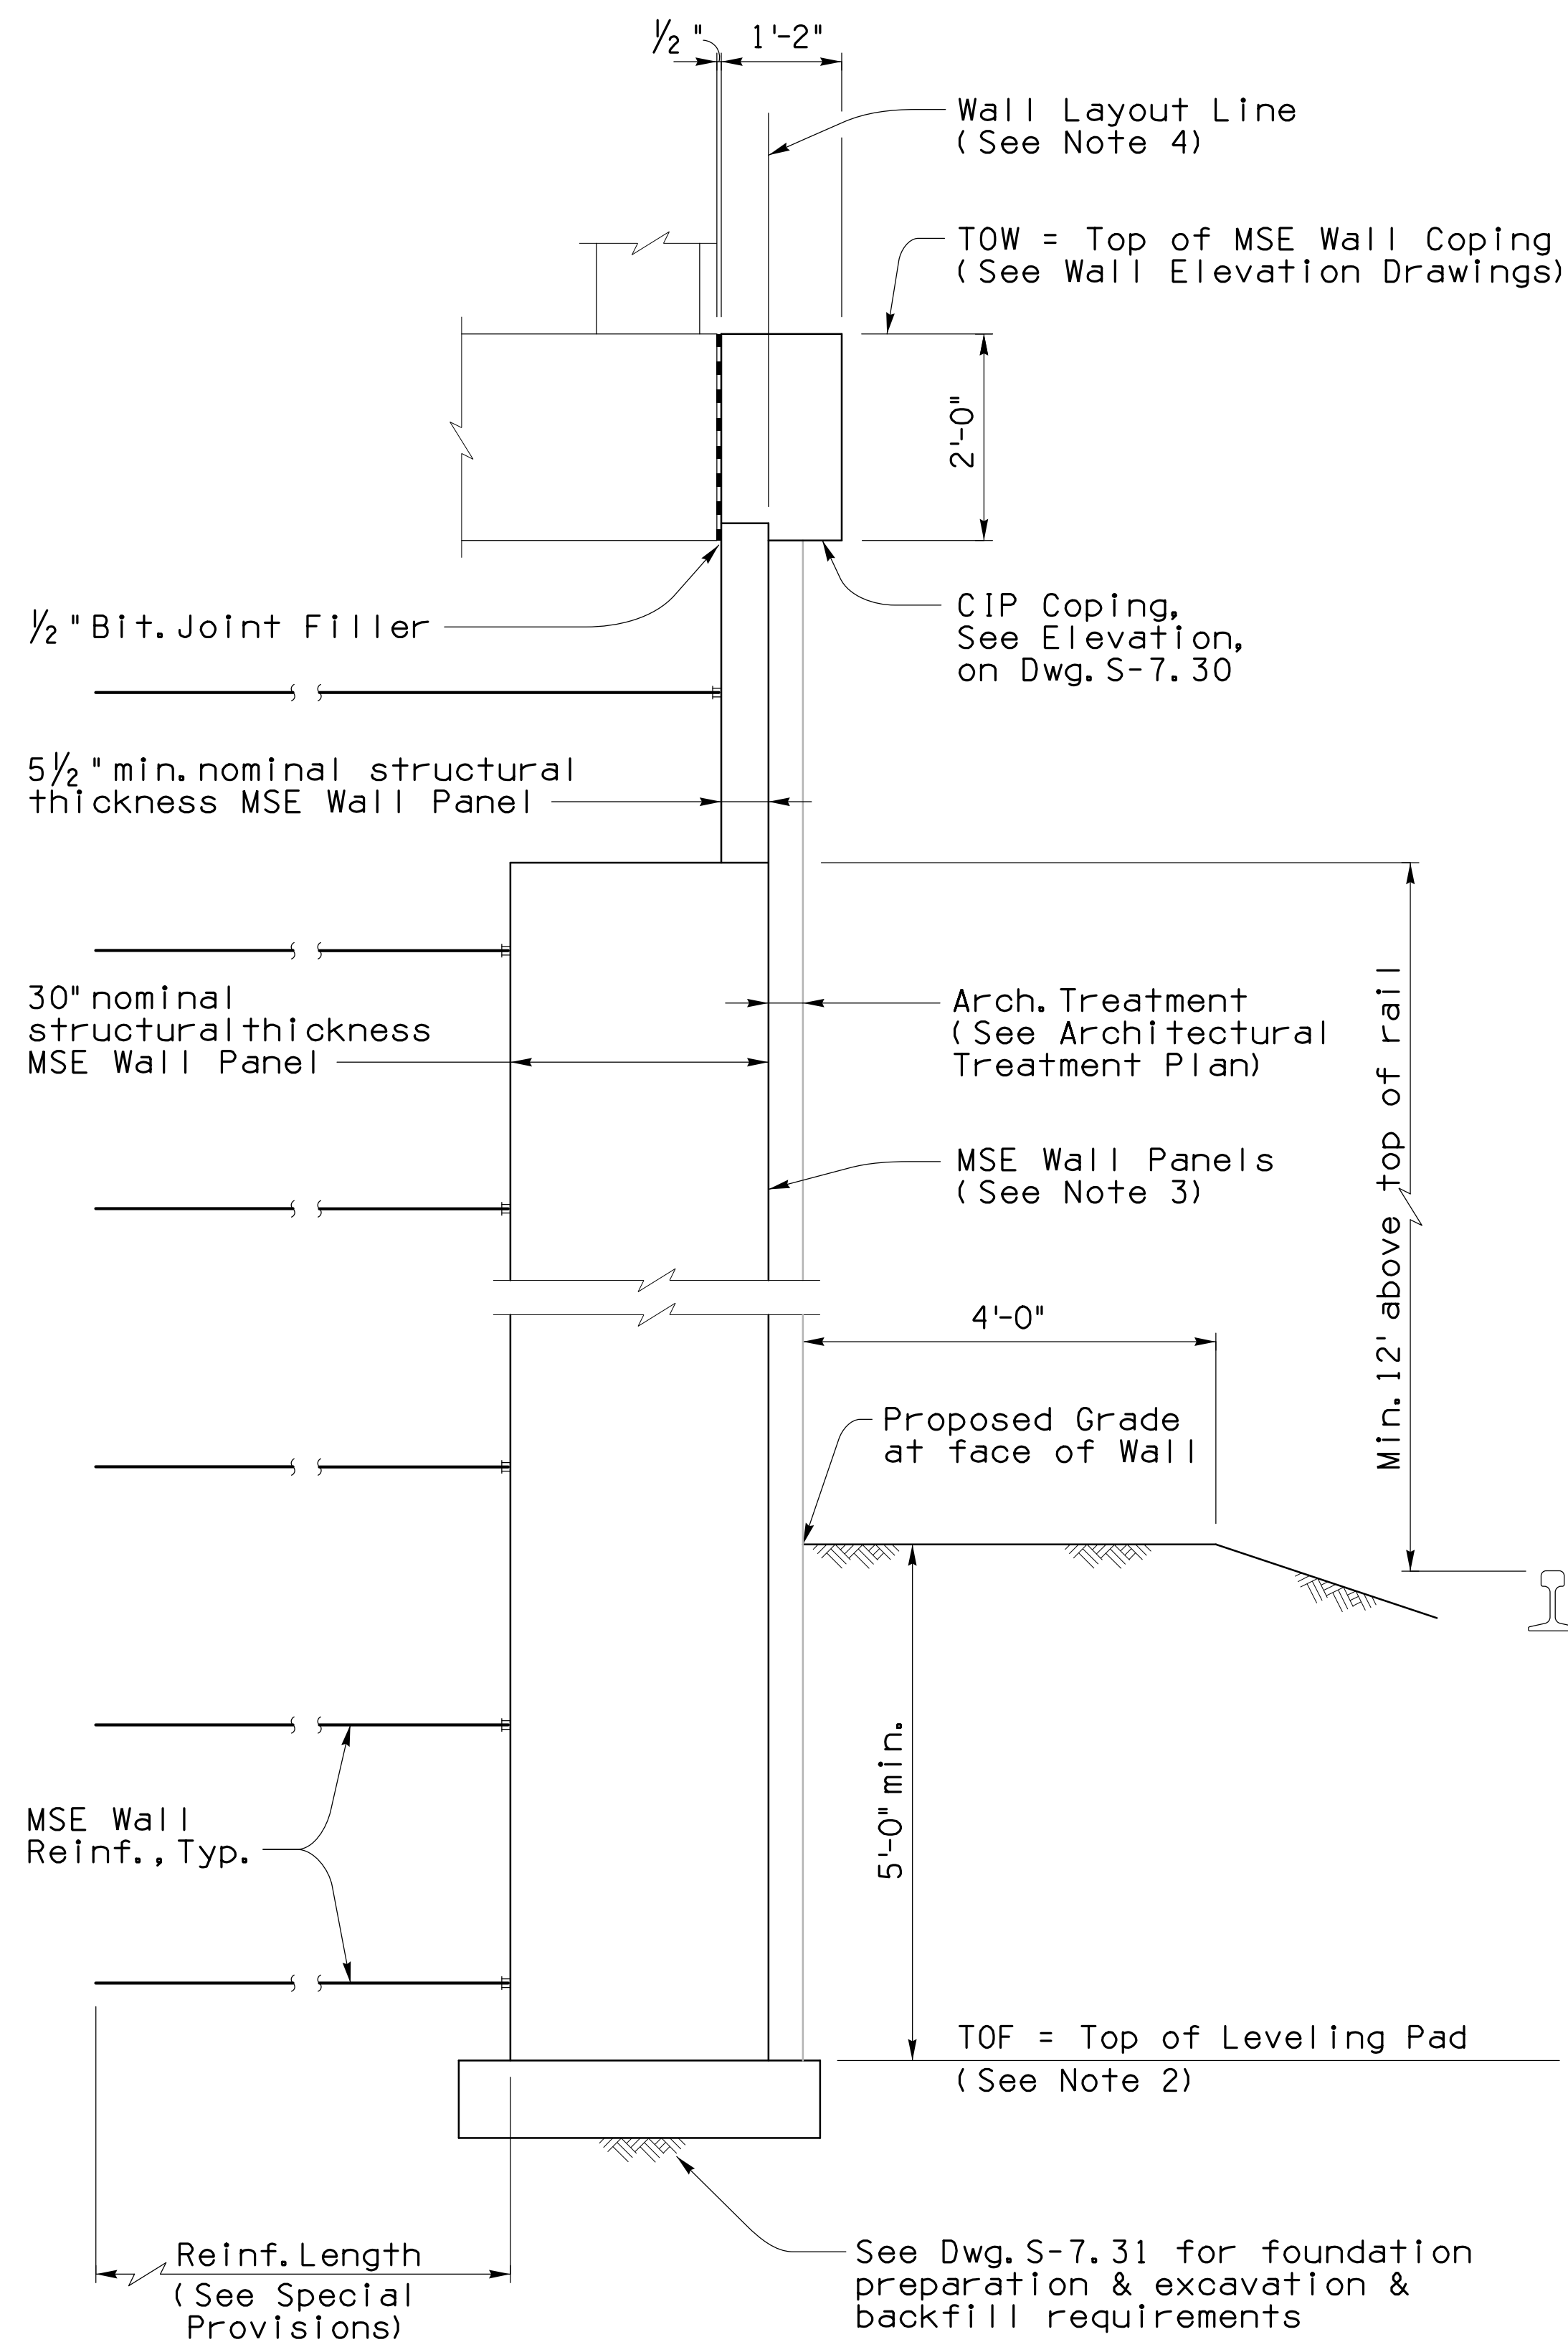

MSE RETAINING WALL (30")  
TYPICAL SECTION  
3/4" = 1'-0"

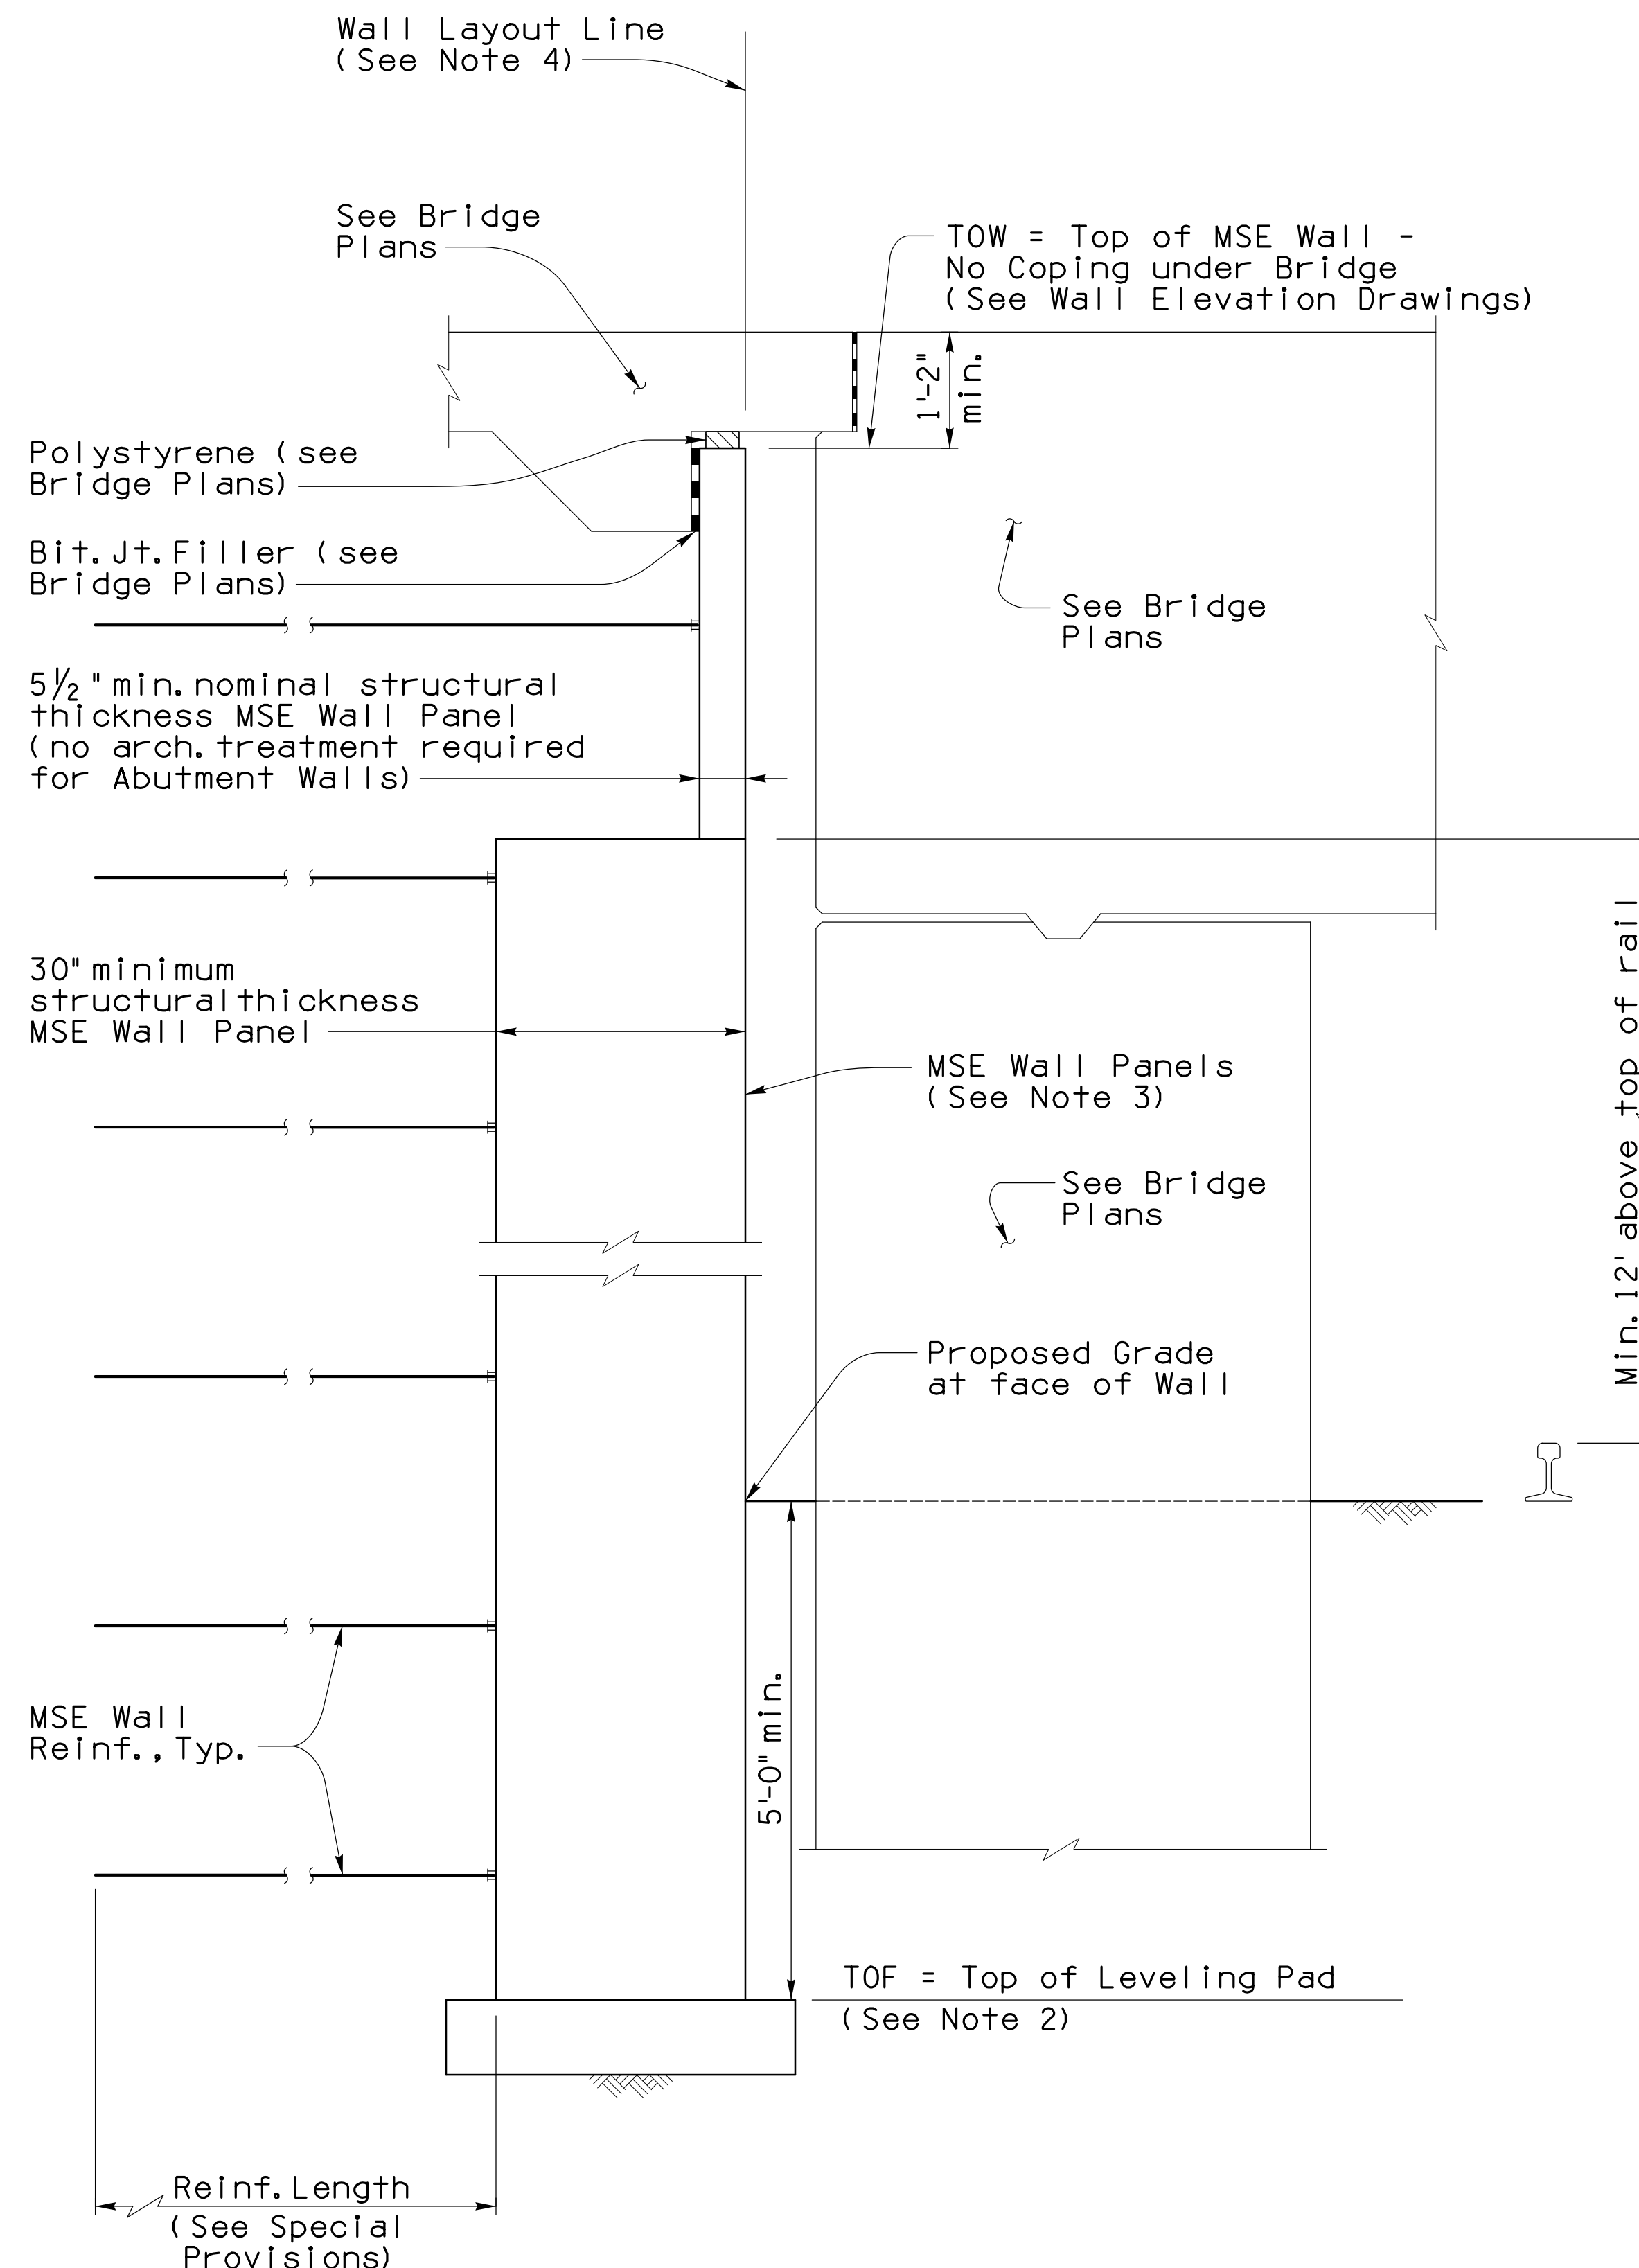

MSE RETAINING WALL (30") -  
AT UPRR BRIDGE ABUTMENT  
3/4" = 1'-0"

**Notes:**


1. The MSE wall Manufacturer is responsible for designing the MSE walls to accommodate obstructions located within the reinforced backfill zone. These obstructions include catch basins, pole foundations and other items as shown on the project plans.
2. See Wall Elevation Plans for top of leveling pad elevations. The leveling pad size shall be determined by the MSE wall Manufacturer's requirements (6" deep x 3' wide minimum) for 30" minimum structural thickness MSE wall panels.
3. MSE wall panels shall be 5' wide x 5' tall, nominal.
4. Wall layout line is based on an assumed minimum nominal structure MSE wall panel thickness excluding rustication as shown.
5. 30" thick MSE panels required on walls WB-3, RR-3 and RR-4. Panels shall extend to at least 12' above the top of adjacent rail. Where top of wall is less than 12' above top of rail, 30" panel shall extend to the bottom of barrier footing. 30" panel and bottom of footing shall be separated by bond breaker as approved by the Engineer.




DESIGN	NAME	DATE	ARIZONA DEPARTMENT OF TRANSPORTATION INTERMODAL TRANSPORTATION DIVISION ROADWAY DESIGN SERVICES
DRAWN	JAM, JWG	03-19	
CHECKED	JHS, MJL	03-19	
			<b>RETAINING WALL DETAILS (4 OF 6)</b>
ROUTE	LOCATION		
I-10	RUTHRAUFF ROAD TI		
TRACS NO. H 8480 01C		010-D(213)S	DWG NO. S-7.29

F.H.W.A. REGION	STATE	PROJECT NO.	SHEET NO.	TOTAL SHEETS	AS BUILT
9	ARIZ.	010-D(213)S	732	849	

010 PM 252

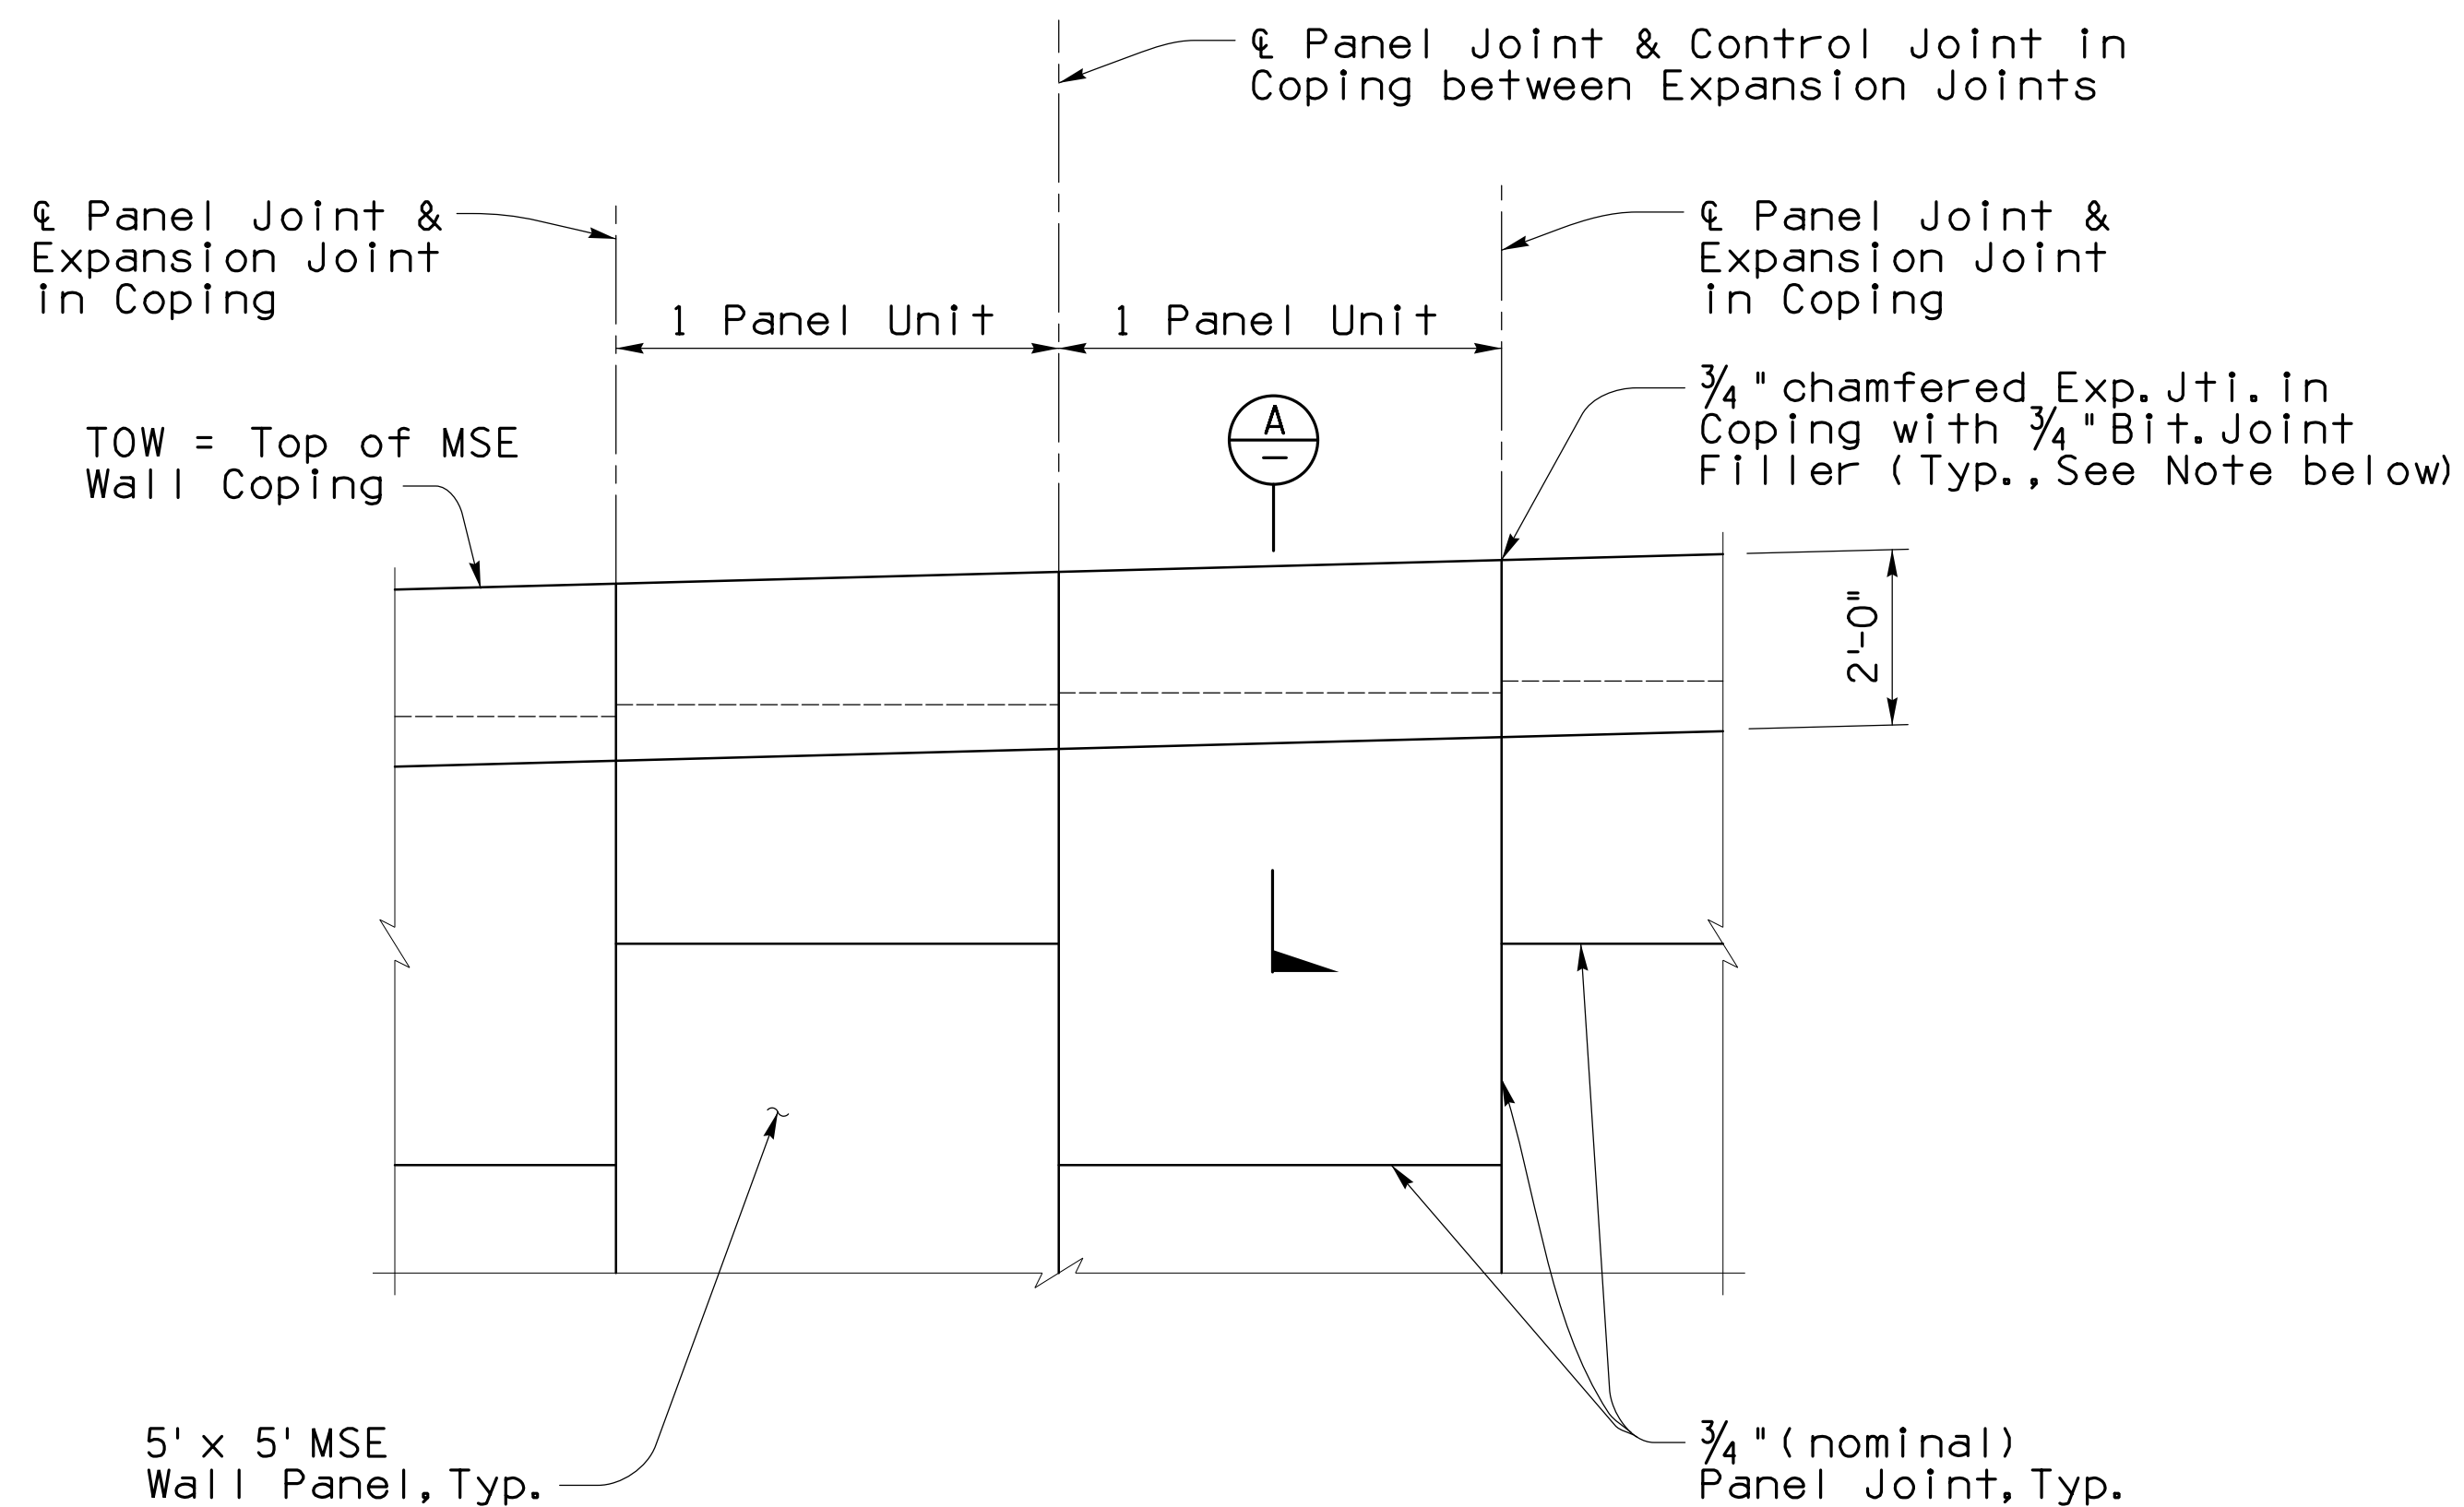

**Note:**  
Coping longitudinal reinforcement shall be cut 2" clear of each side of the expansion joints.

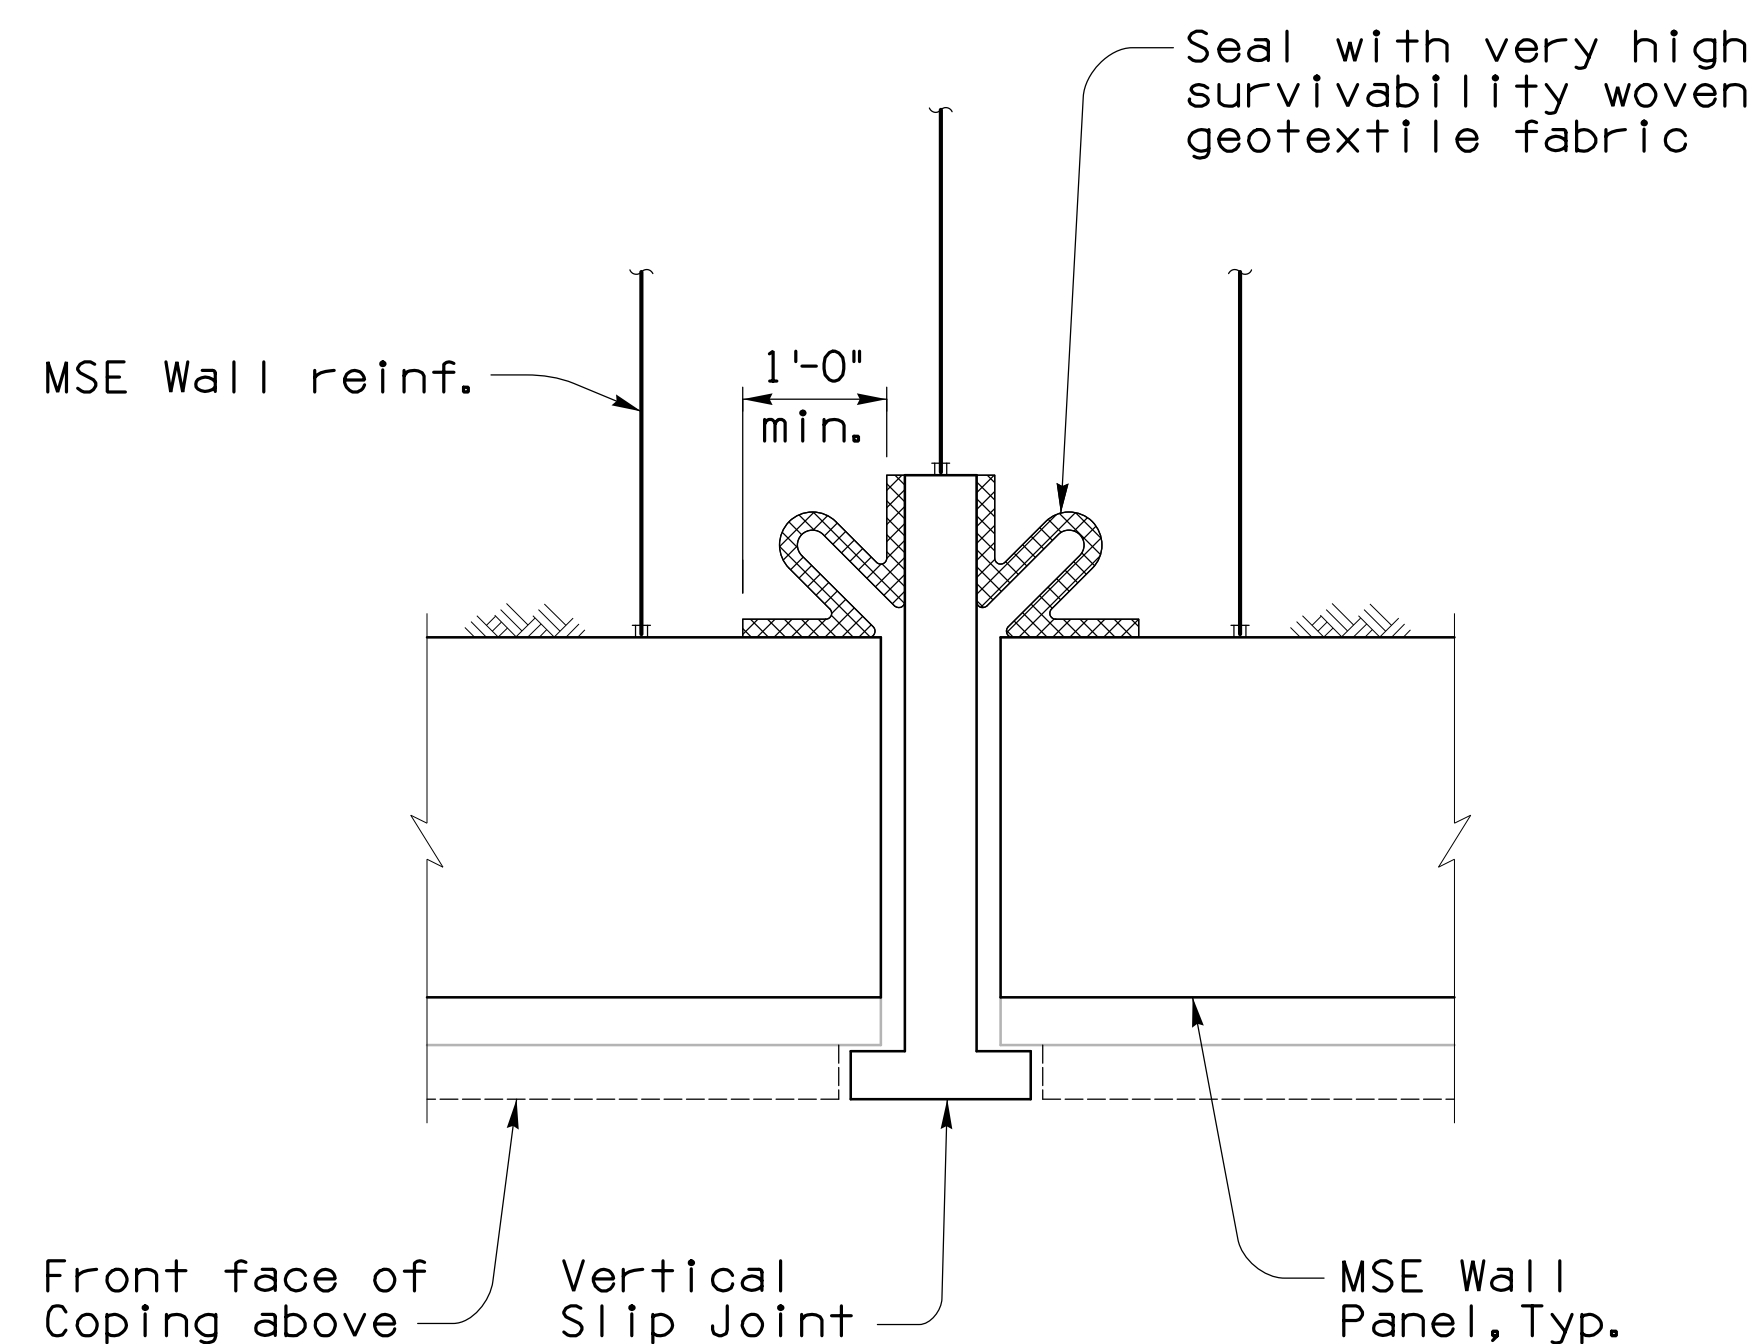


**Notes:**


1. See wall plans for approximate slip joint locations (90' max. except as shown).
2. Slip joints shall be placed on either side of drilled shafts that encroach underneath leveling pad of MSE panels.

**VERTICAL SLIP JOINT (SJ) DETAIL FOR 30" PANELS**  
3/4" = 1'-0"

**ELEVATION**  
1/2" = 1'-0"

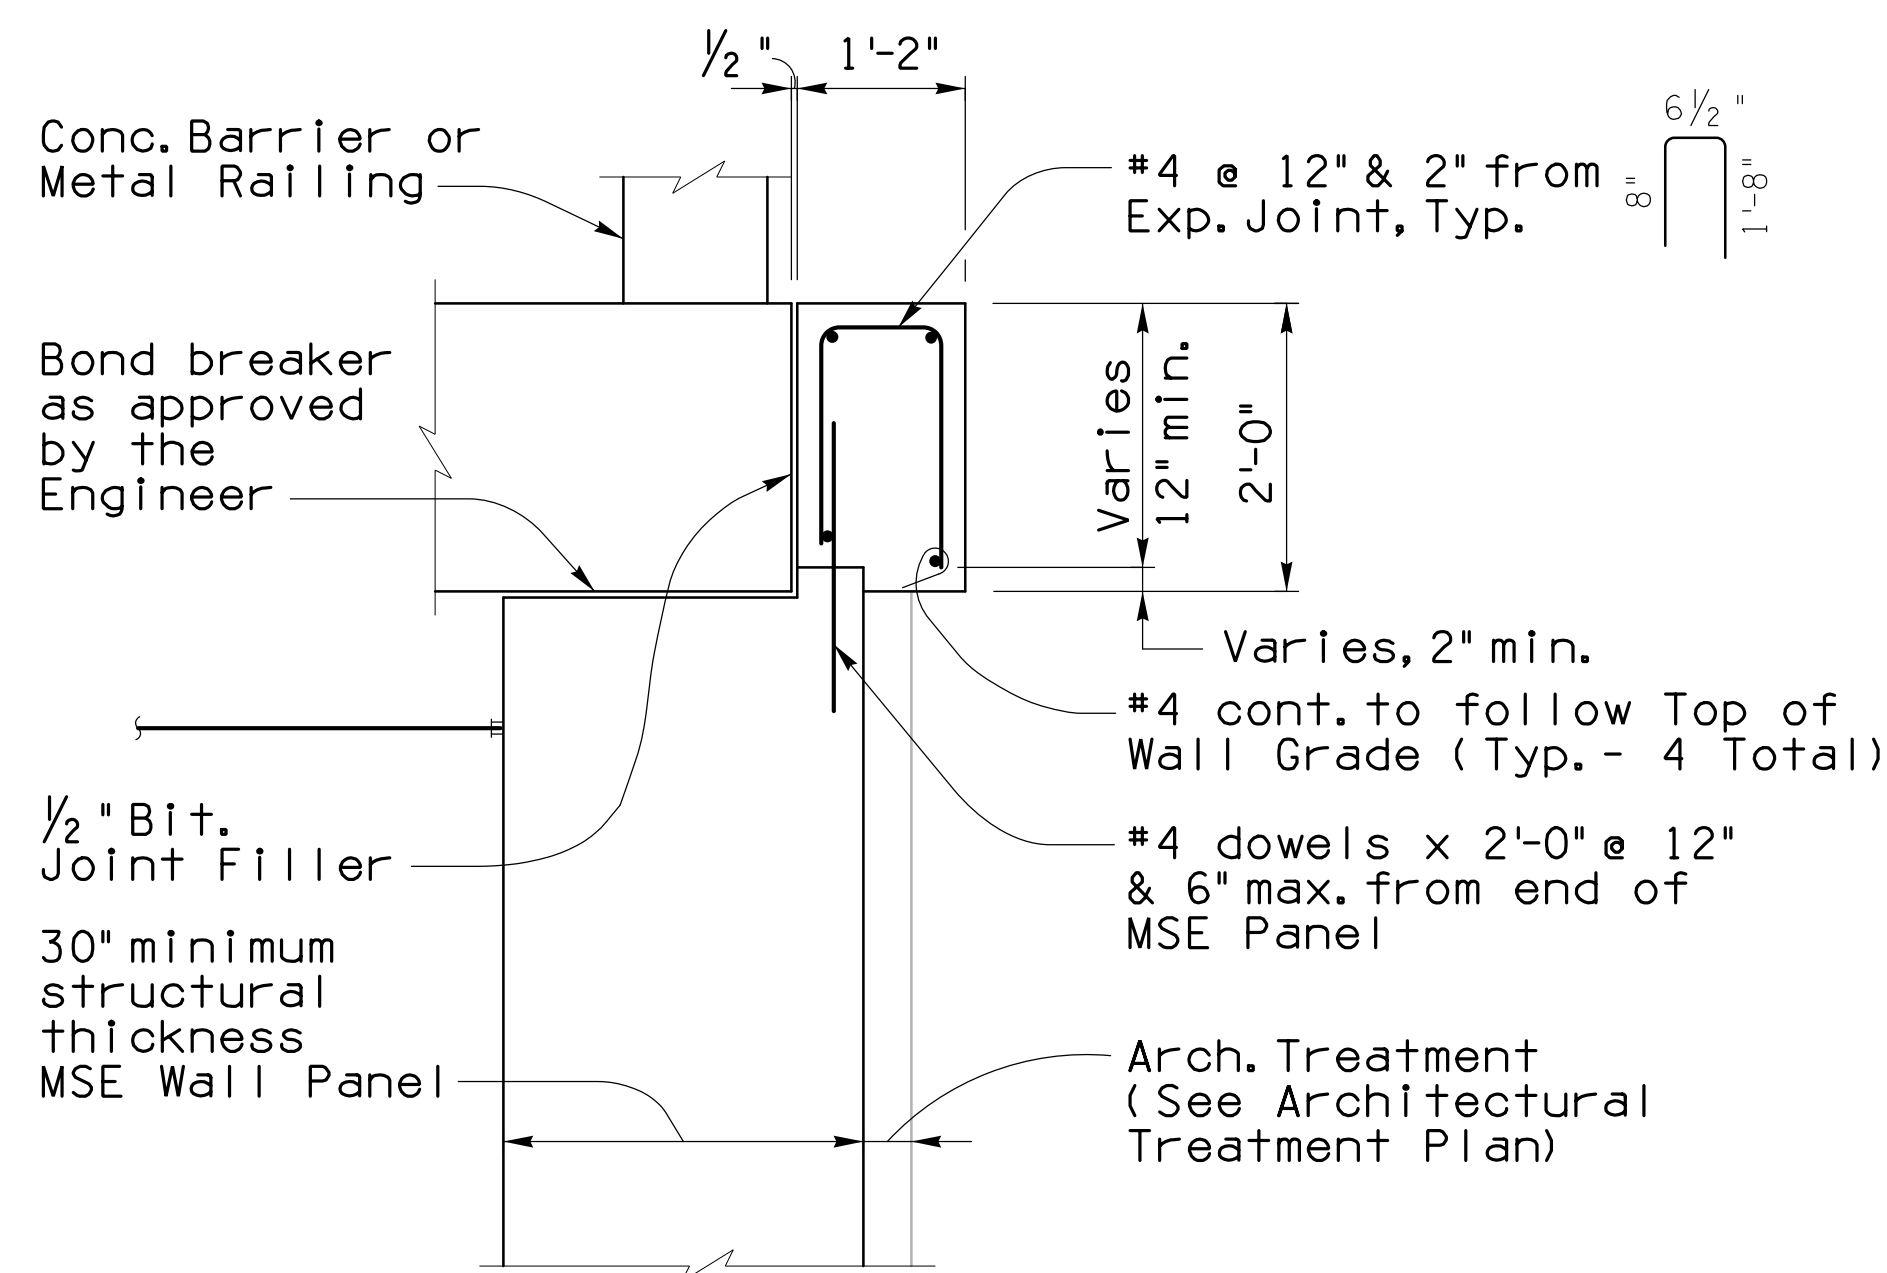

**MSE WALL COPING BEAM SECTION FOR 30" PANELS**  
3/4" = 1'-0"

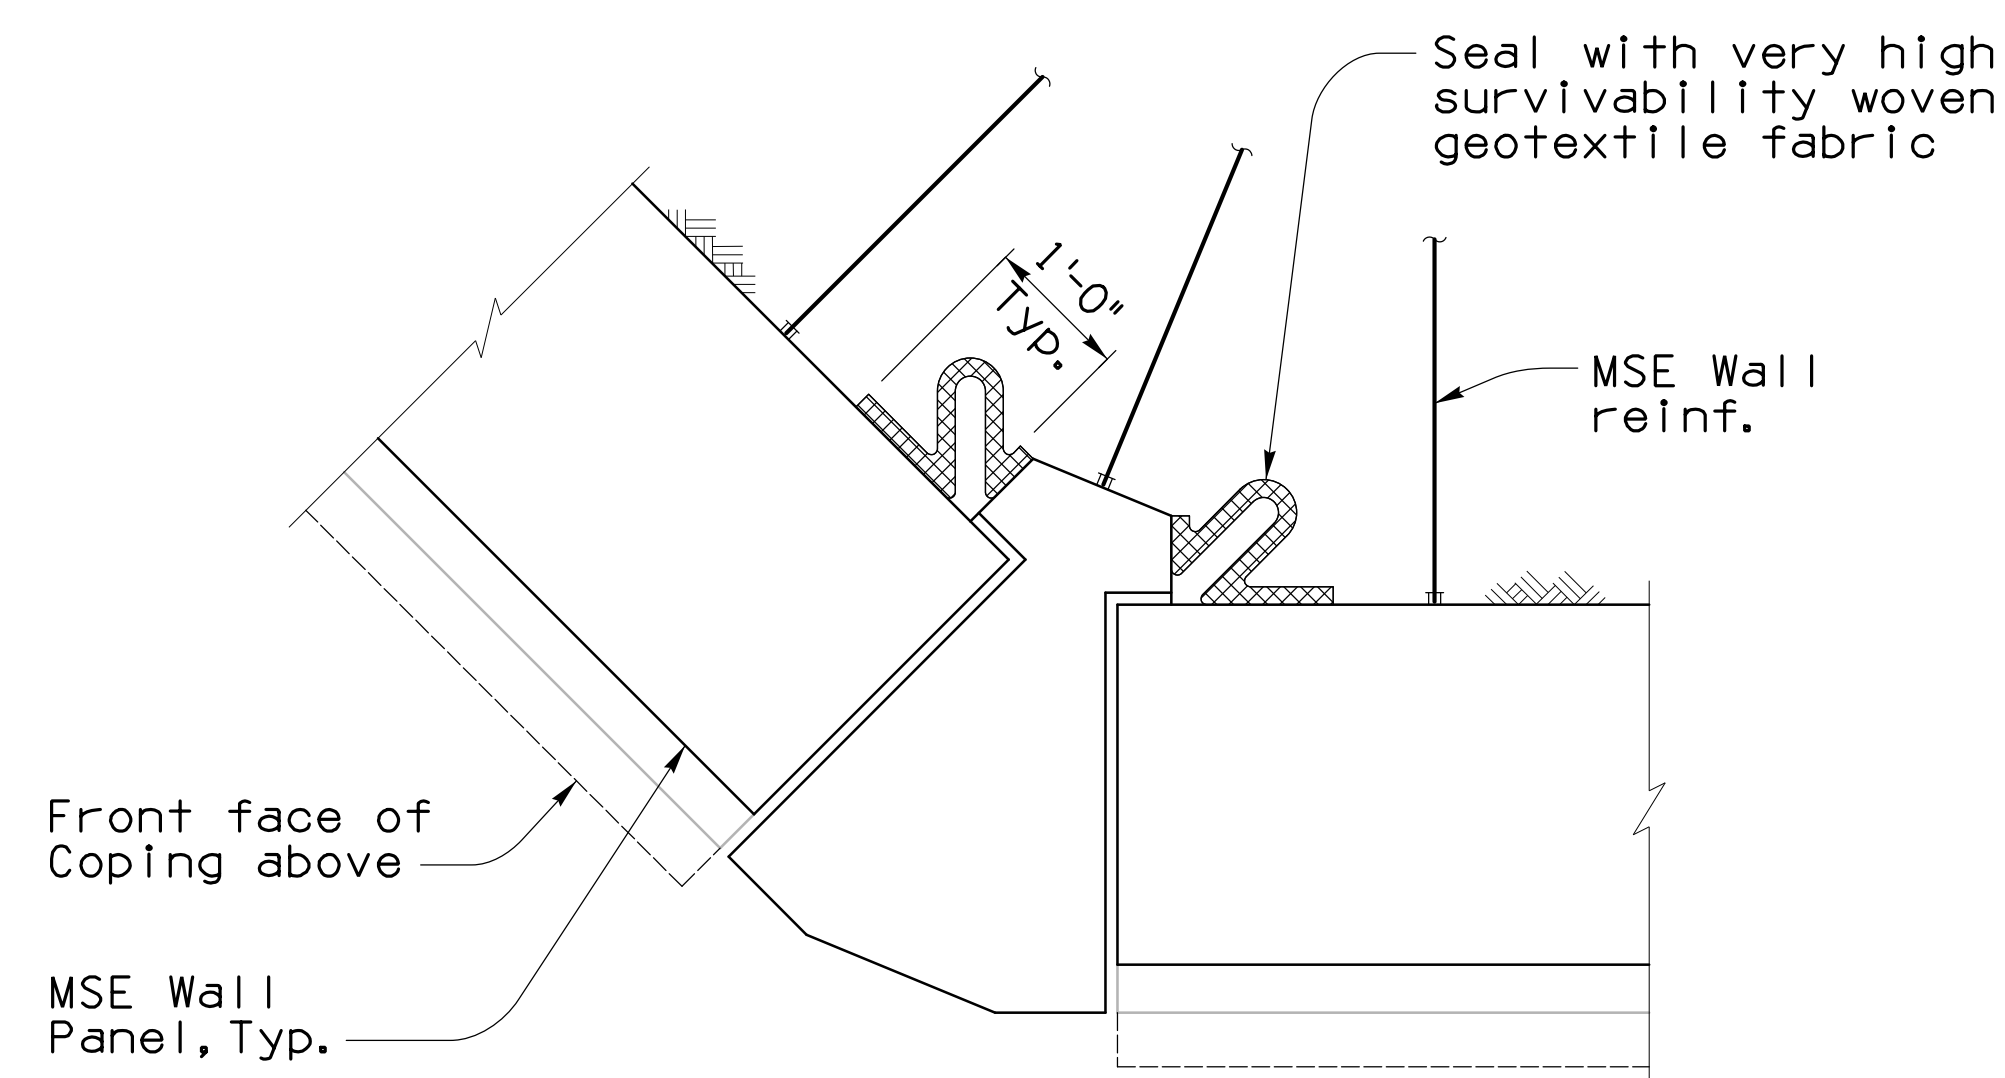


**ANGLE POINT (AP) DETAIL (90° TO 270°) FOR 30" PANELS**  
3/4" = 1'-0"



DESIGN	NAME	DATE	ARIZONA DEPARTMENT OF TRANSPORTATION INTERMODAL TRANSPORTATION DIVISION ROADWAY DESIGN SERVICES
DRAWN	JAM, JWG	03-19	<b>RETAINING WALL DETAILS (5 OF 6)</b>
CHECKED	JHS, MJL	03-19	
	KRH	03-19	
<b>Structural Grace, Inc</b> <small>1430 E. Ft. Lowell, Suite 200 Tucson, Arizona 85719 (520) 320-0156</small>			
ROUTE	LOCATION	RUTHRAUFF ROAD TI	
TRACS NO. H 8480 01C		010-D(213)S	
			DWG NO. S-7.30


F.H.W.A. REGION	STATE	PROJECT NO.	SHEET NO.	TOTAL SHEETS	AS BUILT
9	ARIZ.	010-D(213)S	733	849	

010 PM 252

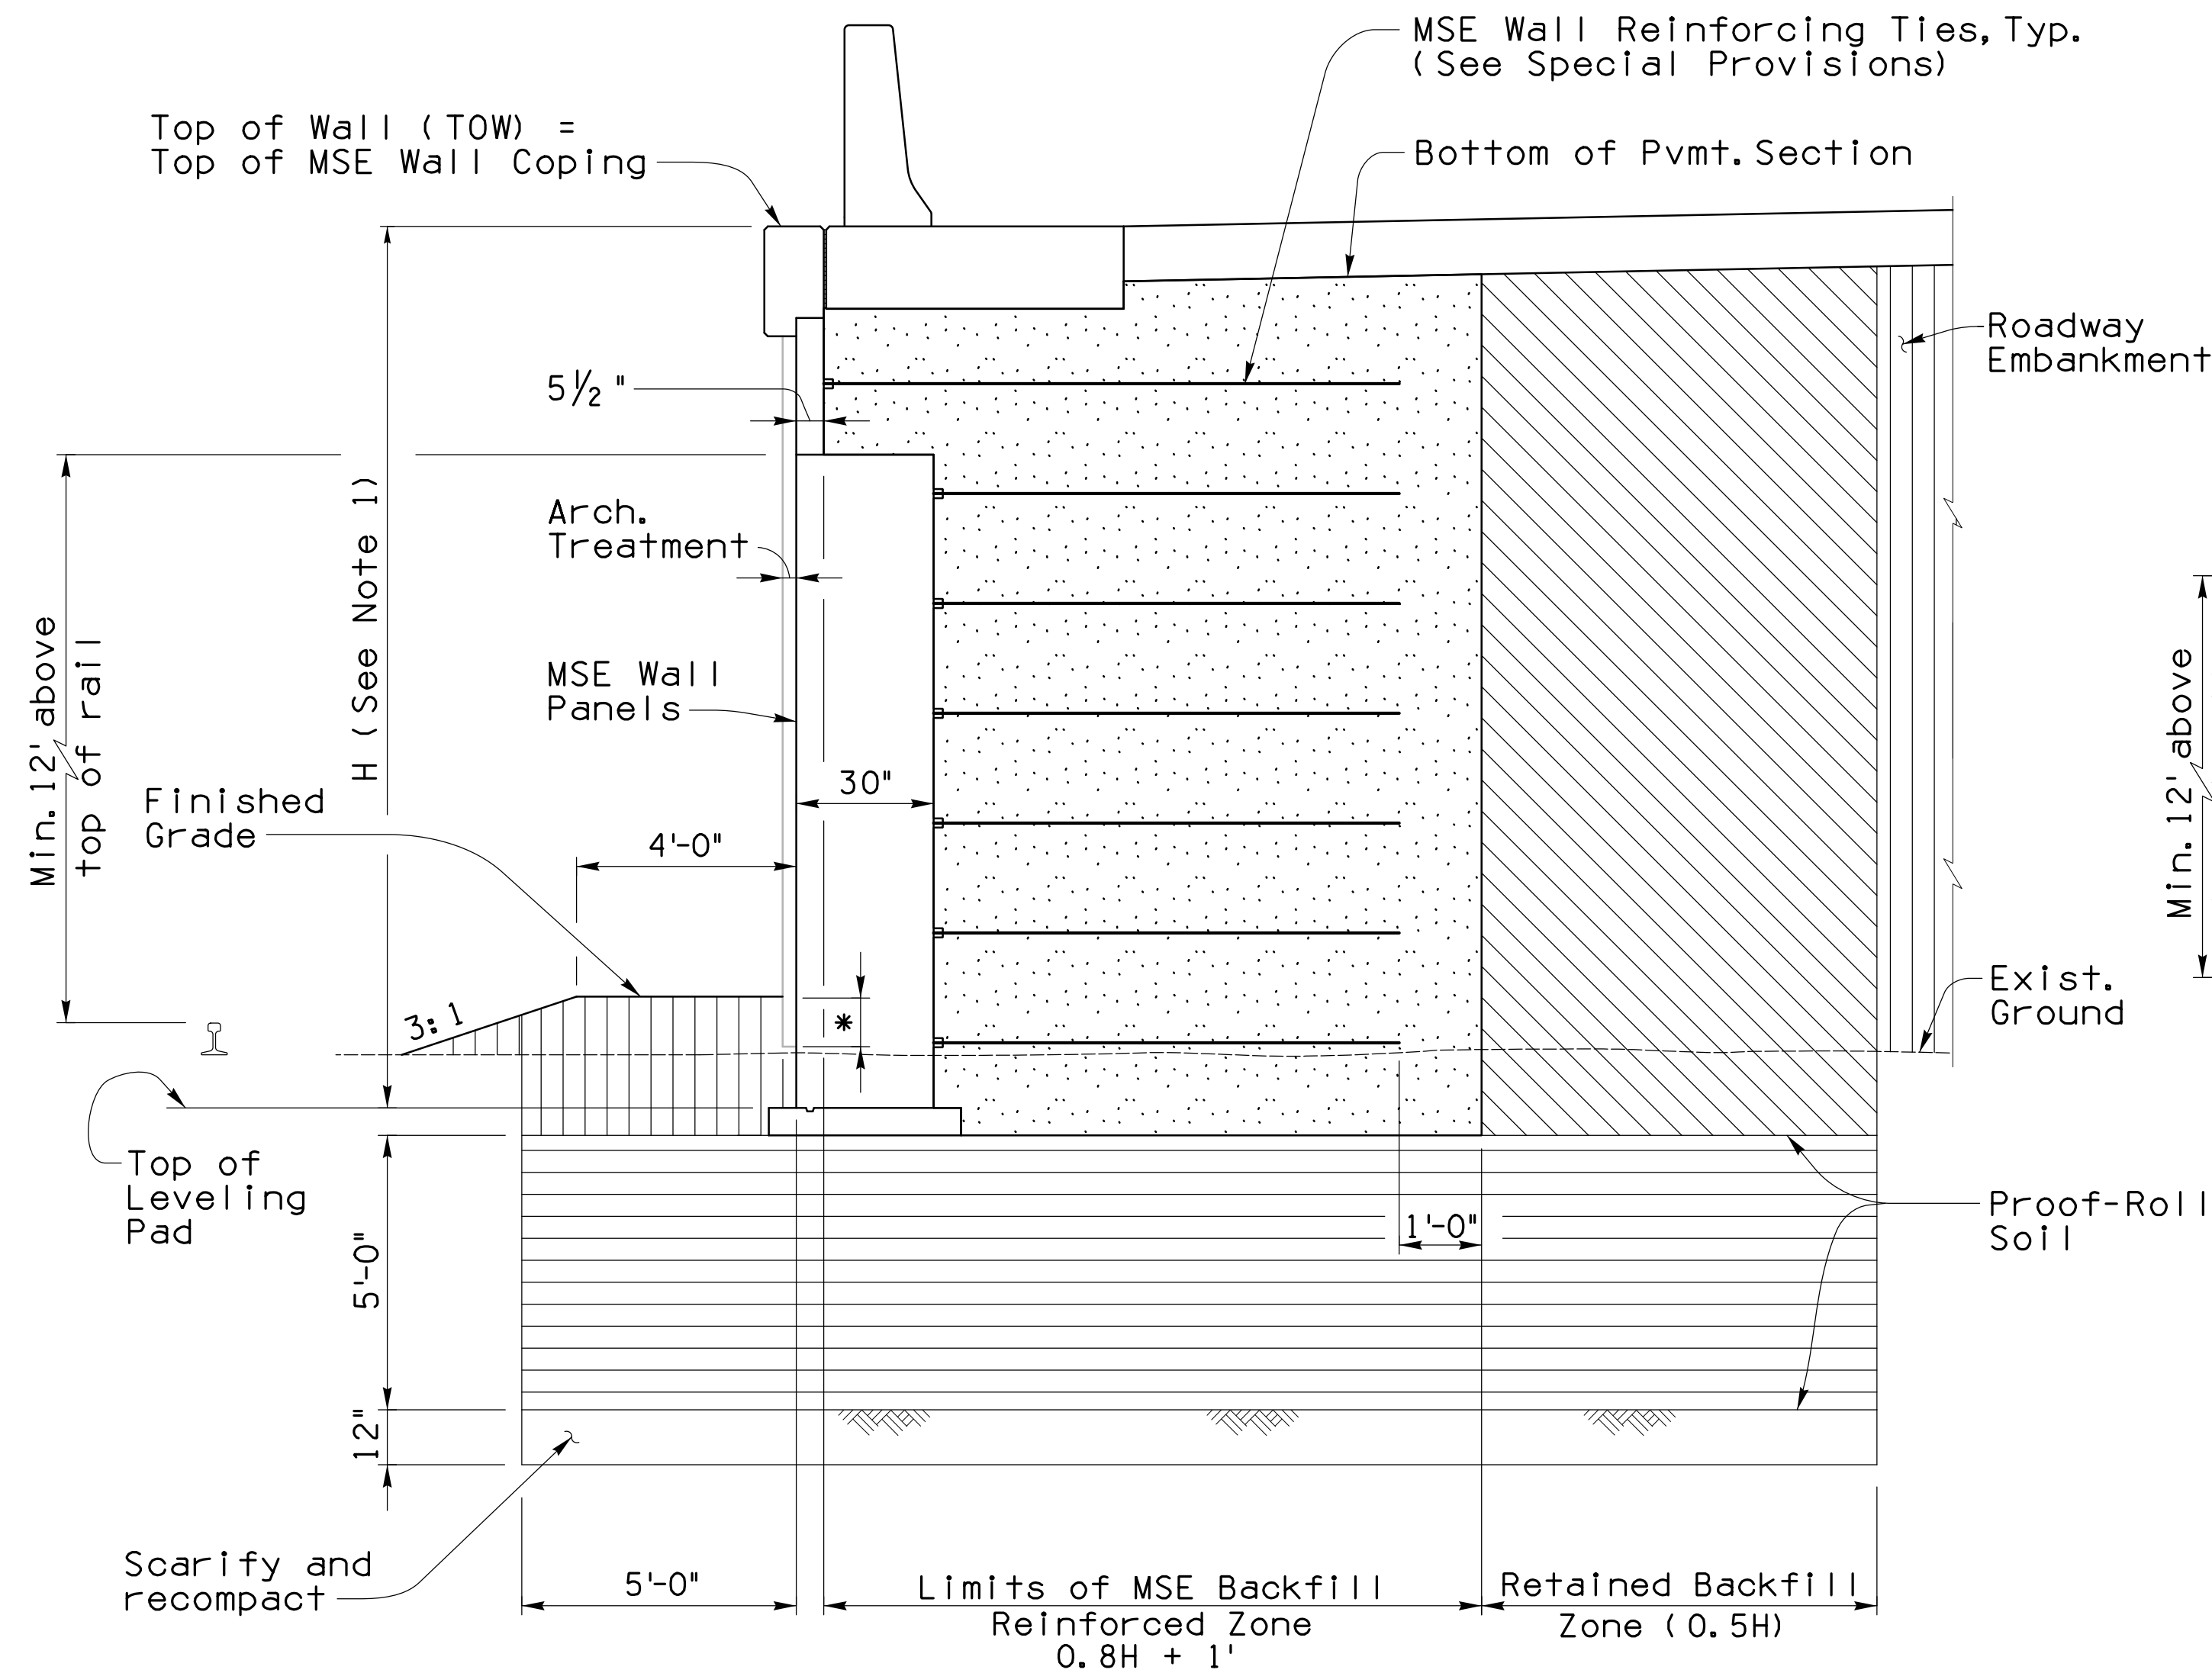

\* Extend Architectural Treatment 1'-0" min. below Finished Grade


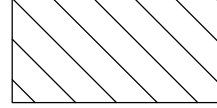

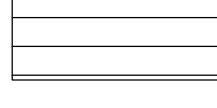

MSE WALL SECTION IN CUT (30")  
No Scale

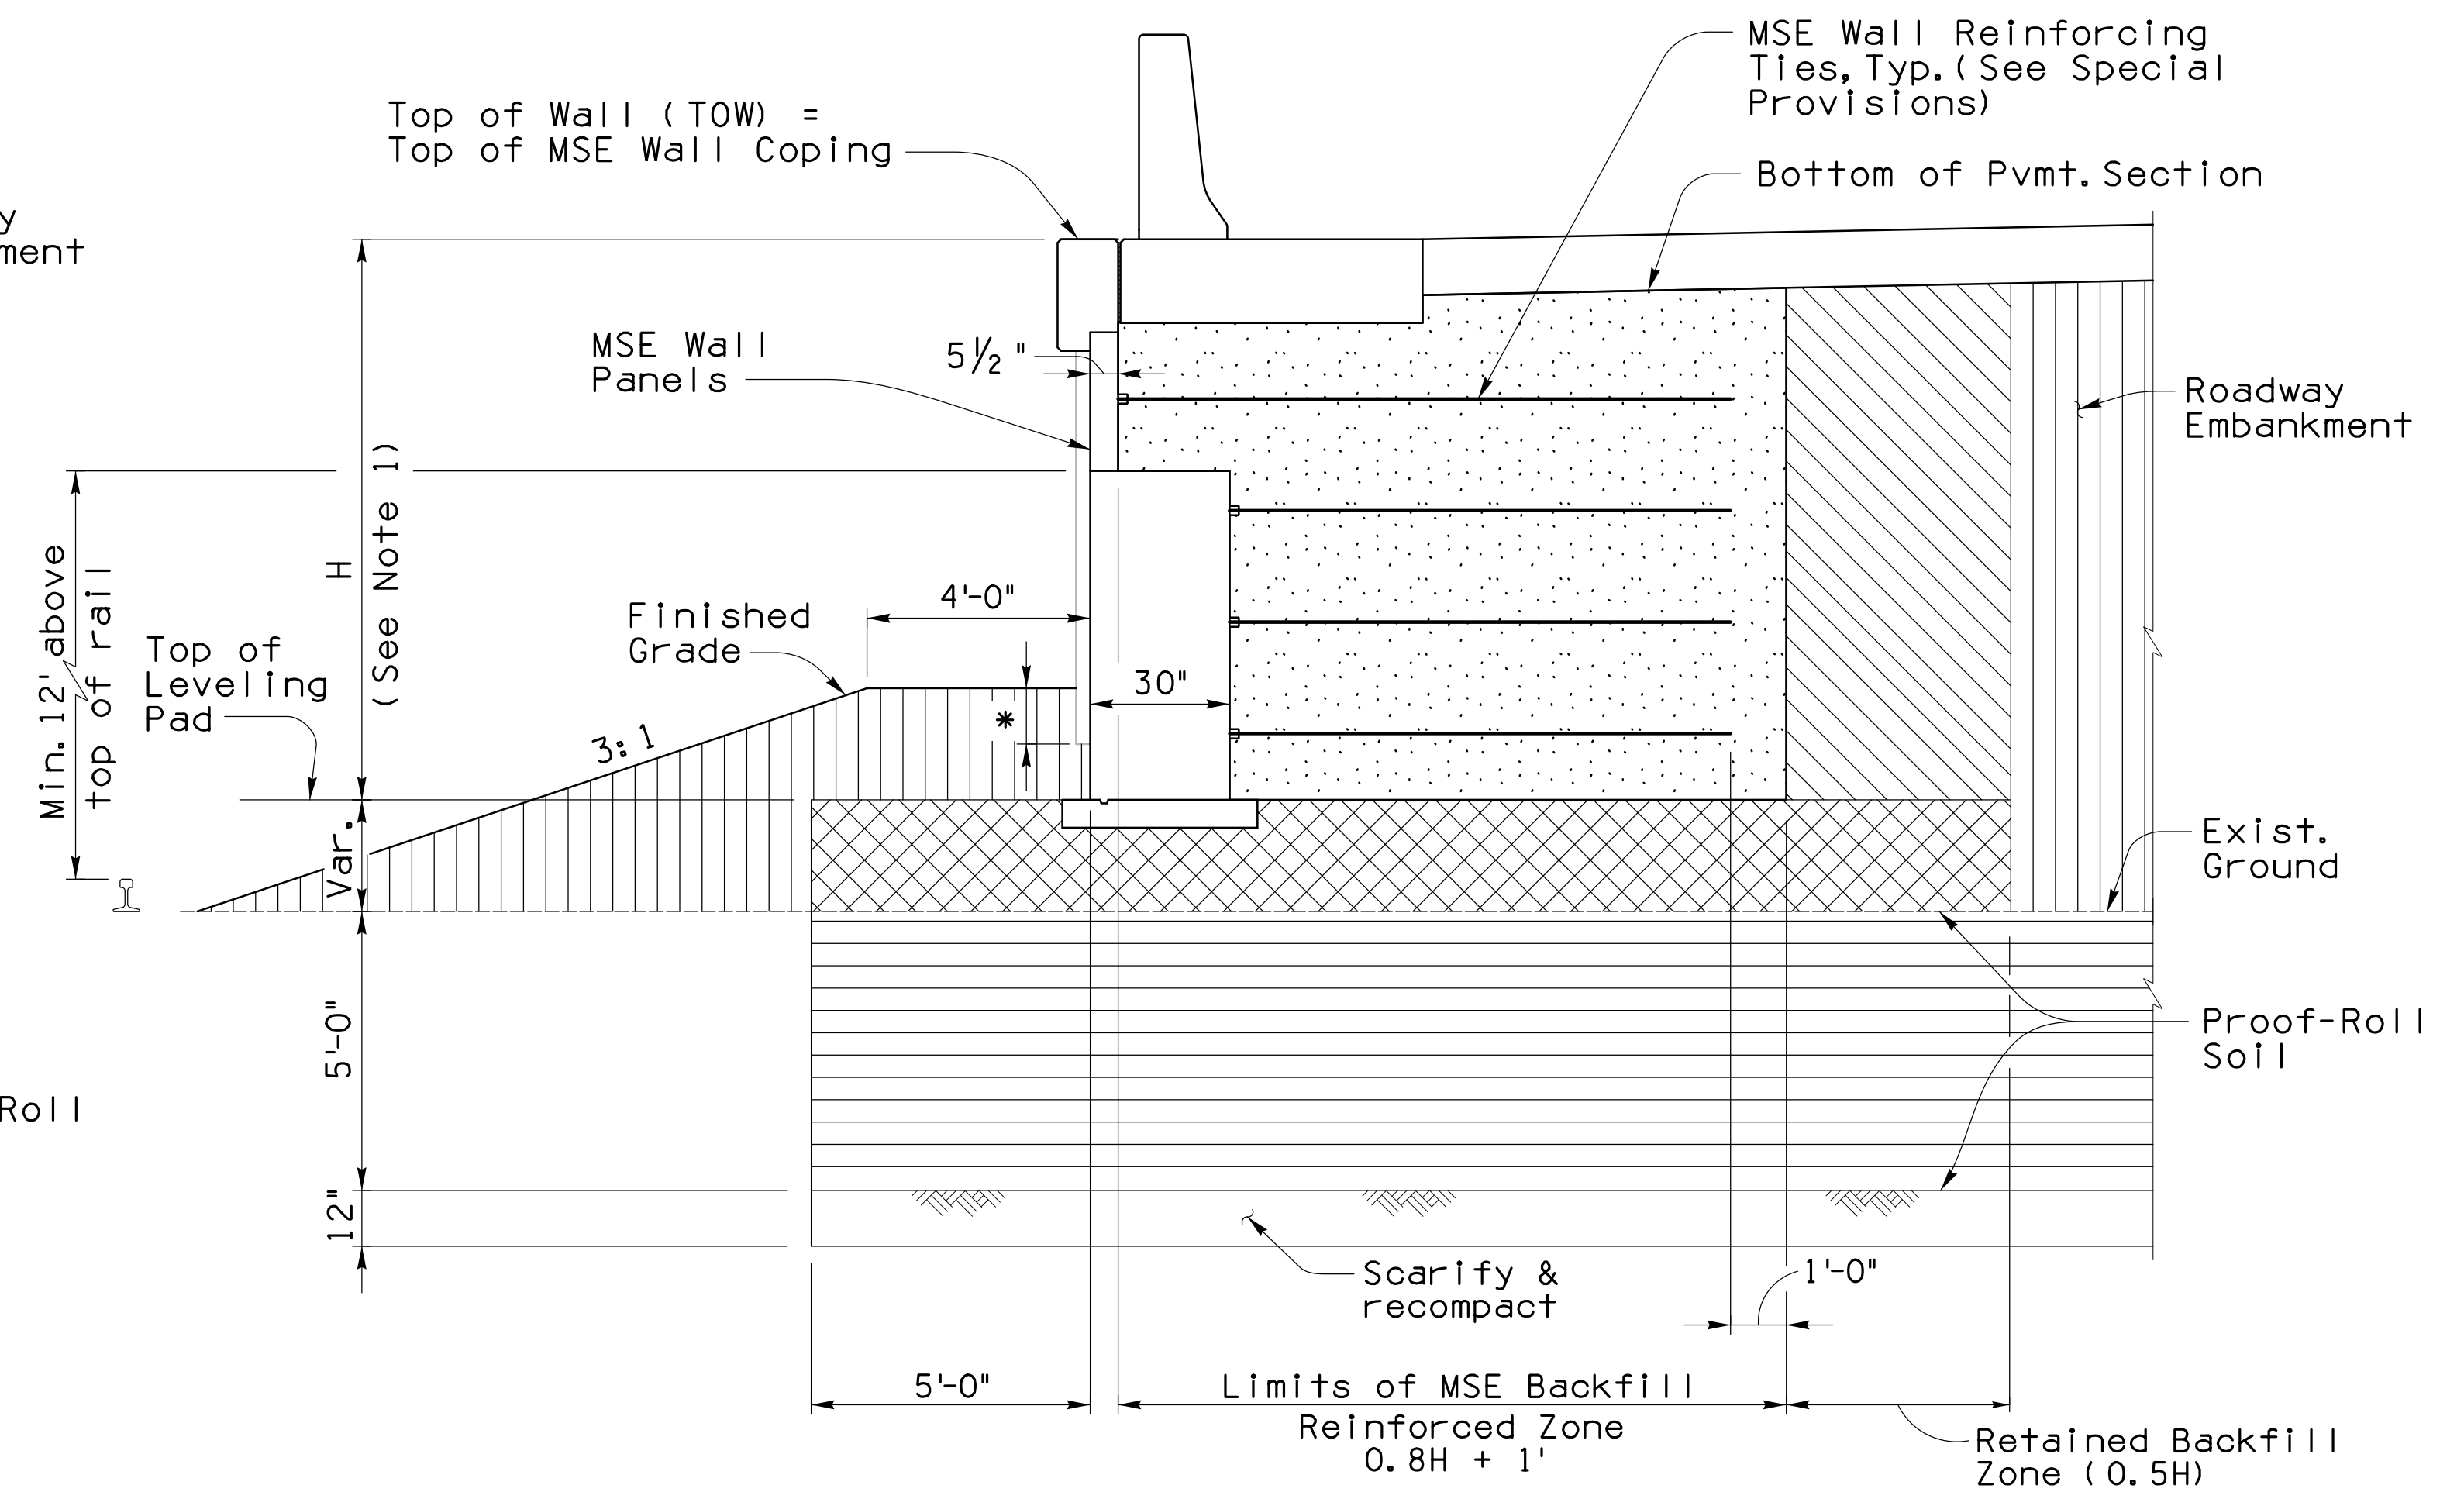

\* Extend Architectural Treatment 1'-0" min. below Finished Grade

MSE WALL SECTION IN FILL (30")  
No Scale

LEGEND:

-  Reinforced Backfill
-  Retained Backfill
-  Roadway Embankment
-  Overexcavation & Recompaction
-  Special Foundation Backfill


Notes:

1. H = Wall height measured from top of coping beam to top of concrete leveling pad.
2. Roadway embankment and Special Foundation Backfill shall be constructed to top of leveling pad prior to construction of leveling pad.
3. Roadway embankment shall be constructed to finished grade at front face of wall before MSE wall is constructed to 0.5H.
4. 30" thick MSE panels required on walls WB-3, RR-3 and RR-4. Panels shall extend to at least 12' above the top of adjacent rail. Where top of wall is less than 12' above top of rail, 30" panel shall extend to the bottom of barrier footing. 30" panel and bottom of footing shall be separated by bond breaker as approved by the Engineer.



DESIGN	NAME	DATE	ARIZONA DEPARTMENT OF TRANSPORTATION INTERMODAL TRANSPORTATION DIVISION ROADWAY DESIGN SERVICES
DRAWN	JAM, JWG	03-19	
CHECKED	KRH	03-19	

<b>Structural Grace, Inc</b> 1430 E. Ft. Lowell Suite 200 Tucson, Arizona 85719 (520) 320-0156		 Expires: 12/31/20
ROUTE I-10	LOCATION RUTHRAUFF ROAD TI	
TRACS NO. H 8480 01C		DWG NO. S-7.31
010-D(213)S		OF

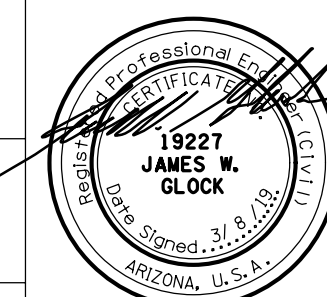

F.H.W.A. REGION	STATE	PROJECT NO.	SHEET NO.	TOTAL SHEETS	RECORD DRAWING
9	ARIZ.	010-D(213)S	734	849	

010 PM 252


**ARCHITECTURAL TREATMENT GENERAL NOTES:**

1. Dimensions Shown In these plans shall be used to construct Architectural Treatments only. Refer to Roadway and Bridge Plans for construction dimensions.
2. The Contractor shall notify the Engineer of any discrepancies prior to fabrication of Formliners or Metal Work.
3. Concrete Finish and Textures shall be in accordance with the Architectural Treatment Plans and Special Provisions.
4. The Engineer and Landscape Architect shall be notified when surface defects occur and coordinate to address issue.
5. All exposed surfaces on bridge structures, piers, abutments, wingwalls, barrier, parapet, retaining walls, concrete sign structures, as well as 2' below grade shall receive paint. Refer to the Architectural Treatment Details and the Special Provisions.
6. All Painting and Paint Colors shall be in accordance with Section 610 of the Special Provisions.
7. The Contractor shall determine the number and size of Formliners.
8. Adjustments to Architectural Treatment Details will require approval from the Engineer and Roadside Development Section.
9. All Rustication Formliners shall extend a minimum of 2'-0" below finish grade (Typ) except where noted on the Plans.
10. Architectural Treatment Elevations and Sections represent concrete, except where noted as metal.
11. Contractor is to provide shop drawings for all the aesthetic features including metal work on the Pedestrian Fence for review and approval from ADOT Roadside Development through the ADOT Resident Engineer prior to fabrication and construction.
12. Interior facade of Davis Structure to receive Diagonal Rib Formliner.

**ARCHITECTURAL TREATMENT SUMMARY TABLE**

STRUCTURE	TREATMENT	STRUCTURE	TREATMENT
Retaining Wall WB-1	Formliner Architectural Treatment	Retaining Wall RRN-1	Formliner Architectural Treatment
Retaining Wall WB-2	Formliner Architectural Treatment	Retaining Wall RRS-1	Formliner Architectural Treatment
Retaining Wall WB-3	Formliner Architectural Treatment	Abutment Wall #1	Formliner Architectural Treatment
Retaining Wall WB-4	Formliner Architectural Treatment	Abutment Wall #2	Formliner Architectural Treatment
Retaining Wall EB-1	Formliner Architectural Treatment	Davis Structure	Formliner Architectural Treatment
Retaining Wall EB-2	Formliner Architectural Treatment	Bridge Barrier (SD 1.04)	Formliner Architectural Treatment
Retaining Wall RR-1	No Treatment (Behind Abutment 1)	F-Shape Barrier (SD 1.02)	Formliner Architectural Treatment
Retaining Wall RR-2	No Treatment (Behind Abutment 2)	Piers	Formliner Architectural Treatment
Retaining Wall RR-3	Formliner Architectural Treatment	I-10 Pedestrian Fence	Metal Work
Retaining Wall RR-4	Formliner Architectural Treatment	UPRR Pedestrian Fence	Metal Work

DATE- LOCATION- REVISIONS- FINISHED PLANS- SURVEY NO. DATE- LOCATION- REVISIONS- FINISHED PLANS- SURVEY NO.


DESIGN	WDC	NAME	DATE	ARIZONA DEPARTMENT OF TRANSPORTATION INFRASTRUCTURE DELIVERY AND OPERATIONS DIVISION ROADSIDE DEVELOPMENT SECTION	
DRAWN	WDC		3/19		
CHECKED	WDC/LEM		3/19		
<b>WHEAT DESIGN GROUP</b>		LANDSCAPE ARCHITECTS		ARCHITECTURAL TREATMENT SUMMARY SHEET	
500 N TUCSON BLVD, SUITE 150 TUCSON AZ 85716					
ROUTE	LOCATION	RUTHRAUFF ROAD TI			
TRACS NO. H 8480 01C		010-D(213)S		DWG NO. A-1.01	

EXPIRES 6-30-2019

OF


F.H.W.A. REGION	STATE	PROJECT NO.	SHEET NO.	TOTAL SHEETS	RECORD DRAWING
9	ARIZ.	010-D(213)S	735	849	

010 PM 252

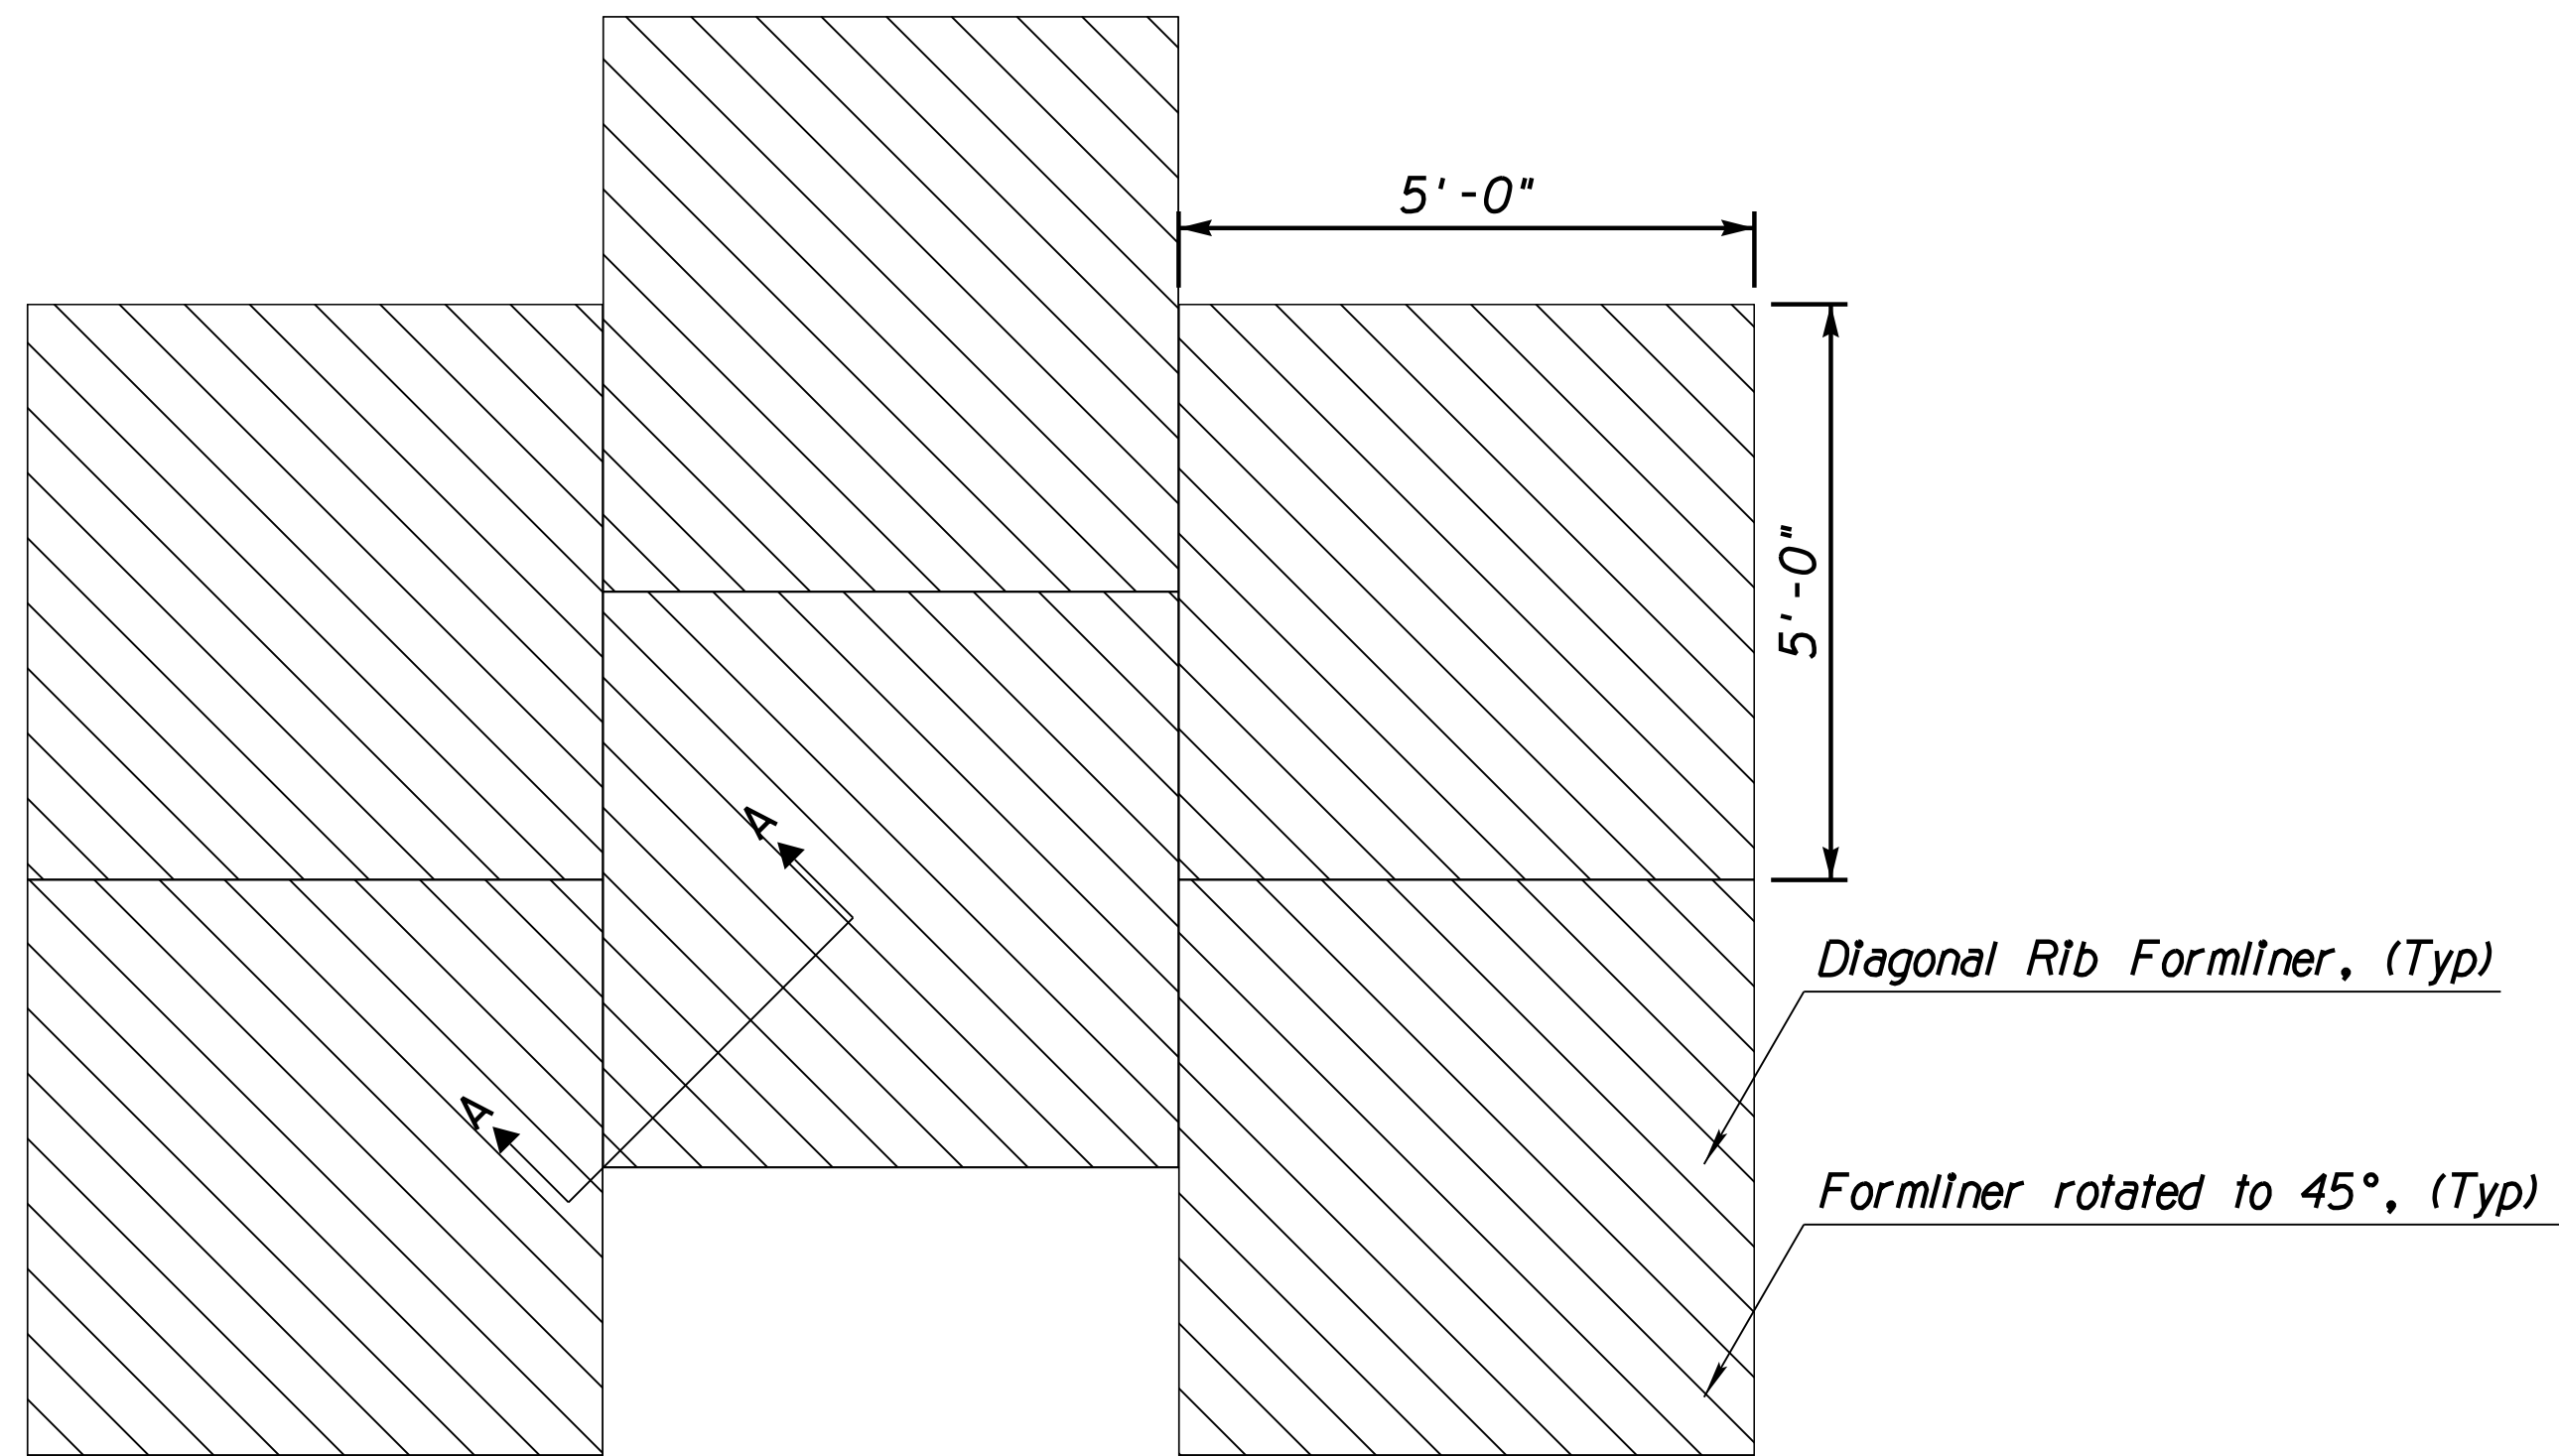

MSE PANEL LAYOUT

NTS

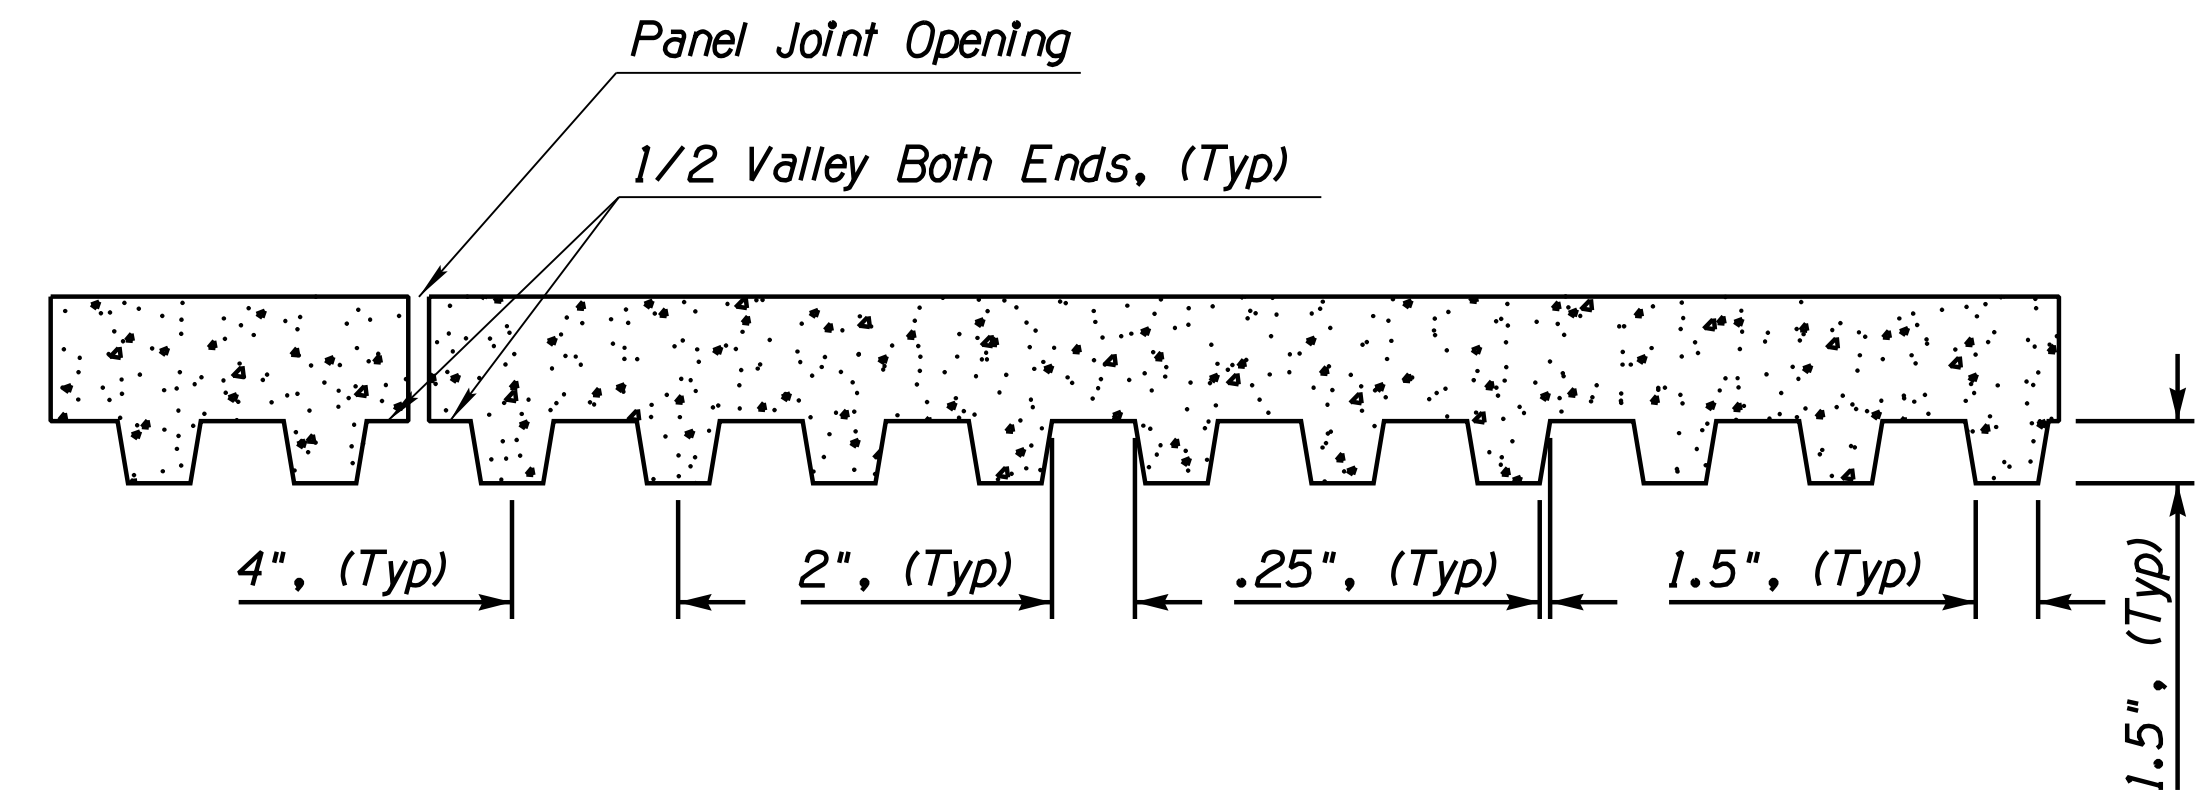


DIAGONAL RIB FORMLINER SECTION 'A-A'

NTS

NOTES:

- All MSE Panels have an approximate dimension of 5' x 5'. Should the overall dimensions of the MSE Panel change, all horizontal and vertical alignments shall be scaled proportionally. Relief dimensions shall not be altered.
- All MSE Panels shall be painted. Refer to Section 610 of the Special Provisions.

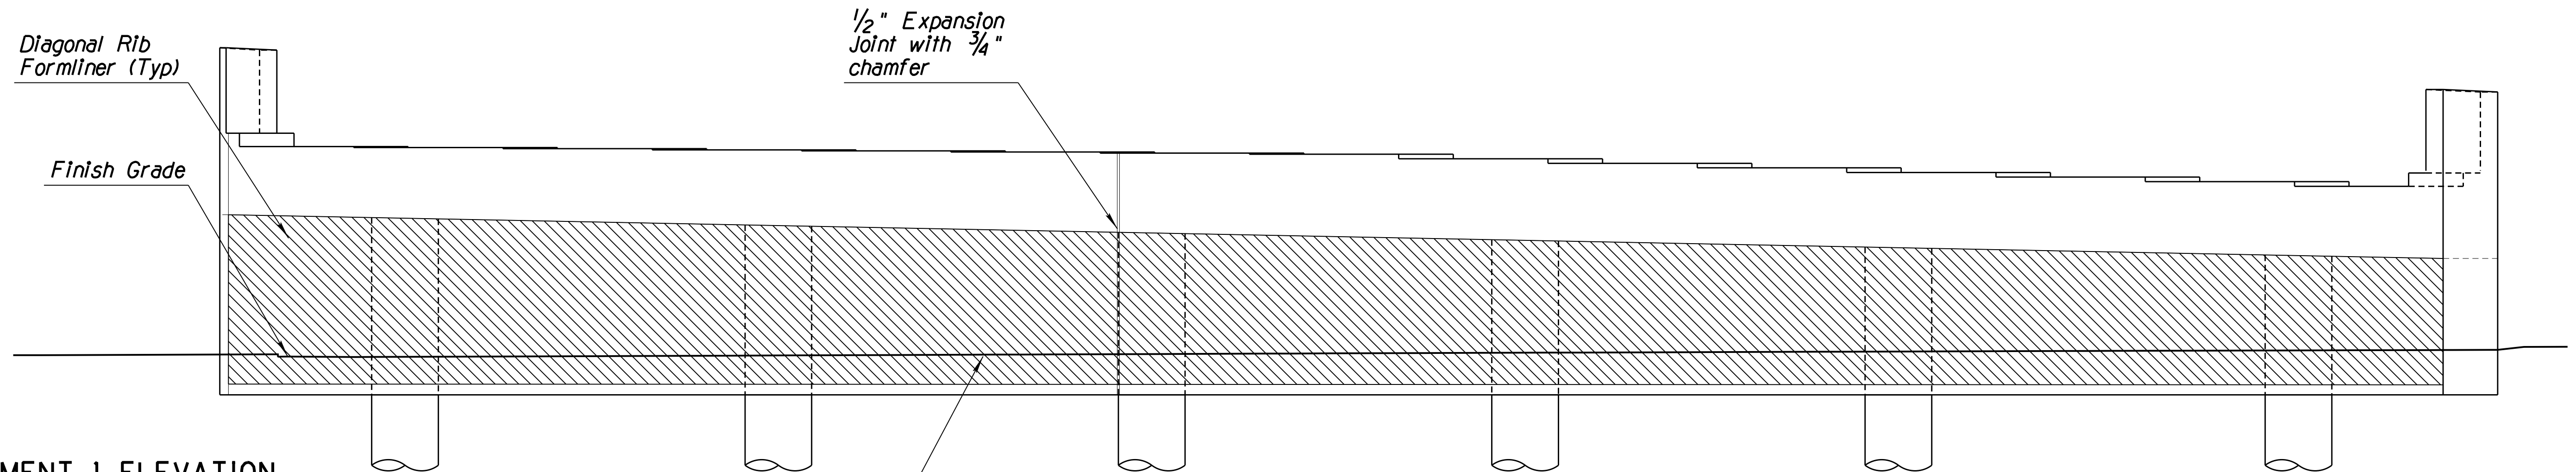

ABUTMENT 1 ELEVATION

NTS

RELIEF LEGEND

- F = Flush
- R1 = Recessed 1/2"
- R2 = Recessed 1"
- R3 = Recessed 1 1/2"
- R4 = Recessed 2"
- R5 = Recessed 2 1/2"
- R6 = Recessed 3"
- R7 = Recessed 3 1/2"
- R8 = Recessed 4"

PAINT LEGEND


- Base: "ADOT Tan" (Flat Finish)
- Accent 1: "Shitake" (Semi-Gloss Finish)
- Accent 2: "Black Deco" (Gloss Finish)
- Accent 3: "Iris White" (Semi-Gloss Finish)

Paint Color Accent 1 (Typ)

NOTES:


- Formliner shall extend 2'-0" below finish grade, (Typ).
- Refer to Structural Plans for additional information.
- Refer to Special Provisions for additional Paint information.
- Fabrication of Formliner and Abutment Patterns to be generated from full scale electronic CADD data.

DESIGN	WDC	NAME	DATE	ARIZONA DEPARTMENT OF TRANSPORTATION INFRASTRUCTURE DELIVERY AND OPERATIONS DIVISION ROADSIDE DEVELOPMENT SECTION
DRAWN	WDC		3/19	
CHECKED	WDC/LEM		3/19	
WHEAT DESIGN GROUP		LANDSCAPE ARCHITECTS		ARCHITECTURAL TREATMENT ABUTMENT 1 ELEVATION
500 N TUCSON BLVD, SUITE 150 TUCSON AZ 85716				
ROUTE	LOCATION	RUTHRAUFF ROAD TI		EXPIRES 6-30-2019 DWG NO. A-2.01
1-10				
TRACS NO. H 8480 OIC		010-D(213)S		OF

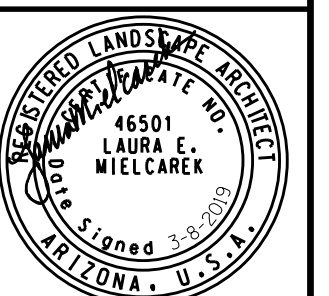


F.H.W.A. REGION	STATE	PROJECT NO.	SHEET NO.	TOTAL SHEETS	RECORD DRAWING
9	ARIZ.	010-D(213)S	736	849	


010 PM 252

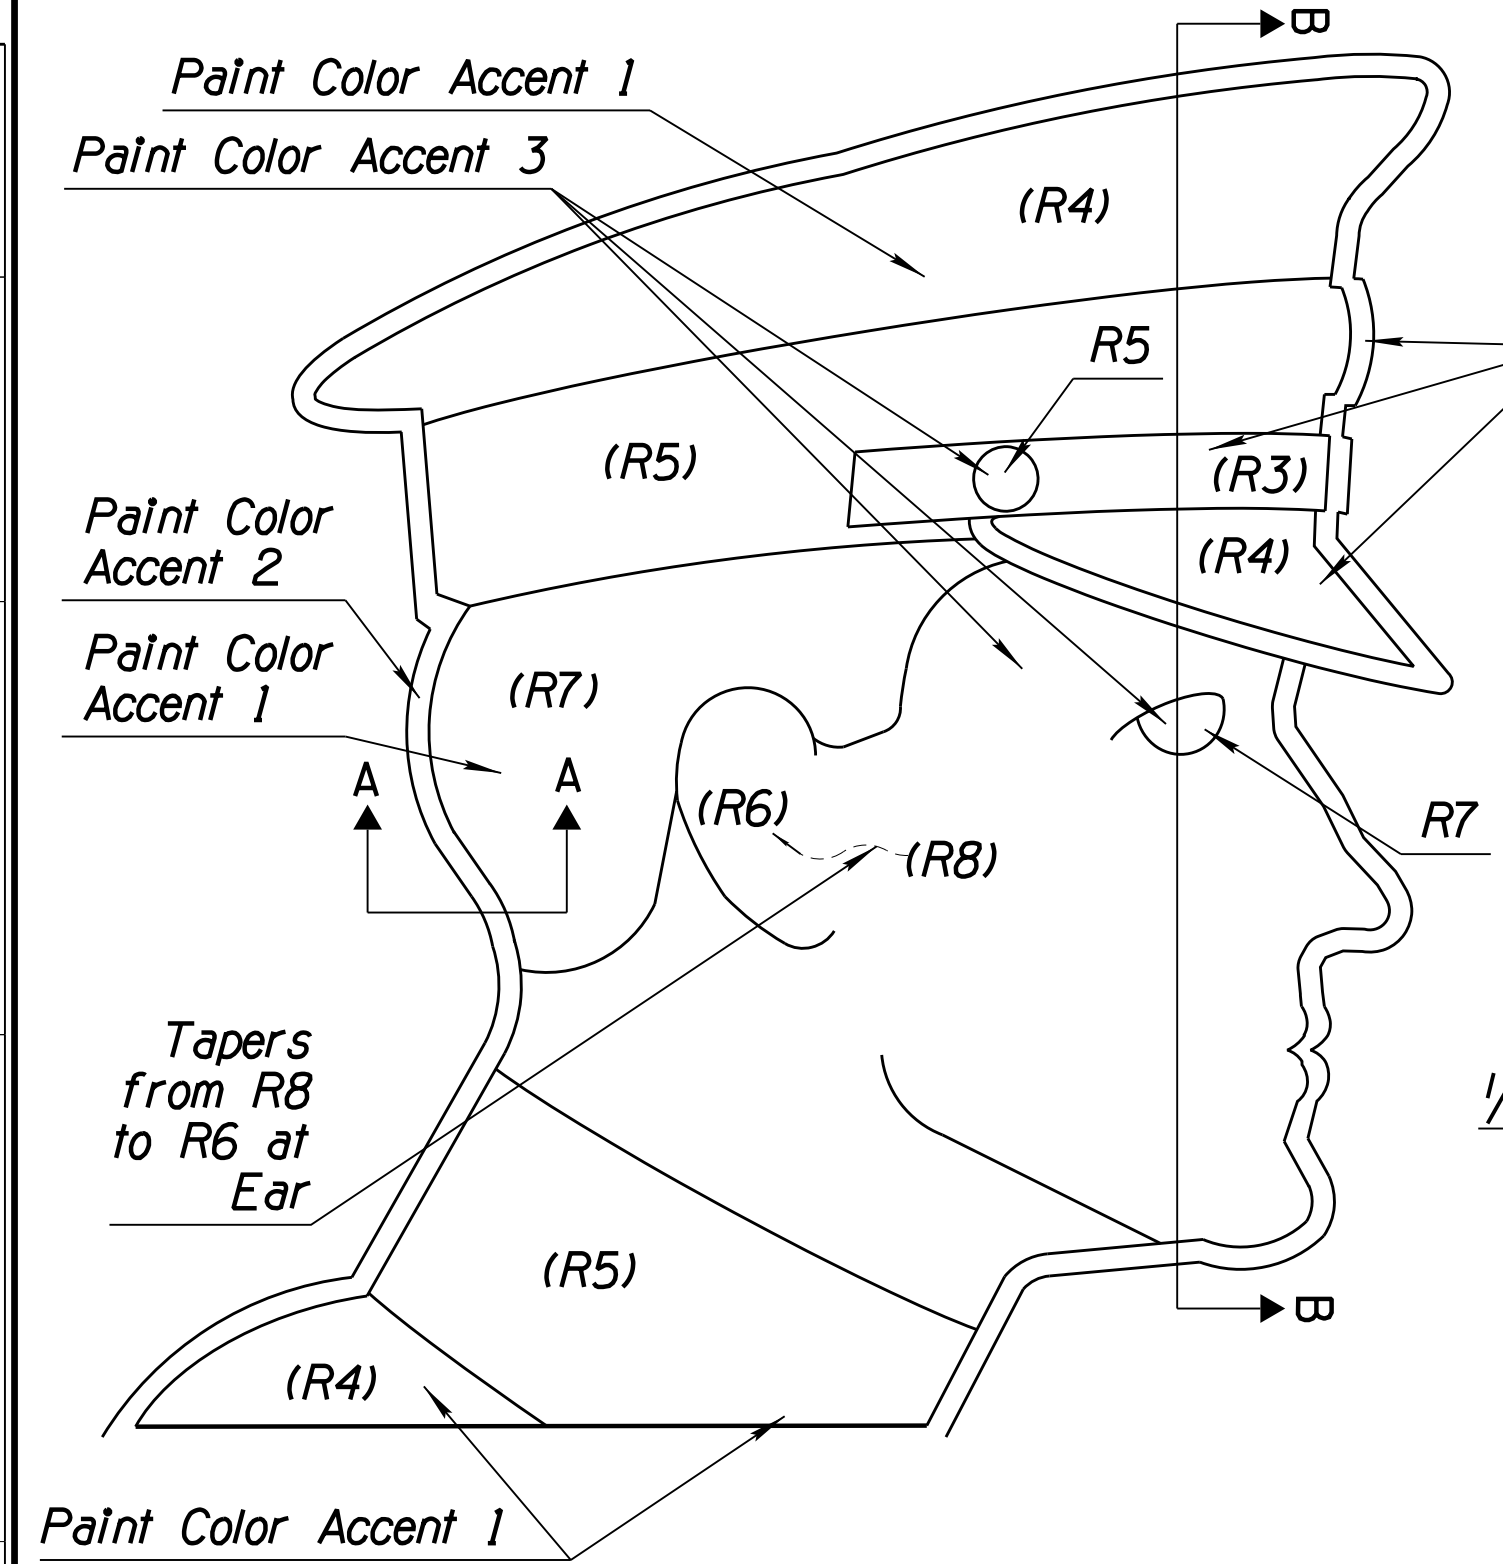

**RUTHRAUFF PROFILE DETAIL**  
NTS

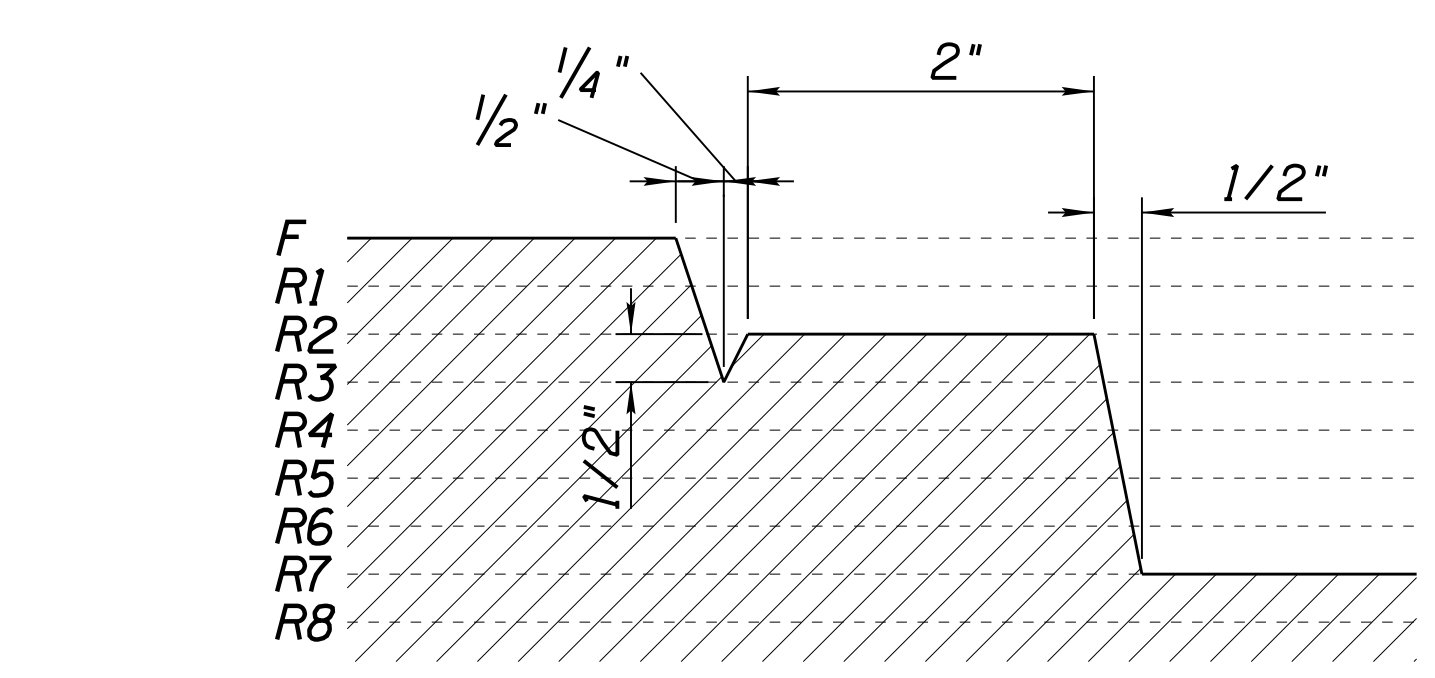


**SECTION 'A-A'**  
NTS

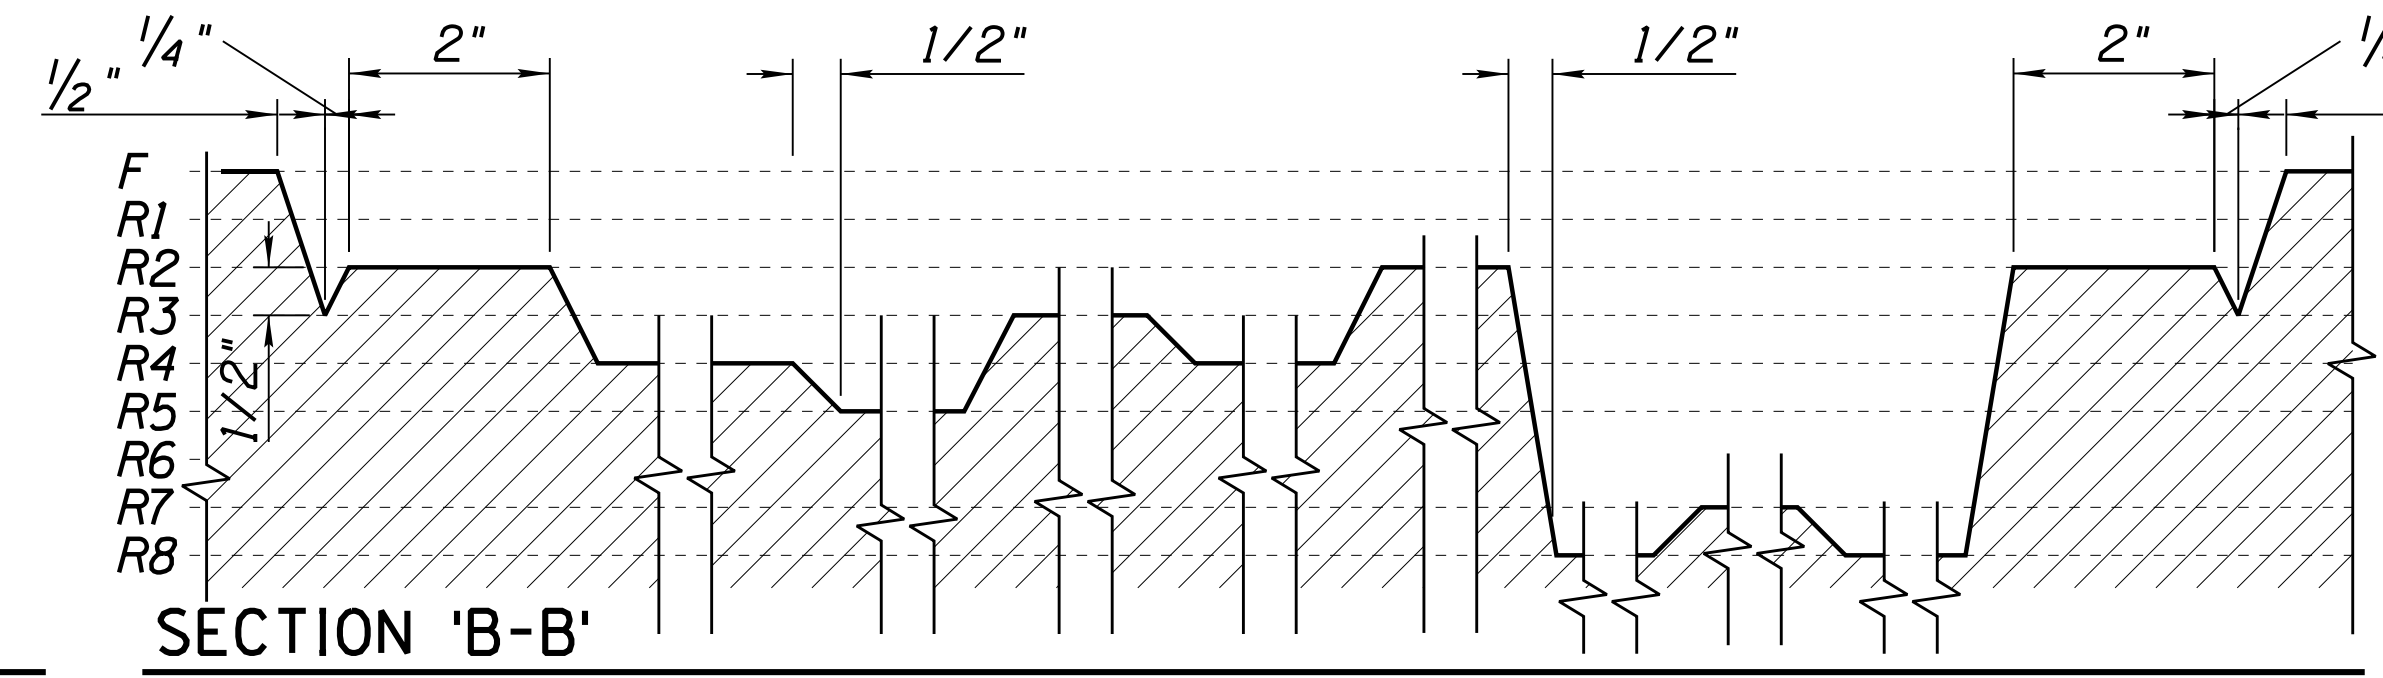


**SECTION 'B-B'**  
NTS

**NOTE:**  
1. The purpose of Sections 'A-A' and 'B-B' is to illustrate relief values. Horizontal values are not to scale.

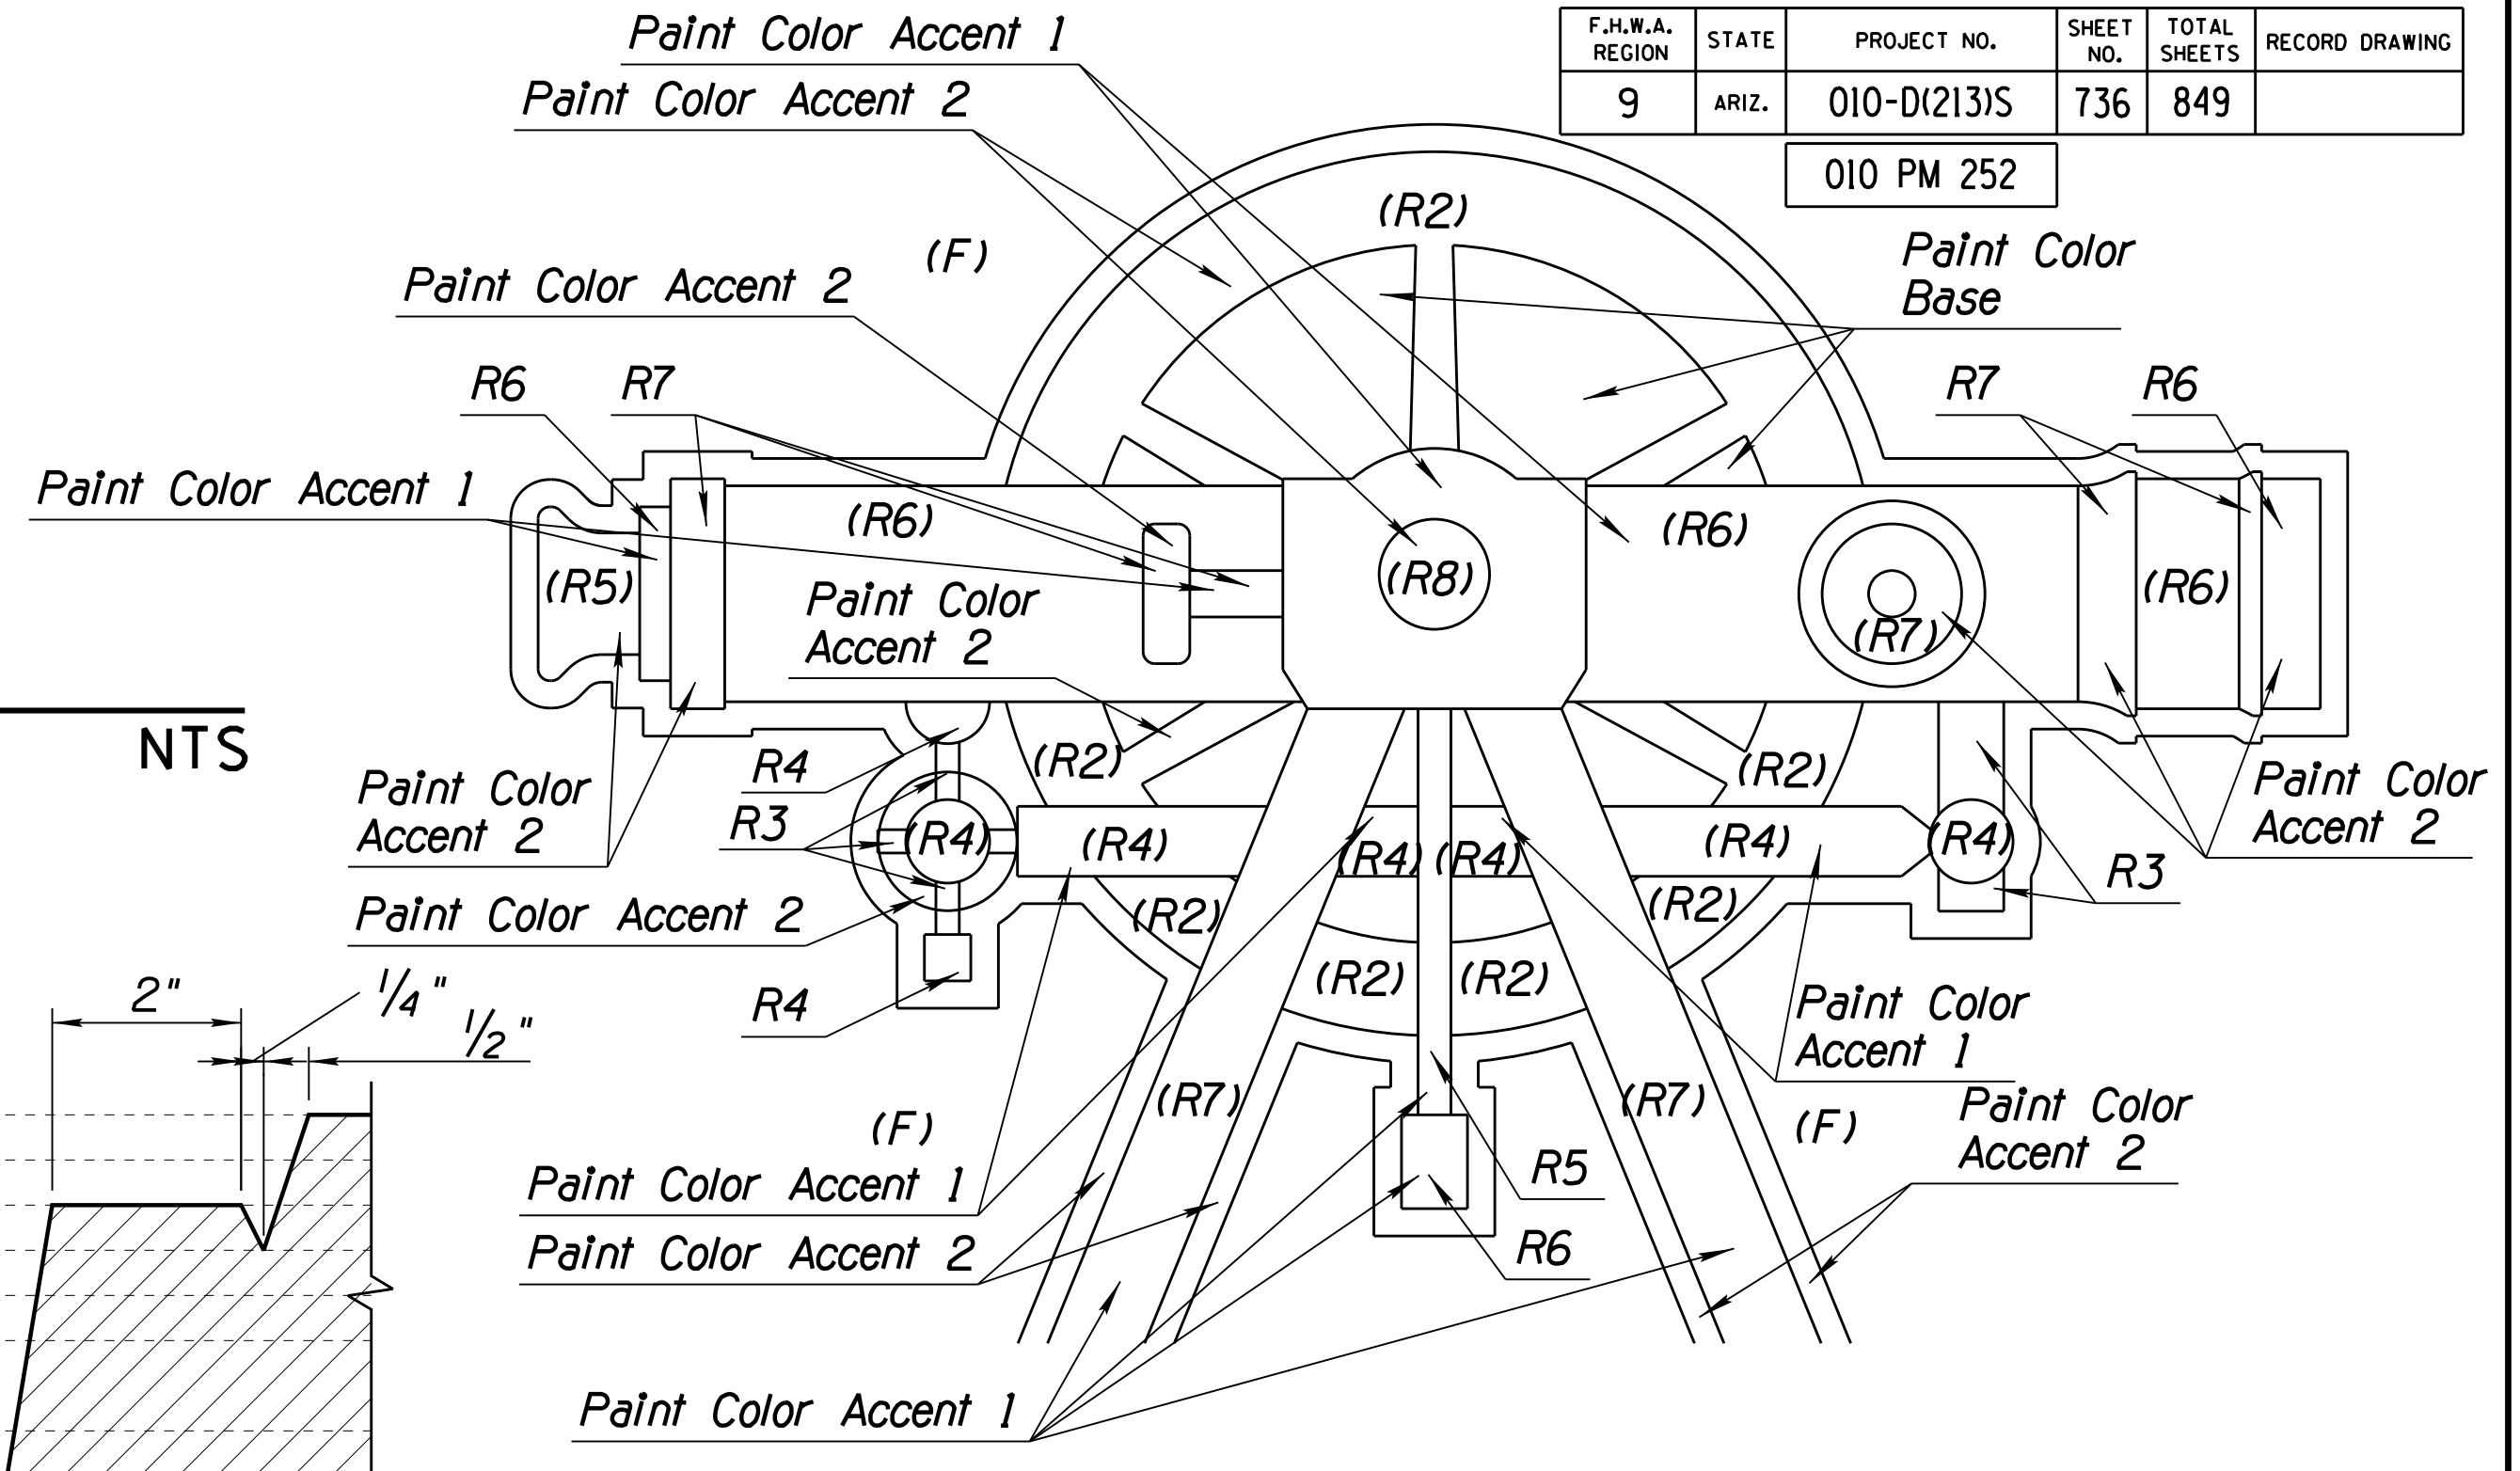

**TRANSIT DETAIL**  
NTS

**NOTES:**  
1. Unlabeled transit areas shall be Paint Color Base.  
2. Final Paint Locations to be approved by ADOT Roadside Development.

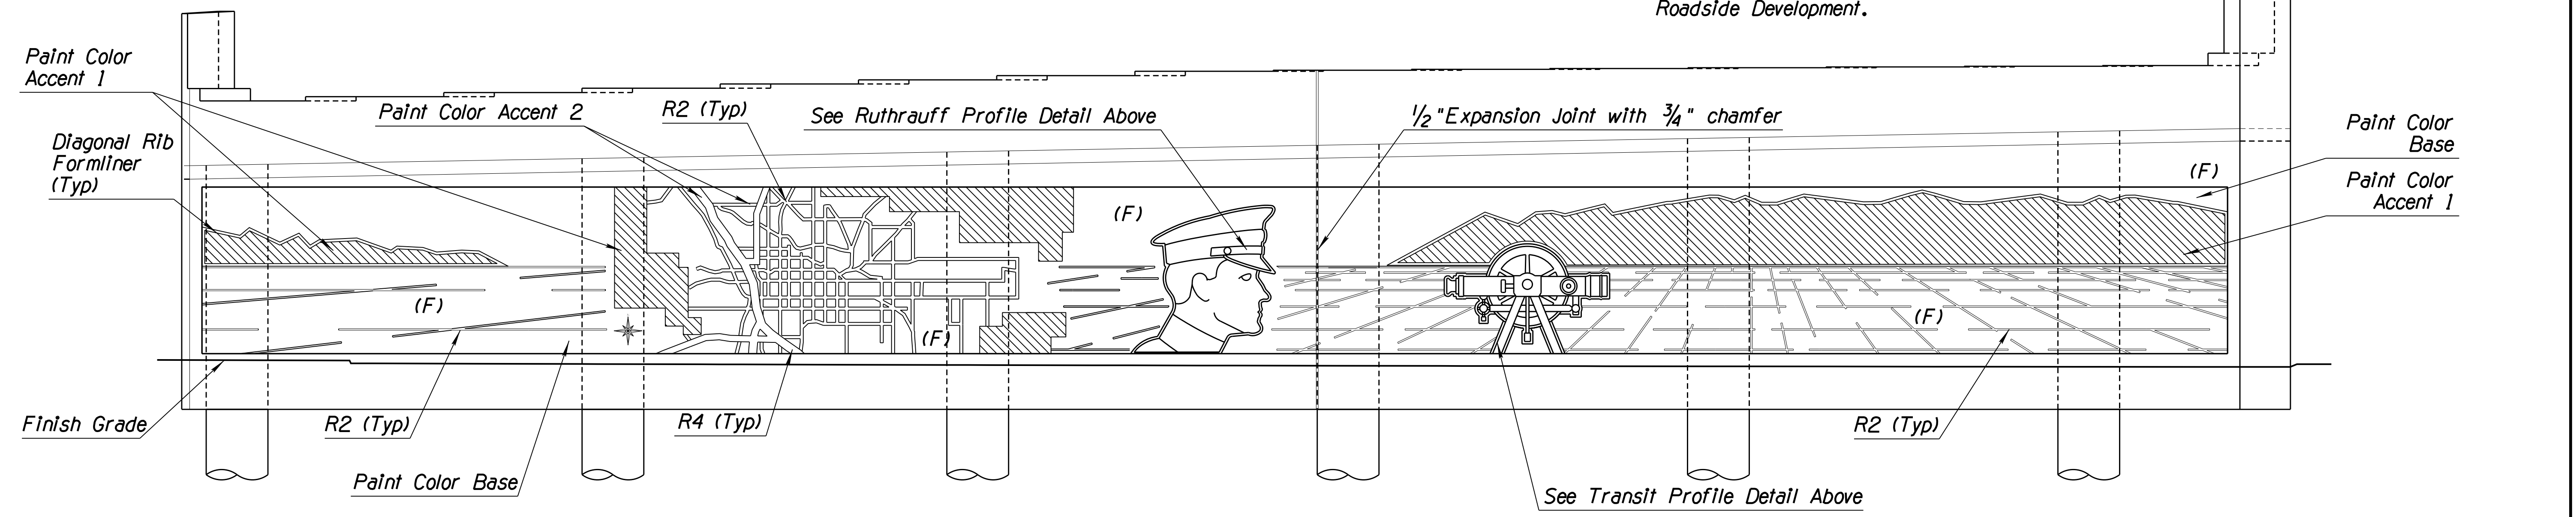

**ABUTMENT 2 ELEVATION**  
NTS

- RELIEF LEGEND**
- F = Flush
  - R1 = Recessed 1/2"
  - R2 = Recessed 1"
  - R3 = Recessed 1 1/2"
  - R4 = Recessed 2"
  - R5 = Recessed 2 1/2"
  - R6 = Recessed 3"
  - R7 = Recessed 3 1/2"
  - R8 = Recessed 4"
- PAINT LEGEND**
- Base: "ADOT Tan" (Flat Finish)
  - Accent 1: "Shitake" (Semi-Gloss Finish)
  - Accent 2: "Black Deco" (Gloss Finish)
  - Accent 3: "Iris White" (Semi-Gloss Finish)




- NOTES:**
1. Formliner shall extend 2'-0" below finish grade, (Typ).
  2. Refer to Structural Plans for additional information.
  3. Refer to Special Provisions for additional Paint information.
  4. Fabrication of Formliner and Abutment Patterns to be generated from full scale electronic CADD data.

DESIGN	WDC	3/19	ARIZONA DEPARTMENT OF TRANSPORTATION INFRASTRUCTURE DELIVERY AND OPERATIONS DIVISION ROADSIDE DEVELOPMENT SECTION	
DRAWN	WDC	3/19		
CHECKED	WDC/LEM	3/19		
<b>WHEAT DESIGN GROUP</b> LANDSCAPE ARCHITECTS 500 N. TUCSON BLVD. SUITE 150 TUCSON AZ 85716			<b>ARCHITECTURAL TREATMENT</b> <b>ABUTMENT 2 ELEVATION DETAILS</b>	
ROUTE	LOCATION			
1-10	RUTHRAUFF ROAD T1		EXPIRES 6-30-2019 DWG NO. A-2.02	
TRACS NO. H 8480 OIC			010-D(213)S	
			OF	



F.H.W.A. REGION	STATE	PROJECT NO.	SHEET NO.	TOTAL SHEETS	RECORD DRAWING
9	ARIZ.	010-D(213)S	737	849	

010 PM 252

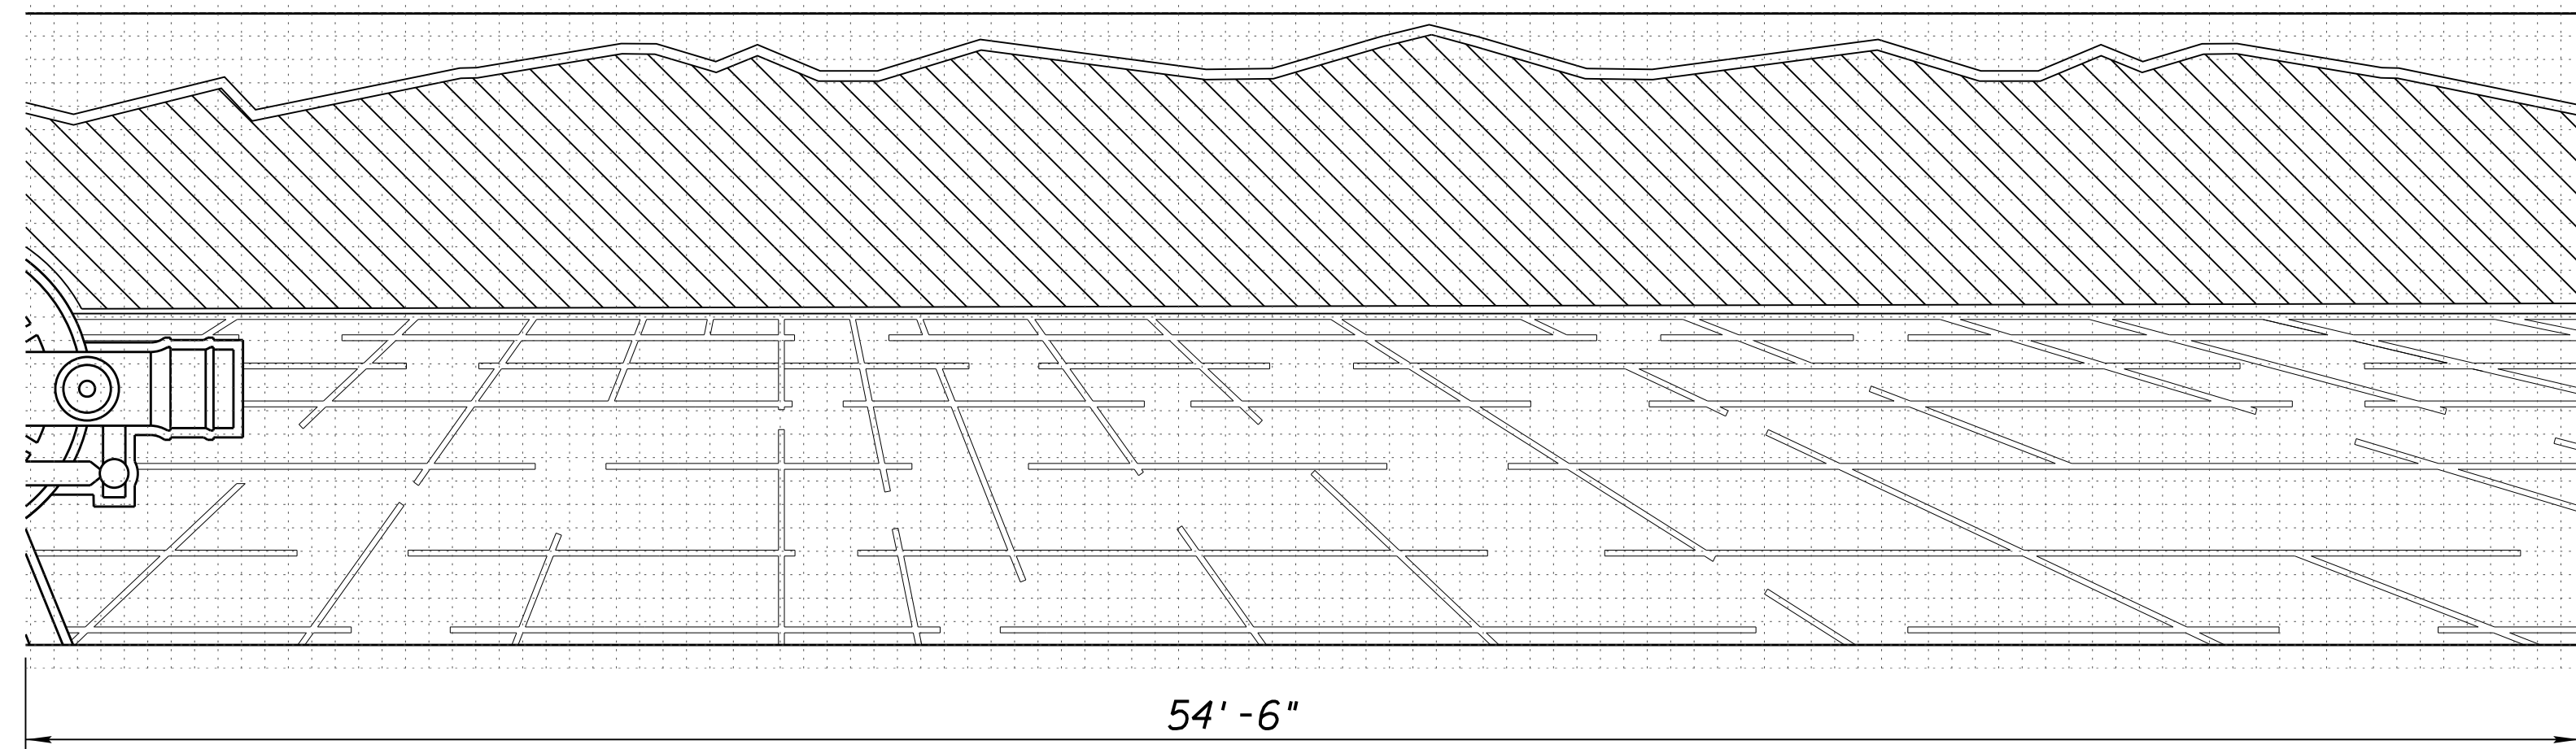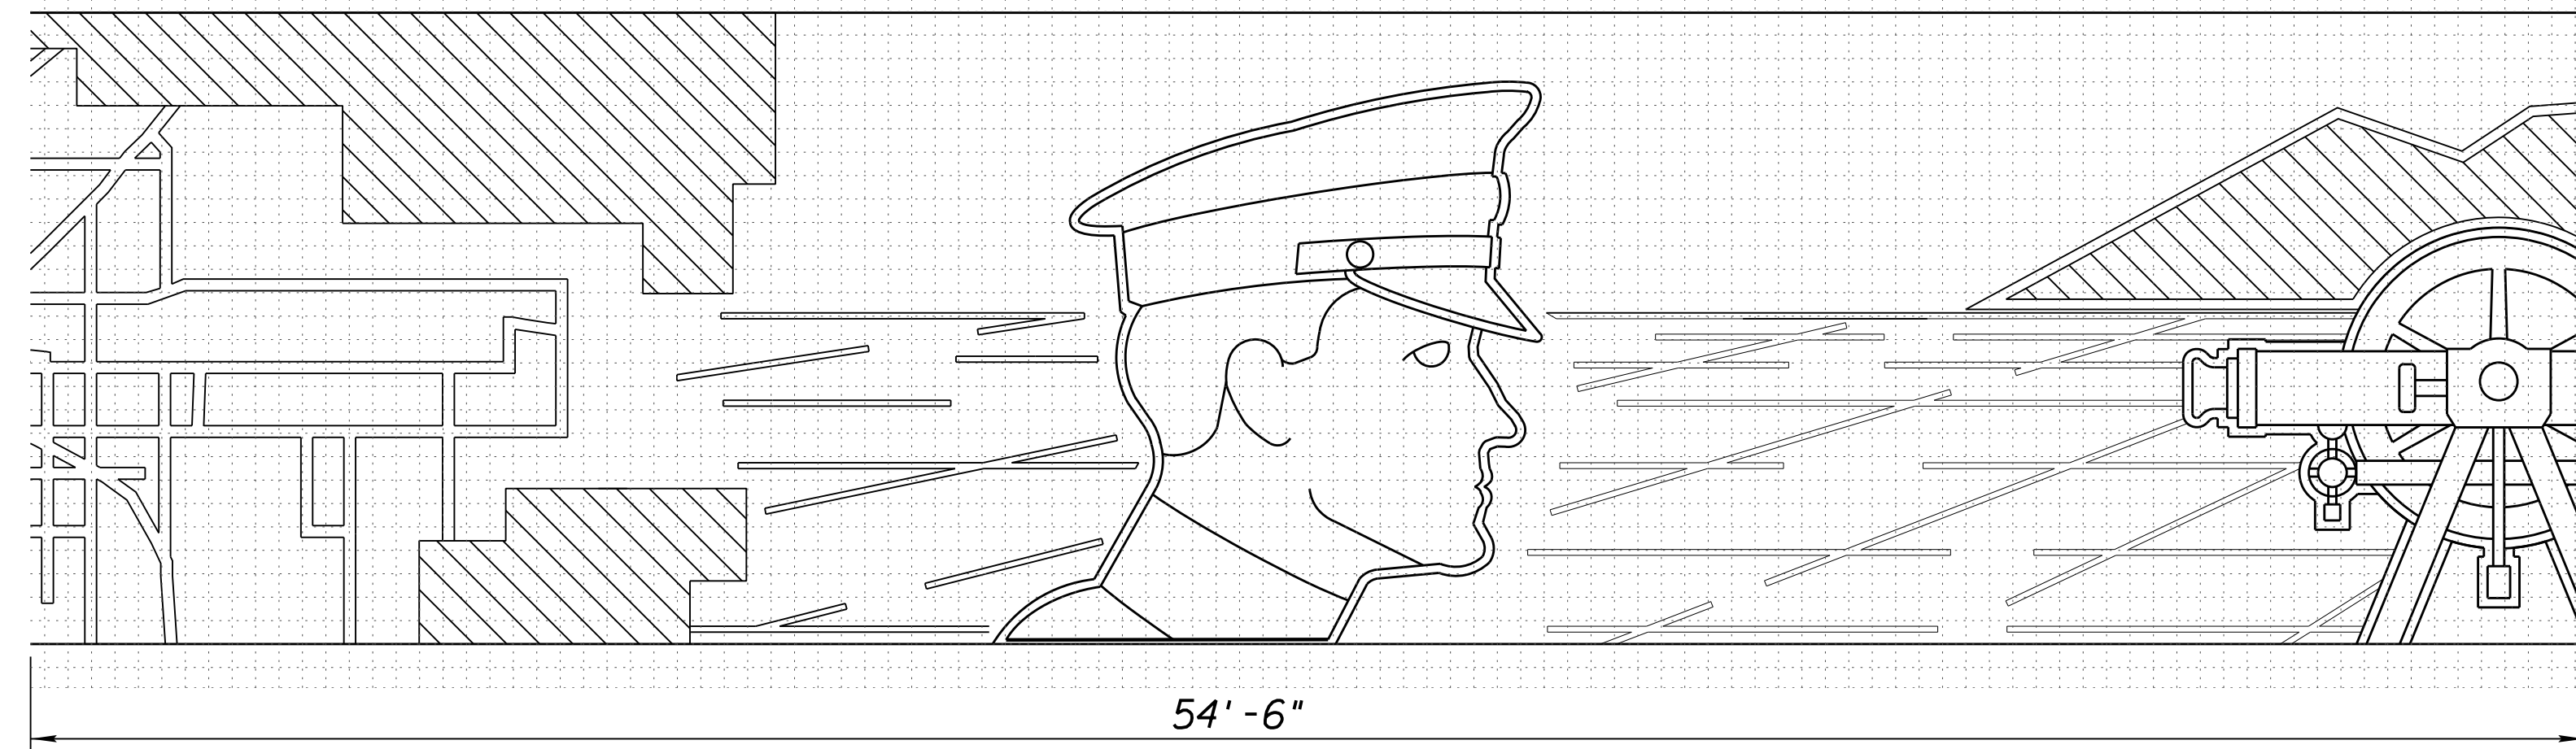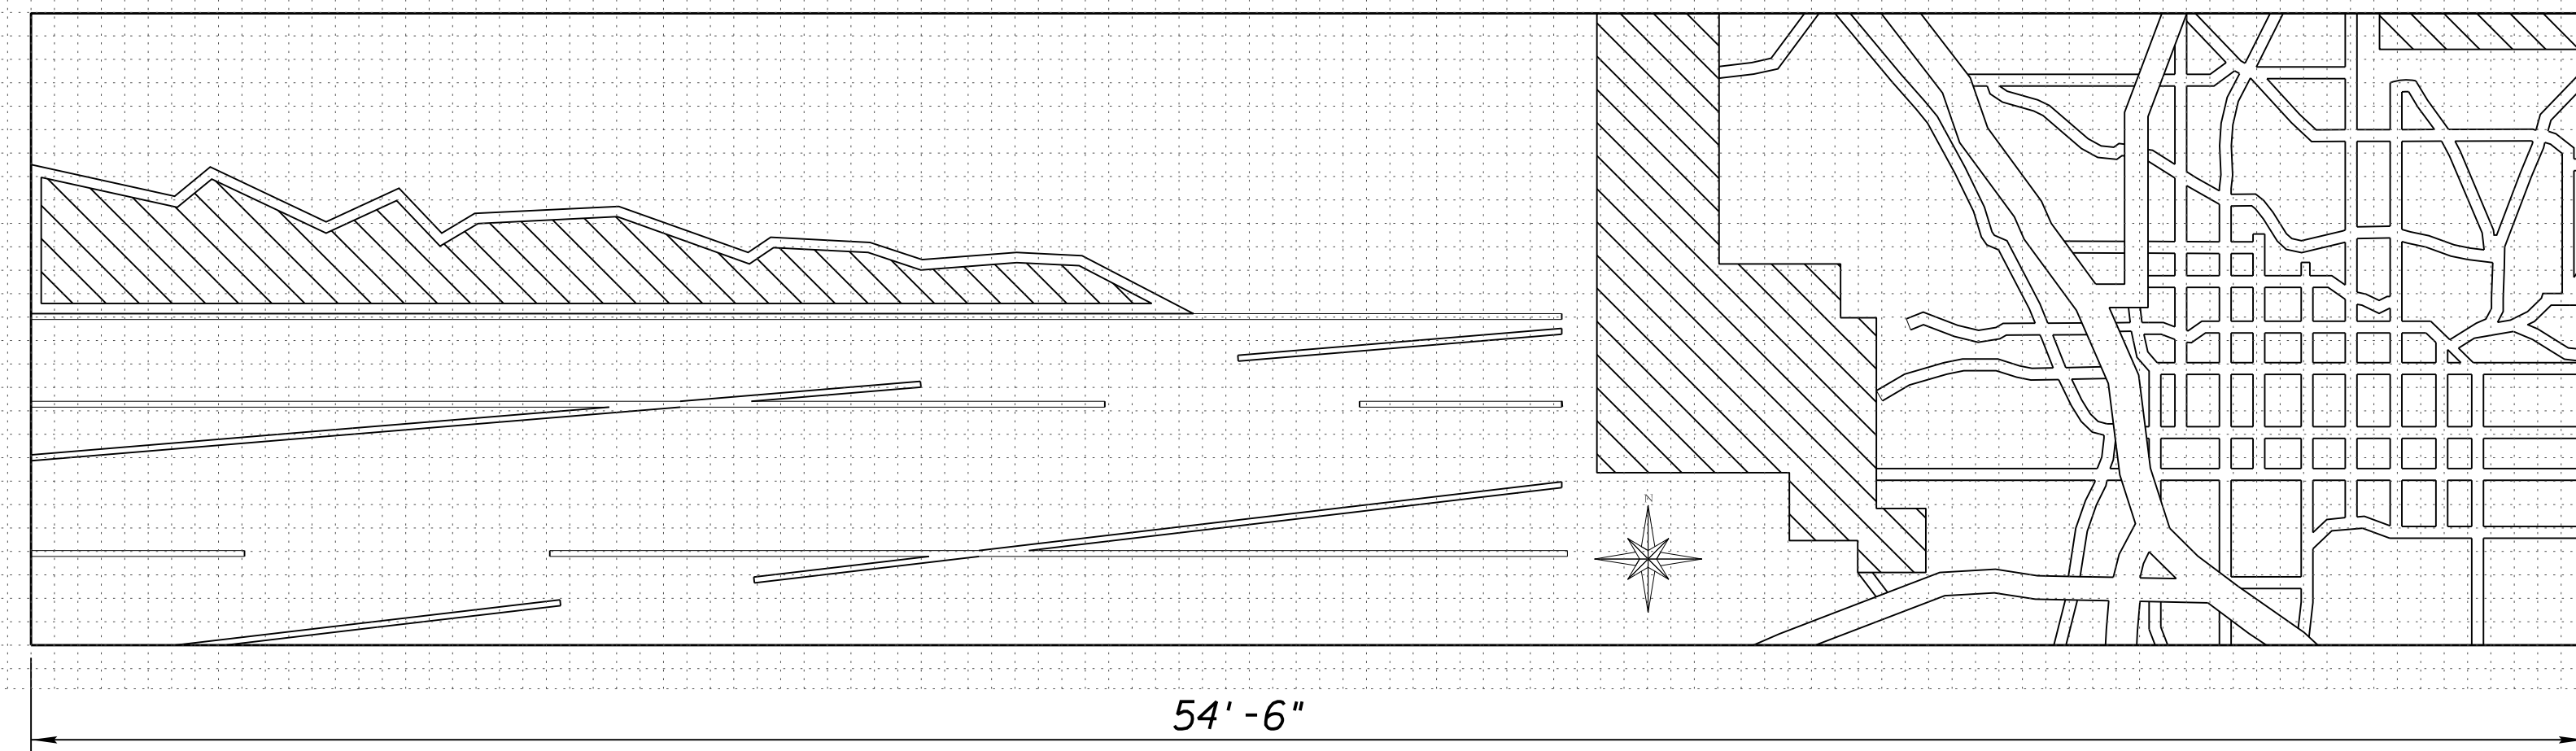

**ABUTMENT 2 ELEVATION - 6"x6" GRID**

NTS

**RELIEF LEGEND**

**PAINT LEGEND**

- |                             |  |
|-----------------------------|--|
| <i>F</i> = Flush            | Base: "ADOT Tan" (Flat Finish)             |
| <i>R1</i> = Recessed 1/2"   | Accent 1: "Shiitake" (Semi-Gloss Finish)   |
| <i>R2</i> = Recessed 1"     | Accent 2: "Black Deco" (Gloss Finish)      |
| <i>R3</i> = Recessed 1 1/2" | Accent 3: "Iris White" (Semi-Gloss Finish) |
| <i>R4</i> = Recessed 2"     |  |
| <i>R5</i> = Recessed 2 1/2" |  |
| <i>R6</i> = Recessed 3"     |  |
| <i>R7</i> = Recessed 3 1/2" |  |
| <i>R8</i> = Recessed 4"     |  |

**NOTES:**


- Formliner shall extend 2'-0" below finish grade, (Typ).
- Refer to Structural Plans for additional information.
- Refer to Special Provisions for additional Paint information.
- Fabrication of Formliner and Abutment Patterns to be generated from full scale electronic CADD data.

DESIGN	WDC	DATE	3/19	ARIZONA DEPARTMENT OF TRANSPORTATION INFRASTRUCTURE DELIVERY AND OPERATIONS DIVISION ROADSIDE DEVELOPMENT SECTION	
DRAWN	WDC	DATE	3/19		
CHECKED	WDC/LEM	DATE	3/19		
<b>WHEAT DESIGN GROUP</b>		LANDSCAPE ARCHITECTS		ARCHITECTURAL TREATMENT ABUTMENT 2 DIMENSIONS	
500 N. TUCSON BLVD, SUITE 150, TUCSON, AZ 85716					
ROUTE	LOCATION	RUTHRAUFF ROAD TI		EXPIRES 6-30-2019	
1-10				DWG NO. A-2.03	
TRACS NO. H 8480 01C			010-D(213)S		OF

DATE- LOCATION- REVISIONS- SURVEY NO. DATE- LOCATION- REVISIONS- SURVEY NO. DATE- LOCATION- REVISIONS- SURVEY NO.


F.H.W.A. REGION	STATE	PROJECT NO.	SHEET NO.	TOTAL SHEETS	RECORD DRAWING
9	ARIZ.	010-D(213)S	738	849	

010 PM 252

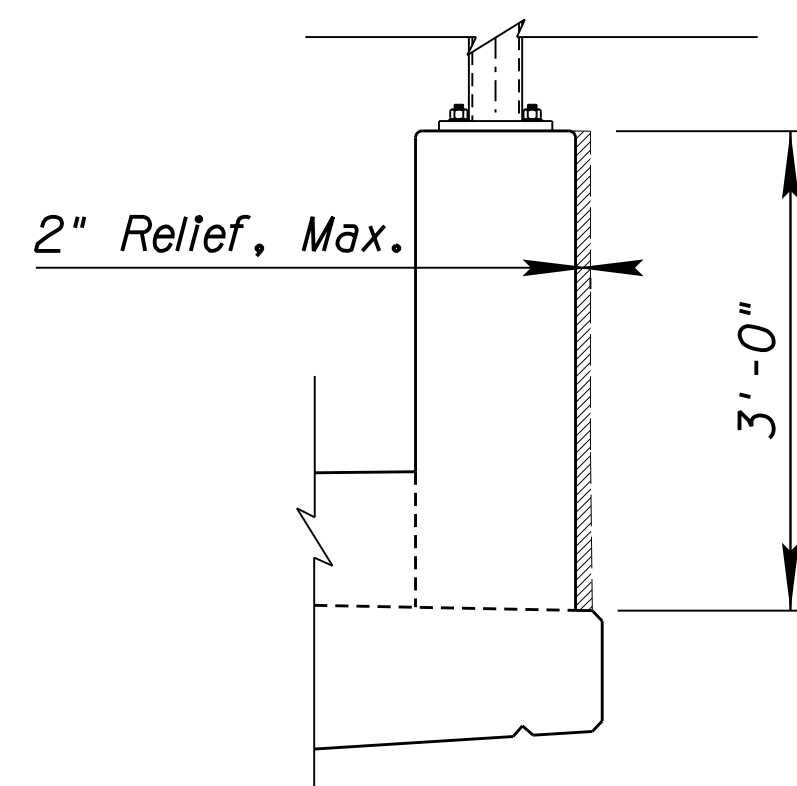


FORMLINER ON BRIDGE BARRIER (ADOT SD 1.04)

NTS

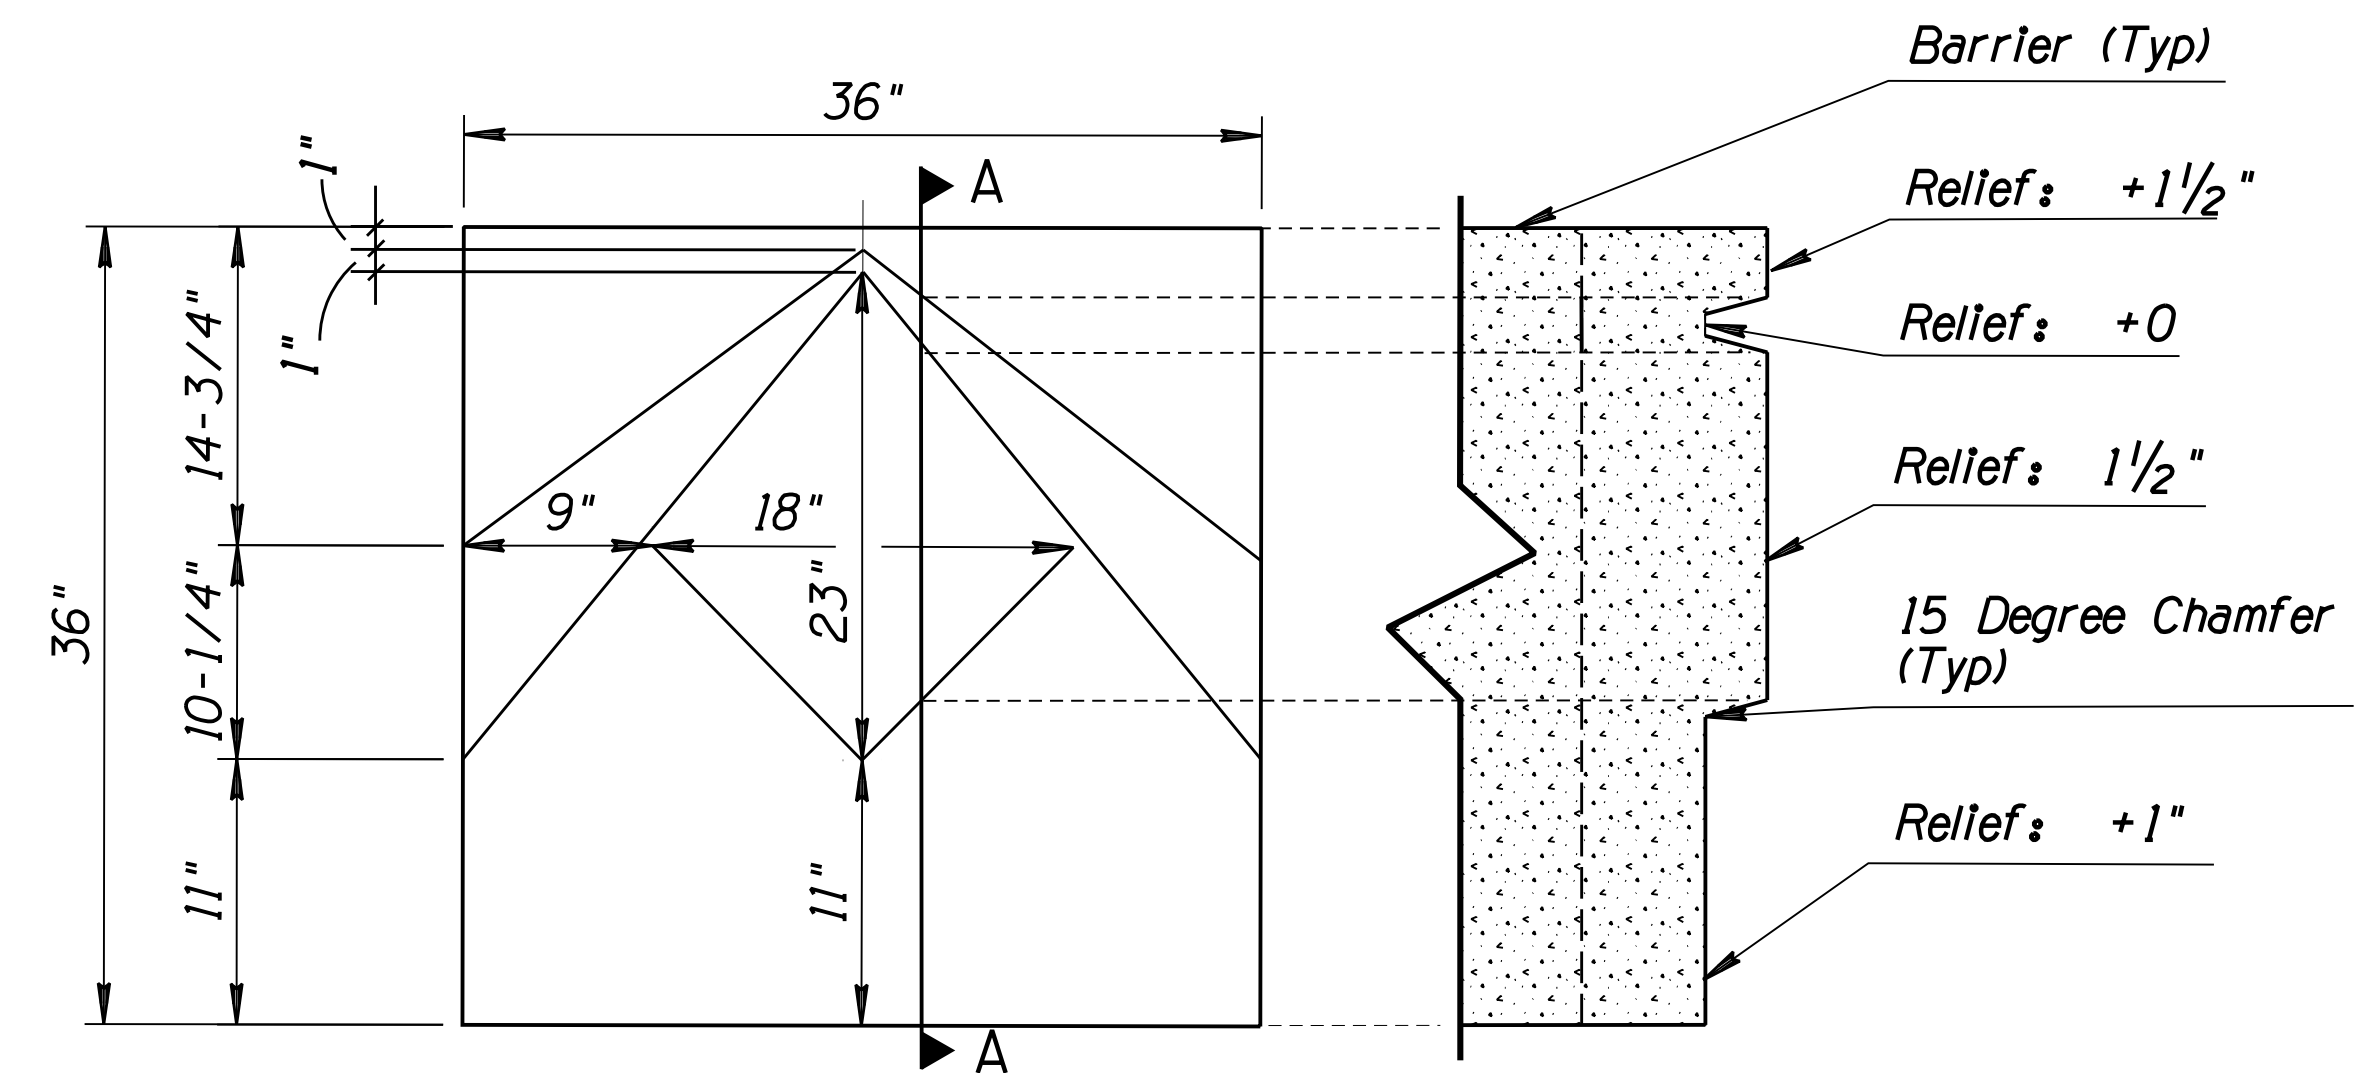

'PUEBLO DECO' FORMLINER - DETAIL & SECTION A-A

NTS

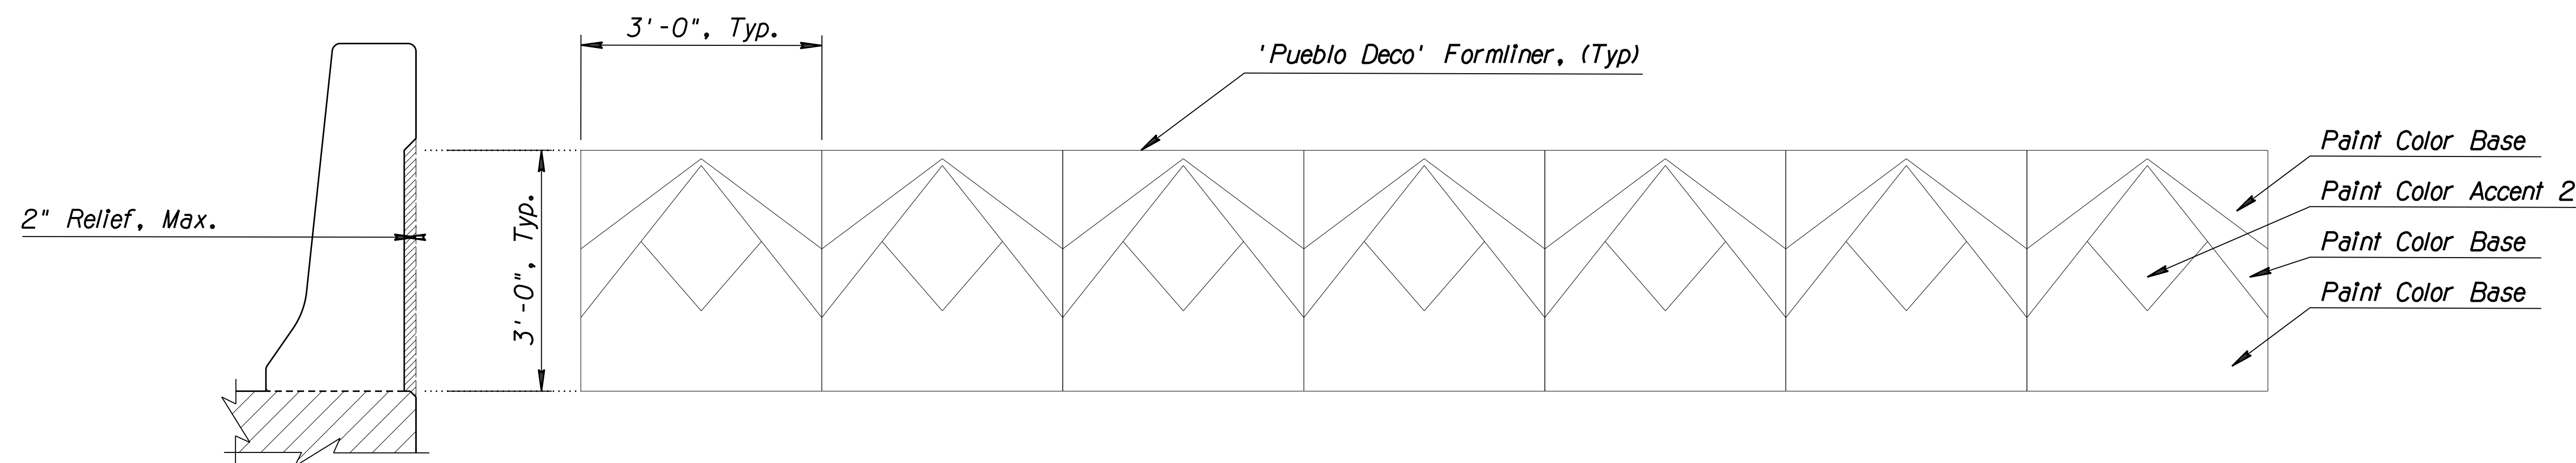

FORMLINER ON F-SHAPE BARRIER (ADOT SD 1.02)

NTS

NOTES:

1. Intent is not to cut any 'Pueblo Deco' formliner in half. Approval of 'Pueblo Deco' layout on Bridge Barrier and F-Shape Barrier is required by ADOT Roadside Development through the ADOT Resident Engineer.
2. Paint colors shown in Architectural Treatment Details is typical paint color for all 'Pueblo Deco' formliners. Refer to Special Provisions for additional paint color information.
3. Relief is measured from the Face of Barrier, which is assigned a depth of +0". The high point of the barrier protrudes from the Face a maximum of +1 1/2".
4. Refer to Bridge Plans for additional Bridge Barrier and F-Shape Barrier Information.
5. Bridge Barrier and F-Shape Barrier shall have Formliner 'Pueblo Deco', maximum relief 1 1/2".


RELIEF LEGEND

- F = Flush
- R1 = Recessed 1/2"
- R2 = Recessed 1"
- R3 = Recessed 1 1/2"
- R4 = Recessed 2"
- R5 = Recessed 2 1/2"
- R6 = Recessed 3"
- R7 = Recessed 3 1/2"
- R8 = Recessed 4"

PAINT LEGEND


- Base: "ADOT Tan" (t
- Accent 1: "Shiitake"
- Accent 2: "Black Dec
- Accent 3: "Iris White"

DESIGN	WDC	DATE	3/19	ARIZONA DEPARTMENT OF TRANSPORTATION INFRASTRUCTURE DELIVERY AND OPERATIONS DIVISION ROADSIDE DEVELOPMENT SECTION
DRAWN	WDC	DATE	3/19	
CHECKED	WDC/LEM	DATE	3/19	
<b>WHEAT DESIGN GROUP</b>		LANDSCAPE ARCHITECTS		ARCHITECTURAL TREATMENT BARRIER DETAILS
500 N. TUCSON BLVD, SUITE 150, TUCSON, AZ 85716				
ROUTE	LOCATION	RUTHRAUFF ROAD TI		EXPIRES 6-30-2019 DWG NO. A-2.04
1-10				
TRACS NO. H 8480 OIC			010-D(213)S	OF

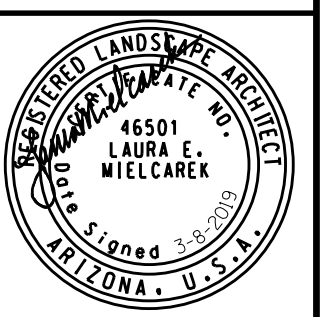


F.H.W.A. REGION	STATE	PROJECT NO.	SHEET NO.	TOTAL SHEETS	RECORD DRAWING
9	ARIZ.	010-D(213)S	739	849	

010 PM 252

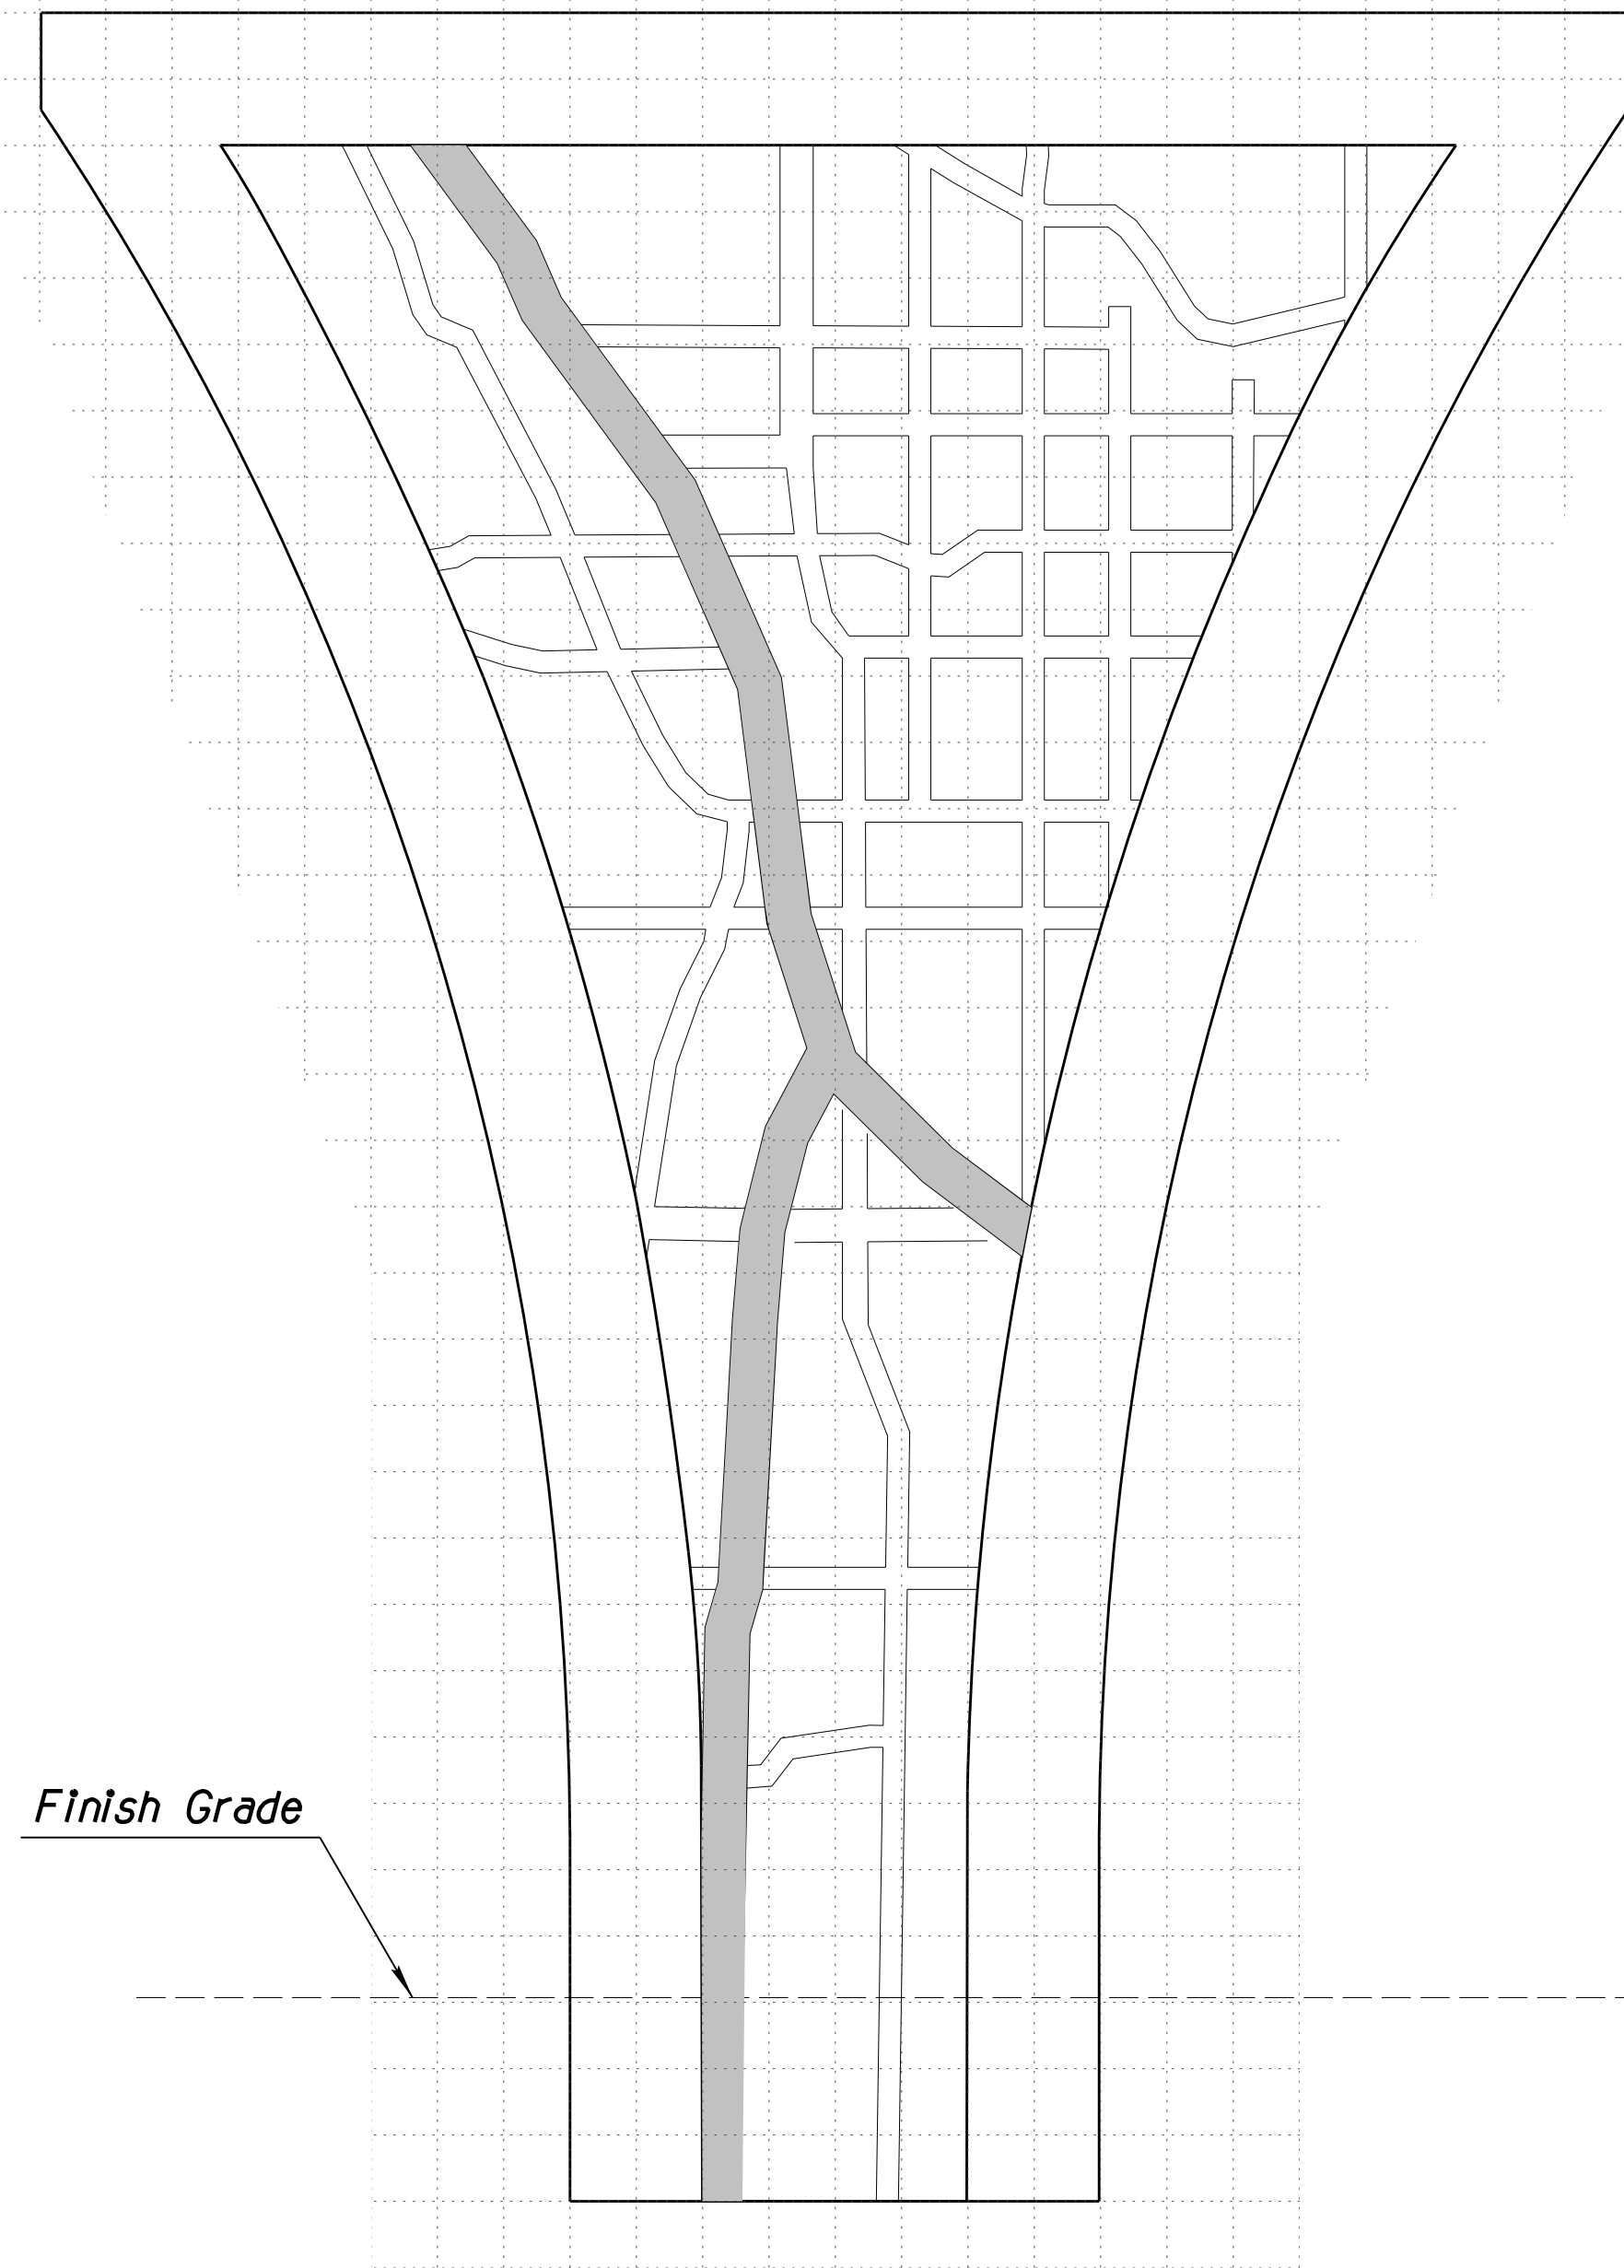


I-10 BRIDGE PIER ELEVATION - 6"x6" GRID

NTS

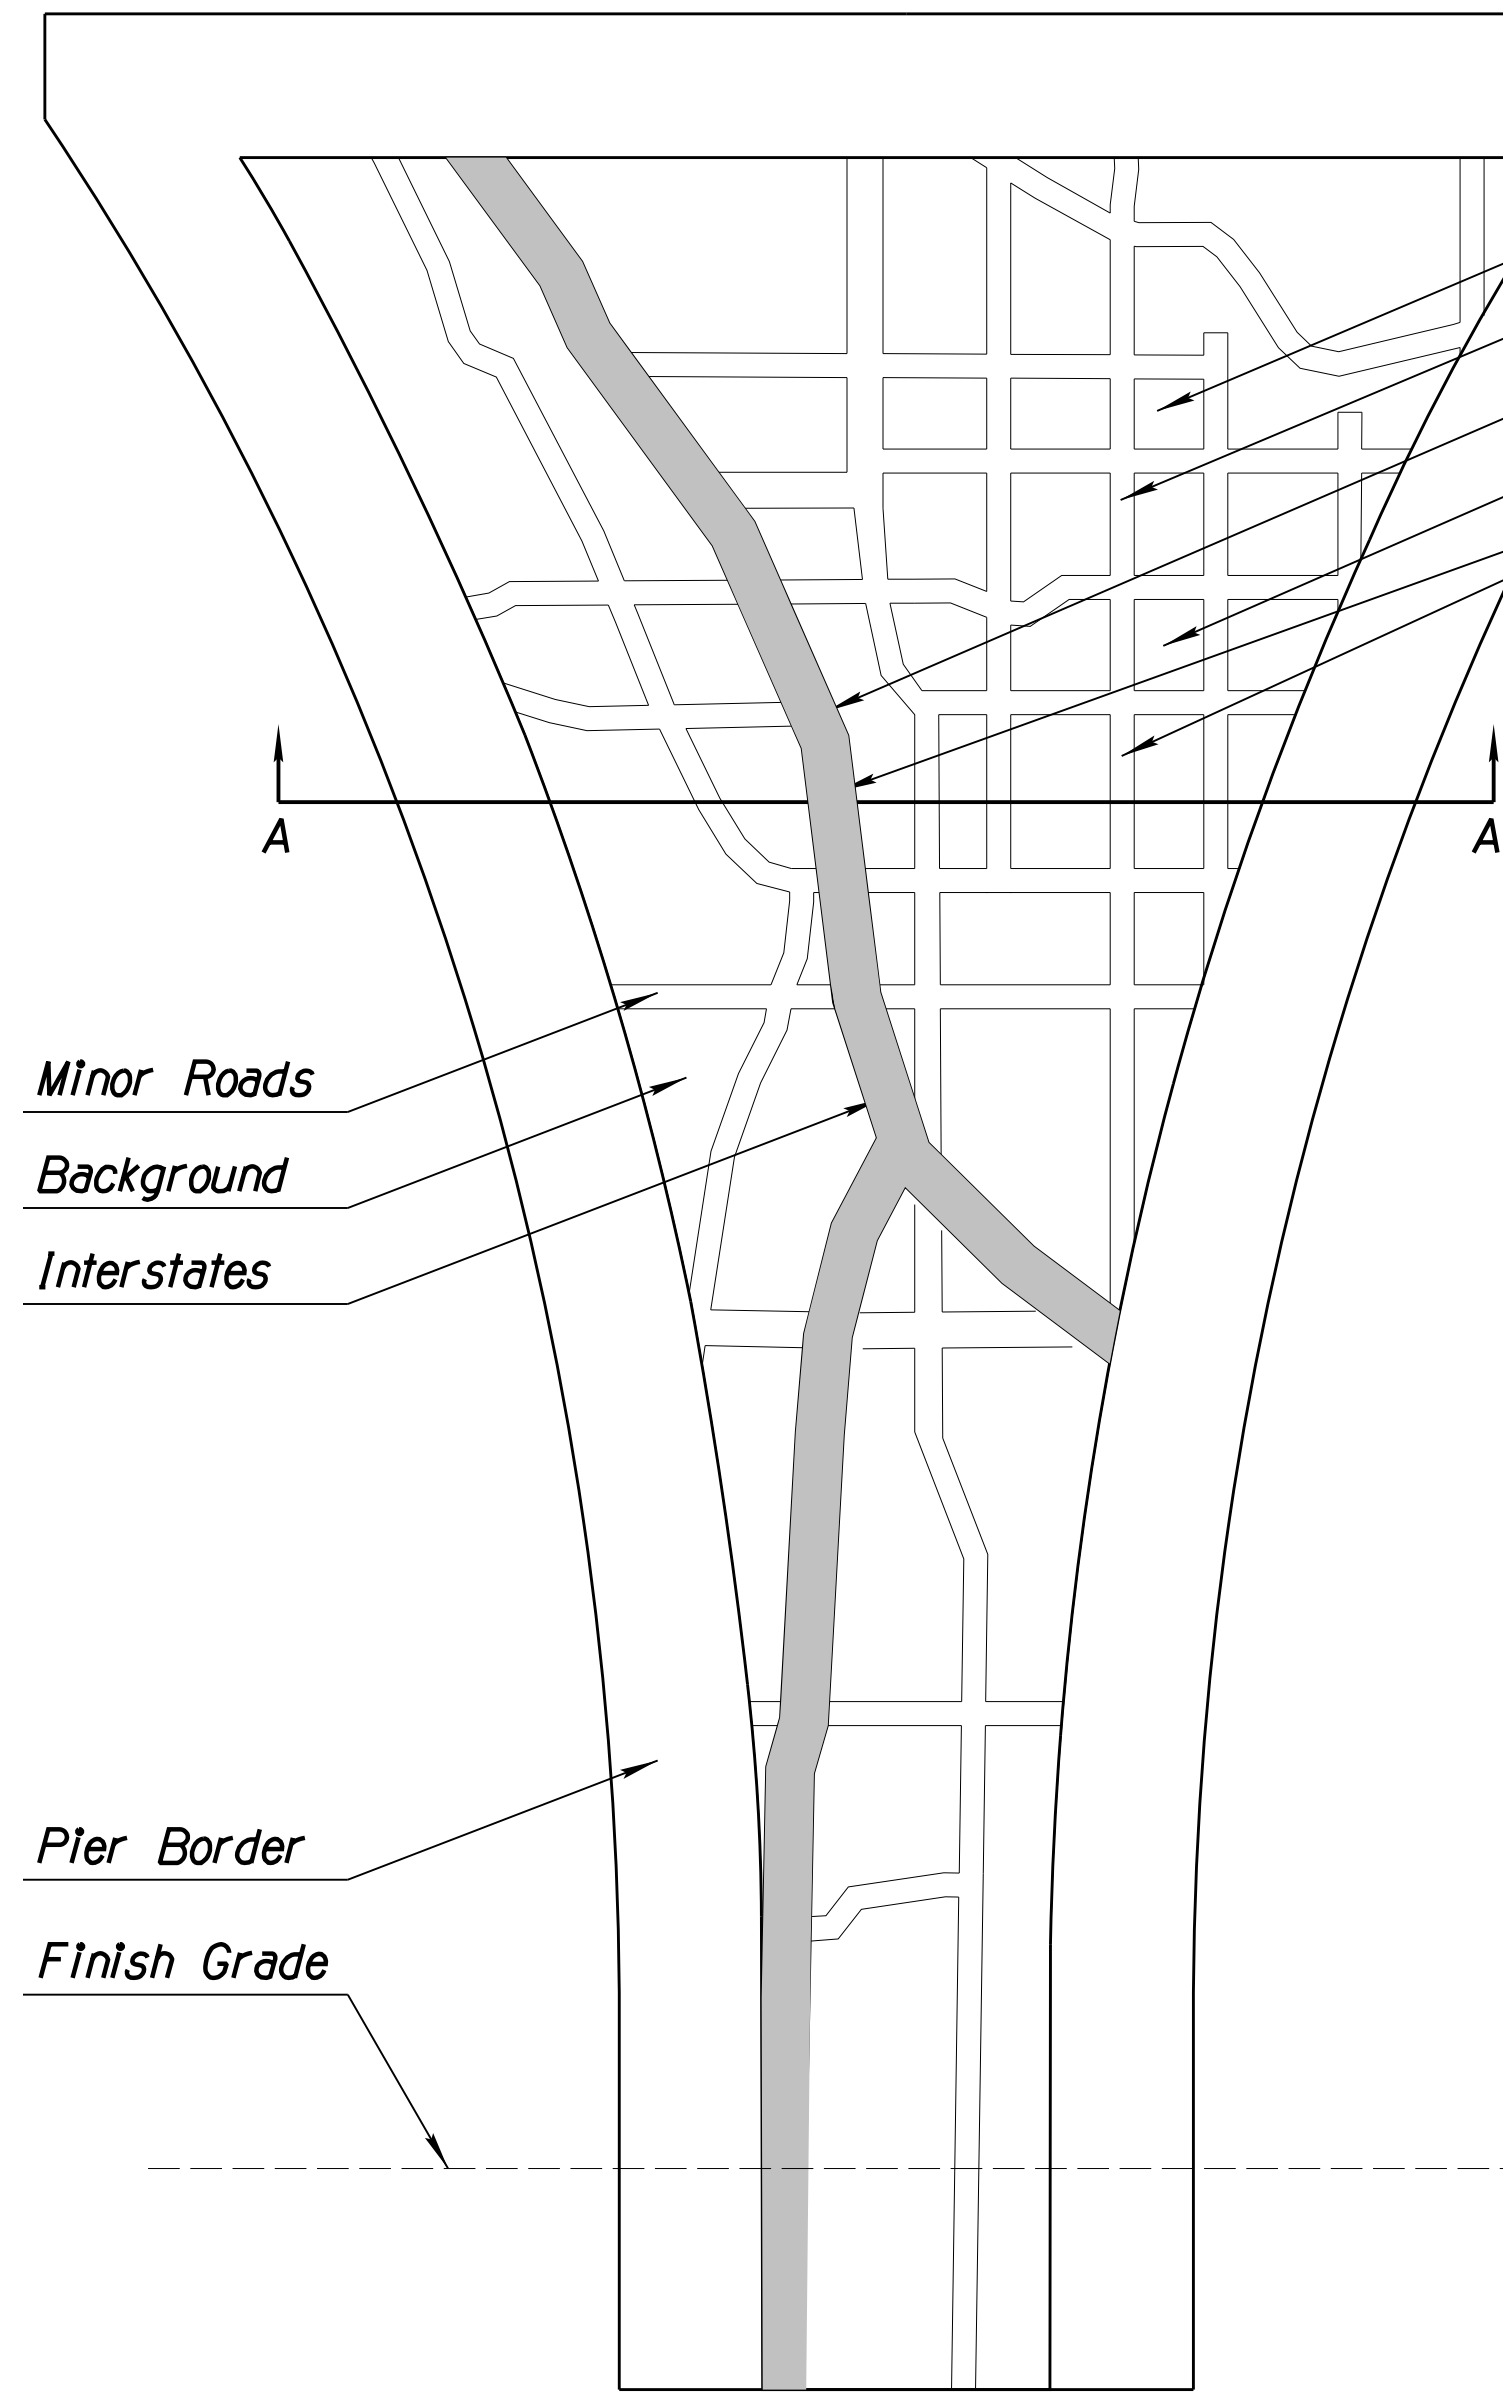

I-10 BRIDGE PIER ELEVATION  
RELIEF AND PAINT

NTS

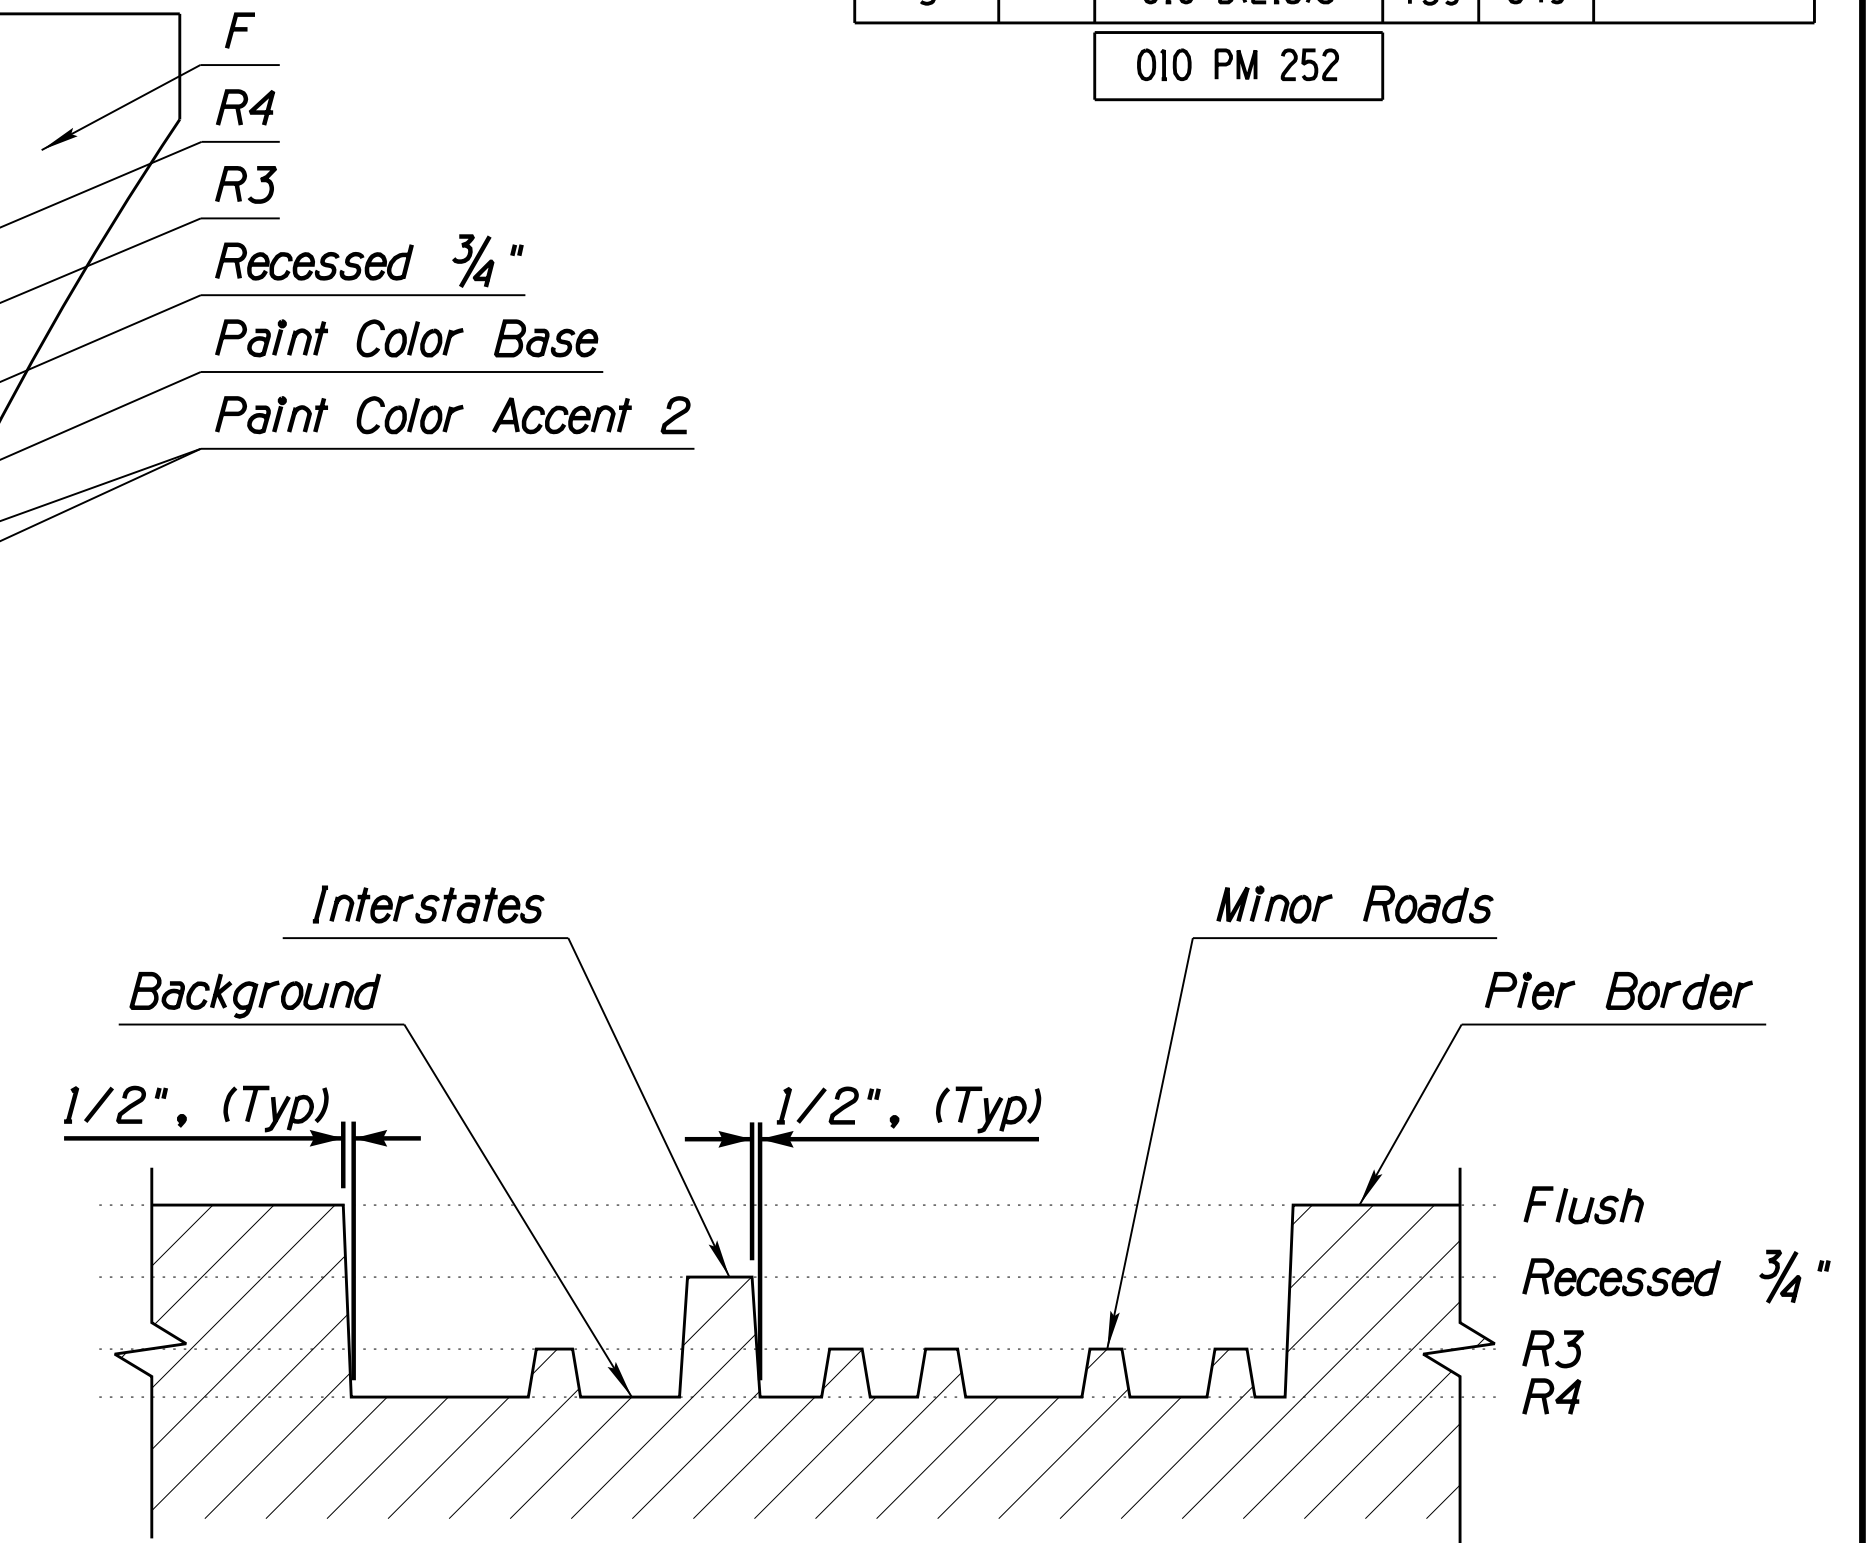

SECTION A-A

NTS

RELIEF LEGEND

- F = Flush
- R1 = Recessed 1/2"
- R2 = Recessed 1"
- R3 = Recessed 1 1/2"
- R4 = Recessed 2"
- R5 = Recessed 2 1/2"
- R6 = Recessed 3"
- R7 = Recessed 3 1/2"
- R8 = Recessed 4"

PAINT LEGEND

- Base: "ADOT Tan" (Flat Finish)
- Accent 1: "Shitake" (Semi-Gloss Finish)
- Accent 2: "Black Deco" (Gloss Finish)
- Accent 3: "Iris White" (Semi-Gloss Finish)

NOTES:

1. Formliner shall extend 2'-0" below finish grade, (Typ).
2. Refer to Structural Plans for additional information.
3. Refer to Special Provisions for additional Paint information.
4. Fabrication of Formliner and Abutment Patterns to be generated from full scale electronic CADD data.


DESIGN	WDC	NAME	DATE	ARIZONA DEPARTMENT OF TRANSPORTATION INFRASTRUCTURE DELIVERY AND OPERATIONS DIVISION ROADSIDE DEVELOPMENT SECTION		
DRAWN	WDC		3/19			
CHECKED	WDC/LEM		3/19			
<b>WHEAT DESIGN GROUP</b> LANDSCAPE ARCHITECTS <small>500 N. TUCSON BLVD, SUITE 150, TUCSON, AZ 85716</small>		<b>ARCHITECTURAL TREATMENT PIER DETAIL</b>		ARCHITECTURAL TREATMENT PIER DETAIL		
ROUTE	I-10	LOCATION	RUTHRAUFF ROAD TI			EXPIRES 6-30-2019
TRACS NO. H 8480 01C		010-D(213)S		DWG NO. A-2.05		
				OF		





F.H.W.A. REGION	STATE	PROJECT NO.	SHEET NO.	TOTAL SHEETS	RECORD DRAWING
9	ARIZ.	010-D(213)S	740	849	

010 PM 252

ξ Brg to ξ Brg = 277'-9 1/4"

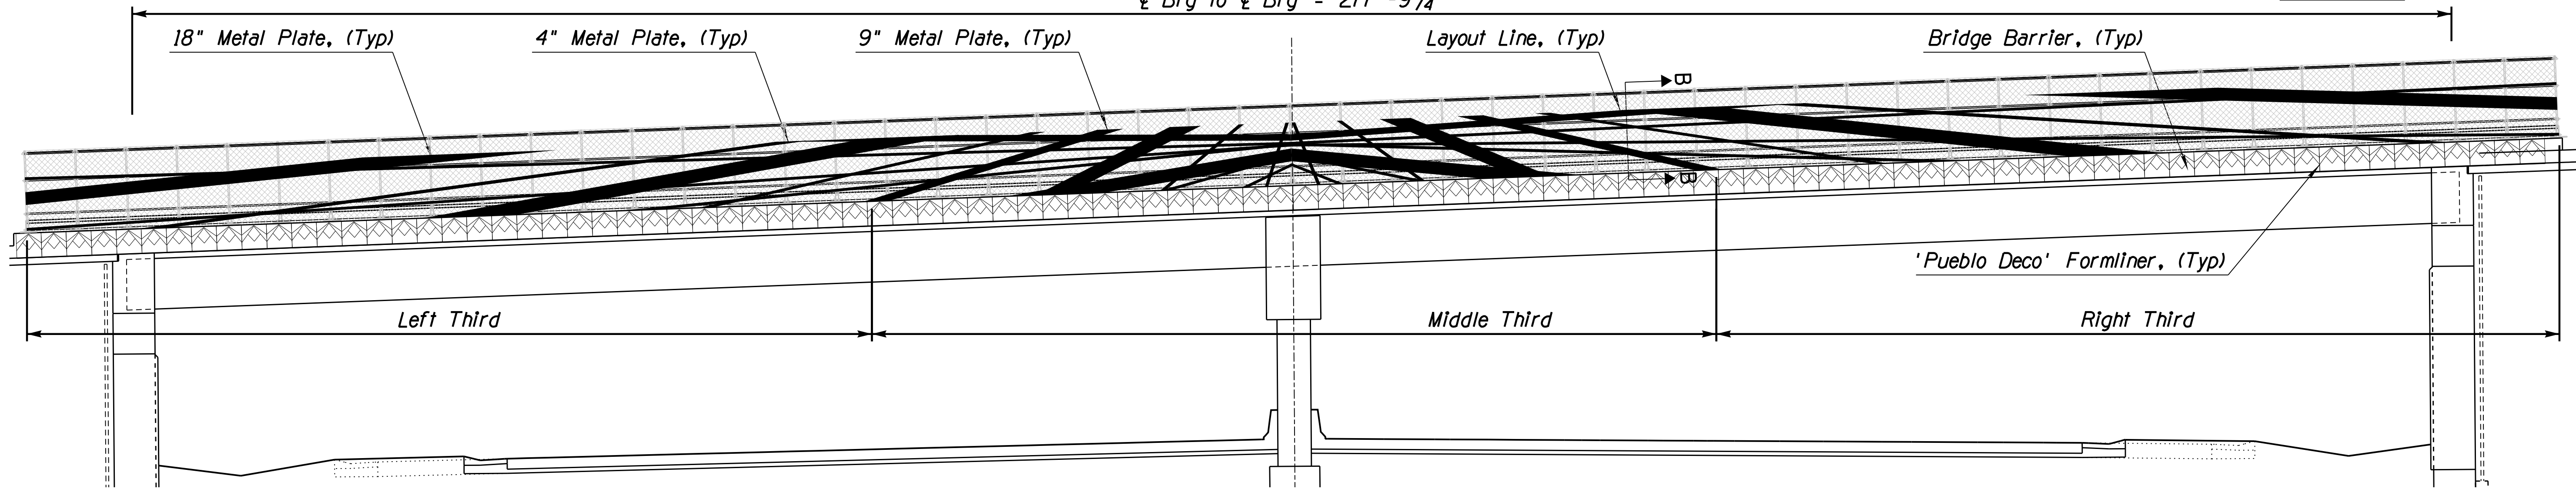


PEDESTRIAN FENCE ELEVATION

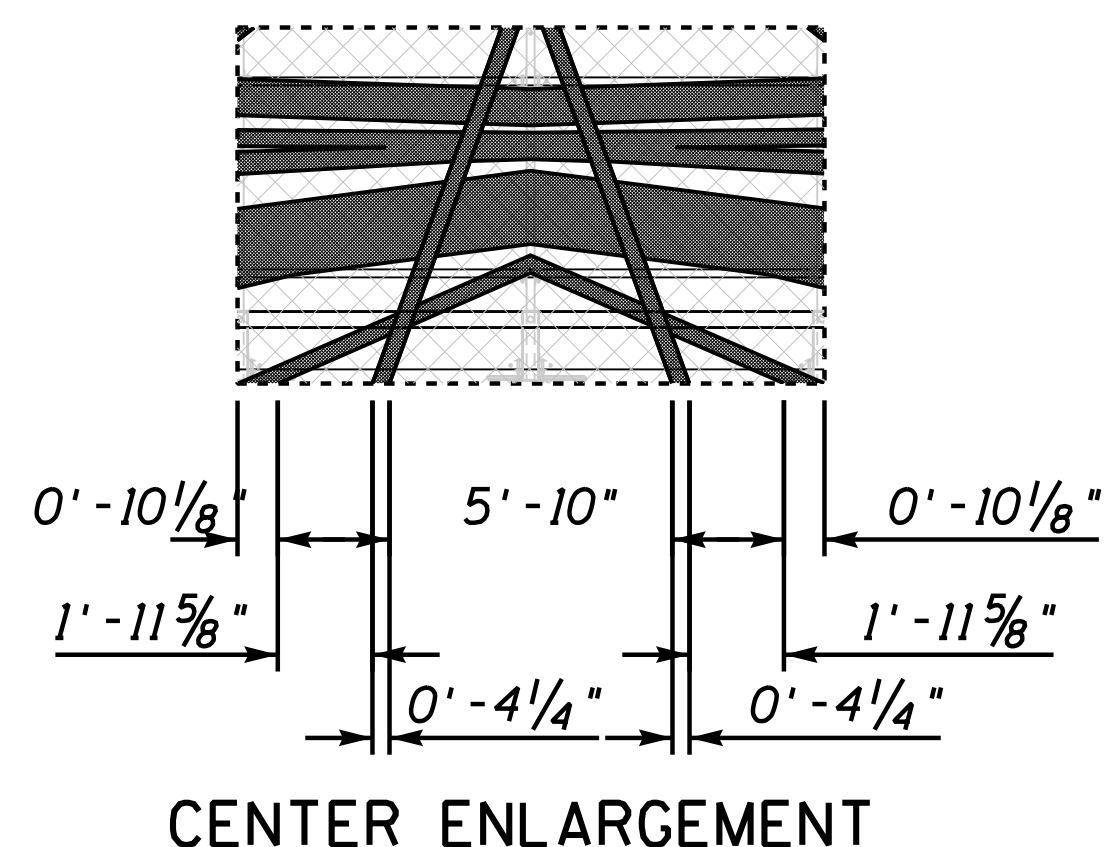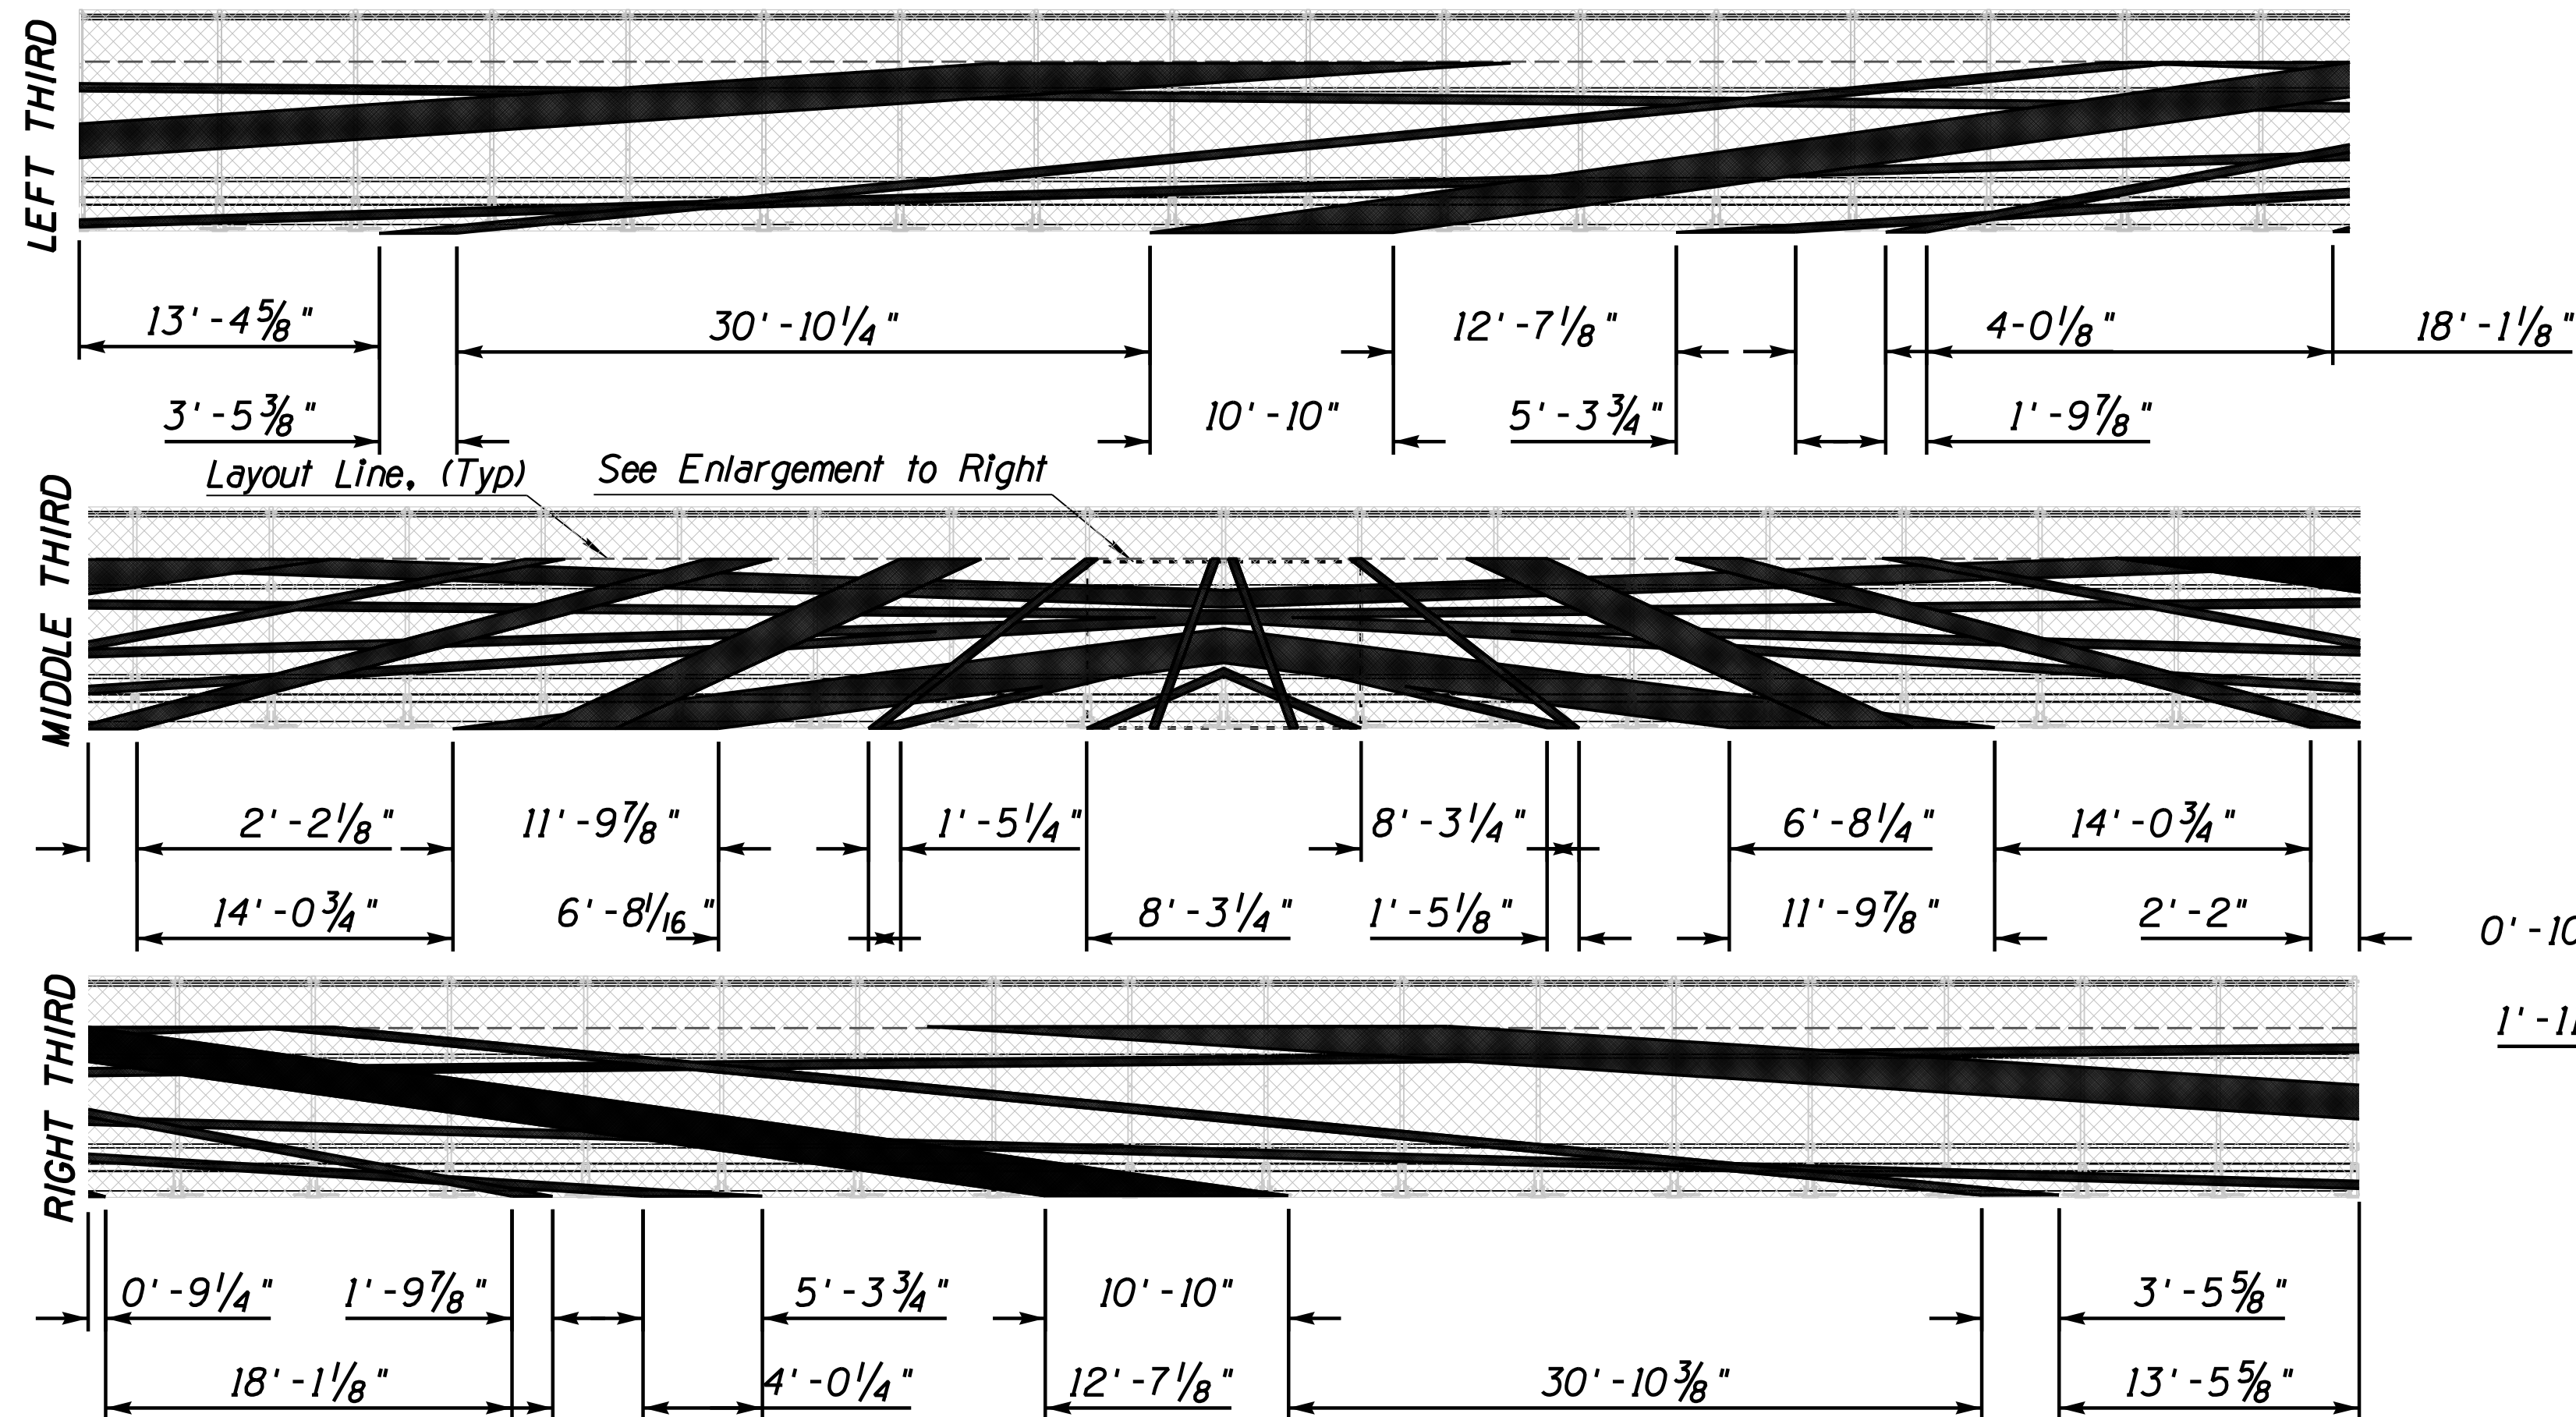

CENTER ENLARGEMENT

SCALE 1"=20'

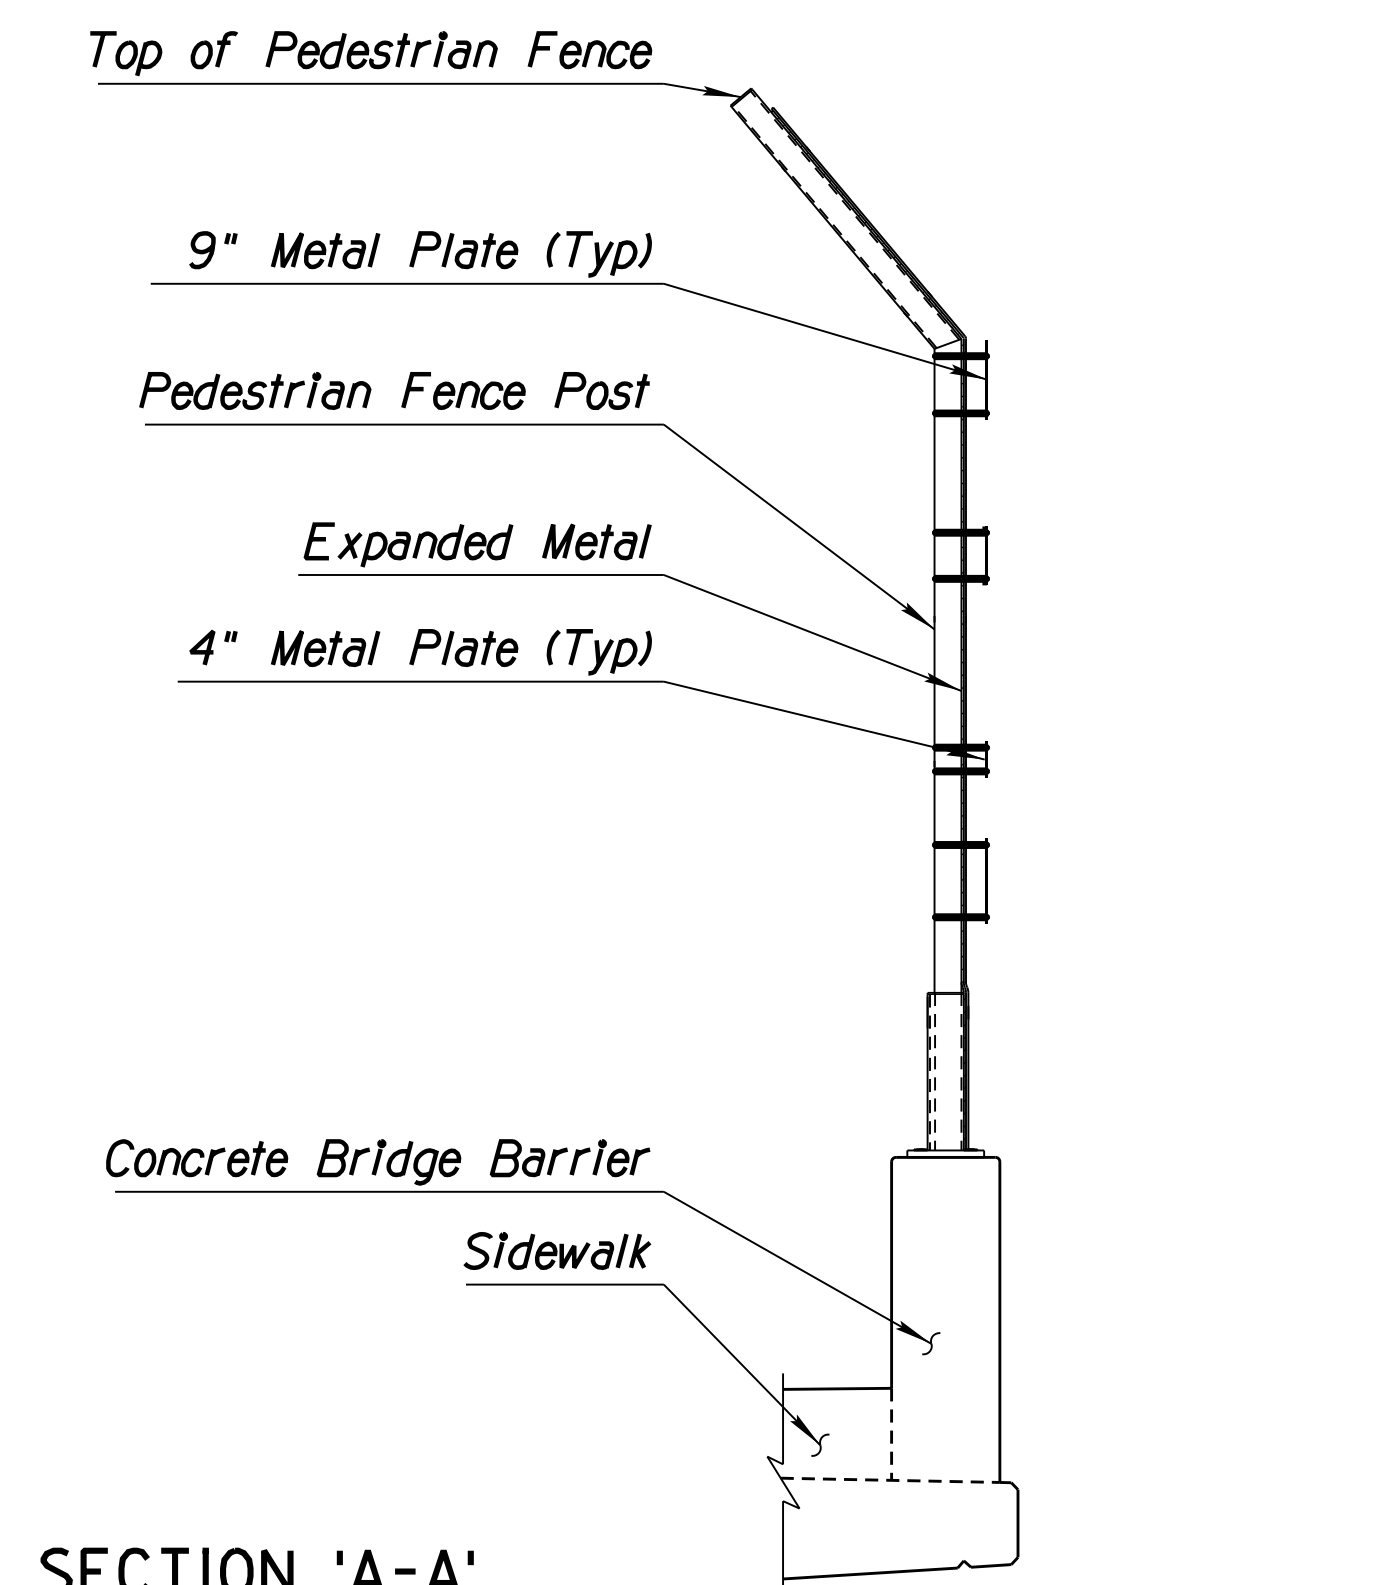

SECTION 'A-A'

NOTE: Section is Schematic. Shop Drawings shall be provided. NTS

GENERAL NOTES:

1. Refer to ADOT Standard Detail SD 1.05 and Bridge Plans for additional information.
2. Dimensions Shown in the Drawings Shall be Used to Construct Architectural Treatments only. Refer to Roadway and Bridge Drawings for Construction Dimensions. The Contractor Shall Notify the Engineer of any Discrepancies Prior to Fabrication of Metal Work.
3. Contractor/Metal Fabricator Shall Provide Samples and Shop Drawings prior to Fabrication. Refer to Special Provisions.
4. Fabrication of Metal Patterns to be generated from full scale electronic CADD data. Refer to Special Provisions.
5. Metal work to be placed on outside of Pedestrian Fence, on both sides of bridges.
6. UPRR Bridge to match Layout of I-10 Bridge. Layout will be cropped to length of UPRR bridge.

DESIGN	WDC	DATE	3/19	ARIZONA DEPARTMENT OF TRANSPORTATION INFRASTRUCTURE DELIVERY AND OPERATIONS DIVISION ROADSIDE DEVELOPMENT SECTION	
DRAWN	WDC	DATE	3/19		
CHECKED	WDC/LEM	DATE	3/19		
<b>WHEAT DESIGN GROUP</b> LANDSCAPE ARCHITECTS <small>500 N TUCSON BLVD, SUITE 150 TUCSON AZ 85716</small>		ARCHITECTURAL TREATMENT FENCE SHEET		EXPIRES 6-30-2019 DWG NO. A-2.06	
ROUTE	LOCATION		RUTHRAUFF ROAD TI		
TRACS NO. H 8480 01C				010-D(213)S	
				OF	

F.H.W.A. REGION	STATE	PROJECT NO.	SHEET NO.	TOTAL SHEETS	RECORD DRAWING
9	ARIZ.	010-D(213)S	741	849	

010 PM 252

**PART 2 - To be completed by ADOT & CONTRACTOR**

[http://www.azdot.gov/Highways/OES/Water\\_Quality/Stormwater/Docs/swppp\\_construction\\_template.dot](http://www.azdot.gov/Highways/OES/Water_Quality/Stormwater/Docs/swppp_construction_template.dot)

**PART 1 - To be completed by the Landscape Architect or Design Engineer**

**I. PROJECT DESCRIPTION**

- A. Owner Name and Address:  
 Arizona Department of Transportation  
 205 South 17th Avenue  
 Phoenix, Arizona 85007-3213
- B. Project TRACS Number: H8480 01D
- C. Project Location: i-10, Ruthrauff Rd. T.I.  
 City: Tucson County: Pima  
 Beginning Latitude (NAD 83): \_\_\_\_\_  
 Beginning Longitude (NAD 83): \_\_\_\_\_  
 Ending Latitude (NAD 83): \_\_\_\_\_  
 Ending Longitude (NAD 83): \_\_\_\_\_  
 To obtain the project latitude/longitude data, refer to the ADOT Web Link below:  
[http://tpd.azdot.gov/website/receiving\\_waters/viewer.htm](http://tpd.azdot.gov/website/receiving_waters/viewer.htm)
- D. Project Description: Construction of new traffic interchange at I-10 and Ruthrauff Road.

**II. HYDROLOGIC INFORMATION**

- A. Project Size:  
 Length (Mi.) 4.7 miles (I-10), 0.77 (Ruthrauff Rd)  
 Area (Ac.) 126 ac.
- B. Area to be Graded (Ac.): \_\_\_\_\_
- C. Percentage of the site that is impervious before and after construction:  
 Percentage before Construction: \_\_\_\_\_  
 Percentage after Construction: \_\_\_\_\_
- D. Receiving Water(s), refer to the same ADOT Web Link above:  
Santa Cruz River

**III. PRESERVATION OF EXISTING VEGETATION**

- A. In accordance with the specifications, existing vegetation will be preserved. Clearing limits shall be confined to areas that require grading. Existing vegetation outside the boundaries of the cleared area shall be protected from damage by construction activities. Existing trees within the area to be cleared shall be preserved and protected, wherever possible.

**IV. SOIL STABILIZATION MEASURES**

- A. All disturbed soil, which will not be paved, riprapped or otherwise covered to prevent erosion, will be revegetated and/or landscaped in accordance with the project plans and specifications.
- B. Scheduling of the revegetation effort can be found on PART 2 of this sheet under SCHEDULE OF MAJOR ACTIVITIES.

**V. MEASURES TO CONTROL EROSION AND SEDIMENT**

- A. Construction (temporary) Erosion and Sediment Controls: (Refer to the Following SWPPP Site Plan and Specifications)
- \_\_\_\_\_ Erosion Control Matting
  - \_\_\_\_\_ Temporary Diversion Dikes
  - \_\_\_\_\_ Check Dams
  - Rock Inlet/Outlet Protection
  - \_\_\_\_\_ Sediment Control Berms
  - \_\_\_\_\_ Silt Fences
  - Wattles (Excelsior/Straw)
  - Excelsior Logs / Sediment Logs
  - Seeding (Class II with mulch)
  - Others Describe: \_\_\_\_\_
- Curb inlet protection
- Stabilized Construction Entrance/Exit Gravel Pad
- B. Post-Construction (permanent) Erosion and Sediment Controls and Storm Water Management Measures: (Refer to SWPPP Site Plan and Specifications)
- \_\_\_\_\_ Crown Ditch/Dike
  - \_\_\_\_\_ Rock Protection
  - \_\_\_\_\_ Rock Riprap Channel Lining
  - \_\_\_\_\_ Sediment Basin
  - \_\_\_\_\_ Embankment Curb
  - \_\_\_\_\_ Spillways and Downdrains
  - \_\_\_\_\_ Minibenching
  - Seeding established as a perennial vegetative cover with a density of 70% of the native background vegetative cover.
  - \_\_\_\_\_ Others Describe: \_\_\_\_\_

**VI. MAINTENANCE AND INSPECTIONS**

- A. Frequency of Inspections:  
 \_\_\_\_\_ At least once every 7 calendar days, OR  
 Every 14 calendar days and within 24 hours after a rainfall of 0.5 inches (12.7 mm) or more.
- NOTE: RAINFALL GAUGE TO BE KEPT ON-SITE TO DETERMINE DEPTH OF RAINFALL
- B. Inspection Procedure:  
 ADOT's Contractor's Inspection Log and Compliance Evaluation Report (CER) will be completed by the contractor or his representative and will be kept on file for 3 years. A signed copy of the CER will be sent to the ADOT resident engineer. If repairs are necessary, they shall be initiated within 24 hours of the inspection report.

**I. SCHEDULE OF MAJOR ACTIVITIES**

- A. Project Schedule: \_\_\_\_\_  
 Start Date: \_\_\_\_\_  
 End Date: \_\_\_\_\_
- B. Construction Sequencing Schedule: (Attach Additional Sheets) Construction Activities \_\_\_\_\_

**II. INVENTORY OF POLLUTANTS**

- A. The materials or substances checked below are expected to be onsite during construction:
- \_\_\_\_\_ Concrete \_\_\_\_\_ Asphalt
  - \_\_\_\_\_ Paints \_\_\_\_\_ Fertilizer
  - \_\_\_\_\_ Herbicides \_\_\_\_\_ Wood
  - \_\_\_\_\_ Fuel \_\_\_\_\_ Oil
  - \_\_\_\_\_ Others, List: \_\_\_\_\_

**III. POLLUTION CONTROL MEASURES**

- A. Other Best Management Practices:
- \_\_\_\_\_ Wind Erosion and Dust Control
  - \_\_\_\_\_ Solid Waste Management
  - \_\_\_\_\_ Equipment Maintenance Procedures
  - \_\_\_\_\_ Designated Washout Areas
  - \_\_\_\_\_ Stabilized Construction Entrance
  - \_\_\_\_\_ Protected Chemical and Material Storage Area
  - \_\_\_\_\_ Other, Describe: \_\_\_\_\_

**IV. SPILL PREVENTION AND RESPONSE**

- A. Spill Prevention:  
 The procedures outlined in the Best Management Practices listed under Pollution Control Measures will be followed to prevent and contain spills of hazardous material. These preventative action include BMP's on equipment maintenance and proper handling, storage and disposal of chemicals and materials. All manufacturer's recommendations for usage, clean-up and disposal shall be followed.
- B. Spill Response:  
 In the event of any accidental spill of chemicals or hazardous materials, contact the ADOT Traffic Operations Center at 800-379-3701. If a reportable quantity is discharged into the storm water, ADOT shall contact the National Response Center and document the spill to the EPA. ADOT's Hazardous Materials Specialist shall provide instructions.

**V. CERTIFICATION OF COMPLIANCE WITH FEDERAL, STATE AND LOCAL REGULATIONS**

- A. This Storm Water Pollution Prevention Plan (SWPPP) has been prepared in accordance with the latest updated version of ADOT's EROSION AND POLLUTION CONTROL MANUAL FOR HIGHWAY DESIGN AND CONSTRUCTION, published by ADOT Intermodal Transportation Division.
- \_\_\_\_\_ SWPPP is in compliance with other Federal, State Laws, or Local Regulations.

**VI. POLLUTION PREVENTION PLAN CERTIFICATION**

- A. I certify under penalty of law that I have personally examined and am familiar with the information submitted in this application and all attachments and that, based on my inquiry of those persons immediately responsible for obtaining the information contained in the application, I believe that the information is true, accurate and complete. I am aware that there are significant penalties for submitting false information, including the possibility of fine and imprisonment. (Applies to VI. B., C., and D)
- B. The operator/contractor as defined in AZPDES should sign the SWPPP in accordance with CGP Part VII. K, and retain the SWPPP on-site at the construction site or other location easily accessible during normal business hours.
- Signature: (operator/contractor) \_\_\_\_\_  
 Date: \_\_\_\_\_  
 Name: \_\_\_\_\_  
 Title: \_\_\_\_\_  
 Company: \_\_\_\_\_

**C. ADOT Resident Engineer**

- Signature: (owner) \_\_\_\_\_  
 Date: \_\_\_\_\_  
 Name: \_\_\_\_\_  
 Title: \_\_\_\_\_  
 ADOT District: \_\_\_\_\_

**D. MUNICIPALITY for Municipal Separate Storm Sewer System (MS4)**

- Signature: \_\_\_\_\_  
 Date: \_\_\_\_\_  
 Name: \_\_\_\_\_  
 Title: \_\_\_\_\_  
 MS4 Name: \_\_\_\_\_

**VII. OTHER REQUIREMENTS**

- A. A copy of the General Permit and NOI are attached in accordance to AZPDES General Permit Storm Water Discharges From Construction Activities To The Water Of The United States.
- B. Projects that are within 1/4 mile of impaired or unique waters require the SWPPP to be sent to ADEQ in combination with the NOI. To check the ADOT Outstanding, Impaired and Not-attaining Waters Interactive Web Map, please turn on the Buffers and Mile Markers Layers:  
[http://www.azdot.gov/inside\\_azdot/OES/Water\\_Quality/Stormwater/outstanding\\_unique\\_waters\\_maps\\_by\\_county.asp](http://www.azdot.gov/inside_azdot/OES/Water_Quality/Stormwater/outstanding_unique_waters_maps_by_county.asp)
- C. For further requirements, check the ADEQ's Smart NOI Web Page: <https://az.gov/webapp/noi>

DESIGN	WDC	3/19	ARIZONA DEPARTMENT OF TRANSPORTATION INFRASTRUCTURE DELIVERY AND OPERATIONS DIVISION ROADSIDE DEVELOPMENT SECTION <b>STORMWATER QUALITY PROTECTION &amp; EROSION/SEDIMENT CONTROL AZDES SWPPP INDEX SHEET</b>	
DRAWN	WDC	3/19		
CHECKED	WDC/LEM	3/19		
<b>WHEAT DESIGN GROUP</b> LANDSCAPE ARCHITECTS <small>500 N TUCSON BLVD, SUITE 150, TUCSON AZ 85716</small>		<b>RUTHRAUFF ROAD TI</b>		EXPIRES 6-30-2019 DWG NO. E-1.01
ROUTE	I-10	LOCATION		
TRACS NO. H 8480 01C		010-D(213)S		OF

DATE- LOCATION- REVISIONS- FINISHED PLANS- SURVEY NO.



F.H.W.A. REGION	STATE	PROJECT NO.	SHEET NO.	TOTAL SHEETS	RECORD DRAWING
9	ARIZ.	010-D(213)S	742	849	


010 PM 252

**EROSION AND SEDIMENT CONTROL BMP  
SUMMARY OF QUANTITIES**

SYMBOL	BMP	UNIT	QTY.	REFERENCE	ITEM NO.
-----	9" Dia. Sediment Wattle	LF	30,951	Detail ES1	8101021
-----	20" Dia. Sediment Wattle	LF	15,054	Detail ES1	8101014
—○—	20" Dia. Sediment Log	LF	1,160	Detail ES2	8101035
□	Storm Drain Inlet Protection 20" Dia. Sediment Log Rock Mulch Gradation C	LF CY	2,914 174	Detail ES3 Detail ES2 Detail ES4	8101035 8101029
∪	Headwall Protection Rock Mulch Gradation C	CY	56	Detail ES4	8101029
—	Catch Basin Protection Fabric Filter	SY	314	Refer to Item 8101018 of the Special Provisions	8101018
▨	Seed Mix (Class II)	AC	13	Refer to Item 8050003 of the Special Provisions	8050003
Not Shown on Plans	Stabilized Construction Entrance/Exit Gravel Pad	SY	1,250	Detail ES5 Refer to Item 8101030 of the Special Provisions	8101030
←	Flow Arrow	N/A	N/A	N/A	N/A

**GENERAL NOTES:**


- Right-of-Way and easements are the Limits of Disturbance, or Project Limits. Areas outside the Project Limits shall remain undisturbed. Any project related activities or disturbance beyond the project limits will require historic preservation and cultural resources compliance to have been included before any disturbance can occur outside the project limits. The Plans and NOI must be updated accordingly and reflect additional BMPs.
- Apply seed mix per Erosion & Pollution Control plans.
- Seeding limits shown on plans are estimated on anticipated limits of soil disturbance. Seeding shall be field adjusted to match limits of soil disturbance.
- Sediment Logs/Wattles shall be installed on slopes, per Erosion & Sediment Control plans, and per Detail ES1 & ES2.
- 20" Sediment Logs shall be placed every 150 feet on center where indicated on the Erosion & Pollution Control plans, unless otherwise noted.
- All Erosion Control Measures shall be installed within 14 days of establishing rough grade.
- Disturbed areas where construction is delayed for more than 14 days require Temporary Erosion Control Measures.
- 20" diameter sediment logs shall be used for curb opening catch basins and fabric filter shall be used for grated catch basins. Refer to plans for locations.
- Sediment Control Measures shall be installed on all side slope boundaries in lieu of sediment basins.
- Ends of Wattles shall be turned at a 45 Degree Angle Upslope, 3' min., Typ.
- Refer to Drainage Plans for permanent erosion control structures.
- Contractor shall determine final location of Stabilized Construction Entrances according to site conditions and/or construction sequencing, with approval from the Engineer. Use of other access points must be approved by the Engineer.
- Sweeping and/or vacuuming may be required as a secondary measure if trackout is visible.
- Containment Areas shall be identified on contractor's Stormwater Pollution Prevention Plan.
- Spill response equipment shall be accessible in case of a spill, and located within/near the Containment Area.
- There are no wetlands within the limits of the project, or adjacent to the project.
- Refer to Civil Plans and Typical Section for Topsoil Plating locations.
- Quantities shown in Summary of Quantities are for contractor convenience. Contractor to verify all quantities.

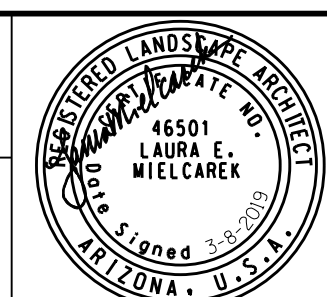DESIGN	WDC	3/19	ARIZONA DEPARTMENT OF TRANSPORTATION INFRASTRUCTURE DELIVERY AND OPERATIONS DIVISION ROADSIDE DEVELOPMENT SECTION	
DRAWN	WDC	3/19		
CHECKED	WDC/LEM	3/19		
<b>WHEAT DESIGN GROUP</b> LANDSCAPE ARCHITECTS <small>500 N TUCSON BLVD, SUITE 150, TUCSON AZ 85716</small>			<b>STORMWATER QUALITY PROTECTION &amp; EROSION/SEDIMENT CONTROL SUMMARY SHEET</b>	
ROUTE	LOCATION		EXPIRES 6-30-2019	
I-10	RUTHRAUFF ROAD TI		DWG NO. E-1.02	
TRACS NO. H 8480 01C			010-D(213)S	OF




F.H.W.A. REGION	STATE	PROJECT NO.	SHEET NO.	TOTAL SHEETS	RECORD DRAWING
9	ARIZ.	010-D(213)S	743	849	

010 PM 252

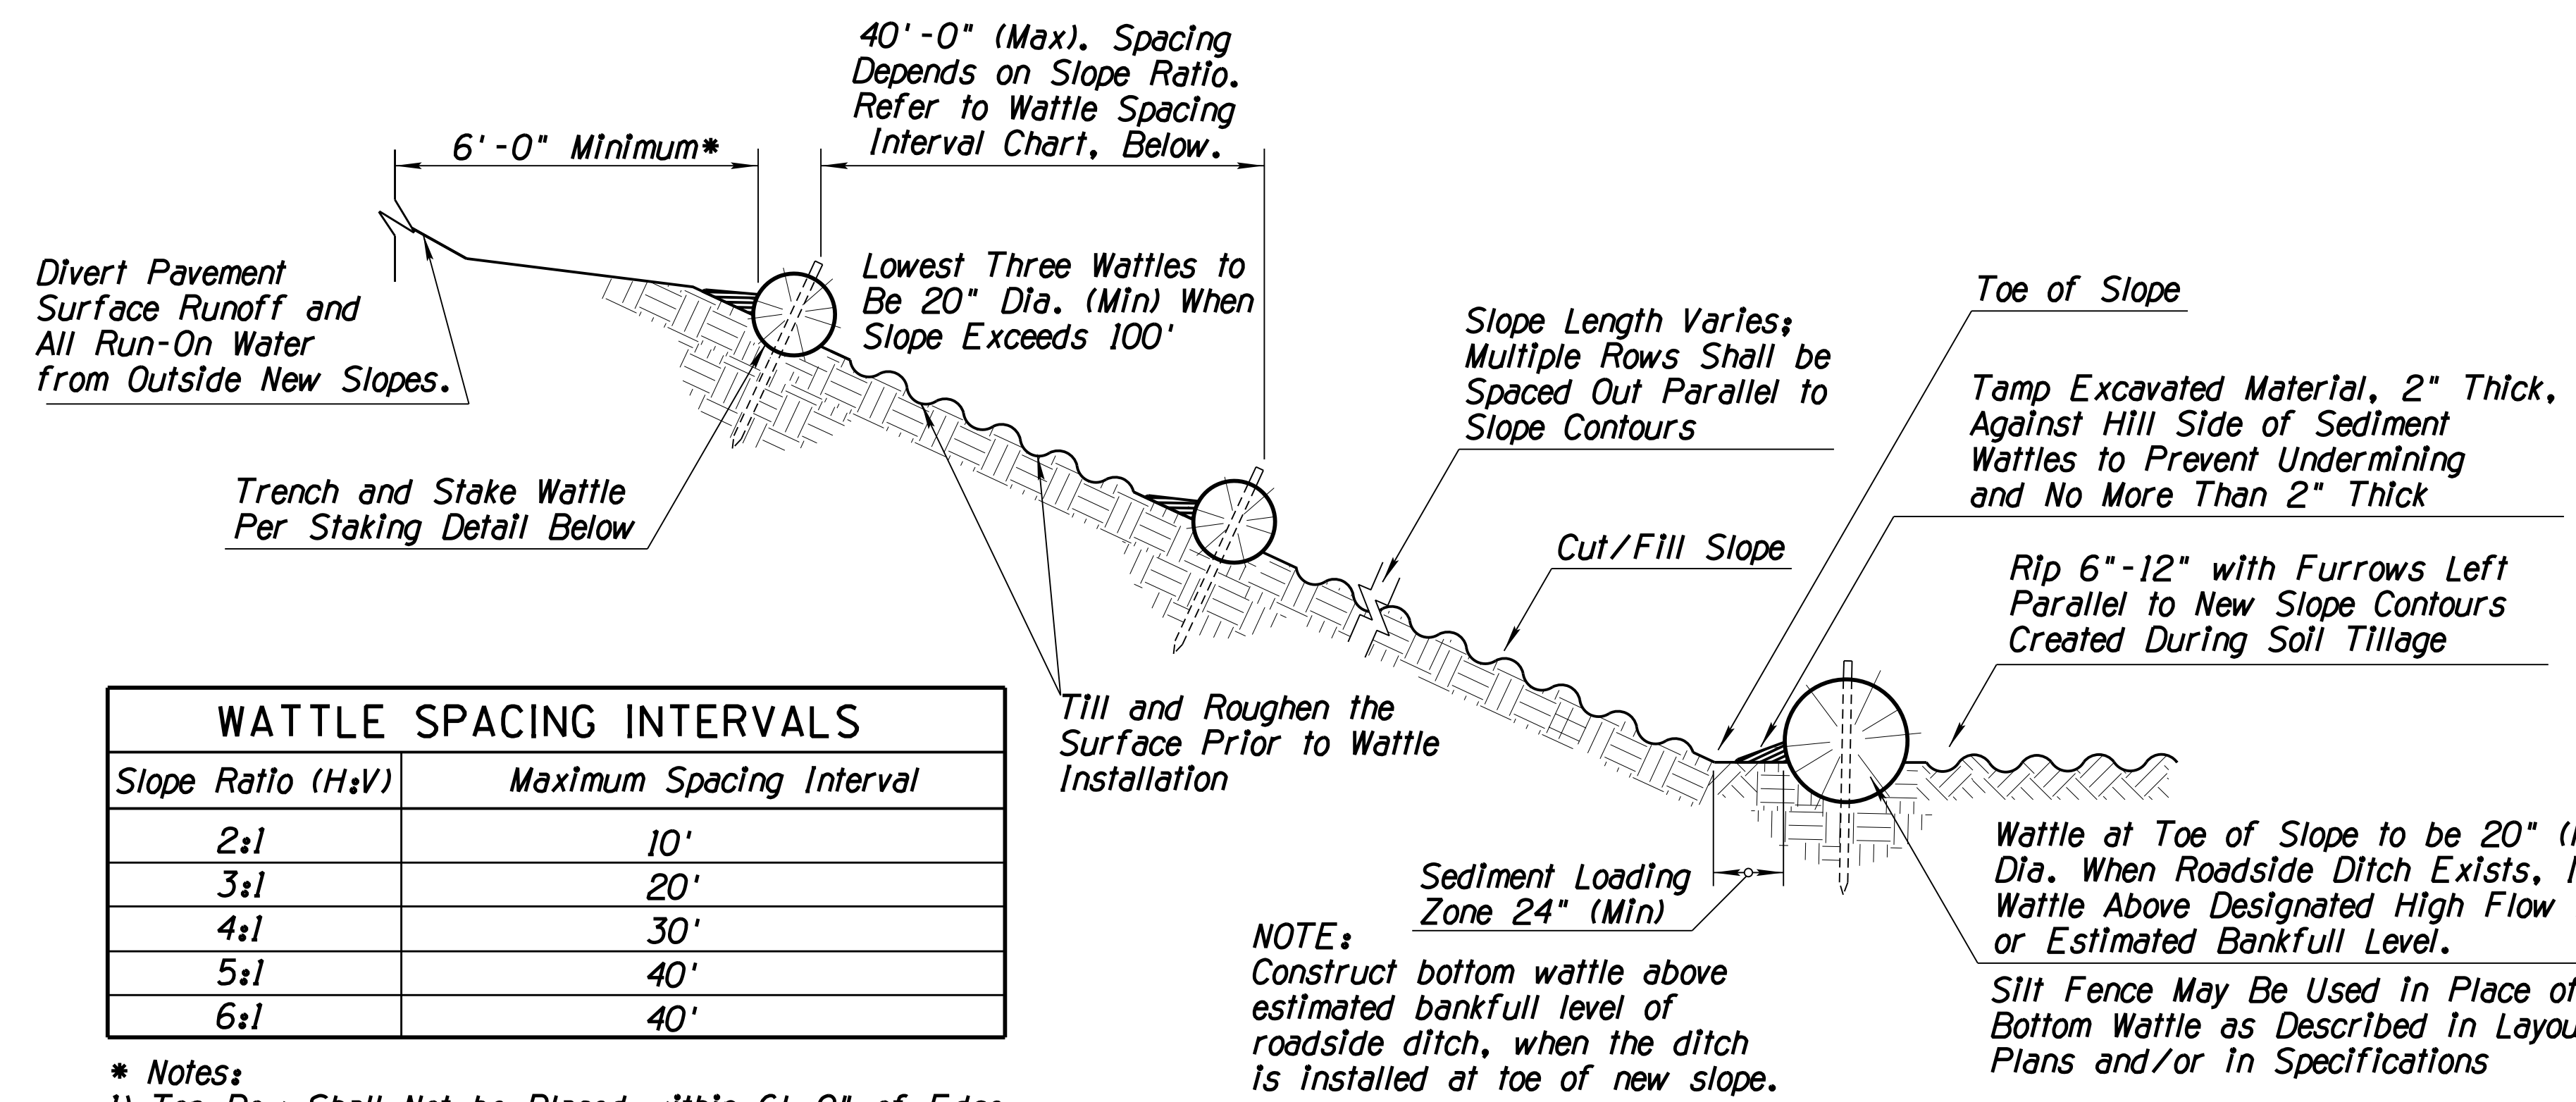


WATTLE SPACING INTERVALS	
Slope Ratio (H:V)	Maximum Spacing Interval
2:1	10'
3:1	20'
4:1	30'
5:1	40'
6:1	40'


- \* Notes:
- 1) Top Row Shall Not be Placed within 6'-0" of Edge of Pavement and 9'-0" from Outside Surface of Barrier.
  - 2) For erosive soils, place rows of wattles closer together.
  - 3) For soils with low erosive potential, place rows of wattles further apart.

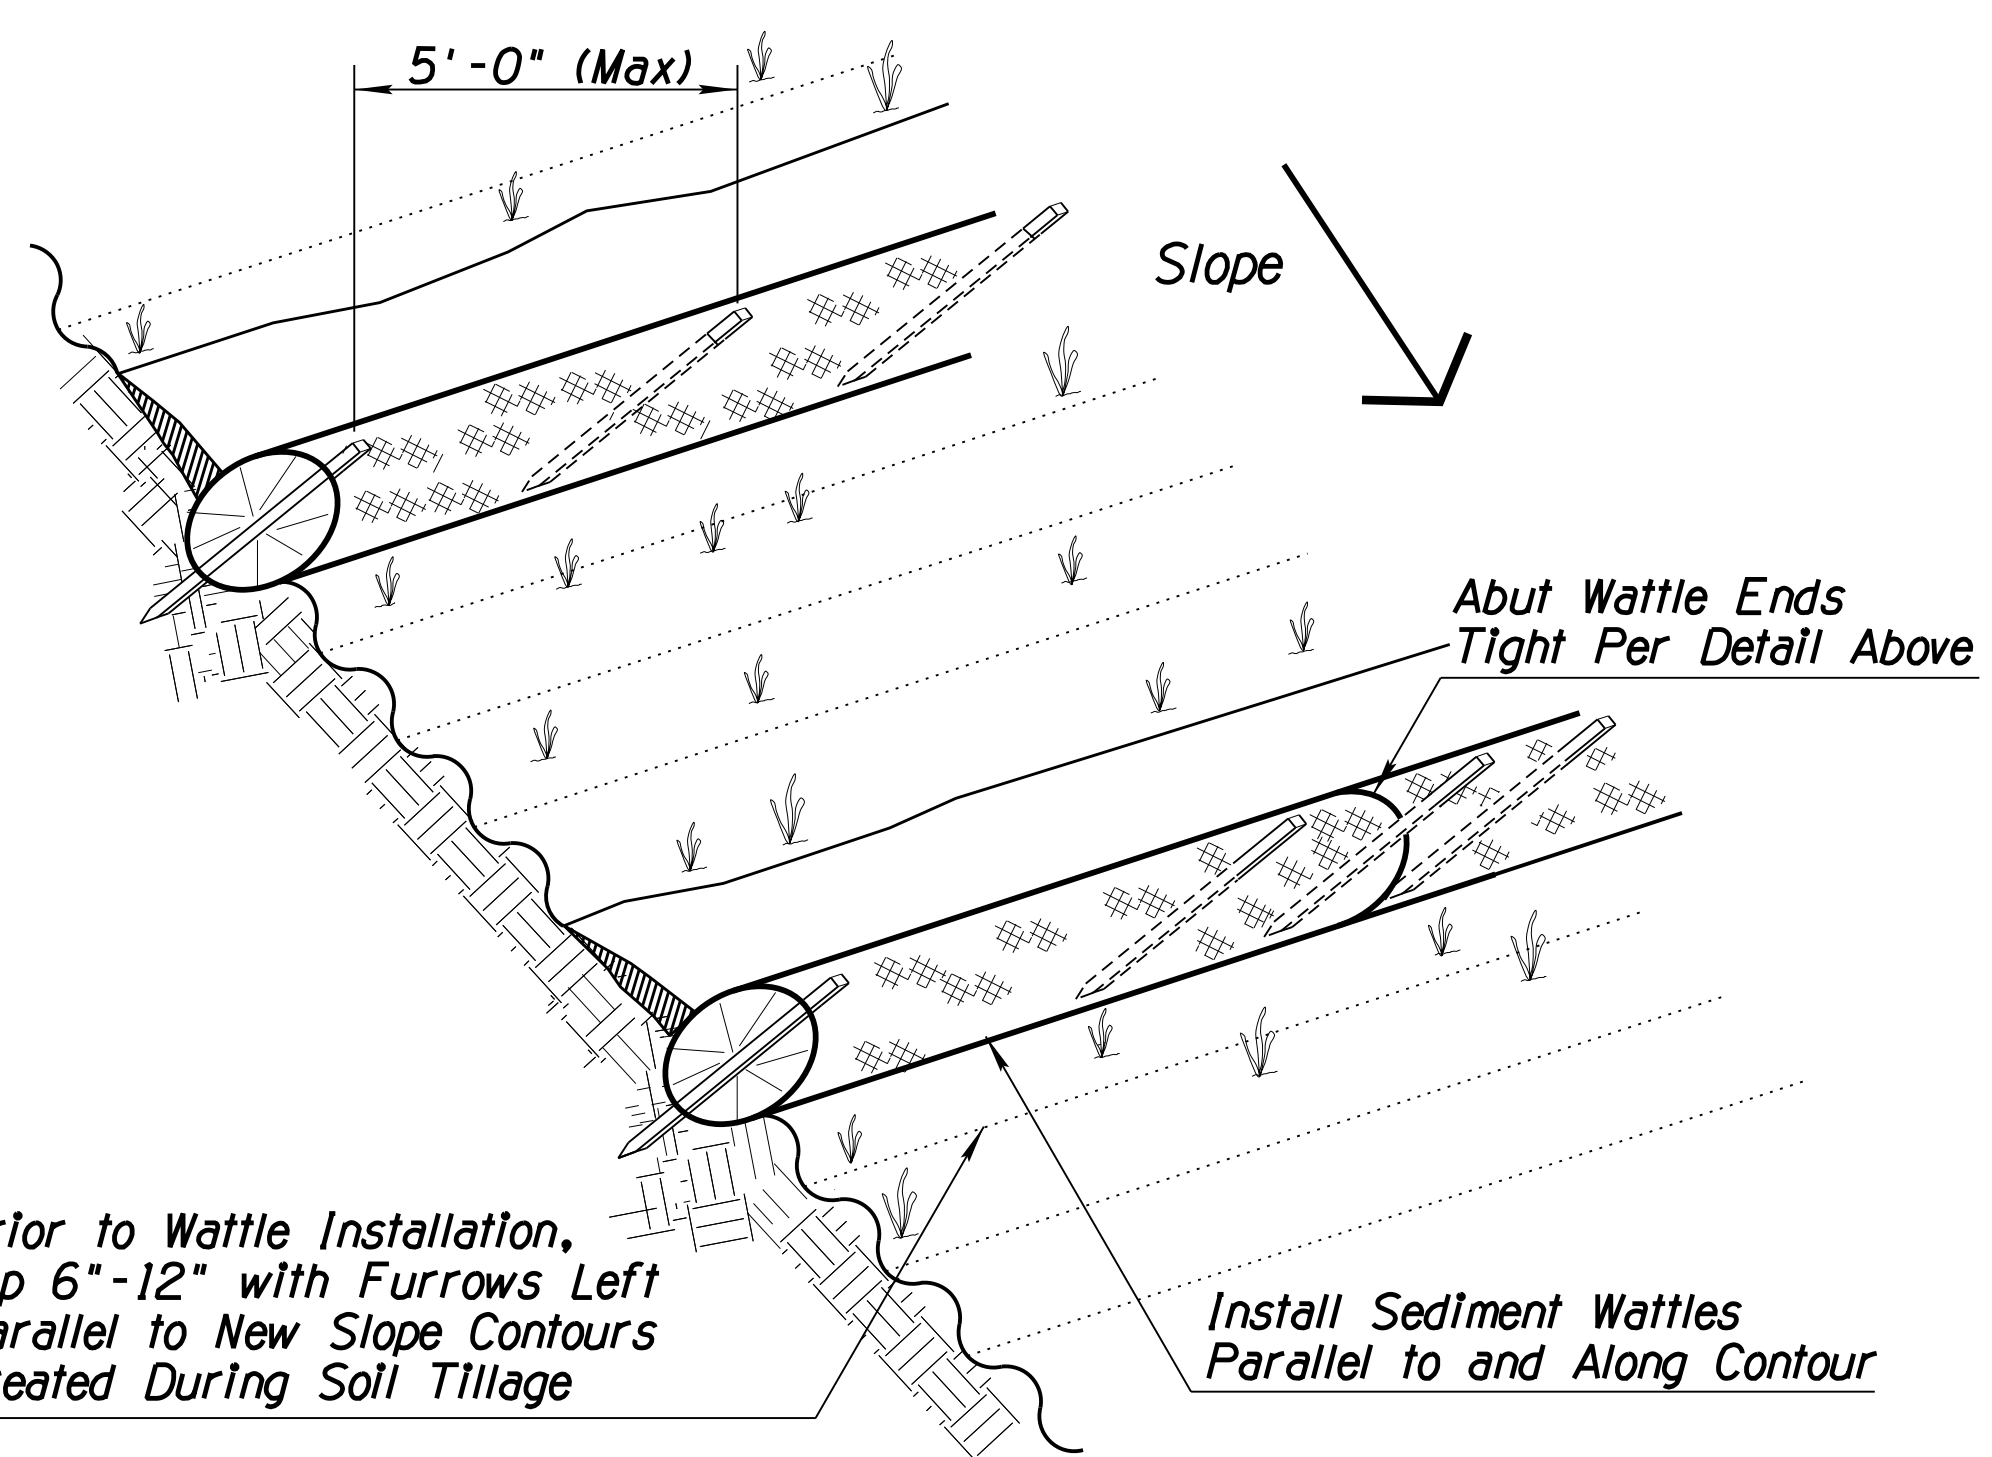


SEDIMENT WATTLE LAYOUT (NTS)

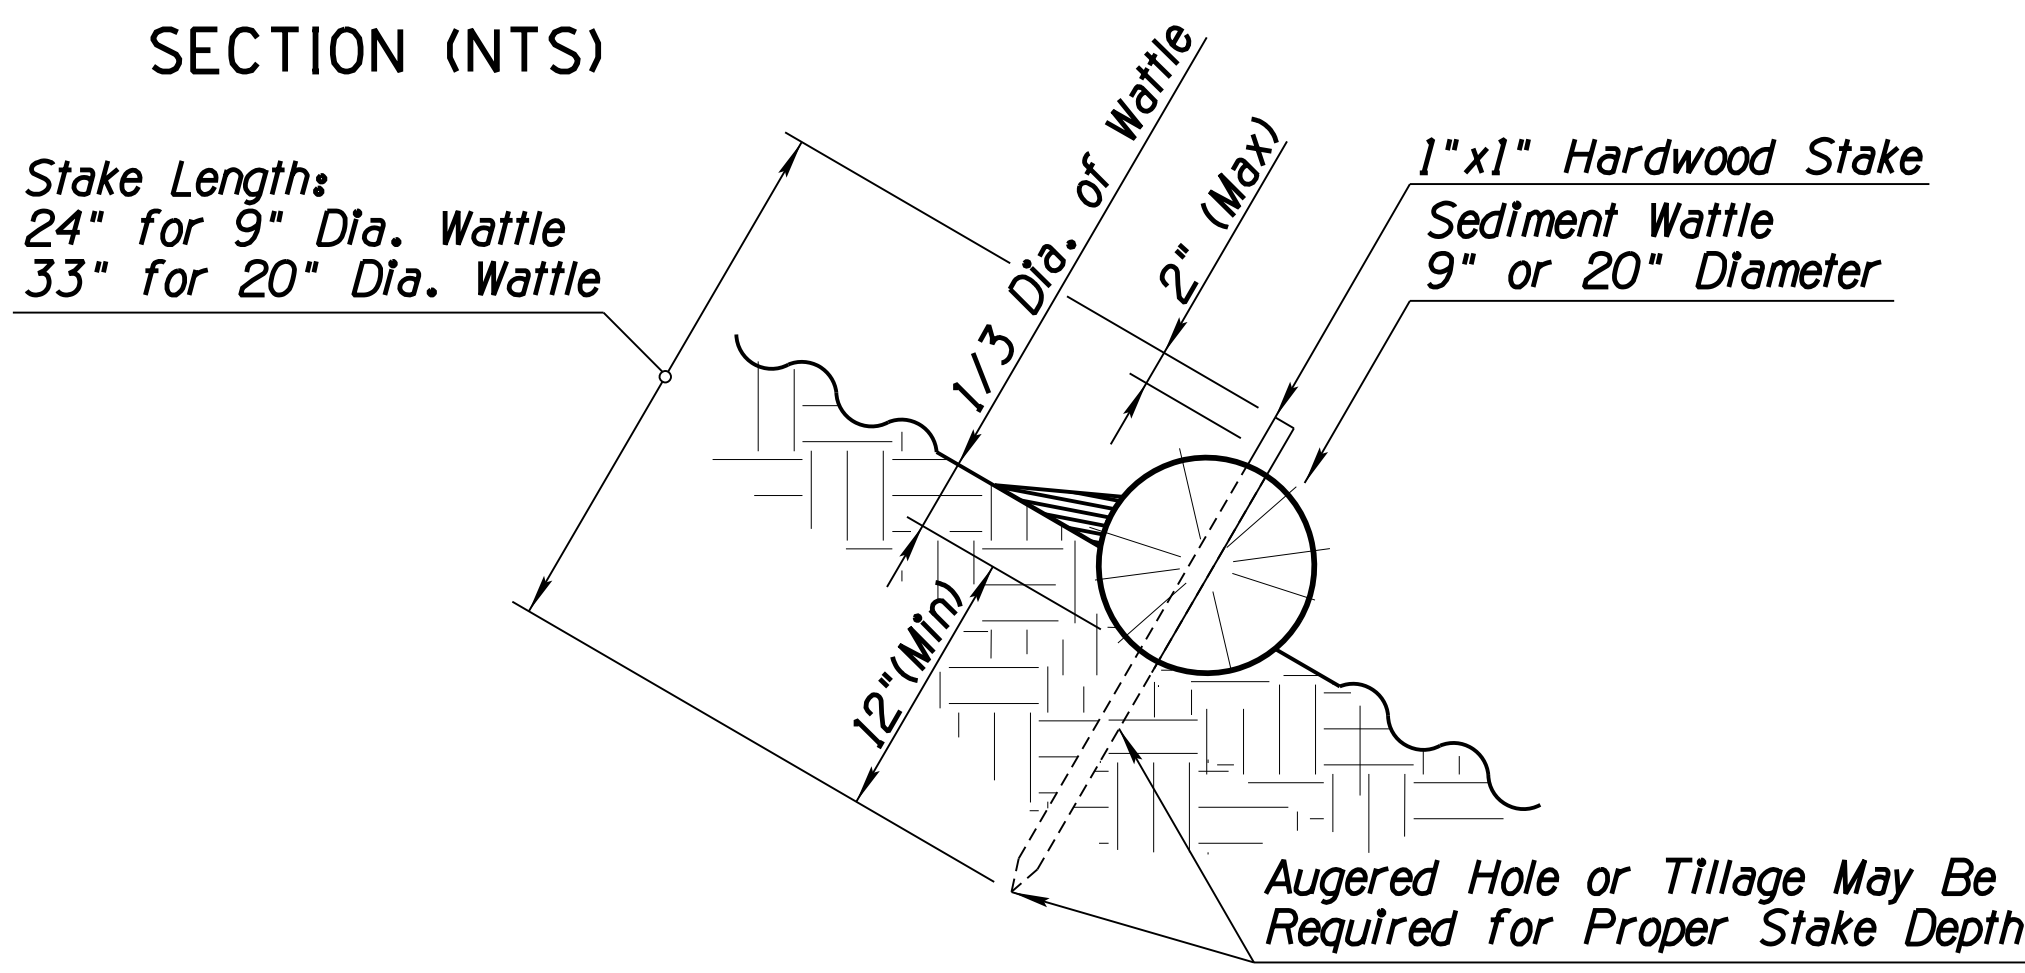


SECTION (NTS)

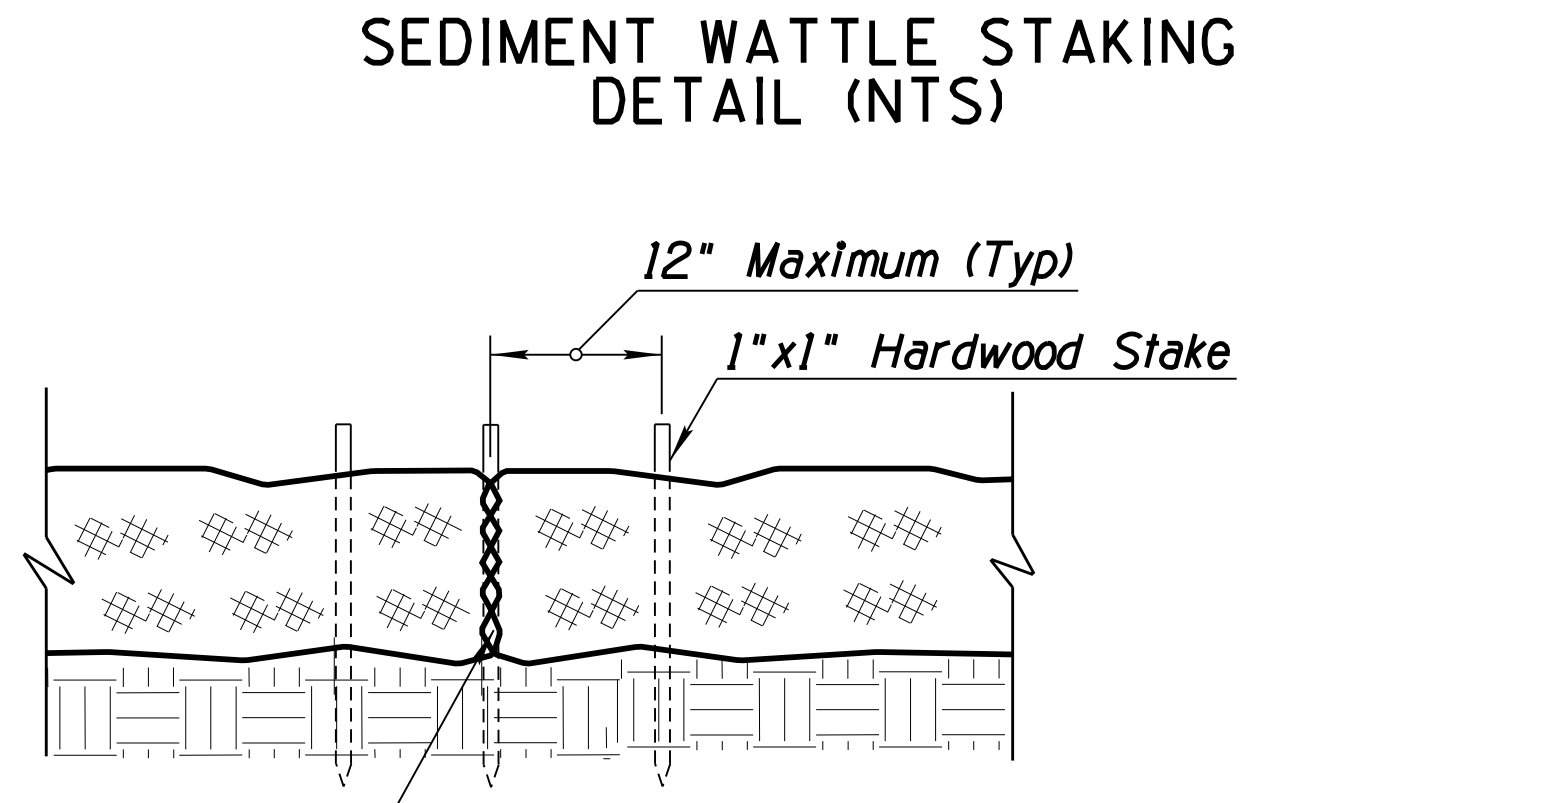

SEDIMENT WATTLE STAKING DETAIL (NTS)

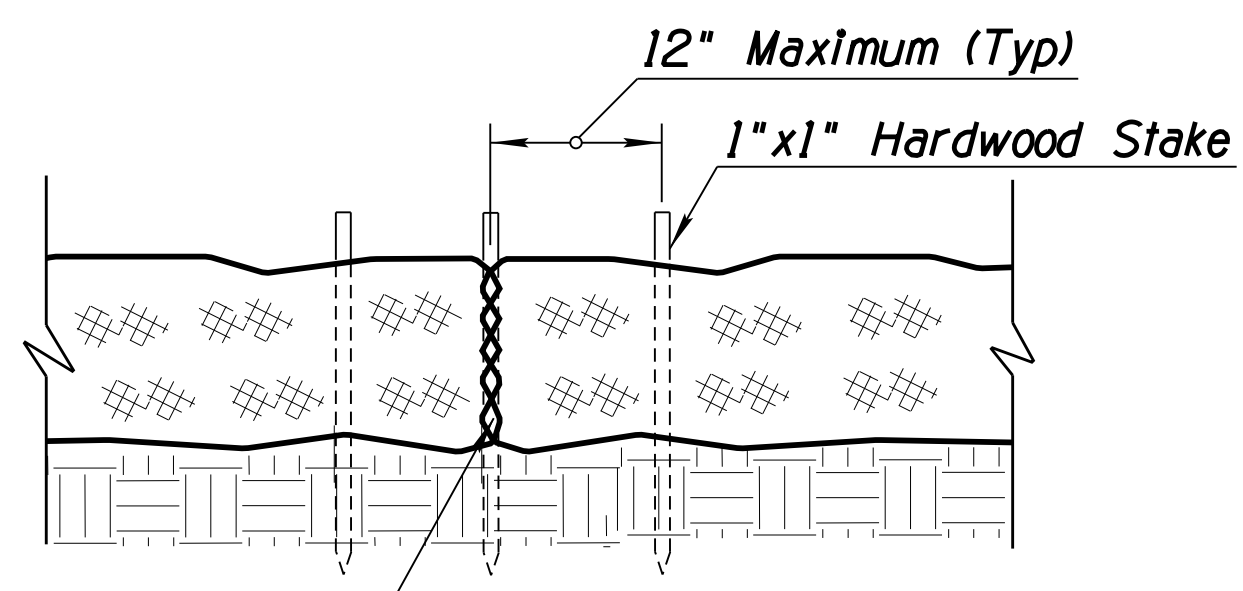

SEDIMENT WATTLE OVERLAP (NTS)

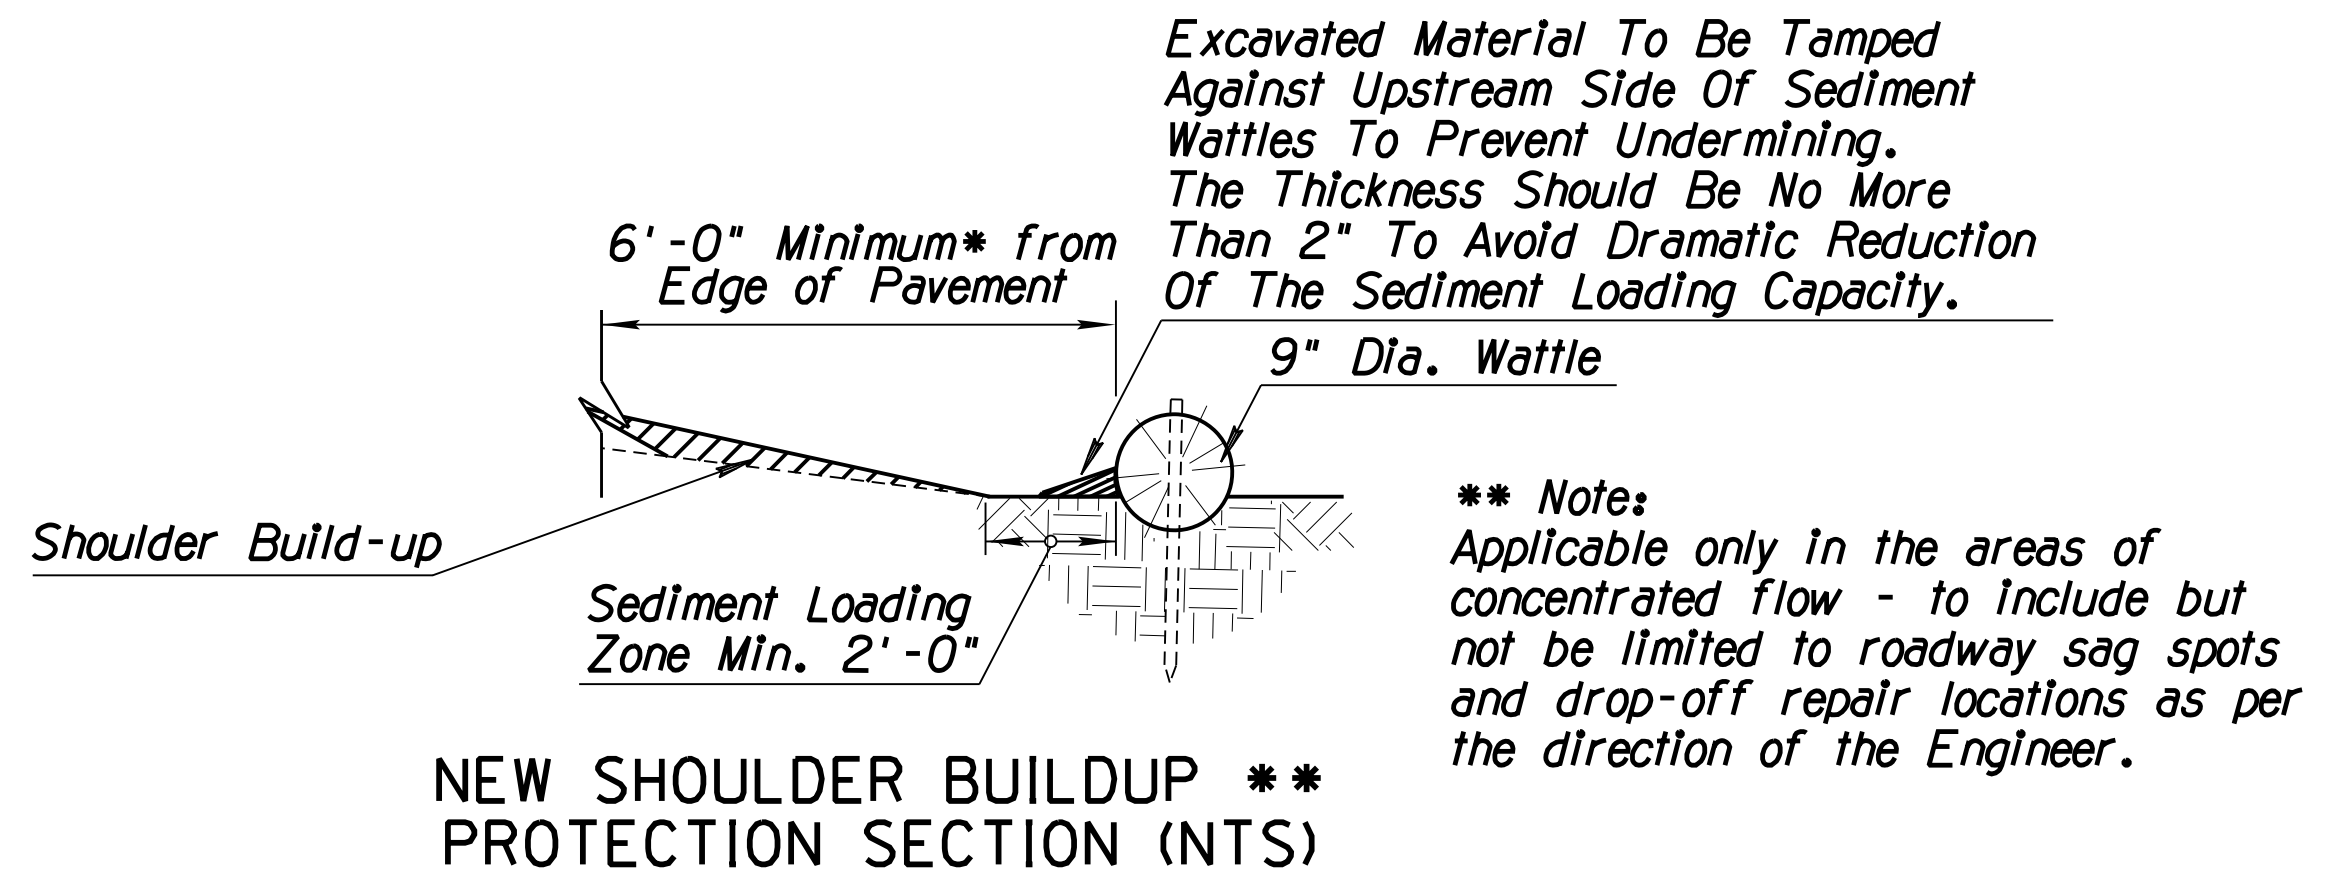

NEW SHOULDER BUILDUP \*\* PROTECTION SECTION (NTS)

- NOTES:
1. Install Sediment Wattles as slopes are constructed to grade or as directed by the Engineer. Select, install and maintain in conformance with manufacturers' specifications to meet site conditions for slope protection and in accordance with good engineering practices. No Sediment Wattles shall be installed in urban freeway medians, nor where cable barrier systems are employed.
  2. Sediment Wattles shall be in continuous contact with trench bottom and sides. Do not overlap wattle ends on top of each other. A 20" Dia. wattle may be made from 2-3 rolled excelsior or straw blankets.
  3. Butt adjoining wattles tightly against each other. Drive the first end stake of the second wattle at an angle toward the first wattle to help abut them tightly.
  4. Repair any rills or gullies promptly. Make field adjustments and corrections of Wattle BMP immediately if it is causing flooding, erosion, and/or affecting roadway safety.
  5. Construction of cut slopes 2:1 and steeper in soil and rock materials that can be ripped shall be constructed, whenever possible, by Minibenching. Refer to Slope Minibenching BMP Detail.
  6. Loosening surface soil is not required where Minibenches are used. For seeded areas, tillage shall be performed to form minor ridges and furrows parallel to new slope contours and as specified in Section 805 of the Specifications.
  7. Divert and direct run-on water from outside of the slopes to the spillways and/or rock riprap/rock mulch. Diversion dikes and/or ditches are necessary on natural undisturbed slopes beyond the top limits of new slopes to divert run-on water.
  8. Installation and maintenance of Sediment Wattle BMPs shall not negatively impact traffic safety, nor the designed function of roadway or bridge drainage facilities.
  9. Install and maintain Sediment Wattle BMPs to carry the stormwater of at least 2-year, 24-hour events.
  10. The Sediment Wattle BMP's pay/bid item shall include all materials used for this BMP: all ground preparation, furnishing, installing, maintenance, final removal, and disposal of this temporary BMP, as well as returning the area to an acceptable condition as approved by the Engineer.
  11. Refer to Section 810-2.06(C) of the Specifications for Sediment Wattle material.
  12. Make field adjustments and corrections to ensure NO sensitive biological resources (native species / habitats) will be adversely impacted.

Abut Wattle Ends Tight, No Gaps. Wood Stake to Penetrate Netting Only.


# DETAIL ES1

## SEDIMENT WATTLE


DESIGN	WDC	DATE	3/19	ARIZONA DEPARTMENT OF TRANSPORTATION INFRASTRUCTURE DELIVERY AND OPERATIONS DIVISION ROADSIDE DEVELOPMENT SECTION	
DRAWN	WDC	DATE	3/19		
CHECKED	WDC/LEM	DATE	3/19		
WHEAT DESIGN GROUP		LANDSCAPE ARCHITECTS		STORMWATER QUALITY PROTECTION & EROSION/SEDIMENT CONTROL DETAIL SHEET	
500 N TUCSON BLVD, SUITE 150, TUCSON AZ 85716				EXPIRES 6-30-2019	
ROUTE	1-10	LOCATION	RUTHRAUFF ROAD TI	DWG NO. E-2.01	
TRACS NO. H 8480 OIC			010-D(213)S		
			OF		

F.H.W.A. REGION	STATE	PROJECT NO.	SHEET NO.	TOTAL SHEETS	RECORD DRAWING
9	ARIZ.	010-D(213)S	744	849	

010 PM 252

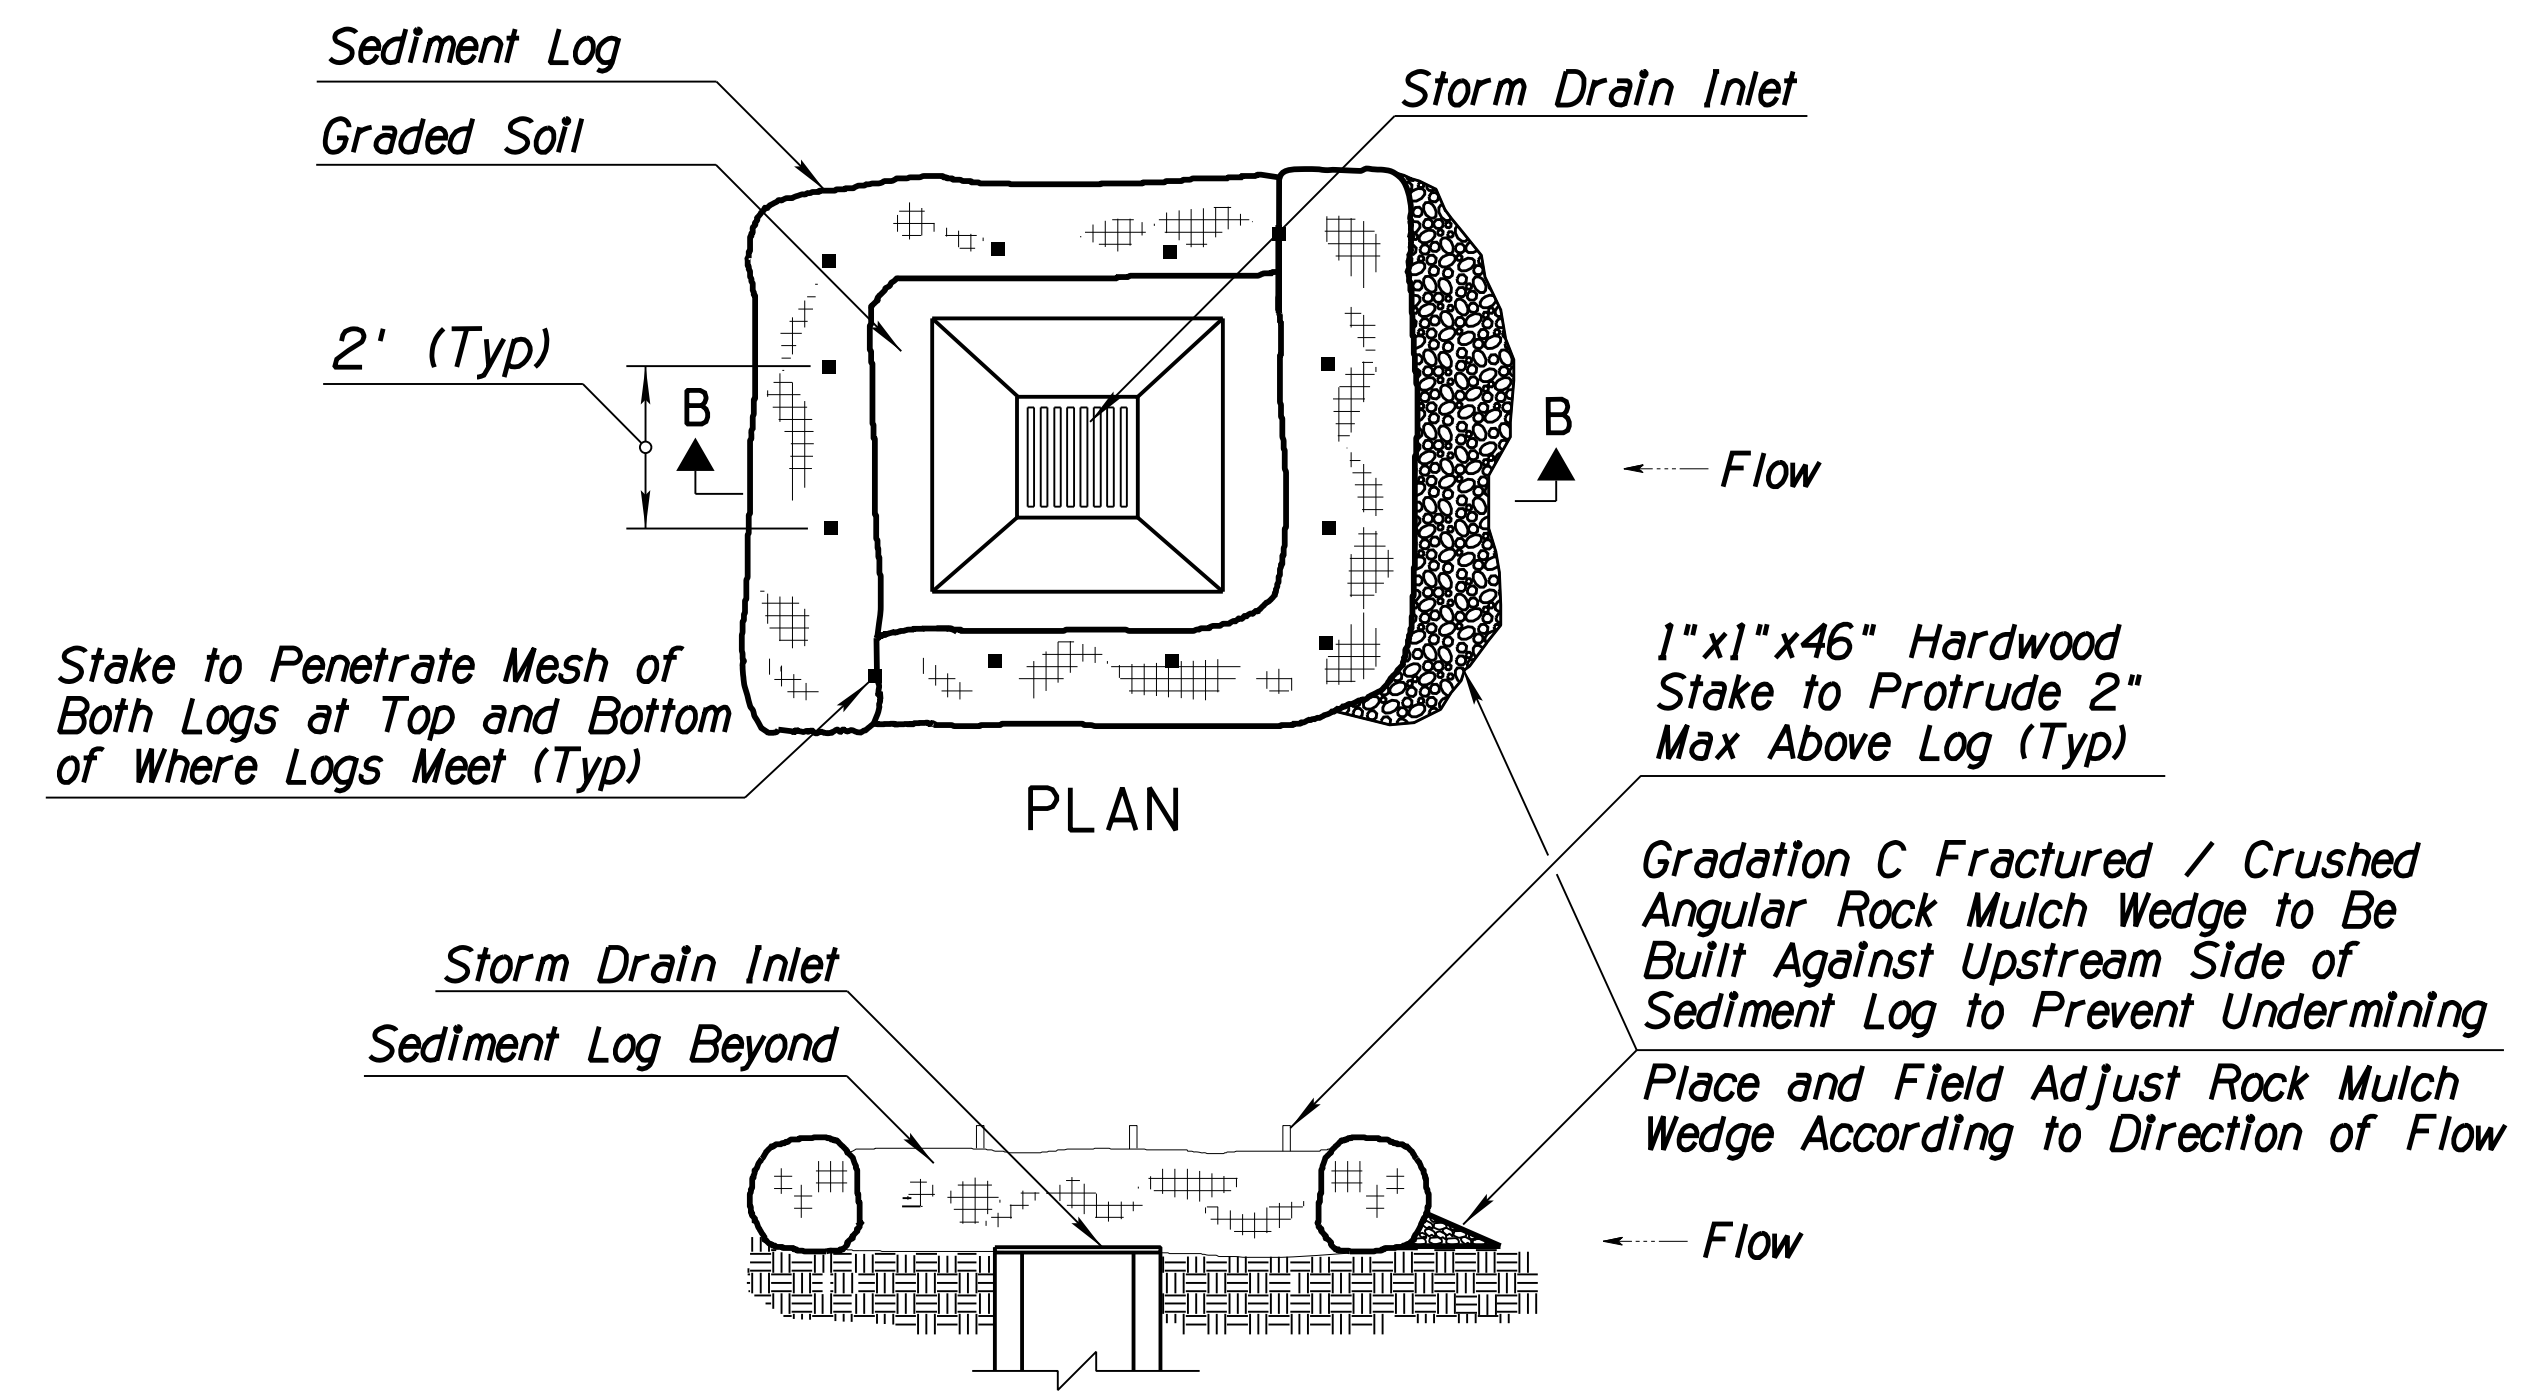


SEDIMENT LOG AT STORM DRAIN SECTION B-B (NTS)

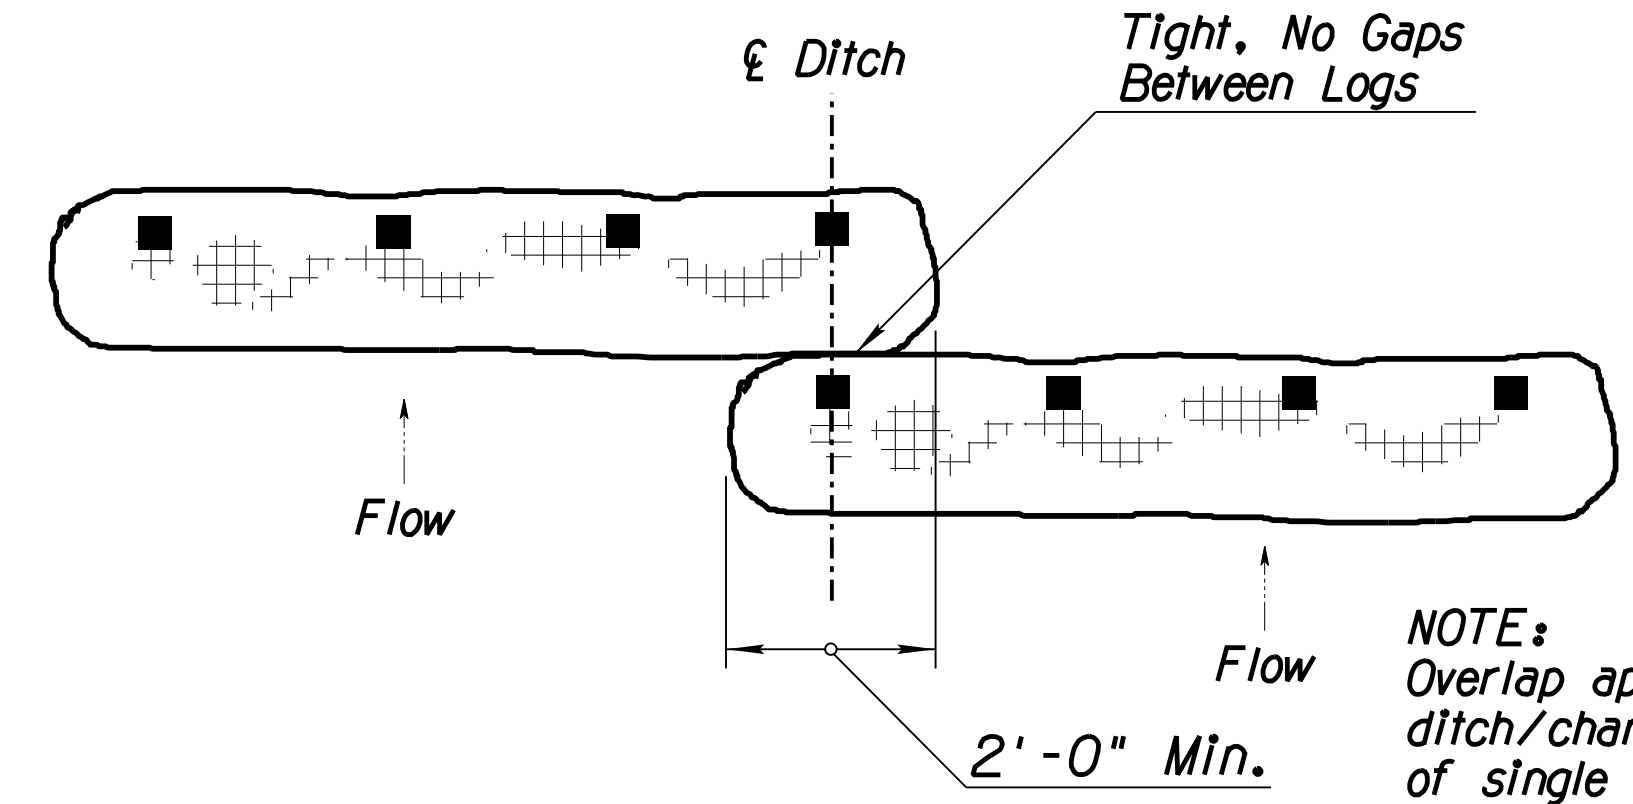


TYPICAL OVERLAP PLAN (NTS)

NOTE:  
Overlap applies to situations where ditch/channel is wider than length of single Sediment Log. Two or multiple Sediment Logs may be necessary.

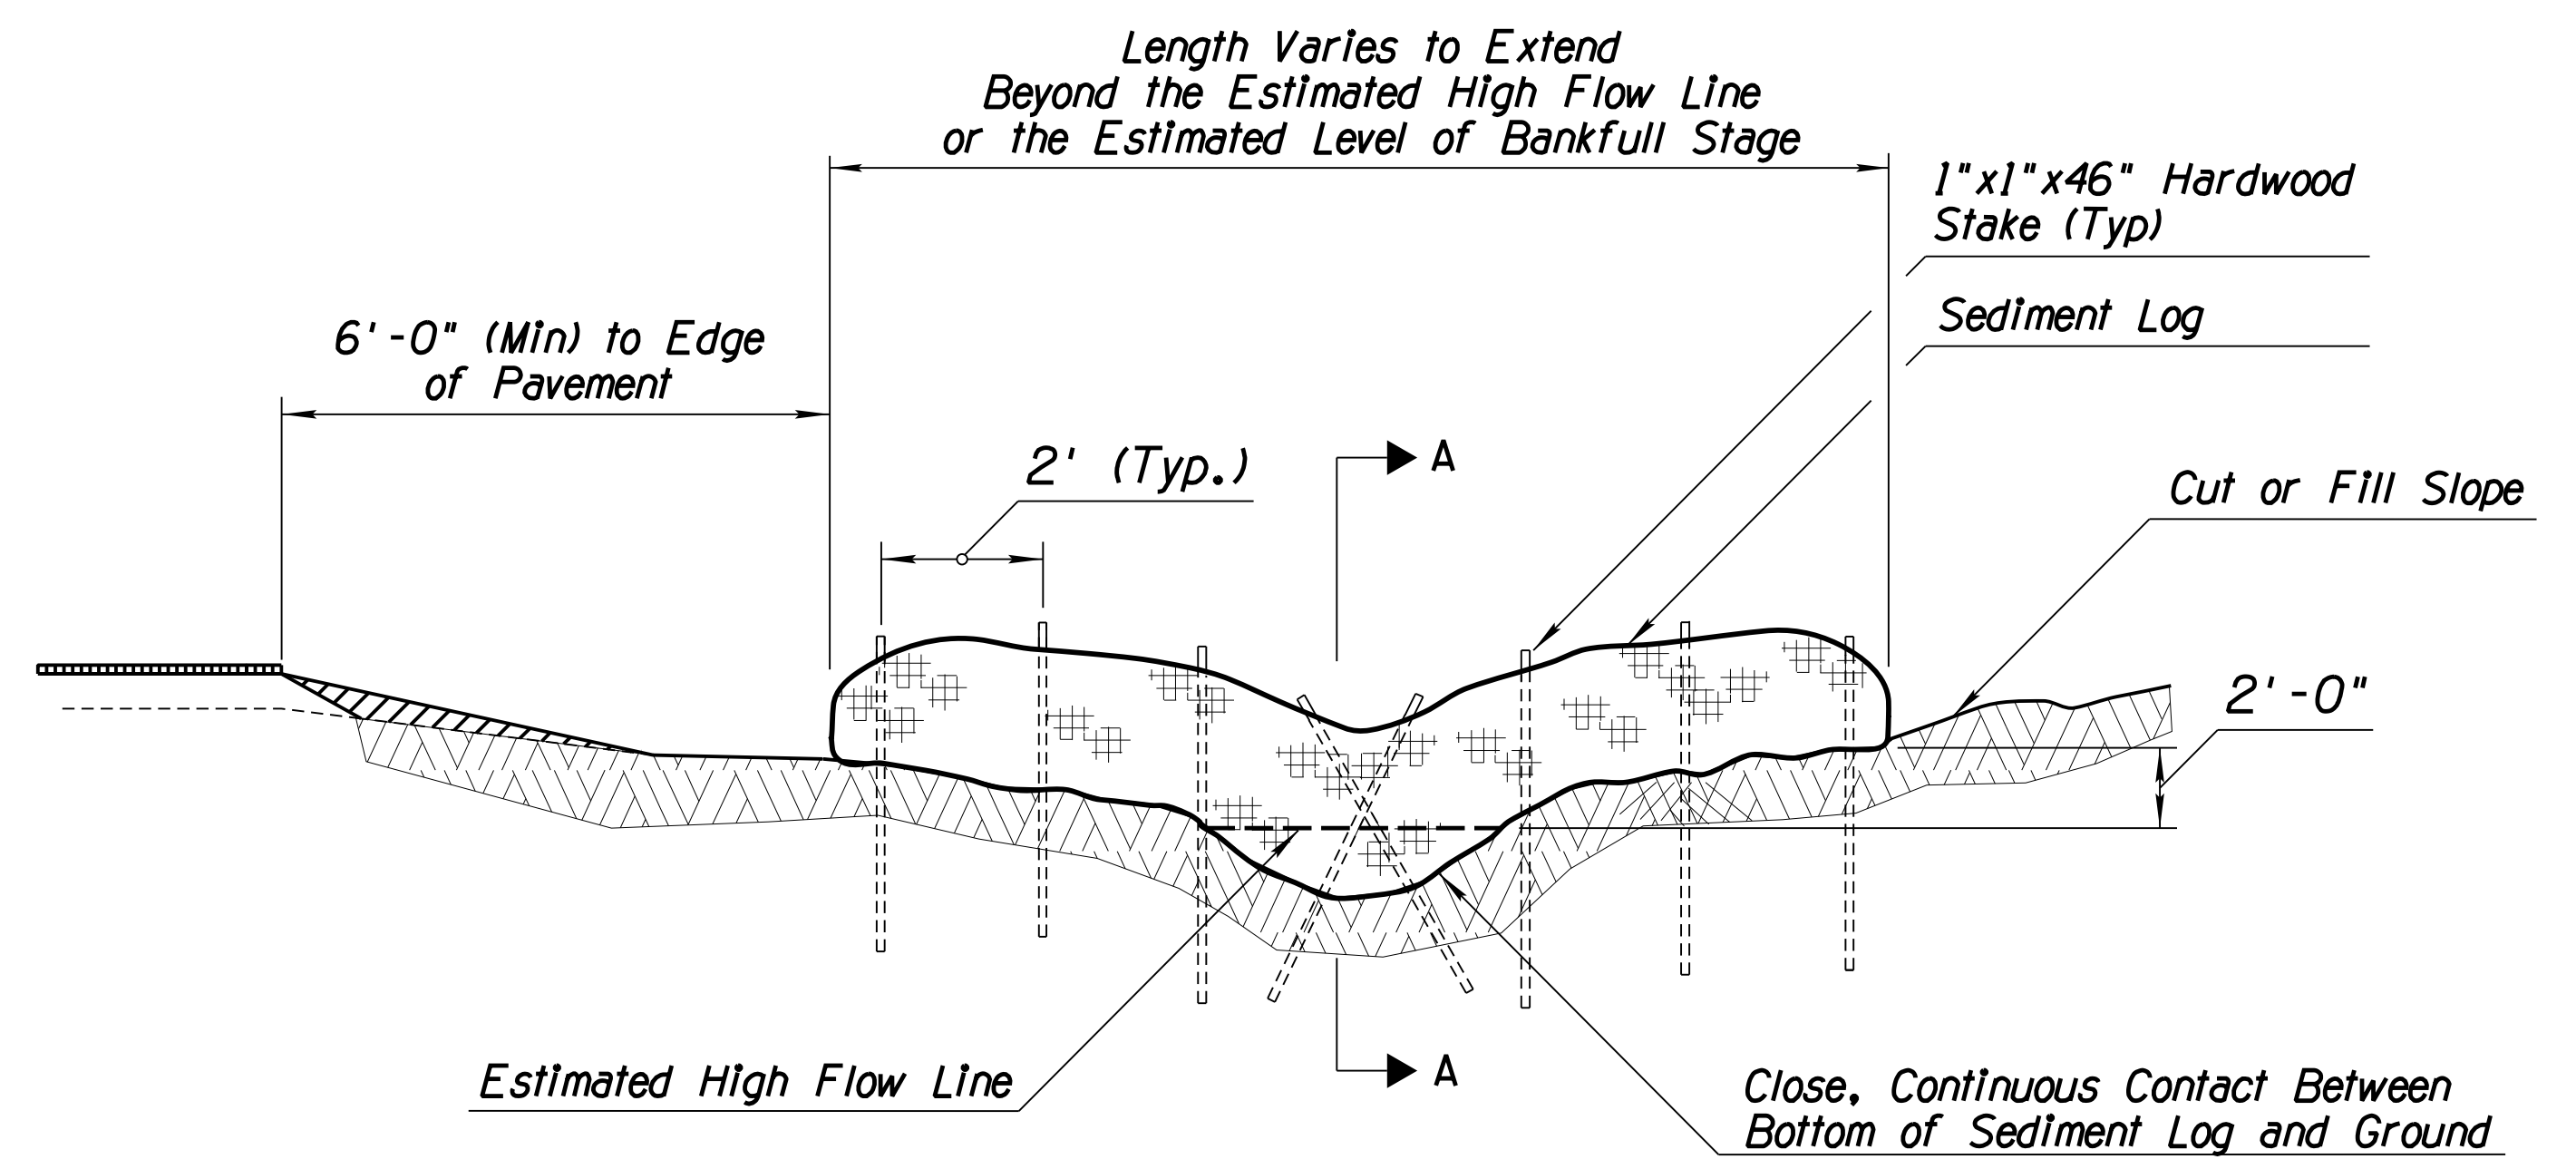

SEDIMENT LOG IN DITCH/CHANNEL SECTIONAL ELEVATION (NTS)

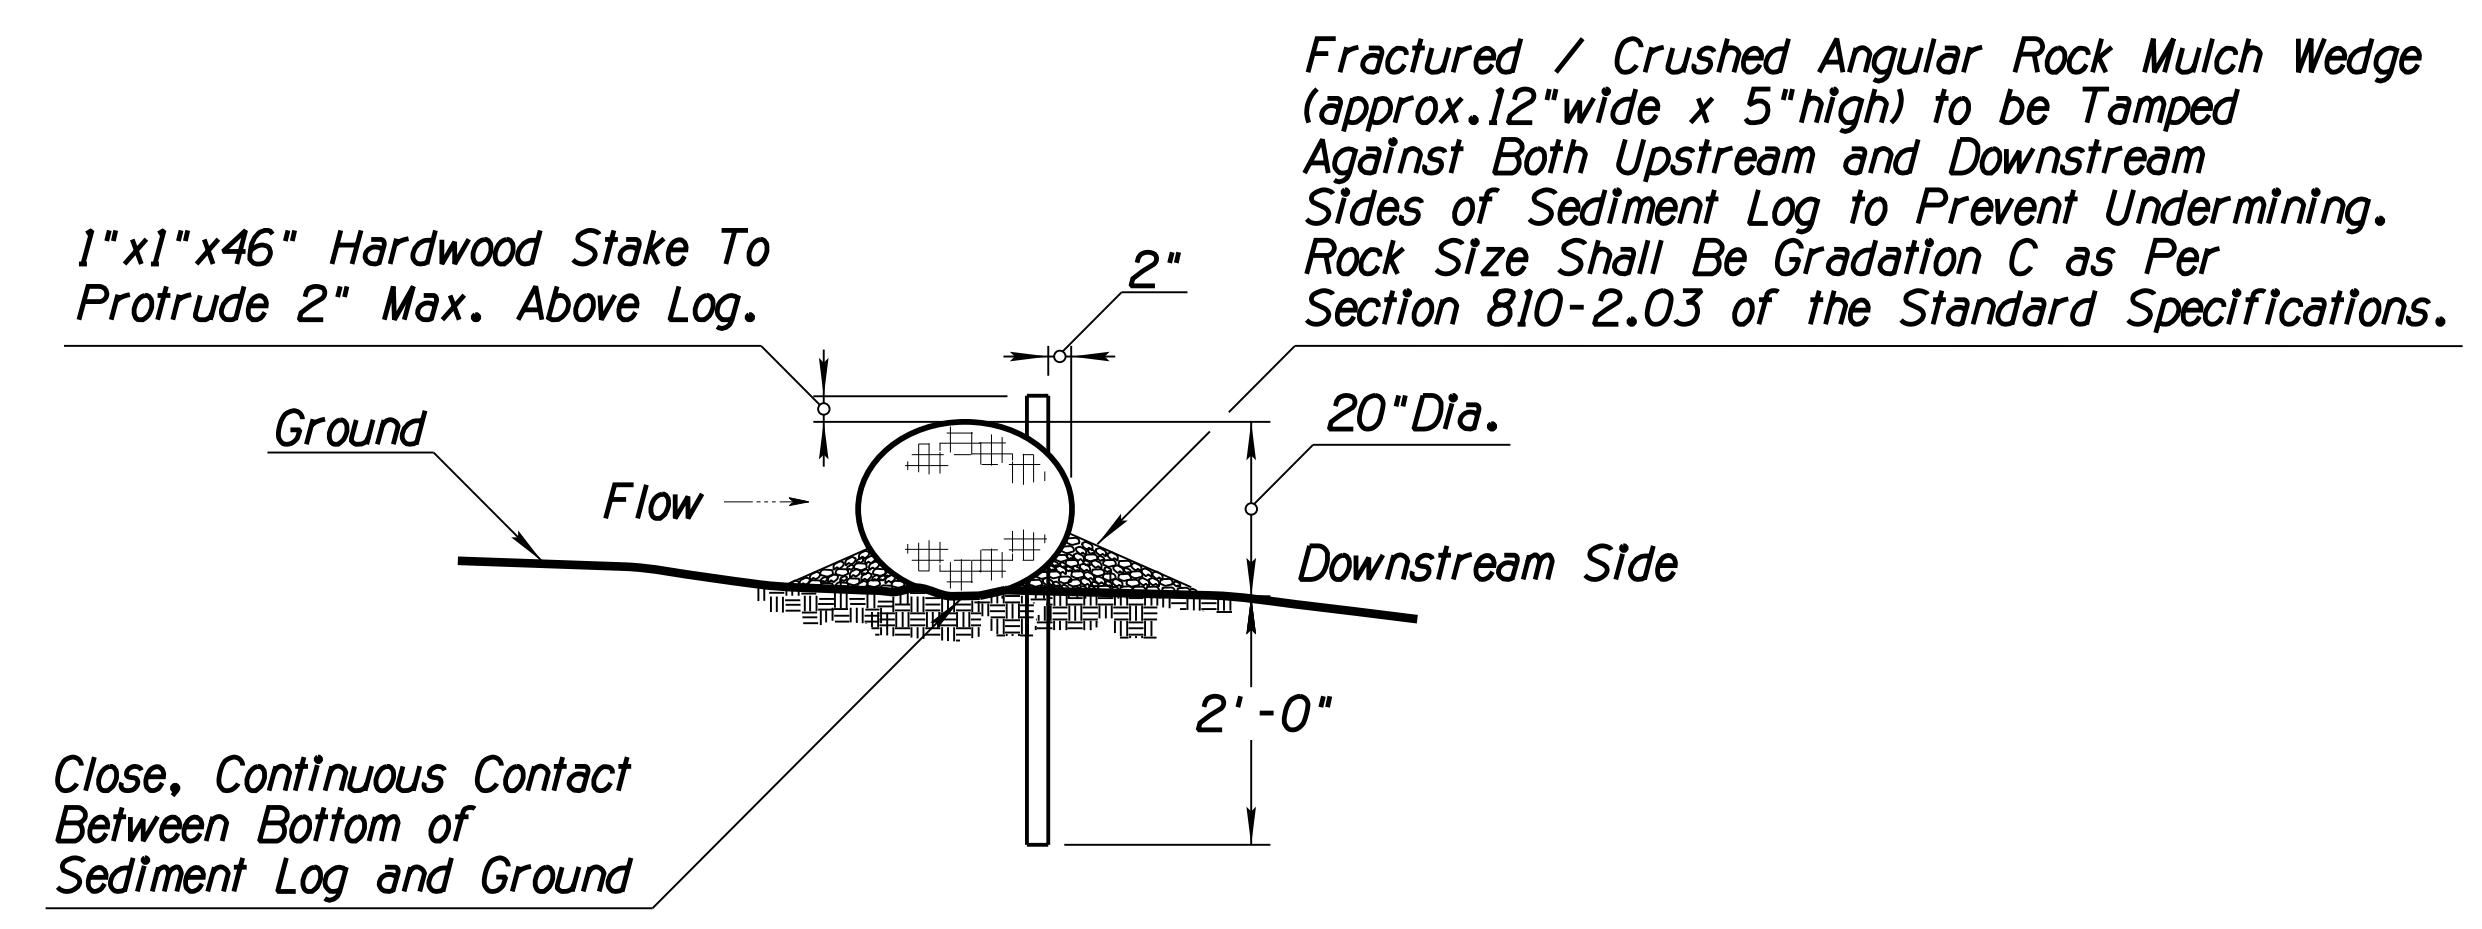

SECTION A-A (NTS)

NOTES:

- Sediment Logs shall not be installed in the urban freeway medians, nor where cable barrier systems are employed.
- Locate Sediment Logs as indicated in plans, SWPPP or as directed by the Engineer.
- Select, install and maintain Logs per manufacturers' specifications and good engineering practices.
- Lay Sediment Log across prepared roadside ditch or channel. Trenching or burial of Sediment Logs is not required. The close, continuous contact between the bottom of the Log and the ground is mandatory. The Logs shall be installed in the roadside ditch, swale or channel bottom perpendicular to the flow of water as shown on detail this sheet.
- Stake Log as shown. Stakes shall be placed through downstream side only as shown.
- DO NOT drive stakes through center of the Log. Stakes must be driven into the ground as shown.
- Ensure that no gaps exist between soil and bottom of Sediment Log. Repair any rills or undercuts promptly.
- Placement of Sediment Logs shall be evaluated by the Engineer in rocky soil conditions.
- Remove Sediment Log BMPs within the ditches/channels and around the storm drain inlets as per the direction of the Engineer or as soon as practicable upon stabilization of the construction disturbed area.
- Dispose of Sediment Logs and trapped sediment material and fill trench created by Sediment Log.
- The installation and maintenance of Sediment Log BMPs shall not negatively impact traffic safety, nor the designed function of roadway or bridge drainage facilities. Sediment Logs shall be installed and maintained to carry the stormwater of at least 2-year, 24-hour events.
- Make field adjustments and corrections of Sediment Log BMP immediately if it is causing flooding, erosion, and/or affecting roadway safety.
- Rock mulch/riprap may be required for channel/ditch lining or rock check dams for longitudinal ditch slopes that exceed 5% and/or for soil conditions not suitable for Log installation.
- The Sediment Log BMP's pay/bid item shall include all materials used for this BMP: all ground preparation, furnishing, installing, maintenance, final removal, and disposal, as well as returning the area to an acceptable condition as approved by the Engineer.
- Refer to Standard Specification Section 810-2.06(B) for Sediment Log material specifications.
- Make field adjustments and corrections to ensure NO sensitive biological resources (native species / habitats) will be adversely impacted.
- Construct Rock Wedge with angular-shaped Gradation C Rock Mulch as defined in Section 810-2.03 of the Standard Specifications and these special provisions. Natural river-run materials such as rounded river rocks/cobblestones and pebbles are NOT acceptable.

# DETAIL ES2


## SEDIMENT LOG

DESIGN	WDC	3/19	ARIZONA DEPARTMENT OF TRANSPORTATION INFRASTRUCTURE DELIVERY AND OPERATIONS DIVISION ROADSIDE DEVELOPMENT SECTION	
DRAWN	WDC	3/19		
CHECKED	WDC/LEM	3/19		
<b>WHEAT DESIGN GROUP</b>		LANDSCAPE ARCHITECTS		<b>STORMWATER QUALITY PROTECTION &amp; EROSION/SEDIMENT CONTROL DETAIL SHEET</b>
500 N TUCSON BLVD, SUITE 150, TUCSON AZ 85716				
ROUTE	I-10	LOCATION	RUTHRAUFF ROAD TI	EXPIRES 6-30-2019
TRACS NO.	H 8480 OIC		010-D(213)S	DWG NO. E-2.02
				OF



F.H.W.A. REGION	STATE	PROJECT NO.	SHEET NO.	TOTAL SHEETS	RECORD DRAWING
9	ARIZ.	010-D(213)S	745	849	

010 PM 252

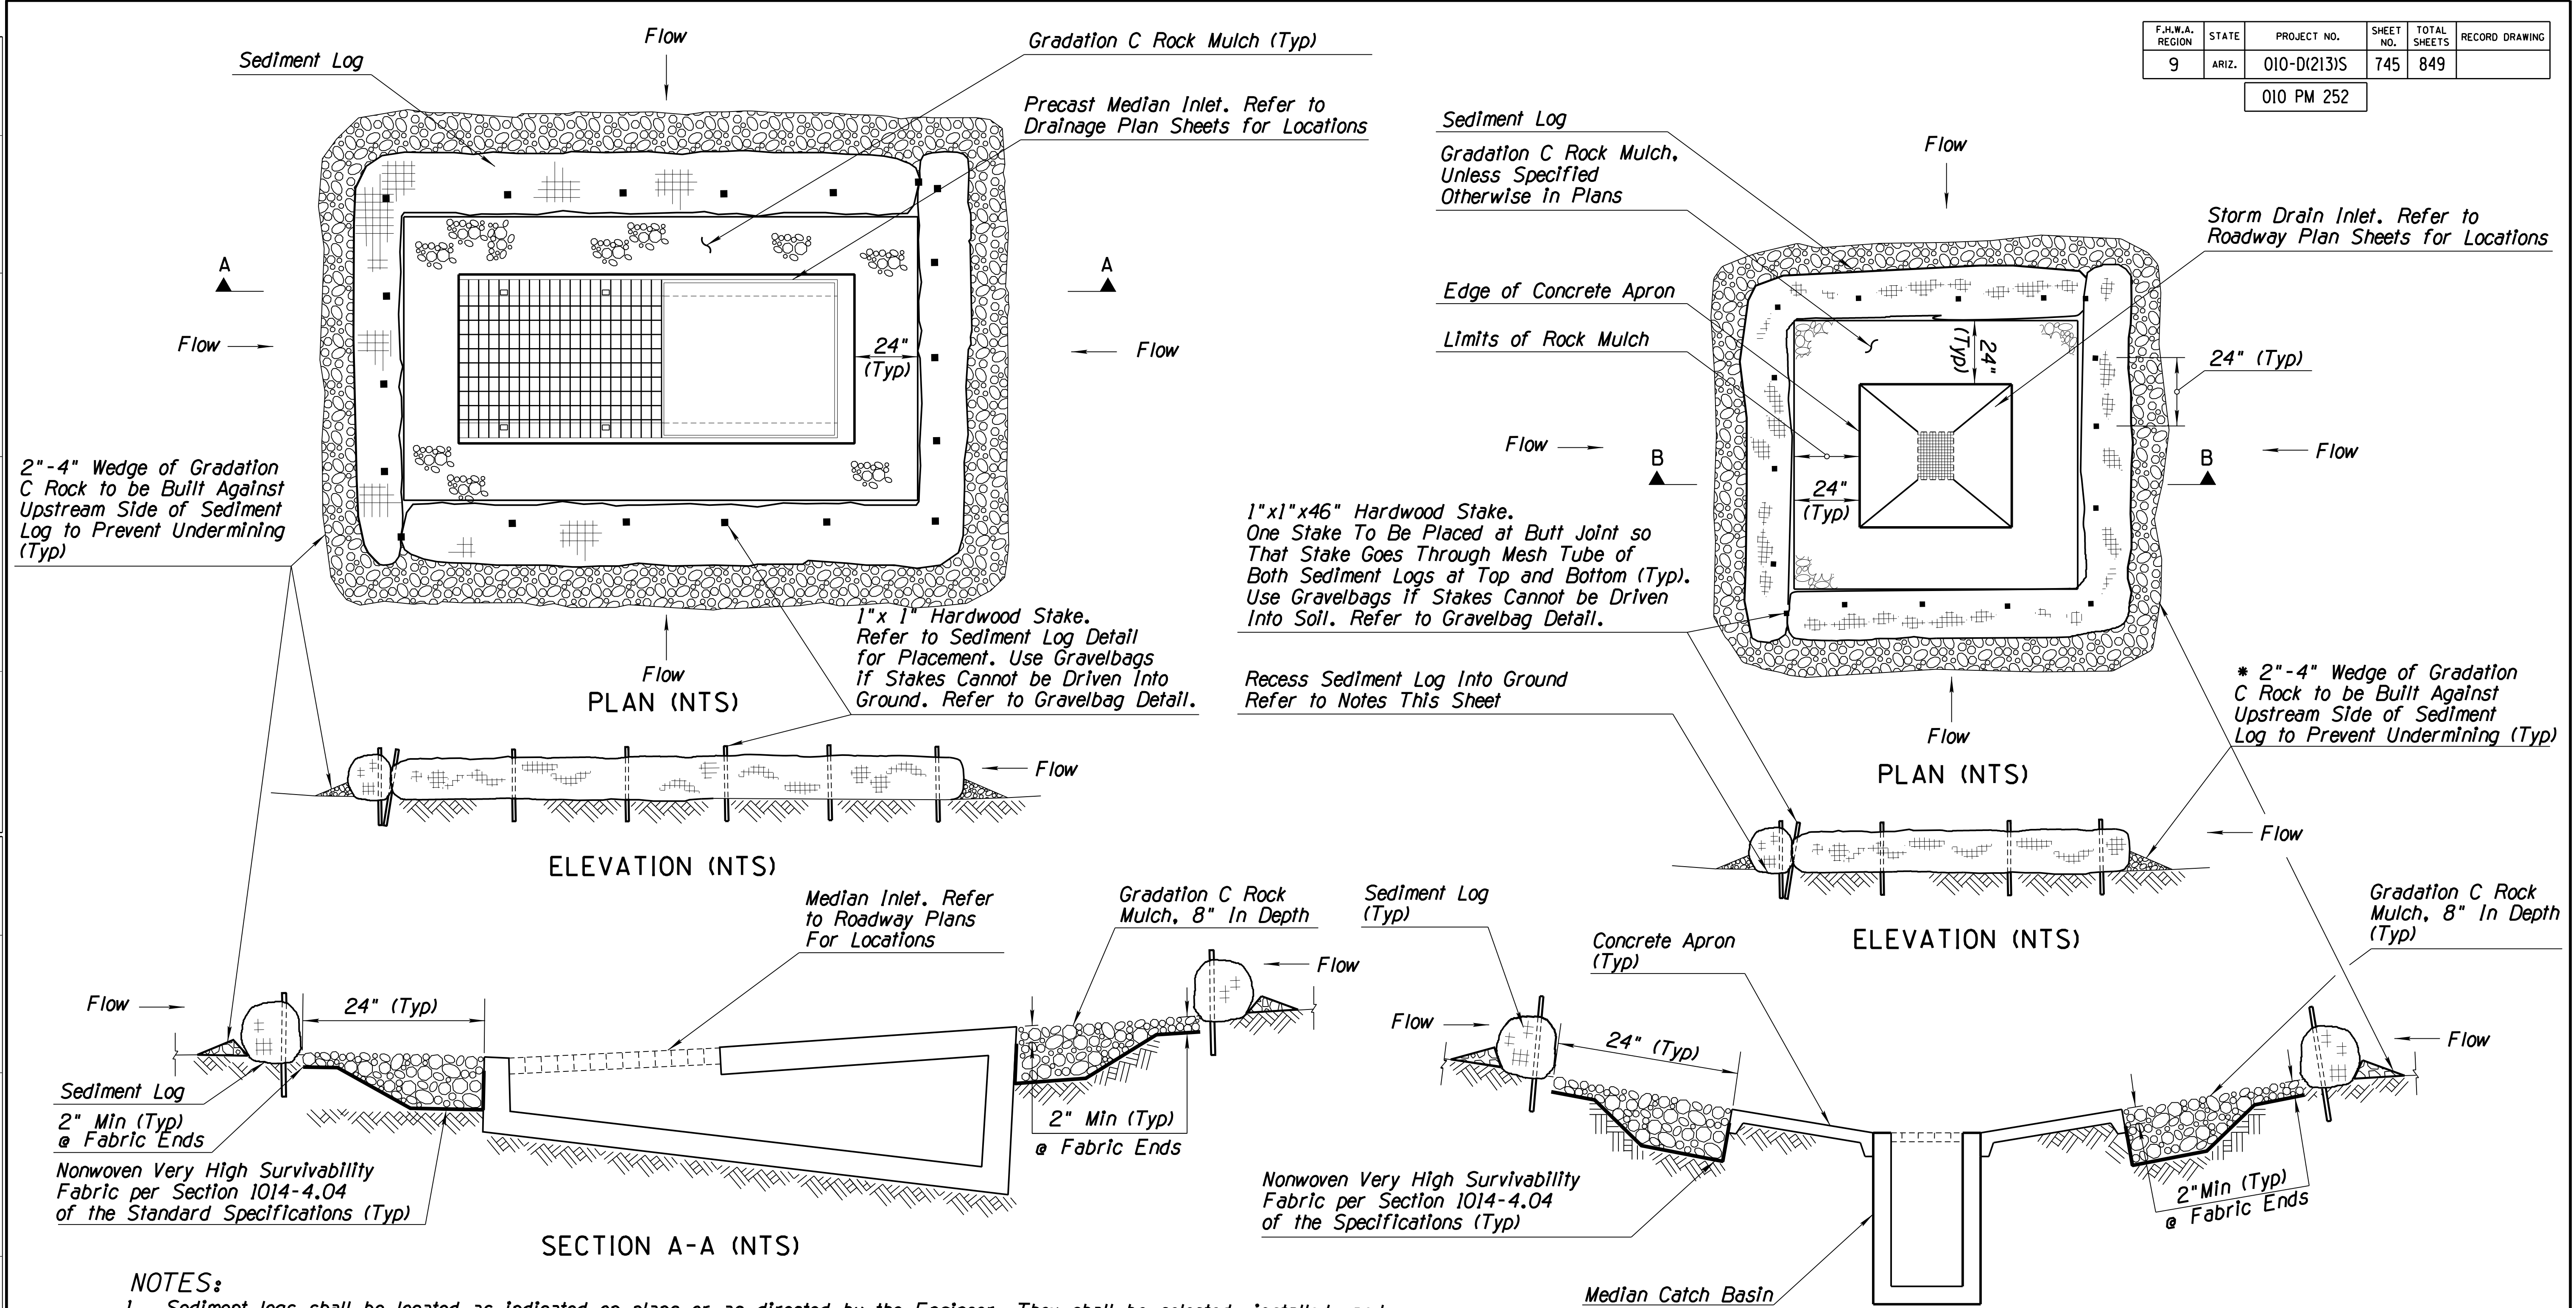

**NOTES:**

- Sediment logs shall be located as indicated on plans or as directed by the Engineer. They shall be selected, installed, and maintained per manufacturer's specifications and good engineering practices. Log shall be installed perpendicular to the flow of water. Continuous contact between the bottom of the log and the ground is mandatory.
- Stake log with 1"x1"x46" Min. hardwood stakes 24" on center. The stake shall be placed through the downstream side only. It is necessary for the stakes to grab one or two inches of netting. Do not drive stake through center of log. The stakes must be driven into the ground 24". Stakes at corners shall be placed in an "X" pattern.
- Make sure no gaps exist between subgrade and sediment log. Runoff must not pass under sediment log. May require subgrade preparation as directed by Engineer.
- Repair any rills or gullies promptly.
- Remove Sediment Log and stakes once construction activities are complete. Dispose of sediment logs and trapped sediment material and fill trench created by sediment log.
- Refer to Roadway and Drainage Plans and Details for Locations of Inlets and Catch Basins.
- Make field adjustments and corrections of Inlet Protection BMP immediately if it is causing flooding, erosion, and/or affecting roadway safety.
- Make field adjustments and corrections to ensure NO sensitive biological resources (native species / habitats) will be adversely impacted.
- \* Construct Rock Wedge with angular-shaped Gradation C Rock Mulch as defined in Section 810-2.03 of the Specifications. Natural river-run materials such as rounded river rocks/cobblestones and pebbles are NOT acceptable.

# DETAIL ES3


INLET PROTECTION COMBINED BMPS

DESIGN	WDC	3/19	ARIZONA DEPARTMENT OF TRANSPORTATION INFRASTRUCTURE DELIVERY AND OPERATIONS DIVISION ROADSIDE DEVELOPMENT SECTION	
DRAWN	WDC	3/19		
CHECKED	WDC/LEM	3/19		
<b>WHEAT DESIGN GROUP</b>		STORMWATER QUALITY PROTECTION & EROSION/SEDIMENT CONTROL DETAIL SHEET		EXPIRES 6-30-2019 DWG NO. E-2.03
LANDSCAPE ARCHITECTS 500 N TUCSON BLVD, SUITE 150, TUCSON AZ 85716				
ROUTE	LOCATION	RUTHRAUFF ROAD TI		
I-10		TRACS NO. H 8480 OIC		010-D(213)S




F.H.W.A. REGION	STATE	PROJECT NO.	SHEET NO.	TOTAL SHEETS	RECORD DRAWING
9	ARIZ.	010-D(213)S	746	849	


010 PM 252

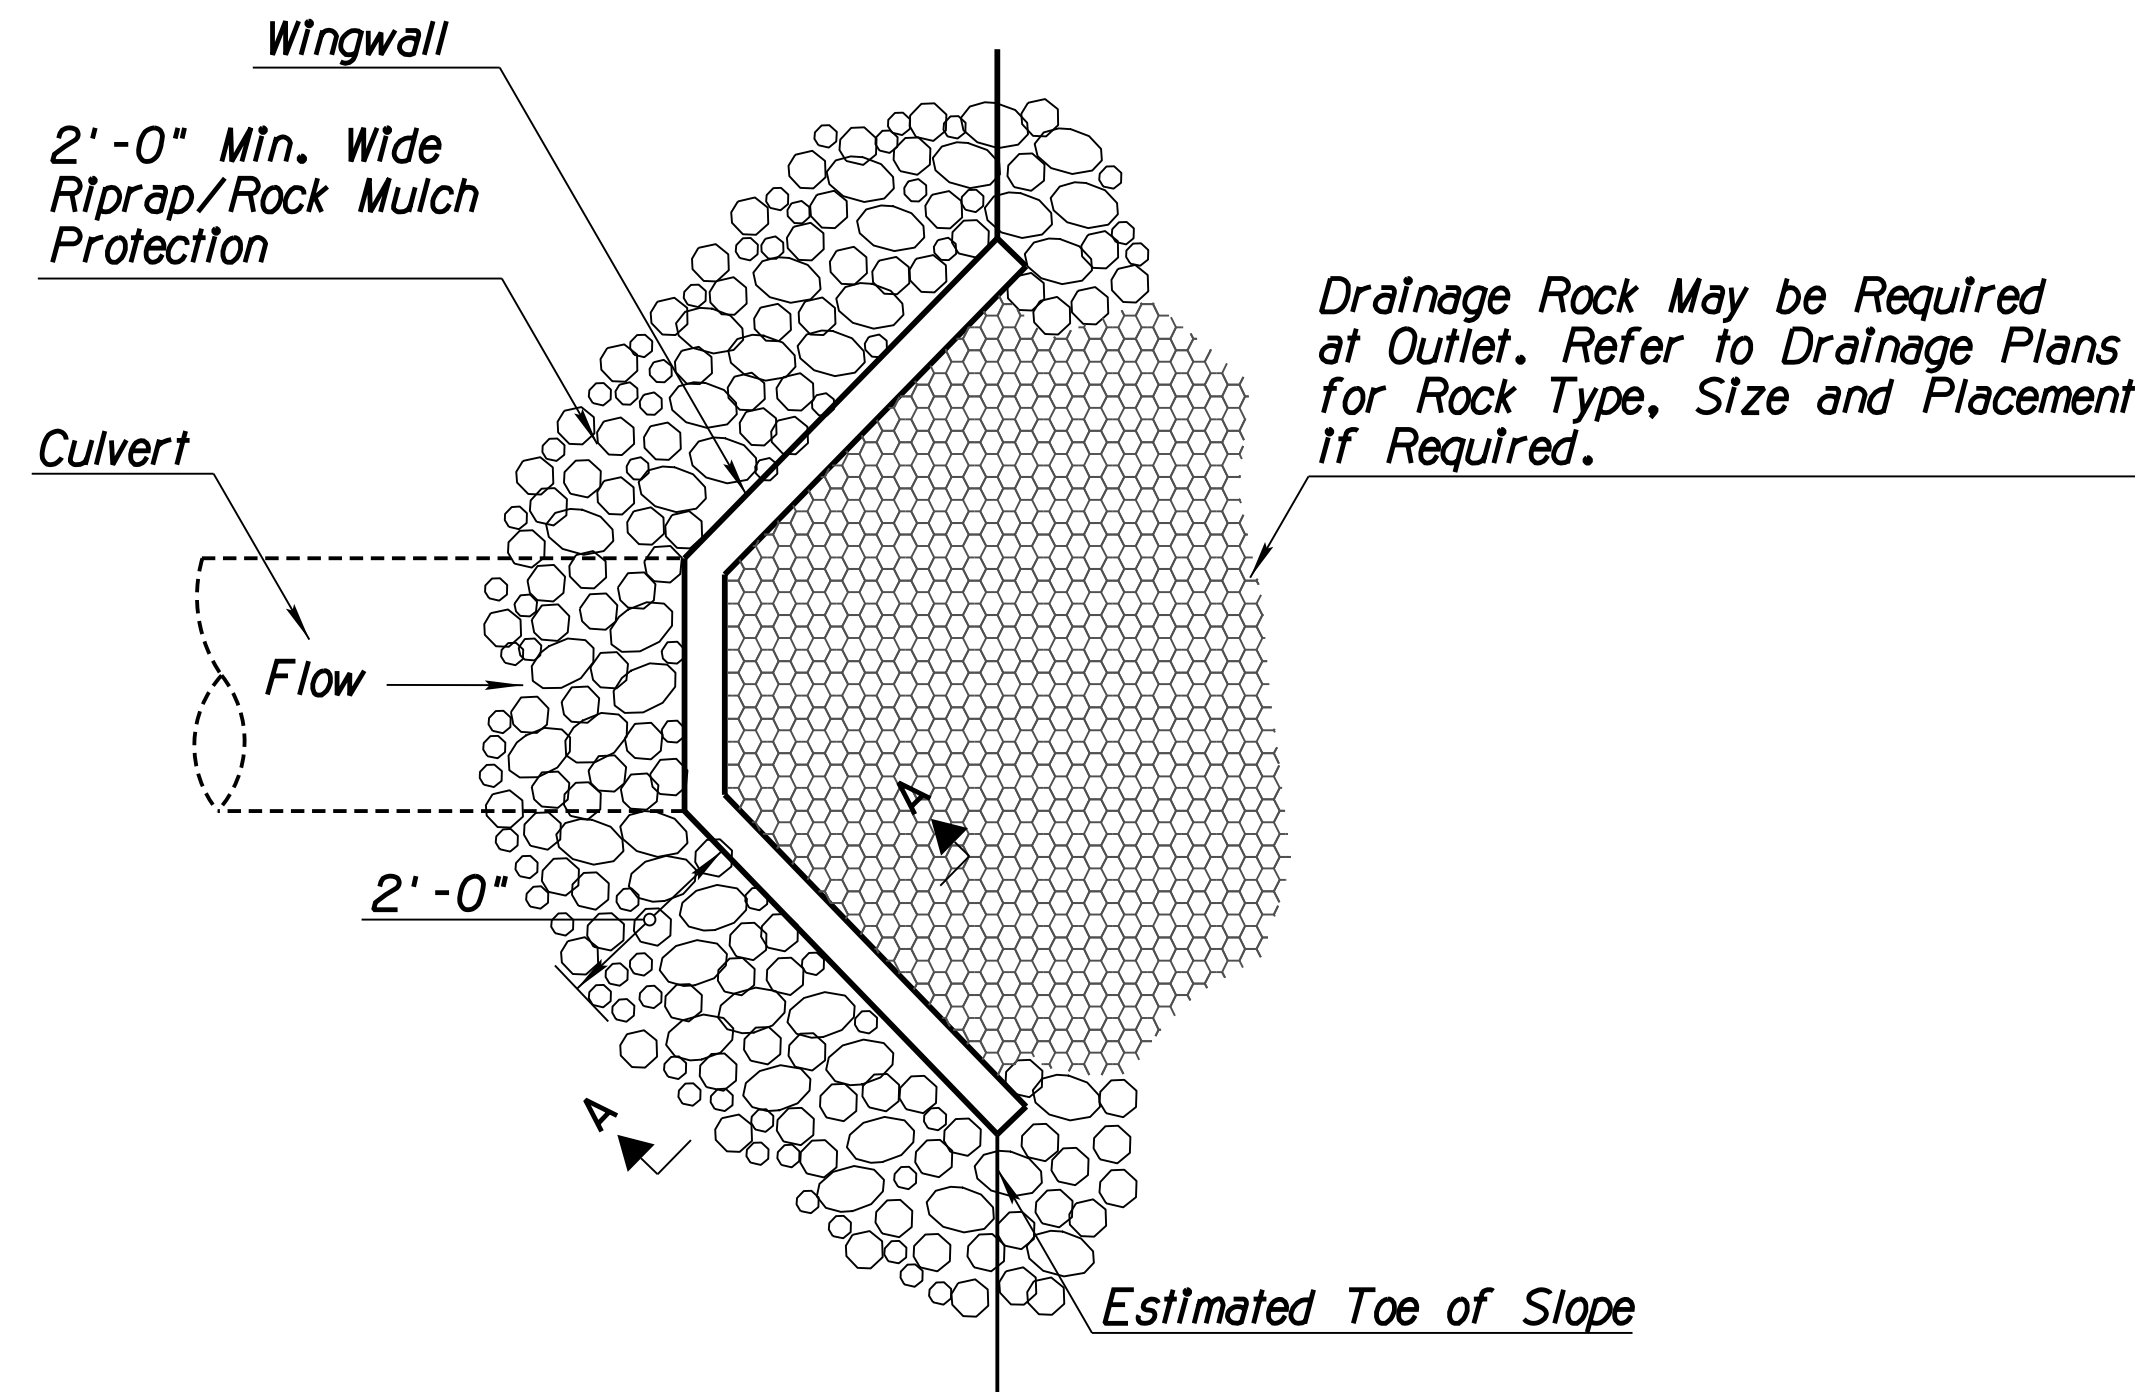


ANGLED HEADWALL  
PLAN VIEW (NTS)

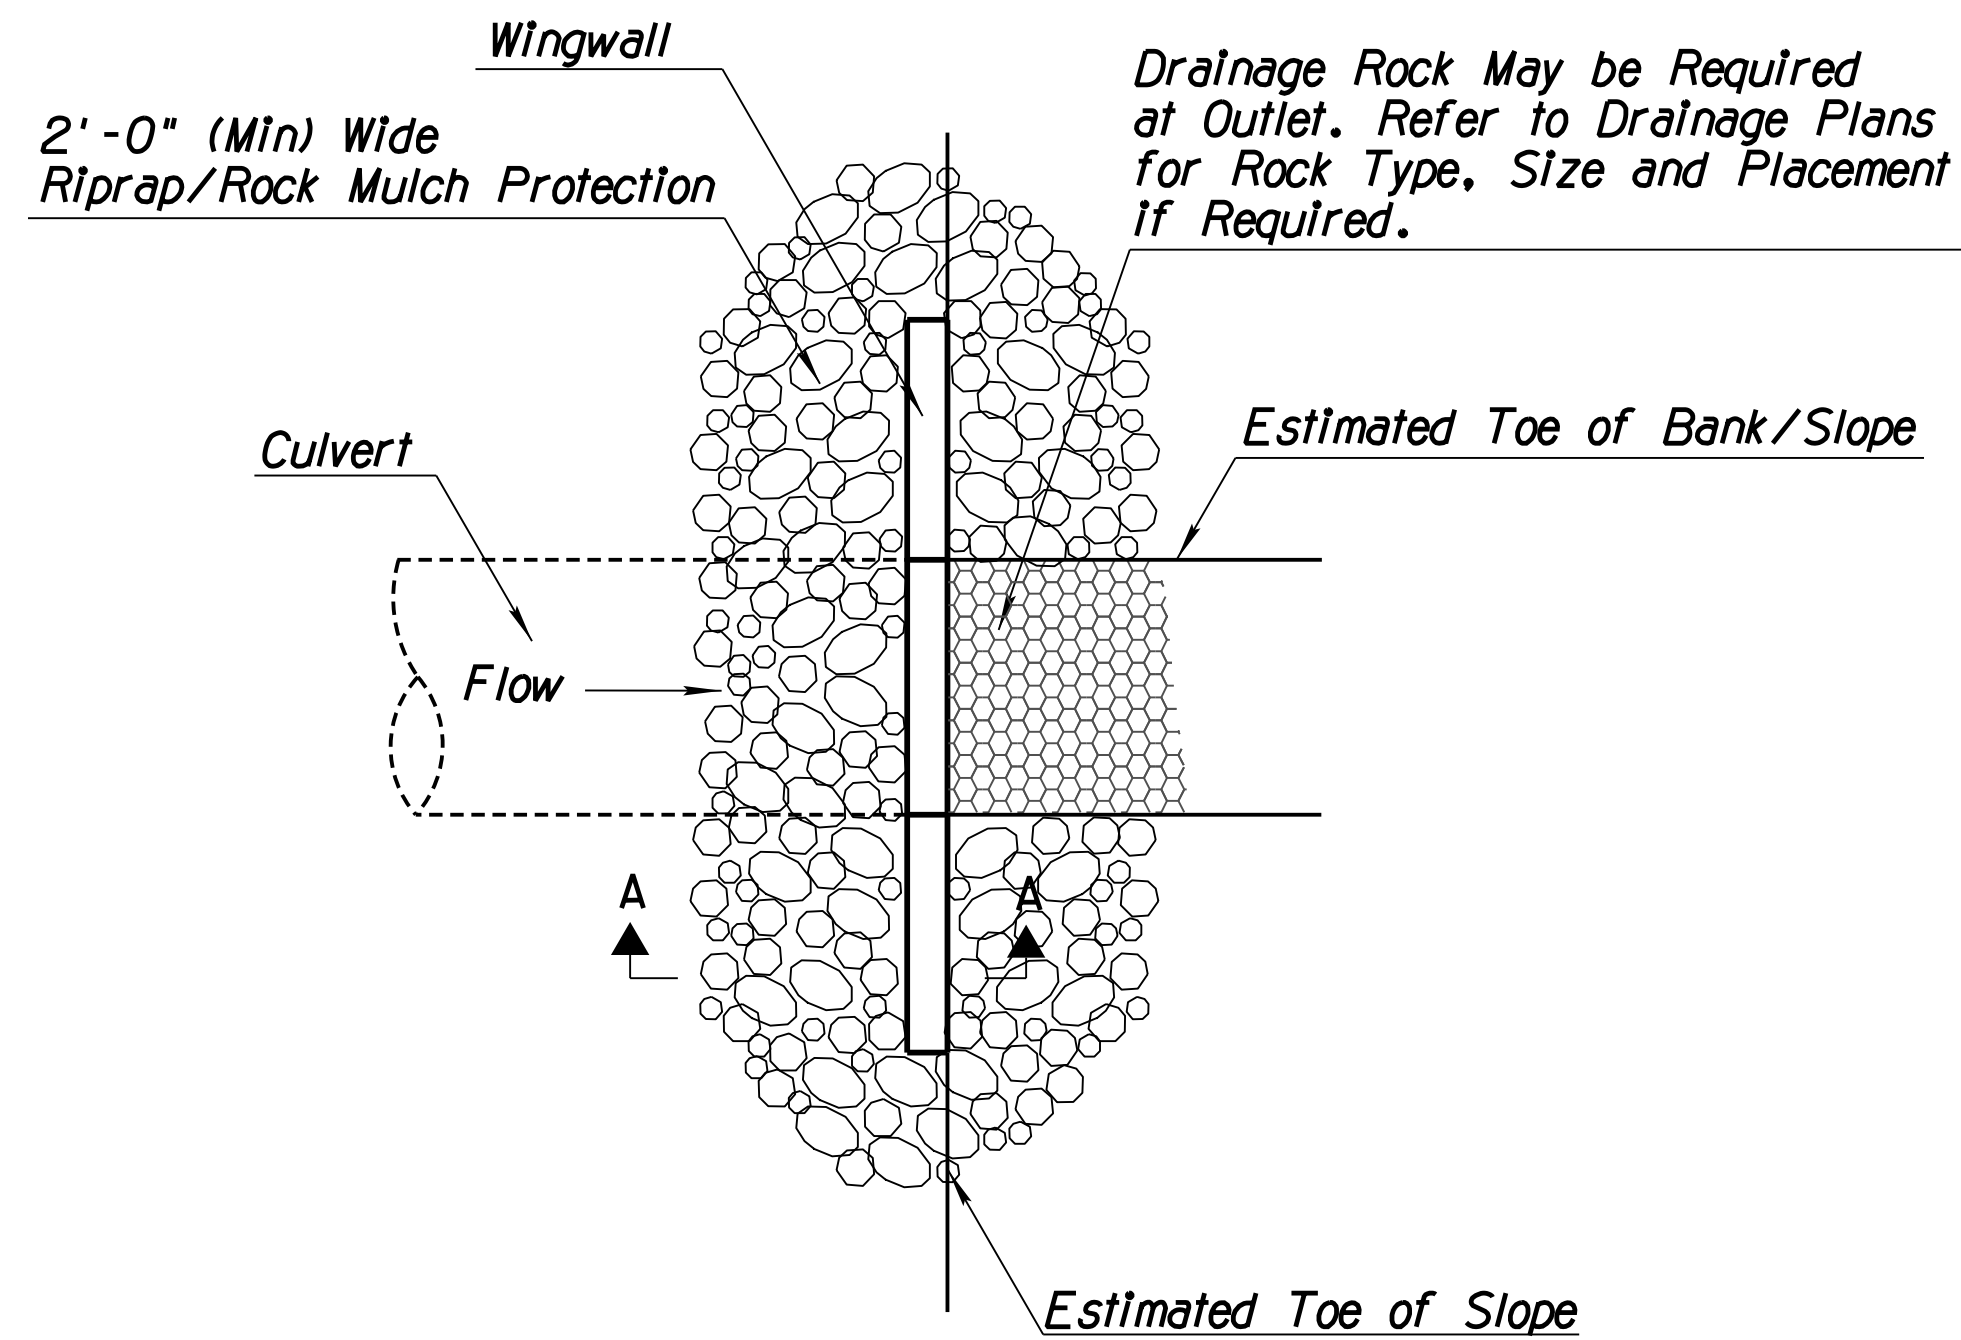


FLUSH HEADWALL  
PLAN VIEW (NTS)

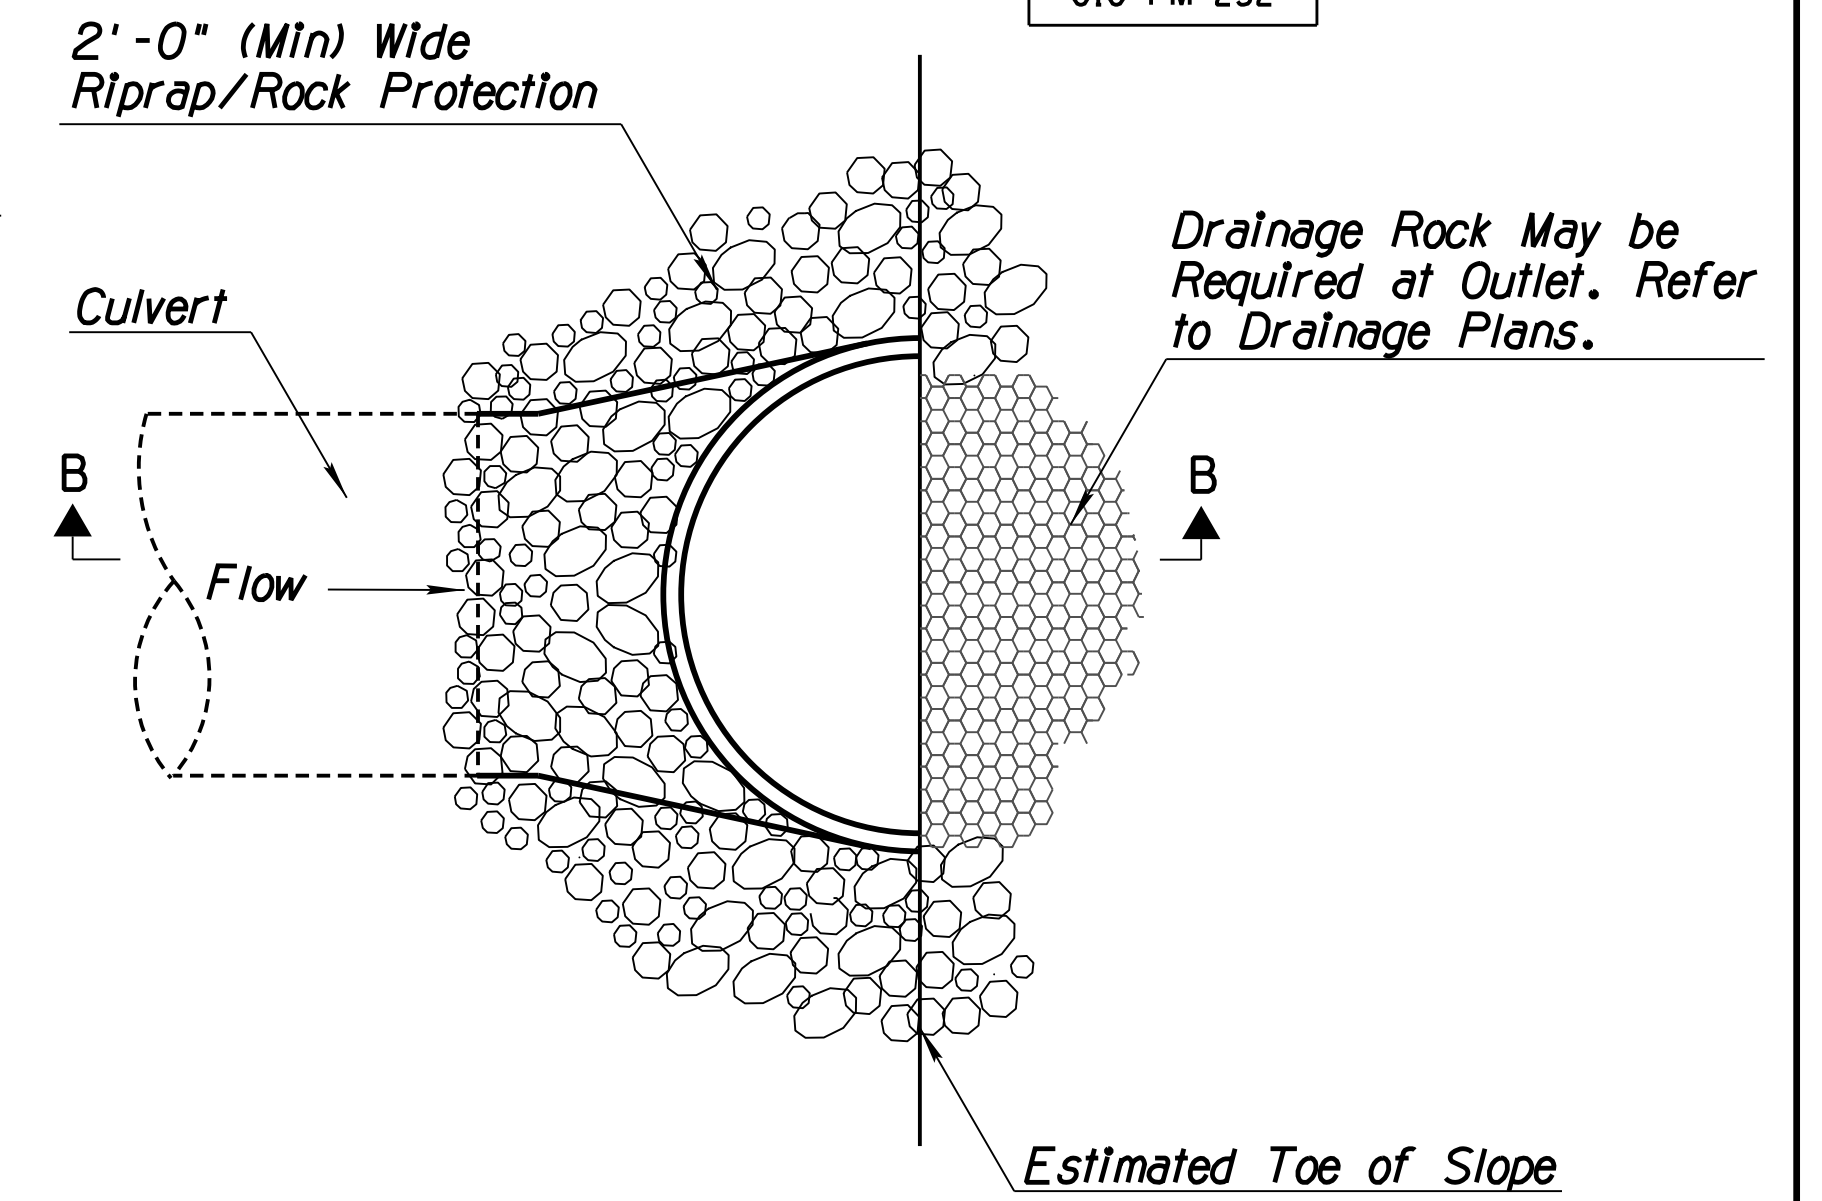

FLARED END  
PLAN VIEW (NTS)

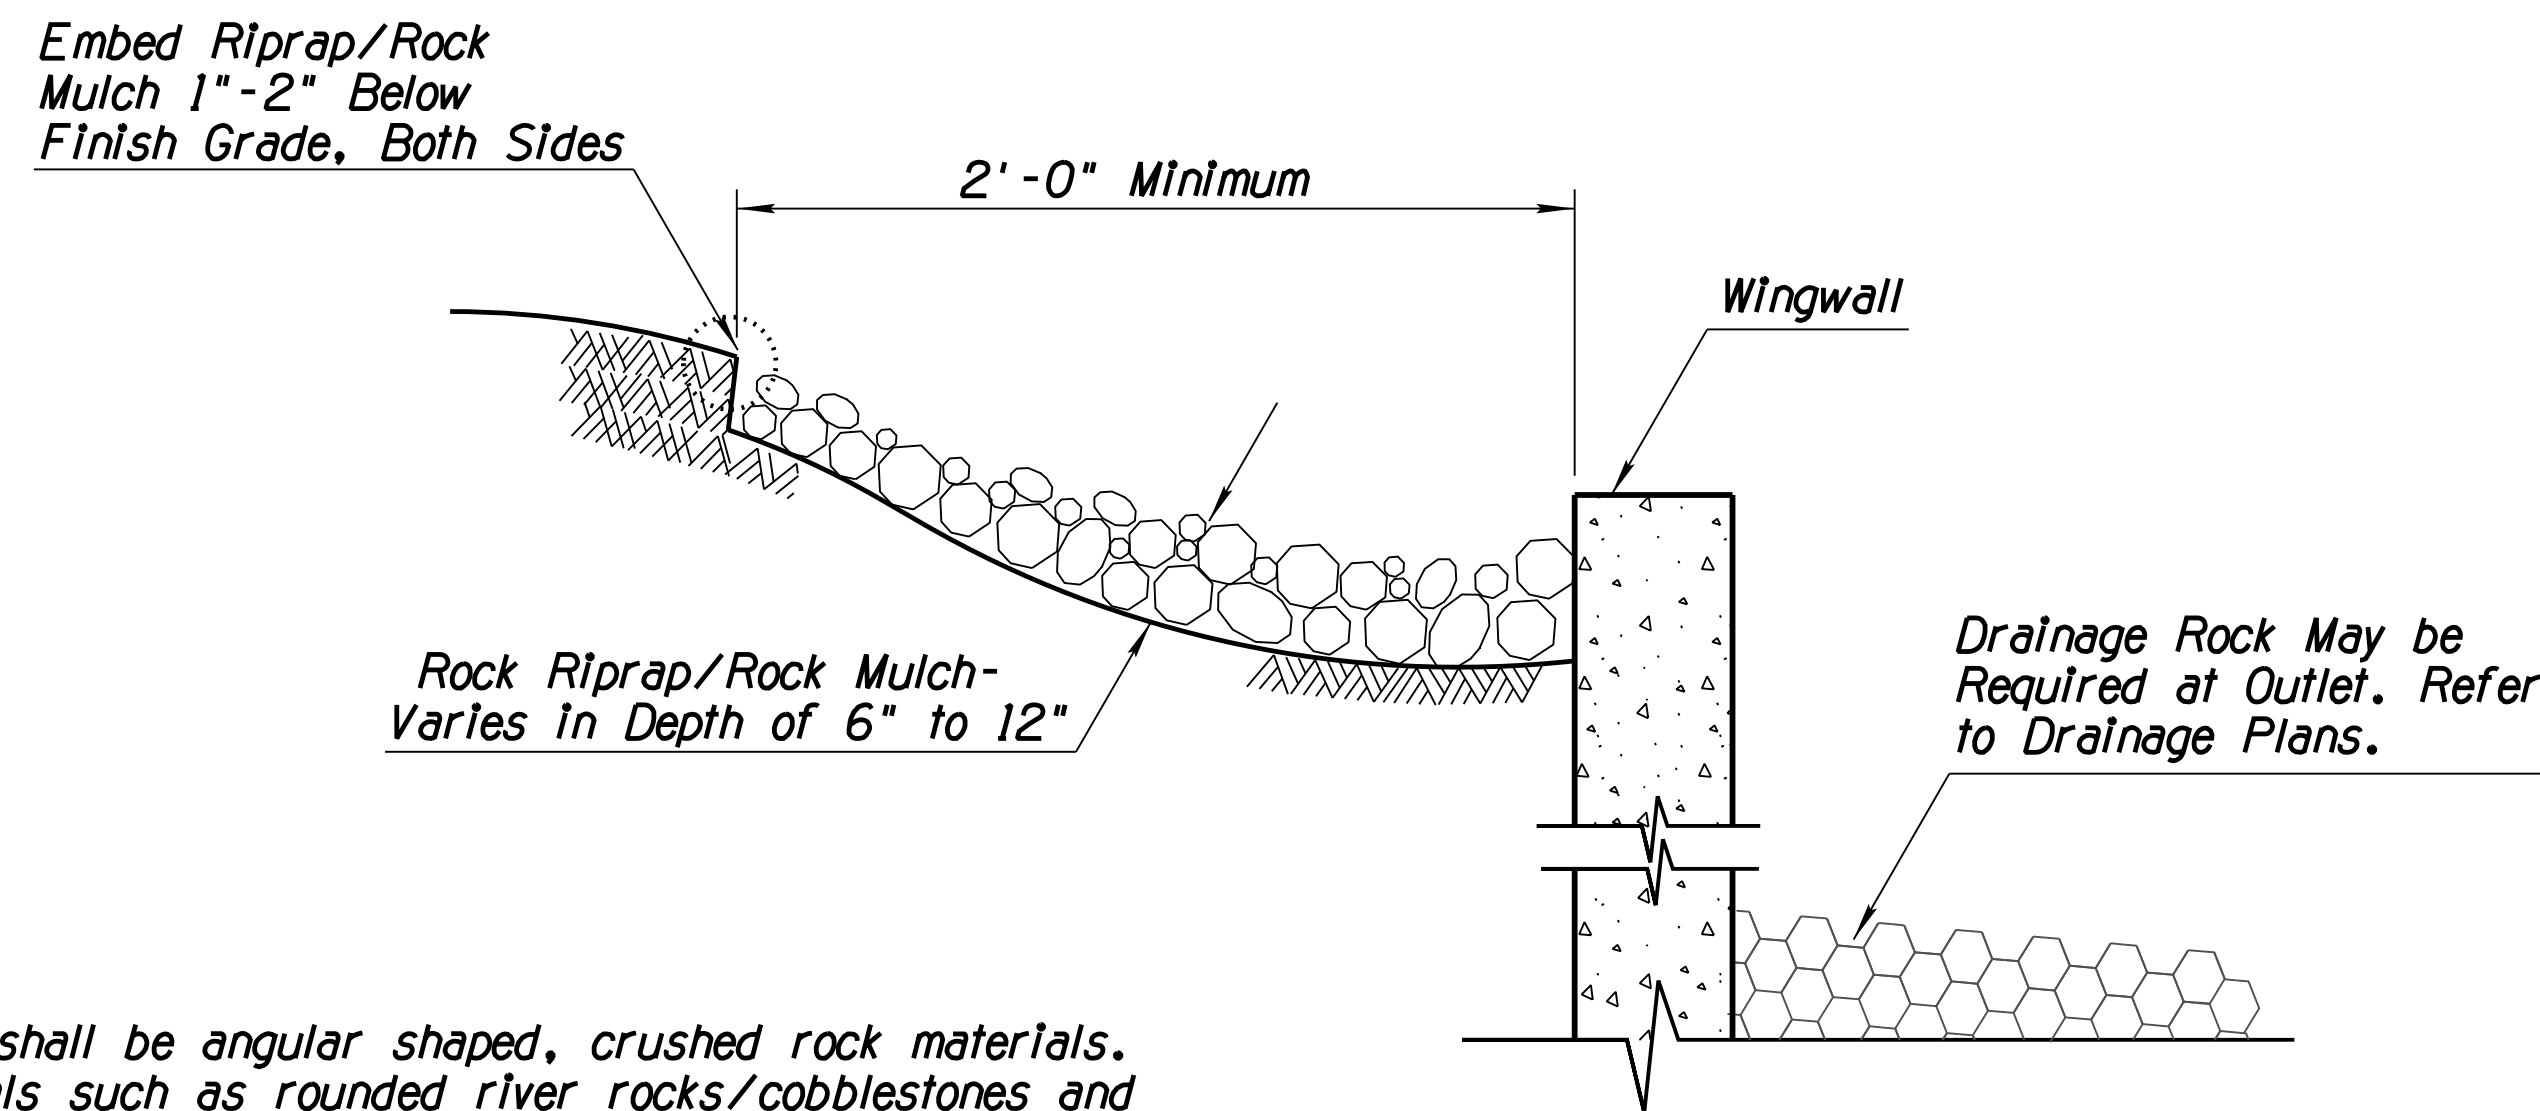

WINGWALL  
SECTION A-A (NTS)

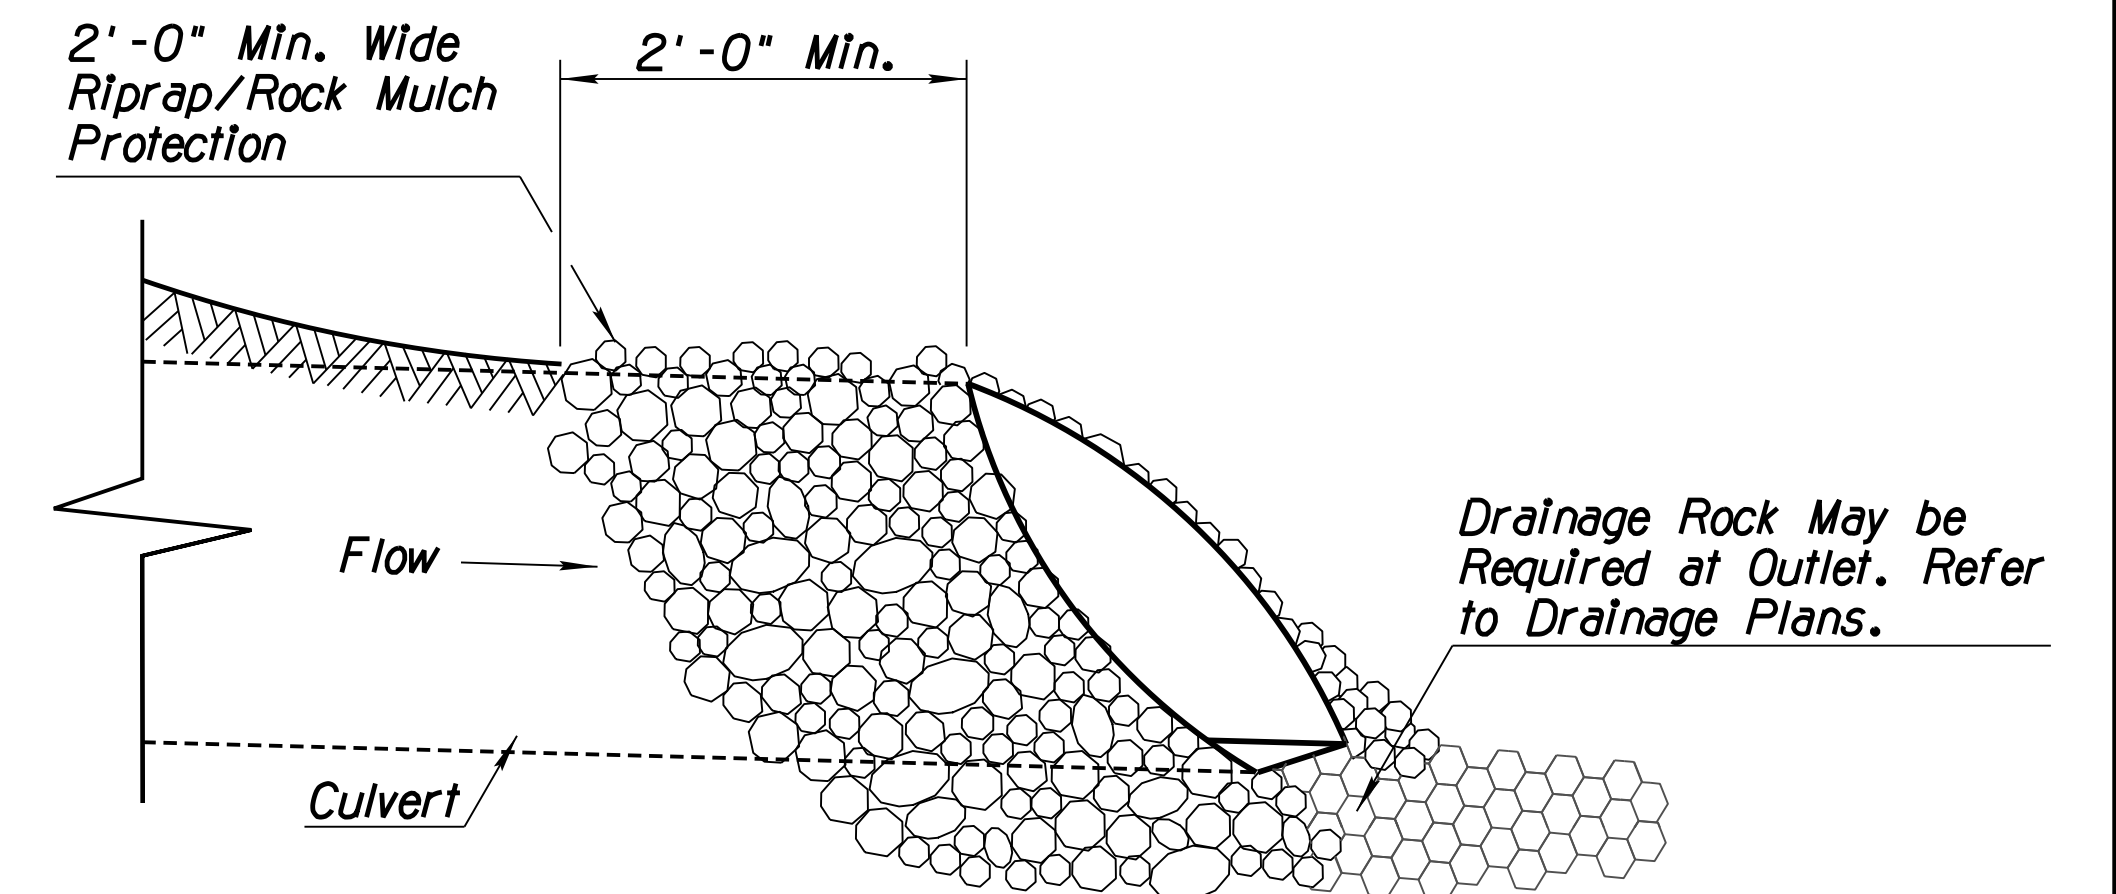

FLARED END  
SECTION B-B (NTS)

NOTES:

1. Rock Riprap/Rock Mulch shall be angular shaped, crushed rock materials. Natural river-run materials such as rounded river rocks/cobblestones and pebbles are NOT acceptable.
2. Rock Riprap/Rock Mulch within the traffic Clear Zone shall conform to the requirements of Section 810-2.03 Sieve Size Gradation A and/or Gradation C, and Section 913 of the Specifications.
3. Embed rock within traffic recovery area/clear zone into the finished grade so that any portion of the rock above the grade will be less than 4" in height.
4. The installation and maintenance of Rock Protection BMPs shall not negatively impact traffic safety, nor the designed function of roadway or bridge drainage facilities. Rock Protection BMPs shall be installed and maintained to carry the stormwater of at least 2-year, 24-hour events.
5. Make field adjustments and corrections of Rock Protection BMP immediately if it is causing flooding, erosion, and/or affecting roadway safety.
6. The Rock Protection BMP's pay/bid item shall include all materials used for this BMP: all ground preparation, furnishing, installing, maintaining as well as returning the area to an acceptable condition as approved by the Engineer.
7. Make field adjustments and corrections to ensure NO sensitive biological resources (native species / habitats) will be adversely impacted.


# DETAIL ES4

ROCK PROTECTION FOR INLETS,  
OUTLETS AND HEADWALL TRANSITION

DESIGN	WDC	3/19	ARIZONA DEPARTMENT OF TRANSPORTATION INFRASTRUCTURE DELIVERY AND OPERATIONS DIVISION ROADSIDE DEVELOPMENT SECTION	
DRAWN	WDC	3/19		
CHECKED	WDC/LEM	3/19		
<b>WHEAT DESIGN GROUP</b> LANDSCAPE ARCHITECTS <small>500 N TUCSON BLVD, SUITE 150, TUCSON AZ 85716</small>		<b>STORMWATER QUALITY PROTECTION &amp; EROSION/SEDIMENT CONTROL DETAIL SHEET</b>		EXPIRES 6-30-2019 DWG NO. E-2.04
ROUTE	LOCATION	RUTHRAUFF ROAD T1		
TRACS NO. H 8480 OIC		010-D(213)S		OF


F.H.W.A. REGION	STATE	PROJECT NO.	SHEET NO.	TOTAL SHEETS	RECORD DRAWING
9	ARIZ.	010-D(213)S	747	849	

010 PM 252

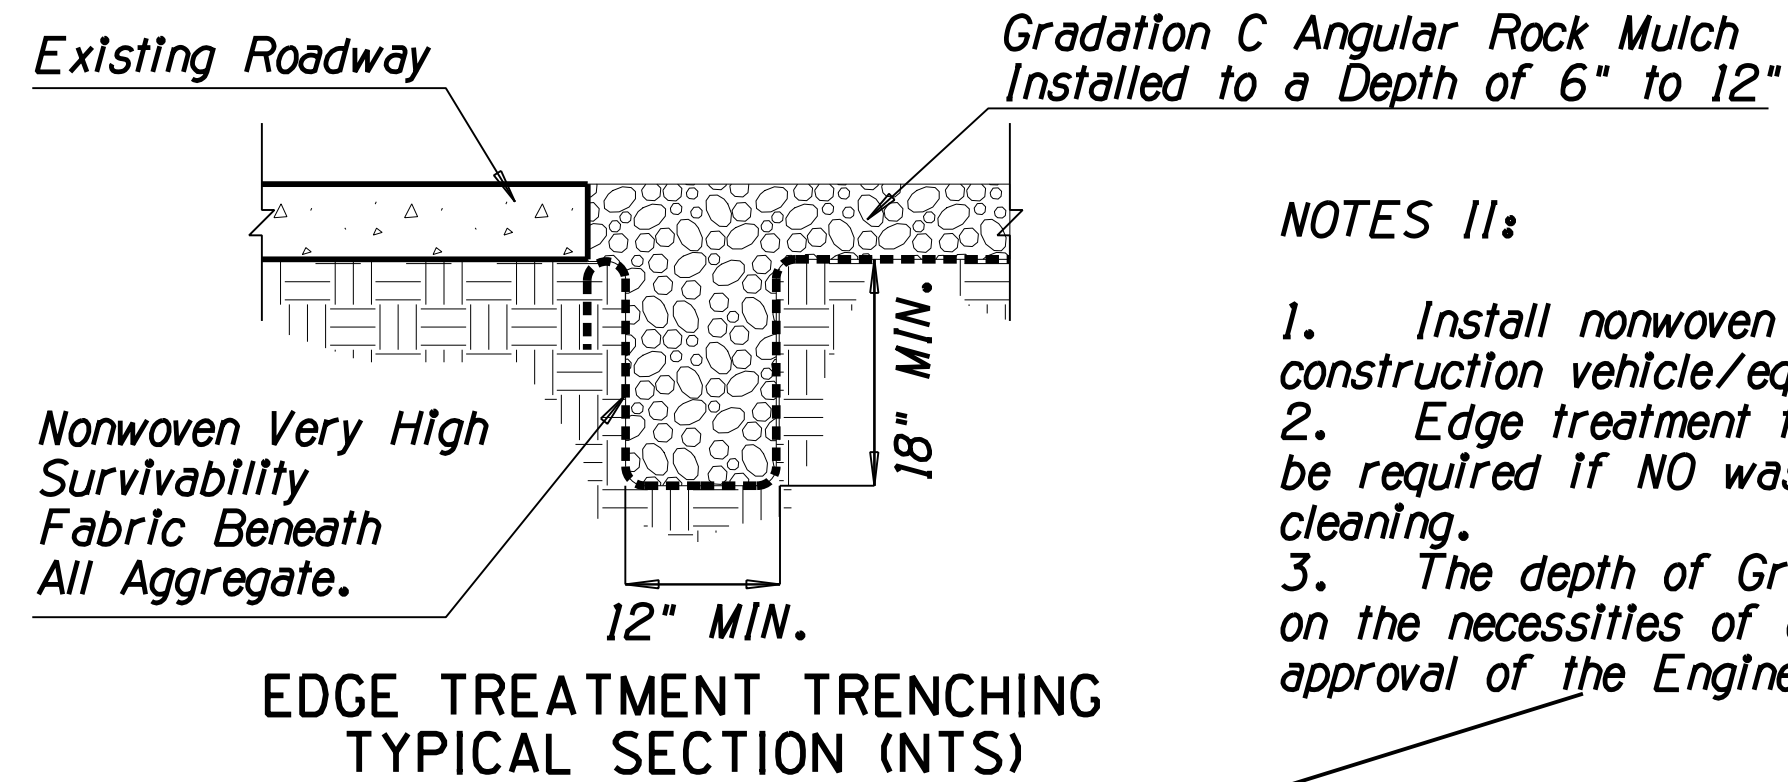

**NOTES II:**

1. Install nonwoven fabric when water is applied for construction vehicle/equipment cleaning on Gravel Pad.
2. Edge treatment trenching and nonwoven fabric shall not be required if NO wash water is used for vehicle/equipment cleaning.
3. The depth of Gravel Pad varies from 6" to 12" based on the necessities of construction vehicle/equipment as per the approval of the Engineer.

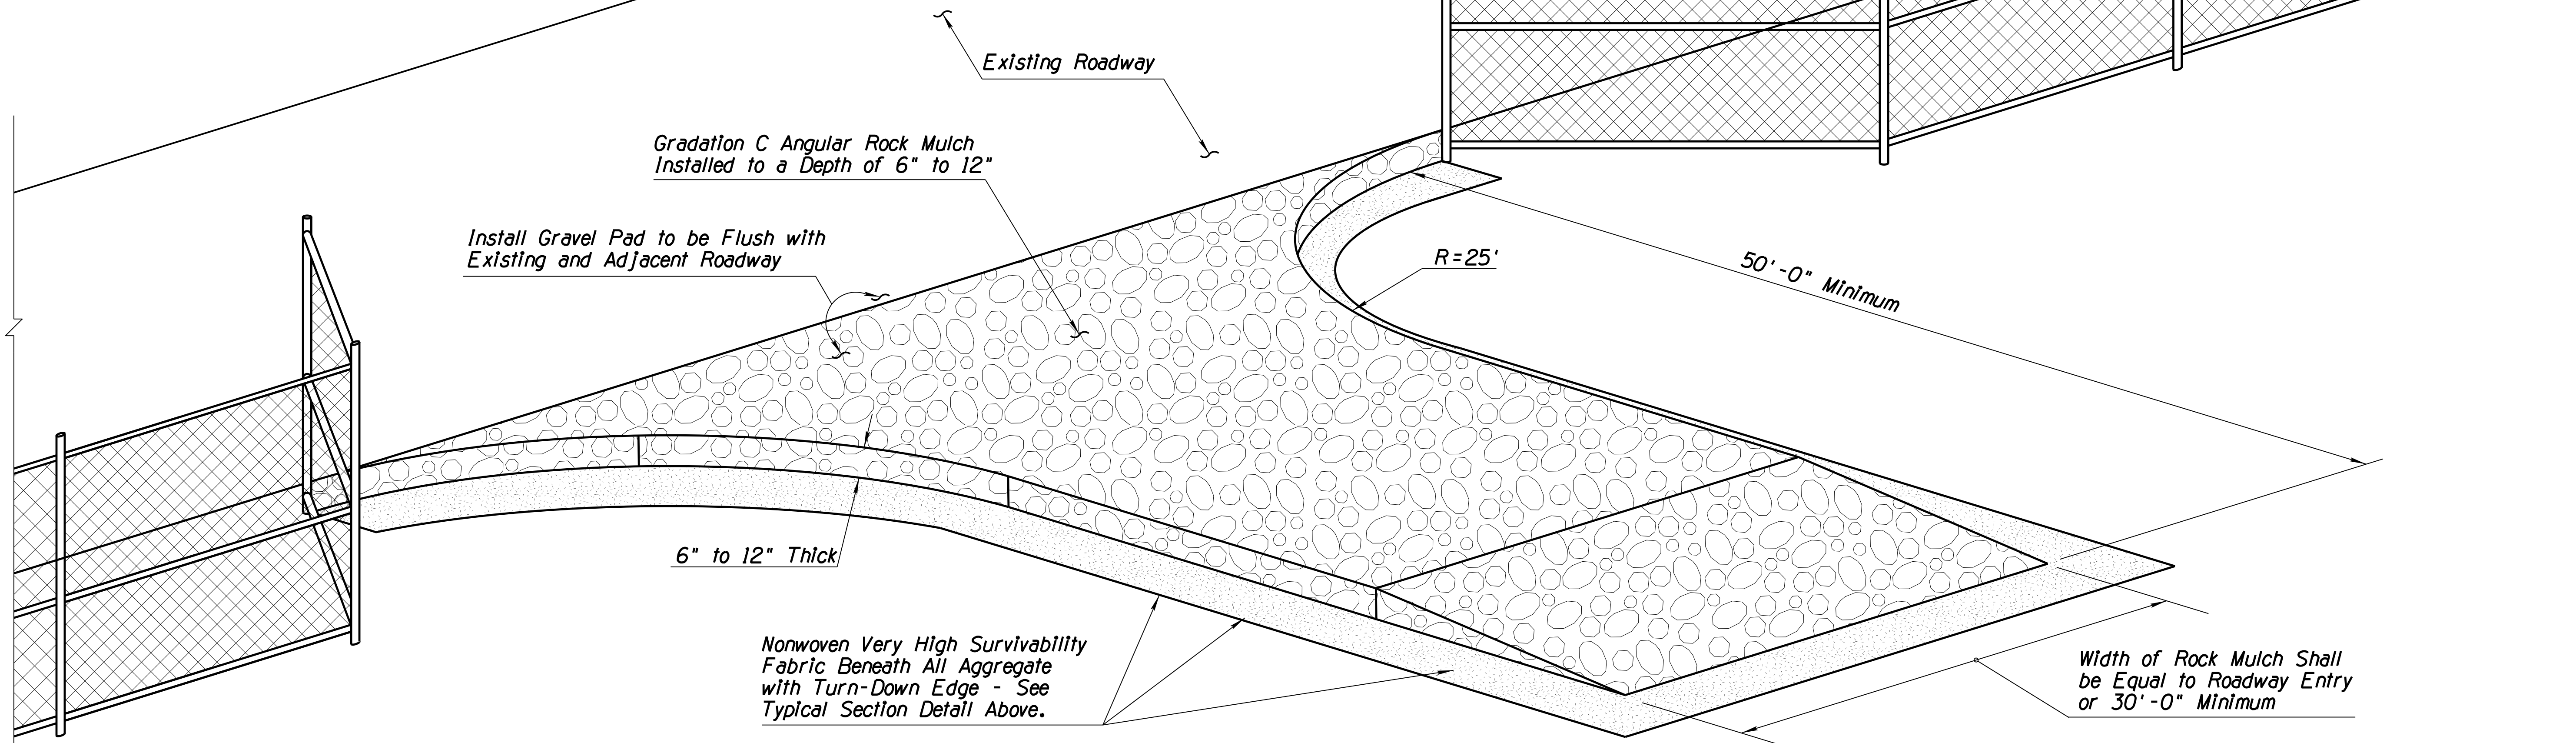

**NOTES:**

1. Install Stabilized Construction Entrance/Exit Gravel Pad BMP for traffic entering or exiting a construction site where sedimentation, clay, silt or other pollutants can be tracked onto public roads and/or adjacent water bodies, as approved by the Engineer. It may also be applied for construction entrance/exit wind erosion/dust control, as approved by the Engineer.
2. Locate new Construction Entrance(s)/Exit(s) at appropriate project entrance/exit points as determined in field with the approval of the Engineer. Relocate Stabilized Construction Entrance/Exit Gravel Pad BMP as needed as project progresses. Replace Rock Mulch materials in drive paths when dirt or mud accumulates.
3. Nonwoven Very High Survivability Fabric shall conform to the standards of Subsection 1014-4.04 of the Standard Specifications.
4. Rock Mulch materials shall be fractured/crushed rocks in angular shape and as defined in the Subsection 810-2.03 of the Standard Specifications. Natural river-run materials, especially rounded natural river rocks are not acceptable.
5. Make field adjustments and corrections of Construction Entrance/Exit Gravel Pad BMP immediately if it is causing flooding and/or affecting roadway safety.
6. When paid separately, the Stabilized Construction Entrance/Exit Gravel Pad BMP's pay/bid item shall include all materials used for this BMP; all ground preparation, furnishing, installing, final removal, and disposal of this temporary BMP, as well as returning the area to an acceptable condition as approved by the Engineer.
7. \* Fence/barricade pay/bid item shall be included as a component of the Stabilized Construction Entrance/Exit Gravel Pad BMP pay/bid item.
8. Make field adjustments and corrections to ensure NO sensitive biological resources (native species / habitats) will be adversely impacted.

BIRD'S EYE VIEW (NTS)

# DETAIL ES5



## STABILIZED CONSTRUCTION ENTRANCE/EXIT GRAVEL PAD

DESIGN	WDC	DATE	3/19	ARIZONA DEPARTMENT OF TRANSPORTATION INFRASTRUCTURE DELIVERY AND OPERATIONS DIVISION ROADSIDE DEVELOPMENT SECTION	
DRAWN	WDC	DATE	3/19		
CHECKED	WDC/LEM	DATE	3/19		
<b>WHEAT DESIGN GROUP</b>		LANDSCAPE ARCHITECTS		STORMWATER QUALITY PROTECTION & EROSION/SEDIMENT CONTROL DETAIL SHEET	
500 N TUCSON BLVD, SUITE 150, TUCSON AZ 85716				EXPIRES 6-30-2019	
ROUTE	I-10	LOCATION	RUTHRAUFF ROAD TI	DWG NO. E-2.05	
TRACS NO. H 8480 01C			010-D(213)S		
			OF		



F.H.W.A. REGION	STATE	PROJECT NO.	SHEET NO.	TOTAL SHEETS	RECORD DRAWING
9	ARIZ.	010-D(213)S	748	849	

010 PM 252

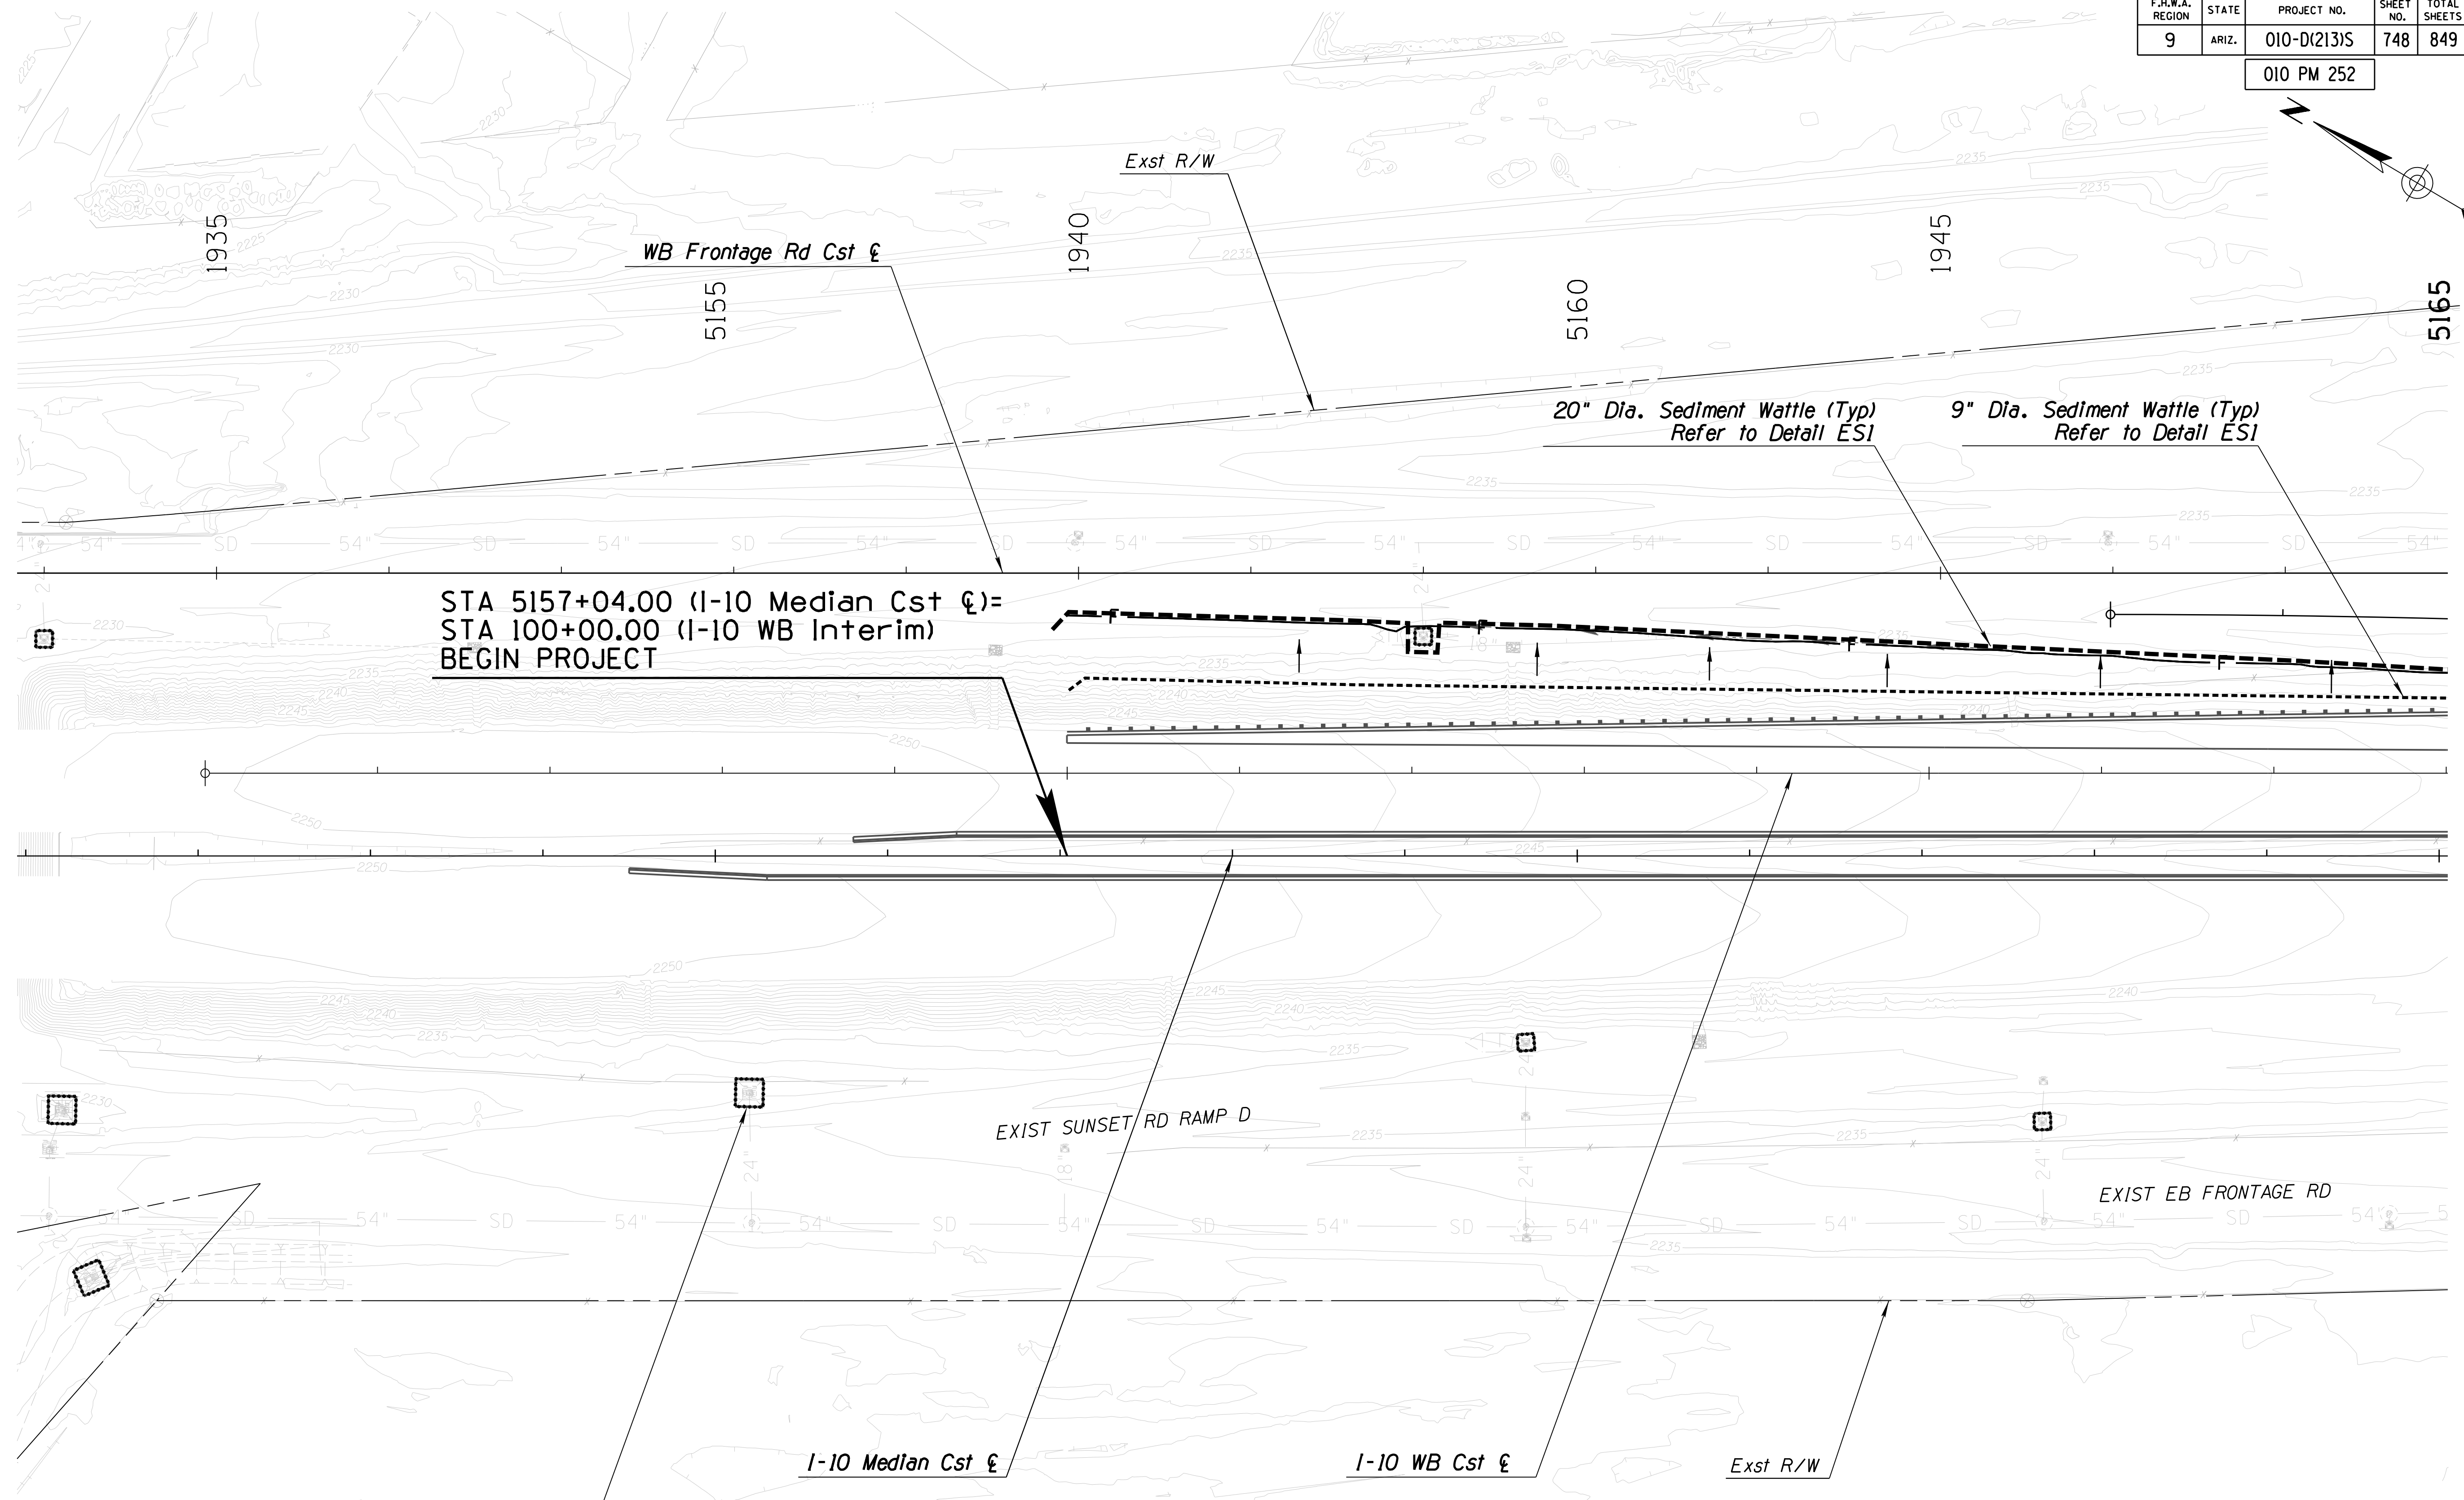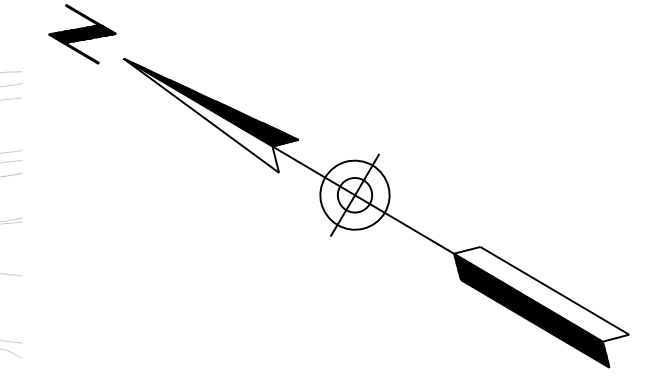

STA 5157+04.00 (I-10 Median Cst &)=  
 STA 100+00.00 (I-10 WB Interim)  
 BEGIN PROJECT

Inlet Protection (Typ)  
 Refer to Detail ES3



DESIGN	WDC	DATE	3/19	ARIZONA DEPARTMENT OF TRANSPORTATION INFRASTRUCTURE DELIVERY AND OPERATIONS DIVISION ROADSIDE DEVELOPMENT SECTION	
DRAWN	WDC	3/19			
CHECKED	WDC/LEM	3/19			
<b>WHEAT DESIGN GROUP</b> LANDSCAPE ARCHITECTS <small>500 N TUCSON BLVD, SUITE 150, TUCSON AZ 85716</small>		<b>EROSION CONTROL PLAN</b> <b>I-10 MED CONST &amp;</b> <b>STA 5151+00 TO 5165+00</b>		EXPIRES 6-30-2019 DWG NO. E-3.01	
ROUTE	LOCATION				
I-10	RUTHRAUFF ROAD TI				
TRACS NO. H 8480 OIC		010-D(213)S		OF	

SURVEY NO.    FINISHED PLANS    DATE    LOCATION    REVISIONS    FINISHED PLANS    DATE    LOCATION    REVISIONS    SURVEY NO.



F.H.W.A. REGION	STATE	PROJECT NO.	SHEET NO.	TOTAL SHEETS	RECORD DRAWING
9	ARIZ.	010-D(213)S	749	849	

010 PM 252

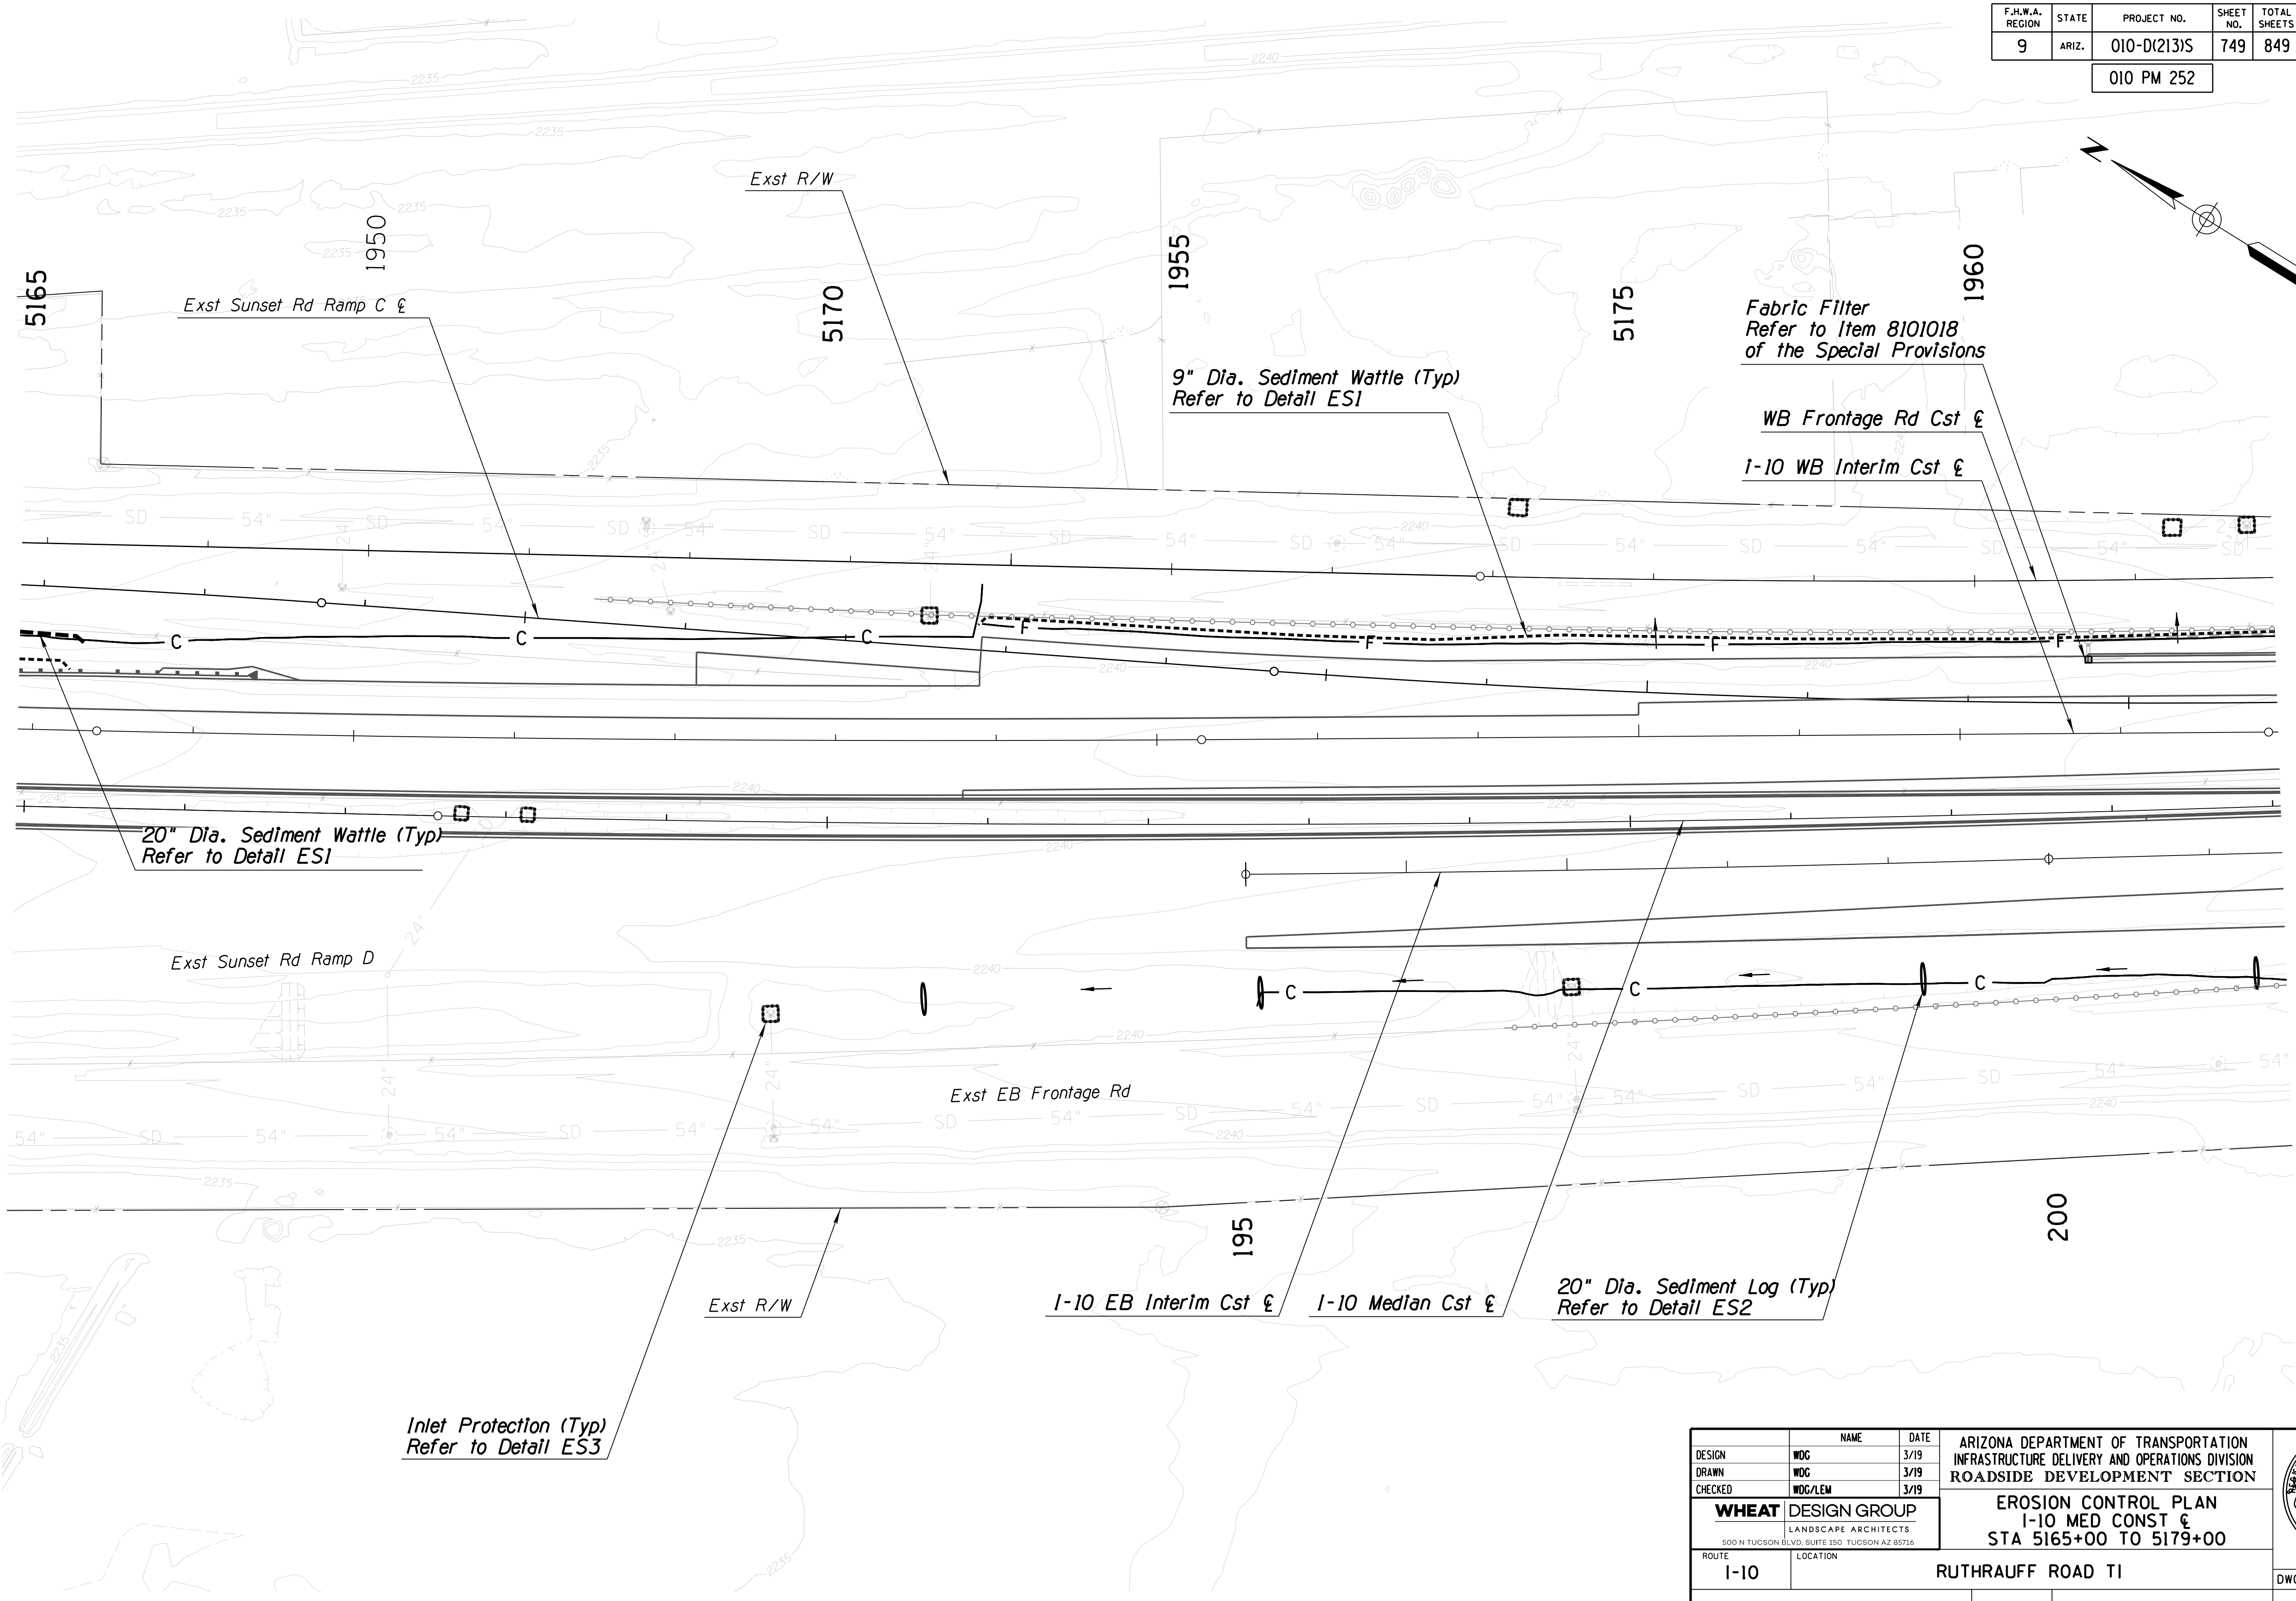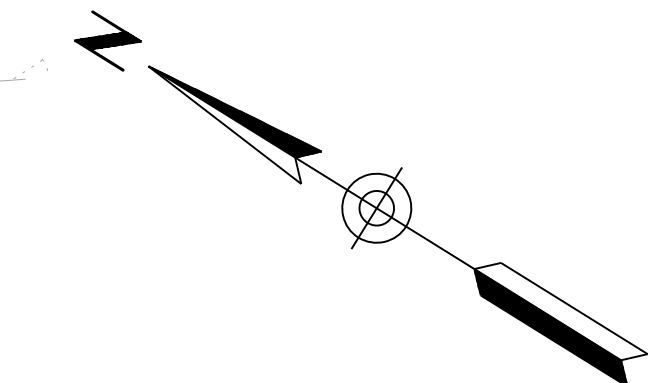


SURVEY NO. FINISHED PLANS DATE LOCATION REVISIONS FINISHED PLANS DATE SURVEY NO. FINISHED PLANS DATE LOCATION REVISIONS FINISHED PLANS DATE SURVEY NO.

ccccSYTIMEcccc      cccccDGNcSPECIFICATIONcccc

DESIGN	WDC	3/19	ARIZONA DEPARTMENT OF TRANSPORTATION INFRASTRUCTURE DELIVERY AND OPERATIONS DIVISION ROADSIDE DEVELOPMENT SECTION	
DRAWN	WDC	3/19		
CHECKED	WDC/LEM	3/19		
<b>WHEAT DESIGN GROUP</b> LANDSCAPE ARCHITECTS <small>500 N TUCSON BLVD, SUITE 150, TUCSON AZ 85716</small>			<b>EROSION CONTROL PLAN</b> <b>1-10 MED CONST &amp;</b> <b>STA 5165+00 TO 5179+00</b>	EXPIRES 6-30-2019 DWG NO. E-3.02
ROUTE	I-10	LOCATION	RUTHRAUFF ROAD TI	
TRACS NO. H 8480 OIC		010-D(213)S		OF

F.H.W.A. REGION	STATE	PROJECT NO.	SHEET NO.	TOTAL SHEETS	RECORD DRAWING
9	ARIZ.	010-D(213)S	750	849	

010 PM 252

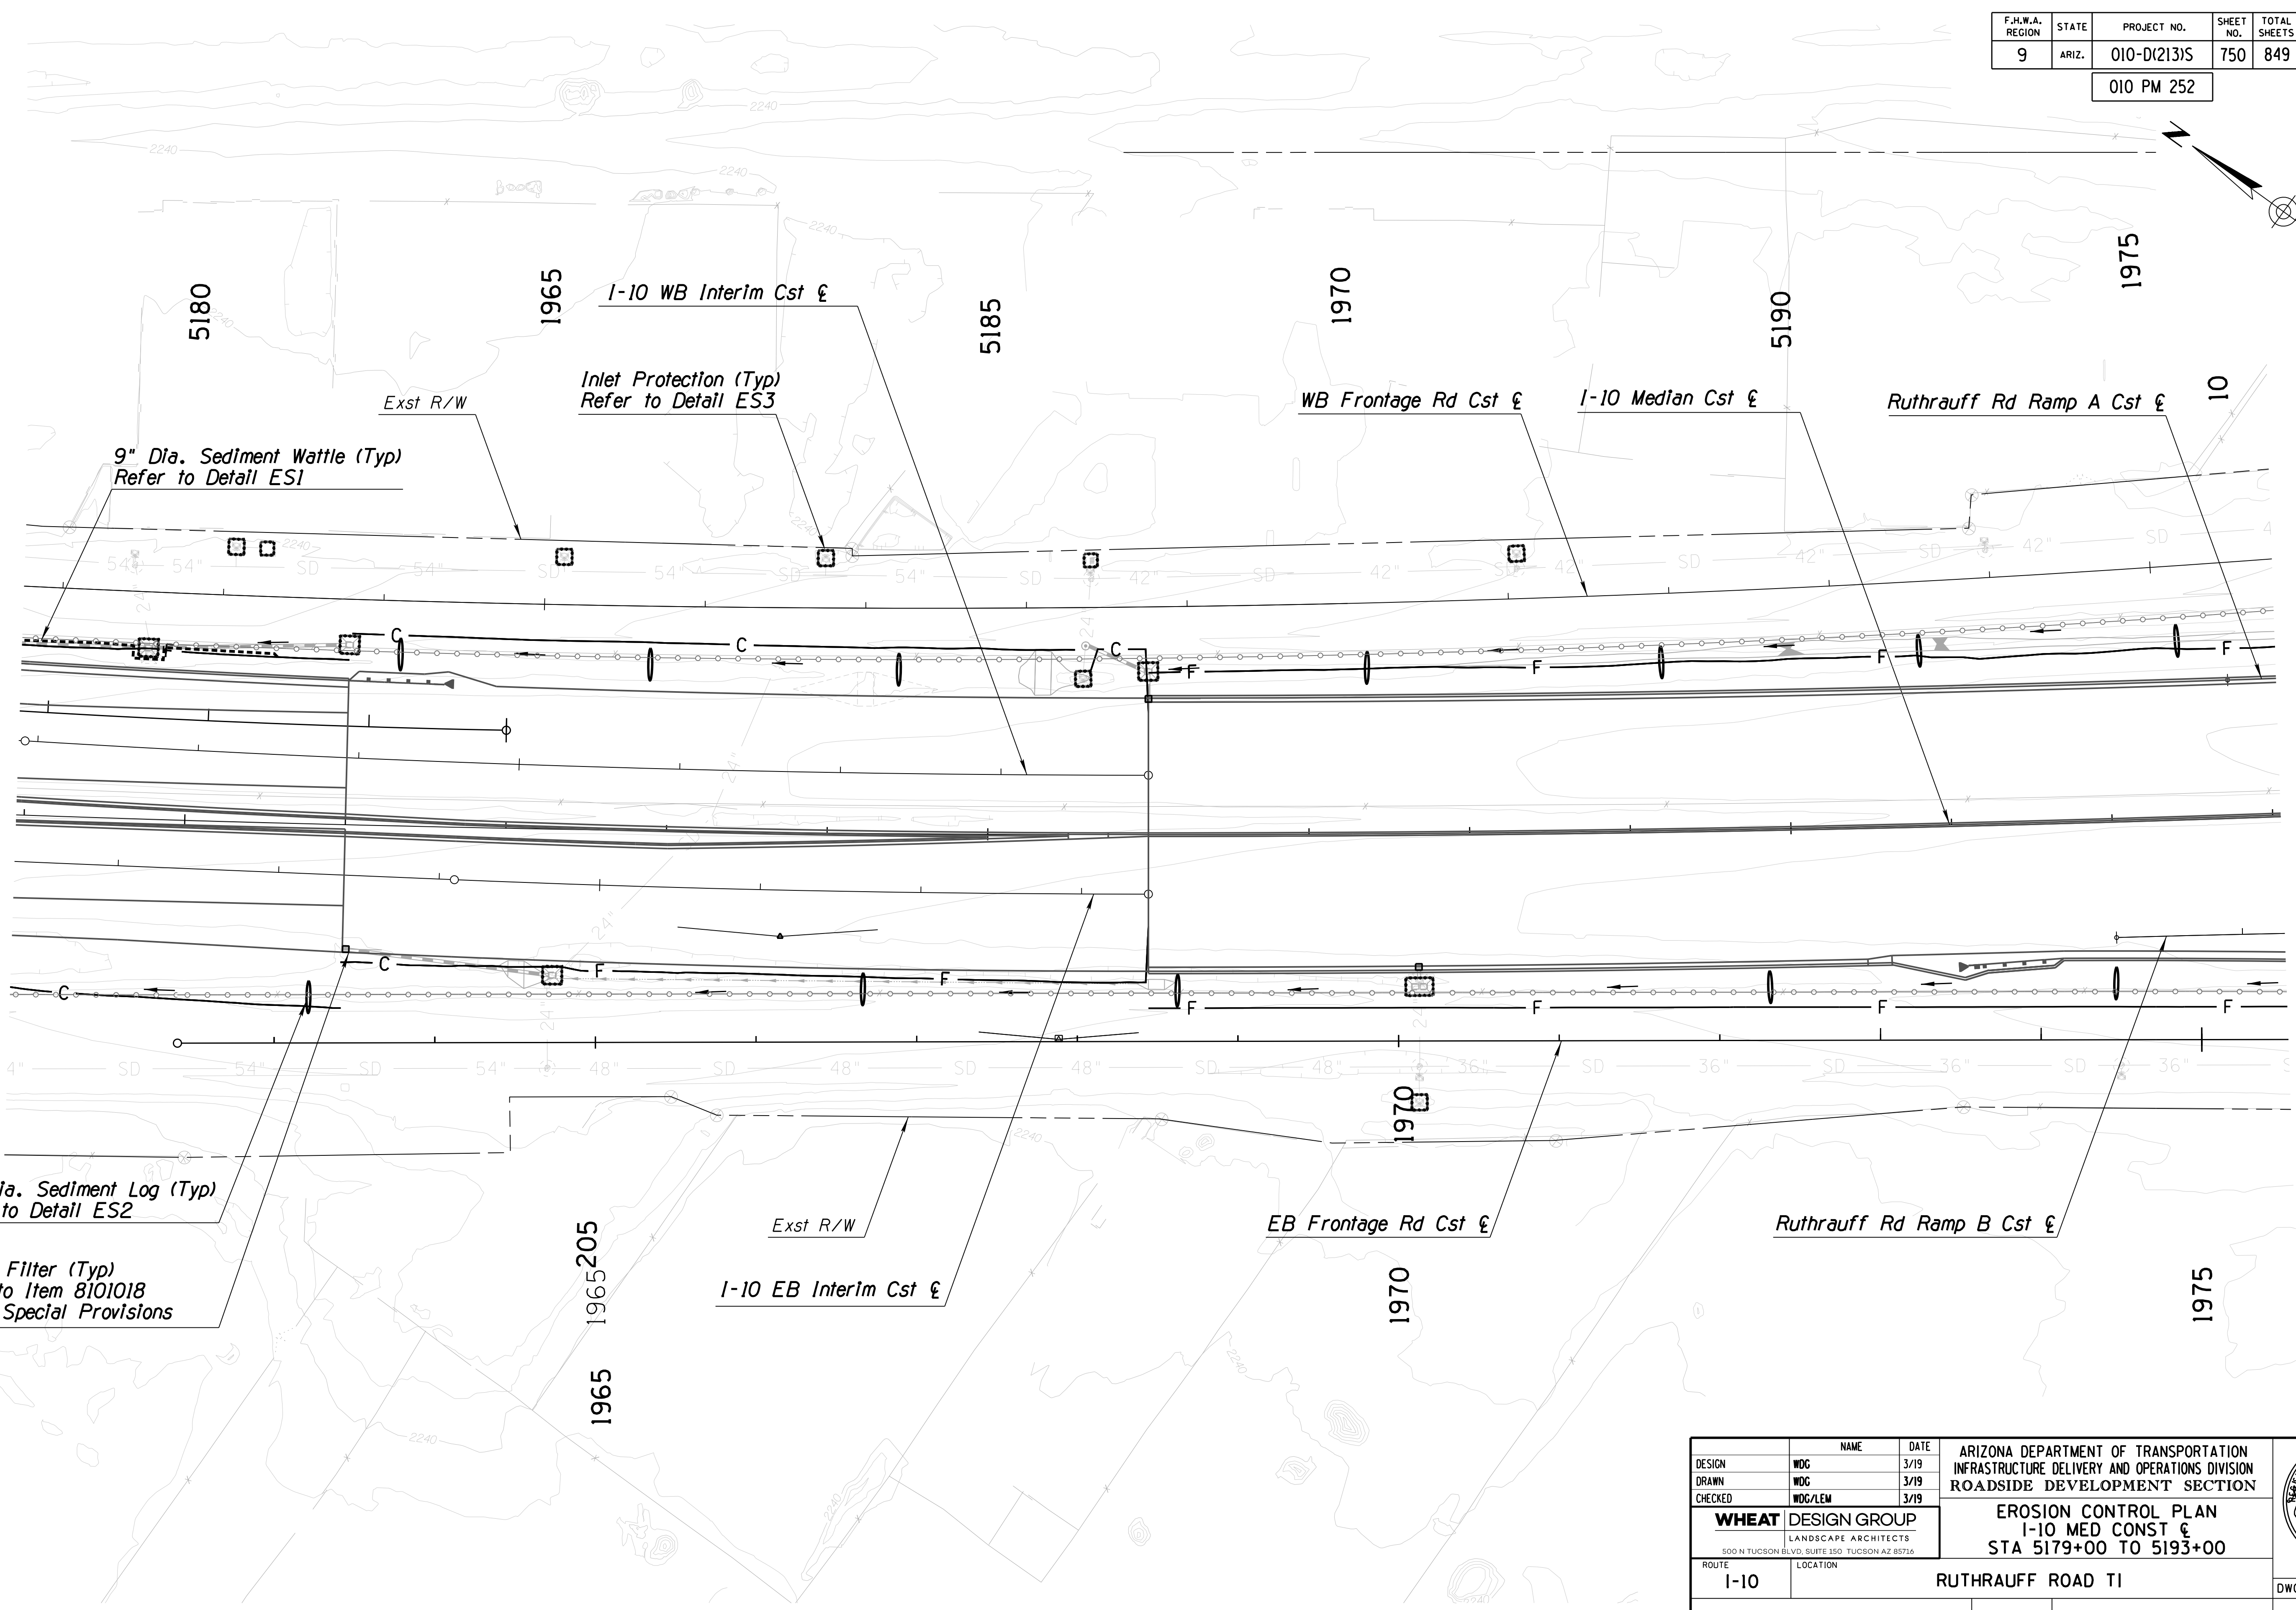

9" Dia. Sediment Wattle (Typ)  
Refer to Detail ES1

Exst R/W

I-10 WB Interim Cst €

Inlet Protection (Typ)  
Refer to Detail ES3

WB Frontage Rd Cst €

I-10 Median Cst €

Ruthrauff Rd Ramp A Cst €

20" Dia. Sediment Log (Typ)  
Refer to Detail ES2

Exst R/W

I-10 EB Interim Cst €

EB Frontage Rd Cst €

Ruthrauff Rd Ramp B Cst €

Fabric Filter (Typ)  
Refer to Item 8101018  
of the Special Provisions

DATE- LOCATION- REVISIONS- FINISHED PLANS- SURVEY NO. DATE- LOCATION- REVISIONS- FINISHED PLANS- SURVEY NO.



DESIGN	WDC	3/19	ARIZONA DEPARTMENT OF TRANSPORTATION INFRASTRUCTURE DELIVERY AND OPERATIONS DIVISION ROADSIDE DEVELOPMENT SECTION		
DRAWN	WDC	3/19			
CHECKED	WDC/LEM	3/19			
<b>WHEAT DESIGN GROUP</b> LANDSCAPE ARCHITECTS <small>500 N TUCSON BLVD, SUITE 150, TUCSON AZ 85716</small>			<b>EROSION CONTROL PLAN</b> <b>I-10 MED CONST €</b> <b>STA 5179+00 TO 5193+00</b>		
ROUTE	LOCATION		EXPIRES 6-30-2019		
I-10	RUTHRAUFF ROAD TI		DWG NO. E-3.03		
TRACS NO. H 8480 OIC			010-D(213)S		
			OF		

ccccSYTIMEcccc

ccccDGNcSPECIFICATIONcccc

F.H.W.A. REGION	STATE	PROJECT NO.	SHEET NO.	TOTAL SHEETS	RECORD DRAWING
9	ARIZ.	010-D(213)S	751	849	

010 PM 252

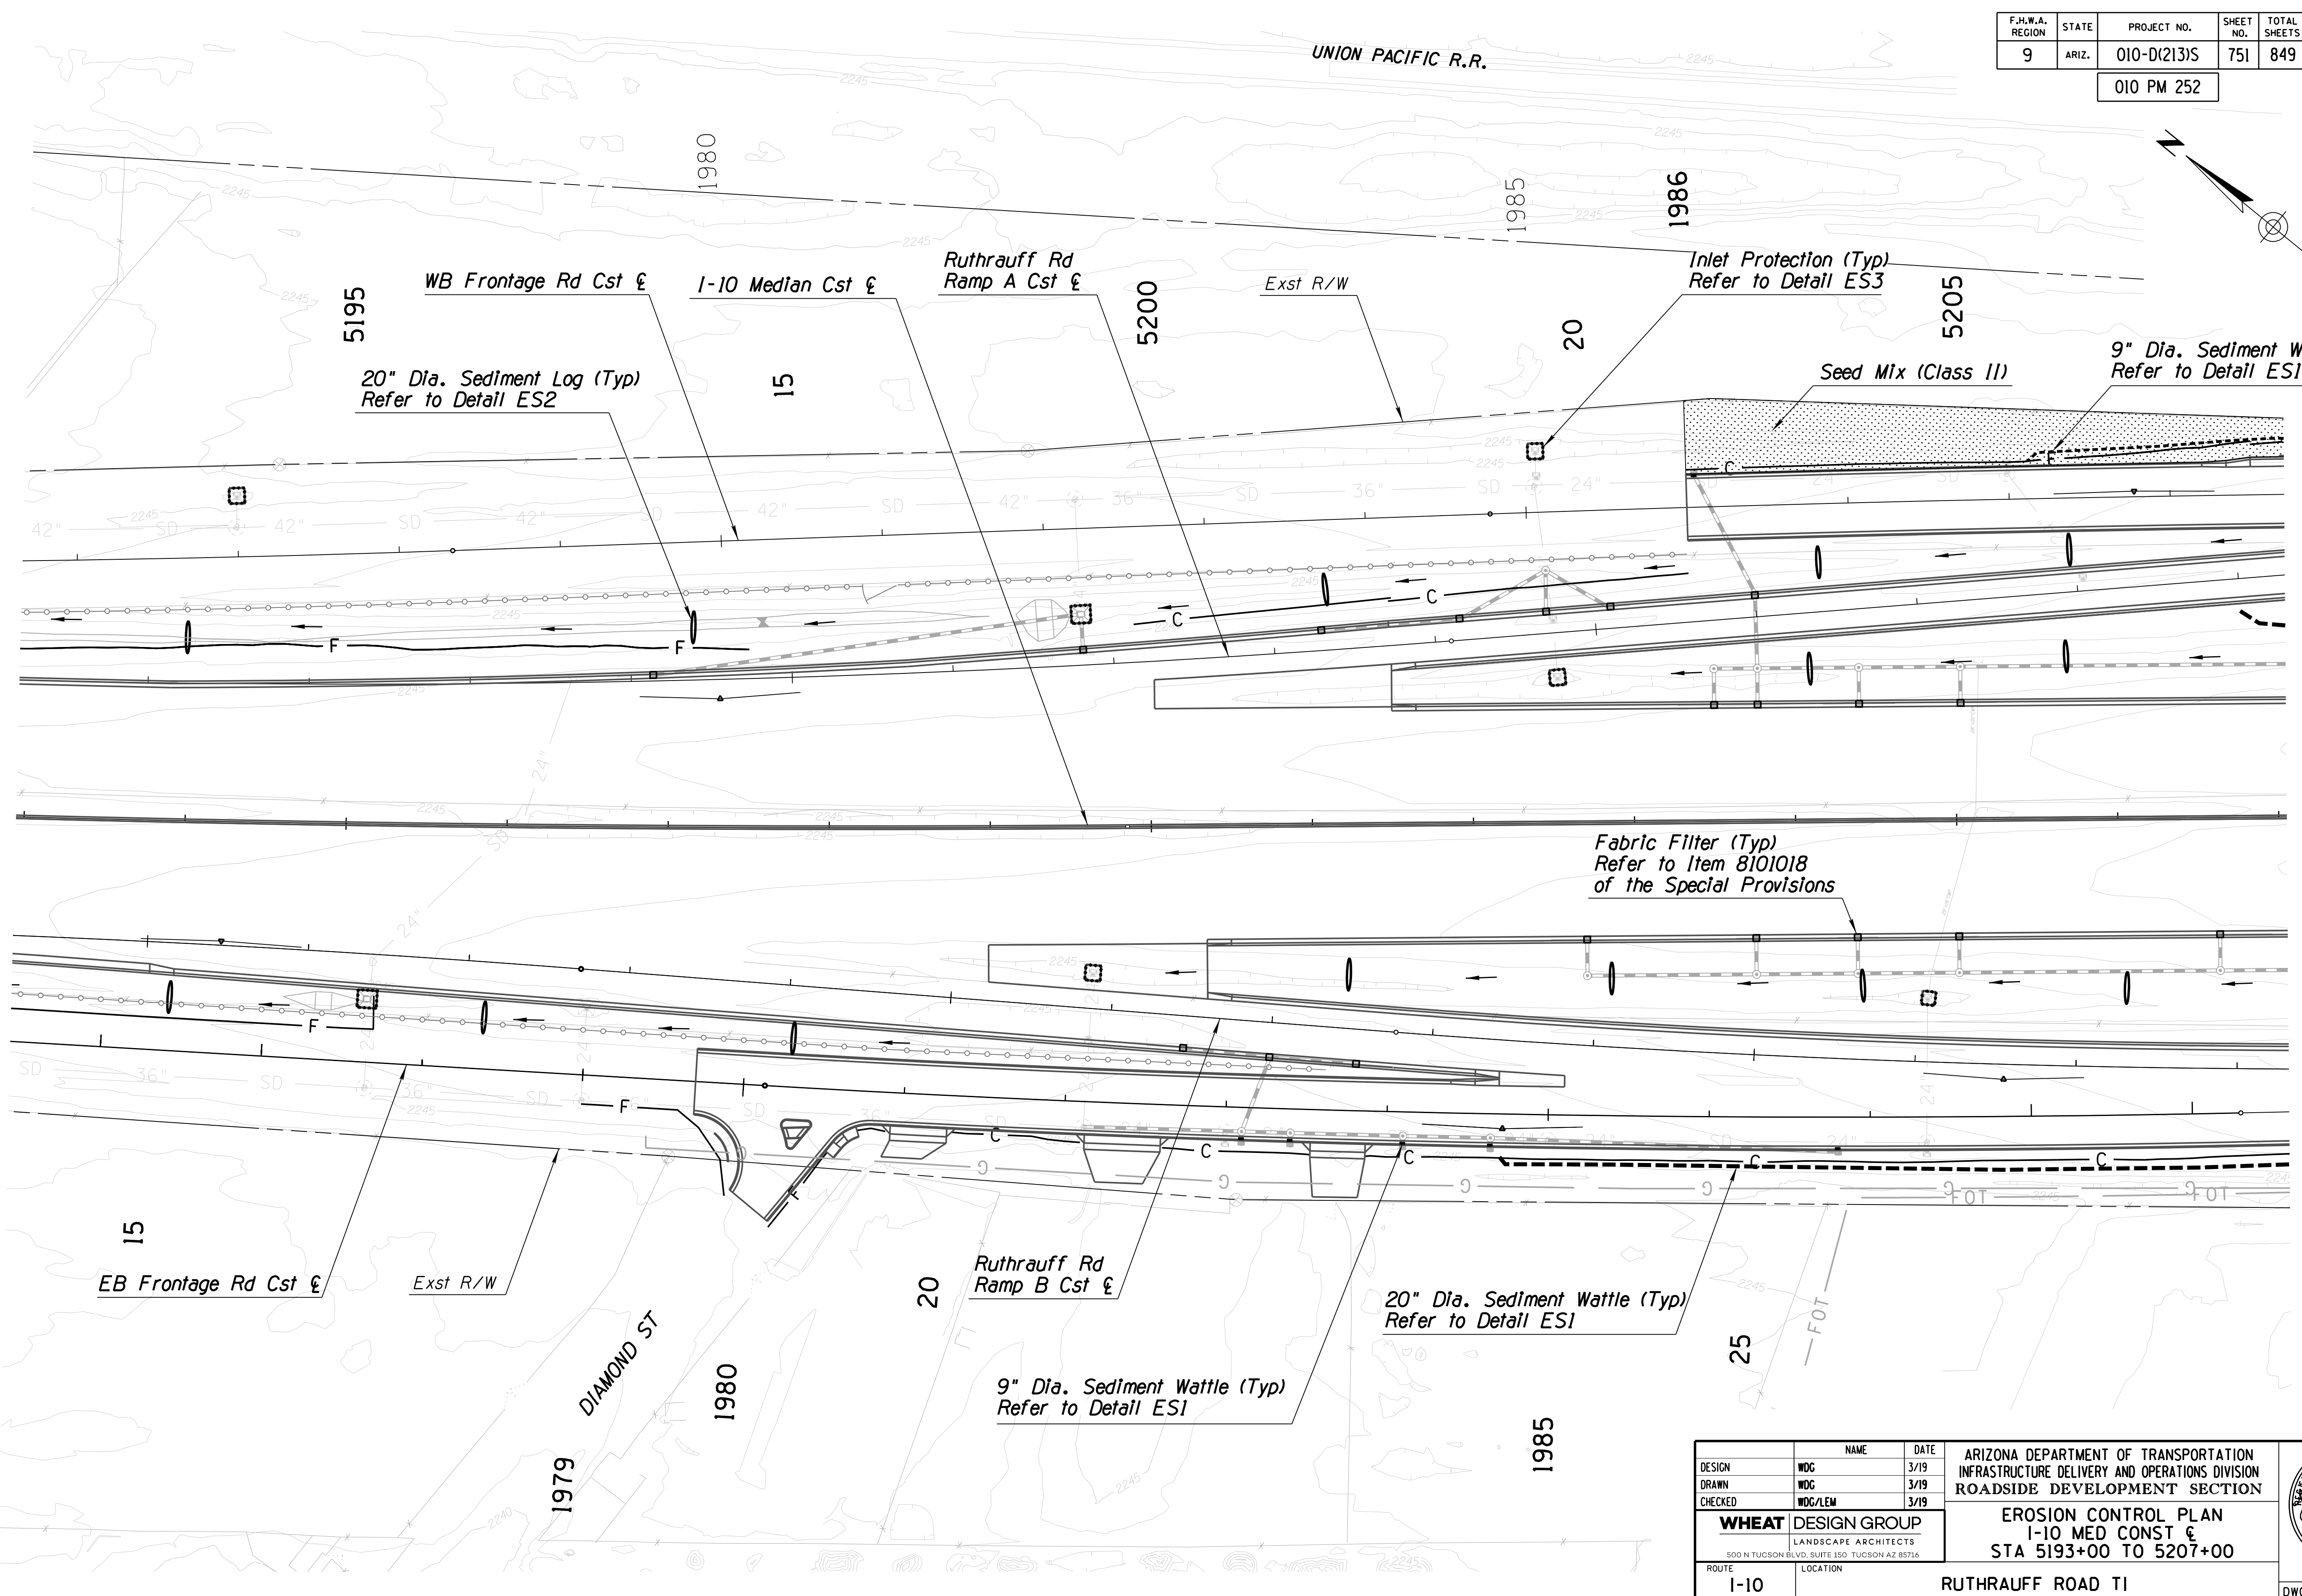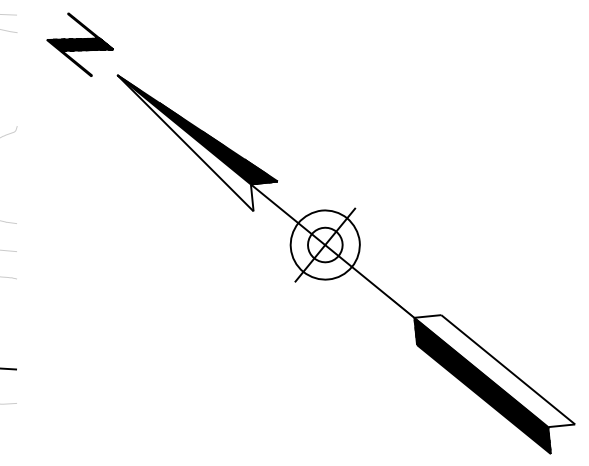

SURVEY NO. FINISHED PLANS DATE LOCATION REVISIONS DATE FINISHED PLANS SURVEY NO. REVISIONS DATE LOCATION

DESIGN	WDC	3/19	ARIZONA DEPARTMENT OF TRANSPORTATION INFRASTRUCTURE DELIVERY AND OPERATIONS DIVISION ROADSIDE DEVELOPMENT SECTION  <b>EROSION CONTROL PLAN</b> <b>I-10 MED CONST &amp;</b> <b>STA 5193+00 TO 5207+00</b>	
DRAWN	WDC	3/19		
CHECKED	WDC/LEM	3/19		
<b>WHEAT DESIGN GROUP</b> LANDSCAPE ARCHITECTS <small>500 N TUCSON BLVD, SUITE 150, TUCSON AZ 85716</small>		ROUTE: I-10 LOCATION: RUTHRAUFF ROAD TI		EXPIRES 6-30-2019 DWG NO. E-3.04
TRACS NO. H 8480 OIC		010-D(213)S		OF


ccccSYTIMEcccc

ccccDGNcSPECIFICATIONcccc




F.H.W.A. REGION	STATE	PROJECT NO.	SHEET NO.	TOTAL SHEETS	RECORD DRAWING
9	ARIZ.	010-D(213)S	752	849	

010 PM 252

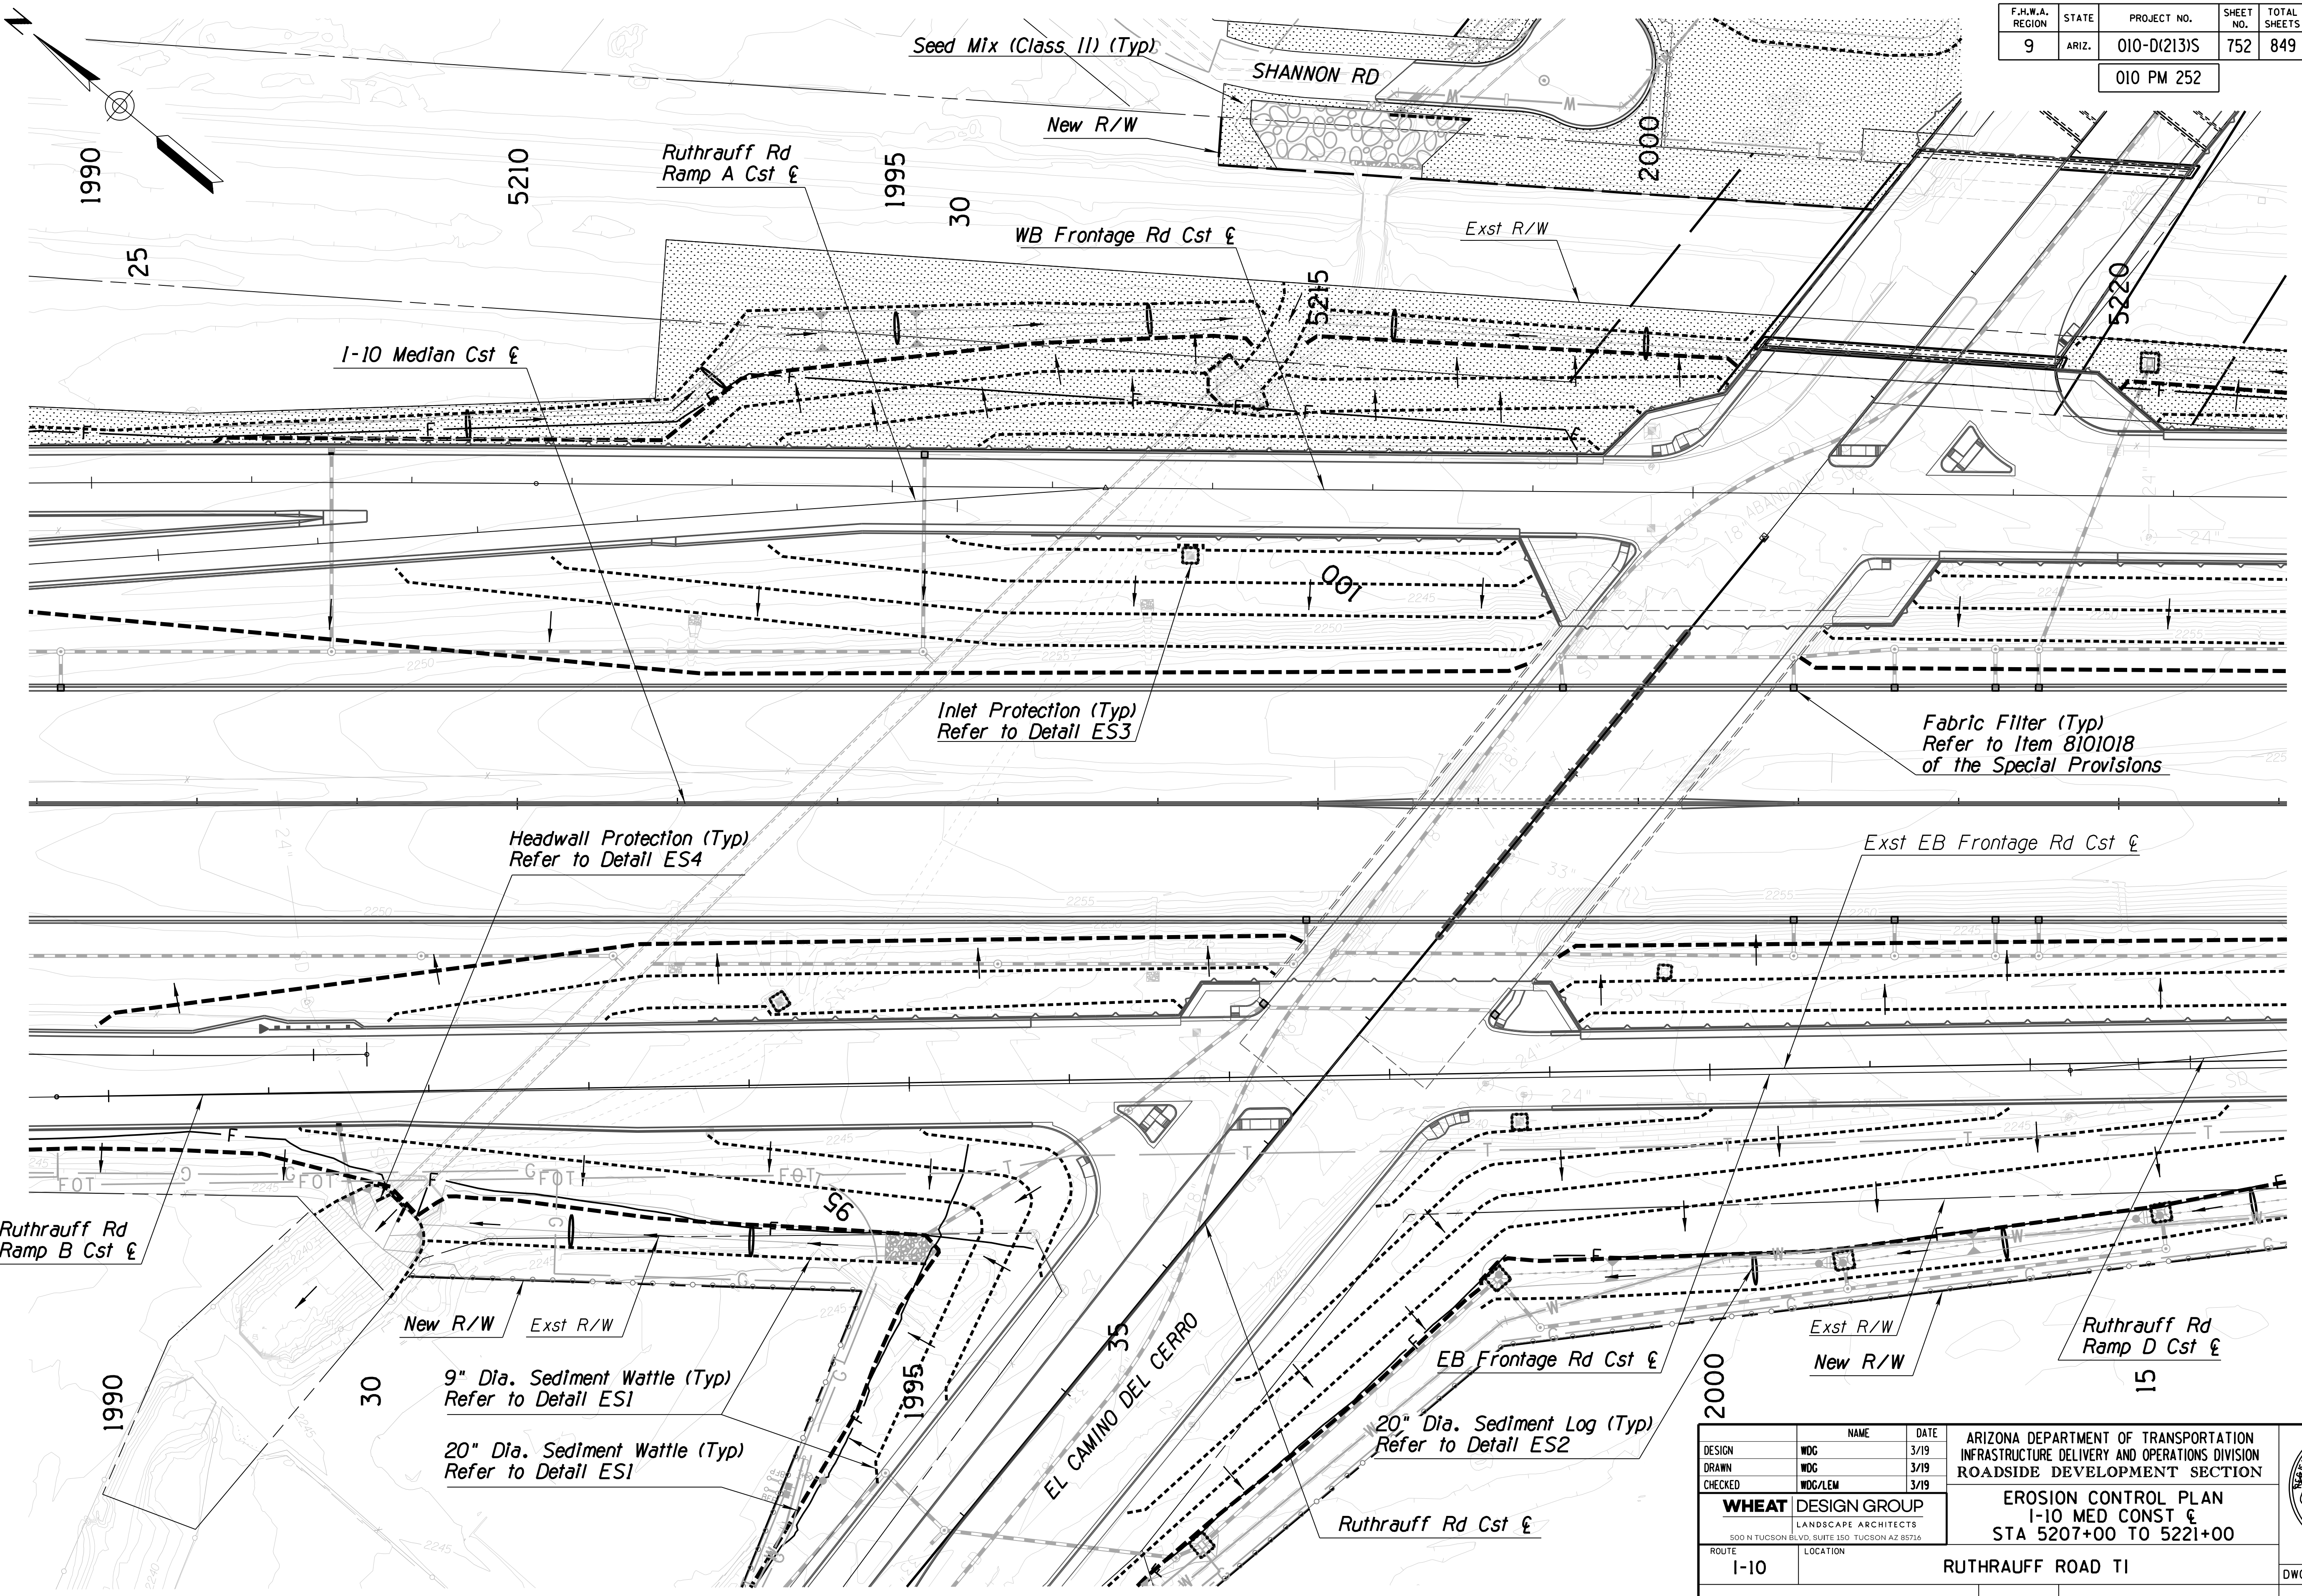

REVISIONS- FINISHED PLANS- SURVEY NO. DATE- LOCATION- DATE- REVISIONS- FINISHED PLANS- SURVEY NO. DATE-



DESIGN	WDC	NAME	DATE	ARIZONA DEPARTMENT OF TRANSPORTATION INFRASTRUCTURE DELIVERY AND OPERATIONS DIVISION ROADSIDE DEVELOPMENT SECTION  <b>EROSION CONTROL PLAN</b> <b>I-10 MED CONST &amp;</b> <b>STA 5207+00 TO 5221+00</b>	 EXPIRES 6-30-2019 DWG NO. E-3.05
DRAWN	WDC	3/19			
CHECKED	WDC/LEM	3/19			
<b>WHEAT DESIGN GROUP</b> LANDSCAPE ARCHITECTS <small>500 N TUCSON BLVD, SUITE 150, TUCSON AZ 85716</small>		ROUTE: I-10      LOCATION: RUTHRAUFF ROAD TI		TRACS NO. H 8480 OIC	010-D(213)S
				OF	

ccccSYTIMEcccc

ccccDGNcSPECIFICATIONcccc

F.H.W.A. REGION	STATE	PROJECT NO.	SHEET NO.	TOTAL SHEETS	RECORD DRAWING
9	ARIZ.	010-D(213)S	753	849	

010 PM 252

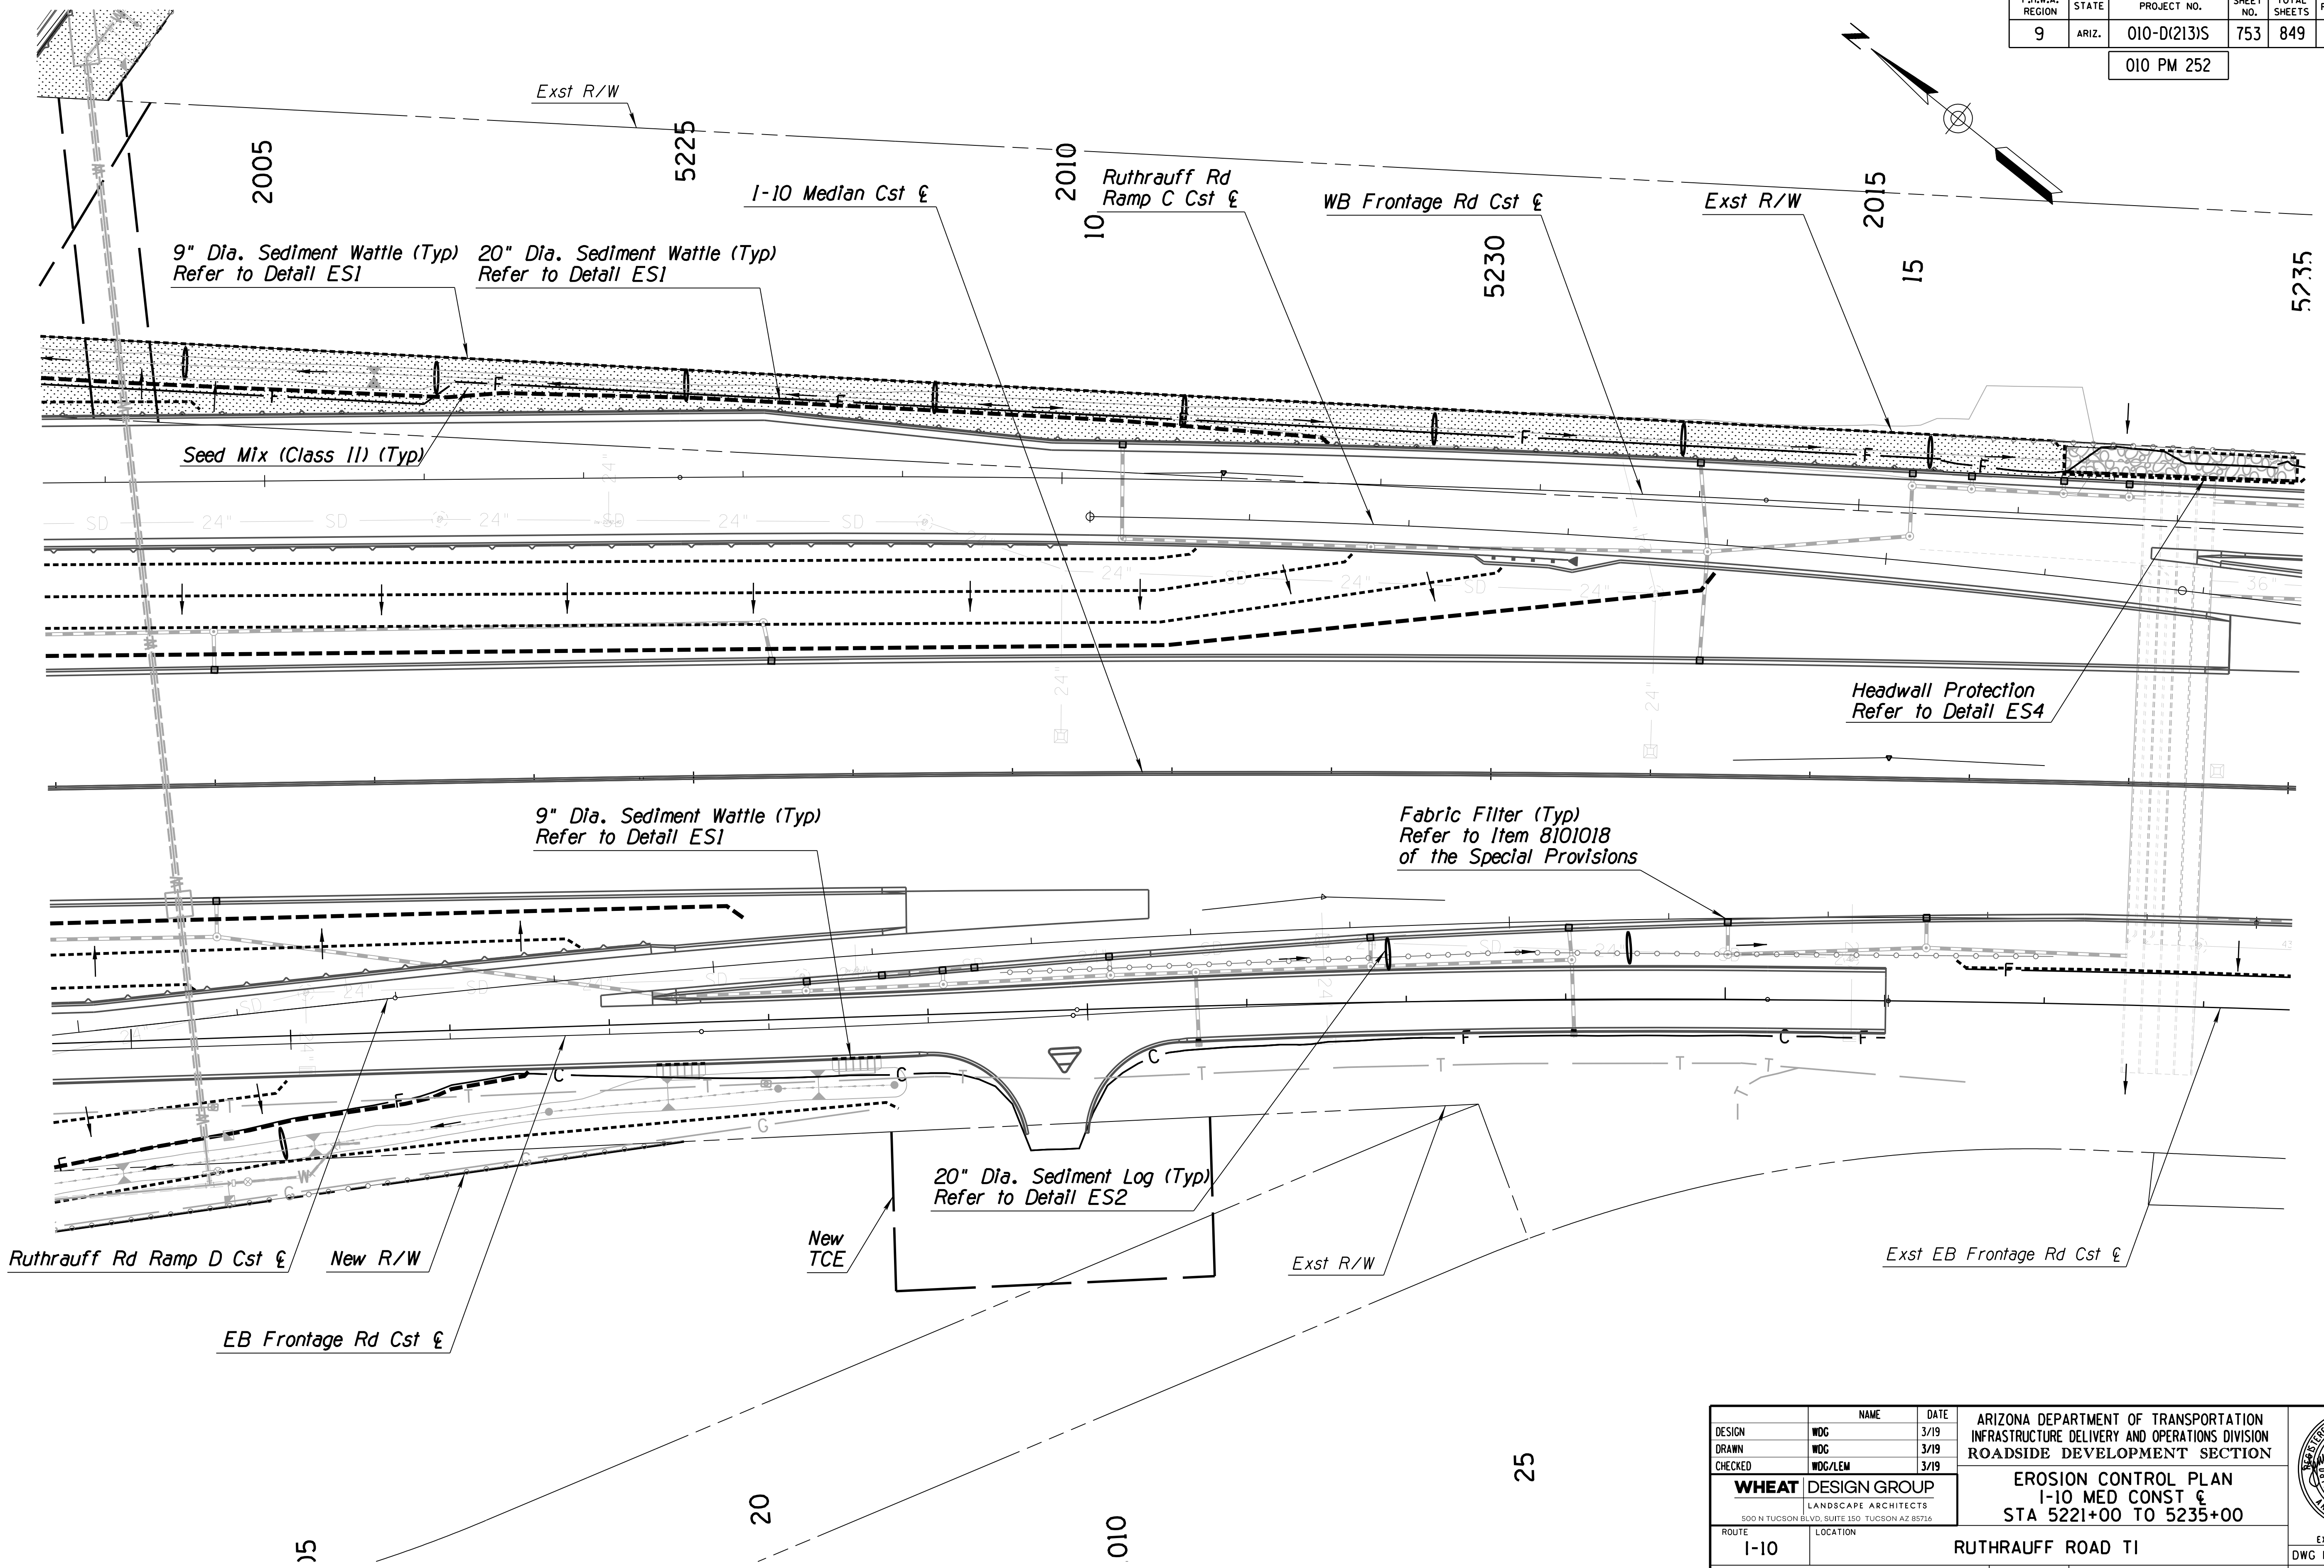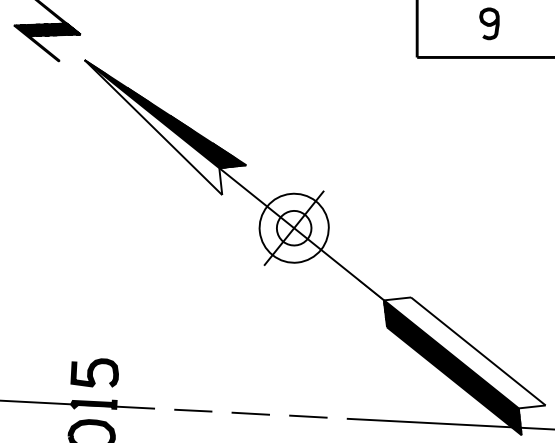

DATE: LOCATION: REVISIONS: FINISHED PLANS: SURVEY NO. DATE: LOCATION: REVISIONS: FINISHED PLANS: SURVEY NO.

DESIGN	WDC	NAME	DATE	ARIZONA DEPARTMENT OF TRANSPORTATION INFRASTRUCTURE DELIVERY AND OPERATIONS DIVISION ROADSIDE DEVELOPMENT SECTION	
DRAWN	WDC		3/19		
CHECKED	WDC/LEM		3/19		
<b>WHEAT DESIGN GROUP</b> LANDSCAPE ARCHITECTS <small>500 N TUCSON BLVD, SUITE 150, TUCSON AZ 85716</small>		<b>EROSION CONTROL PLAN</b> <b>I-10 MED CONST &amp;</b> <b>STA 5221+00 TO 5235+00</b>		EXPIRES 6-30-2019 DWG NO. E-3.06	
ROUTE	I-10	LOCATION	RUTHRAUFF ROAD TI		
TRACS NO.	H 8480 OIC		010-D(213)S		
			OF		


ccccSYTIMEcccc

ccccDGNcSPECIFICATIONcccc



F.H.W.A. REGION	STATE	PROJECT NO.	SHEET NO.	TOTAL SHEETS	RECORD DRAWING
9	ARIZ.	010-D(213)S	754	849	

010 PM 252

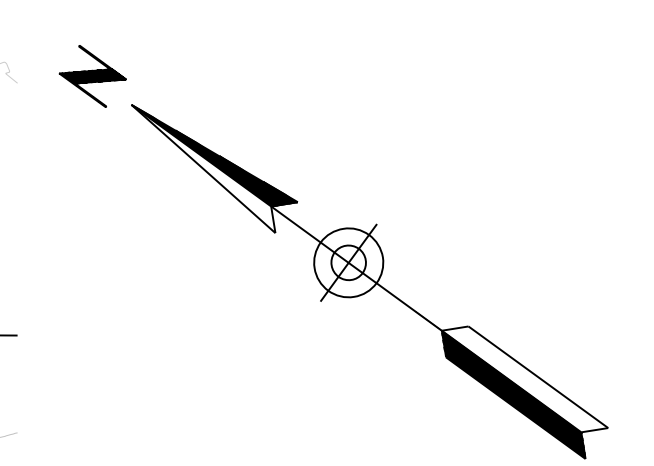

Fabric Filter (Typ)  
Refer to Item 8101018  
of the Special Provisions

Inlet Protection (Typ)  
Refer to Detail ES3

Ruthrauff Rd  
Ramp C Cst &

WB Frontage Rd Cst &

Exst R/W

I-10 Median Cst &

5235

2020  
20

5240

25

26

5245

9" Dia. Sediment Wattle (Typ)  
Refer to Detail ES1

24"

24"

43x68

43x68

43x68

43x68

54"

54"

54"

24"

54"

Exst EB Frontage Rd Cst &

9" Dia. Sediment Wattle (Typ)  
Refer to Detail ES1

Exst R/W

DESIGN	WDC	3/19	ARIZONA DEPARTMENT OF TRANSPORTATION INFRASTRUCTURE DELIVERY AND OPERATIONS DIVISION ROADSIDE DEVELOPMENT SECTION		
DRAWN	WDC	3/19			
CHECKED	WDC/LEM	3/19			
<b>WHEAT DESIGN GROUP</b> LANDSCAPE ARCHITECTS <small>500 N TUCSON BLVD, SUITE 150, TUCSON AZ 85716</small>			<b>EROSION CONTROL PLAN</b> <b>I-10 MED CONST &amp;</b> <b>STA 5235+00 TO 5249+00</b>		
ROUTE	I-10	LOCATION	RUTHRAUFF ROAD TI		
TRACS NO. H 8480 OIC			010-D(213)S		
			EXPIRES 6-30-2019 DWG NO. E-3.07 OF		

ccccSYTIMEcccc


ccccDGNcSPECIFICATIONcccc

DATE- LOCATION- REVISIONS- FINISHED PLANS- SURVEY NO. DATE- LOCATION- REVISIONS- FINISHED PLANS- SURVEY NO.



F.H.W.A. REGION	STATE	PROJECT NO.	SHEET NO.	TOTAL SHEETS	RECORD DRAWING
9	ARIZ.	010-D(213)S	755	849	

010 PM 252

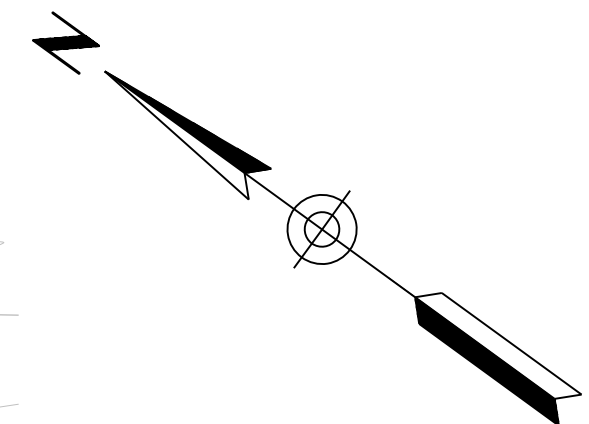

I-10 Median Cst €

5250

Exst R/W

No Erosion Control on this Sheet



Exst R/W

SURVEY NO. FINISHED PLANS DATE LOCATION REVISIONS FINISHED PLANS DATE SURVEY NO. FINISHED PLANS DATE LOCATION REVISIONS FINISHED PLANS DATE SURVEY NO.

DESIGN	WDC	3/19	ARIZONA DEPARTMENT OF TRANSPORTATION INFRASTRUCTURE DELIVERY AND OPERATIONS DIVISION ROADSIDE DEVELOPMENT SECTION	
DRAWN	WDC	3/19		
CHECKED	WDC/LEM	3/19		
<b>WHEAT DESIGN GROUP</b> LANDSCAPE ARCHITECTS <small>500 N TUCSON BLVD, SUITE 150 TUCSON AZ 85716</small>			<b>EROSION CONTROL PLAN</b> <b>I-10 MED CONST €</b> <b>STA 5249+00 TO 5263+00</b>	EXPIRES 6-30-2019 DWG NO. E-3.08
ROUTE	I-10	LOCATION	RUTHRAUFF ROAD TI	
TRACS NO.	H 8480 OIC		010-D(213)S	OF

F.H.W.A. REGION	STATE	PROJECT NO.	SHEET NO.	TOTAL SHEETS	RECORD DRAWING
9	ARIZ.	010-D(213)S	756	849	

010 PM 252

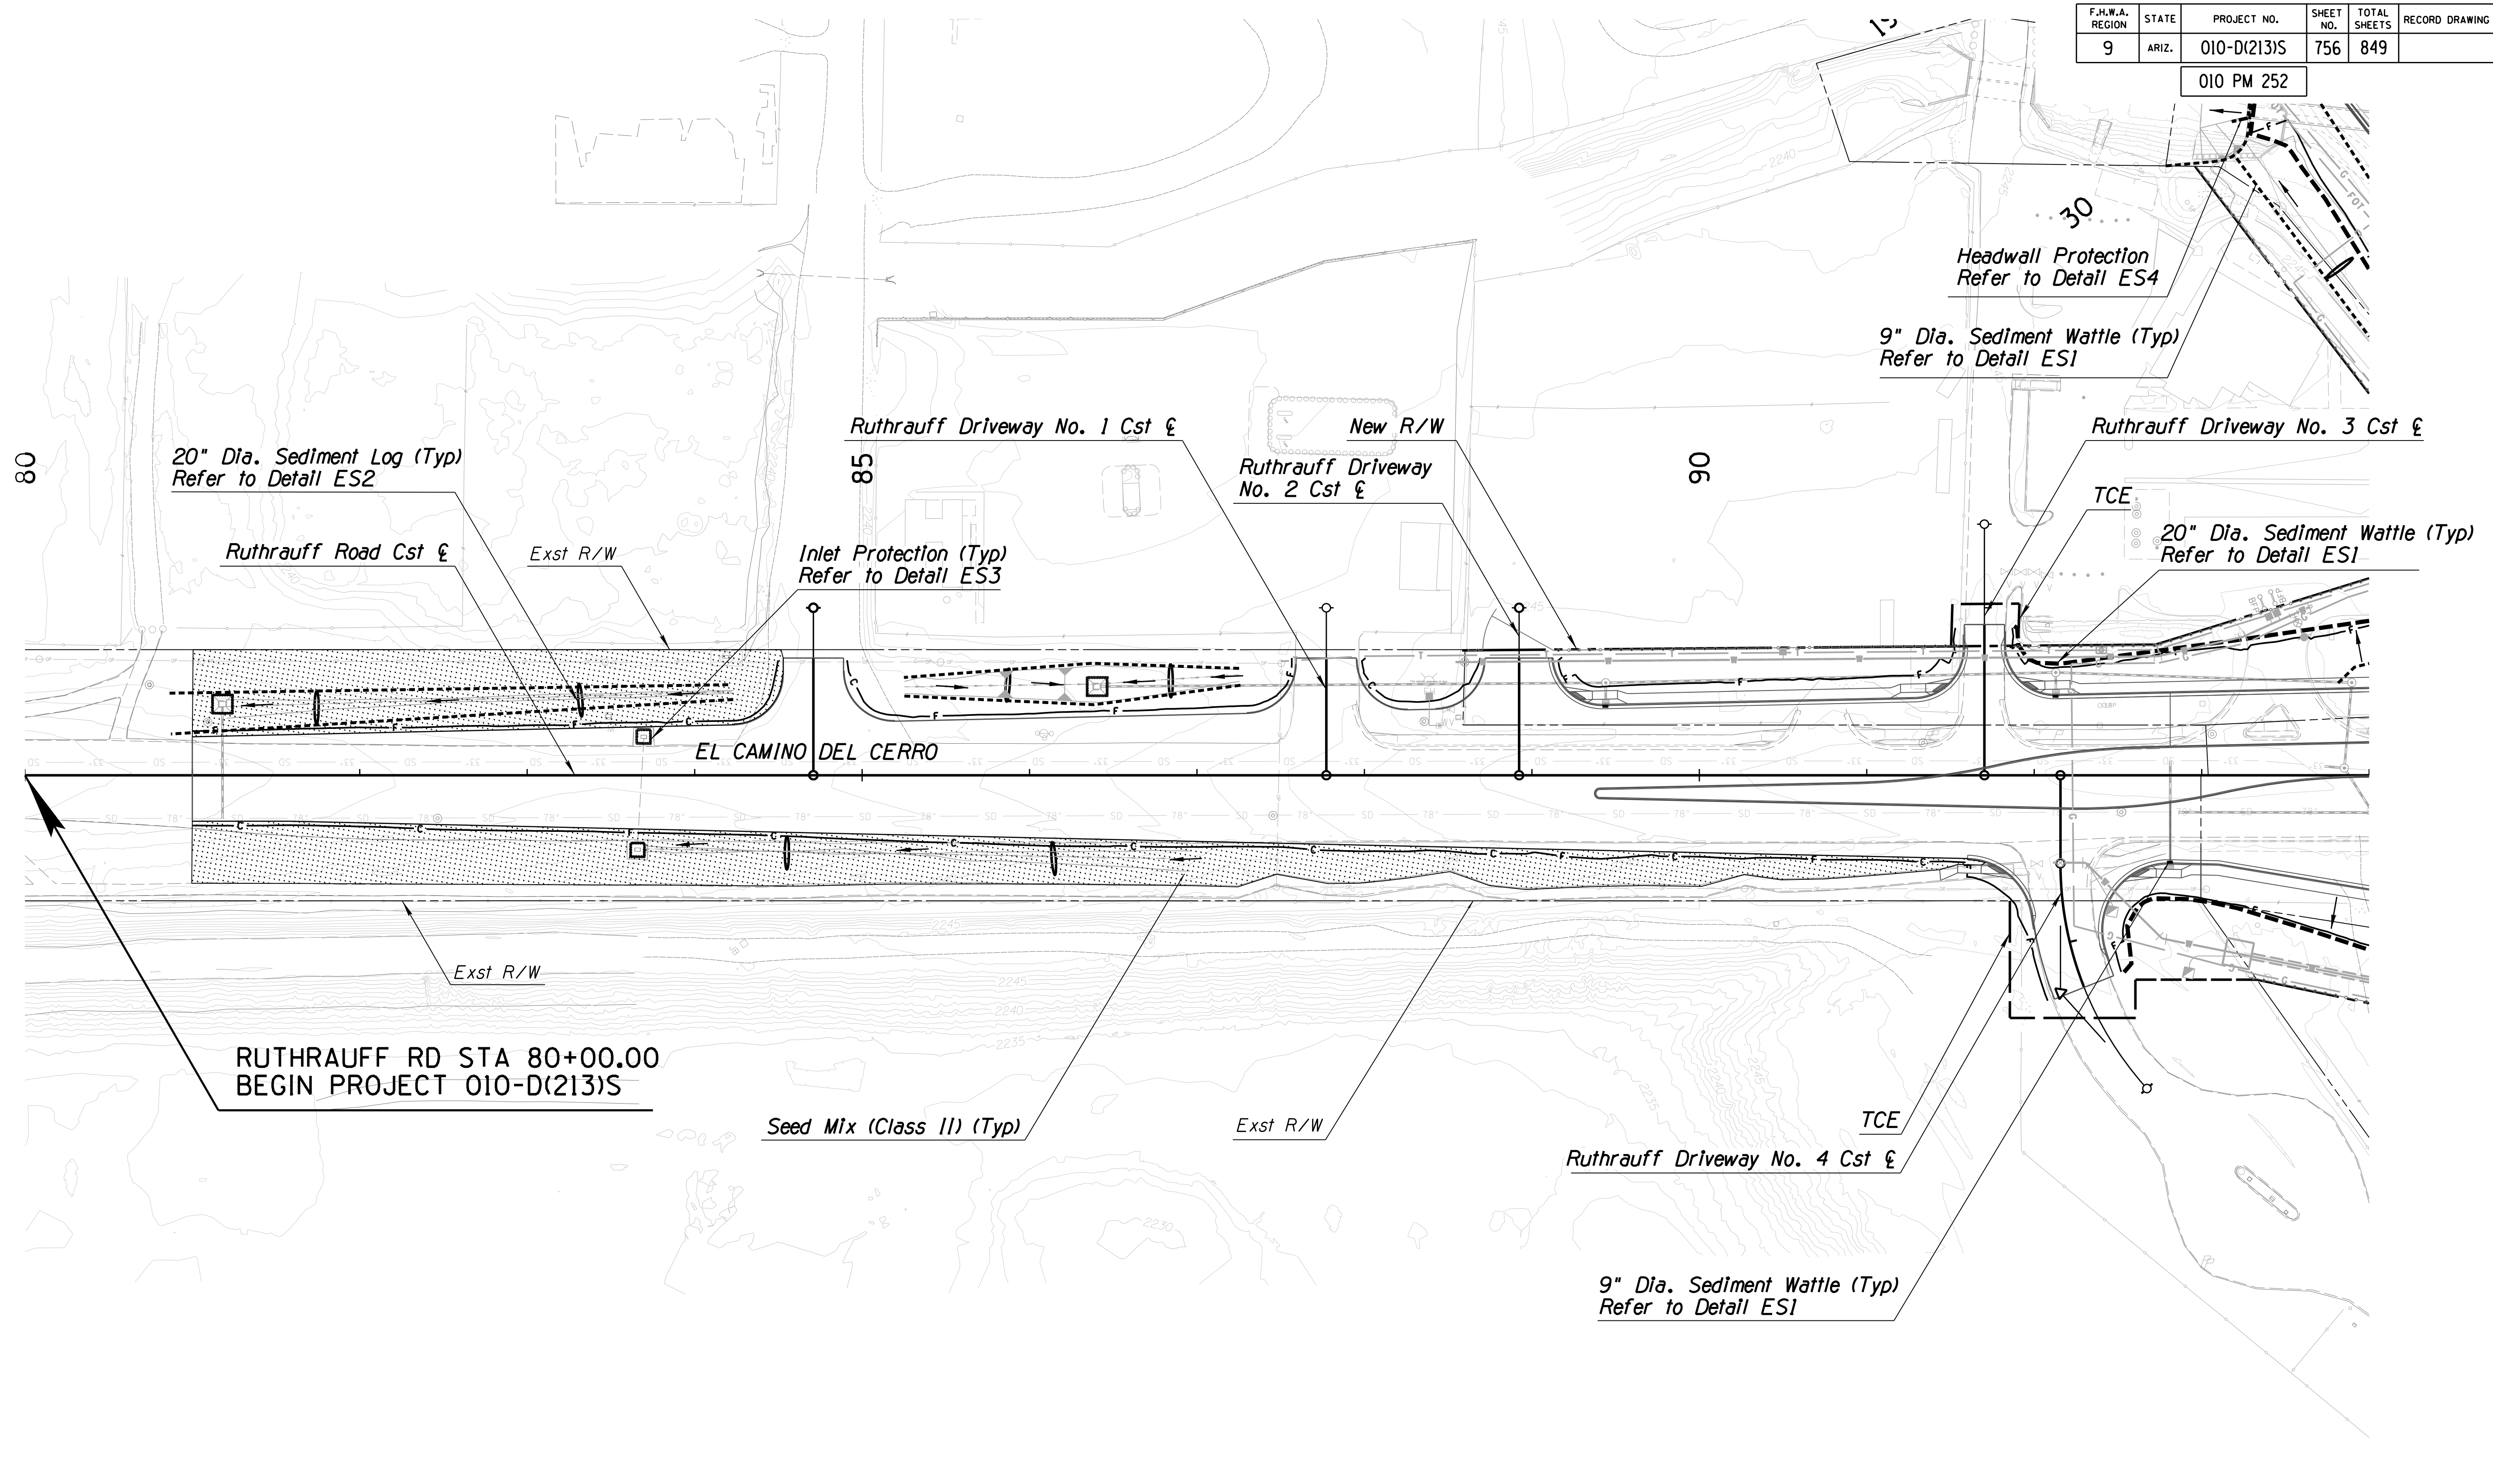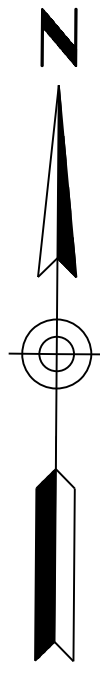

**NOTE:** The local street names are El Camino Del Cerro west of I-10 and Ruthrauff Road east of I-10. The construction & has been designated as Ruthrauff Road Cst & for entire length.

DESIGN	WDC	DATE	3/19	ARIZONA DEPARTMENT OF TRANSPORTATION INFRASTRUCTURE DELIVERY AND OPERATIONS DIVISION ROADSIDE DEVELOPMENT SECTION
DRAWN	WDC	DATE	3/19	
CHECKED	WDC/LEM	DATE	3/19	
<b>WHEAT DESIGN GROUP</b>				EROSION CONTROL PLAN RUTHRAUFF ROAD STA 81+00 TO 94+00
LANDSCAPE ARCHITECTS				
500 N TUCSON BLVD, SUITE 150, TUCSON AZ 85716				
ROUTE	I-10	LOCATION	RUTHRAUFF ROAD TI	
TRACS NO. H 8480 OIC		010-D(213)S		EXPIRES 6-30-2019 DWG NO. E-3.09 OF

ccccSYSTEMEcccc



ccccDGNcSPECIFICATIONcccc

SURVEY NO. FINISHED PLANS DATE LOCATION REVISIONS DATE SURVEY NO. FINISHED PLANS DATE LOCATION REVISIONS DATE SURVEY NO. FINISHED PLANS DATE



F.H.W.A. REGION	STATE	PROJECT NO.	SHEET NO.	TOTAL SHEETS	RECORD DRAWING
9	ARIZ.	010-D(213)S	757	849	

010 PM 252

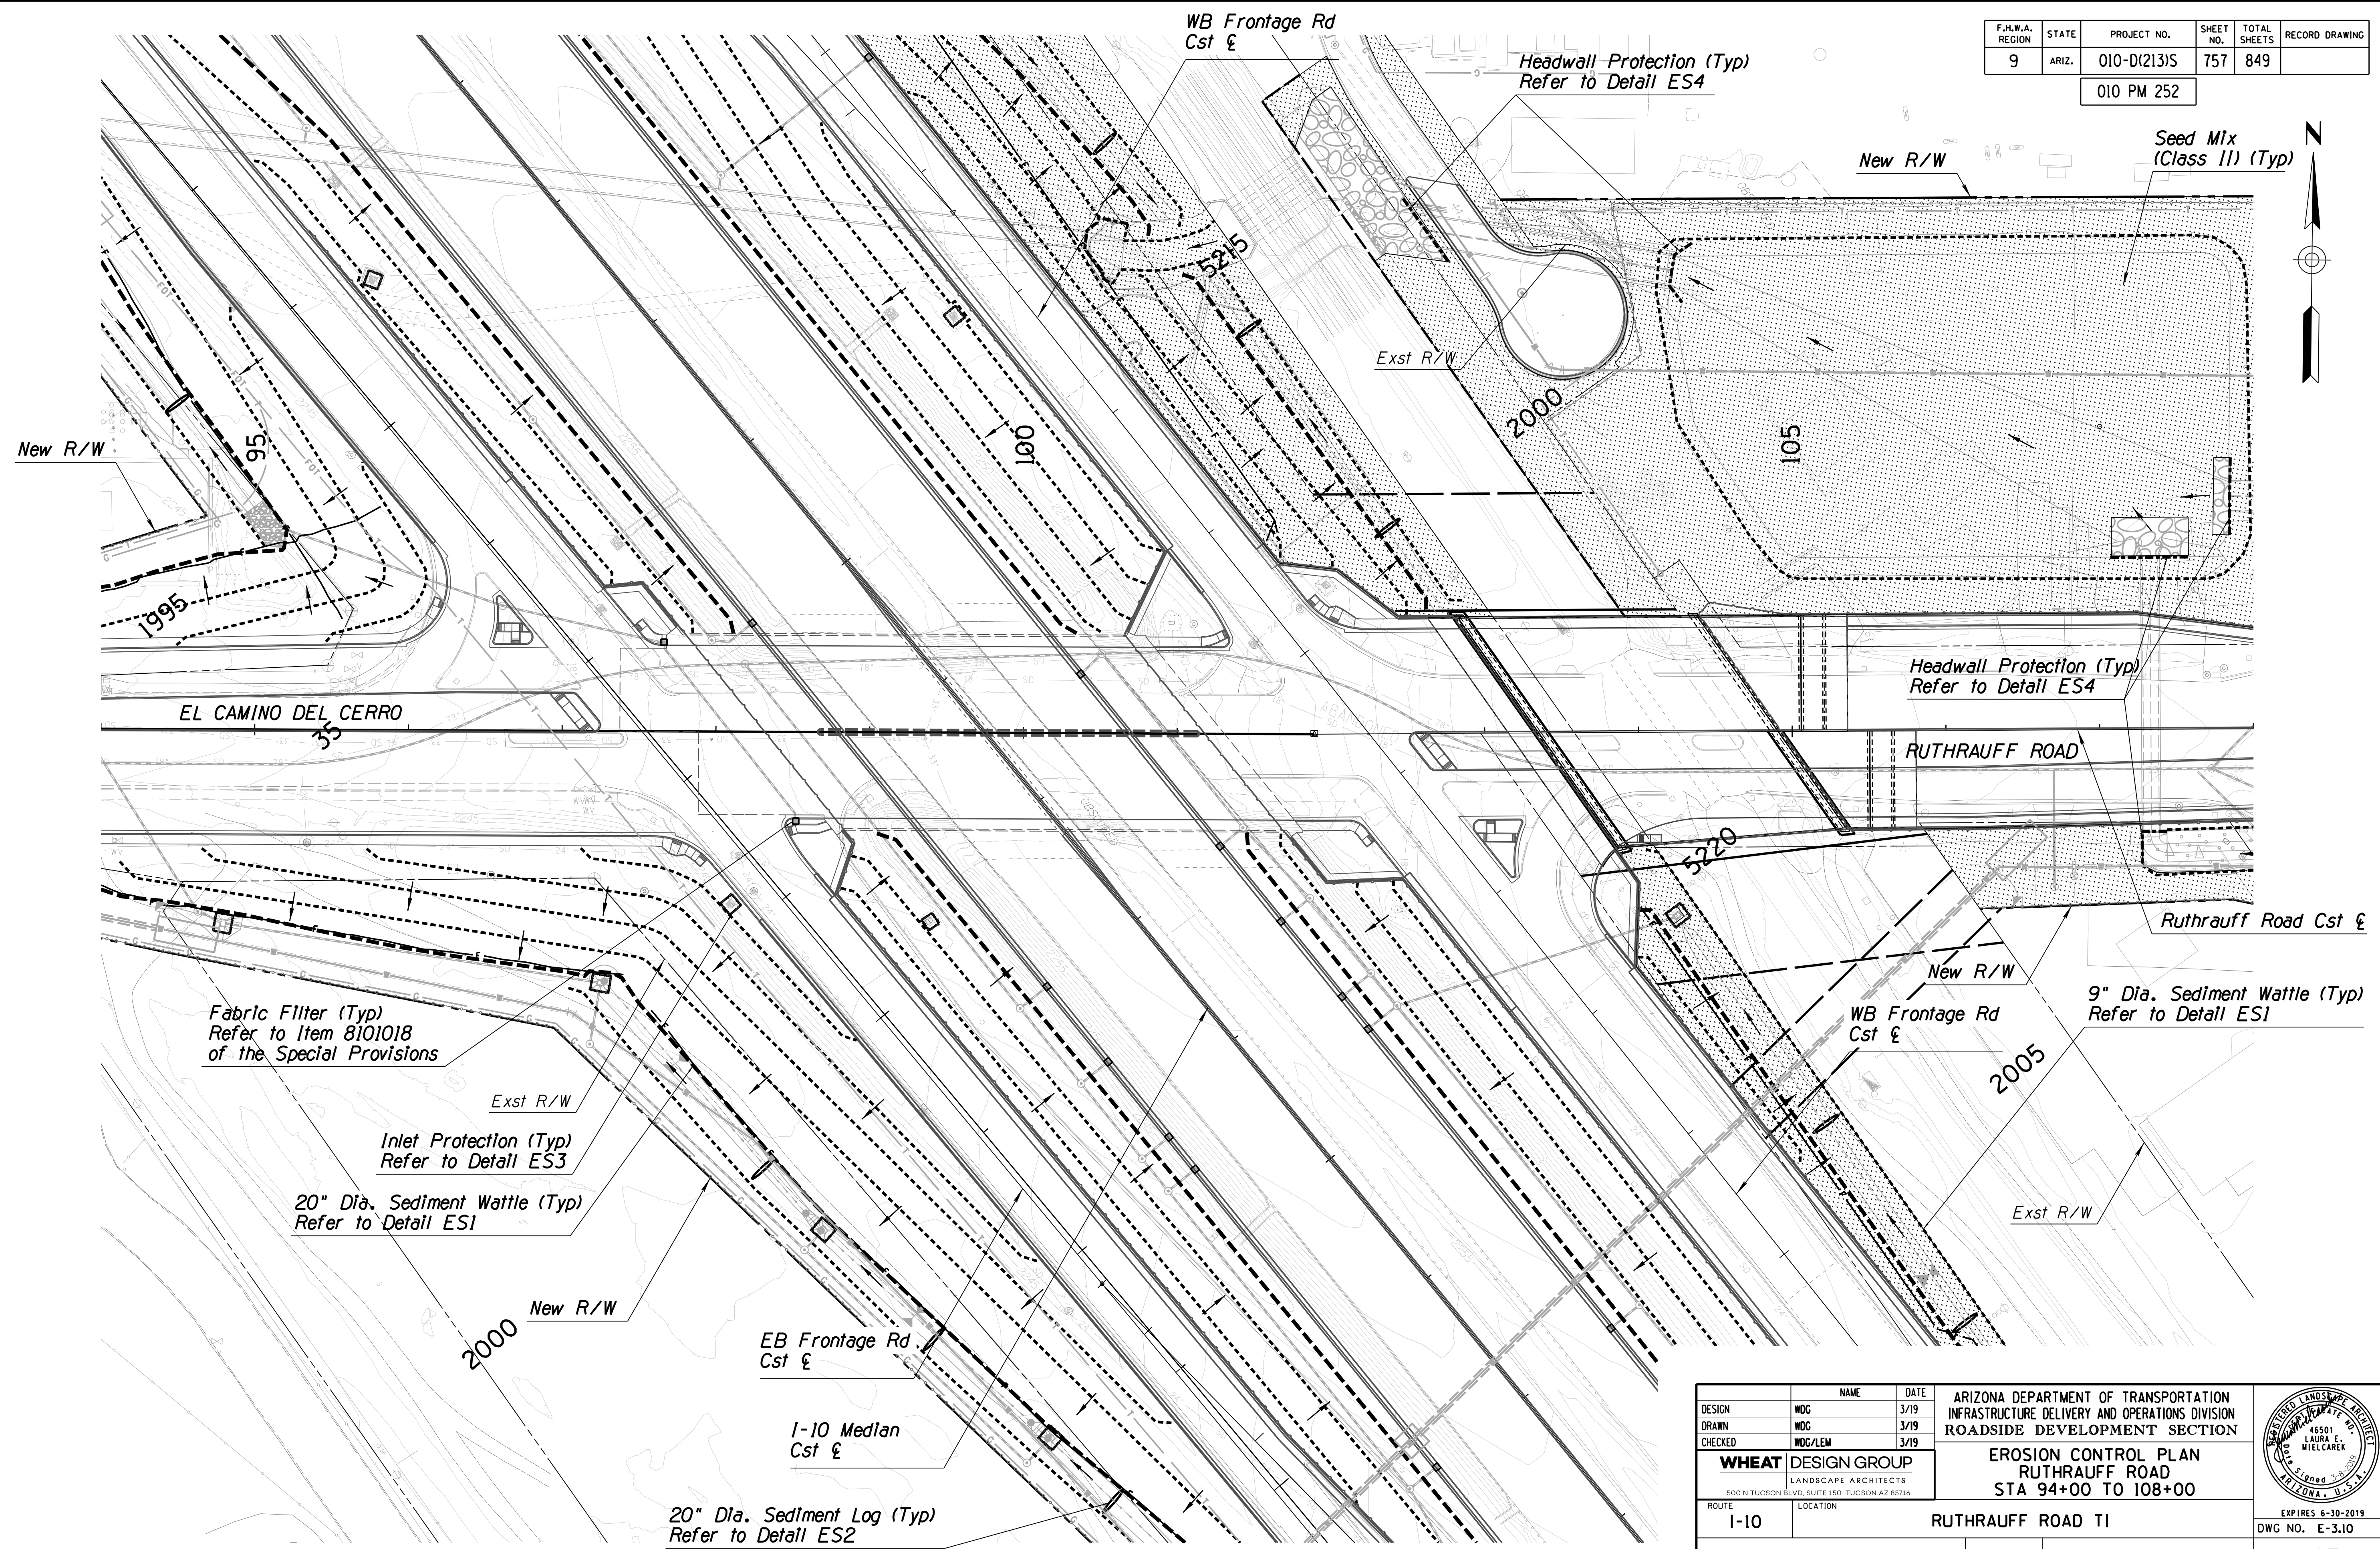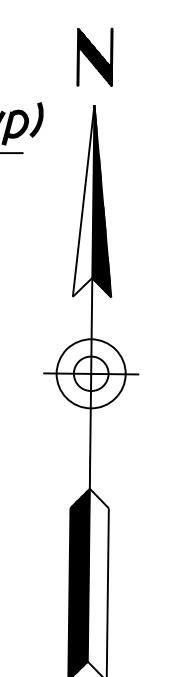



SURVEY NO. FINISHED PLANS DATE LOCATION REVISIONS FINISHED PLANS DATE SURVEY NO. FINISHED PLANS DATE LOCATION REVISIONS FINISHED PLANS DATE SURVEY NO.

DESIGN	WDC	NAME	DATE	ARIZONA DEPARTMENT OF TRANSPORTATION INFRASTRUCTURE DELIVERY AND OPERATIONS DIVISION ROADSIDE DEVELOPMENT SECTION  <b>EROSION CONTROL PLAN</b> <b>RUTHRAUFF ROAD</b> <b>STA 94+00 TO 108+00</b>
DRAWN	WDC		3/19	
CHECKED	WDC/LEM		3/19	
<b>WHEAT DESIGN GROUP</b> LANDSCAPE ARCHITECTS <small>500 N TUCSON BLVD, SUITE 150, TUCSON AZ 85716</small>				 EXPIRES 6-30-2019 DWG NO. E-3.10
ROUTE	LOCATION	RUTHRAUFF ROAD TI		
TRACS NO. H 8480 01C		010-D(213)S		OF



F.H.W.A. REGION	STATE	PROJECT NO.	SHEET NO.	TOTAL SHEETS	RECORD DRAWING
9	ARIZ.	010-D(213)S	758	849	

010 PM 252

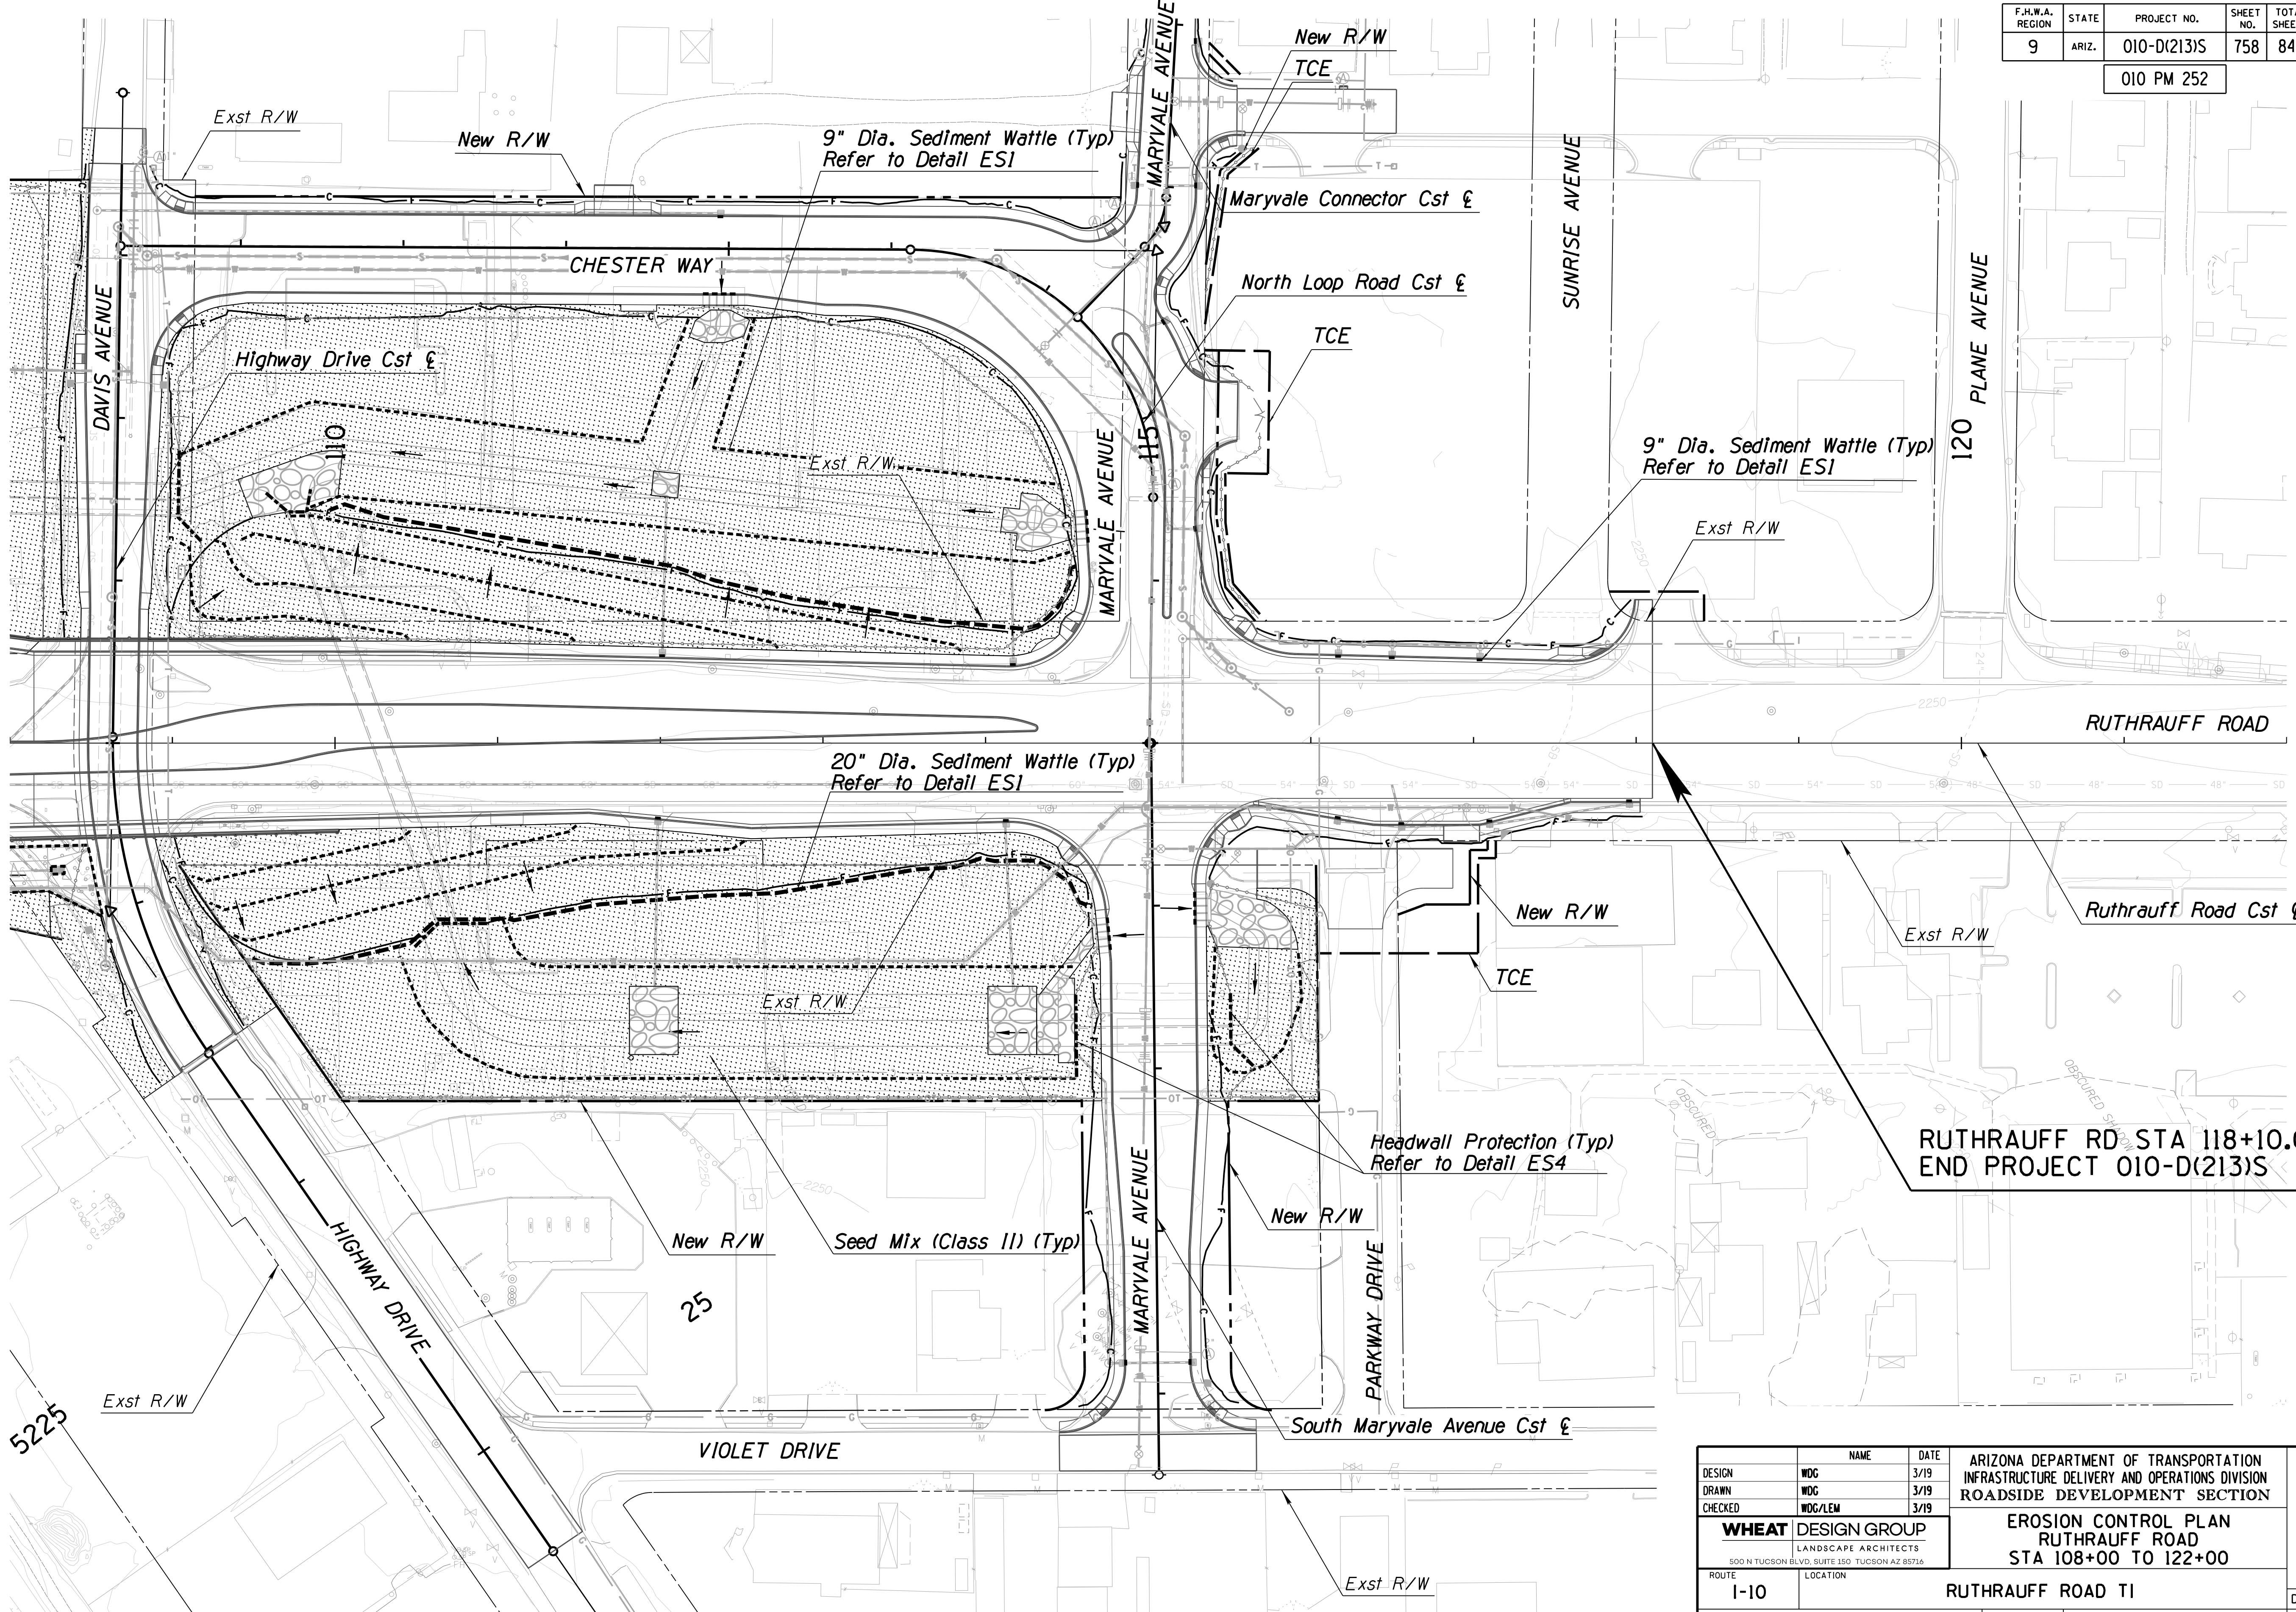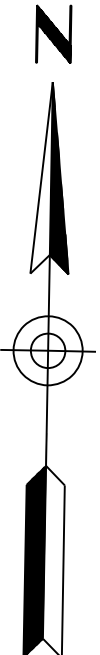

RUTHRAUFF RD STA 118+10.00  
END PROJECT 010-D(213)S

DESIGN	WDC	3/19	ARIZONA DEPARTMENT OF TRANSPORTATION INFRASTRUCTURE DELIVERY AND OPERATIONS DIVISION ROADSIDE DEVELOPMENT SECTION
DRAWN	WDC	3/19	
CHECKED	WDC/LEM	3/19	
<b>WHEAT DESIGN GROUP</b> LANDSCAPE ARCHITECTS 500 N TUCSON BLVD, SUITE 150, TUCSON AZ 85716			EROSION CONTROL PLAN RUTHRAUFF ROAD STA 108+00 TO 122+00
ROUTE	LOCATION		
I-10	RUTHRAUFF ROAD TI		EXPIRES 6-30-2019 DWG NO. E-3.11
TRACS NO. H 8480 OIC			010-D(213)S OF



SURVEY NO. FINISHED PLANS REVISIONS DATE LOCATION FINISHED PLANS REVISIONS DATE SURVEY NO. FINISHED PLANS REVISIONS DATE LOCATION FINISHED PLANS REVISIONS DATE SURVEY NO.

ccccSYSTEMEcccc

ccccDGNcSPECIFICATIONcccc

NURSERY PLANT MATERIALS

AVERAGE SIZE OF NURSERY STOCK

F.H.W.A. REGION	STATE	PROJECT NO.	SHEET NO.	TOTAL SHEETS	RECORD DRAWING
9	ARIZ.	010-D(213)S	759	849	

010 PM 252

SYMBOL	BOTANICAL NAME/ COMMON NAME	QUANTITY	SIZE	ITEM NUMBER	HEIGHT	WIDTH	CALIPER	TYP. O.C. SPACING	TYPE	REMARKS
TREES										
	<i>Chilopsis linearis</i> Desert Willow	16	15 gal	8061005	5'	2'	0.75"	20'	Single Trunk	Double Staked
	<i>Parkinsonia spp</i> Hybrid Palo Verde	25	15 gal	8061005	6'	2'	1.0"	30'	Multi-Trunk Low Break	Triple Staked
	<i>Prosopis velutina</i> Velvet Mesquite	37	15 gal	8061005	4'	2'	0.75"	20'	Multi-Trunk Low Break	Triple Staked
SHRUBS										
	<i>Caesalpinia mexicana</i> Mexican Bird of Paradise	40	15 gal	8061299	36"	24"	N/A	15'		
	<i>Calliandra eriophylla</i> Fairyduster	71	5 gal	8061298	18"	12"	N/A	6'		
	<i>Dodonaea viscosa</i> Hopbush	173	5 gal	8061298	18"	12"	N/A	8'		
	<i>Larrea tridentata</i> Creosote	195	5 gal	8061298	18"	12"	N/A	8'		
	<i>Leucophyllum langmaniae</i> Lynn's Legacy Lynn's Legacy Texas Ranger	257	5 gal	8061298	18"	12"	N/A	8'		
	<i>Senna wislizeni</i> Shrubby Senna	35	5 gal	8061298	18"	12"	N/A	8'		
CACTI & ACCENTS										
	<i>Carnegiea gigantea</i> Saguaro	32 32 33	0'-6' 6'-8' 8'-10'	8061603 8061604 8061605	N/A N/A N/A	N/A N/A N/A	N/A N/A N/A	10' 10' 10'		
	<i>Dasylirion wheeleri</i> Desert Spoon	417	18" - 24"	8061390	12"	12"	N/A	6'		
	<i>Ferocactus pilosus</i> Mexican Fire Barrel	55	5 gal	8061645	12"	12"	N/A	4'		
	<i>Fouquieria splendens</i> Ocotillo	51	24" Box Container Grown 6'-8" Tall	8061655	12"	12"	N/A	6'		
	<i>Hesperaloe funifera</i> Giant Hesperaloe	138	5 gal	8061298	18"	12"	N/A	6'		
	<i>Hesperaloe parviflora</i> Red Yucca	238	5 gal	8061424	12"	12"	N/A	4'		
	<i>Opuntia Gomei</i> 'Old Mexico' Old Mexico Prickly Pear	81	5 gal	8061631	12"	12"	N/A	6'		
	<i>Opuntia santa-rita</i> Purple Prickly Pear	311	5 gal	8061631	12"	12"	N/A	8'		
	<i>Yucca rigida</i> Blue Yucca	90	15 gal	8061427	12"	12"	N/A	10'		
SEED MIX										
	Seeding (Class II)	13	Acre	850003	N/A	N/A	N/A	N/A		

LANDSCAPE PLATING MATERIALS

SYMBOL	ITEM	QUANTITY	UNIT	ITEM NUMBER	NOTES
	Granite Mulch (1 1/4")	130,617	Sq. Yd.	8030092	Granite mulch not shown on plans. All landscaped areas shall receive granite mulch.
	Rock Mulch (2"-4")	6,377	Sq. Yd.	8030117	Color for Granite Mulch and Rock to be Apache Brown.
	Median Paving (Concrete Pavers)	3,090	Sq. Yd.	9210012	Refer to Special Provisions for Paver Color.
	Preservation Fencing	1,127	L.F.	9030008	

DESIGN	WDC	DATE	3/19	ARIZONA DEPARTMENT OF TRANSPORTATION INFRASTRUCTURE DELIVERY AND OPERATIONS DIVISION ROADSIDE DEVELOPMENT SECTION	
DRAWN	WDC	DATE	3/19		
CHECKED	WDC/LEM	DATE	3/19		
<b>WHEAT DESIGN GROUP</b>		LANDSCAPE ARCHITECTS		LANDSCAPE SCHEDULE	
500 N TUCSON BLVD, SUITE 150, TUCSON AZ 85716					
ROUTE	LOCATION		RUTHRAUFF ROAD TI		
TRACS NO. H 8480 01C			010-D(213)S		OF



F.H.W.A. REGION	STATE	PROJECT NO.	SHEET NO.	TOTAL SHEETS	RECORD DRAWING
9	ARIZ.	010-D(213)S	760	849	

010 PM 252

General Landscape Notes:

- All landscape installation shall be installed per the approved plans and will comply with the Specifications. Any deviations to the approved plans require the approval of the Engineer.
- The contractor is responsible for obtaining any required permits prior to the commencement of any work.
- It is the contractor's responsibility to inspect the job site to become familiar with all existing conditions that could affect the installation of any work set forth in these plans and the Specifications prior to submitting a bid.
- Contractor shall verify rock and soil conditions within the project site prior to bidding. No extra payment or time extension will be given due to rocky soil conditions. Contractor is responsible for conducting site inspections and checking testing logs to determine subsurface conditions prior to bidding.
- Clear zone requirements:
  - Concrete Drainage Channels:  
Maintain a 15' clear zone between the edge of the concrete drainage channel and trees.
  - Paved surfaces:  
Maintain a 5' clear zone between mature spread of existing shrubs and ground covers and all paved surfaces. Minimum setback from paved surface edge to plant center shall be 10'. 30' clear zone shall be maintained between tree trunks and the closest driving lane.
  - Critical Slopes:  
Includes slopes exceeding 4:1 and not protected with a barrier as specified in the AASHTO Roadway Design Guidelines. Existing trees located adjacent to downward sloping critical slopes shall maintain a 10' clear zone beyond the toe of slope. It is the contractor's responsibility to insure that the tree trunk locations of the trees comply with the ADOT clear zone standards.
- Provide a 6' clear zone between right-of-way fence and the nearest existing plant center along the project.
- Existing plants shall be field adjusted to allow for maintenance roadway access into each area, all adjustments/removals require prior approval from the Engineer.
- The term Landscape Architect, Resident Landscape Architect, and Resident Engineer are used interchangeably throughout the document. The term Landscape Architect, Resident Landscape Architect, and Resident Engineer shall be interpreted to mean the Engineer.
- The landscape contractor shall provide a 12 month landscape establishment period in accordance with Section 807 of the Specifications.
- The contractor shall maintain field record drawings and present the field record drawings to the Engineer at a minimum of every two weeks for the duration of construction. A final presentation of field record drawings to ADOT's Resident Landscape Architect is required for approval.


Landscape Establishment

- Repair erosion damage immediately.
- Remove any paper and container debris from the ROW.
- Control noxious weeds and undesirable grasses from the ROW.
- Remove tree stakes and braces as soon as possible.
- Trees shall be pruned to remove broken, crossed or diseased branches.
- Prune for visibility of traffic, signs, delineators and curb edges.
- Do not prune trees or shrubs up after landscape establishment unless needed for sight visibility or utility line clearances.
- Allow all plants to grow into a natural multi-trunk tree/shrub formation.

Landscape Planting Notes:

- No trees shall be located within 10 feet of sewer or water lines, or overhead utility lines. All trees shall be planted in conformance with this standard. Trees shall be field adjusted if conditions differ from these plans, with approval from the engineer.
- No trees shall be located within 8 feet of gaslines.
- The minimum spacing between existing water mains and the edge of prepared soil for trees shall be a minimum of 5 feet horizontal distance from the outside of the prepared soil to the outside wall of the water pipe.
- No plants shall be planted within 10 feet of retaining walls.
- Install plants a minimum of 5 feet away from traffic control devices and lightpoles for maintenance access.
- The trunk of all trees shall be located no closer than 8 feet from face of curb.
- Trunks of all trees shall be located outside all clear zones.
- No trees or shrubs shall be planted so as to conceal the view of any highway sign or signal.
- ADOT reserves the right to inspect all containerized plants for condition of the root ball. The contractor shall supply additional plants at no additional cost to the Department if the plant is rejected.
- The plant pit depth shall be measured on the low side of the plant pit when on a slope.
- All plants shall be centered in plant pits.
- Install Granite Mulch in all planting areas within the ROW, except for seeded areas and areas receiving Rock Mulch, as shown on project plans. Refer to Planting Plans & Special Provisions for additional information.
- Refer to Landscape and Erosion Control plans for Seed Mix Location.
- Quantity schedules are shown for the contractor's convenience only. Actual quantities shall be taken from the plans.
- The contractor is responsible for all finished grading operations and shall meet existing grade at project limits. The contractor shall also insure positive drainage throughout the landscape areas to the designed drainage system and shall not create berms which obstruct flow, unless indicated per plans.
- The contractor shall install Granite Mulch in accordance with the Specifications. Place and water settle to a minimum of two inches (2") total depth over a minimum of 85% compacted subgrade. A pre-emergent herbicide shall be applied before and after granite mulch placement.
- The contractor shall provide Granite Mulch samples to the Engineer for approval prior to installation.
- All trees to be staked shall include the cost for staking and/or guying as directed by the Engineer.
- Saguaros shall be placed according to Landscape Plans. Contractor to evenly distribute differing sizing of Saguaros throughout the project.

DATE- LOCATION- REVISIONS- FINISHED PLANS- SURVEY NO. DATE- LOCATION- REVISIONS- FINISHED PLANS- SURVEY NO.


DESIGN	WDC	3/19	ARIZONA DEPARTMENT OF TRANSPORTATION INFRASTRUCTURE DELIVERY AND OPERATIONS DIVISION ROADSIDE DEVELOPMENT SECTION		
DRAWN	WDC	3/19			
CHECKED	WDC/LEM	3/19			
<b>WHEAT DESIGN GROUP</b> LANDSCAPE ARCHITECTS <small>500 N TUCSON BLVD, SUITE 150, TUCSON AZ 85716</small>			<b>LANDSCAPE NOTES</b>		
ROUTE	LOCATION		RUTHRAUFF ROAD T1		
TRACS NO. H 8480 01C			010-D(213)S		
			DWG NO. R-1.02		
			EXPIRES 6-30-2019		
			OF		



F.H.W.A. REGION	STATE	PROJECT NO.	SHEET NO.	TOTAL SHEETS	RECORD DRAWING
9	ARIZ.	010-D(213)S	761	849	


010 PM 252

DATE: \_\_\_\_\_ LOCATION: \_\_\_\_\_ REVISIONS: \_\_\_\_\_ FINISHED PLANS: \_\_\_\_\_ SURVEY NO. \_\_\_\_\_ DATE: \_\_\_\_\_ LOCATION: \_\_\_\_\_ REVISIONS: \_\_\_\_\_ FINISHED PLANS: \_\_\_\_\_ SURVEY NO. \_\_\_\_\_ DATE: \_\_\_\_\_ LOCATION: \_\_\_\_\_ REVISIONS: \_\_\_\_\_ FINISHED PLANS: \_\_\_\_\_ SURVEY NO. \_\_\_\_\_

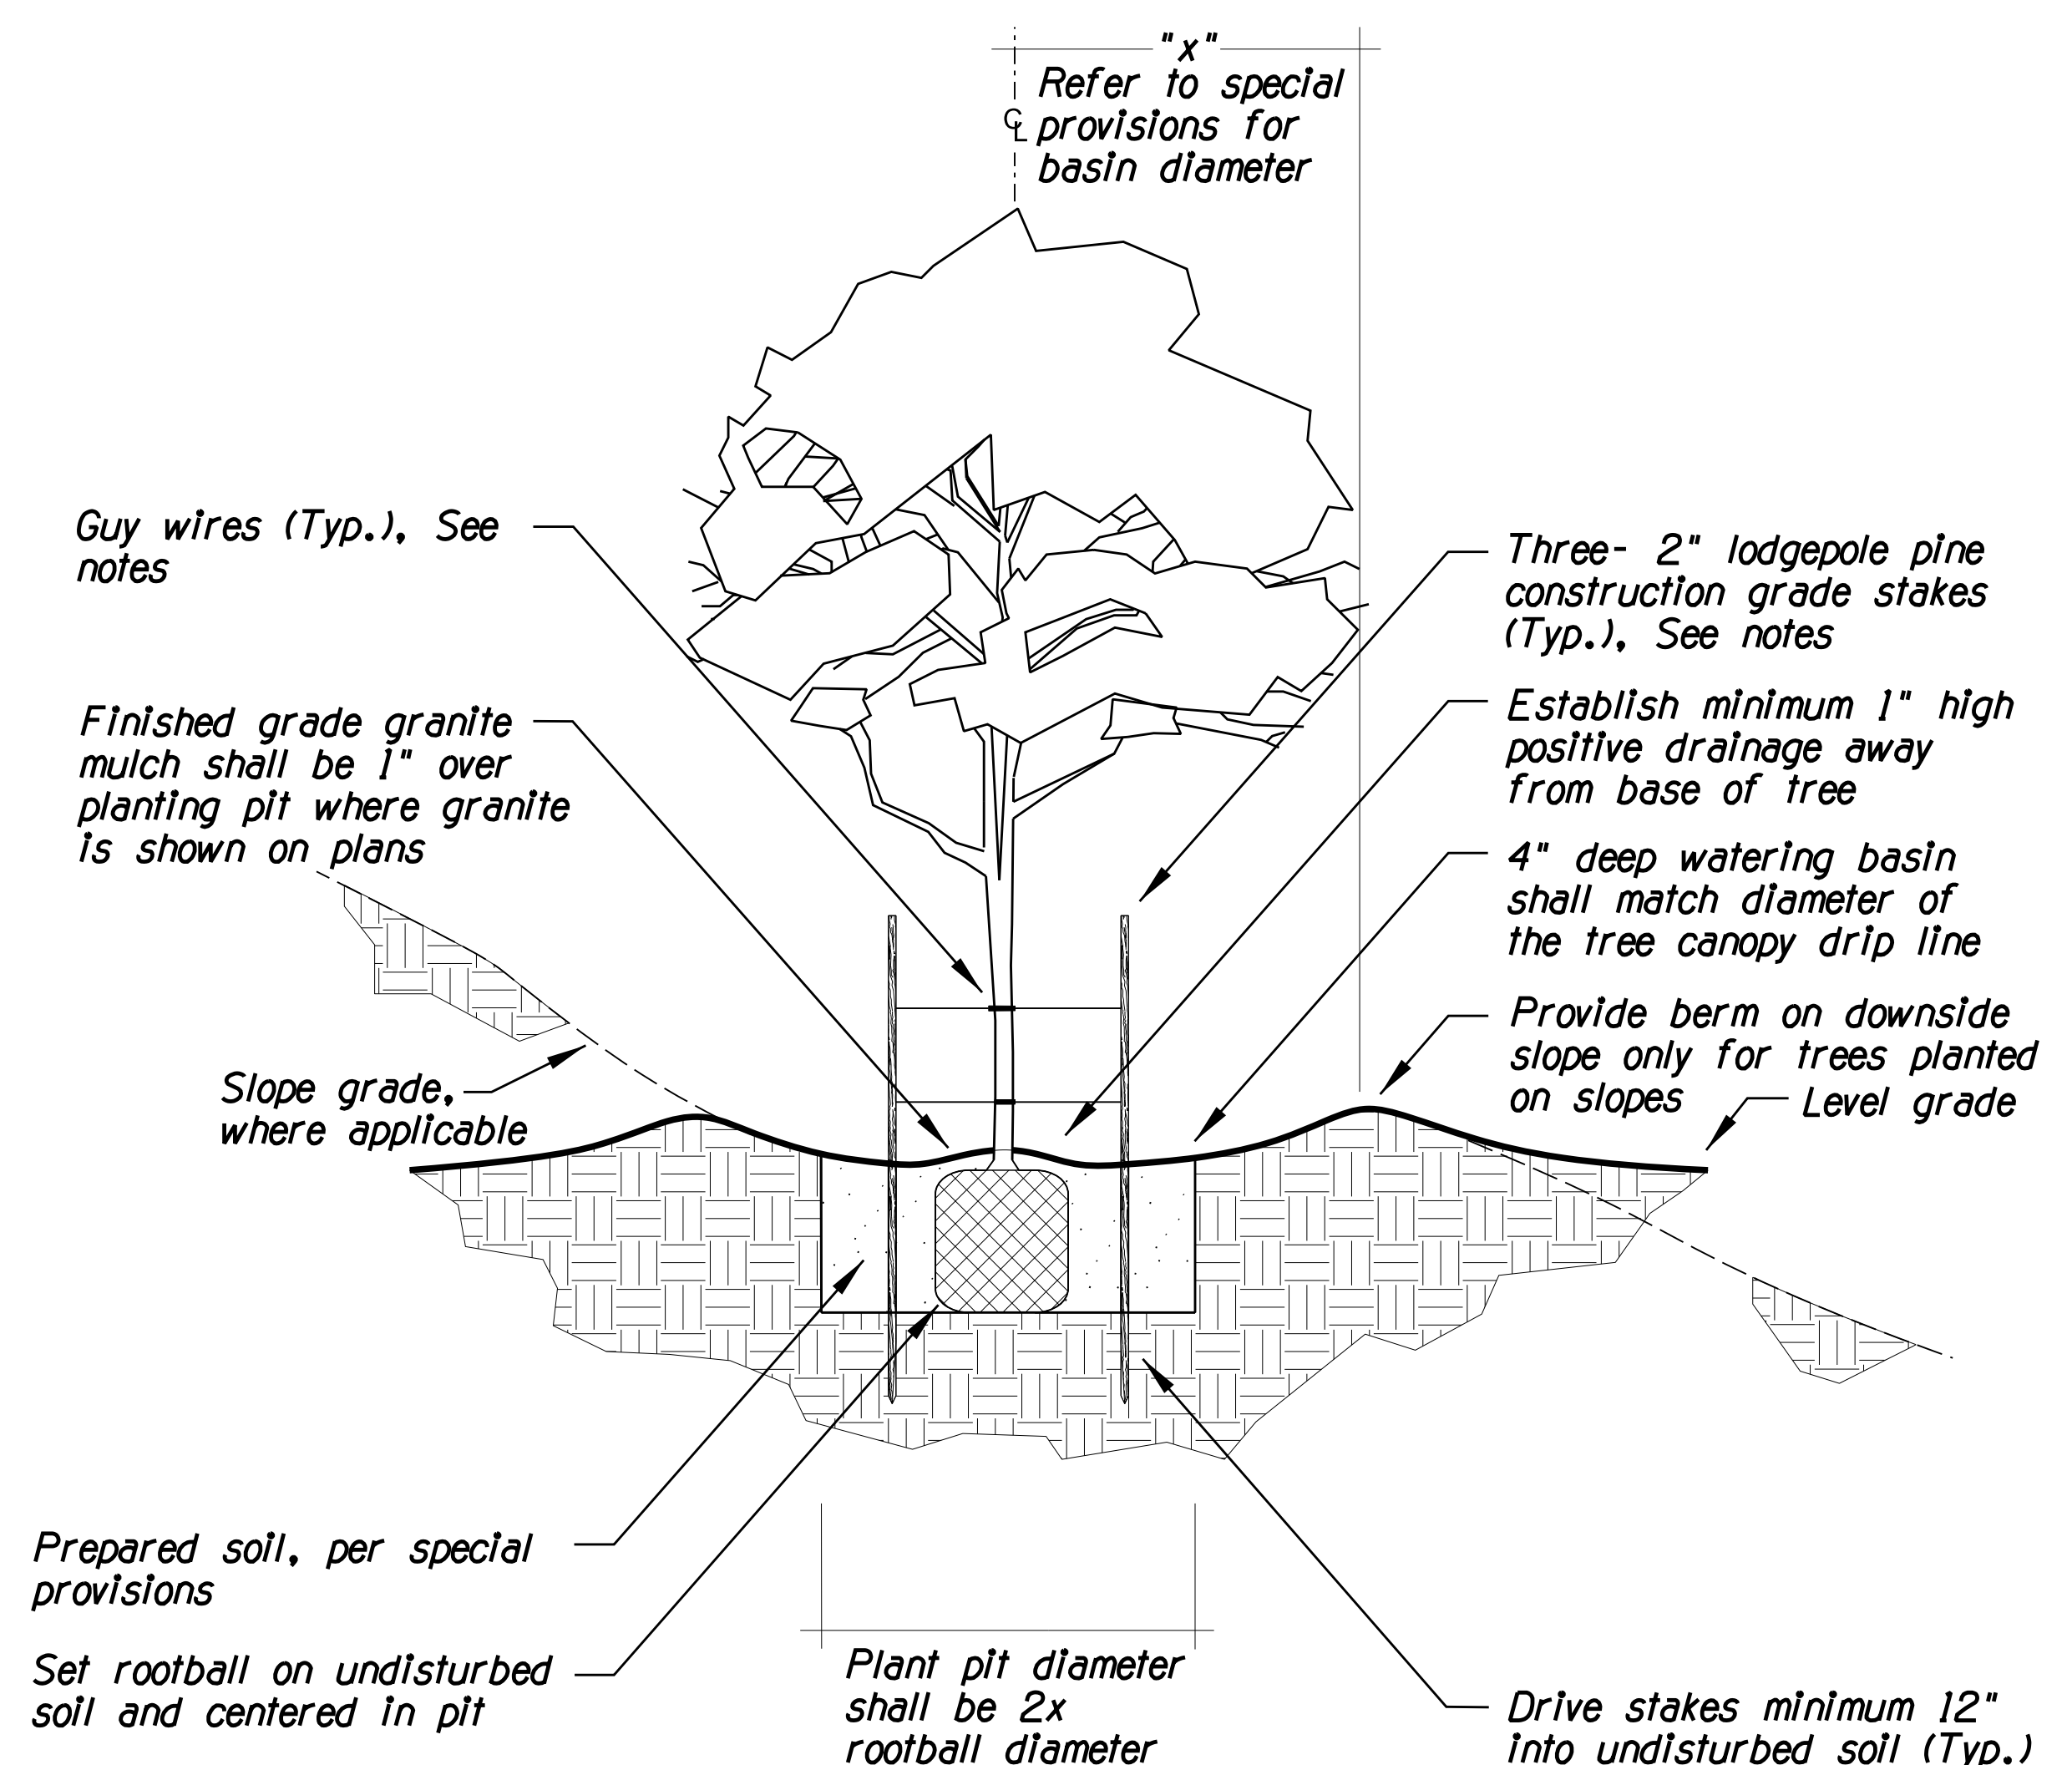


**NOTES:**  
 1. Staking installed per approved "Pruning, Staking, Guying & Irrigation Plan".  
 2. Staking shall be constructed so that trunks have flexibility.  
 3. Refer to special provisions for planting pit width and basin diameter.

**DETAIL P1**  
 STANDARD TRUNK TREE  
 PLANTING AND STAKING

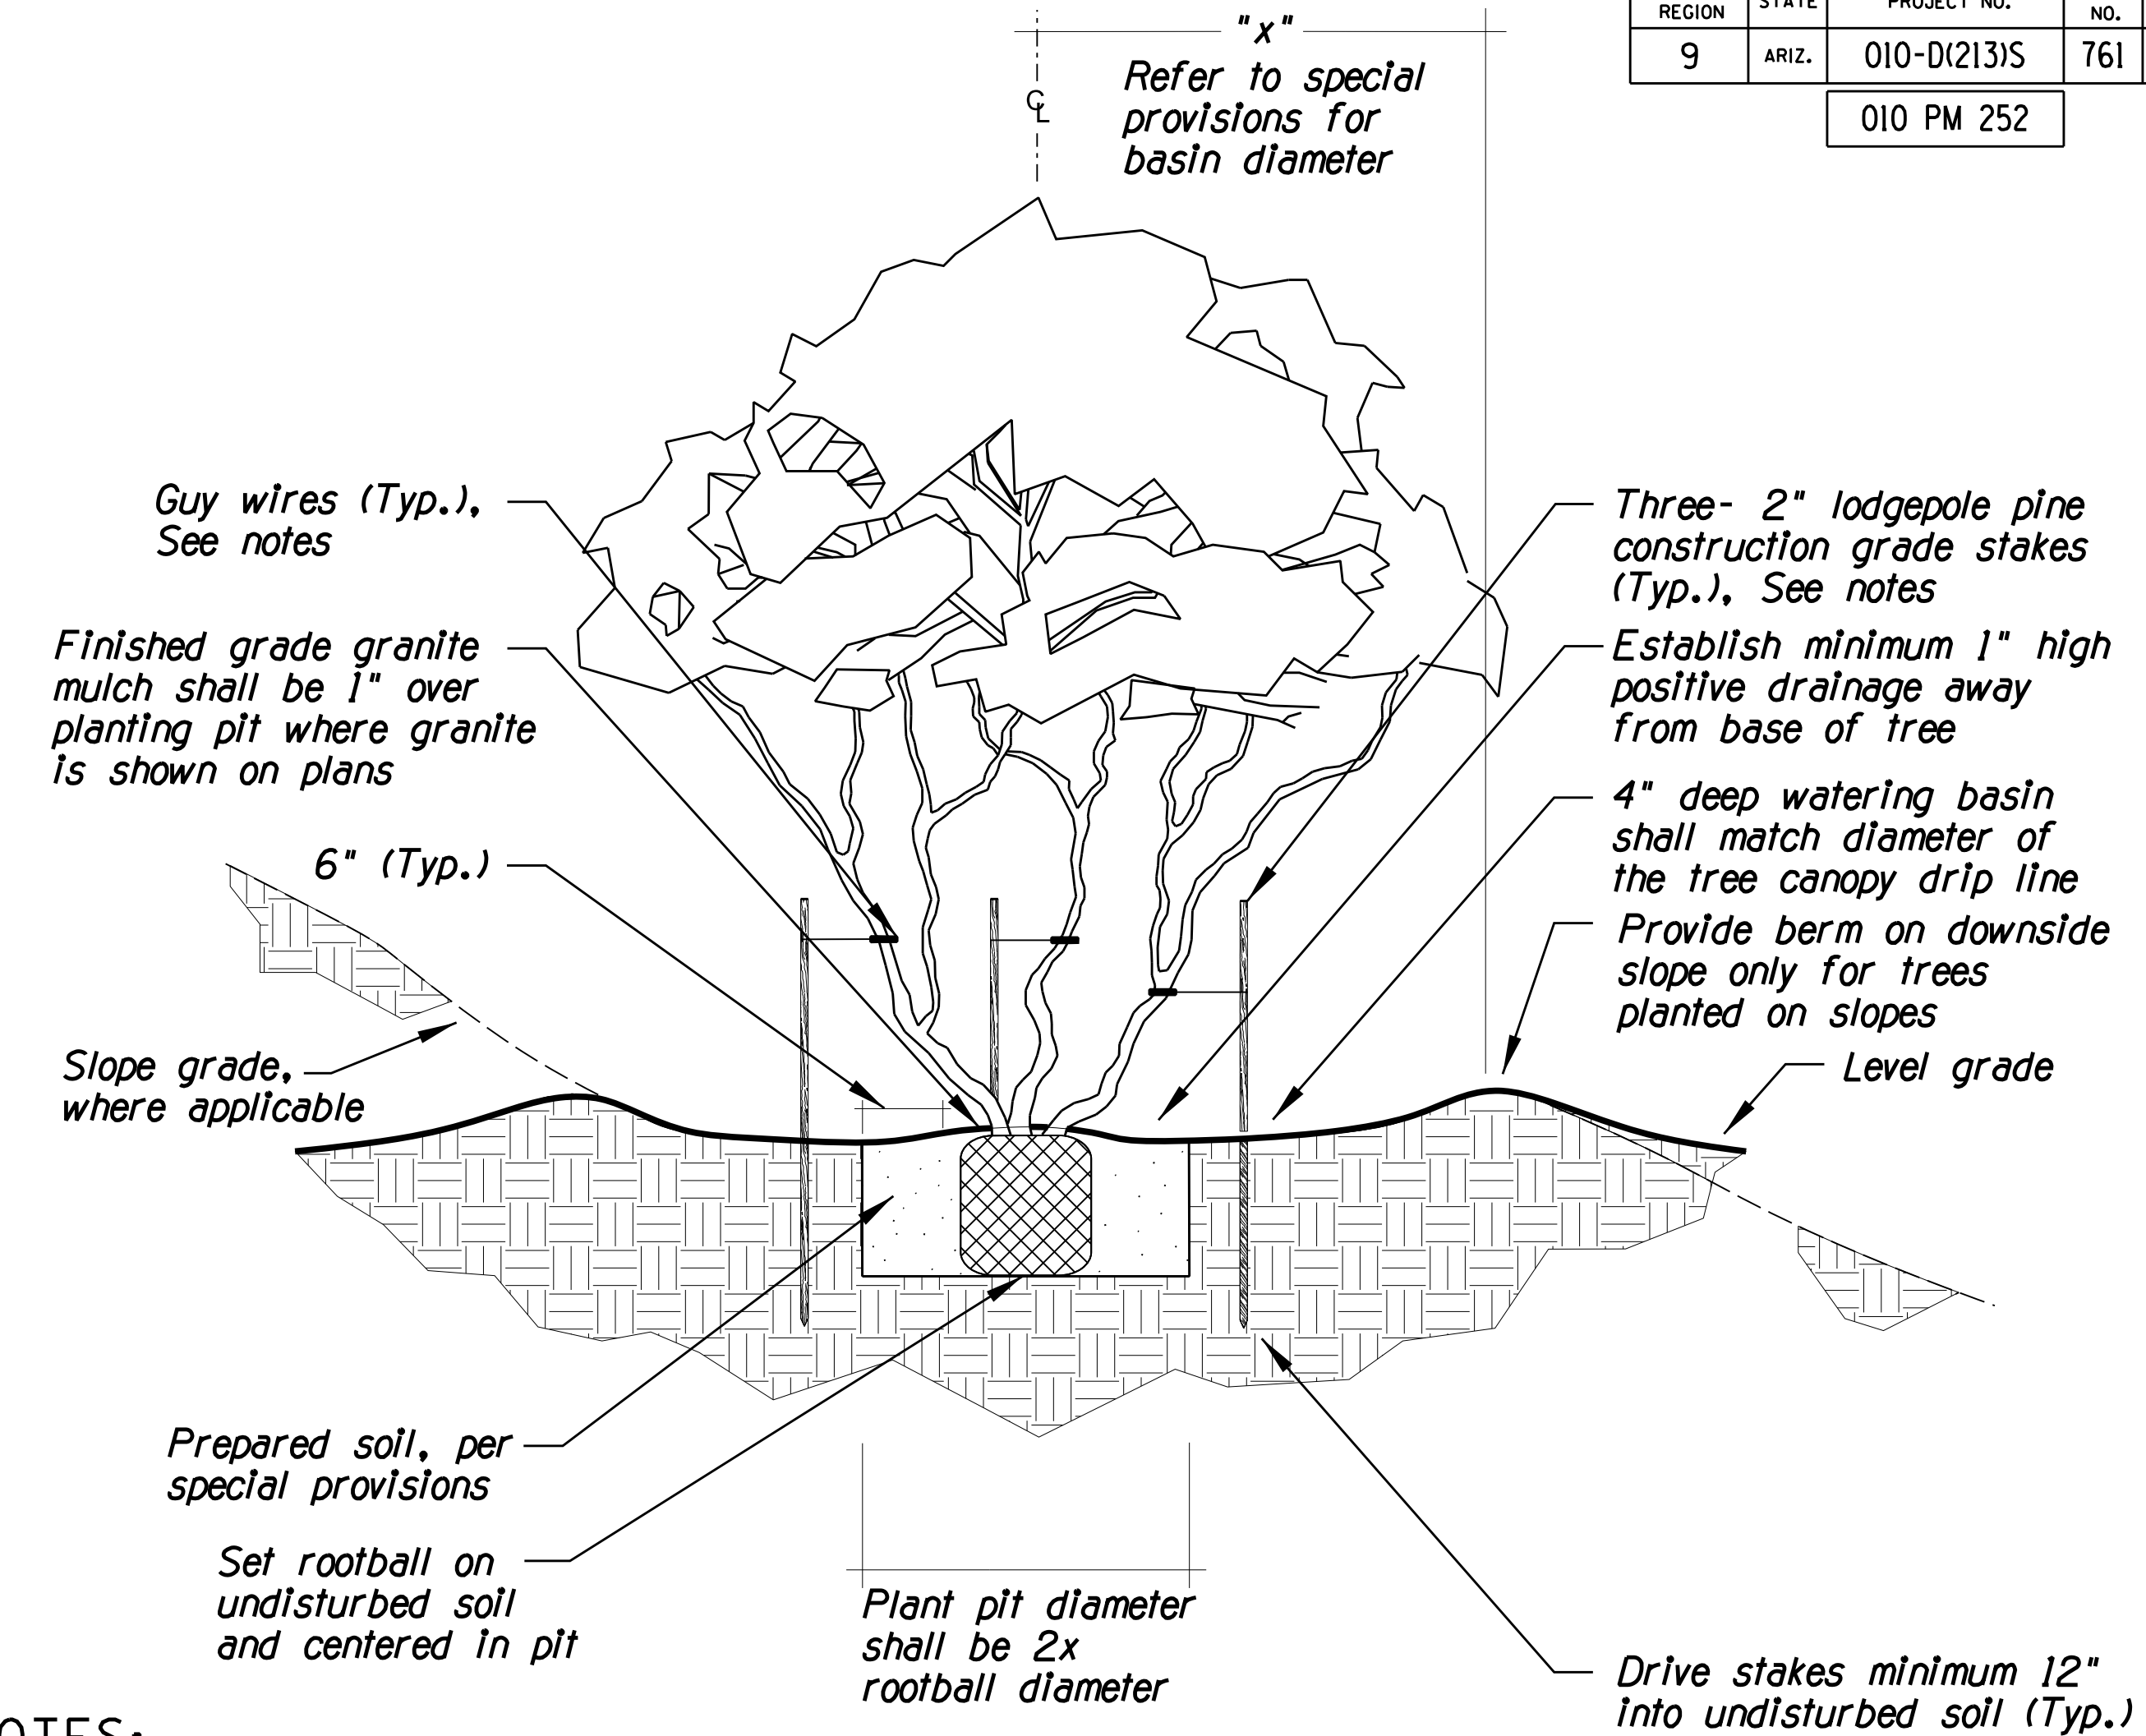


**NOTES:**  
 1. Staking installed per approved "Pruning, Staking, Guying & Irrigation Plan".  
 2. Staking shall be constructed so that trunks have flexibility.  
 3. Remove entire box when planting.  
 4. Refer to special provisions for planting pit width and basin diameter.

**DETAIL P2**  
 MULTI-TRUNK TREE  
 PLANTING AND STAKING

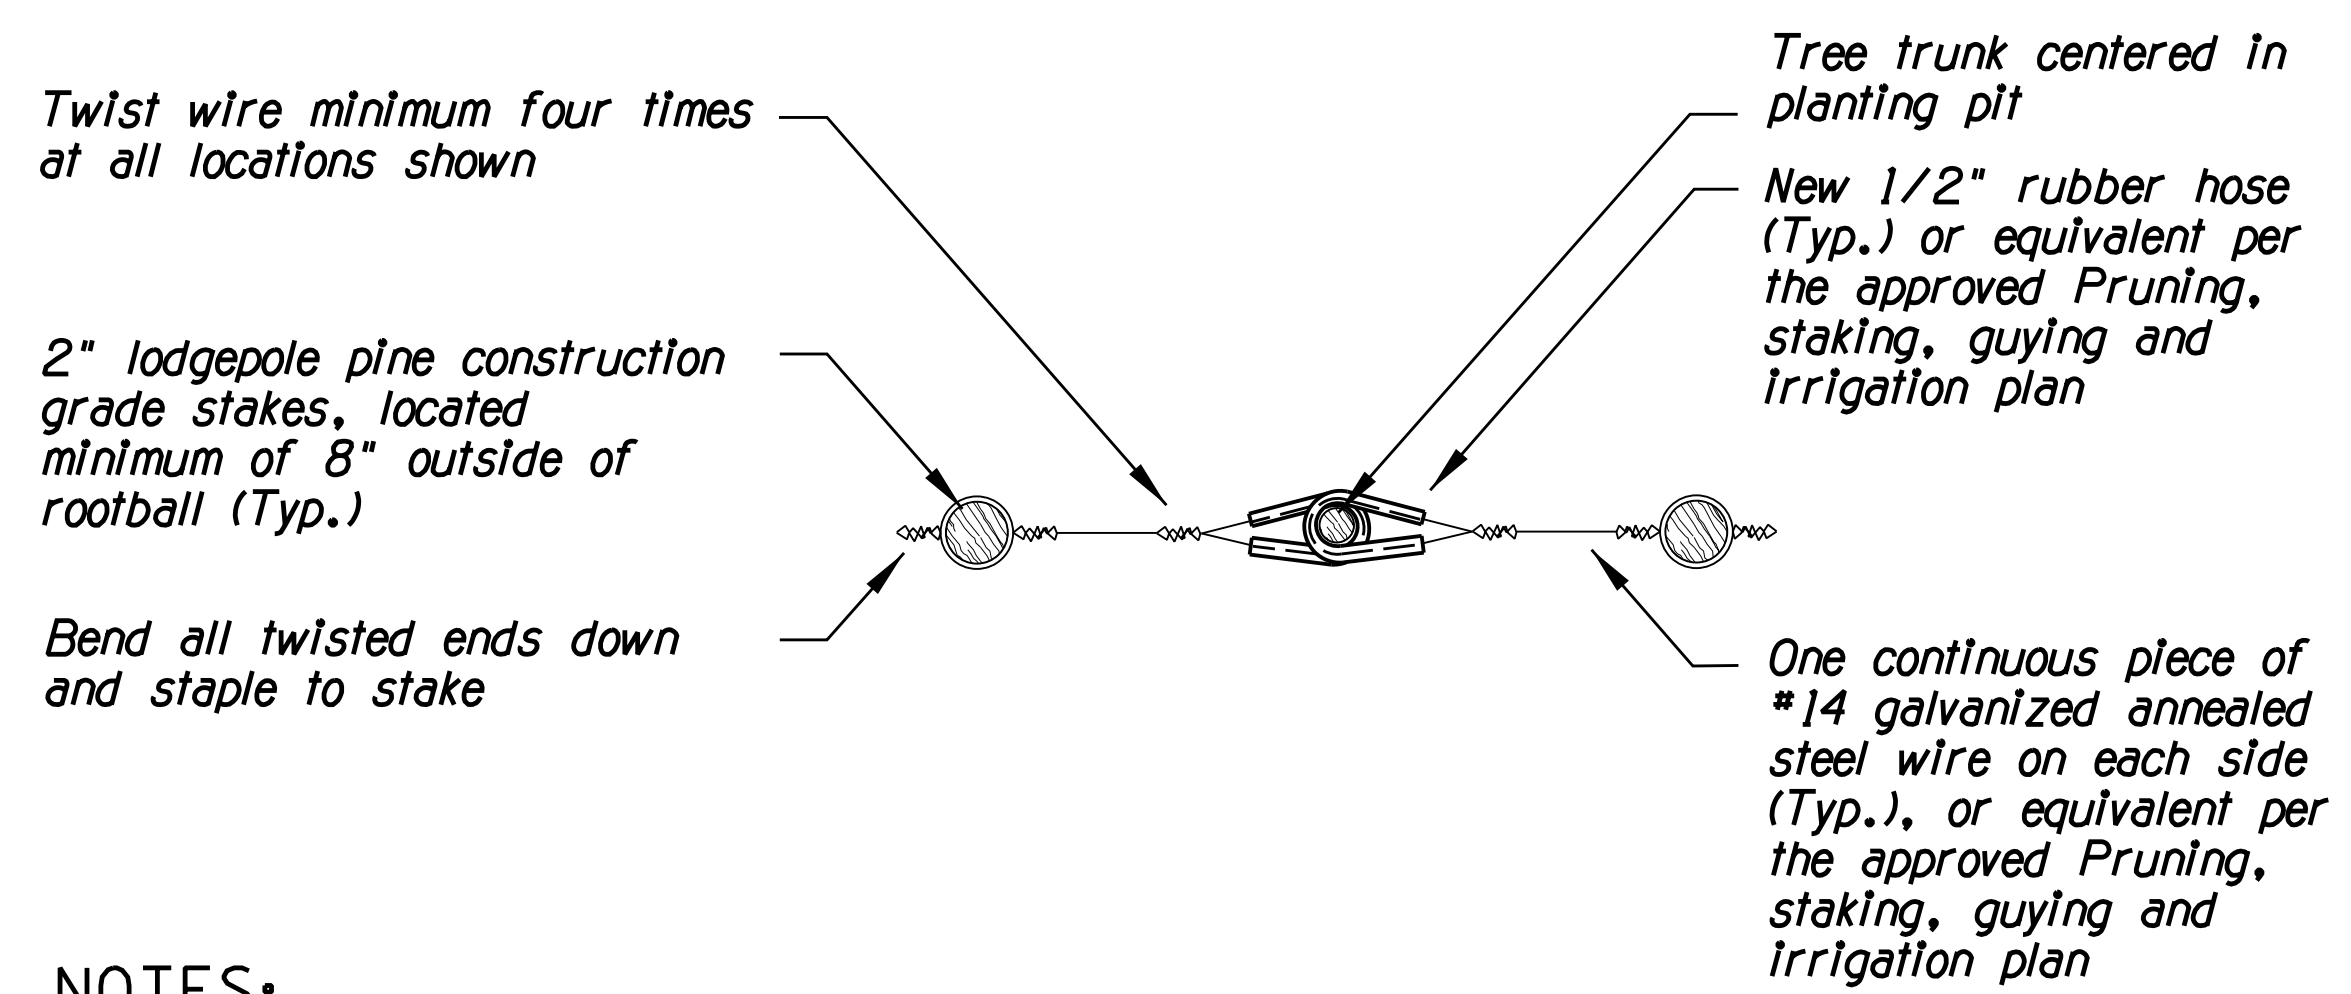

**NOTES:**  
 1. Contractor may use tree strap or equivalent product in lieu of steel wire per approval of the RLA.  
 2. Staking shall be constructed so that trunks have flexibility.

**DETAIL P3**  
 TREE DOUBLE STAKING

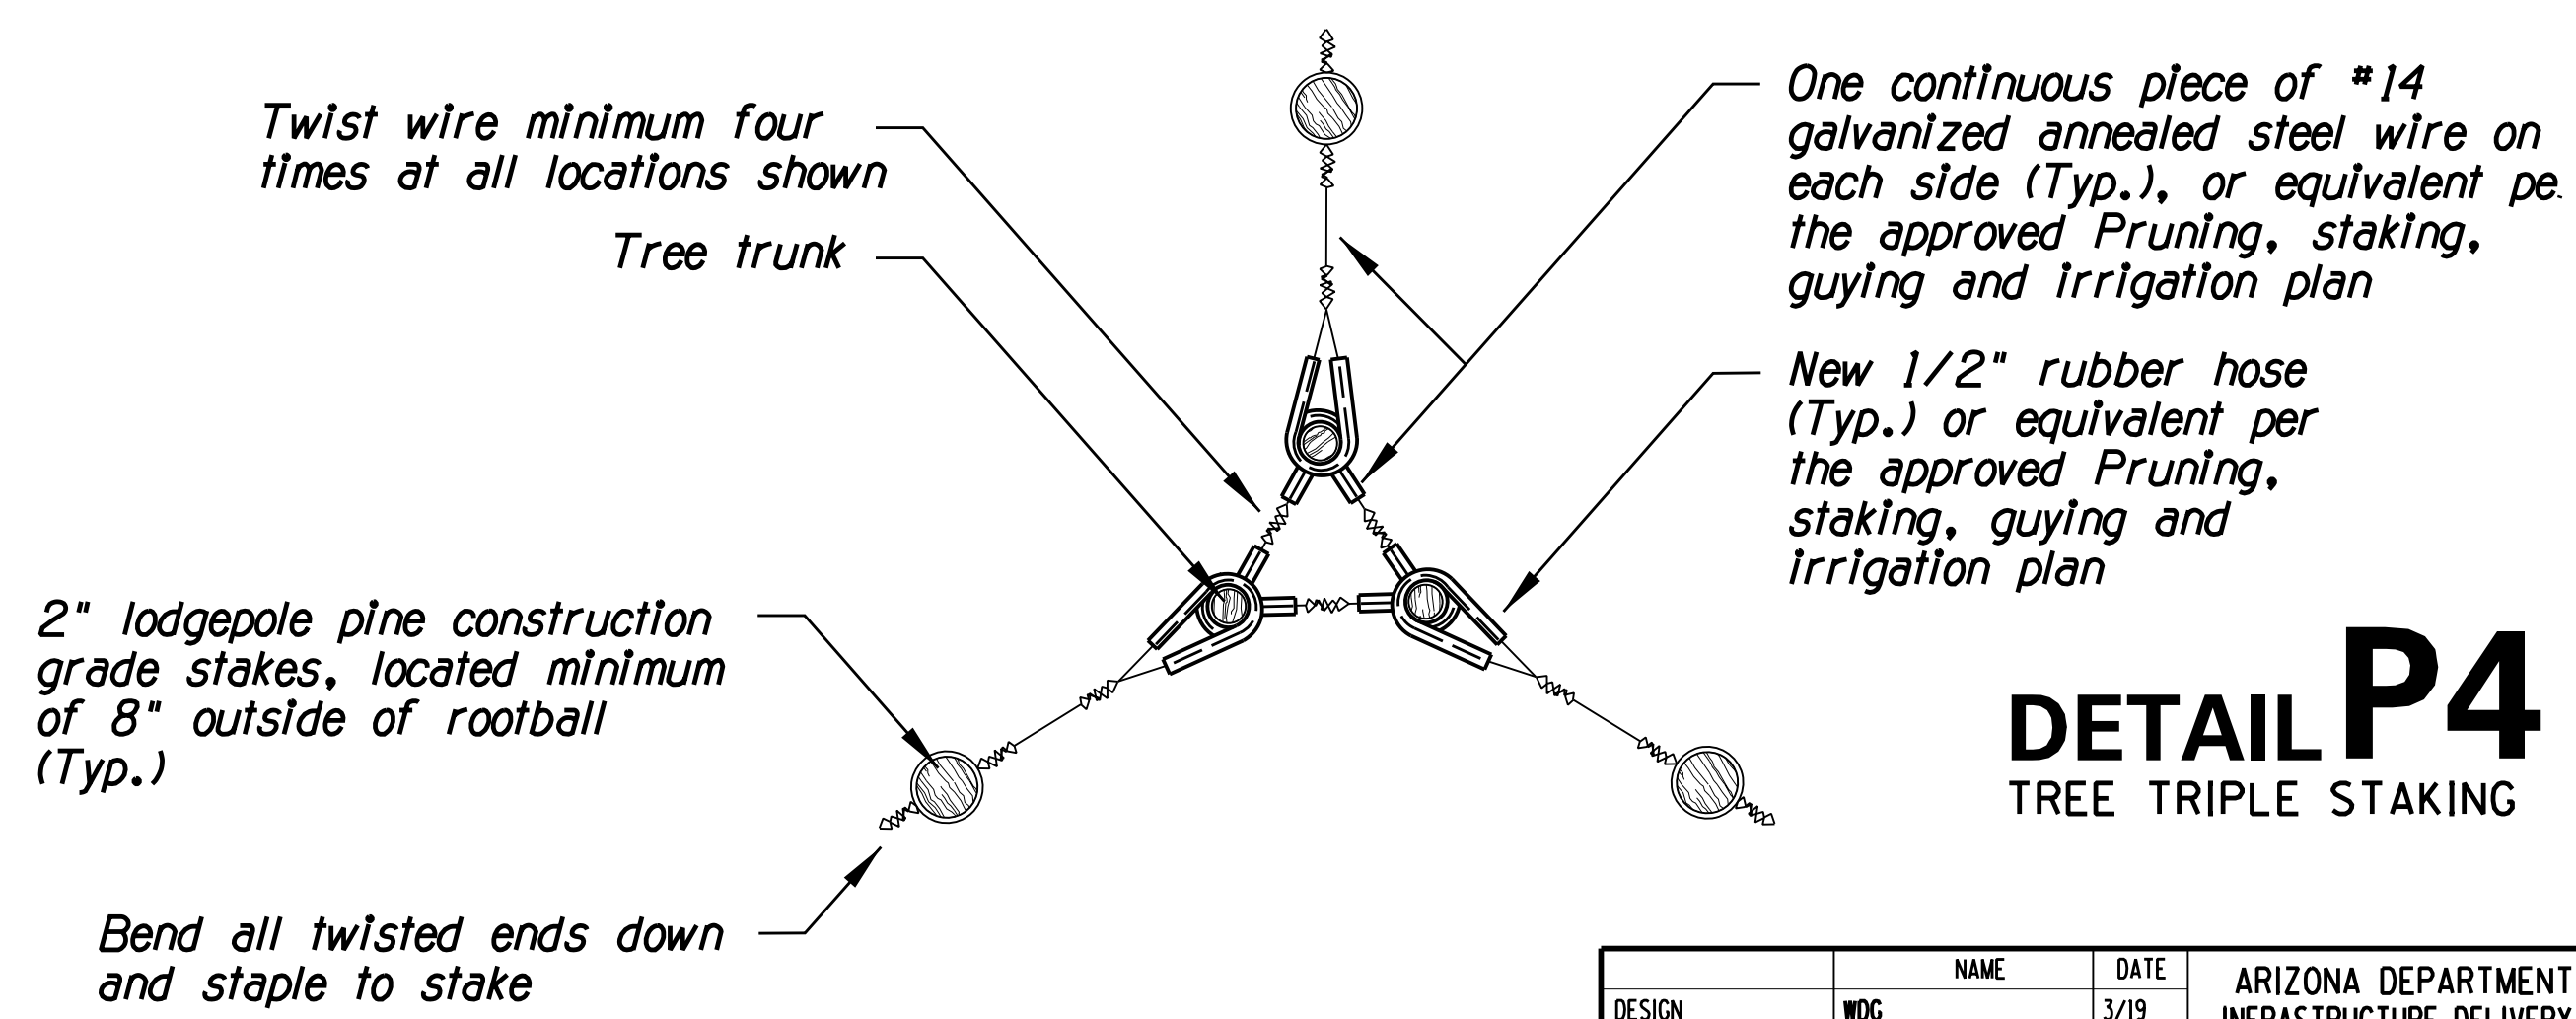


**NOTES:**  
 1. Contractor may use tree strap or equivalent product in lieu of steel wire per approval of the RLA.  
 2. Staking shall be constructed so that trunks have flexibility.

**DETAIL P4**  
 TREE TRIPLE STAKING


DESIGN	WDC	DATE	3/19	ARIZONA DEPARTMENT OF TRANSPORTATION INFRASTRUCTURE DELIVERY AND OPERATIONS DIVISION ROADSIDE DEVELOPMENT SECTION	
DRAWN	WDC	DATE	3/19		
CHECKED	WDC/LEM	DATE	3/19		
<b>WHEAT DESIGN GROUP</b>		LANDSCAPE ARCHITECTS		LANDSCAPE PLAN DETAIL SHEET	
500 N TUCSON BLVD, SUITE 150, TUCSON AZ 85716					
ROUTE	LOCATION	RUTHRAUFF ROAD T1			
I-10					
TRACS NO. H 8480 OIC			010-D(213)S		
					EXPIRES 6-30-2019 DWG NO. R-2.01
					OF

F.H.W.A. REGION	STATE	PROJECT NO.	SHEET NO.	TOTAL SHEETS	RECORD DRAWING
9	ARIZ.	010-D(213)S	762	849	
010 PM 252					

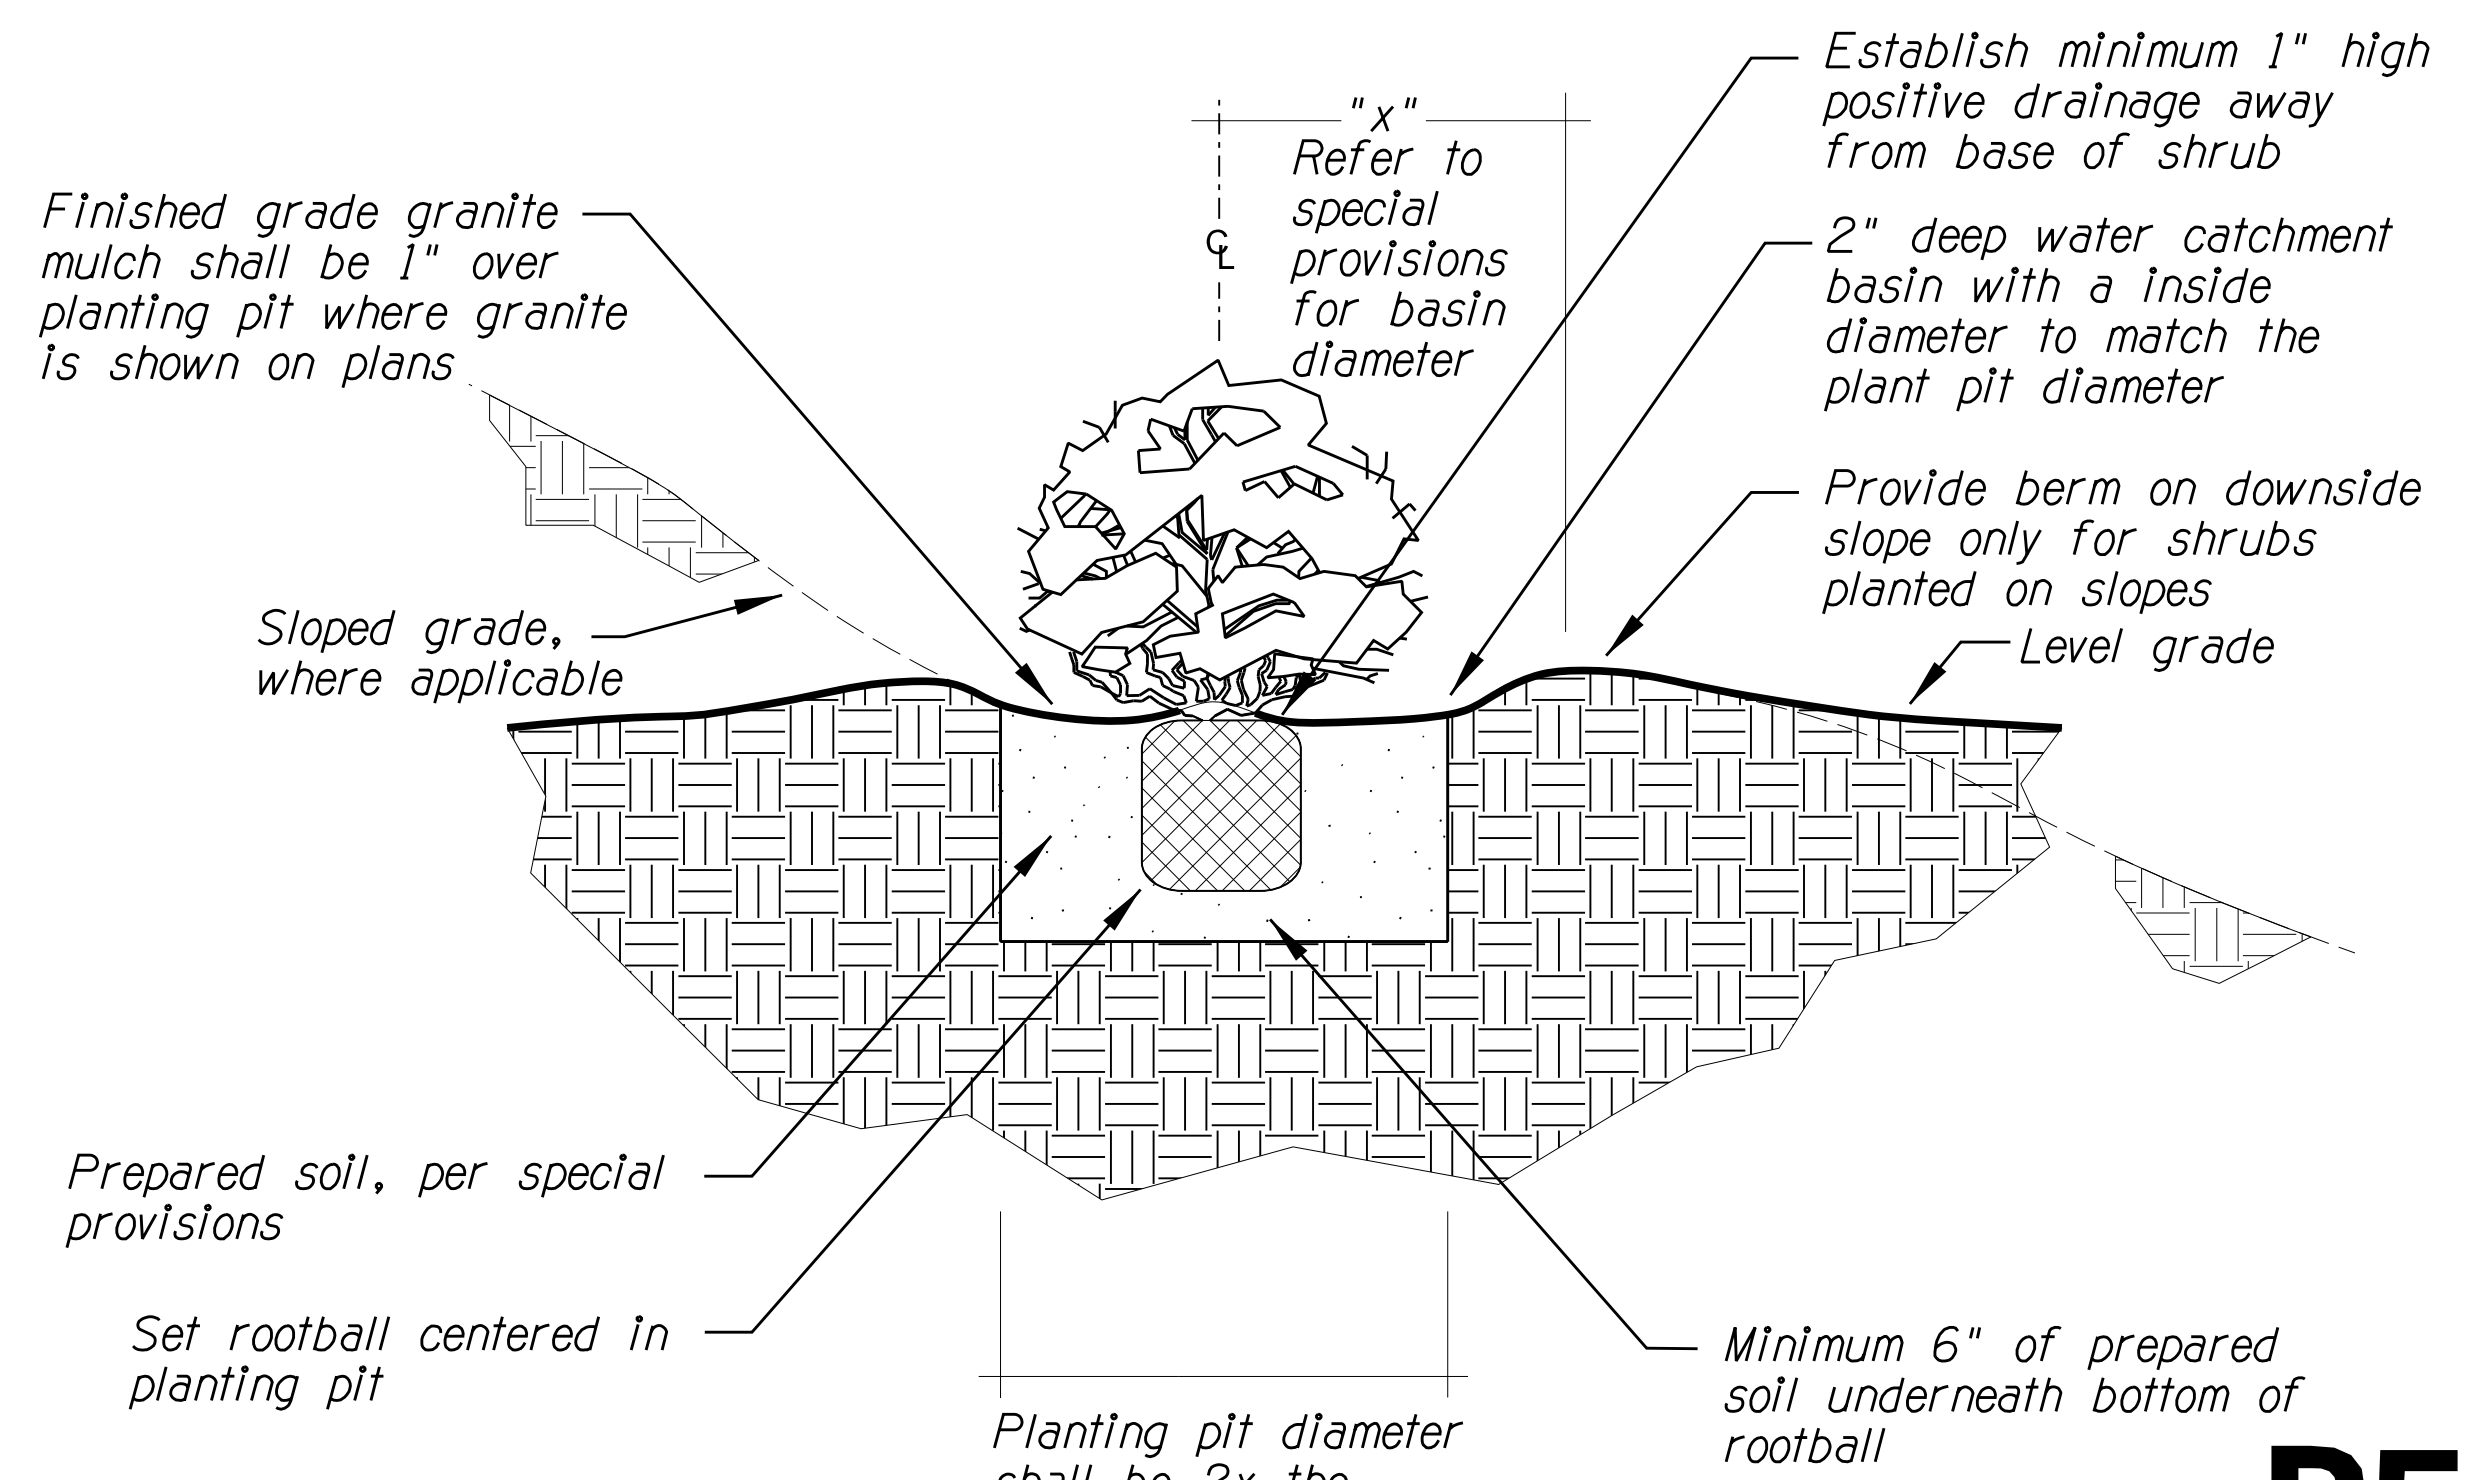


**DETAIL P5**  
SHRUB PLANTING

NOTE:  
1. Refer to special provisions for planting pit width and basin diameter.

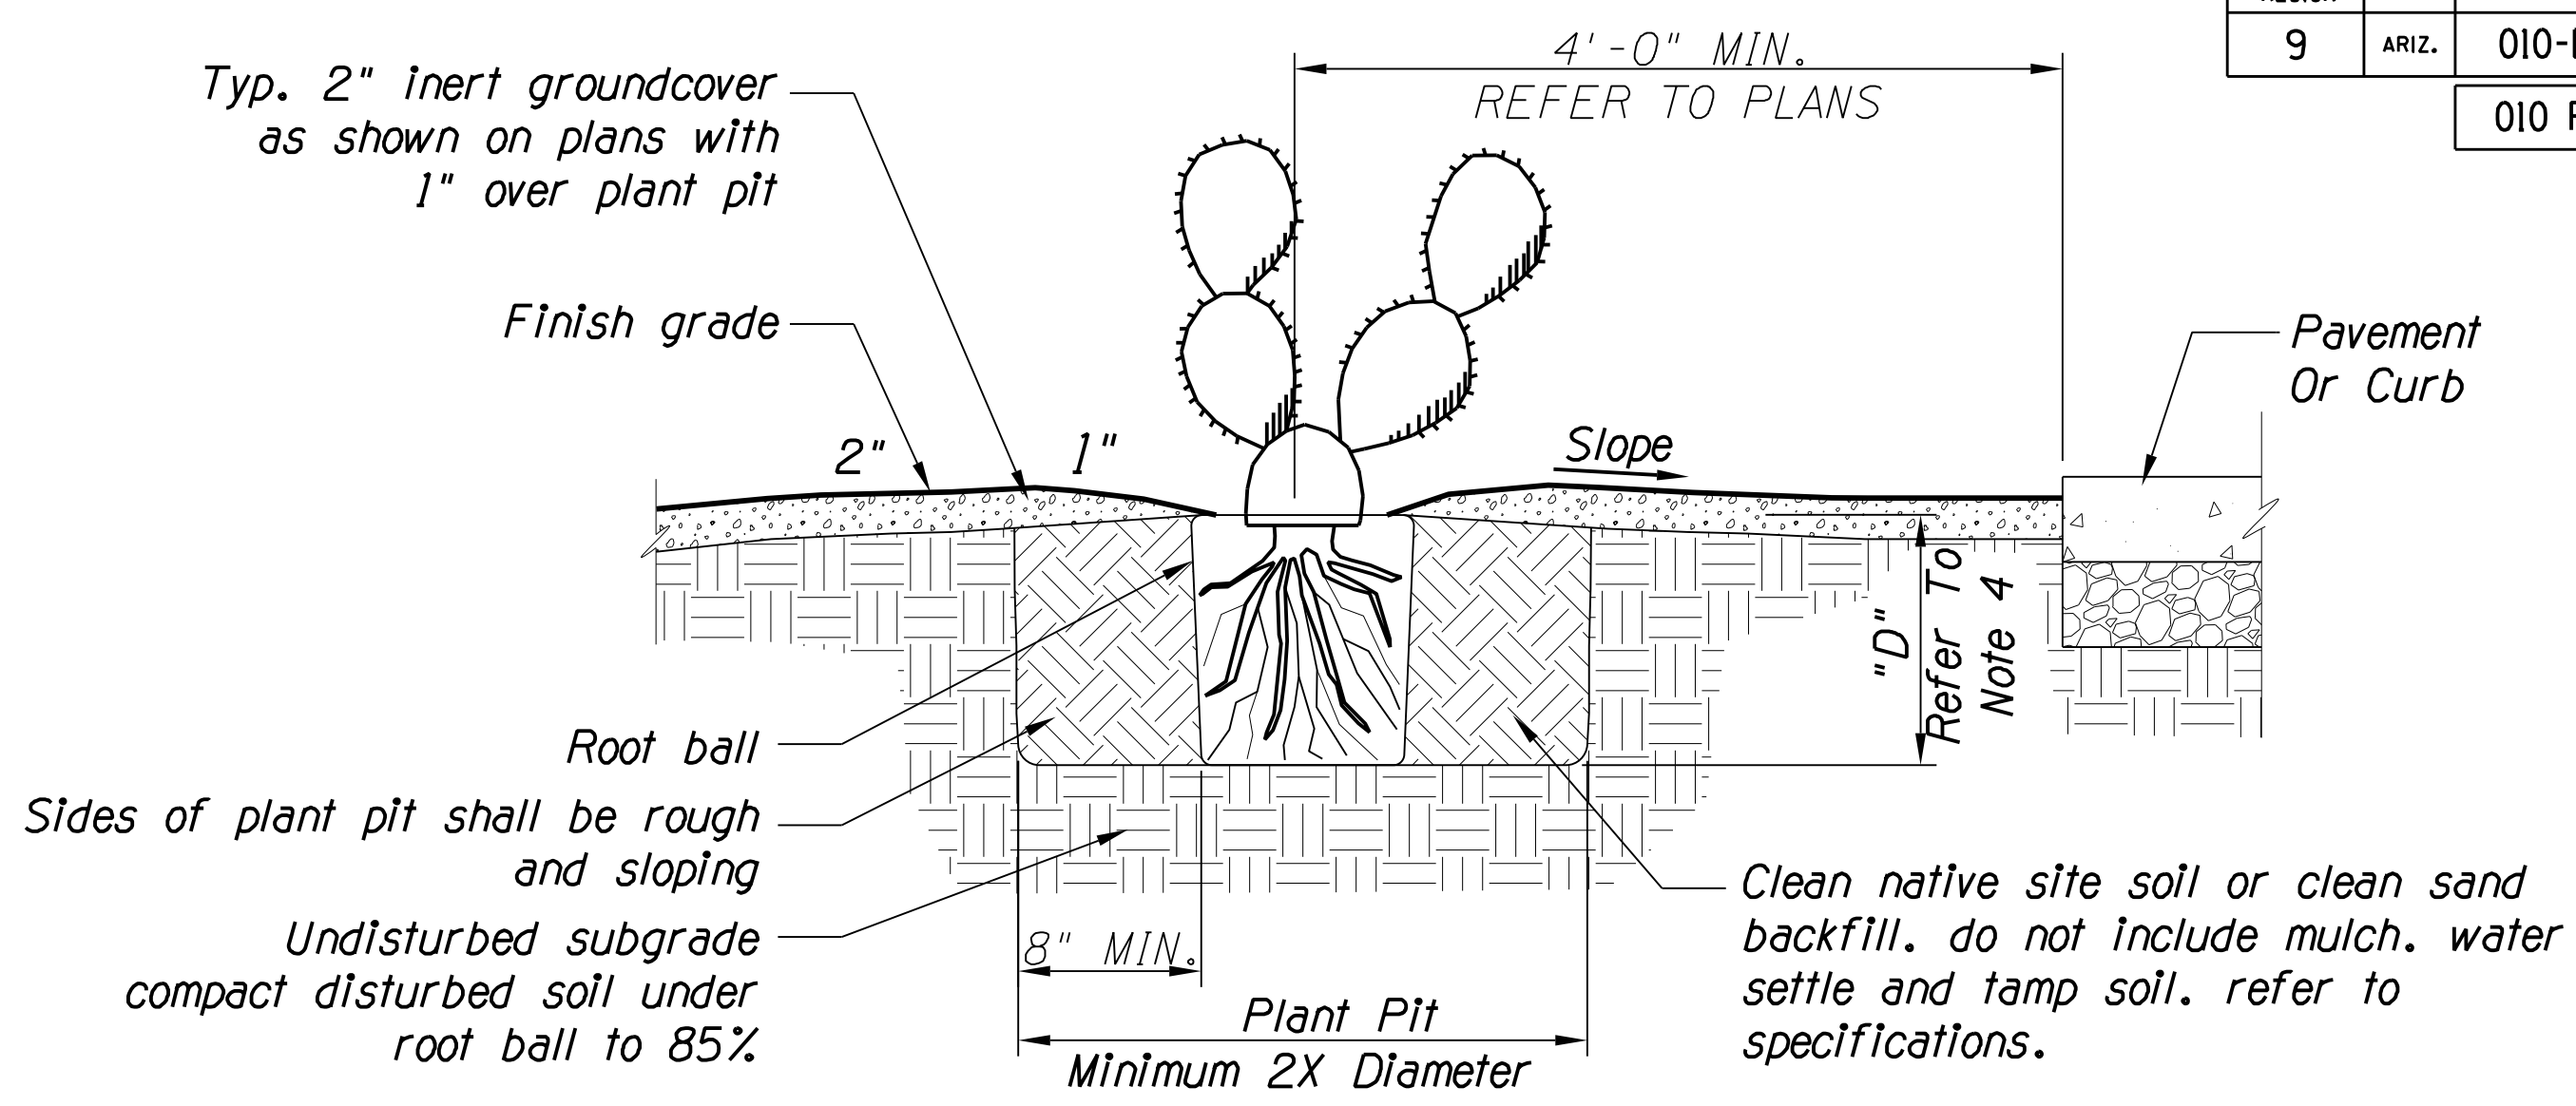


**DETAIL P6**  
CACTUS PLANTING

NOTES:  
1. This detail applies to nursery grown stock of cactus.  
2. Do not create a basin at base of plant. slope backfill away from stem.  
3. Set stem succulent so that top of root ball matches adjacent grade.  
4. Depth ("d") of plant pit to be equal to depth of root ball.

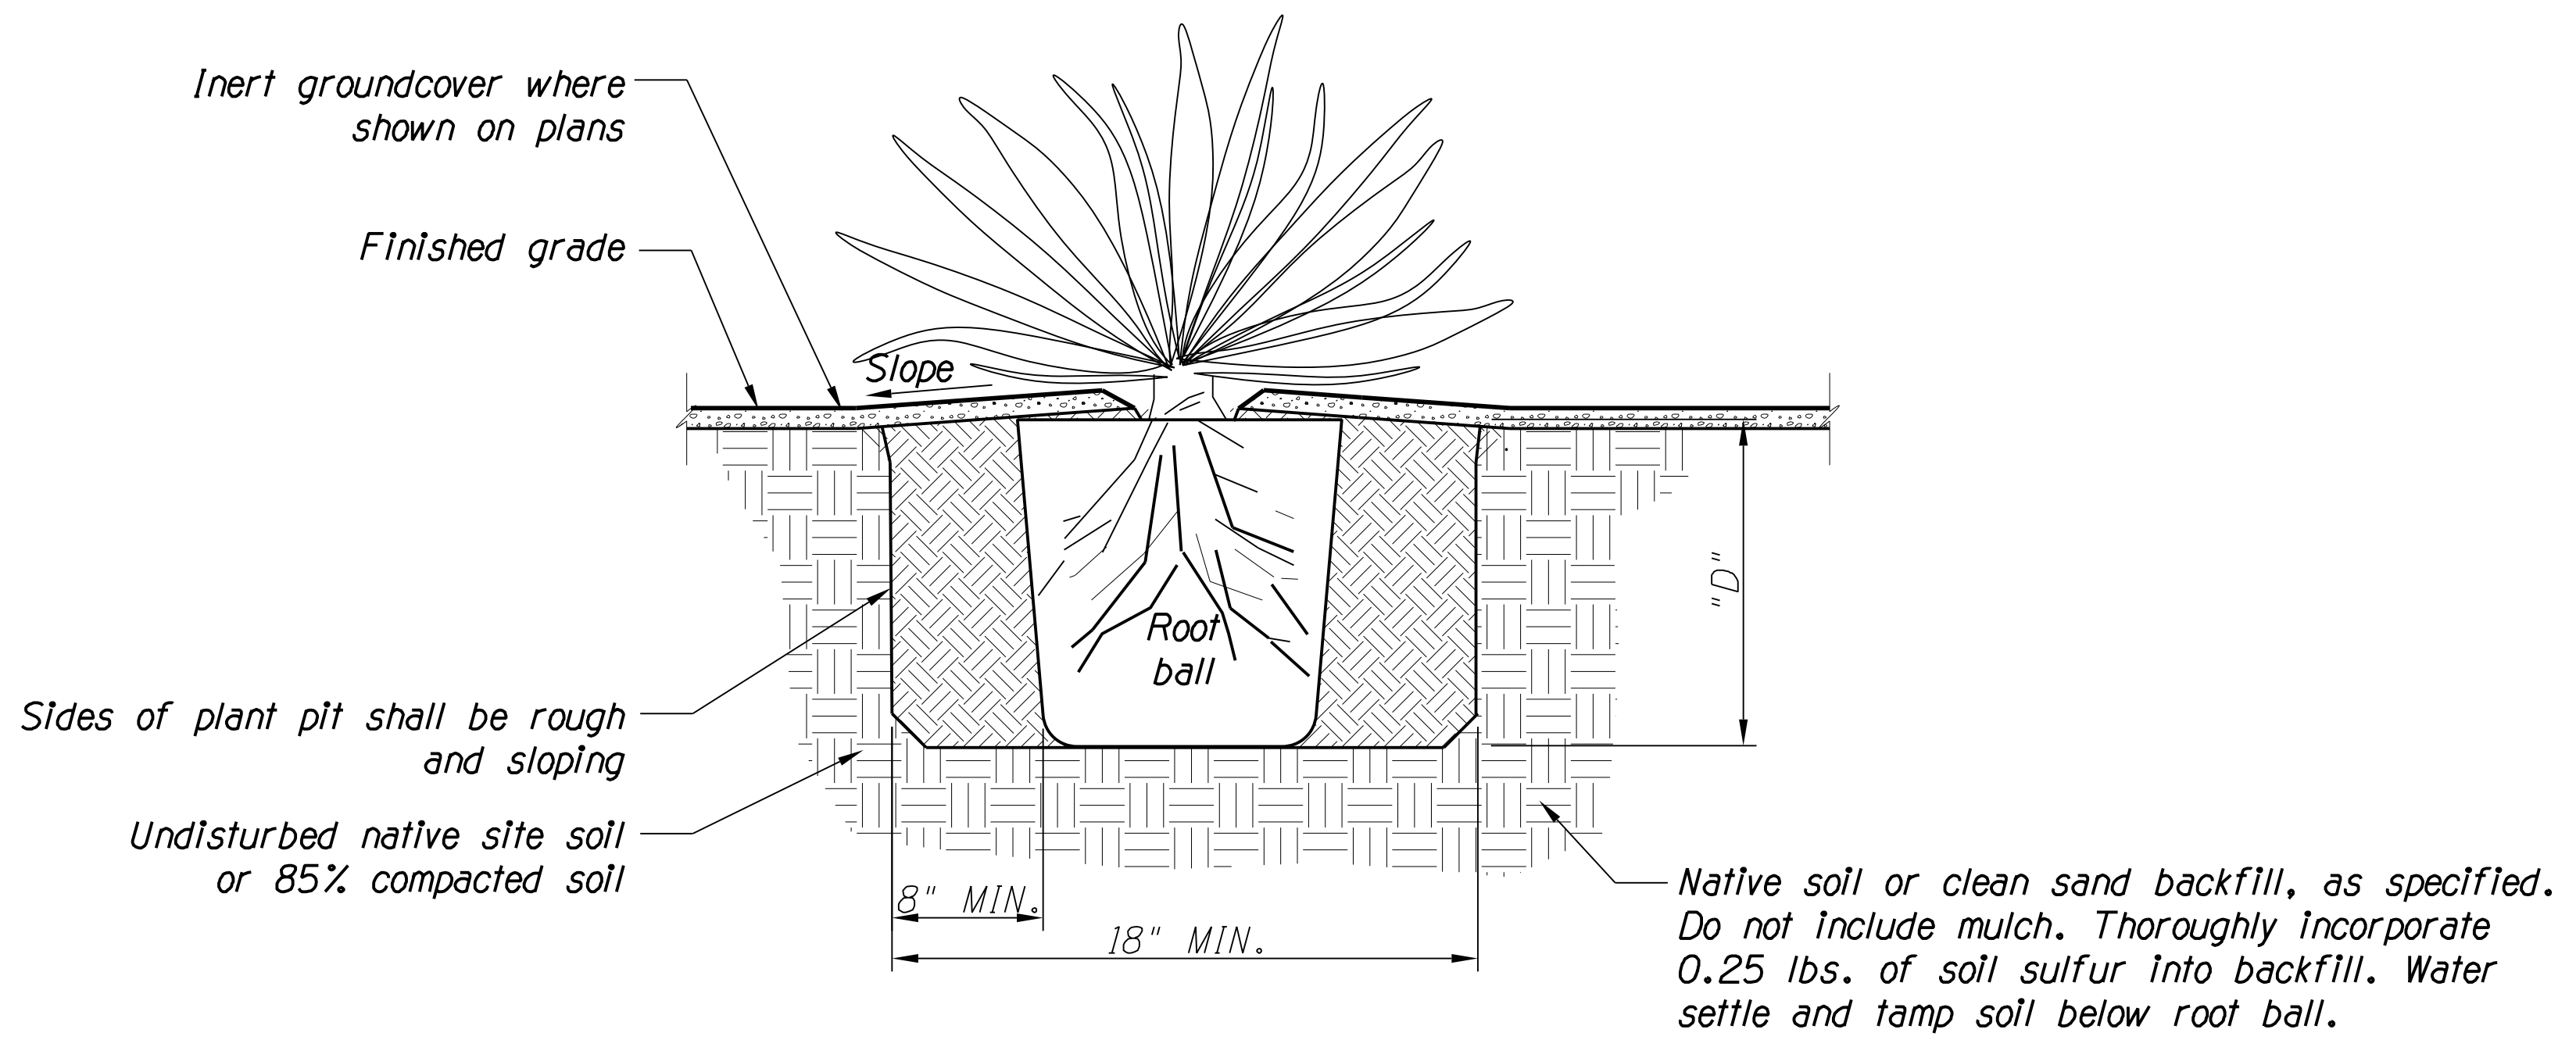

**DETAIL P7**  
YUCCA PLANTING

NOTES:  
1. Do not create a basin at base of plant. Slope backfill away from stem.  
2. Set stem succulent so that top of root ball matches adjacent grade.  
3. Depth ("D") of plant pit to be equal to depth of rootball.  
4. Maintain intact rootball. Root prune all shredded or damaged roots. Ensure that all wounds to the root system are clean cut before planting.  
5. Backfill with dry site soil only.  
6. This detail applies to nursery grown stock of the Genera Agave, Aloe, Dasylirion, Hesperaloe, Nolina and Yucca.

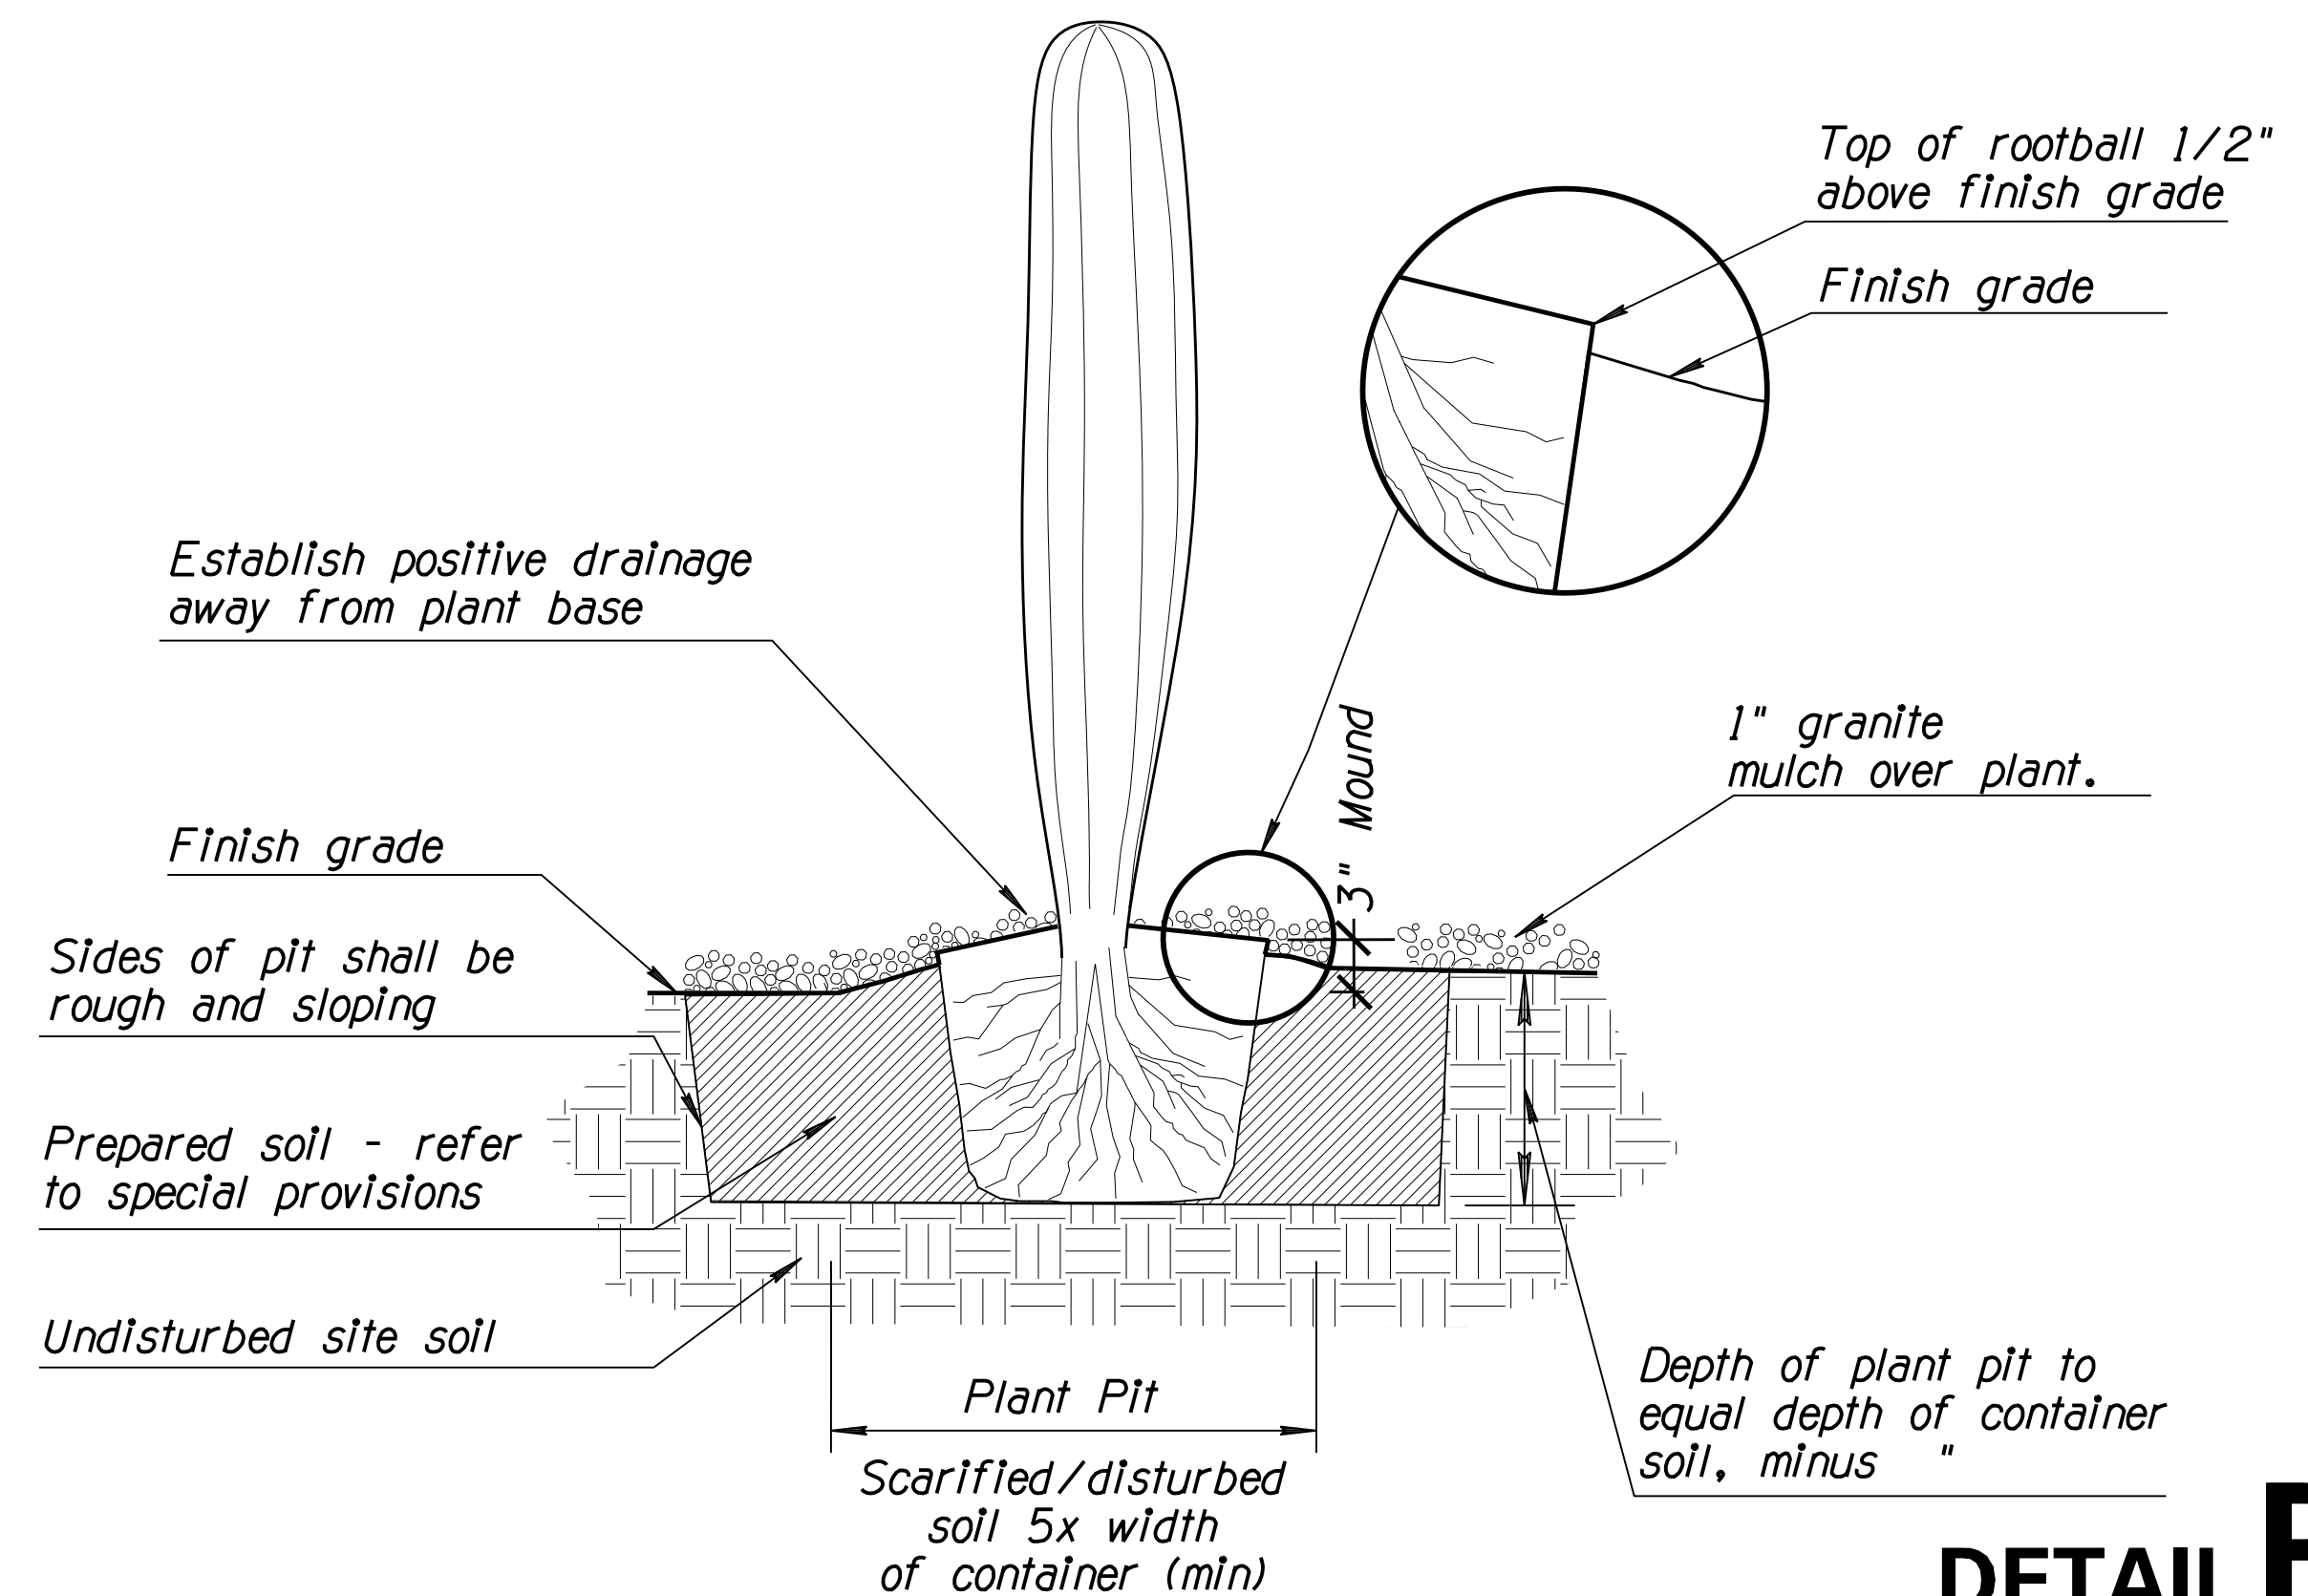


**DETAIL P8**  
SAGUARO PLANTING

DESIGN	WDC	DATE	3/19	ARIZONA DEPARTMENT OF TRANSPORTATION INFRASTRUCTURE DELIVERY AND OPERATIONS DIVISION ROADSIDE DEVELOPMENT SECTION	
DRAWN	WDC	DATE	3/19		
CHECKED	WDC/LEM	DATE	3/19		
<b>WHEAT DESIGN GROUP</b>		LANDSCAPE ARCHITECTS		LANDSCAPE PLAN DETAIL SHEET	
500 N TUCSON BLVD, SUITE 150, TUCSON AZ 85716					
ROUTE	LOCATION		RUTHRAUFF ROAD T1		
TRACS NO. H 8480 OIC		010-D(213)S		EXPIRES 6-30-2019 DWG NO. R-2.02	

DATE- LOCATION- REVISIONS- FINISHED PLANS- SURVEY NO.

F.H.W.A. REGION	STATE	PROJECT NO.	SHEET NO.	TOTAL SHEETS	RECORD DRAWING
9	ARIZ.	010-D(213)S	763	849	



010 PM 252

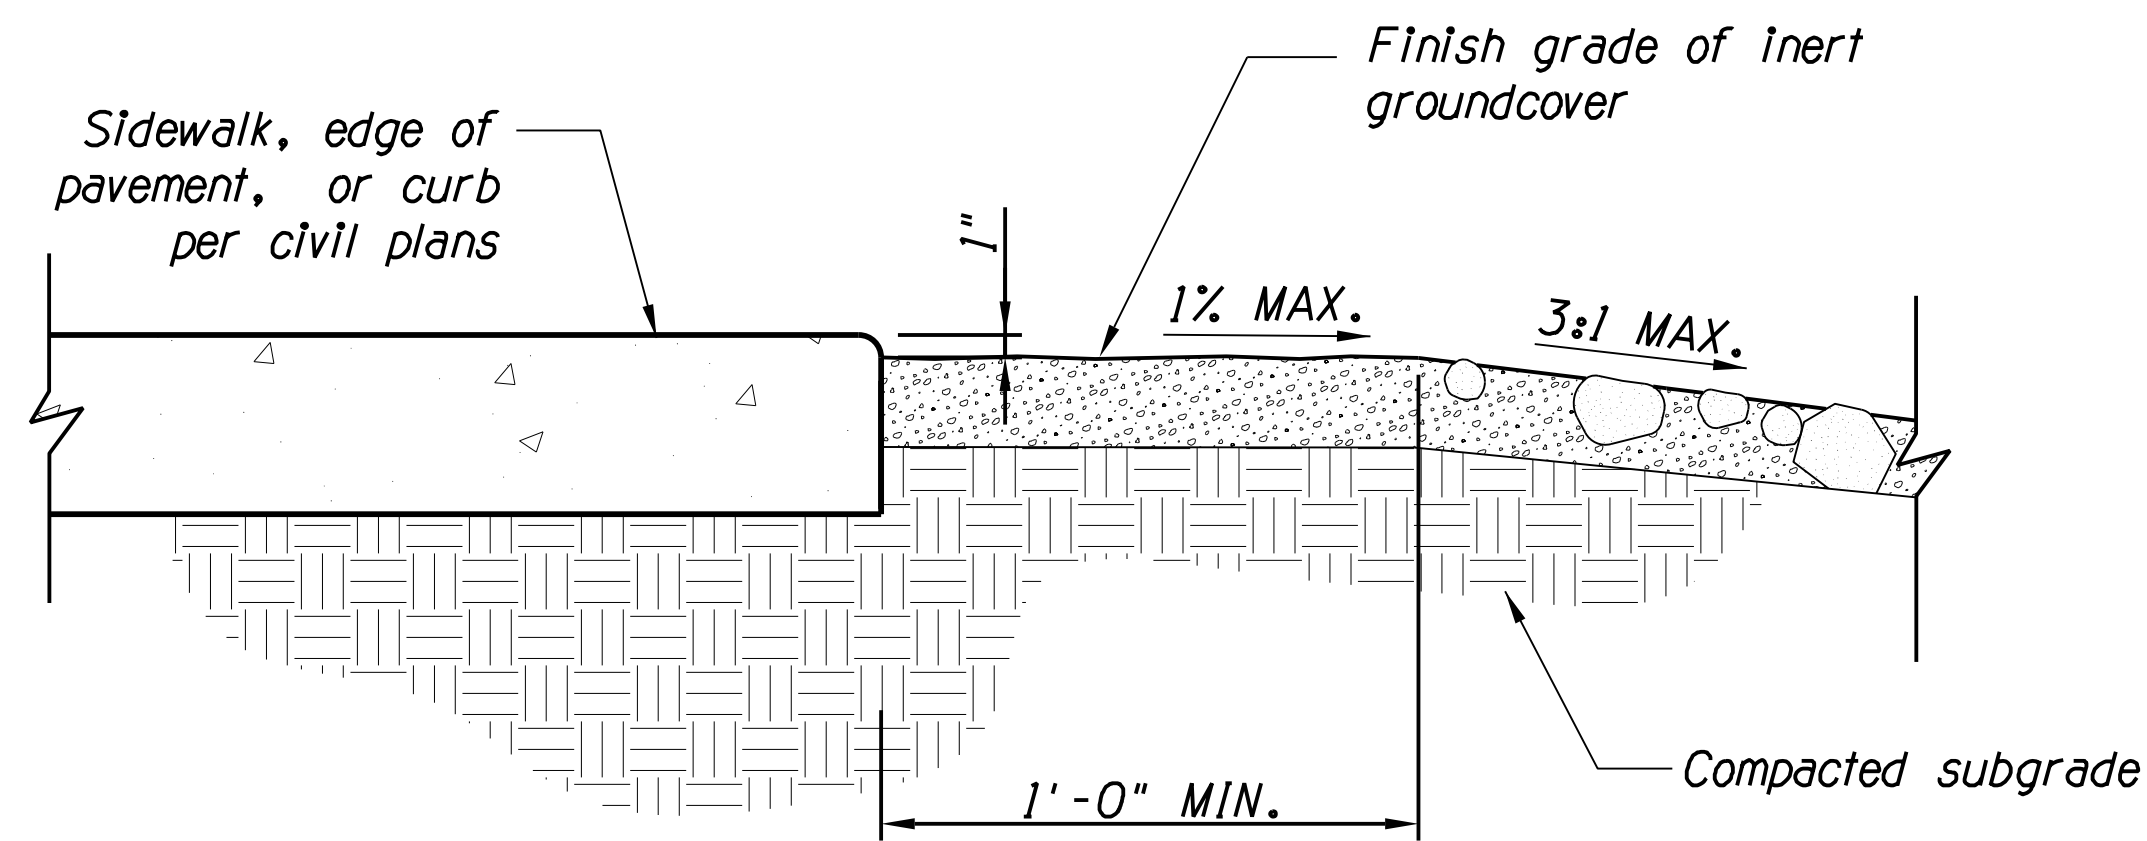

NOTE:  
1. Refer to Landscape Summary Sheet LPO1 for Granite Mulch Color and Size.

## DETAIL P9

FINISH GRADE

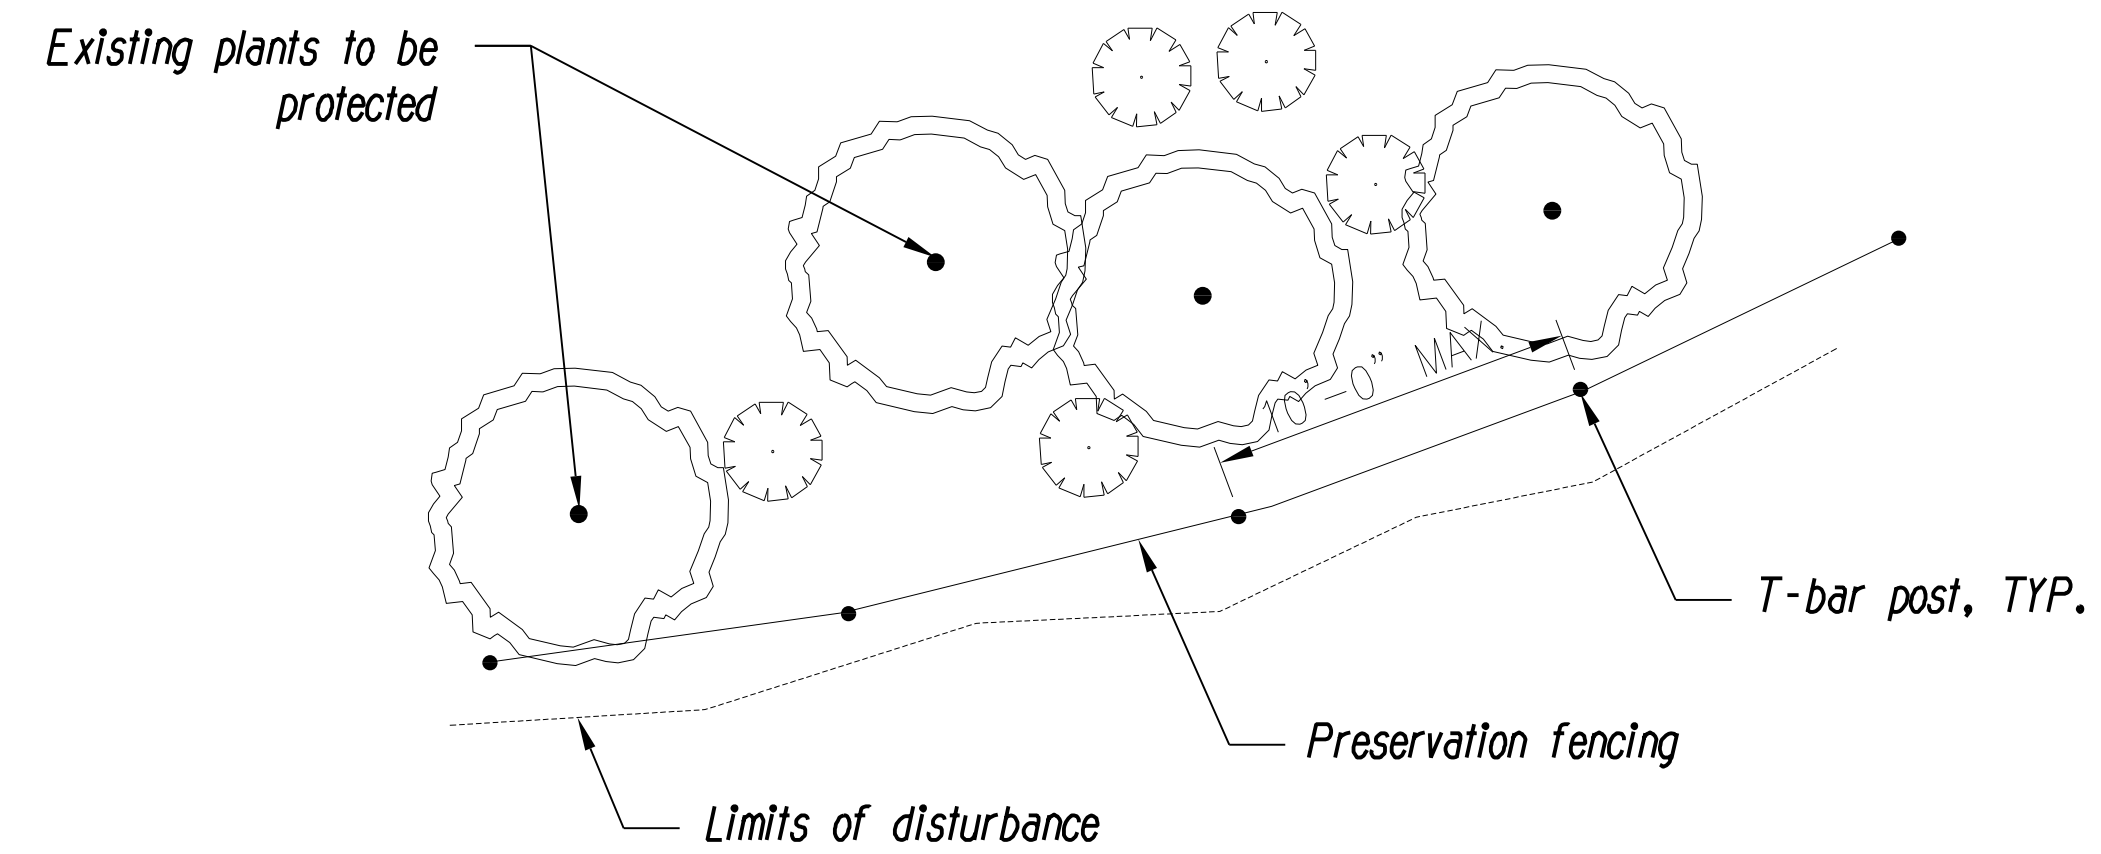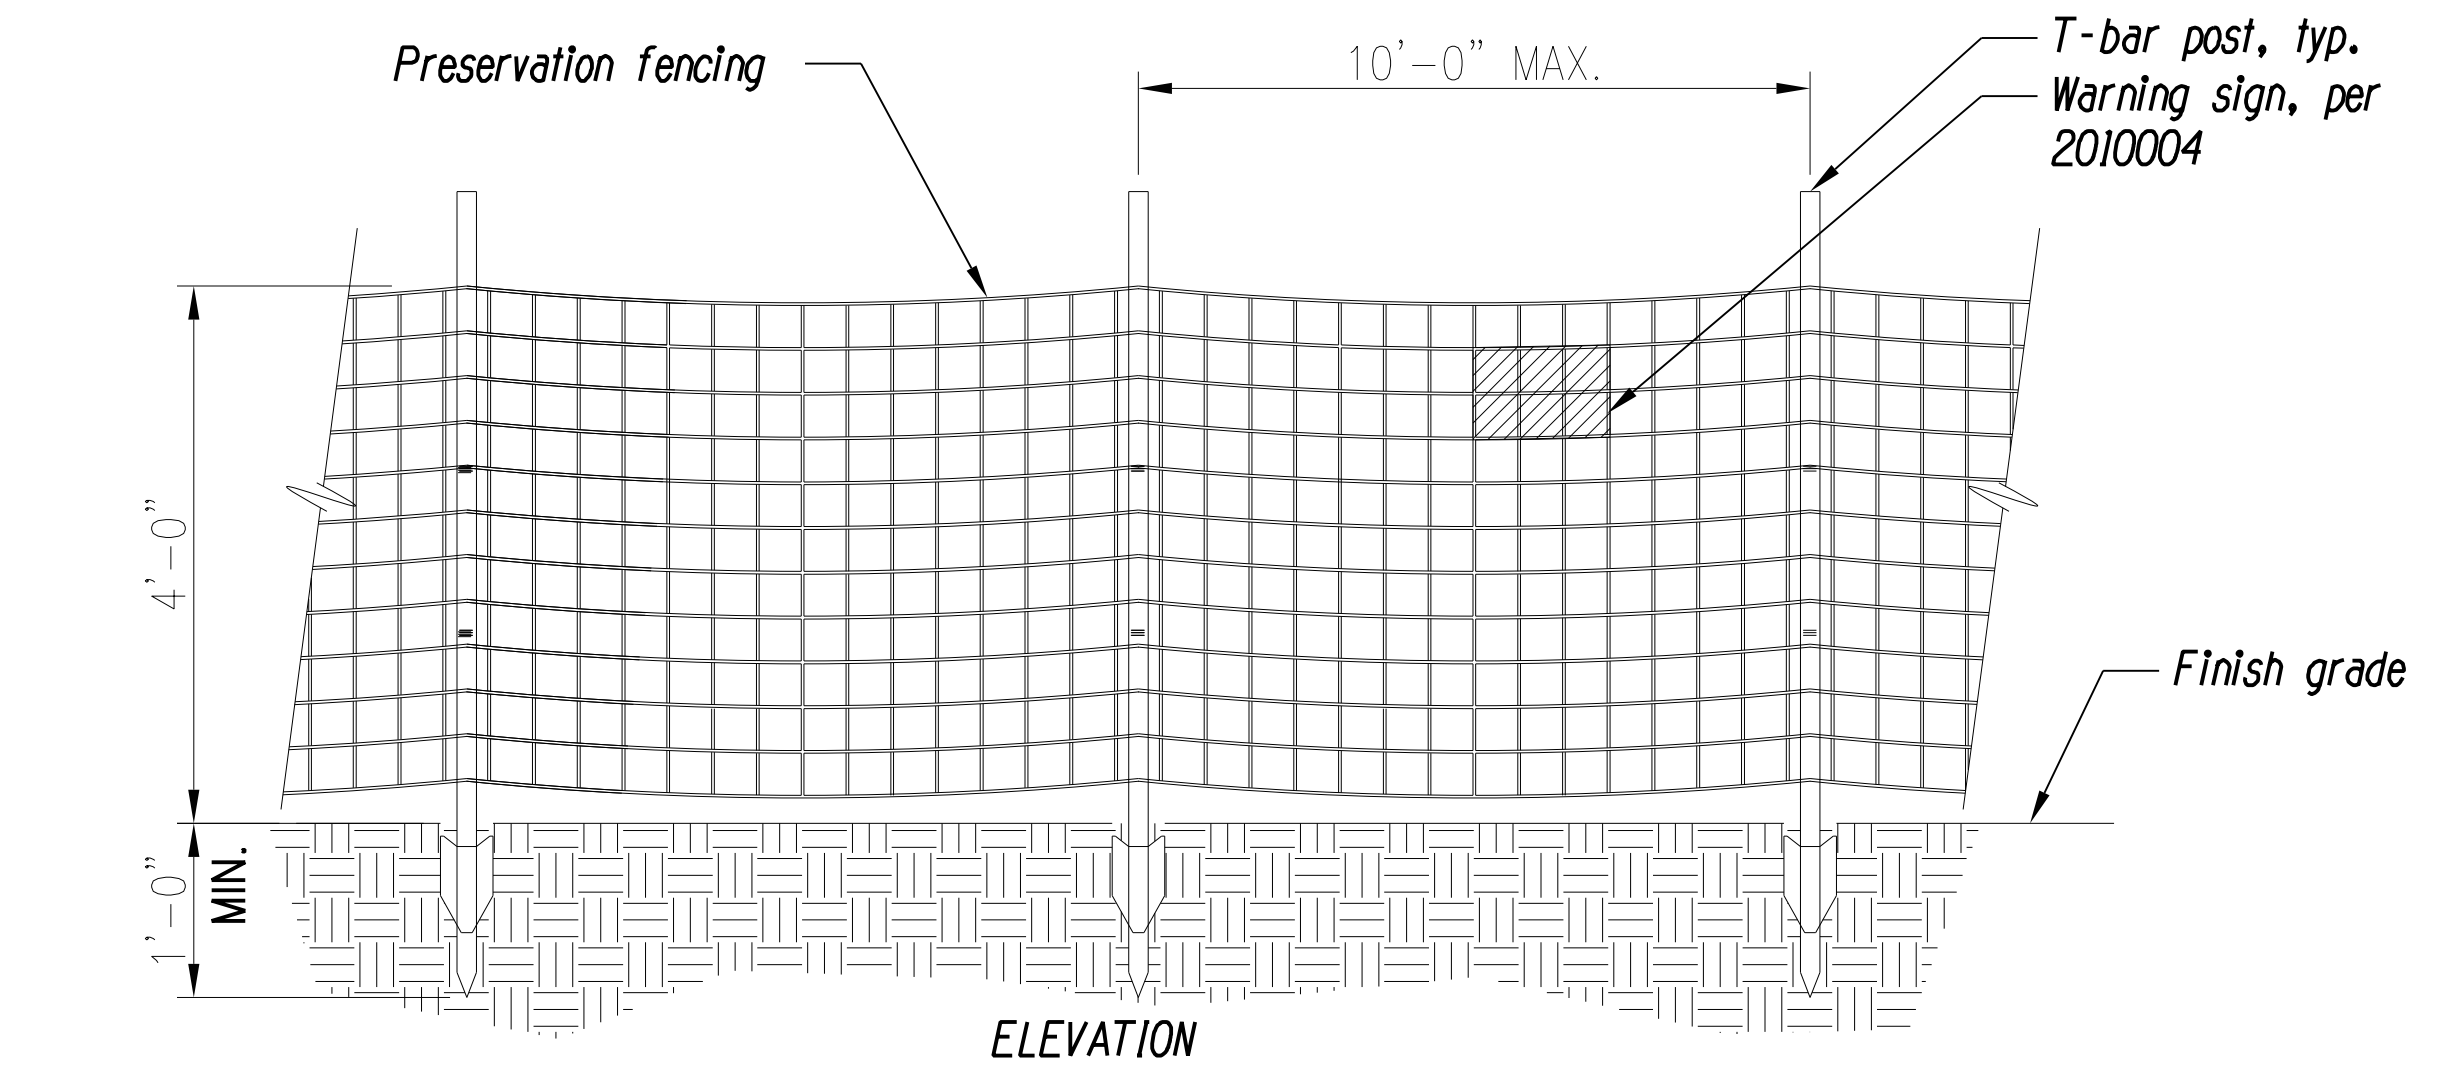

NOTE:  
1. Preservation fencing is Tensar 4' orange mesh fence or approved equal.

## DETAIL P10



PRESERVATION FENCING

DESIGN	WDC	DATE	3/19	ARIZONA DEPARTMENT OF TRANSPORTATION INFRASTRUCTURE DELIVERY AND OPERATIONS DIVISION ROADSIDE DEVELOPMENT SECTION	
DRAWN	WDC	DATE	3/19		
CHECKED	WDC/LEM	DATE	3/19		
<b>WHEAT DESIGN GROUP</b>		LANDSCAPE ARCHITECTS		LANDSCAPE PLAN DETAIL SHEET	
500 N TUCSON BLVD, SUITE 150, TUCSON AZ 85716					
ROUTE	I-10	LOCATION	RUTHRAUFF ROAD TI		
TRACS NO.	H 8480 01C		010-D(213)S		OF



F.H.W.A. REGION	STATE	PROJECT NO.	SHEET NO.	TOTAL SHEETS	RECORD DRAWING
9	ARIZ.	010-D(213)S	764	849	

010 PM 252

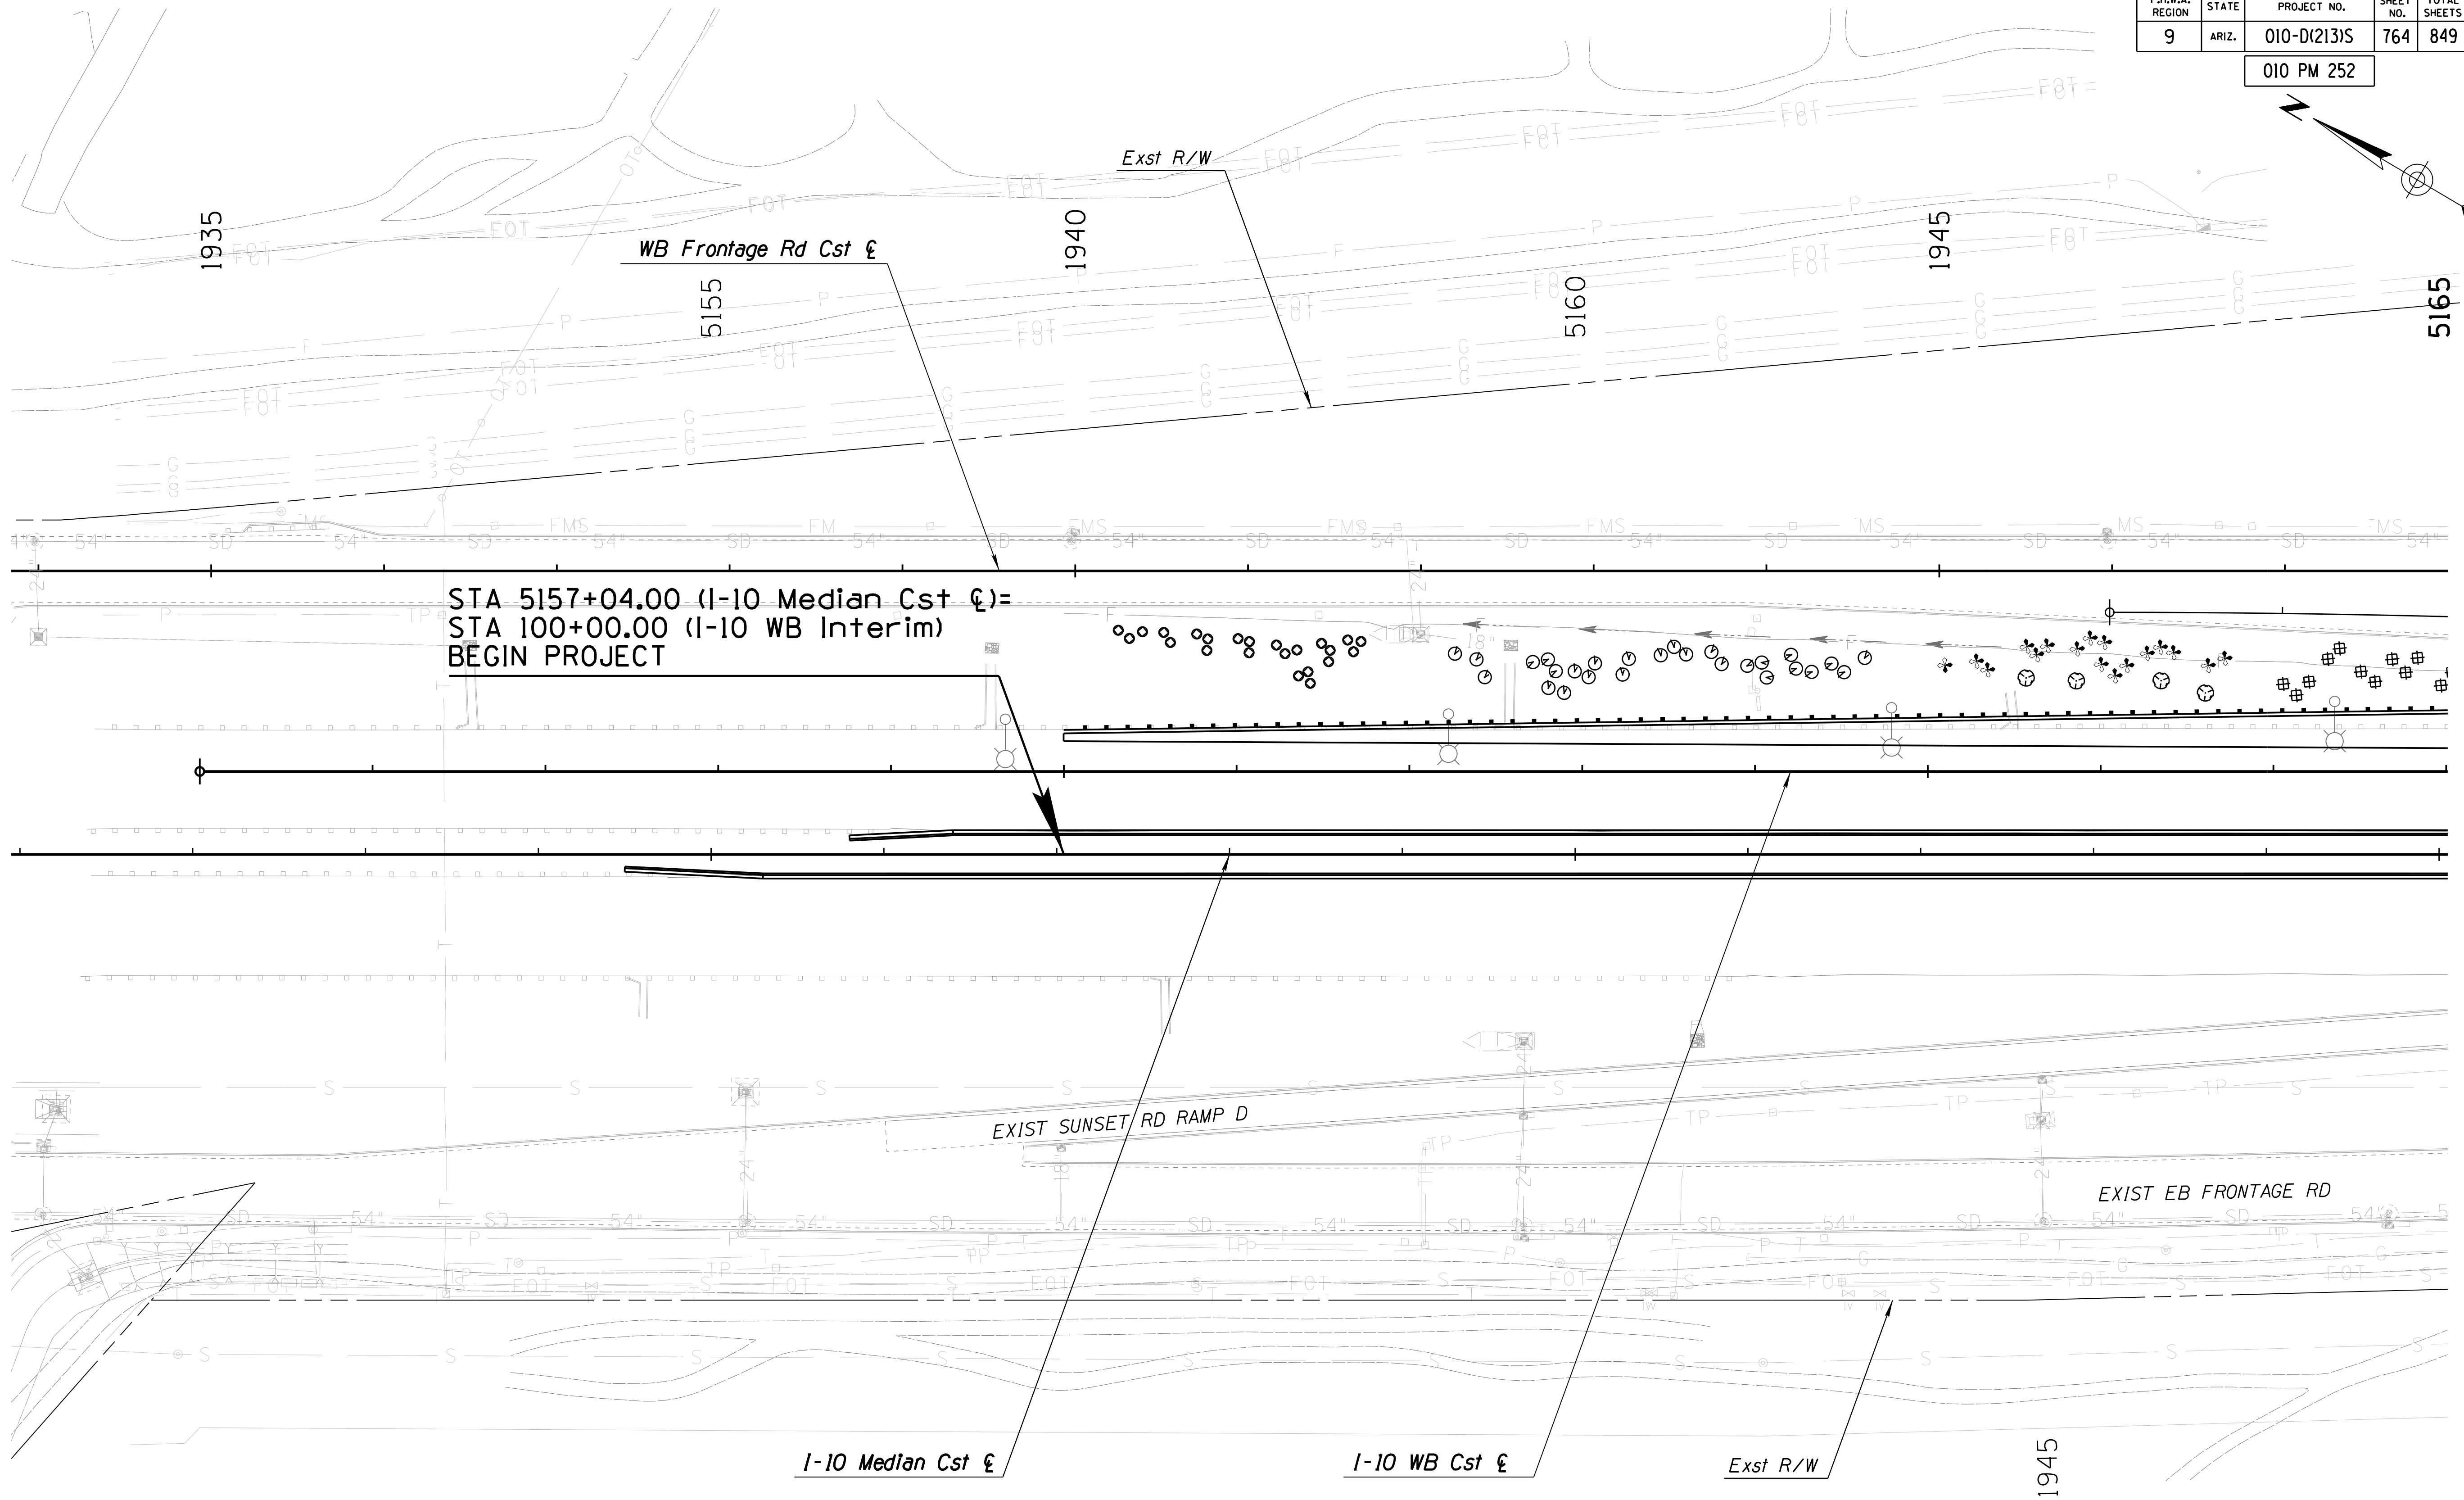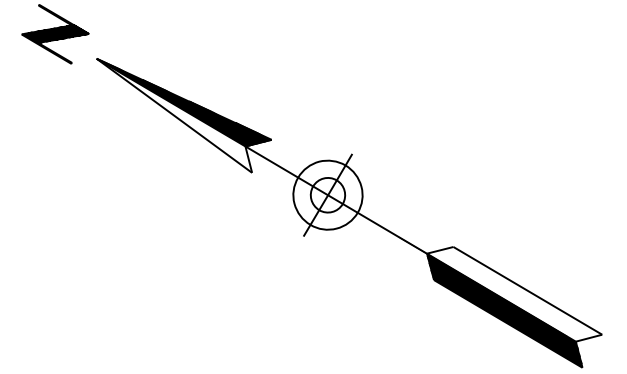

STA 5157+04.00 (I-10 Median Cst &)=  
 STA 100+00.00 (I-10 WB Interim)  
 BEGIN PROJECT



REVISIONS- FINISHED PLANS- SURVEY NO. DATE- LOCATION- DATE- REVISIONS- FINISHED PLANS- SURVEY NO. DATE-

DESIGN	WDC	NAME	DATE	ARIZONA DEPARTMENT OF TRANSPORTATION INFRASTRUCTURE DELIVERY AND OPERATIONS DIVISION ROADSIDE DEVELOPMENT SECTION
DRAWN	WDC		3/19	
CHECKED	WDC/LEM		3/19	
<b>WHEAT DESIGN GROUP</b> LANDSCAPE ARCHITECTS <small>500 N TUCSON BLVD, SUITE 150, TUCSON AZ 85716</small>		<b>LANDSCAPE PLAN</b> <b>I-10 MED CONST &amp;</b> <b>STA 5151+00 TO 5165+00</b>		
ROUTE	I-10	LOCATION	RUTHRAUFF ROAD TI	
TRACS NO. H 8480 OIC		010-D(213)S		EXPIRES 6-30-2019 DWG NO. R-3.01 OF



F.H.W.A. REGION	STATE	PROJECT NO.	SHEET NO.	TOTAL SHEETS	RECORD DRAWING
9	ARIZ.	010-D(213)S	766	849	

010 PM 252

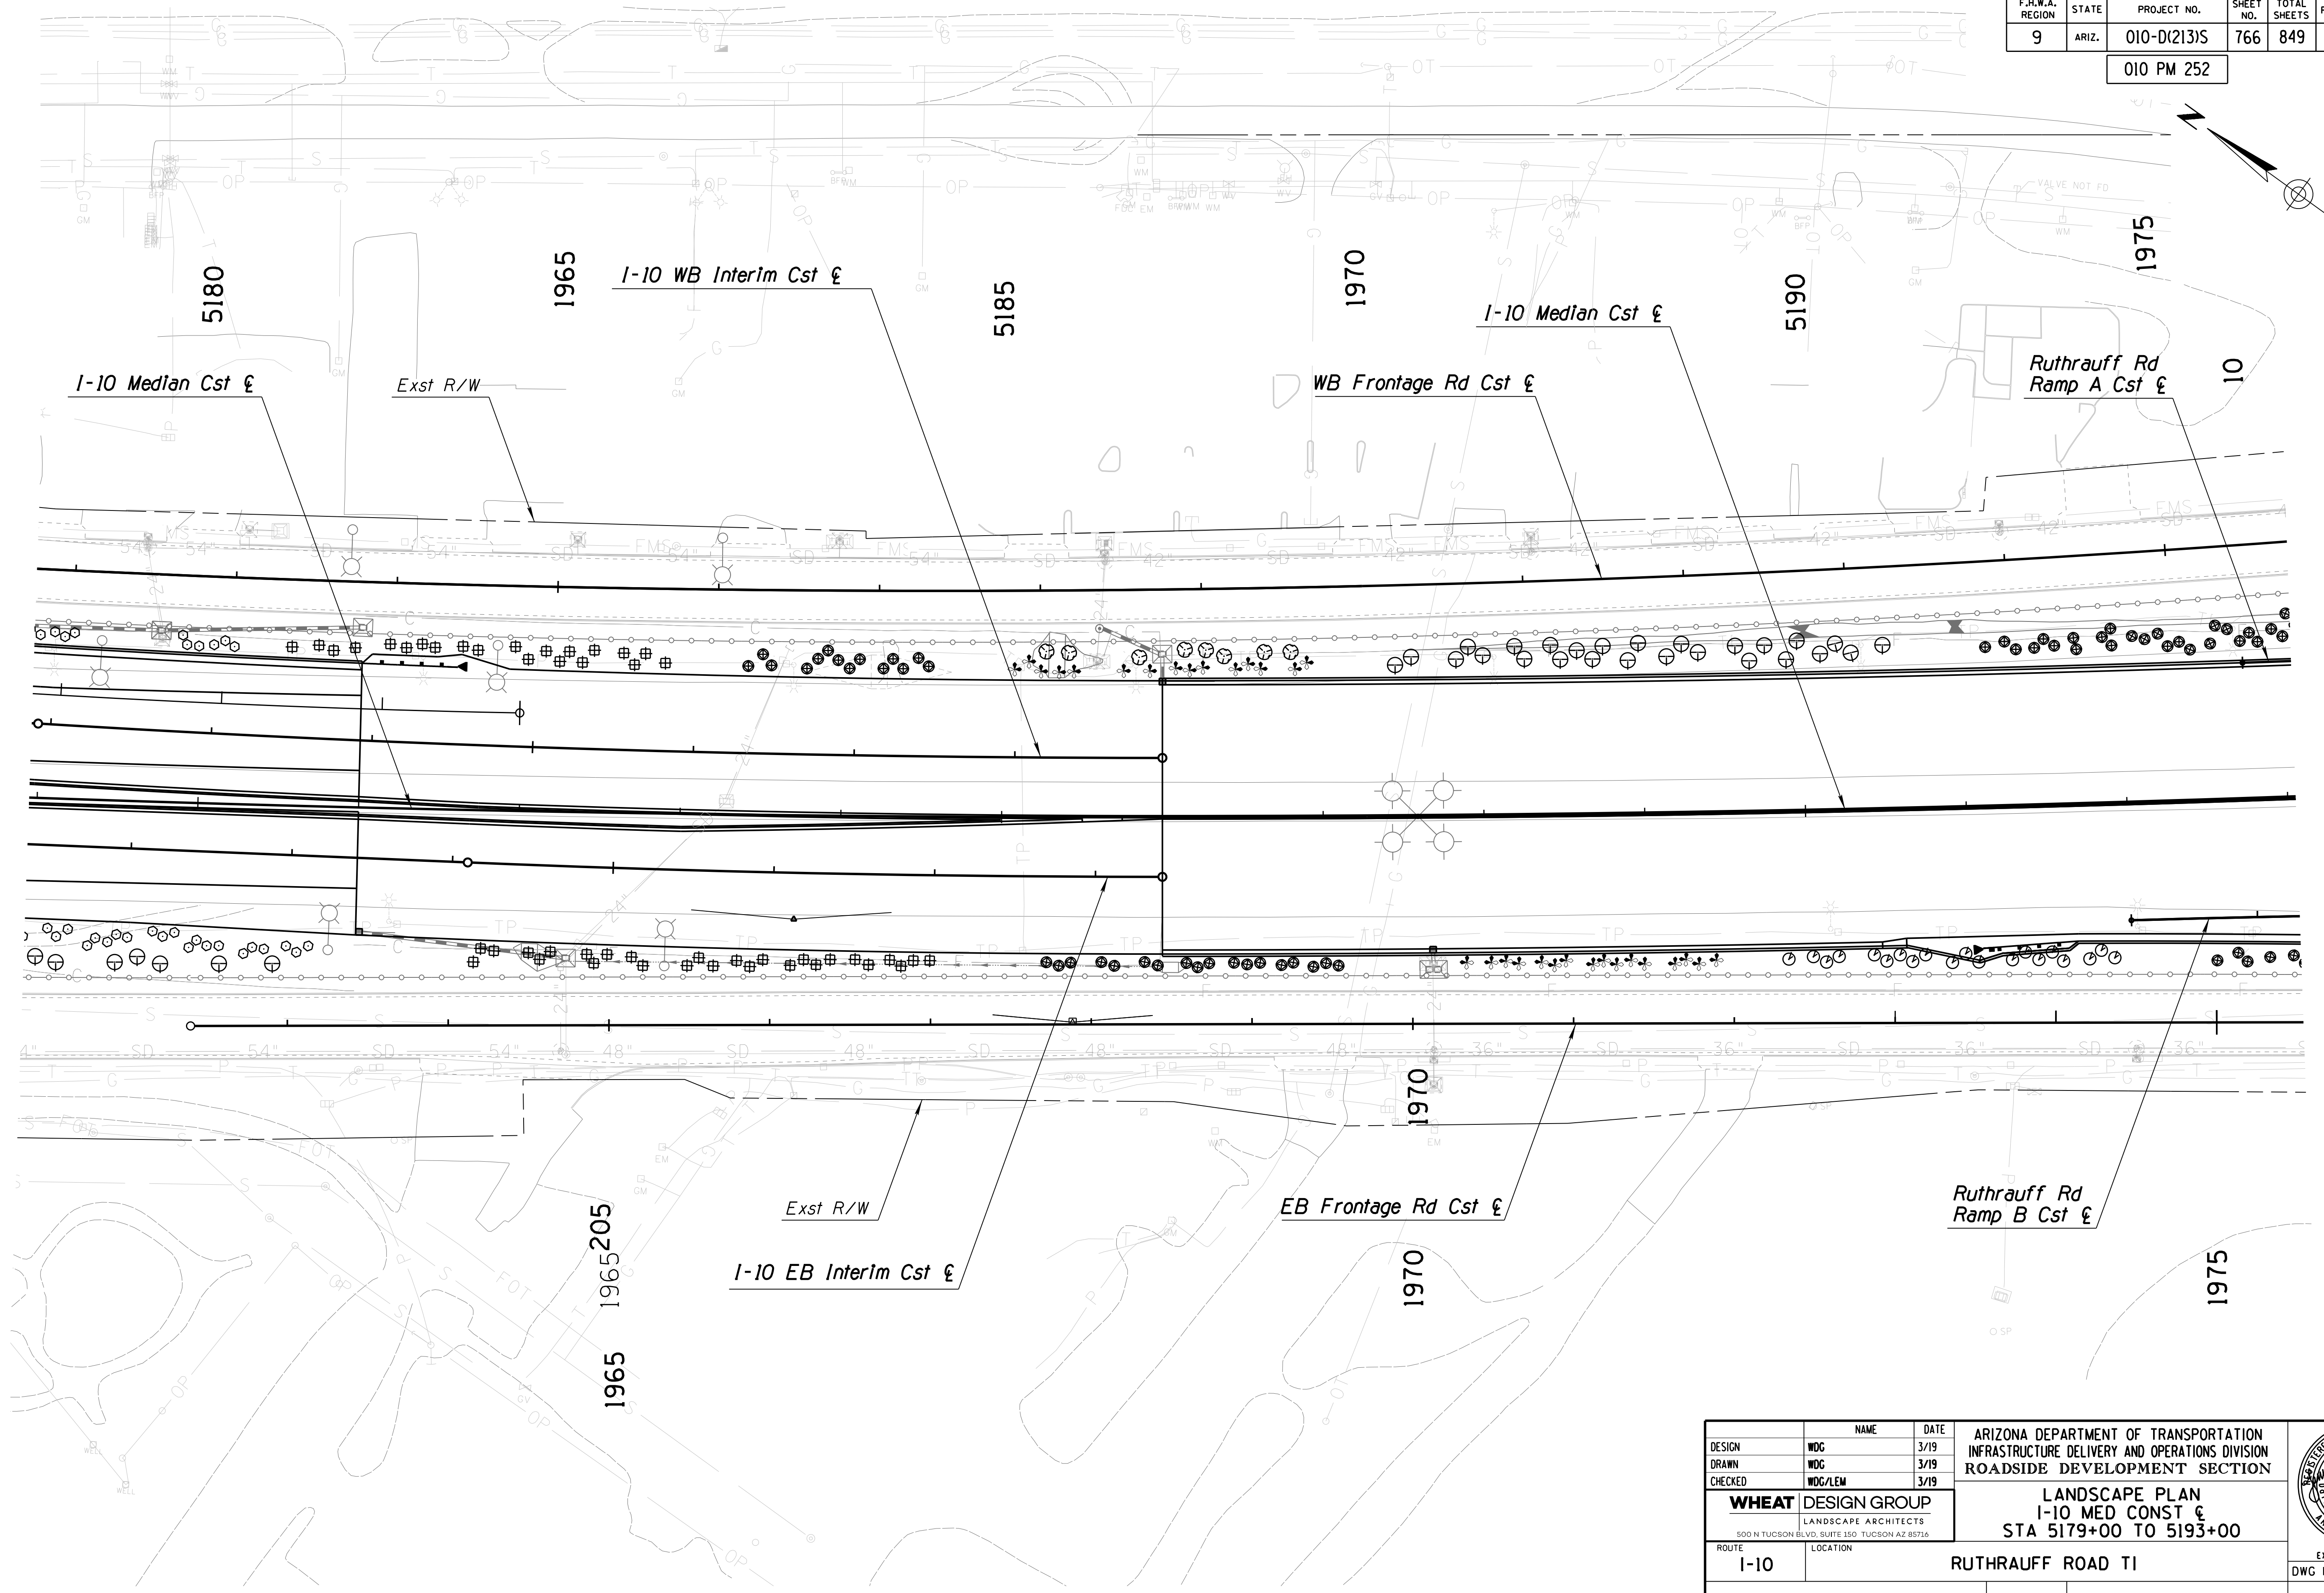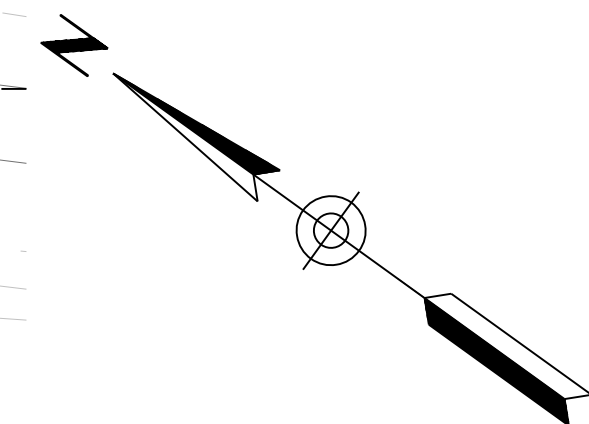



SURVEY NO. FINISHED PLANS DATE LOCATION REVISIONS FINISHED PLANS DATE SURVEY NO. REVISIONS FINISHED PLANS DATE

DESIGN	WDC	NAME	DATE	ARIZONA DEPARTMENT OF TRANSPORTATION INFRASTRUCTURE DELIVERY AND OPERATIONS DIVISION ROADSIDE DEVELOPMENT SECTION  <b>LANDSCAPE PLAN</b> <b>I-10 MED CONST</b> <b>STA 5179+00 TO 5193+00</b>	
DRAWN	WDC	3/19			
CHECKED	WDC/LEM	3/19			
<b>WHEAT DESIGN GROUP</b> LANDSCAPE ARCHITECTS <small>500 N TUCSON BLVD, SUITE 150, TUCSON AZ 85716</small>		ROUTE: I-10      LOCATION: RUTHRAUFF ROAD TI		EXPIRES 6-30-2019 DWG NO. R-3.03	
TRACS NO. H 8480 OIC		010-D(213)S		OF	



F.H.W.A. REGION	STATE	PROJECT NO.	SHEET NO.	TOTAL SHEETS	RECORD DRAWING
9	ARIZ.	010-D(213)S	767	849	

010 PM 252

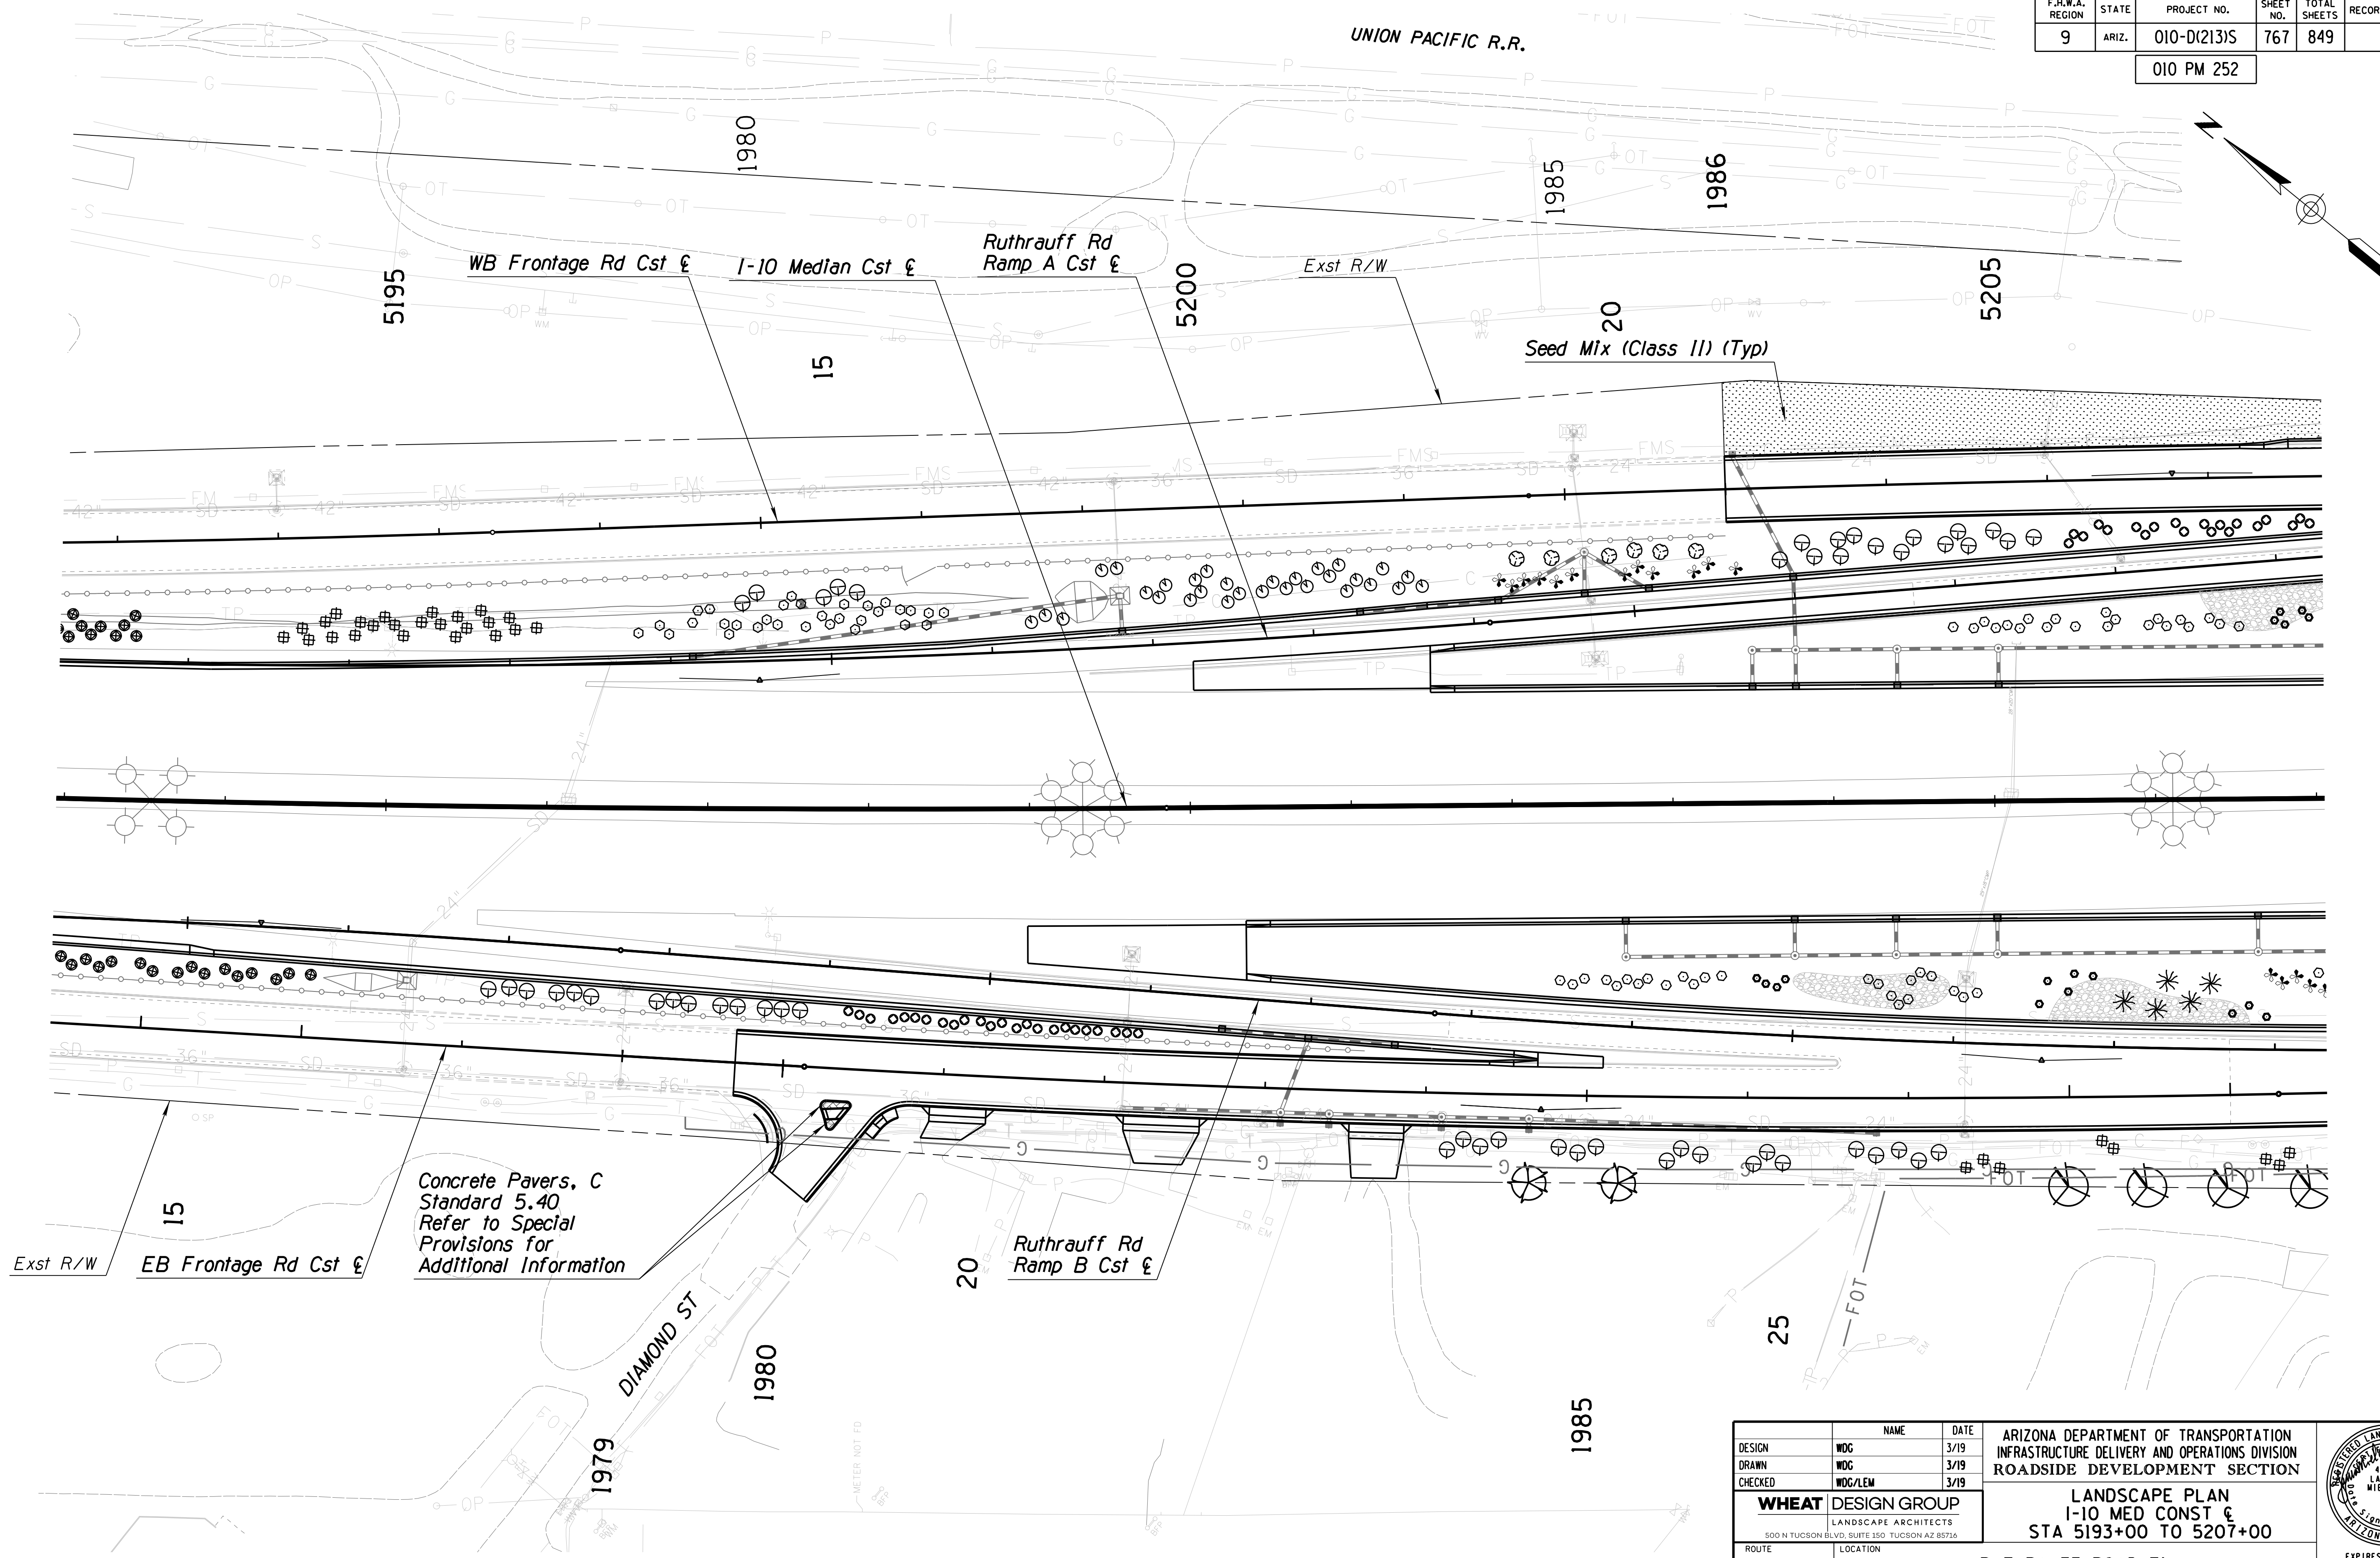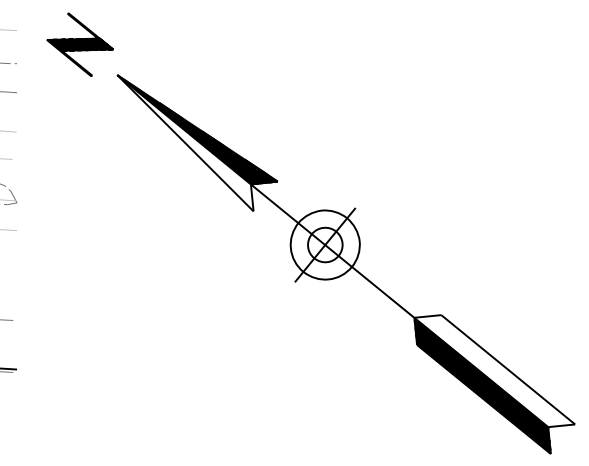


Concrete Pavers, C  
Standard 5.40  
Refer to Special  
Provisions for  
Additional Information

DESIGN	NAME	DATE
WDC		3/19
DRAWN		
WDC		3/19
CHECKED		
WDC/LEM		3/19

ARIZONA DEPARTMENT OF TRANSPORTATION  
INFRASTRUCTURE DELIVERY AND OPERATIONS DIVISION  
ROADSIDE DEVELOPMENT SECTION

**LANDSCAPE PLAN**  
I-10 MED CONST &  
STA 5193+00 TO 5207+00

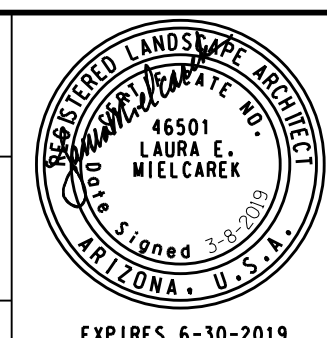


ROUTE	LOCATION	EXPIRES 6-30-2019
I-10	RUTHRAUFF ROAD TI	DWG NO. R-3.04
TRACS NO. H 8480 OIC	010-D(213)S	OF

DATE- LOCATION- REVISIONS- FINISHED PLANS- SURVEY NO. DATE- LOCATION- REVISIONS- FINISHED PLANS- SURVEY NO.



F.H.W.A. REGION	STATE	PROJECT NO.	SHEET NO.	TOTAL SHEETS	RECORD DRAWING
9	ARIZ.	010-D(213)S	768	849	

010 PM 252

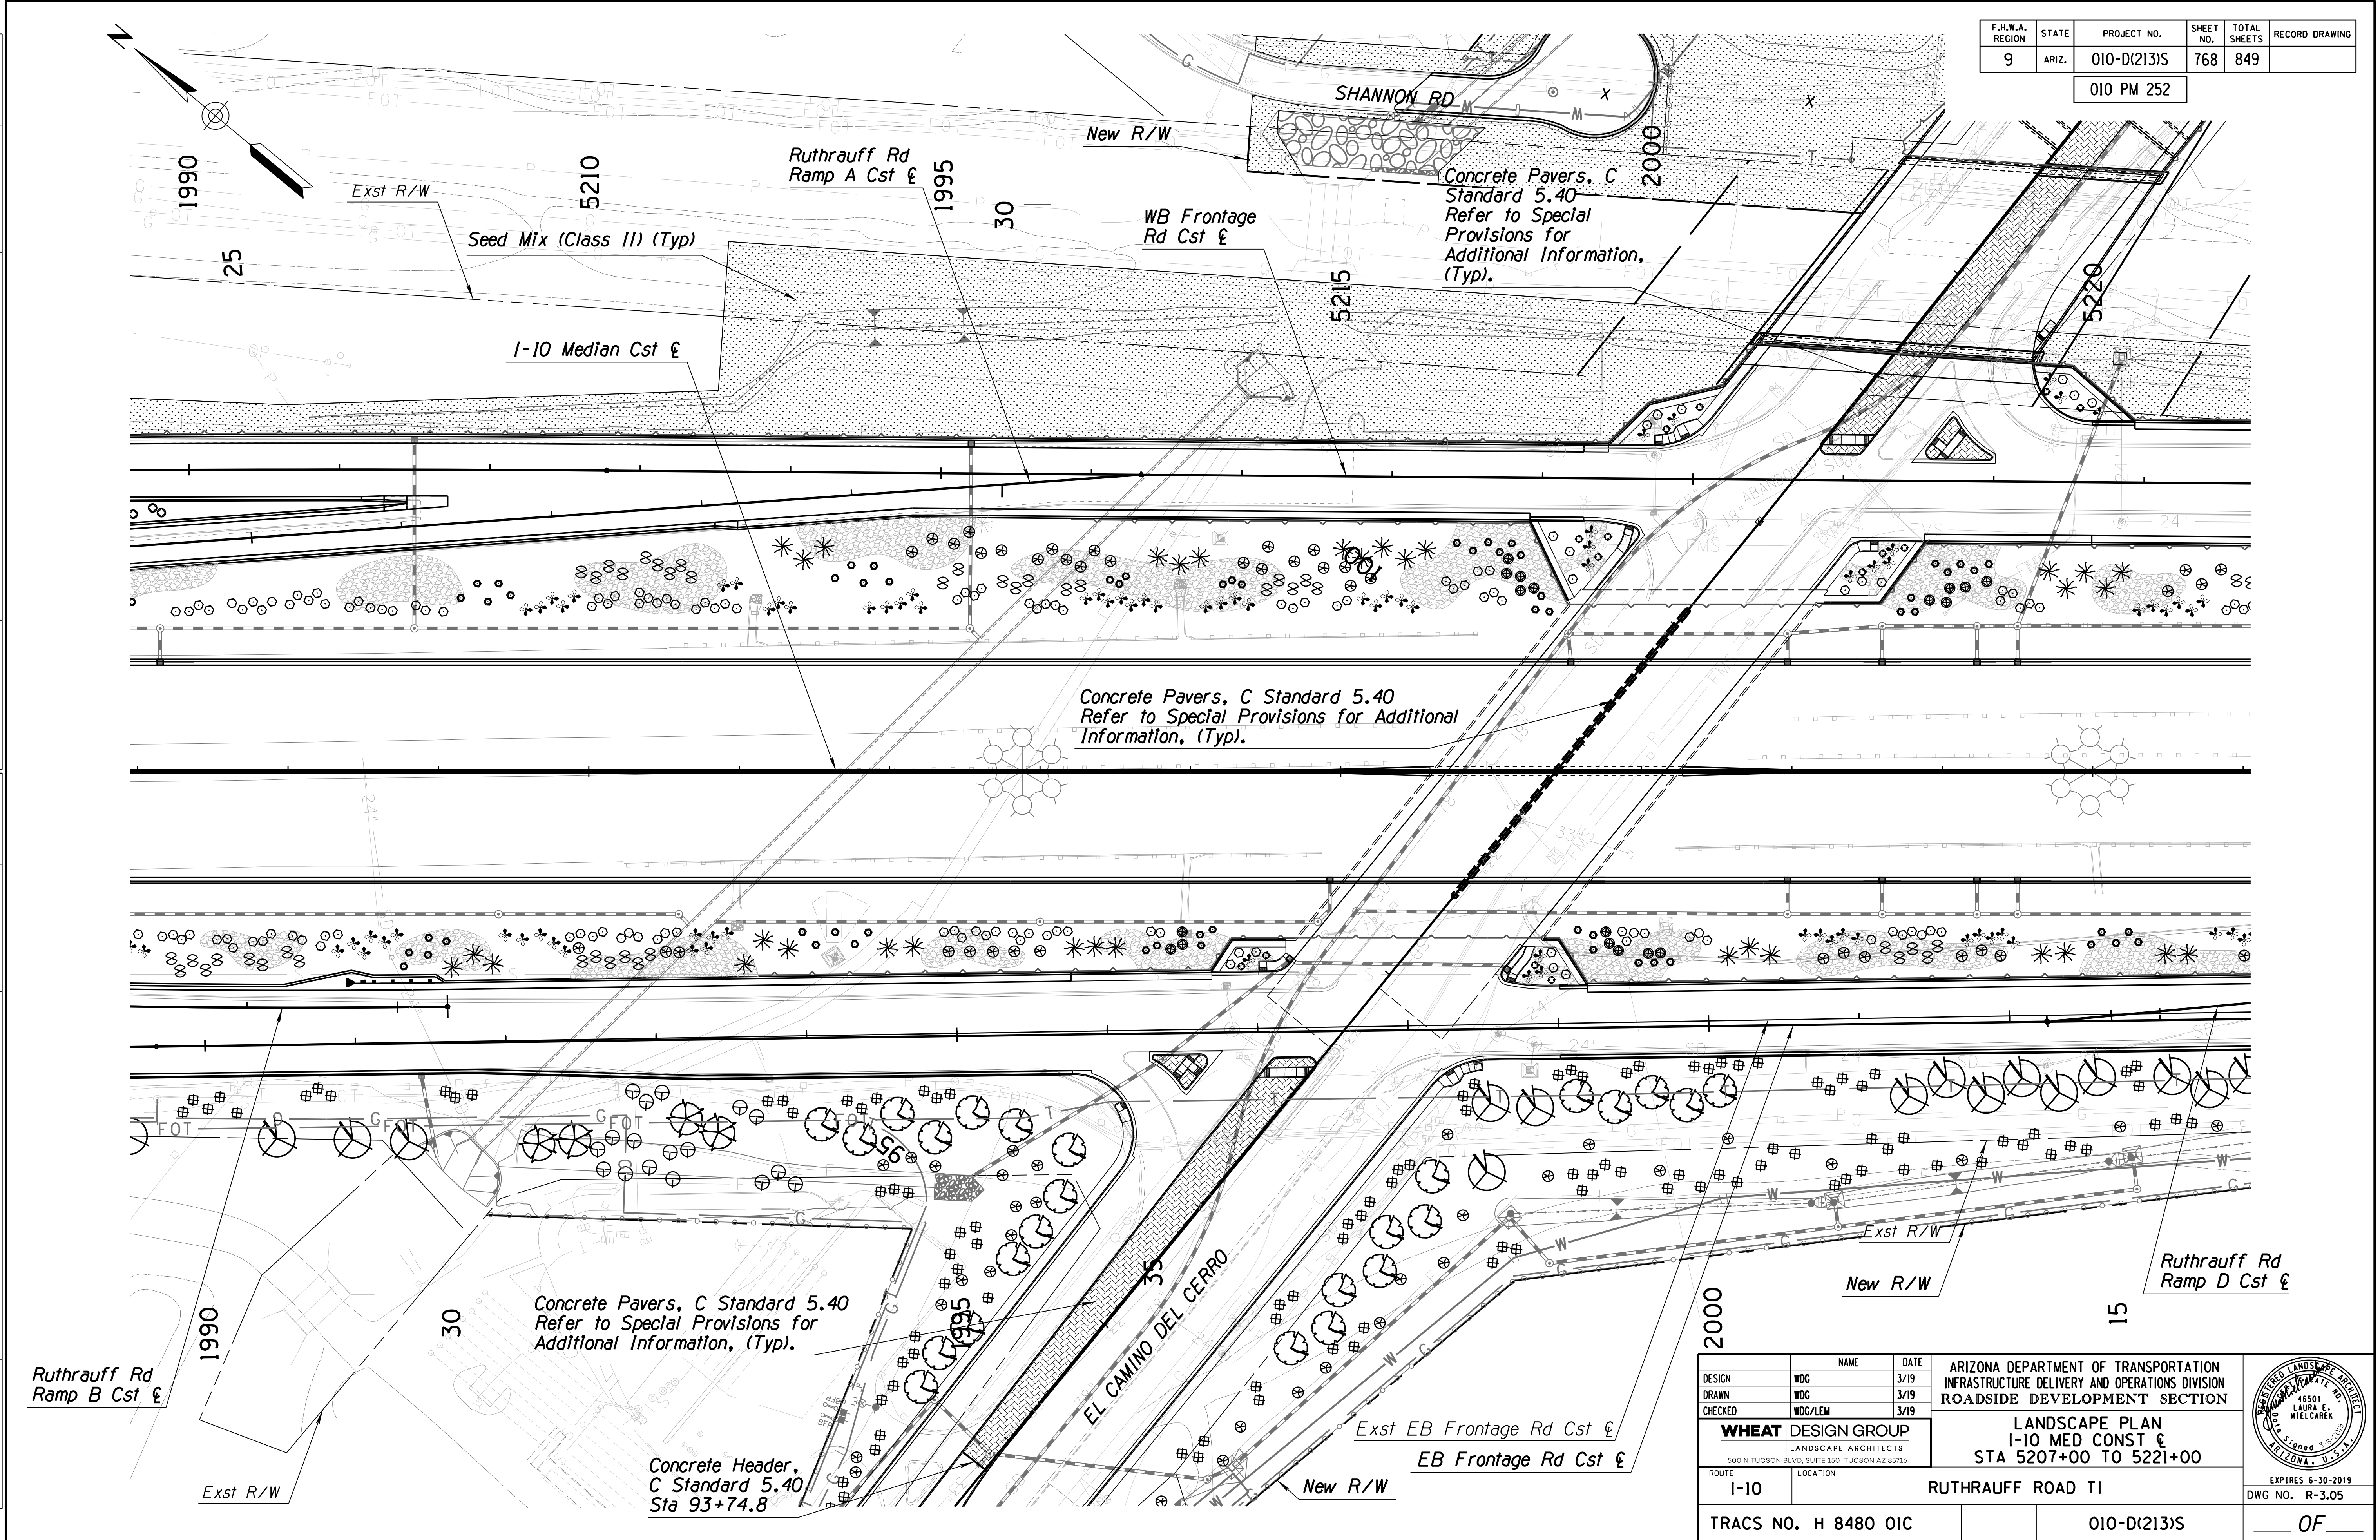

Seed Mix (Class II) (Typ)

I-10 Median Cst €

Ruthrauff Rd Ramp A Cst €

WB Frontage Rd Cst €

Concrete Pavers, C Standard 5.40 Refer to Special Provisions for Additional Information, (Typ).

Concrete Pavers, C Standard 5.40 Refer to Special Provisions for Additional Information, (Typ).

Concrete Pavers, C Standard 5.40 Refer to Special Provisions for Additional Information, (Typ).

Concrete Header, C Standard 5.40 Sta 93+74.8

Ruthrauff Rd Ramp B Cst €

Ruthrauff Rd Ramp D Cst €

Exst EB Frontage Rd Cst € EB Frontage Rd Cst €

DESIGN	WDC	NAME	DATE
DRAWN	WDC		3/19
CHECKED	WDC/LEM		3/19

ARIZONA DEPARTMENT OF TRANSPORTATION  
INFRASTRUCTURE DELIVERY AND OPERATIONS DIVISION  
ROADSIDE DEVELOPMENT SECTION

**WHEAT DESIGN GROUP**  
LANDSCAPE ARCHITECTS  
500 N TUCSON BLVD, SUITE 150, TUCSON AZ 85716

LANDSCAPE PLAN  
I-10 MED CONST €  
STA 5207+00 TO 5221+00



ROUTE I-10 LOCATION RUTHRAUFF ROAD TI

EXPIRES 6-30-2019  
DWG NO. R-3.05

TRACS NO. H 8480 OIC 010-D(213)S OF

ccccSYTIMEcccc



ccccDGNcSPECIFICATIONcccc

DATE- LOCATION- REVISIONS- FINISHED PLANS- SURVEY NO. DATE- LOCATION- REVISIONS- FINISHED PLANS- SURVEY NO.



F.H.W.A. REGION	STATE	PROJECT NO.	SHEET NO.	TOTAL SHEETS	RECORD DRAWING
9	ARIZ.	010-D(213)S	769	849	

010 PM 252

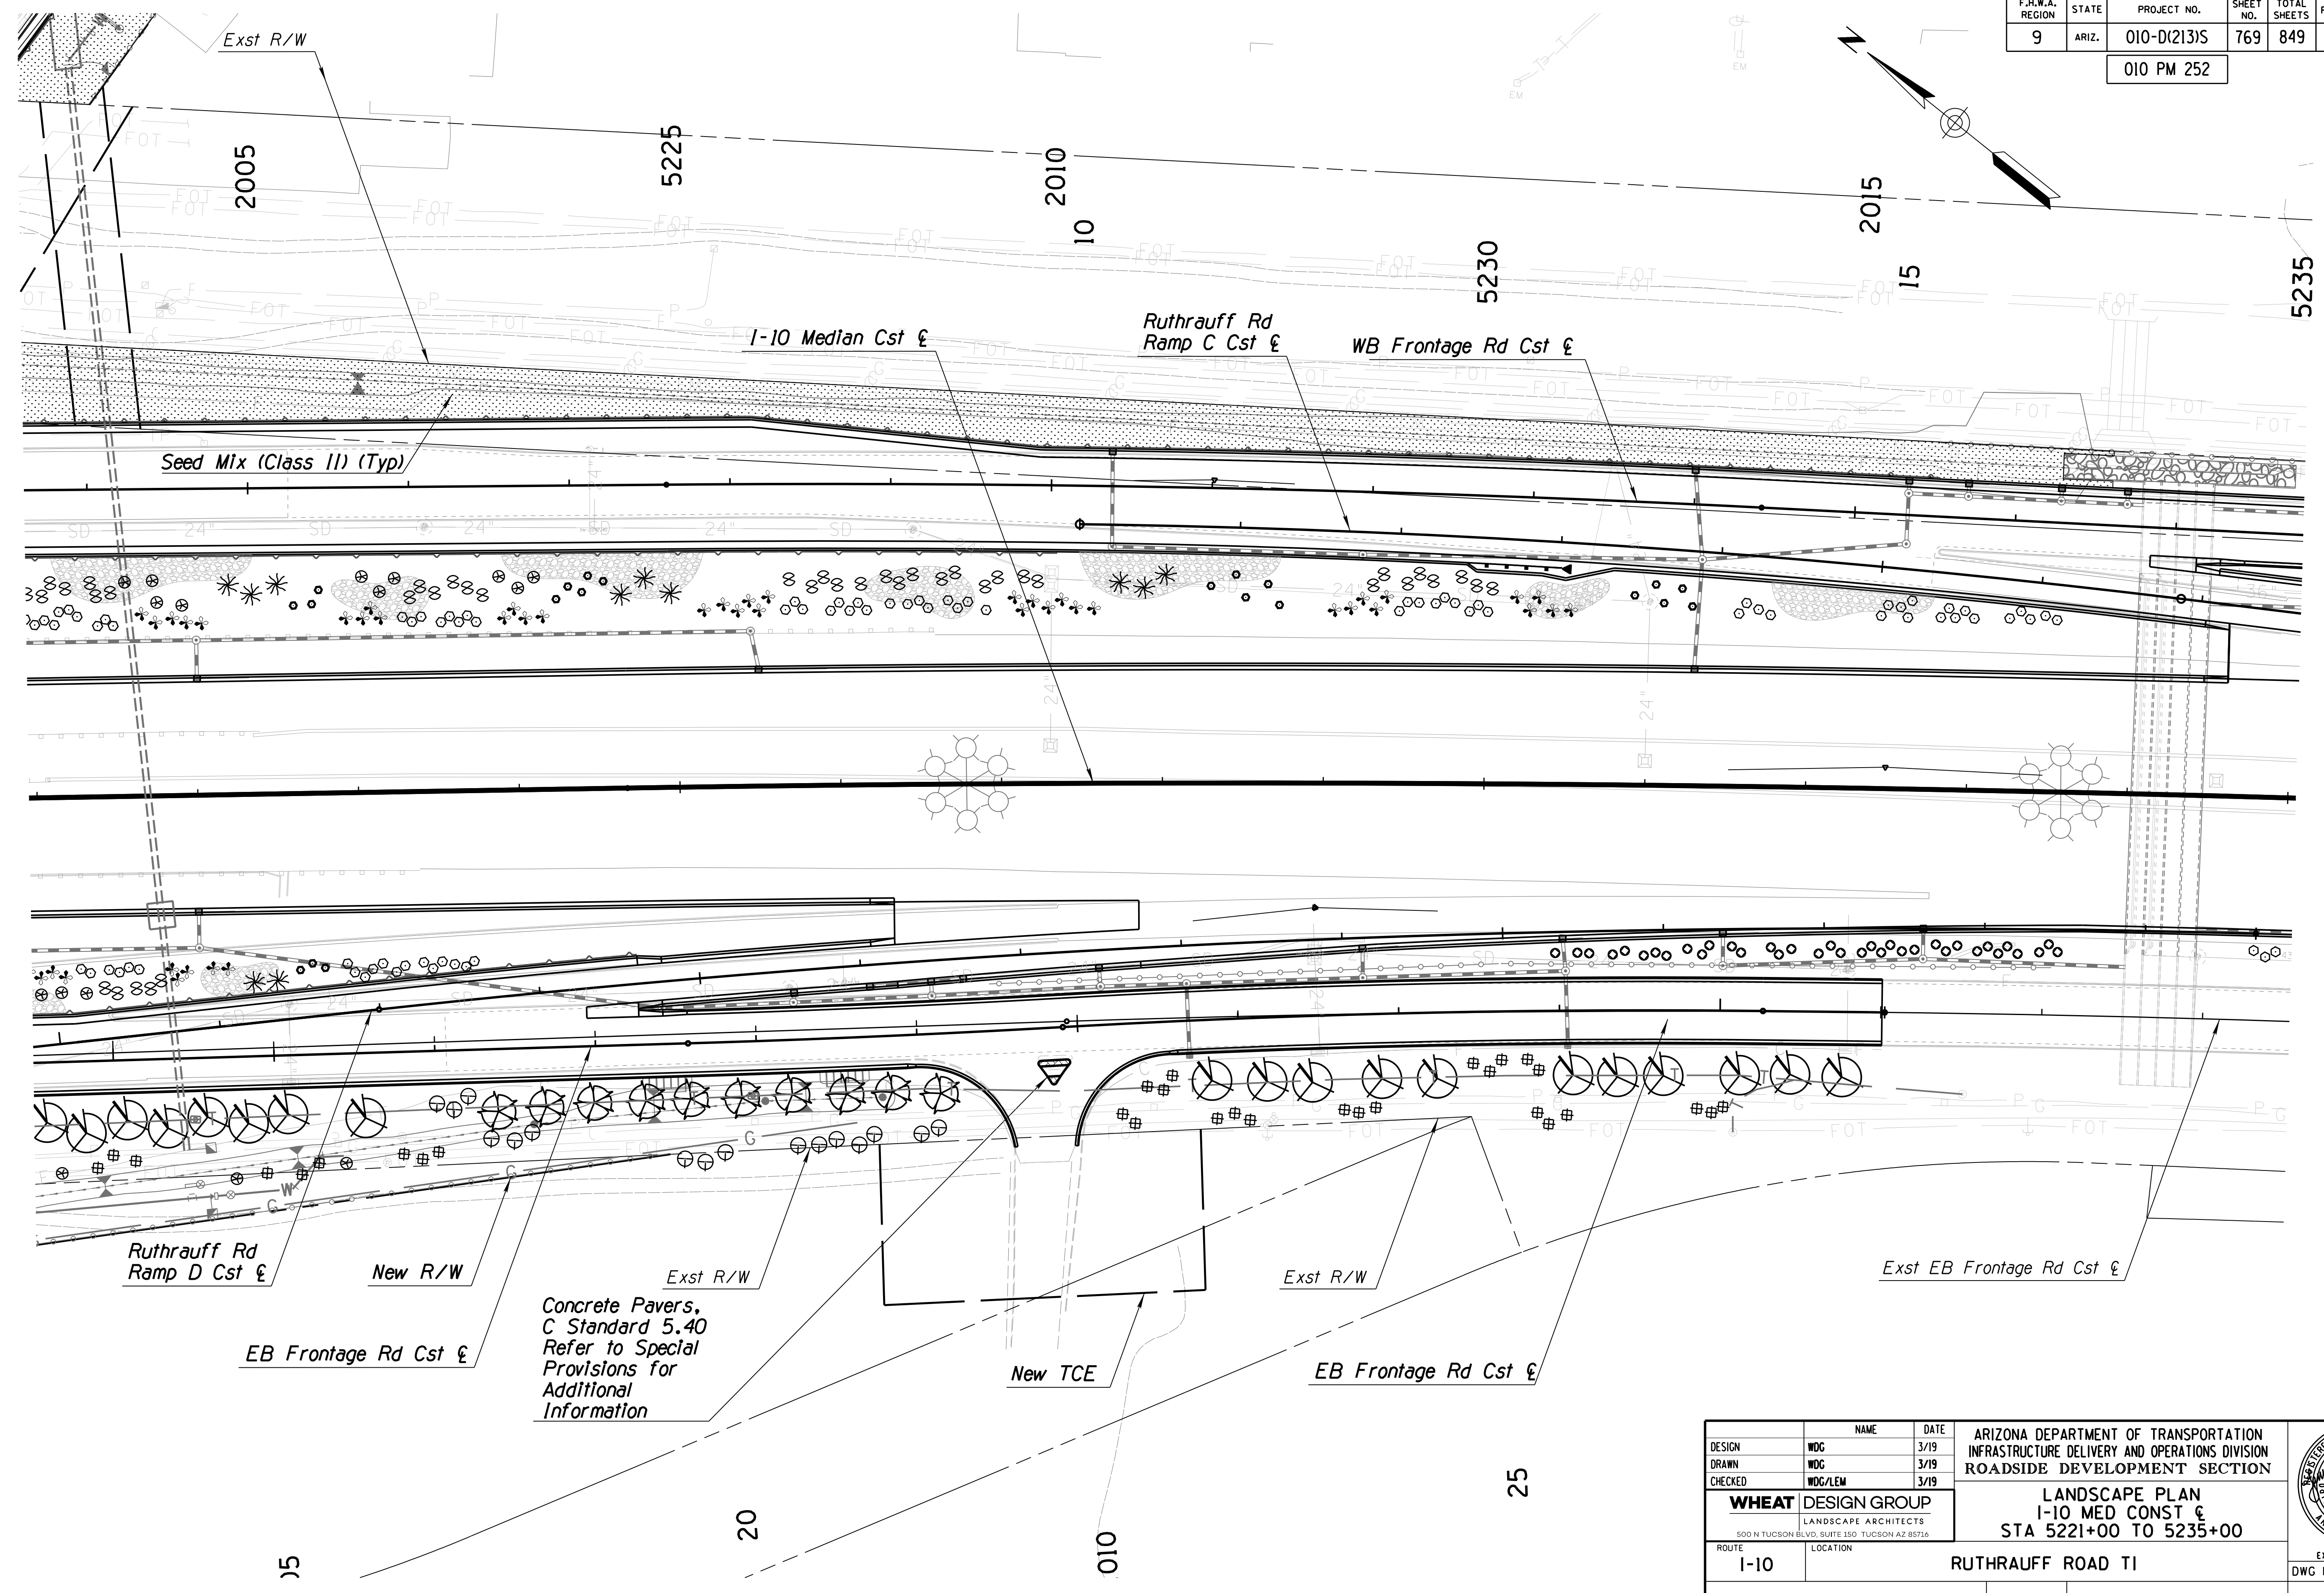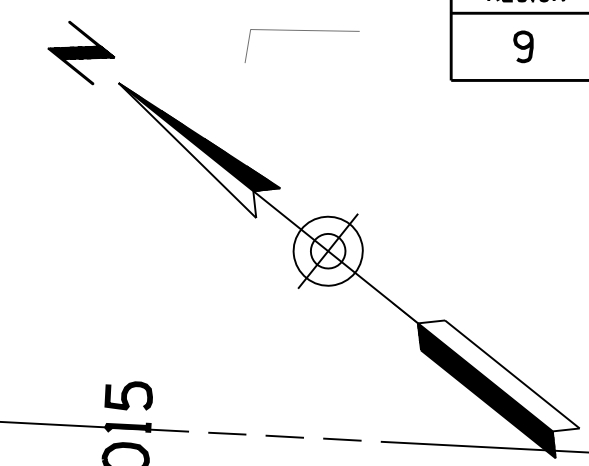



SURVEY NO. FINISHED PLANS DATE LOCATION REVISIONS FINISHED PLANS DATE LOCATION REVISIONS FINISHED PLANS DATE SURVEY NO.

DESIGN	WDC	NAME	DATE	ARIZONA DEPARTMENT OF TRANSPORTATION INFRASTRUCTURE DELIVERY AND OPERATIONS DIVISION ROADSIDE DEVELOPMENT SECTION  <b>LANDSCAPE PLAN</b> <b>I-10 MED CONST €</b> <b>STA 5221+00 TO 5235+00</b>	
DRAWN	WDC	3/19			
CHECKED	WDC/LEM	3/19			
<b>WHEAT DESIGN GROUP</b> LANDSCAPE ARCHITECTS <small>500 N TUCSON BLVD, SUITE 150, TUCSON AZ 85716</small>		ROUTE: I-10      LOCATION: RUTHRAUFF ROAD TI		EXPIRES 6-30-2019 DWG NO. R-3.06	
TRACS NO. H 8480 OIC			010-D(213)S		OF



F.H.W.A. REGION	STATE	PROJECT NO.	SHEET NO.	TOTAL SHEETS	RECORD DRAWING
9	ARIZ.	010-D(213)S	770	849	

010 PM 252

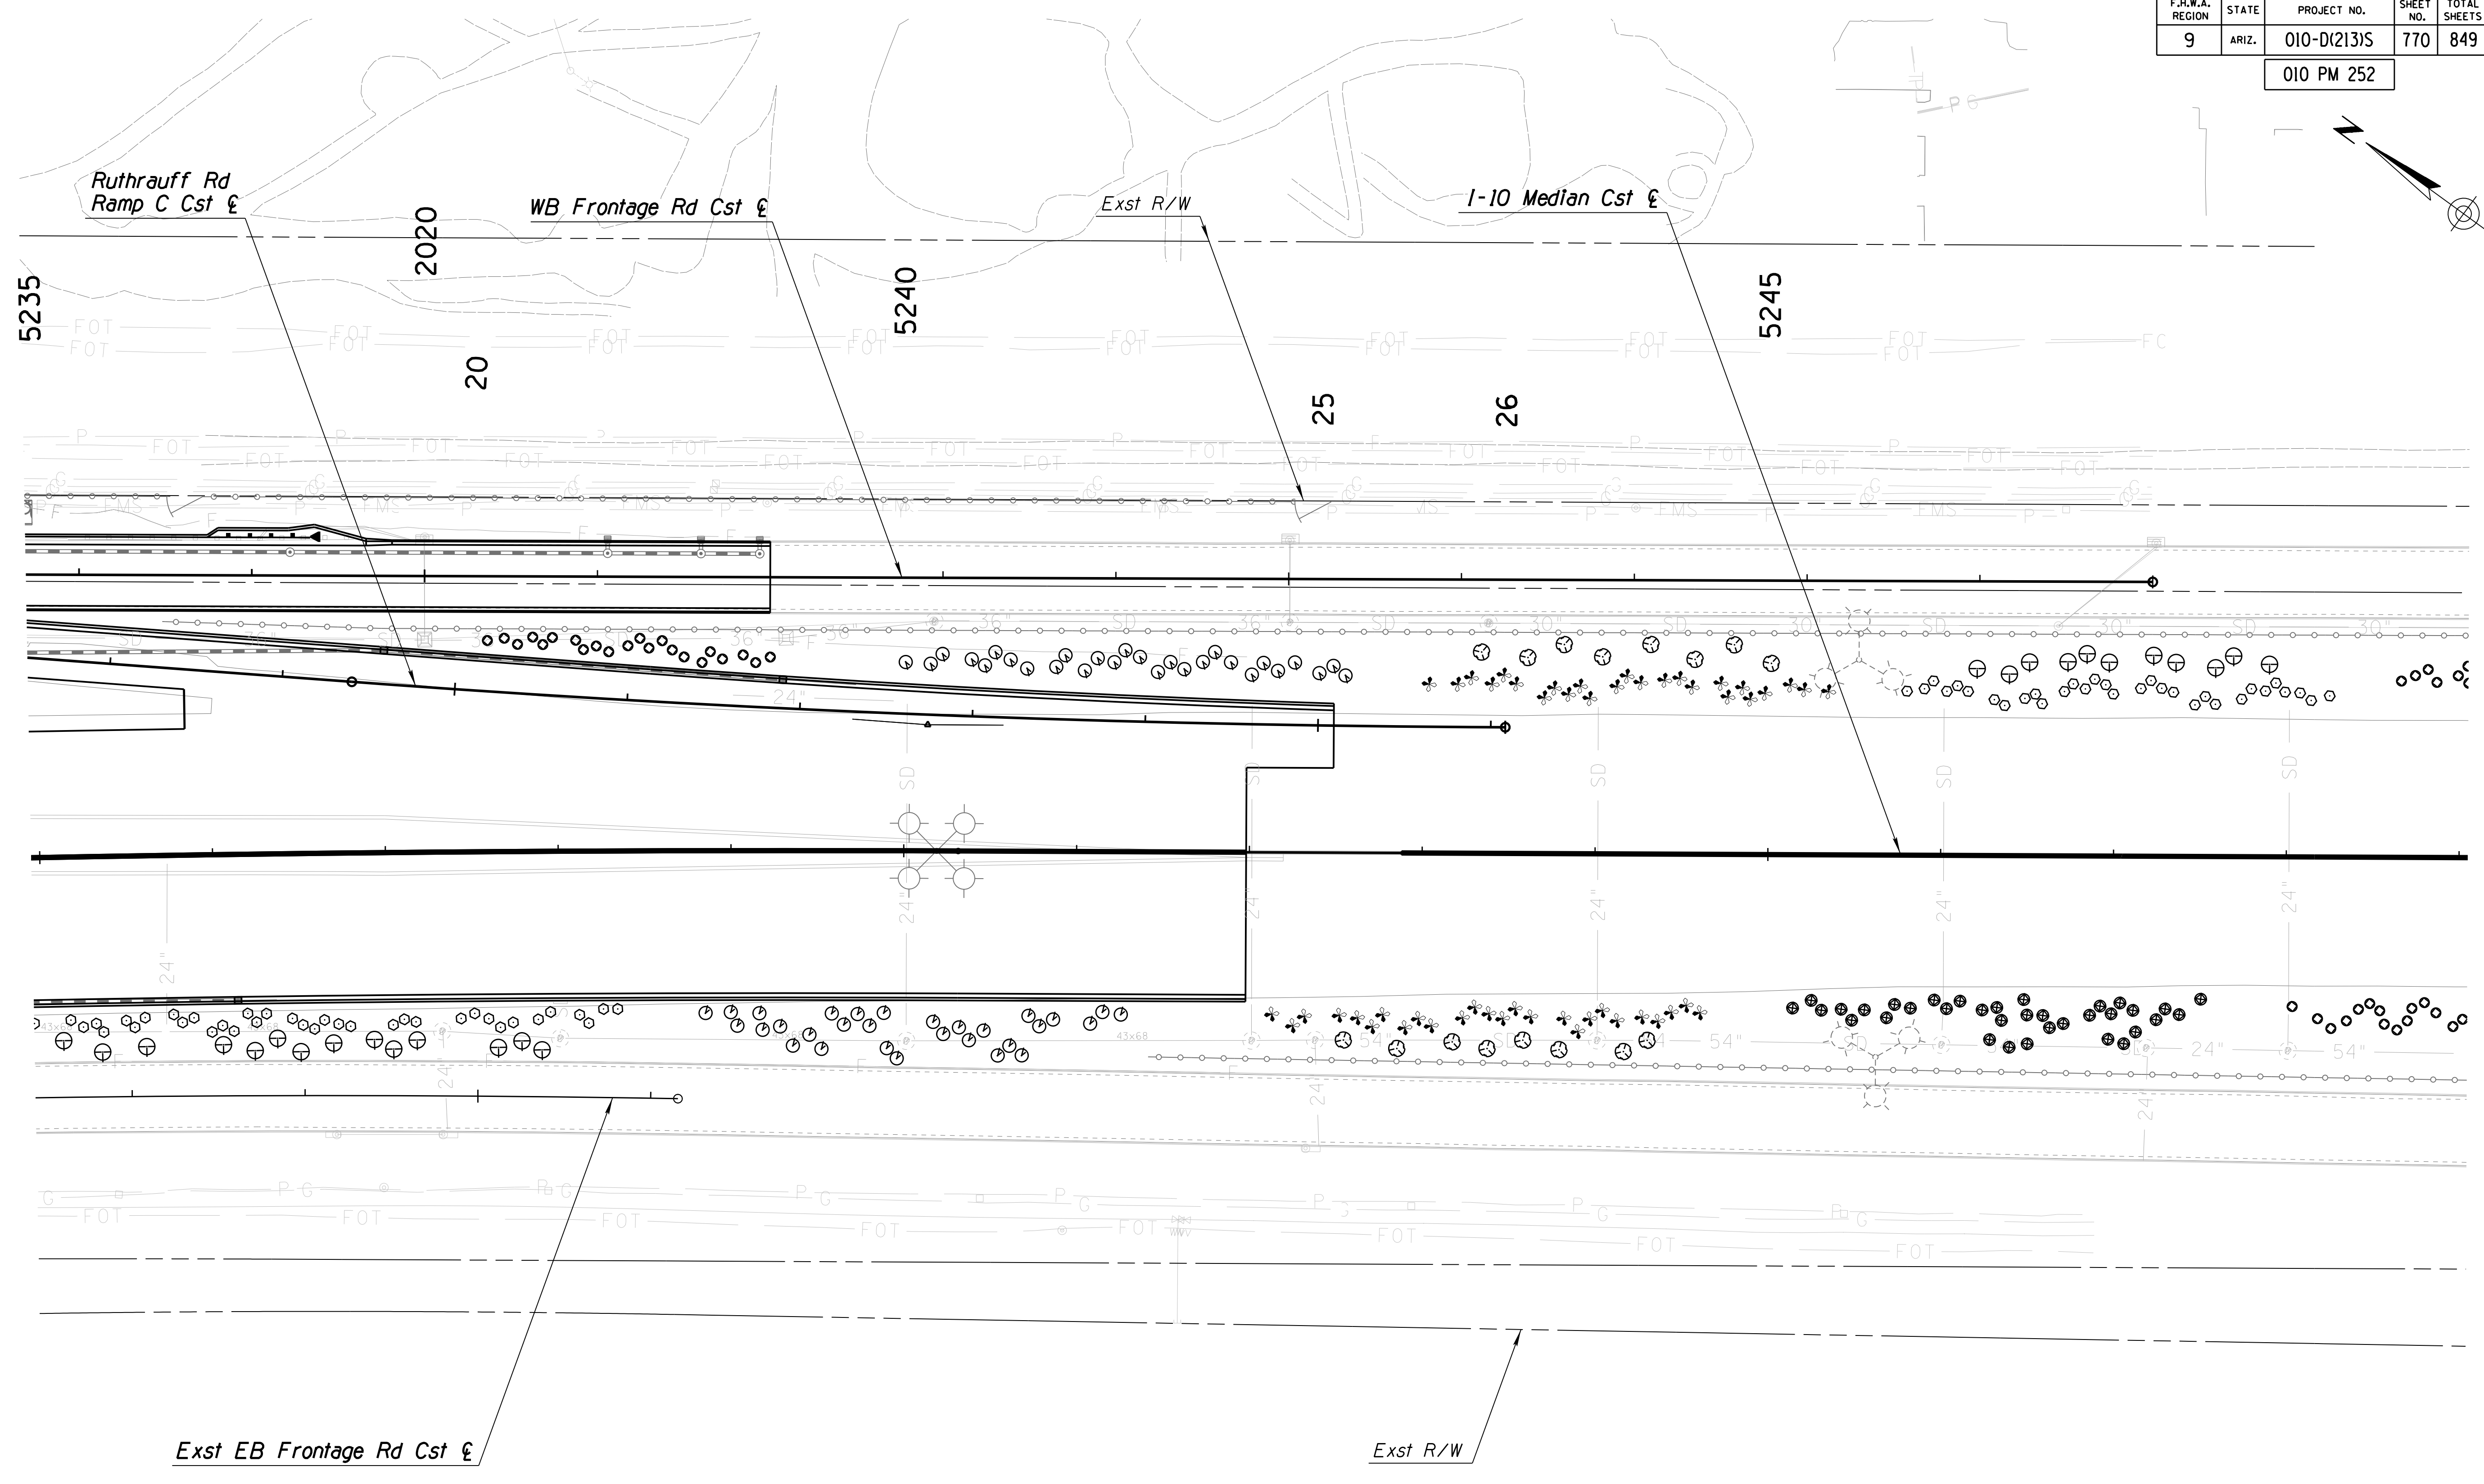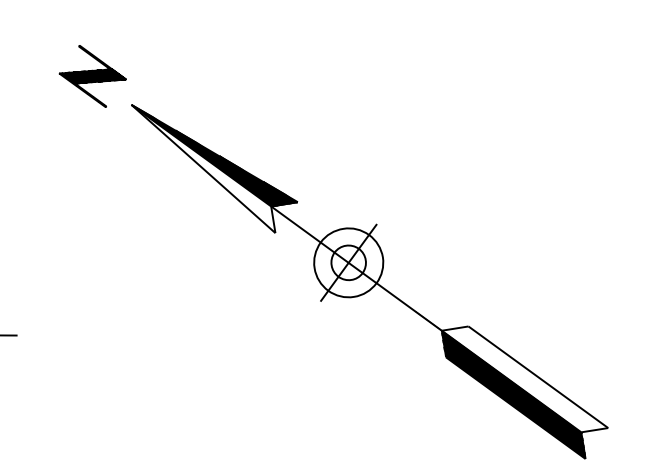

SURVEY NO. FINISHED PLANS DATE LOCATION REVISIONS FINISHED PLANS SURVEY NO. DATE LOCATION REVISIONS FINISHED PLANS DATE SURVEY NO.


ccccSYTIMEcccc      ccccDGNcSPECIFICATIONcccc

DESIGN	WDC	3/19	ARIZONA DEPARTMENT OF TRANSPORTATION INFRASTRUCTURE DELIVERY AND OPERATIONS DIVISION ROADSIDE DEVELOPMENT SECTION		
DRAWN	WDC	3/19			
CHECKED	WDC/LEM	3/19			
<b>WHEAT DESIGN GROUP</b> LANDSCAPE ARCHITECTS <small>500 N TUCSON BLVD, SUITE 150, TUCSON AZ 85716</small>			<b>LANDSCAPE PLAN</b> <b>I-10 MED CONST &amp;</b> <b>STA 5235+00 TO 5249+00</b>		
ROUTE	I-10	LOCATION	RUTHRAUFF ROAD TI		
TRACS NO. H 8480 OIC			010-D(213)S	OF	

EXPIRES 6-30-2019  
DWG NO. R-3.07

F.H.W.A. REGION	STATE	PROJECT NO.	SHEET NO.	TOTAL SHEETS	RECORD DRAWING
9	ARIZ.	010-D(213)S	771	849	

010 PM 252

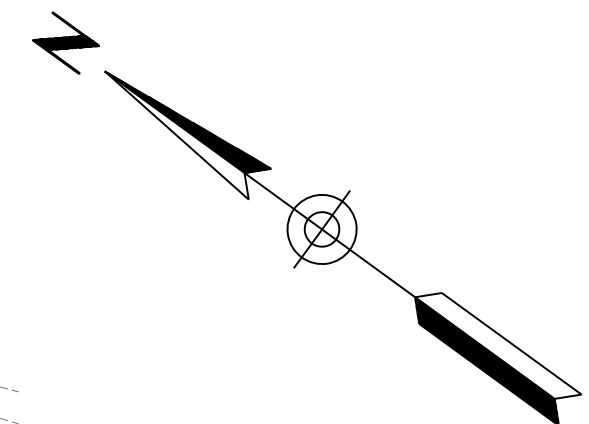


I-10 Median Cst €

Exst R/W

5250

Exst R/W

SURVEY NO. DATE FINISHED PLANS REVISIONS LOCATION DATE FINISHED PLANS REVISIONS LOCATION DATE FINISHED PLANS REVISIONS LOCATION DATE FINISHED PLANS REVISIONS LOCATION DATE FINISHED PLANS REVISIONS LOCATION DATE FINISHED PLANS REVISIONS LOCATION DATE FINISHED PLANS REVISIONS LOCATION

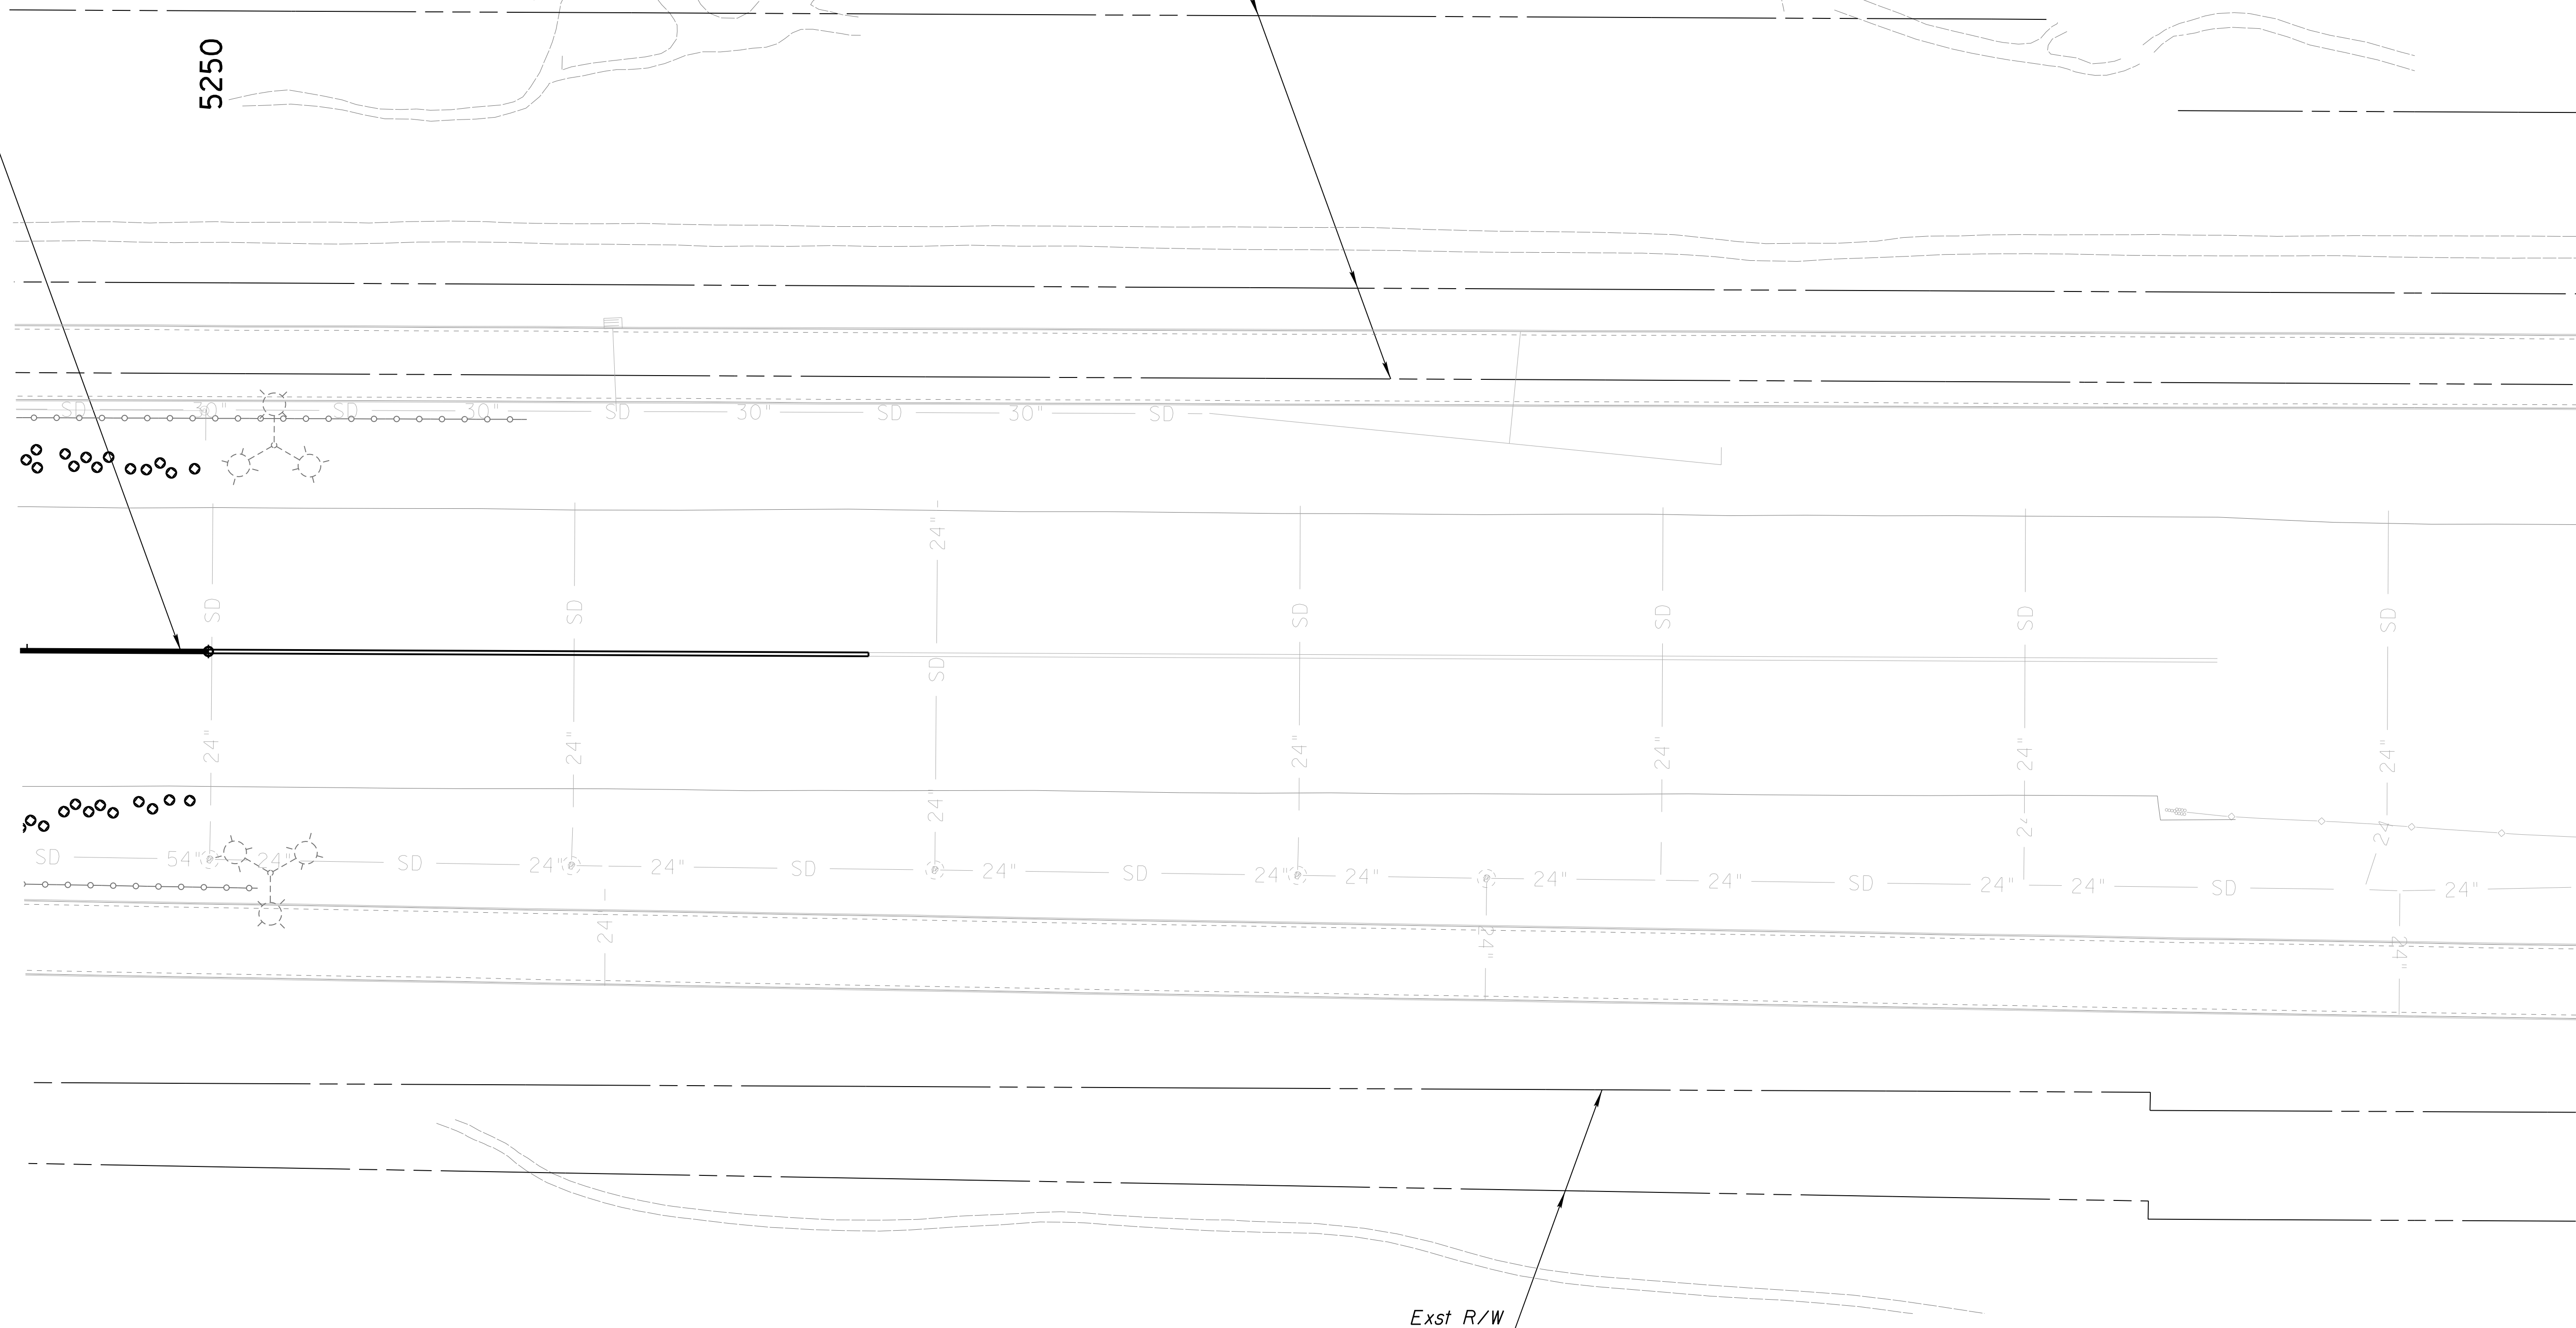

DESIGN	WDC	DATE	3/19	ARIZONA DEPARTMENT OF TRANSPORTATION INFRASTRUCTURE DELIVERY AND OPERATIONS DIVISION ROADSIDE DEVELOPMENT SECTION		
DRAWN	WDC	DATE	3/19			
CHECKED	WDC/LEM	DATE	3/19			
<b>WHEAT DESIGN GROUP</b>			LANDSCAPE PLAN I-10 MED CONST € STA 5249+00 TO 5263+00			
LANDSCAPE ARCHITECTS 500 N TUCSON BLVD, SUITE 150, TUCSON AZ 85716						
ROUTE	I-10	LOCATION	RUTHRAUFF ROAD TI			EXPIRES 6-30-2019
TRACS NO.	H 8480 OIC			010-D(213)S	DWG NO. R-3.08	
					OF	













F.H.W.A. REGION	STATE	PROJECT NO.	SHEET NO.	TOTAL SHEETS	RECORD DRAWING
9	ARIZ.	010-D(213)S	775	849	

010 PM 252

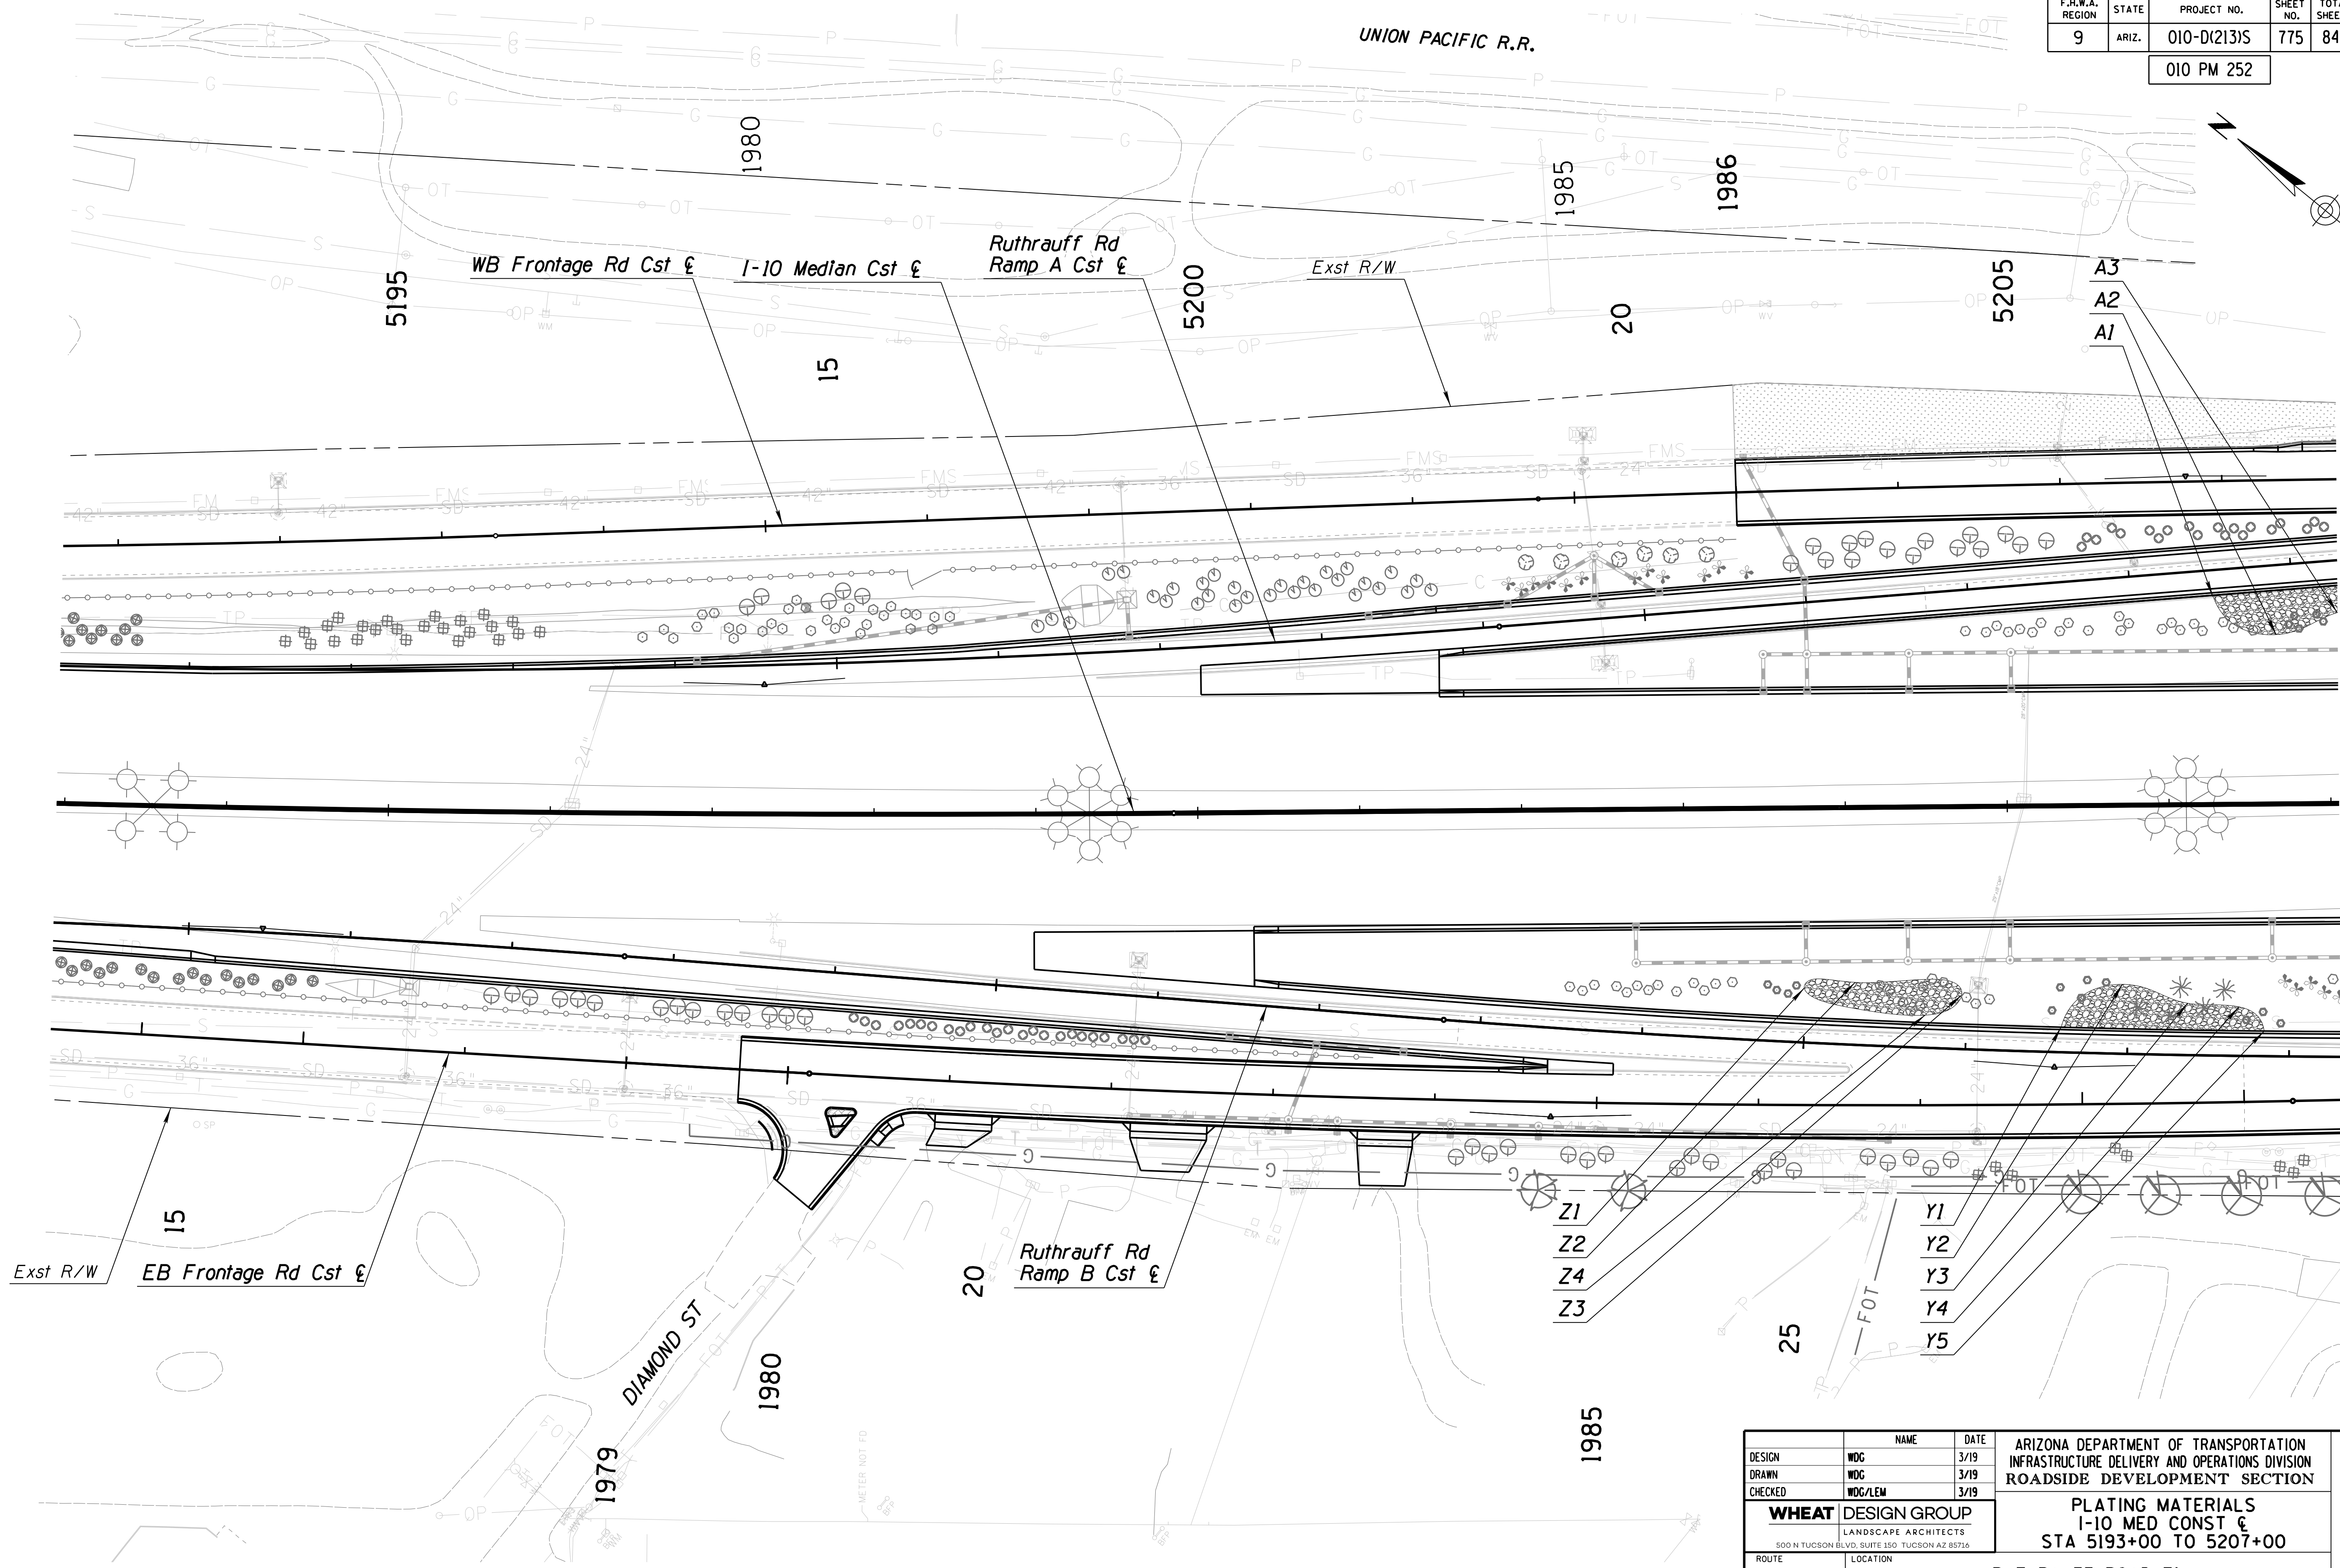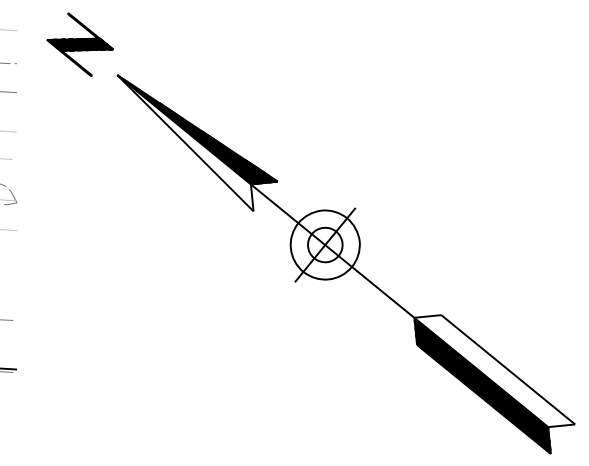


SURVEY NO. FINISHED PLANS DATE LOCATION REVISIONS DATE SURVEY NO. FINISHED PLANS DATE LOCATION REVISIONS DATE SURVEY NO. FINISHED PLANS DATE

DESIGN	WDC	NAME	DATE	ARIZONA DEPARTMENT OF TRANSPORTATION INFRASTRUCTURE DELIVERY AND OPERATIONS DIVISION ROADSIDE DEVELOPMENT SECTION
DRAWN	WDC		3/19	
CHECKED	WDC/LEM		3/19	
<b>WHEAT DESIGN GROUP</b> LANDSCAPE ARCHITECTS <small>500 N TUCSON BLVD, SUITE 150, TUCSON AZ 85716</small>		<b>PLATING MATERIALS</b> <b>I-10 MED CONST &amp;</b> <b>STA 5193+00 TO 5207+00</b>		
ROUTE	I-10	LOCATION	RUTHRAUFF ROAD TI	
TRACS NO. H 8480 OIC		010-D(213)S		EXPIRES 6-30-2019 DWG NO. R-4.01 OF



F.H.W.A. REGION	STATE	PROJECT NO.	SHEET NO.	TOTAL SHEETS	RECORD DRAWING
9	ARIZ.	010-D(213)S	776	849	

010 PM 252

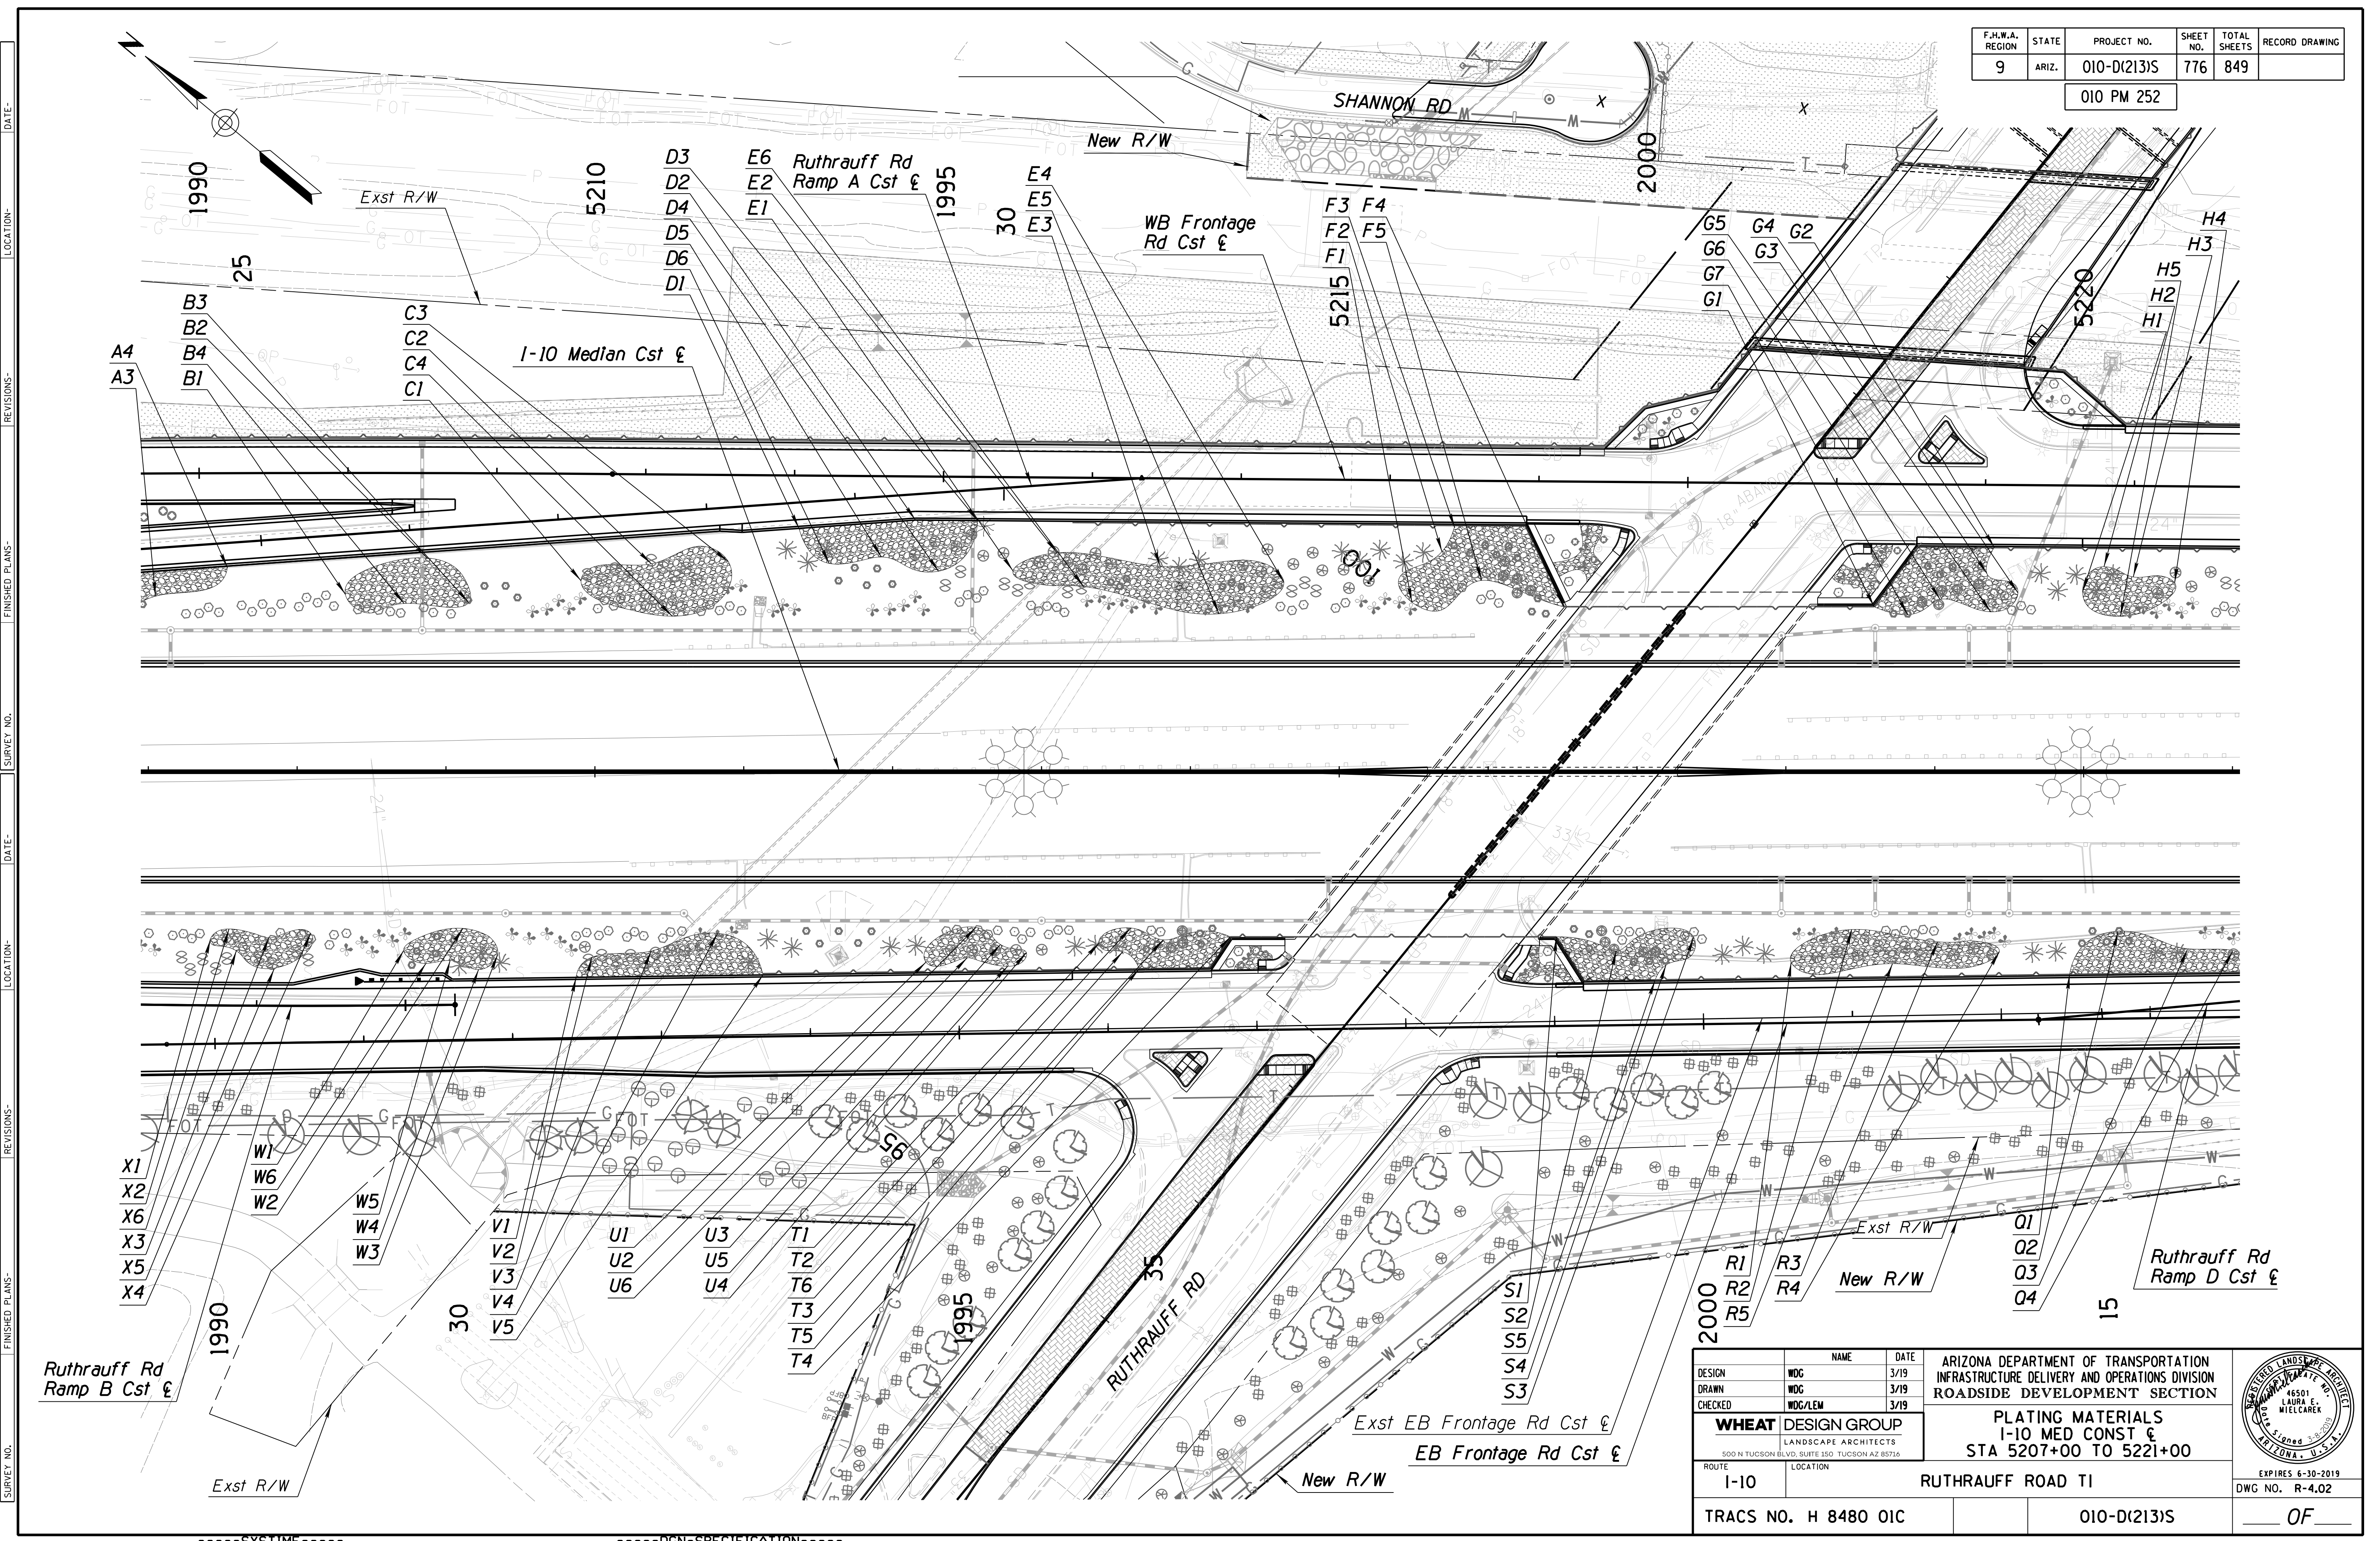

REVISIONS- FINISHED PLANS- SURVEY NO. DATE- LOCATION- DATE- REVISIONS- FINISHED PLANS- SURVEY NO. DATE-

Ruthrauff Rd Ramp B Cst €

Exst R/W

ccccSYTIMEcccc

V1  
V2  
V3  
V4  
V5

U1  
U2  
U6

U3  
U5  
U4

T1  
T2  
T3  
T5  
T4

W1  
W2  
W6

W5  
W4  
W3

X1  
X2  
X3  
X4  
X5  
X6

S1  
S2  
S3  
S4  
S5

R1  
R2  
R3  
R4  
R5

Q1  
Q2  
Q3  
Q4

H1  
H2  
H3  
H4  
H5

G1  
G2  
G3  
G4  
G5  
G6  
G7

F1  
F2  
F3  
F4  
F5

E1  
E2  
E3  
E4  
E5  
E6

D1  
D2  
D3  
D4  
D5  
D6

C1  
C2  
C3  
C4

B1  
B2  
B3  
B4

A1  
A2  
A3  
A4

1990

30

1995

5215

2000


5220

15

DESIGN	NAME	DATE
WDC		3/19
DRAWN		3/19
WDC		3/19
CHECKED		3/19
WDC/LEM		3/19

ARIZONA DEPARTMENT OF TRANSPORTATION  
INFRASTRUCTURE DELIVERY AND OPERATIONS DIVISION  
ROADSIDE DEVELOPMENT SECTION

PLATING MATERIALS  
I-10 MED CONST €  
STA 5207+00 TO 5221+00

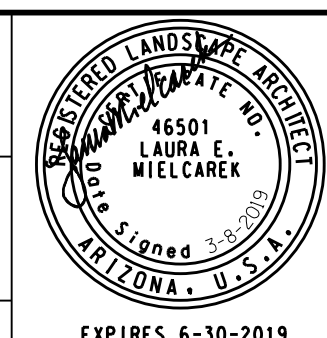

WHEAT DESIGN GROUP  
LANDSCAPE ARCHITECTS  
500 N TUCSON BLVD, SUITE 150, TUCSON AZ 85716

ROUTE I-10 LOCATION RUTHRAUFF ROAD TI

TRACS NO. H 8480 OIC

EXPIRES 6-30-2019  
DWG NO. R-4.02

010-D(213)S

OF



OF

ccccDGNcSPECIFICATIONcccc



F.H.W.A. REGION	STATE	PROJECT NO.	SHEET NO.	TOTAL SHEETS	RECORD DRAWING
9	ARIZ.	010-D(213)S	777	849	

010 PM 252

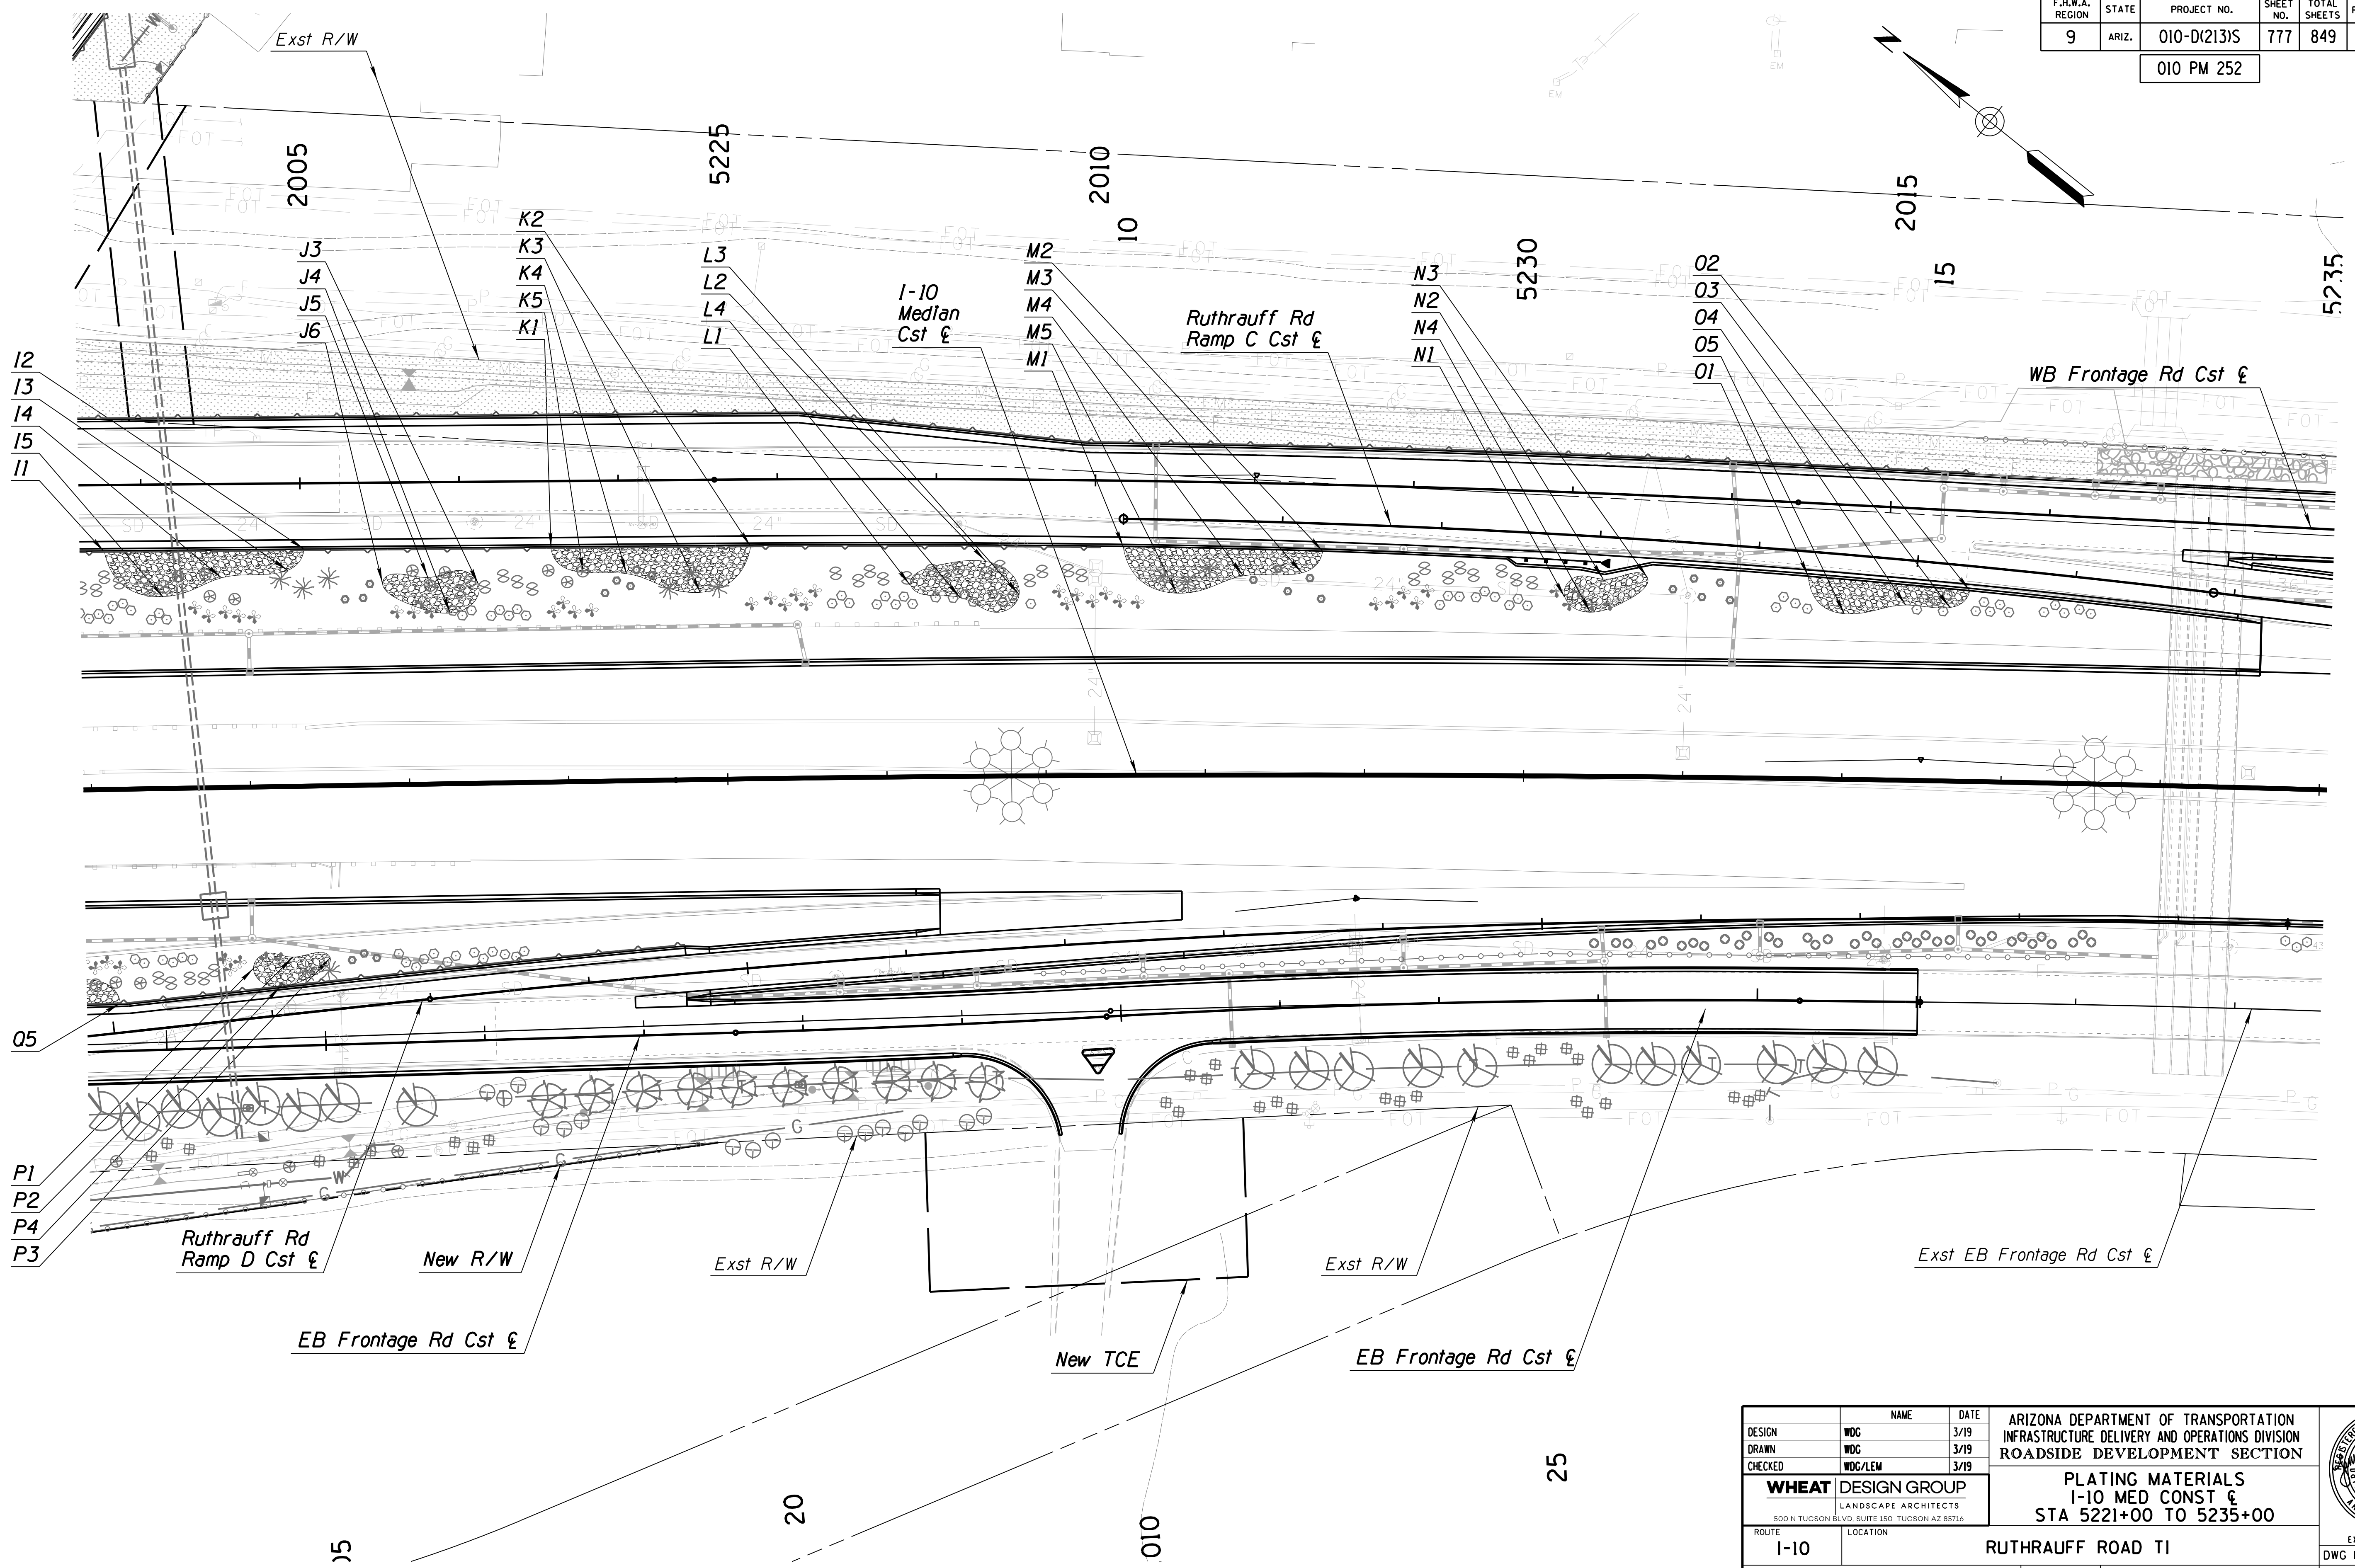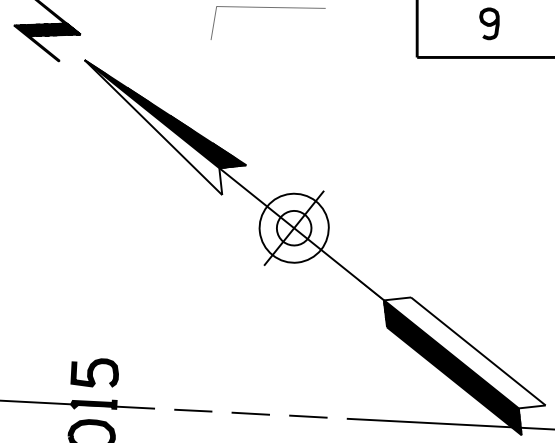

REVISIONS- LOCATION- DATE-  
 FINISHED PLANS- SURVEY NO.  
 REVISIONS- LOCATION- DATE-  
 FINISHED PLANS- SURVEY NO.

DESIGN	WDC	NAME	DATE	ARIZONA DEPARTMENT OF TRANSPORTATION INFRASTRUCTURE DELIVERY AND OPERATIONS DIVISION ROADSIDE DEVELOPMENT SECTION  <b>PLATING MATERIALS</b> <b>I-10 MED CONST &amp;</b> <b>STA 5221+00 TO 5235+00</b>	
DRAWN	WDC	3/19			
CHECKED	WDC/LEM	3/19			
<b>WHEAT DESIGN GROUP</b> LANDSCAPE ARCHITECTS <small>500 N TUCSON BLVD, SUITE 150, TUCSON AZ 85716</small>		ROUTE: I-10      LOCATION: RUTHRAUFF ROAD TI		EXPIRES 6-30-2019 DWG NO. R-4.03	
TRACS NO. H 8480 OIC			010-D(213)S		OF


F.H.W.A. REGION	STATE	PROJECT NO.	SHEET NO.	TOTAL SHEETS	RECORD DRAWING
9	ARIZ.	010-D(213)S	778	849	

010 PM 252

Rock Mulch Locations

VERTEX	STATION	OFFSET	VERTEX	STATION	OFFSET	VERTEX	STATION	OFFSET	VERTEX	STATION	OFFSET
A1	5206+28.0	129.28	H4	5220+61.0	126.87	Q2	5220+23.1	107.04	X3	5207+80.8	111.5
A2	5207+53.1	138.14	H5	5220+24.3	104.36	Q3	5220+69.8	118.82	X4	5208+09.1	108.51
A3	5207+04.8	117.88	I1	5221+10.7	149.21	Q4	5221+00.3	119.94	X5	5207+84.3	131.86
A4	5206+66.8	104.5	I2	5222+35.9	147.93	Q5	5221+16.0	134.4	X6	5207+59.0	120.23
B1	5208+32.3	129.2	I3	5222+25.6	135.84	R1	5218+03.5	128.02	Y1	5205+32.0	137.02
B2	5208+87.4	152.5	I4	5221+83.8	131.79	R2	5218+44.1	105.9	Y2	5205+70.1	110.6
B3	5209+15.3	124.77	I5	5221+46.7	120.57	R3	5219+01.8	114.19	Y3	5206+10.4	122.6
B4	5208+71.4	124.16	J1	5222+84.8	126.93	R4	5219+43.2	119.91	Y4	5206+42.1	125.13
C1	5209+90.5	127.75	J2	5223+45.2	29.85	R5	5218+71.4	128.82	Y5	5206+57.42	140.23
C2	5210+37.9	139.62	J3	5223+27.2	125.21	S1	5216+45.7	110.83	Z1	5203+73.6	110.19
C3	5210+89.4	141.2	J4	5223+13.5	107.28	S2	5216+85.8	120.32	Z2	5204+05.1	108.03
C4	5210+51.9	104.49	K1	5223+91.0	147.01	S3	5217+38.0	111.15	Z3	5204+70.7	116.52
D1	5211+37.3	163.5	K2	5225+16.7	145.93	S4	5217+19.4	129.74	Z4	5204+48.1	128.66
D2	5212+15.3	169.01	K3	5224+84.4	117.67	S5	5217+12.1	139.73			
D3	5212+57.0	168.68	K4	5224+38.28	130.24	T1	5213+38.7	115.02			
D4	5212+30.8	134.7	K5	5224+11.2	131.52	T2	5213+59.8	104.87			
D5	5211+93.26	144.23	L1	5226+15.9	121.31	T3	5213+81.5	112.86			
D6	5211+57.2	139.94	L2	5226+62.9	135.01	T4	5214+26.8	110.83			
E1	5212+80.7	134.9	L3	5226+83.7	114.09	T5	5213+65.5	132.31			
E2	5213+10.4	147.1	L4	5226+47.1	112.43	T6	5213+54.4	120.82			
E3	5213+79.6	138.1	M1	5227+48.9	143.92	U1	5212+22.3	127.86			
E4	5214+62.7	126.8	M2	5228+73.6	140.75	U2	5212+55.9	104.49			
E5	5214+19.1	106.1	M3	5228+60.6	127.05	U3	5212+72.3	115.96			
E6	5213+28.3	124.4	M4	5228+24.4	125.23	U4	5212+89.6	121.45			
F1	5215+48.7	113.9	M5	5227+82.4	114.36	U5	5212+77.1	130.63			
F2	5215+68.8	147.8	N1	5230+24.9	113.11	U6	5212+50.0	124.9			
F3	5215+77.4	165.4	N2	5230+48.9	123.98	V1	5209+87.2	138.07			
F4	5216+50.7	110.8	N3	5230+76.4	125.3	V2	5209+97.7	124.6			
F5	5215+95.4	128.52	N4	5230+41.3	103.09	V3	5210+37.8	120.42			
G1	5218+59.1	110.83	O1	5231+77.0	127.13	V4	5210+82.6	108.43			
G2	5219+39.7	150.55	O2	5232+78.1	119.87	V5	5211+12.8	136.41			
G3	5219+34.9	138.18	O3	5232+66.2	109.14	W1	5208+71.4	120.04			
G4	5219+55.7	120.15	O4	5232+38.3	110.12	W2	5209+11.3	105.05			
G5	5219+37.6	107.43	O5	5231+99.8	104.07	W3	5209+34.6	122.82			
G6	5219+03.6	115.75	P1	5221+99.3	113.83	W4	5209+21.8	132.82			
G7	5218+81.5	105.48	P2	5222+24.8	107.28	W5	5209+02.8	126.68			
H1	5219+99.1	120.86	P3	5222+48.2	108.02	W6	5208+86.7	128.68			
H2	5220+13.6	137.7	P4	5222+16.4	125.76	X1	5207+41+7	112.46			
H3	5220+33.3	130.82	Q1	5219+90.3	136.06	X2	5207+54.1	105.53			

DATE- LOCATION- REVISIONS- FINISHED PLANS- SURVEY NO. DATE- LOCATION- REVISIONS- FINISHED PLANS- SURVEY NO.

DESIGN	WDC	3/19	ARIZONA DEPARTMENT OF TRANSPORTATION INFRASTRUCTURE DELIVERY AND OPERATIONS DIVISION ROADSIDE DEVELOPMENT SECTION	
DRAWN	WDC	3/19		
CHECKED	WDC/LEM	3/19		
<b>WHEAT DESIGN GROUP</b>		ROCK MULCH LOCATIONS		EXPIRES 6-30-2019 DWG NO. R-4.04
LANDSCAPE ARCHITECTS 500 N TUCSON BLVD, SUITE 150, TUCSON AZ 85716				
ROUTE	LOCATION		RUTHRAUFF ROAD T1	
I-10		TRACS NO. H 8480 OIC		010-D(213)S
				OF



F.H.W.A. REGION	STATE	PROJECT NO.	SHEET NO.	TOTAL SHEETS	RECORD DRAWING
9	ARIZ.	010-D(213)S	779	849	

010 PM 252


### IRRIGATION EQUIPMENT SCHEDULE

SYMBOL	EQUIPMENT	SIZE	QTY
[A-1]	Equipment Assembly and Enclosure		1
[A]	Computerized Control System		1
not shown	Hydrometer	1-1/2"	2
⊘	Existing Reduced Pressure Backflow Preventor (ADOT) to be Replaced	2"	1
⊞	Existing 2" Water Meter (ADOT) to be Preserved	2"	1
⊕	Gate Valve (ADOT)	2"	11
⊕	Gate Valve (ADOT)	1-1/2"	3
⊕	New Remote Control Valve (ADOT)	1"	23
⊕	Existing Remote Control Valve (ADOT)	1"	16
●	Pressure Regulator Riser (ADOT)	1"	40
—	Mainline (ADOT), PVC Sch 40 Pipe (lin. ft.)	1 1/2"	776 LF
—	Mainline (ADOT), PVC Sch 40 Pipe (lin. ft.)	2"	20,030 LF
.....	Existing Mainline	N/A	N/A
----	Sub-main PVC Class 200 Pipe (lin. ft.)	1"	12,153 LF
-.-.-	Lateral Line - Tree PVC Class 200 Pipe (lin. ft.)	3/4"	3,452 LF
-.-.-	Lateral Line - Shrub PVC Class 200 Pipe (lin. ft.)	3/4"	24,146 LF
not shown	Emitter Assembly (ADOT) (multi-port, 0.6 gph, 1 gph, 2 gph each)	0.6/1.2/2.3 GPH	637
not shown	Emitter Assembly - (single outlet, 0.6 gph each)	0.6/GPH	964
—	New Sleeve (ADOT), (lin. ft.)	12"	1,423 LF
—	New Sleeve (ADOT), (lin. ft.)	6"	213 LF
—	New Sleeve (ADOT), (lin. ft.)	4"	376 LF
—	New Sleeve (ADOT), (lin. ft.)	2"	213 LF
.....	Existing Sleeve (ADOT), (lin. ft.)	12"	N/A
—◇	Lateral End Cap Assembly	N/A	99
⊞	Pullbox	N/A	N/A

NOTES:  
 1. QUANTITIES ARE APPROXIMATE  
 2. SEE CIVIL SHEETS FOR IRRIGATION SUPPLY LINE LOCATION

### WATER USE CALCULATIONS

ZONE / AREA MAINLINE LOCATION	IRRIGATION CONTROLLER IDENTIFICATION	ANNUAL VOLUME
ADOT	A	6.5 ACRE FEET
<b>TOTAL PROJECT USAGE VOLUME</b>		<b>6.5 ACRE FEET</b>

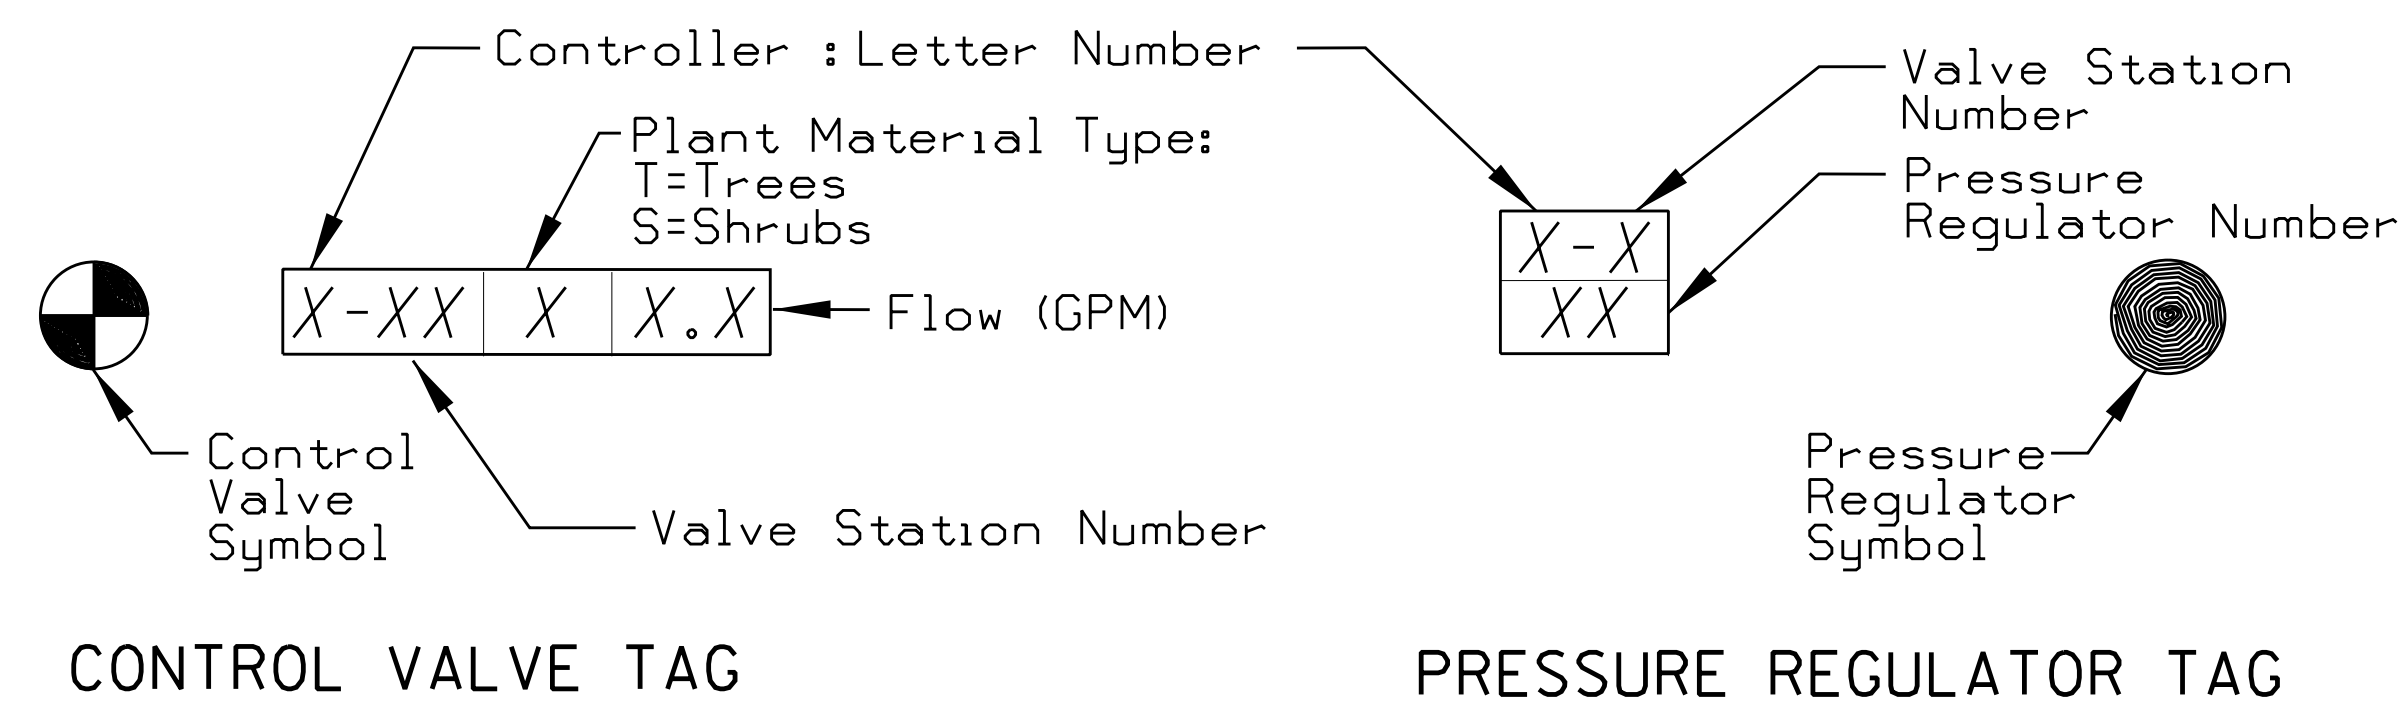

### WATER USE SCHEDULING CALCULATIONS:

1. Available water per 1' depth of soil = 1.75"
2. Management allowable depletion between irrigation = 50%
3. Plant root depth: Trees: 24", Shrubs: 12"
4. Maximum allowable loss between irrigation cycles: Trees: 1.75", Shrubs: 0.875"
5. Irrigation is required any time total of daily ET equals the maximum allowable loss.
6. Run times: Trees: 3 Hours, Shrubs: 1 Hour
7. Adjust run times for seasonal and soil variations.

### GENERAL IRRIGATION NOTES:

1. All irrigation equipment noted as existing shall be protected in place.
2. Sleeves are existing at crossings unless noted otherwise.
3. Irrigation lines may be shown outside of landscape areas for graphic clarity - locate all lines within planting areas and within ADOT Right-of-Way.
4. Contractor shall locate all existing utilities, including existing landscape irrigation lines, prior to any construction activities.
5. Preserve existing Point of Connection and Structure including Electrical and Water Service at Sta 5205+00.00.
6. Preserve existing Water Meter at Sta 5200+00.00.
7. Cap existing Mainline at Northern End of Project at last existing valves to be preserved in place so that Mainline can be reconnected during Irrigation Construction.
8. Preserve existing Sleeves Outside of Roadway Construction.
9. Cap existing irrigation electrical wires with coil and wire nuts in a junction box.
10. Refer to Irrigation Plans for Existing and Proposed Irrigation Design.

DESIGN	CK	DATE	3/19	ARIZONA DEPARTMENT OF TRANSPORTATION INFRASTRUCTURE DELIVERY AND OPERATIONS DIVISION ROADSIDE DEVELOPMENT SECTION	
DRAWN	WDC	DATE	3/19		
CHECKED	CK/LEM	DATE	3/19		
<b>WHEAT DESIGN GROUP</b>		LANDSCAPE ARCHITECTS		IRRIGATION PLAN SUMMARY SHEET	
500 N TUCSON BLVD, SUITE 150, TUCSON AZ 85716					
ROUTE	LOCATION		RUTHRAUFF ROAD TI		
I-10			DWG NO. I-1.01		
TRACS NO. H 8480 OIC		010-D(213)S		OF	

IRRIGATION CONSULTANT:  
 Carl Kominsky, RLA, ASIC  
 CARL KOMINSKY LANDSCAPE ARCHITECT, INC.  
 Tucson, Arizona  
 Phone: (520) 740-0700  
 Email: ckominsky@comcast.net


F.H.W.A. REGION	STATE	PROJECT NO.	SHEET NO.	TOTAL SHEETS	RECORD DRAWING
9	ARIZ.	010-D(213)S	780	849	

010 PM 252

CONTROLLER A - CONTROL WIRE SCHEDULE

Valve No.	EXISTING	TYPE	SEGMENT	LENGTH (FT)	COMMON WIRE	CIRCUIT WIRE
A-1	EXISTING	S	1	5200	#8	#10
A-2	EXISTING	T	1	5200	#8	#8
A-3	EXISTING	S	1	5000	#8	#10
A-4	EXISTING	T	1	5000	#8	#8
A-5	EXISTING	S	1	3500	#8	#10
A-6	EXISTING	S	1	3600	#8	#10
A-7	EXISTING	T	1	3600	#8	#8
A-8		S	1	2000	#8	#14
A-9		S	1	950	#8	#14
A-10		S	2	1050	#8	#14
A-11		S	2	2000	#8	#14
A-12		S	2	2800	#8	#12
A-13		S	2	4200	#8	#10
A-14		S	2	5200	#8	#10
A-15	EXISTING	S	3	5100	#8	#8
A-16		S	3	4800	#8	#8
A-17		S	3	3500	#8	#10
A-18	EXISTING	S	3	3500	#8	#8
A-19		T	3	2400	#8	#12
A-20		S	3	2400	#8	#12
A-21		S	3	1800	#8	#14
A-22		T	3,4	2200	#8,#10	#14
A-23		S	3,4	2200	#8,#10	#14
A-24		T	3,5	900	#8,#12	#14
A-25		S	3,5	900	#8,#12	#14
A-26		S	3	600	#8	#14
A-27		T	3	200	#8	#14
A-28		S	6	1300	#8	#14
A-29	EXISTING	S	6	1500	#8	#12
A-30		S	6	2900	#8	#10
A-31		T	6	3000	#8	#10
A-32	EXISTING	S	6	3000	#8	#10
A-33	EXISTING	T	6	3600	#8	#10
A-34	EXISTING	S	6	3600	#8	#10
A-35	EXISTING	S	6	4600	#8	#10
A-36	EXISTING	S	6	4800	#8	#8
A-37	EXISTING	T	6	4800	#8	#10
A-38	EXISTING	T	1	1100	#8	#14
A-39	EXISTING	S	1	1100	#8	#14

COMMON WIRE DIAGRAM CONTROLLER 'A'

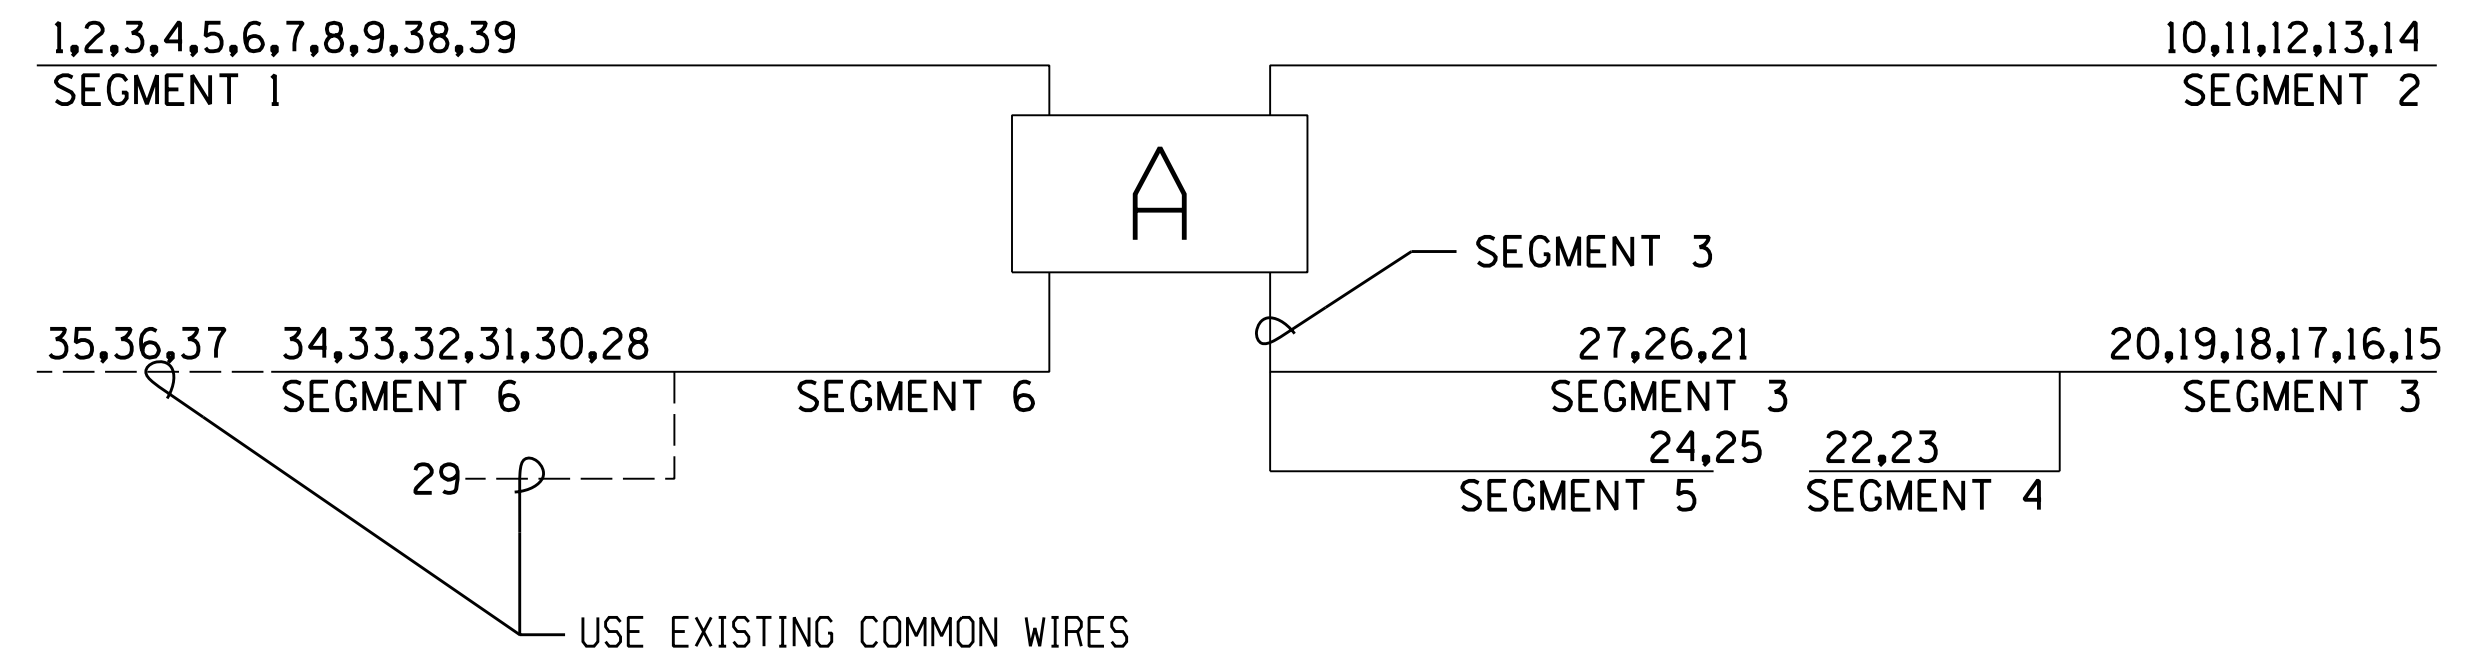

DATE- LOCATION- REVISIONS- FINISHED PLANS- SURVEY NO. DATE- LOCATION- REVISIONS- FINISHED PLANS- SURVEY NO.

IRRIGATION CONSULTANT:  
 Carl Kominsky, RLA, ASIC  
 CARL KOMINSKY LANDSCAPE ARCHITECT, INC.  
 Tucson, Arizona  
 Phone: (520) 740-0700  
 Email: ckominsky@comcast.net

DESIGN	CK	DATE	3/19	ARIZONA DEPARTMENT OF TRANSPORTATION INFRASTRUCTURE DELIVERY AND OPERATIONS DIVISION ROADSIDE DEVELOPMENT SECTION	
DRAWN	WDC	DATE	3/19		
CHECKED	CK/LEM	DATE	3/19		
<b>WHEAT DESIGN GROUP</b>		LANDSCAPE ARCHITECTS		IRRIGATION PLAN SUMMARY SHEET	
500 N TUCSON BLVD, SUITE 150, TUCSON AZ 85716					
ROUTE	LOCATION		RUTHRAUFF ROAD T1		
TRACS NO. H 8480 01C		010-D(213)S		DWG NO. I-1.02	
				OF	

VALVE SEQUENCING CHARTS - CONTROLLER A

F.H.W.A. REGION	STATE	PROJECT NO.	SHEET NO.	TOTAL SHEETS	RECORD DRAWING
9	ARIZ.	010-D(213)S	781	849	

010 PM 252

MAINLINE 1

MAINLINE 2

GROUP 1 - Tree		GROUP 4 - Shrub	
Valve No.	GPM	Valve No.	GPM
A-2	4.2	A-3 (EXIST)	2.4
A-38 (EXIST)	3.0	A-9	3.0
		A-14	1.0
Total	7.2	Total	6.4
Hours Per Cycle	8.0	Hours Per Cycle	4.0
Max Cycles/Week	3.0	Max Cycles/Week	3.0

GROUP 1 - Tree		GROUP 4 - Shrub	
Valve No.	GPM	Valve No.	GPM
A-19	4.2	A-15 (EXIST)	2.7
A-27	2.2	A-18 (EXIST)	2.2
A-37 (EX)	3.6	A-29 (EXIST)	4.5
		A-30	2.9
		A-34 (EXIST)	1.5
Total	10.0	Total	13.8
Hours Per Cycle	8.0	Hours Per Cycle	4.0
Max Cycles/Week	3.0	Max Cycles/Week	3.0

GROUP 7 - Shrub	
Valve No.	GPM
A-20	1.7
A-23	2.7
A-25	2.9
Total	7.3
Hours Per Cycle	4.0
Max Cycles/Week	3.0

GROUP 2 - Tree		GROUP 5 - Shrub	
Valve No.	GPM	Valve No.	GPM
A-4 (EXIST)	2.4	A-6 (EXIST)	0.5
A-7 (EXIST)	3.5	A-8	2.5
Total	5.9	Total	3.0
Hours Per Cycle	8.0	Hours Per Cycle	4.0
Max Cycles/Week	3.0	Max Cycles/Week	3.0

GROUP 2 - Tree		GROUP 5 - Shrub	
Valve No.	GPM	Valve No.	GPM
A-22	5.6	A-16	1.6
A-24	3.0	A-17	1.9
		A-28	3.2
		A-35 (EXIST)	2.1
Total	8.6	Total	8.8
Hours Per Cycle	8.0	Hours Per Cycle	4.0
Max Cycles/Week	3.0	Max Cycles/Week	3.0


GROUP 3 - Shrub		GROUP 6 - Shrub	
Valve No.	GPM	Valve No.	GPM
A-1 (EXIST)	1.2	A-5	1.9
A-11	0.8	A-10	1.9
A-12	1.1	A-13	1.3
		A-39 (EXIST)	1.0
Total	3.1	Total	6.1
Hours Per Cycle	4.0	Hours Per Cycle	4.0
Max Cycles/Week	3.0	Max Cycles/Week	3.0

GROUP 3 - Tree		GROUP 6 - Shrub	
Valve No.	GPM	Valve No.	GPM
A-31 (EXIST)	4.7	A-21	1.0
A-33 (EXIST)	4.5	A-26	1.4
		A-32 (EXIST)	0.5
		A-36 (EXIST)	1.5
Total	9.2	Total	4.4
Hours Per Cycle	8.0	Hours Per Cycle	4.0
Max Cycles/Week	3.0	Max Cycles/Week	3.0

IRRIGATION EMITTER SCHEDULE

BOTANICAL NAME	PEAK DAILY DEMAND GALS.	RUN HRS PER IRRIGATION DAY	PEAK IRRIGATION FREQUENCY DAYS/WEEK	RUN HRS YR	MAT. WATER USE PER YR	EMITTER PLACEMENT TYPE	EMITTER TYPE M/S	* OF DISTRIB. TUBES @ CONST./MAT.	OUTLET GPH	TOTAL GPH
<b>TREES</b>										
<i>Chilopsis linearis</i>		8	3	600	7200	A	M	6	2	12
<i>Parkinsonia spp.</i>		8	3	600	7200	A	M	6	2	12
<i>Prosopis velutina</i>		8	3	600	7200	A	M	6	2	12
<b>SHRUBS</b>										
<i>Caesalpinia mexicana</i>		4	3	200	600	B	M	3	1	3
<i>Dodonaea viscosa</i>		4	3	200	400	B	M	2	1	2
<i>Larrea tridentata</i>		4	3	200	200	D/E	M	1	1	1
<i>Leucophyllum langmaniae 'Lynn's Legacy'</i>		4	3	200	400	B	M	2	1	2
<i>Vauquelinia californica</i>		4	3	200	800	C	M	4	1	4
<b>CACTUS &amp; ACCENT PLANTS</b>										
<i>Carnegiea gigantea</i>		4	3	200	100	D	S	1	0.5	0.6
<i>Dastilirion wheeleri</i>		4	3	200	100	D	S	1	0.5	0.6
<i>Fouquieria splendens</i>		4	3	200	100	D	S	1	0.5	0.6
<i>Hesperaloe funifera</i>		4	3	200	200	D	S	1	1	1
<i>Hesperaloe parviflora</i>		4	3	200	200	D	S	1	1	1
<i>Opuntia gomei 'Old Mexico'</i>		4	3	200	100	D	S	1	0.5	0.6
<i>Opuntia santa-rita</i>		4	3	200	100	D	S	1	0.5	0.6
<i>Yucca rigida</i>		4	3	200	200	D	S	1	1	1

**IRRIGATION CONSULTANT:**  
 Carl Kominsky, RLA, ASIC  
 CARL KOMINSKY LANDSCAPE ARCHITECT, INC.  
 Tucson, Arizona  
 Phone: (520) 740-0700  
 Email: ckominsky@comcast.net

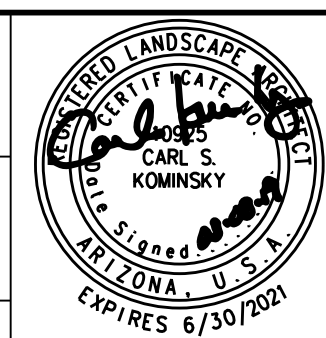DESIGN	CK	DATE	3/19	ARIZONA DEPARTMENT OF TRANSPORTATION INFRASTRUCTURE DELIVERY AND OPERATIONS DIVISION ROADSIDE DEVELOPMENT SECTION	
DRAWN	WDC	DATE	3/19		
CHECKED	CK/LEM	DATE	3/19		
<b>WHEAT DESIGN GROUP</b>		LANDSCAPE ARCHITECTS		<b>IRRIGATION PLAN SUMMARY SHEET</b>	
500 N TUCSON BLVD, SUITE 150, TUCSON AZ 85716					
ROUTE	LOCATION		RUTHRAUFF ROAD T1		
TRACS NO. H 8480 OIC		010-D(213)S		DWG NO. I-1.03	

DATE- LOCATION- REVISIONS- FINISHED PLANS- SURVEY NO. DATE- LOCATION- REVISIONS- FINISHED PLANS- SURVEY NO.











F.H.W.A. REGION	STATE	PROJECT NO.	SHEET NO.	TOTAL SHEETS	RECORD DRAWING
9	ARIZ.	010-D(213)S	784	849	

010 PM 252

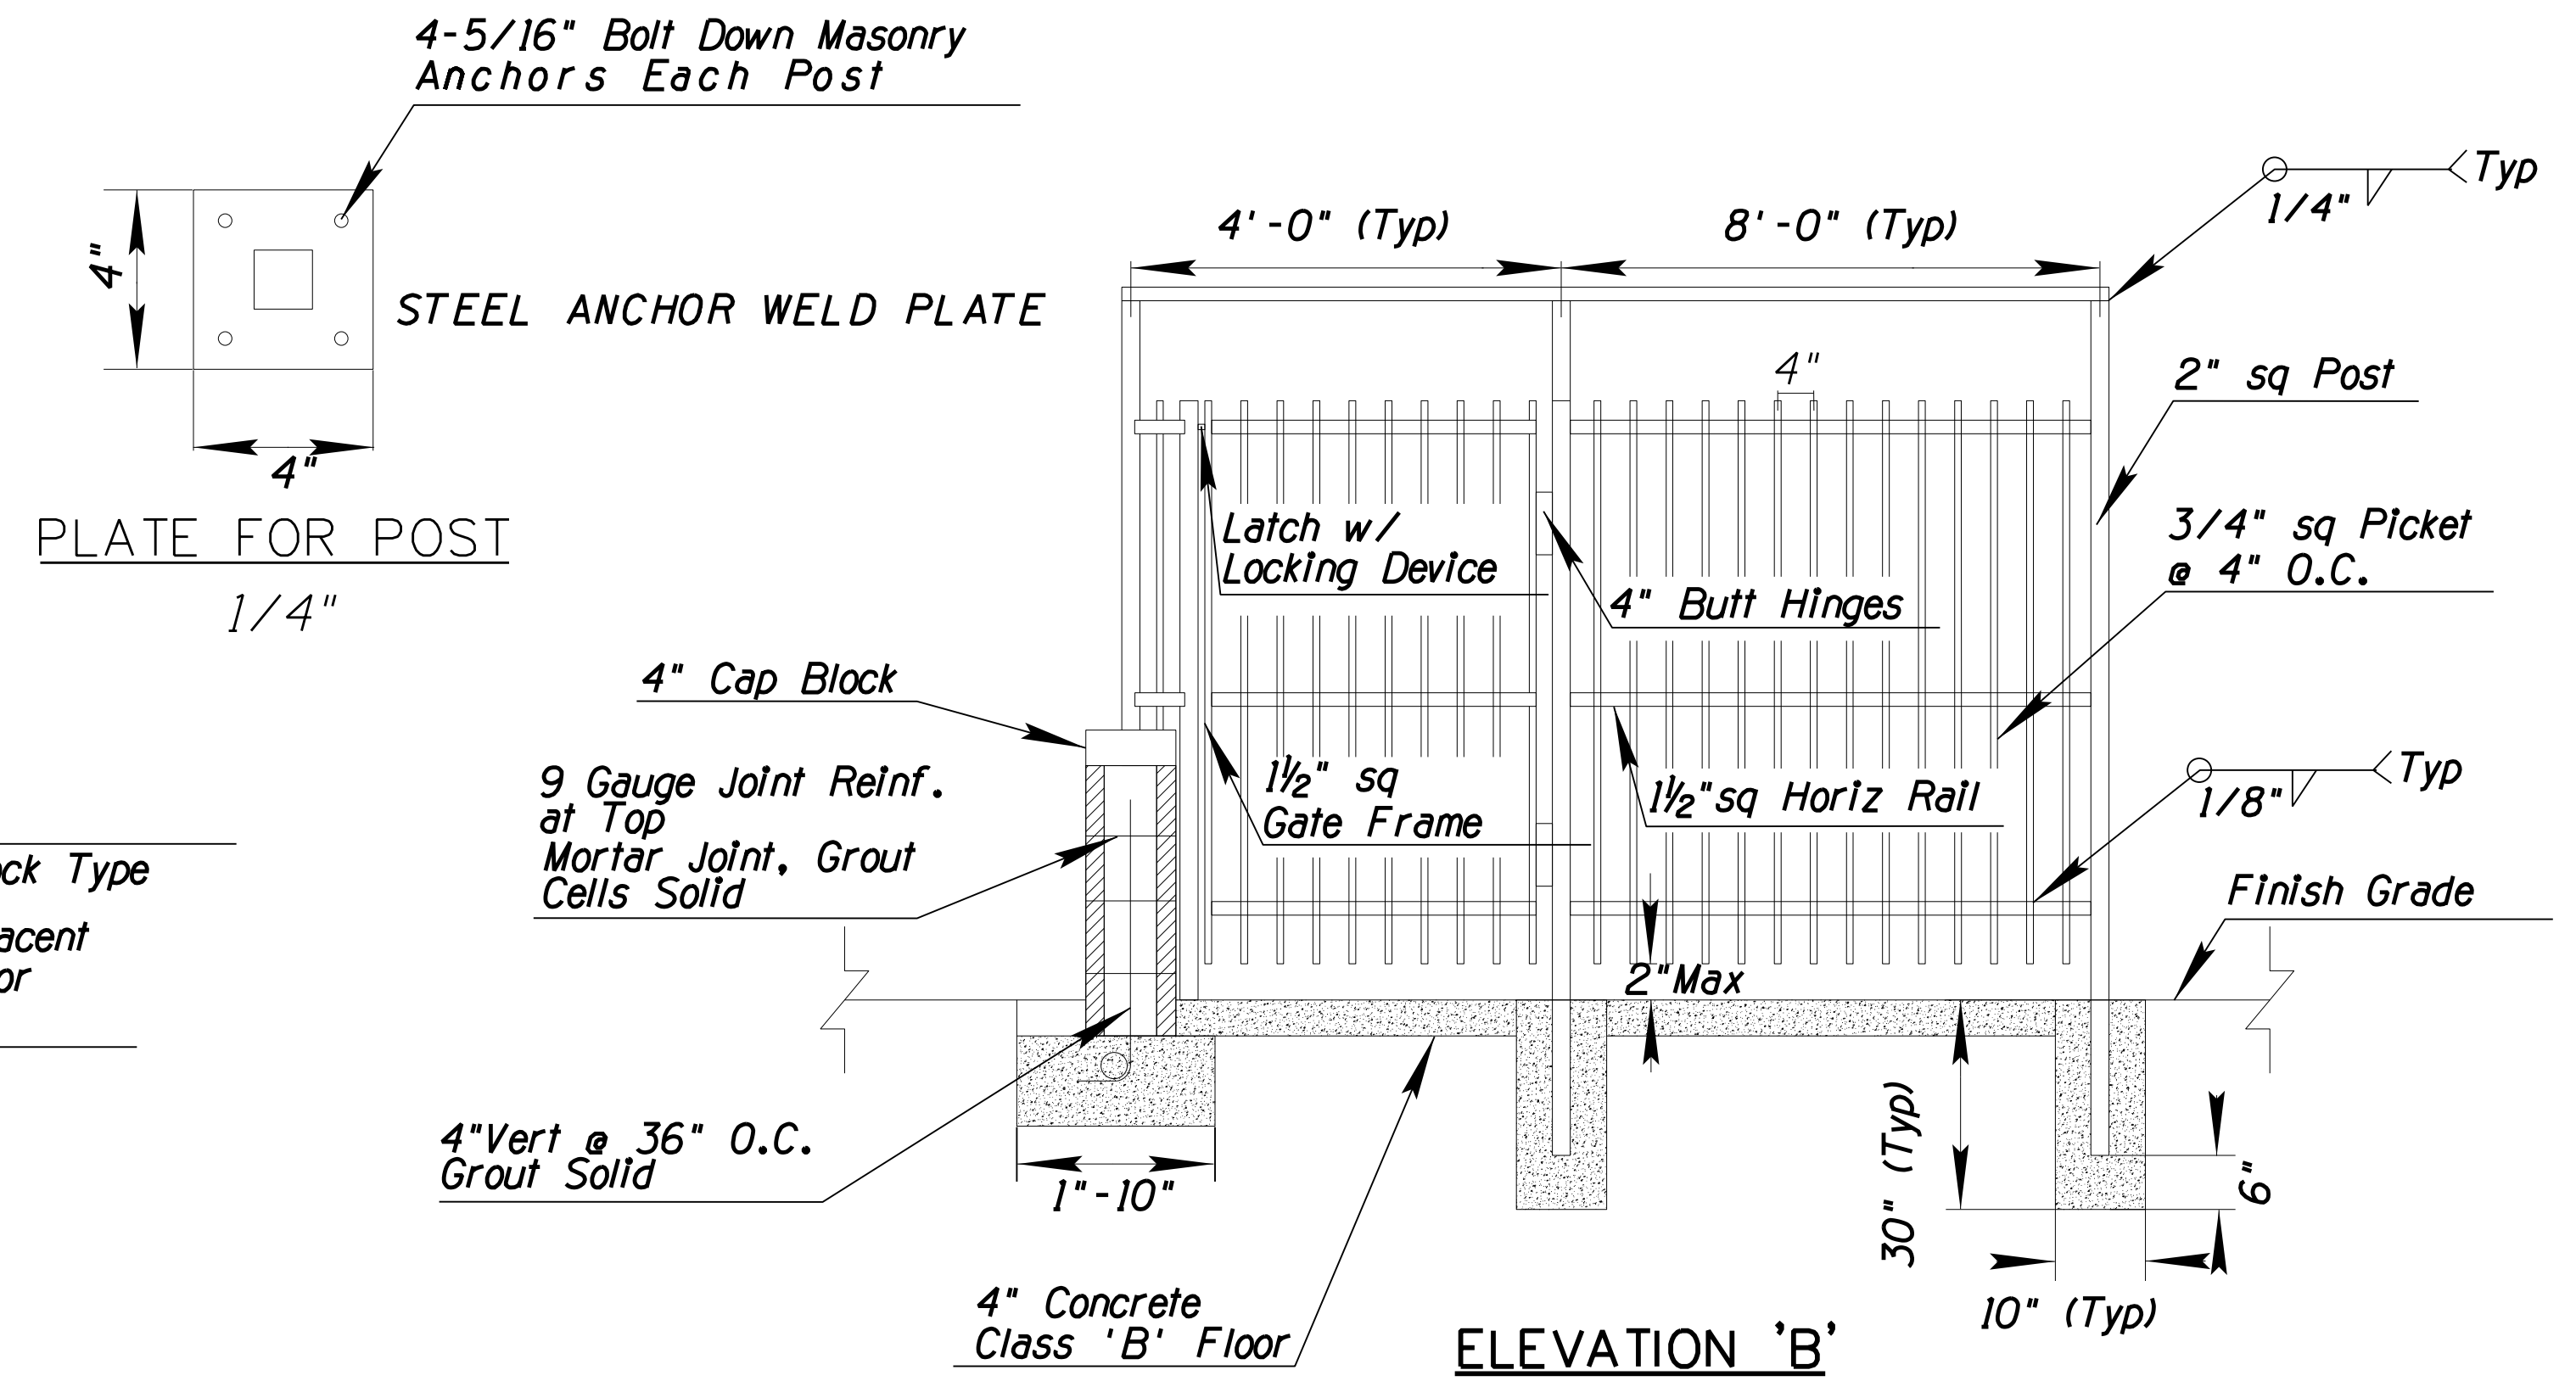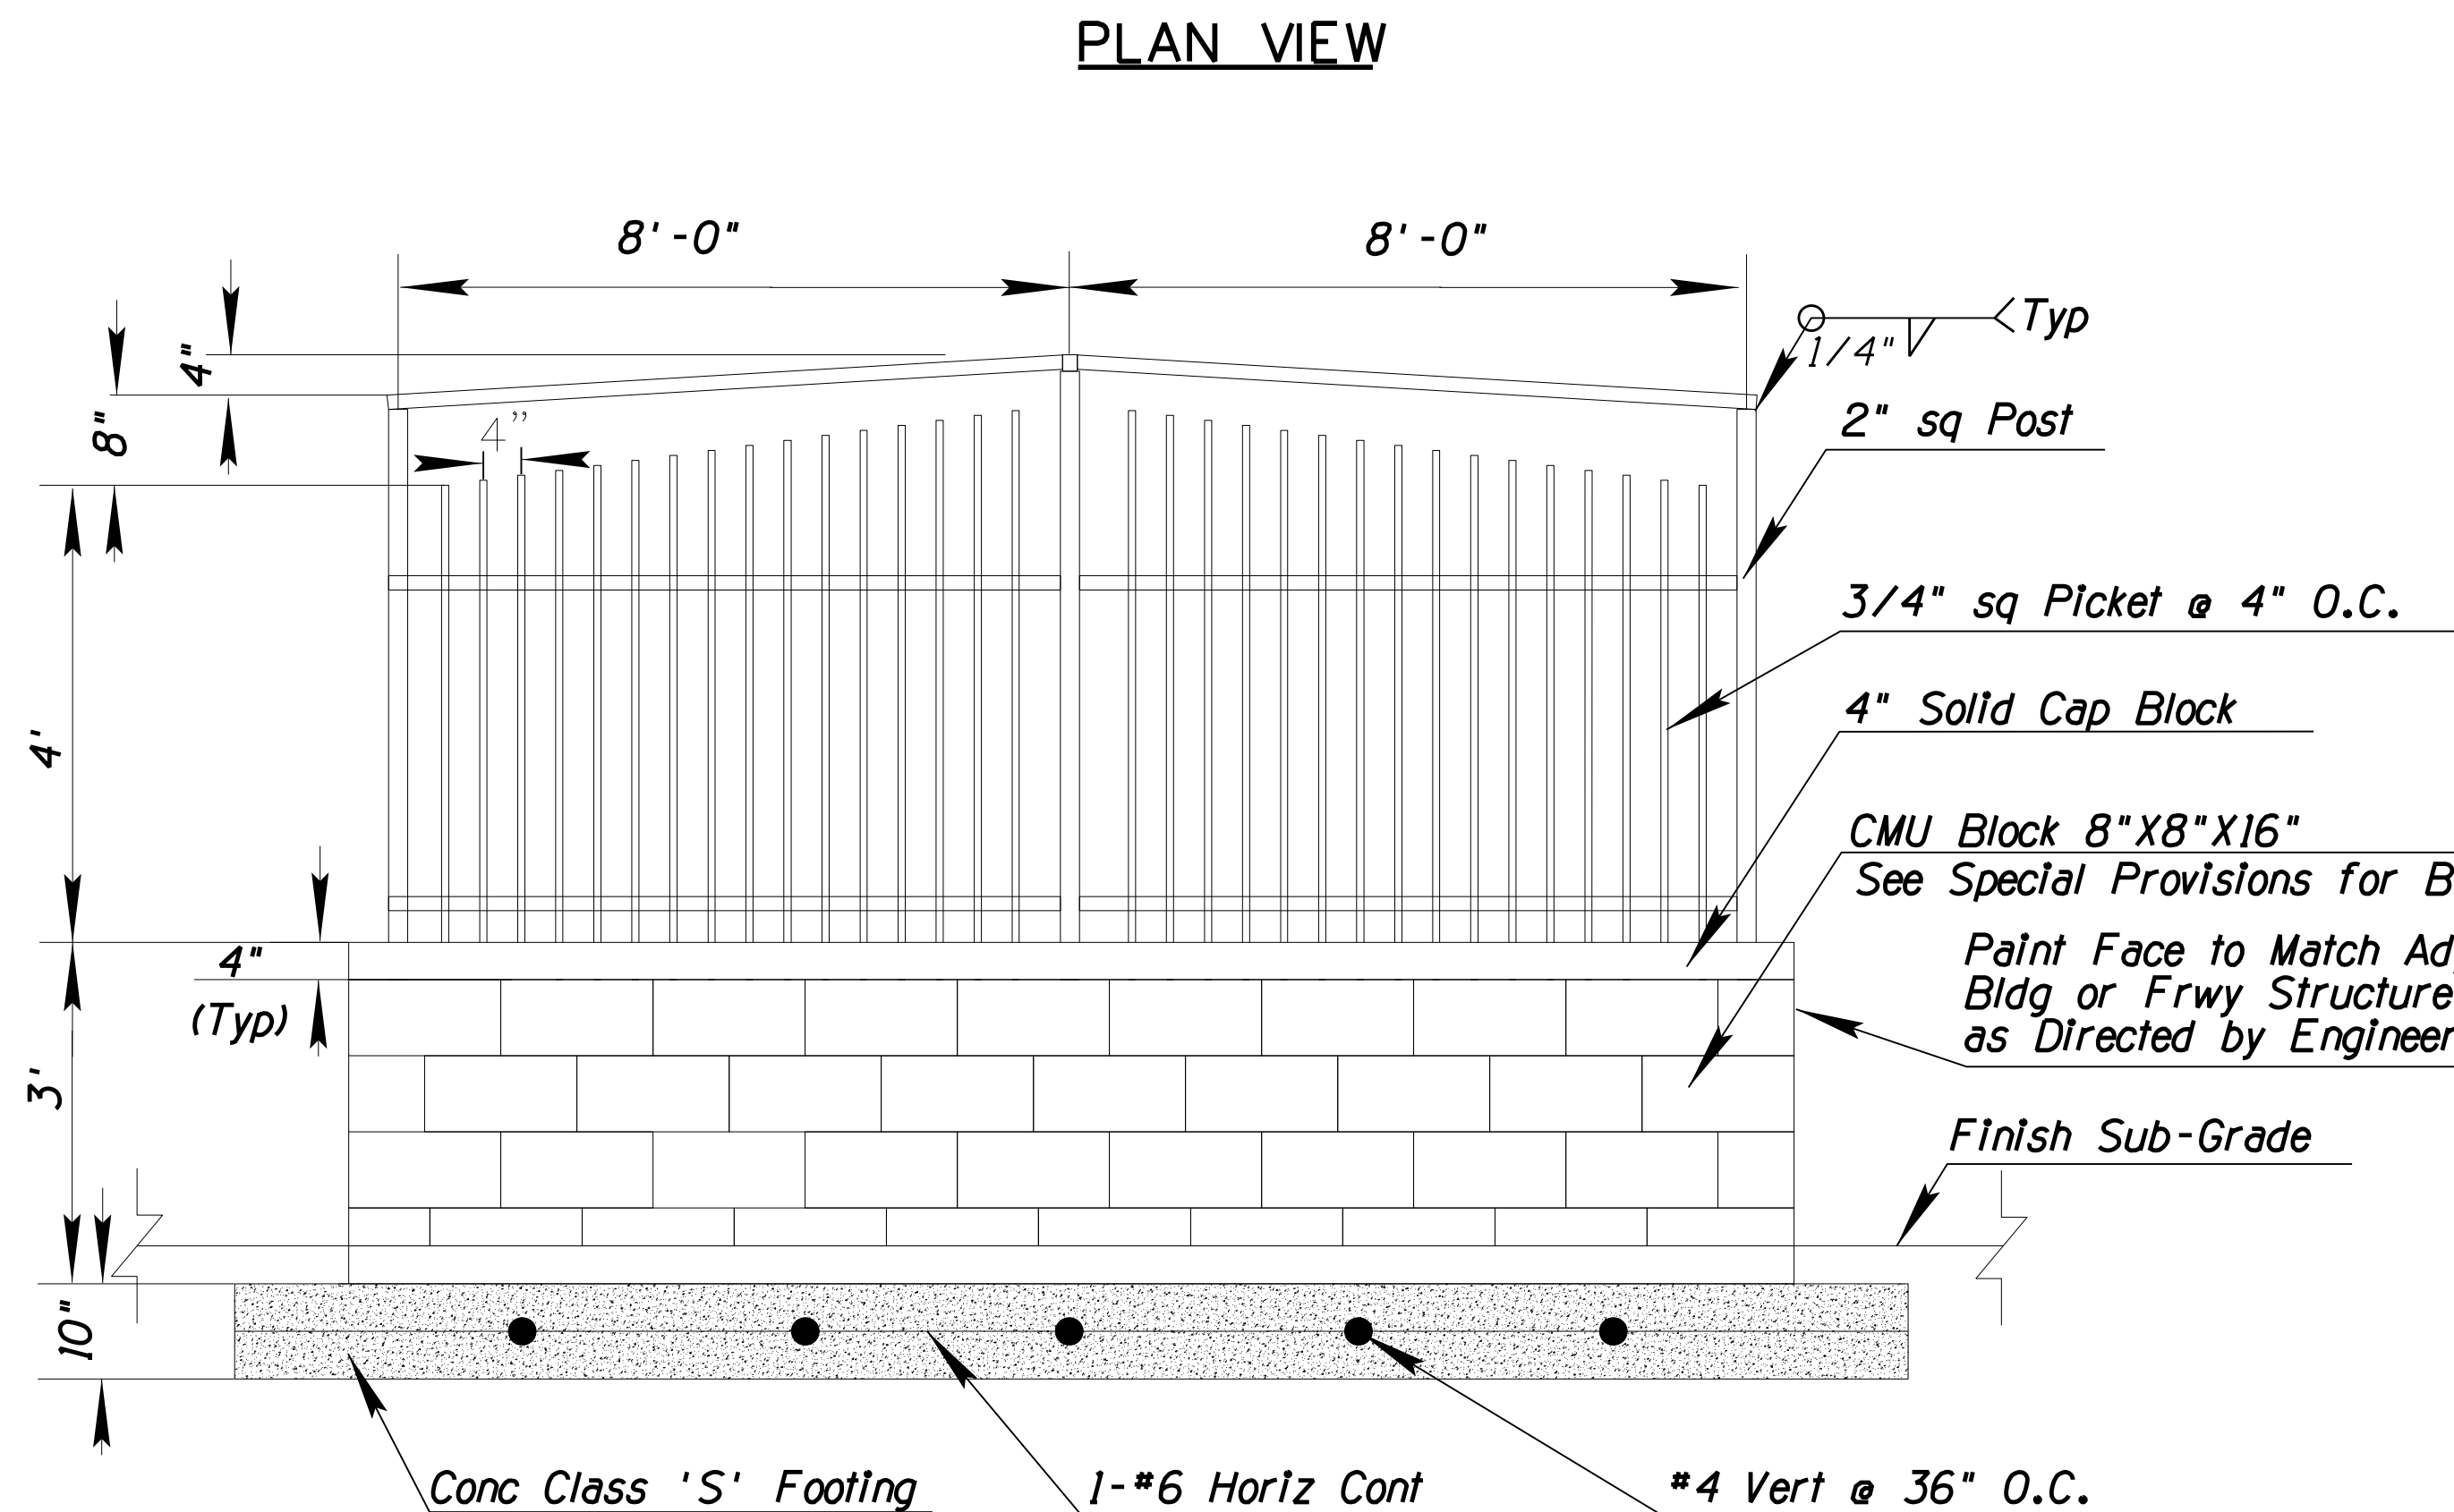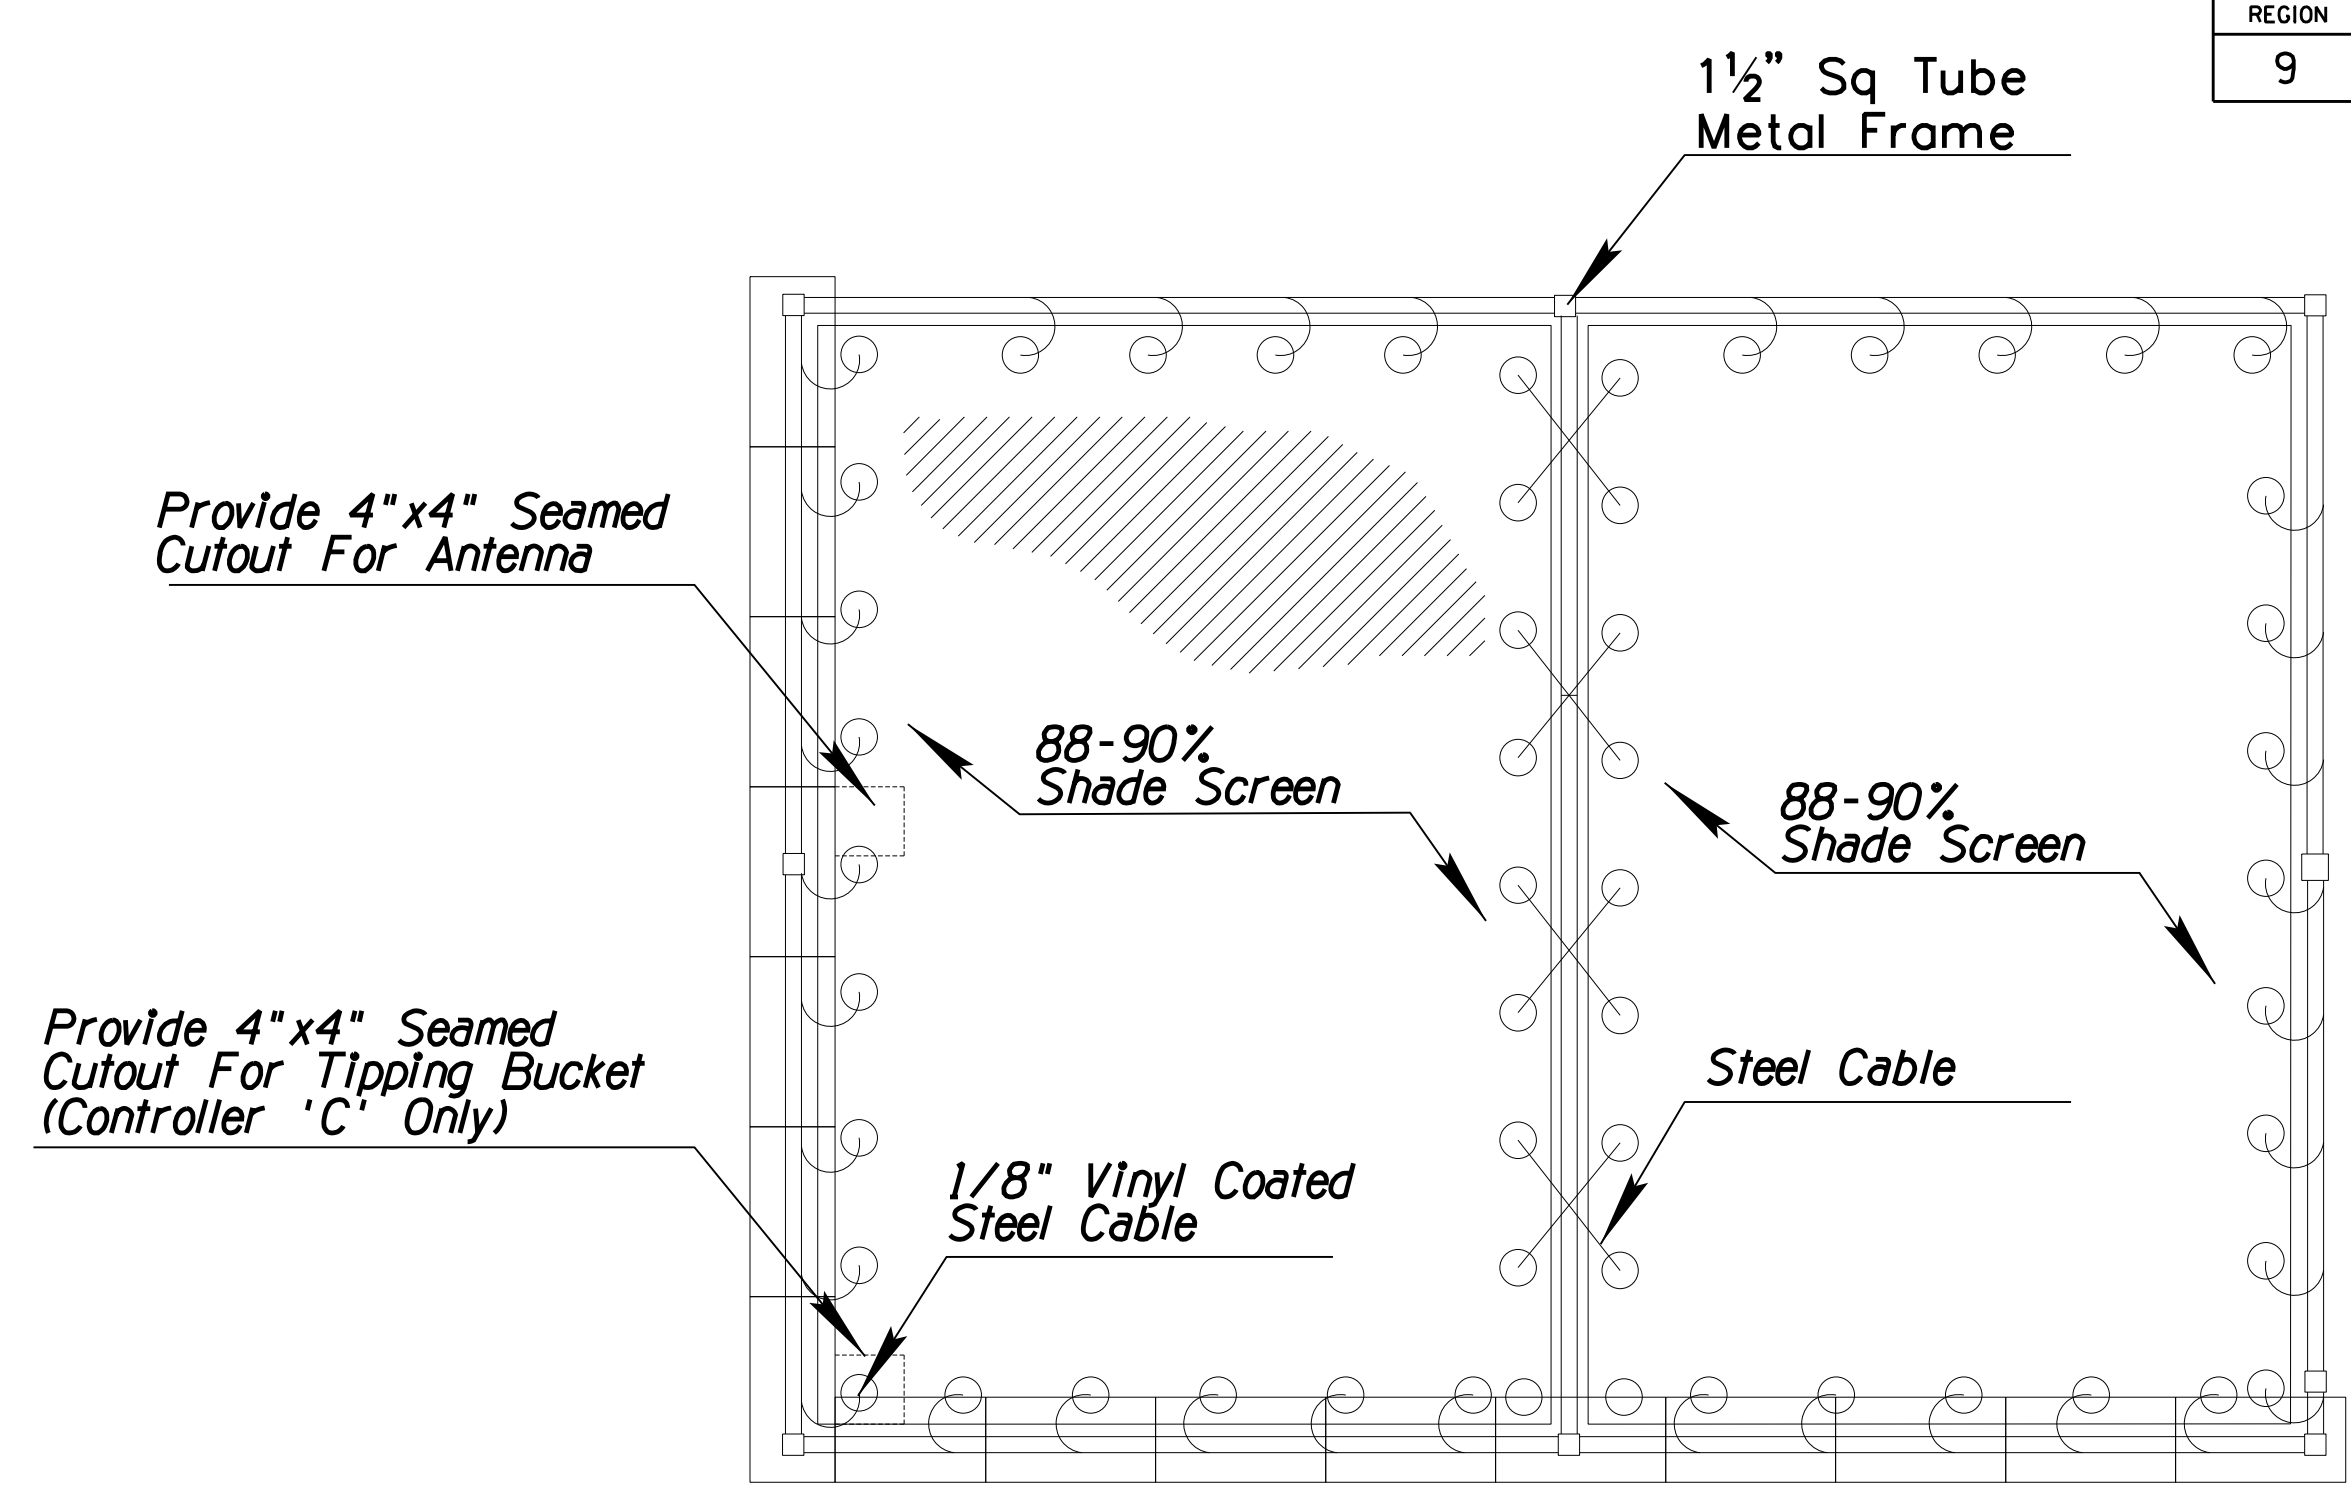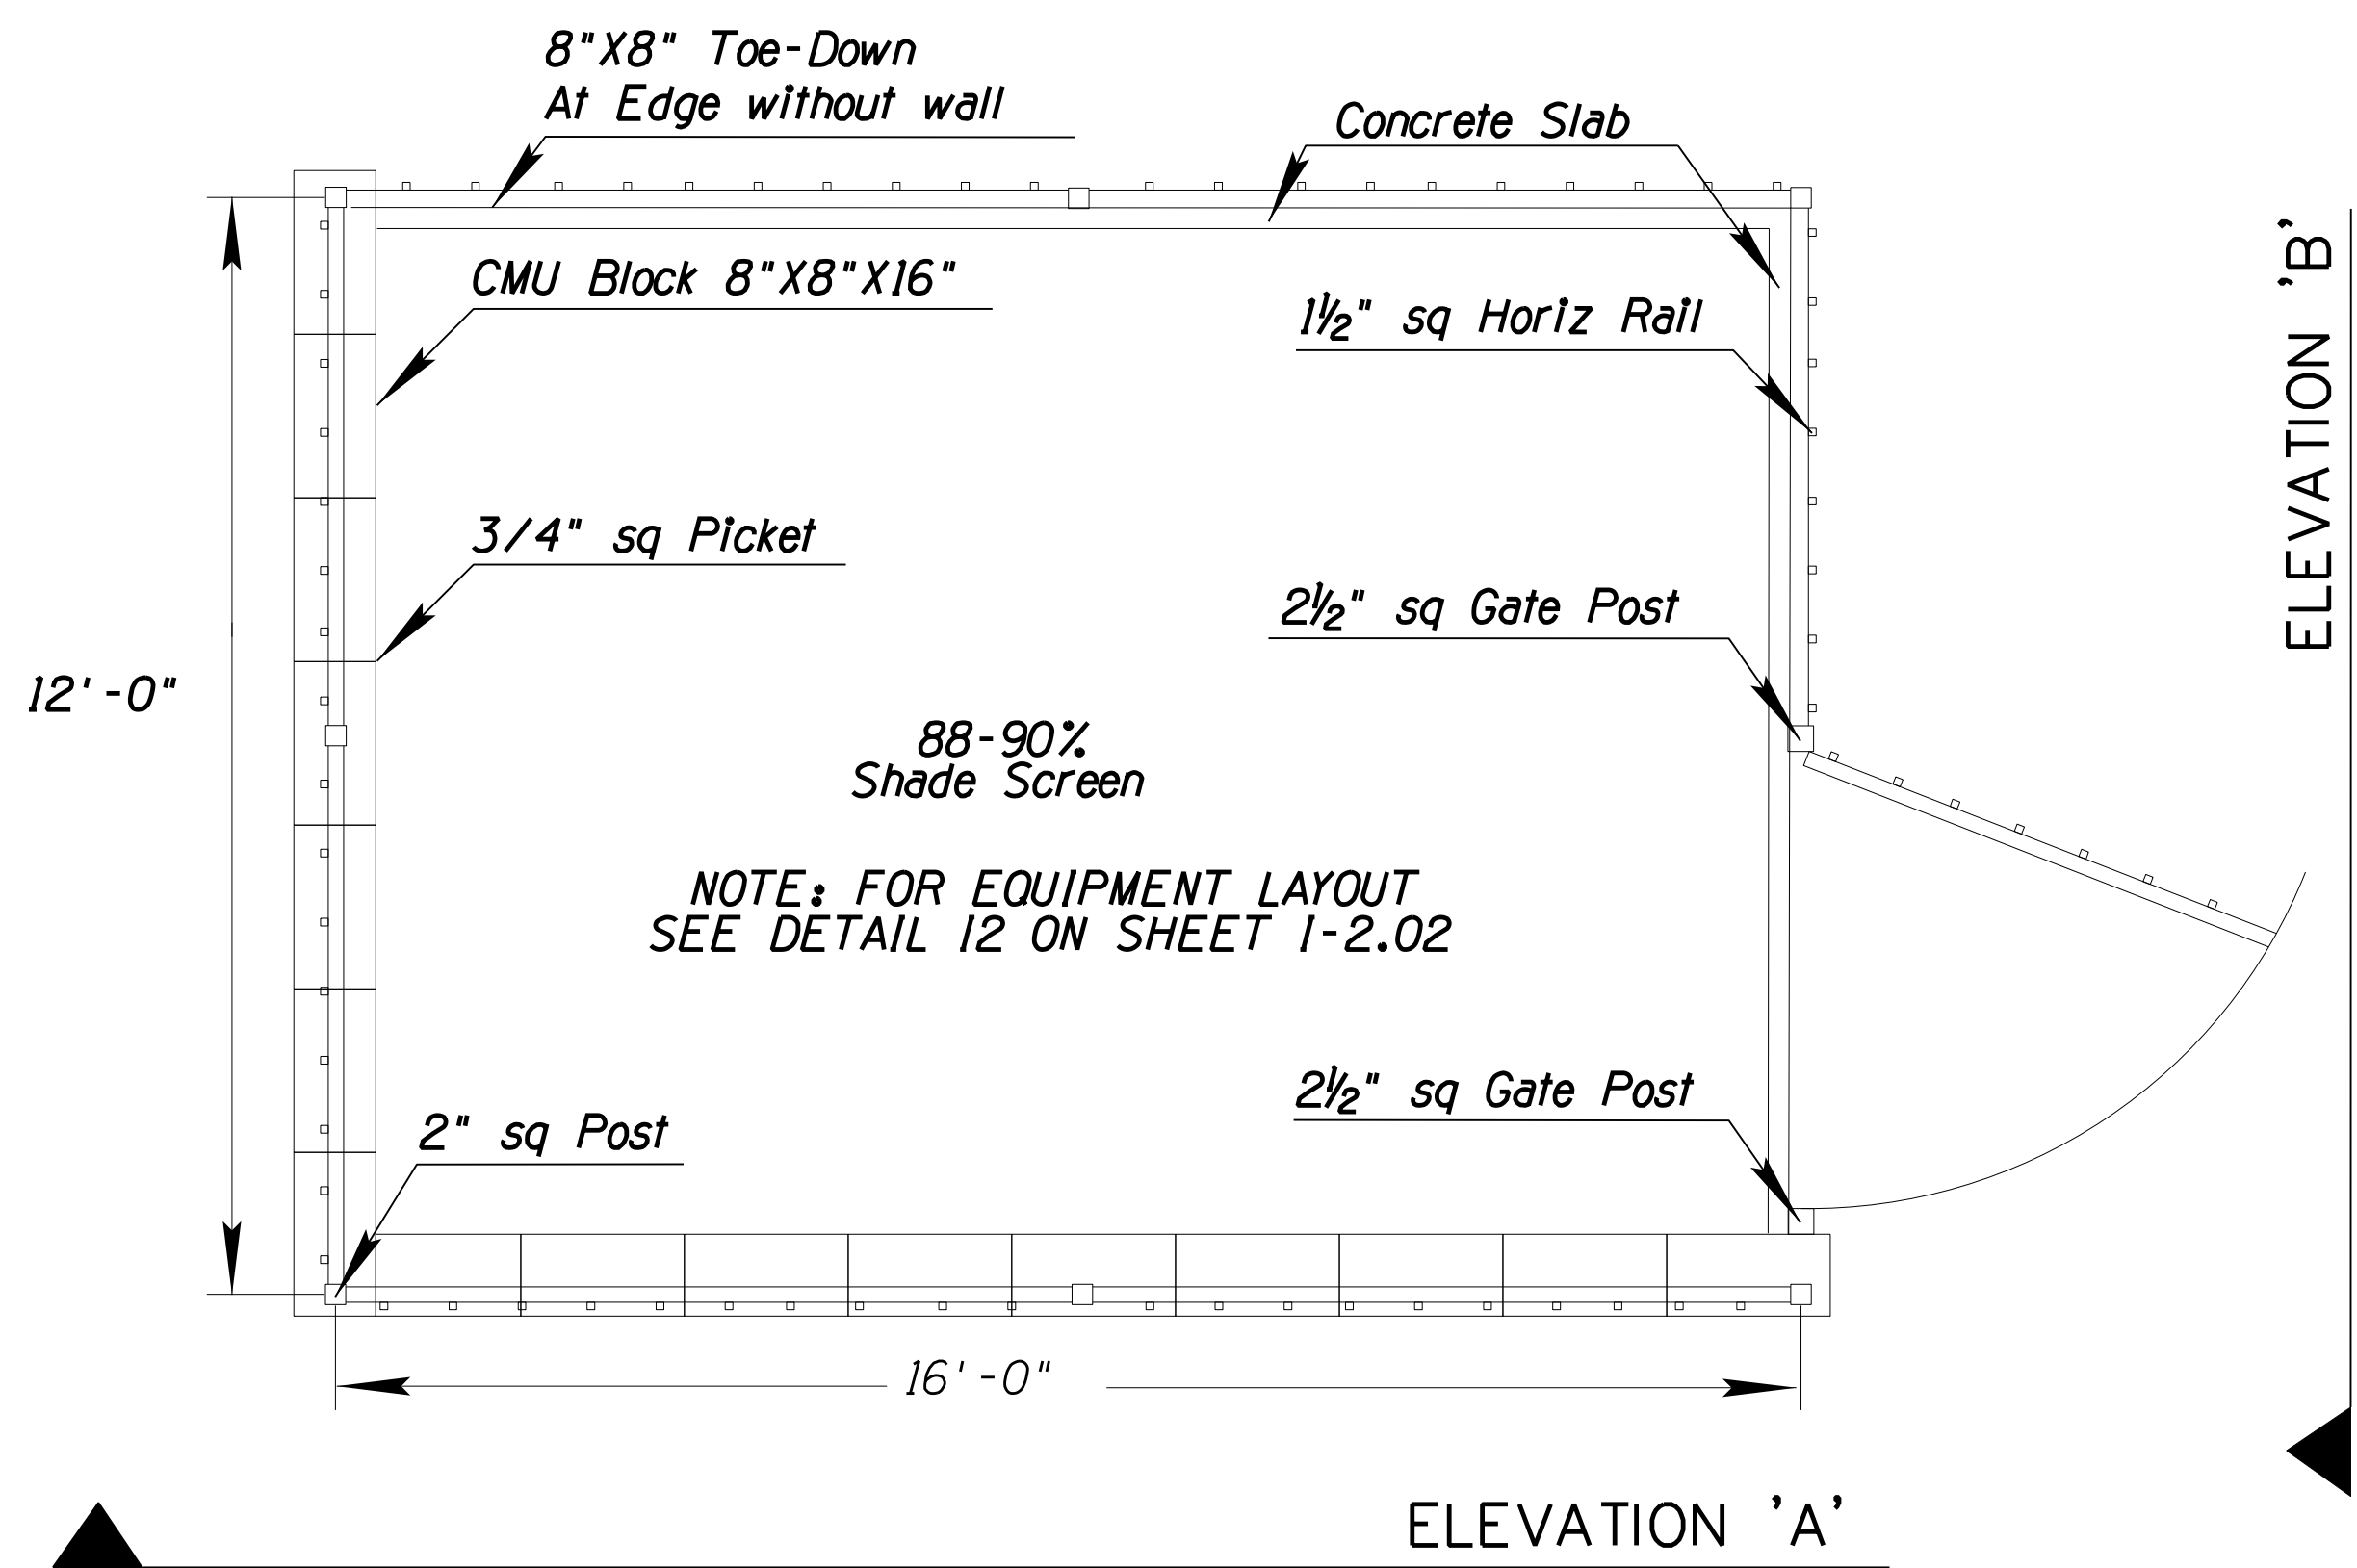

ELEVATION 'A'

# DETAIL 1

CONTROLLER ENCLOSURE

IRRIGATION CONSULTANT:  
 Carl Kominsky, RLA, ASIC  
 CARL KOMINSKY LANDSCAPE ARCHITECT, INC.  
 Tucson, Arizona  
 Phone: (520) 740-0700  
 Email: ckominsky@comcast.net


DESIGN	CK	NAME	DATE	ARIZONA DEPARTMENT OF TRANSPORTATION INFRASTRUCTURE DELIVERY AND OPERATIONS DIVISION ROADSIDE DEVELOPMENT SECTION
DRAWN	WDC		3/19	
CHECKED	CK/LEM		3/19	
<b>WHEAT DESIGN GROUP</b>		<b>IRRIGATION PLAN</b>		
LANDSCAPE ARCHITECTS		DETAIL SHEET		
ROUTE	LOCATION	RUTHRAUFF ROAD TI		DWG NO. I-3.01
I-10				
TRACS NO. H 8480 OIC		010-D(213)S		OF




REVISIONS- FINISHED PLANS- SURVEY NO. LOCATION- DATE-

F.H.W.A. REGION	STATE	PROJECT NO.	SHEET NO.	TOTAL SHEETS	RECORD DRAWING
9	ARIZ.	010-D(213)S	785	849	

010 PM 252

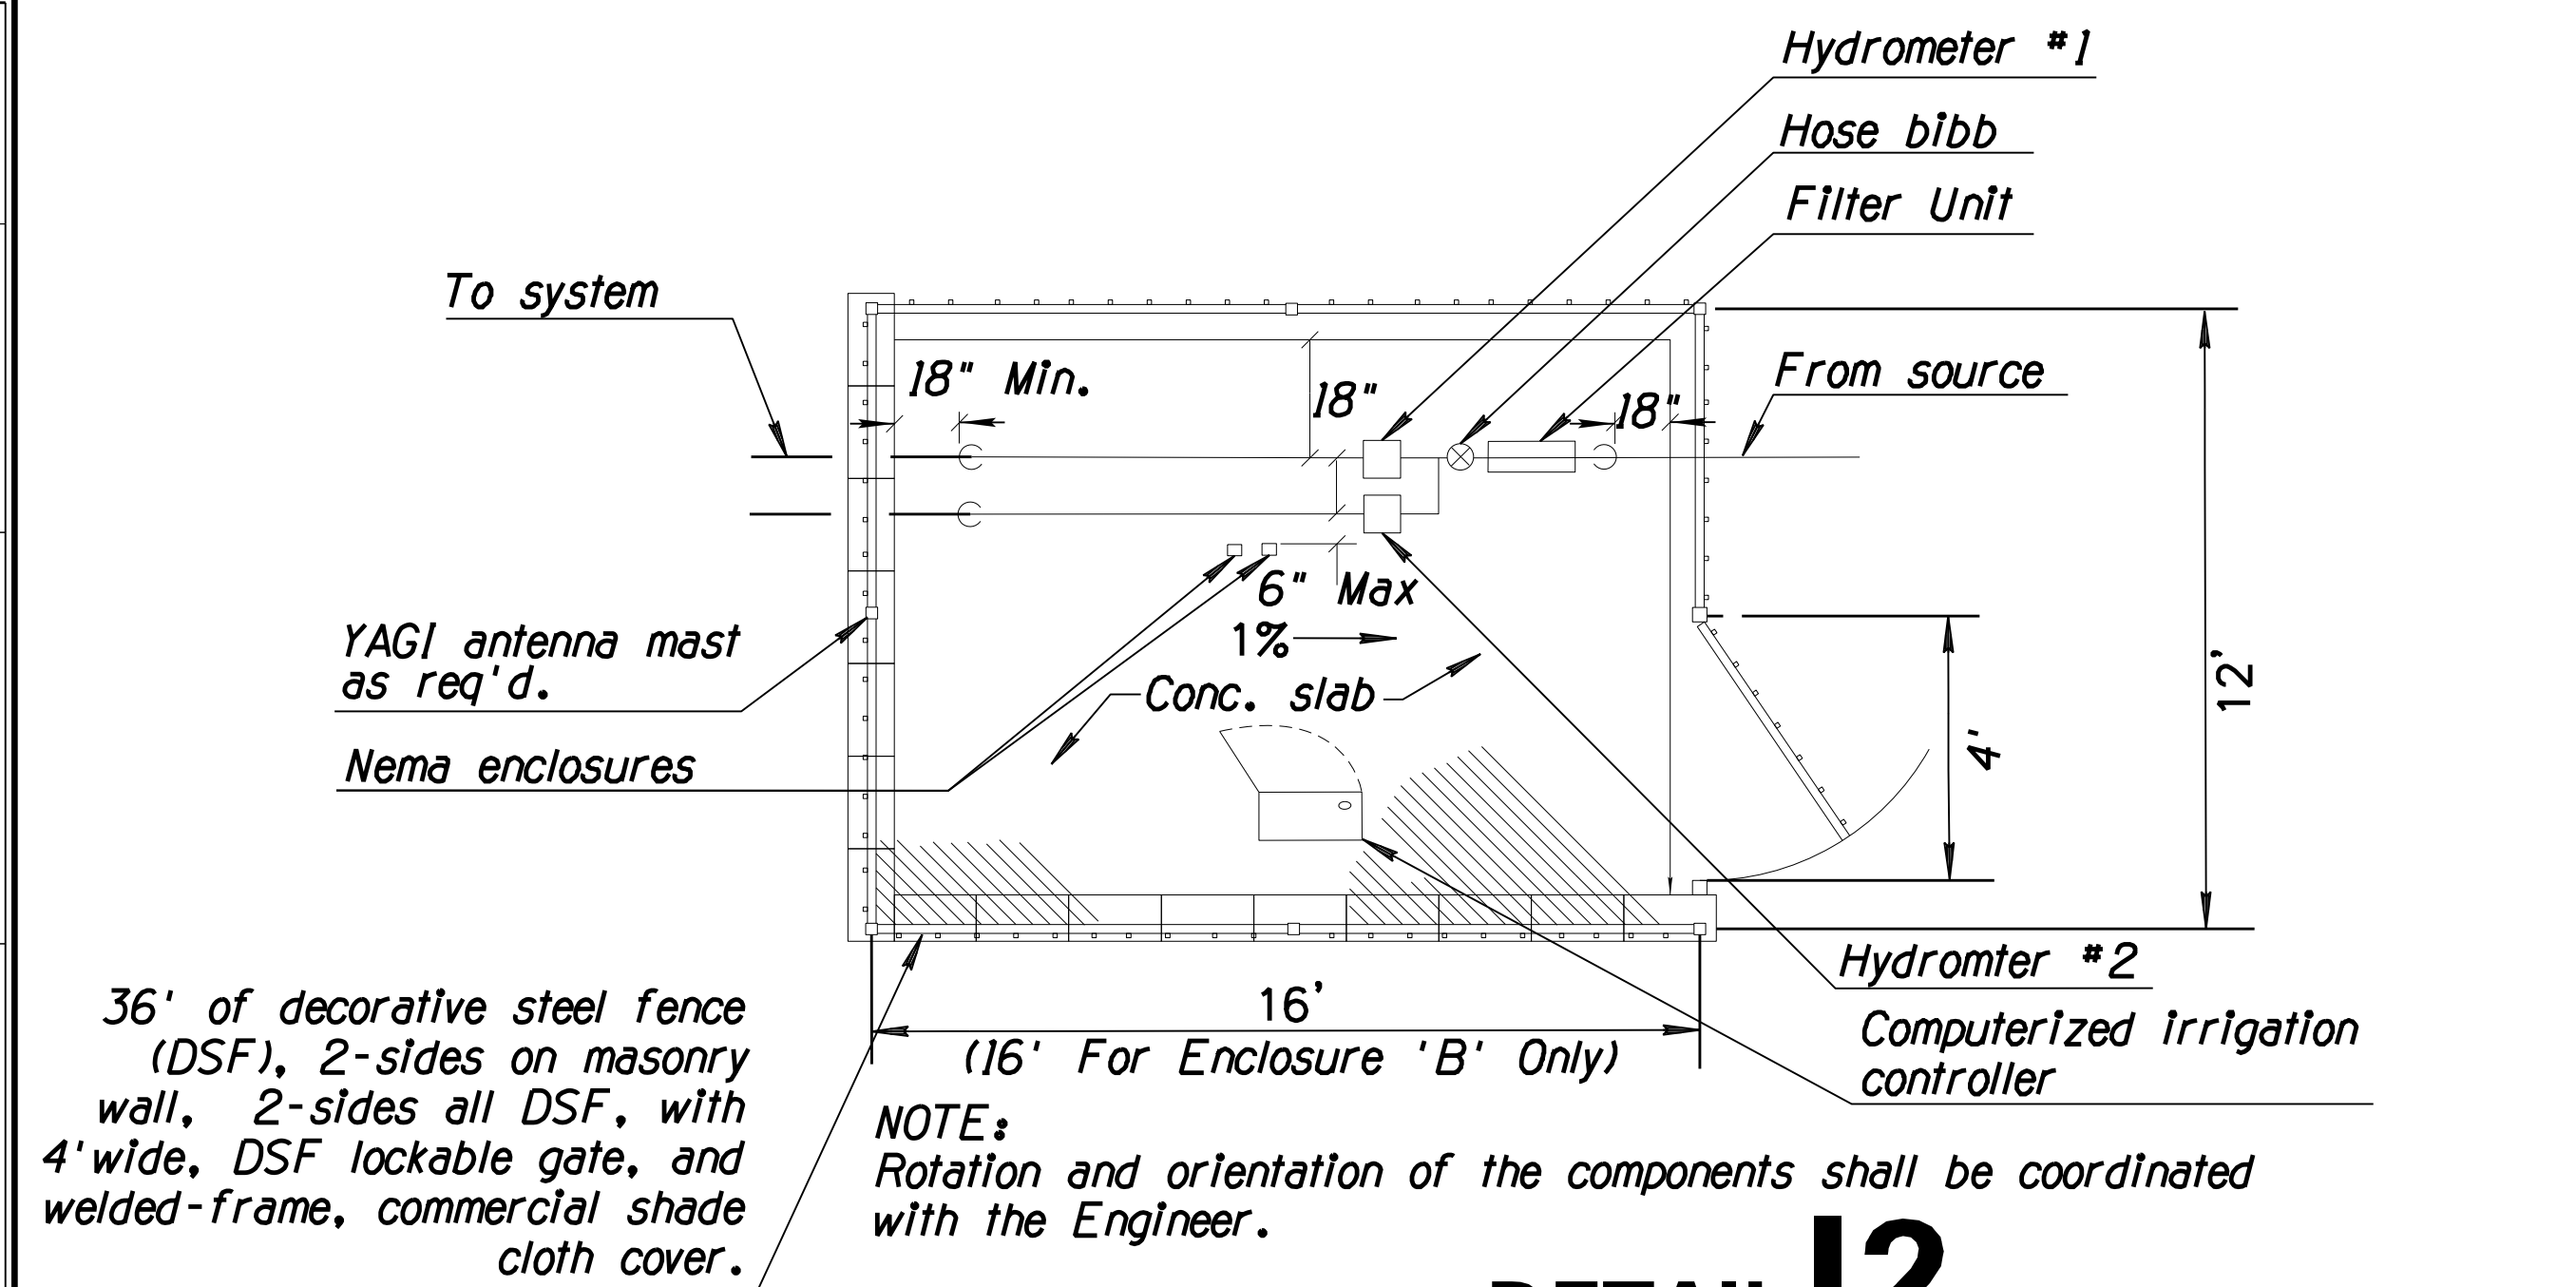


**DETAIL 12**  
DUAL MAINLINE CONTROLLER ENCLOSURE (ADOT)

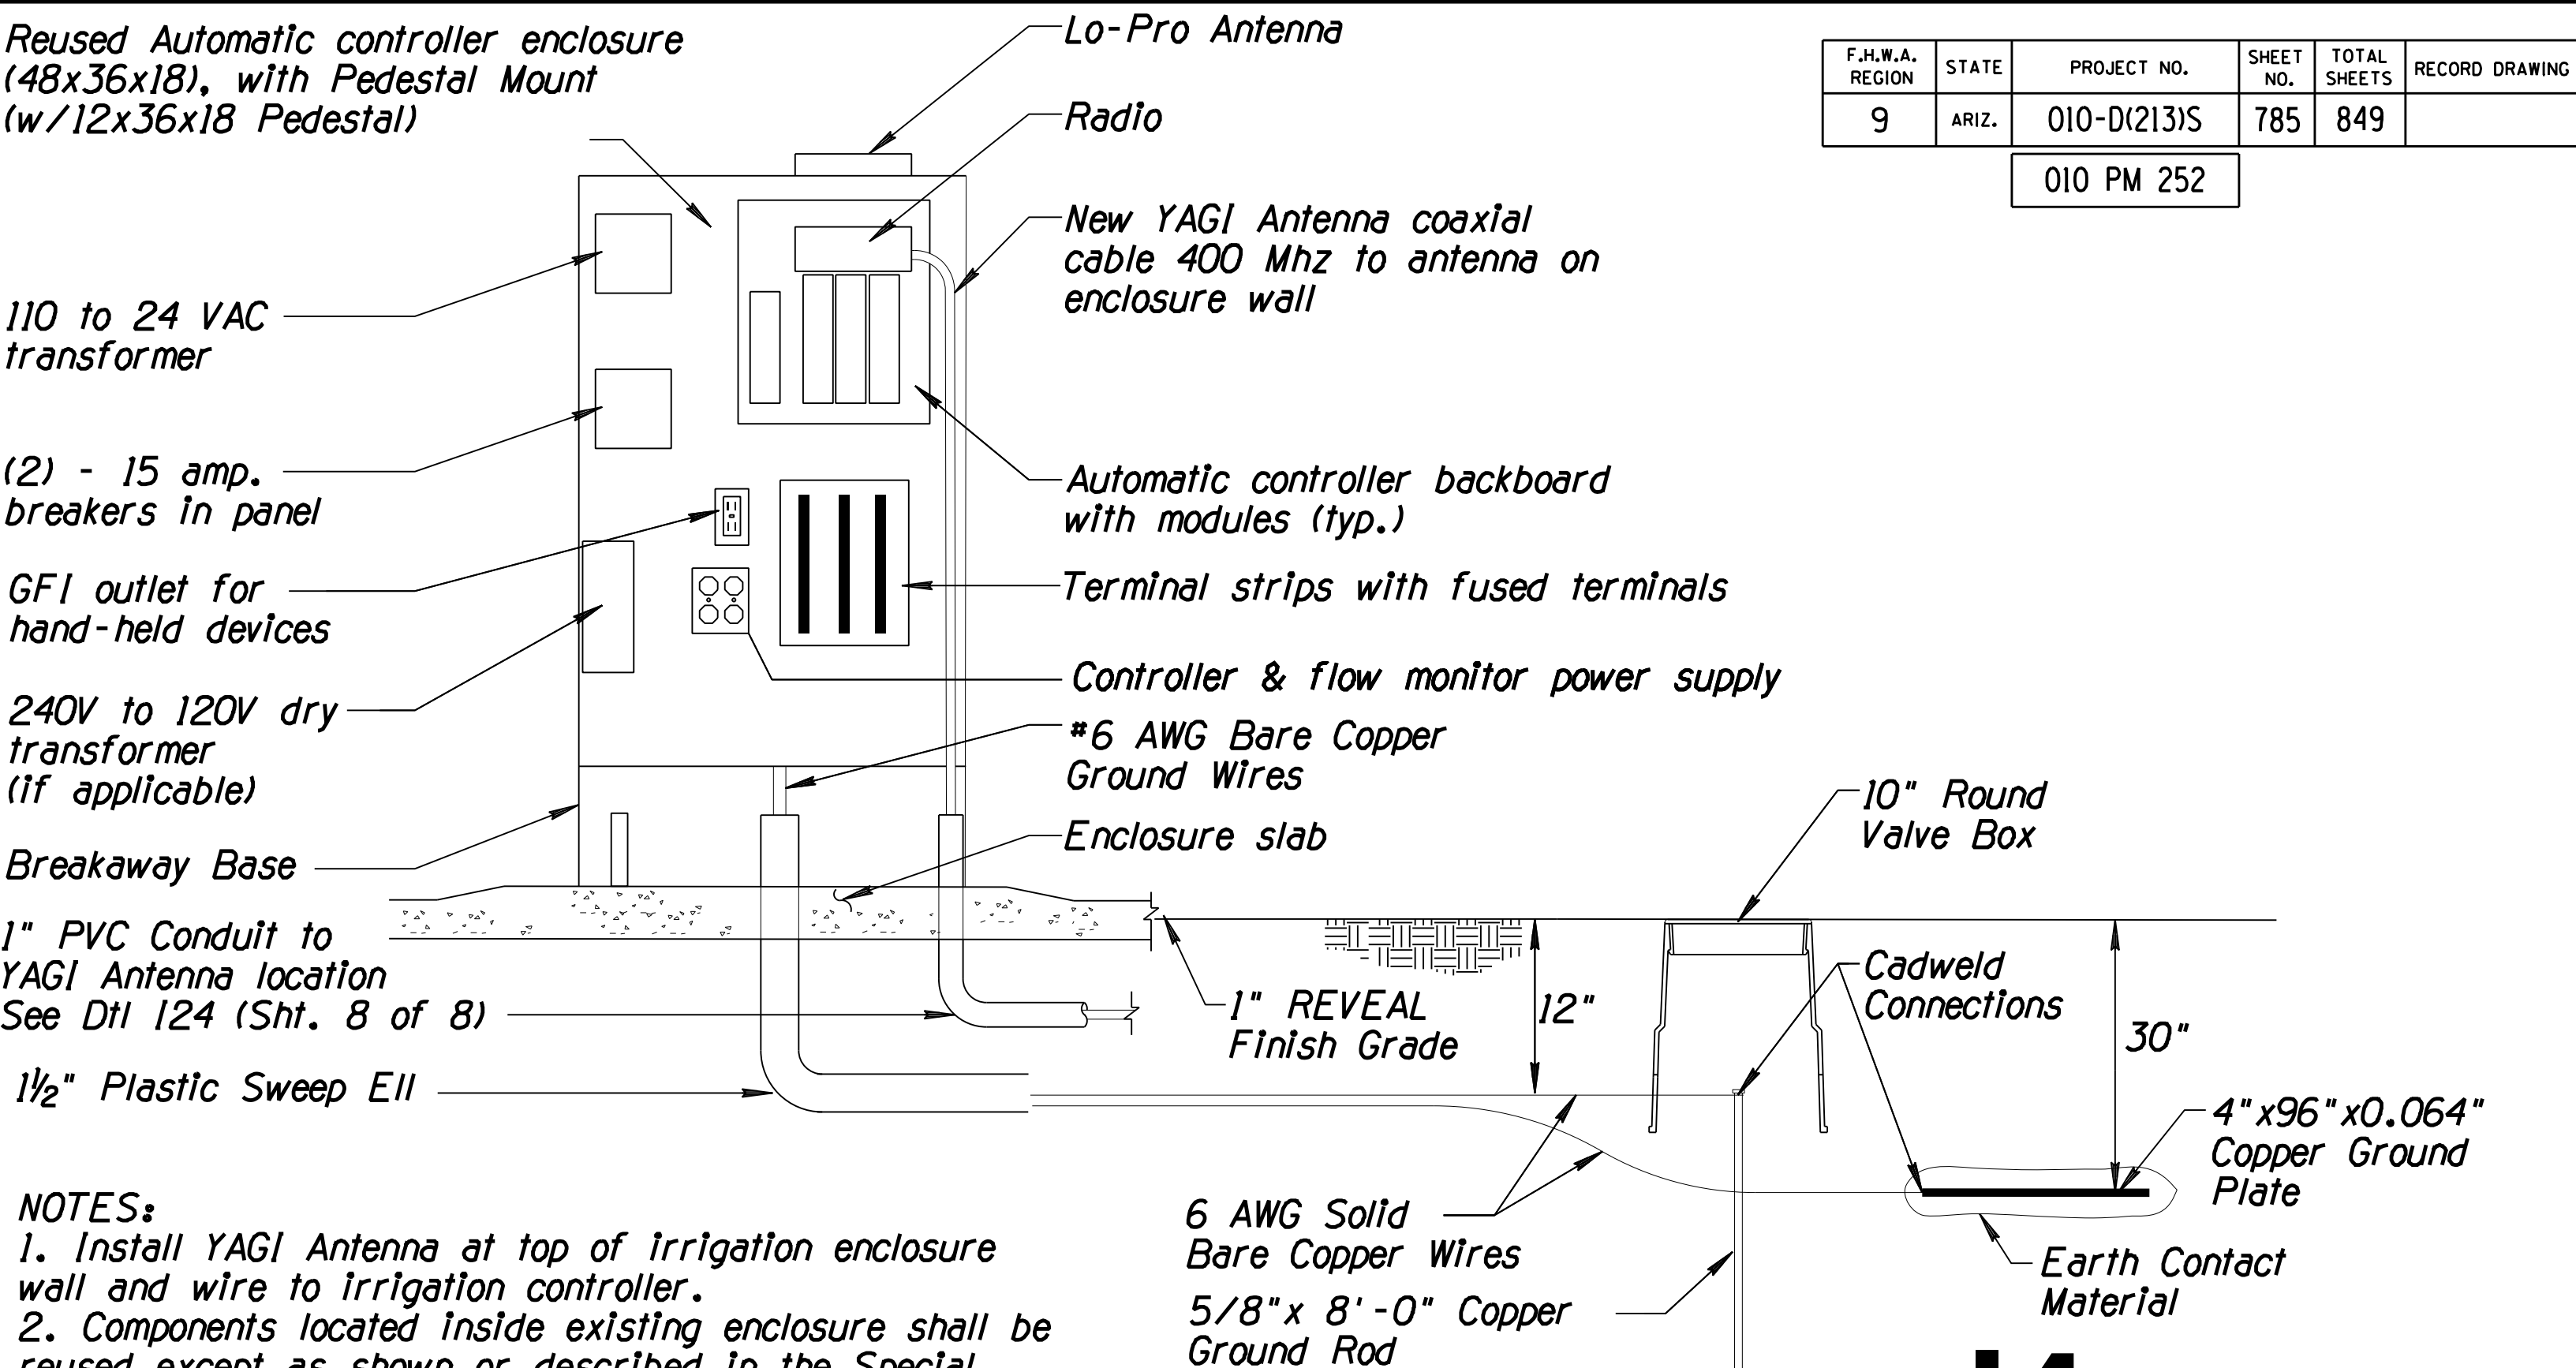

**DETAIL 14**  
CONTROLLER ENCLOSURE COMPONENTS (ADOT)

**NOTES:**  
 1. Install YAGI Antenna at top of irrigation enclosure wall and wire to irrigation controller.  
 2. Components located inside existing enclosure shall be reused except as shown or described in the Special Provisions.  
 3. The Enclosure and Components shall be removed and reinstalled as described in the Special Provisions.


Reused Automatic controller enclosure (48x36x18), with Pedestal Mount (w/12x36x18 Pedestal)

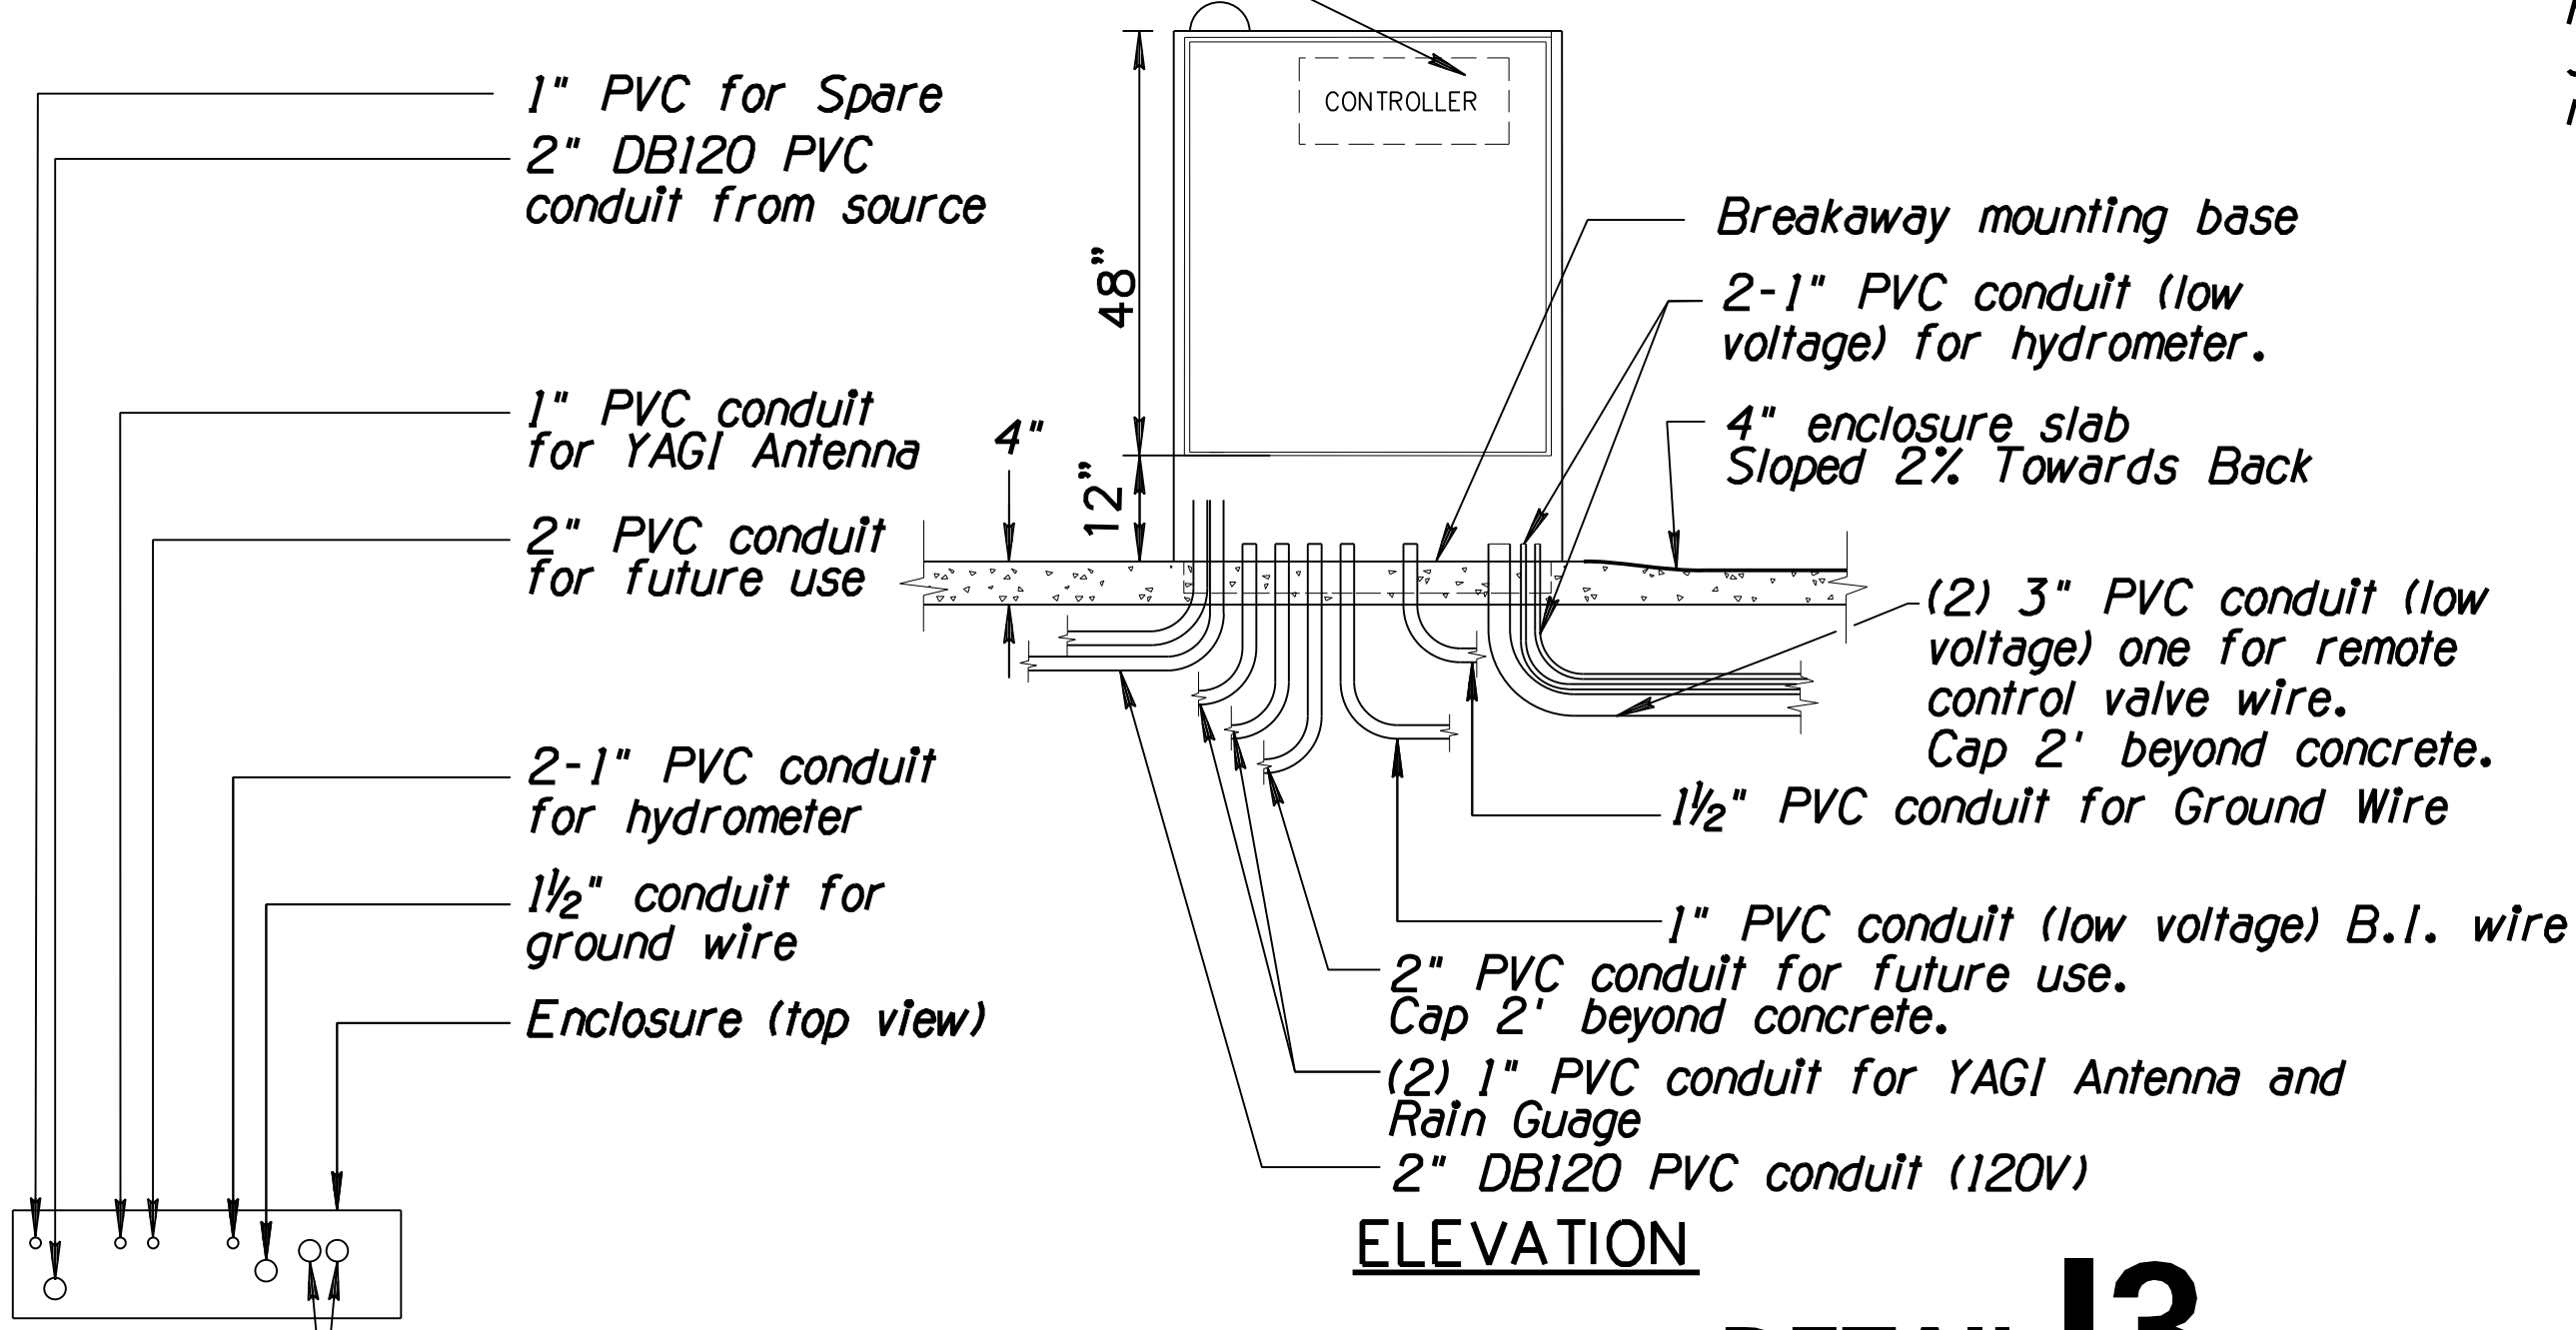

**DETAIL 13**  
CONTROLLER (ADOT)

**PLAN**

**Notes:**  
 1. Where possible, all wire shall be routed within conduit.  
 2. All wiring not in conduit shall be bundled.  
 3. All electric components and installations shall be in accordance with applicable codes.  
 4. All pipe to be Type K copper.  
 5. Test prior to final acceptance.  
 6. Stainless steel screen shall be 40 mesh for filter.  
 7. See Irrigation Summary & Project Specifications for sizes, approved manufacturers, model numbers, and colors of all equipment.  
 8. Two parallel assemblies required for ADOT Enclosure.

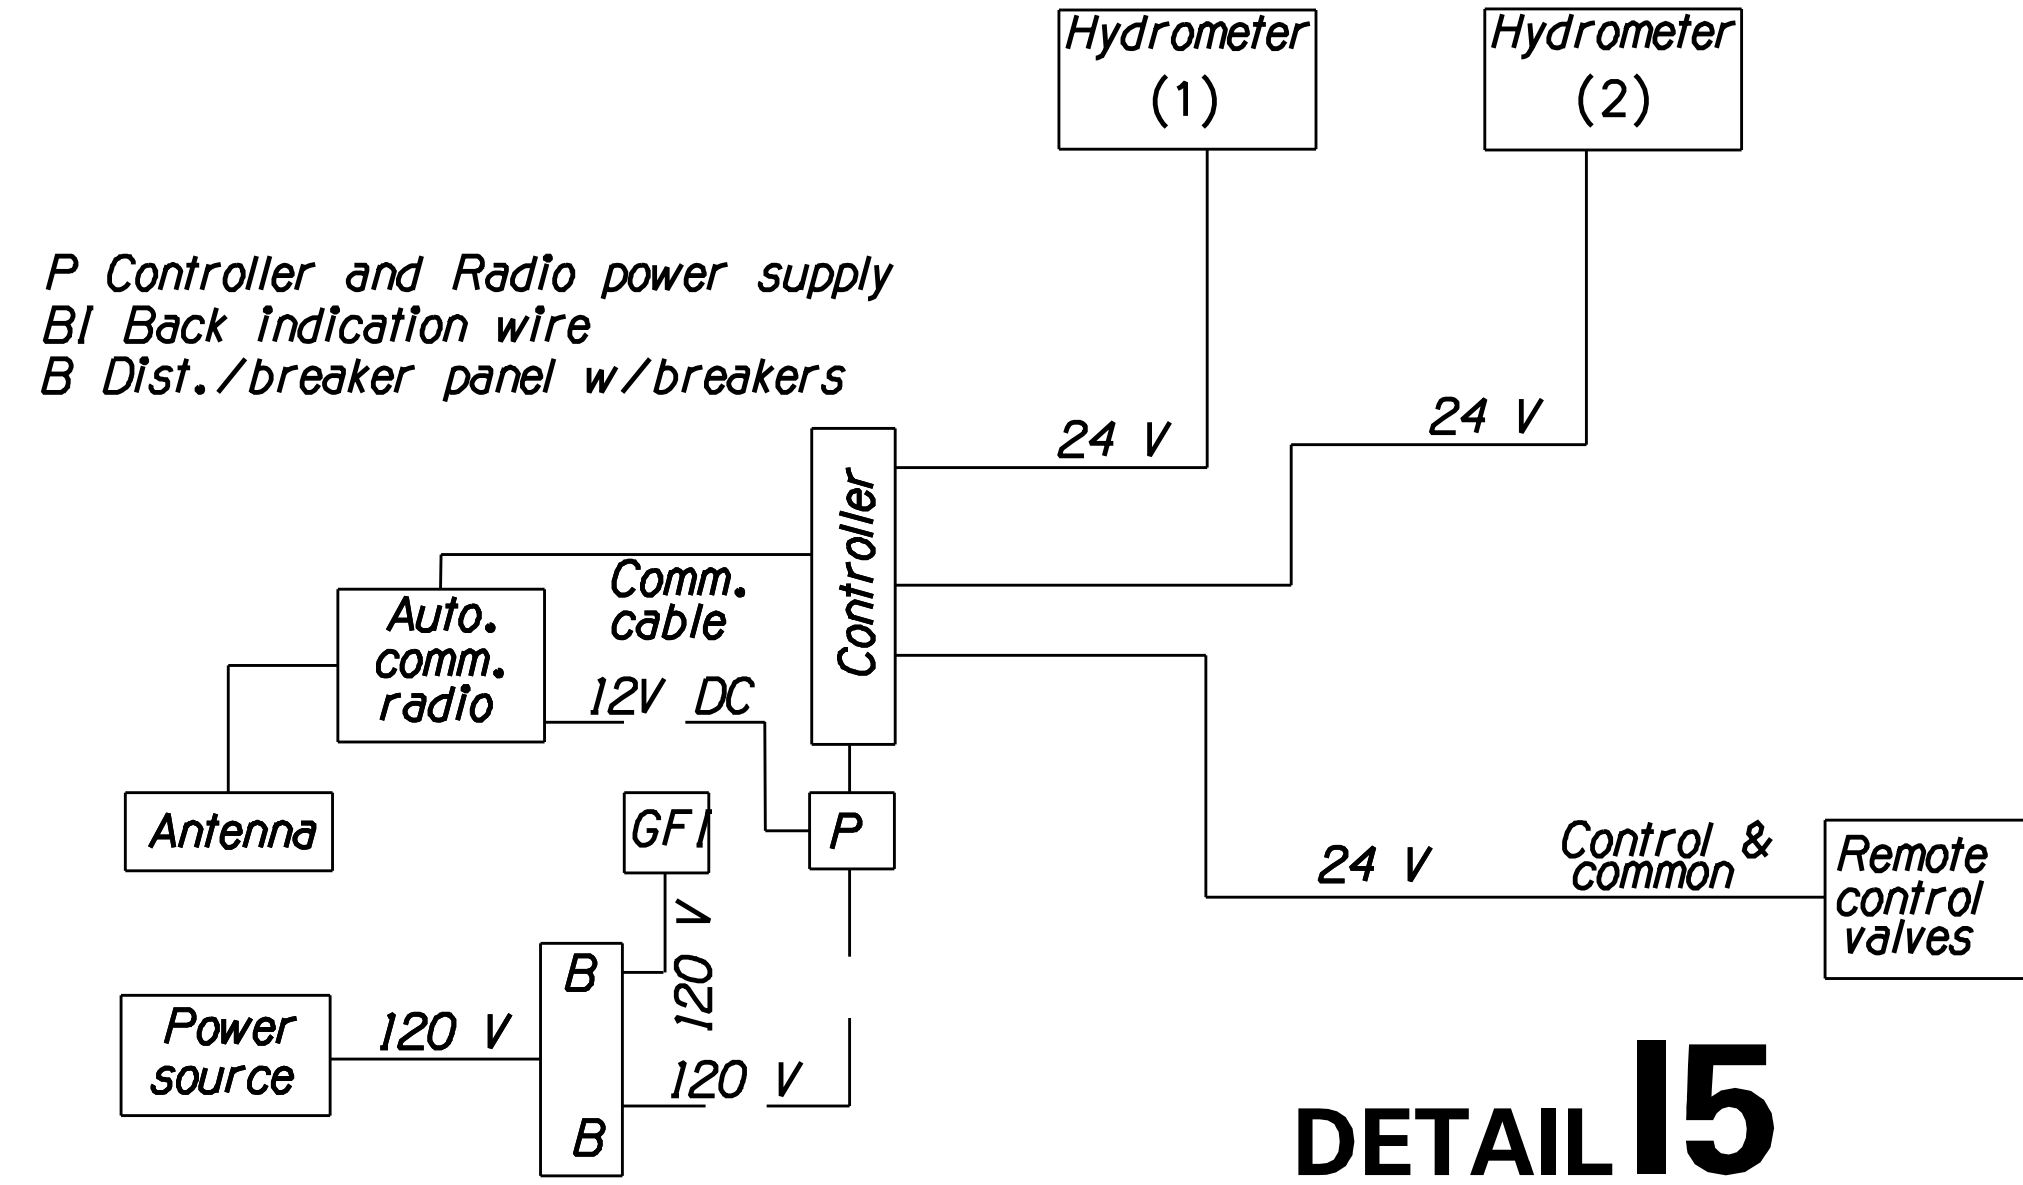

**DETAIL 15**  
CONTROL SYSTEM FLOW CHART (ADOT)

IRRIGATION CONSULTANT:  
 Carl Kominsky, RLA, ASIC  
 CARL KOMINSKY LANDSCAPE ARCHITECT, INC.  
 Tucson, Arizona  
 Phone: (520) 740-0700  
 Email: ckominsky@comcast.net



DESIGN	NAME	DATE	ARIZONA DEPARTMENT OF TRANSPORTATION INFRASTRUCTURE DELIVERY AND OPERATIONS DIVISION ROADSIDE DEVELOPMENT SECTION
CK		3/19	<b>WHEAT DESIGN GROUP</b> LANDSCAPE ARCHITECTS 500 N TUCSON BLVD, SUITE 150, TUCSON AZ 85716
WDC		3/19	
CK/LEM		3/19	
ROUTE: I-10 LOCATION: RUTHRAUFF ROAD TI			<b>IRRIGATION PLAN DETAIL SHEET</b>
TRACS NO. H 8480 OIC			



DWG NO. I-3.02  
 OF

F.H.W.A. REGION	STATE	PROJECT NO.	SHEET NO.	TOTAL SHEETS	RECORD DRAWING
9	ARIZ.	010-D(213)S	786	849	

010 PM 252

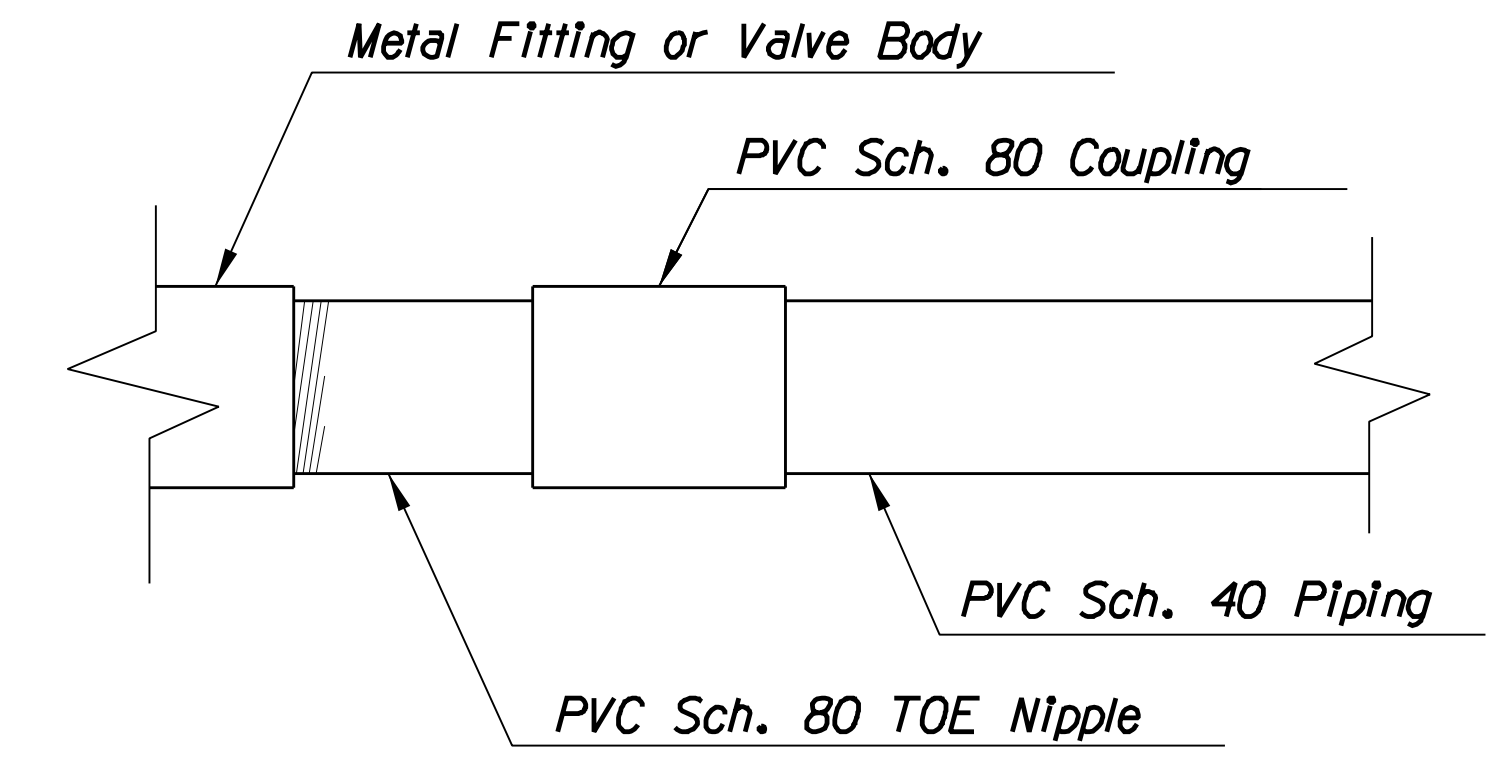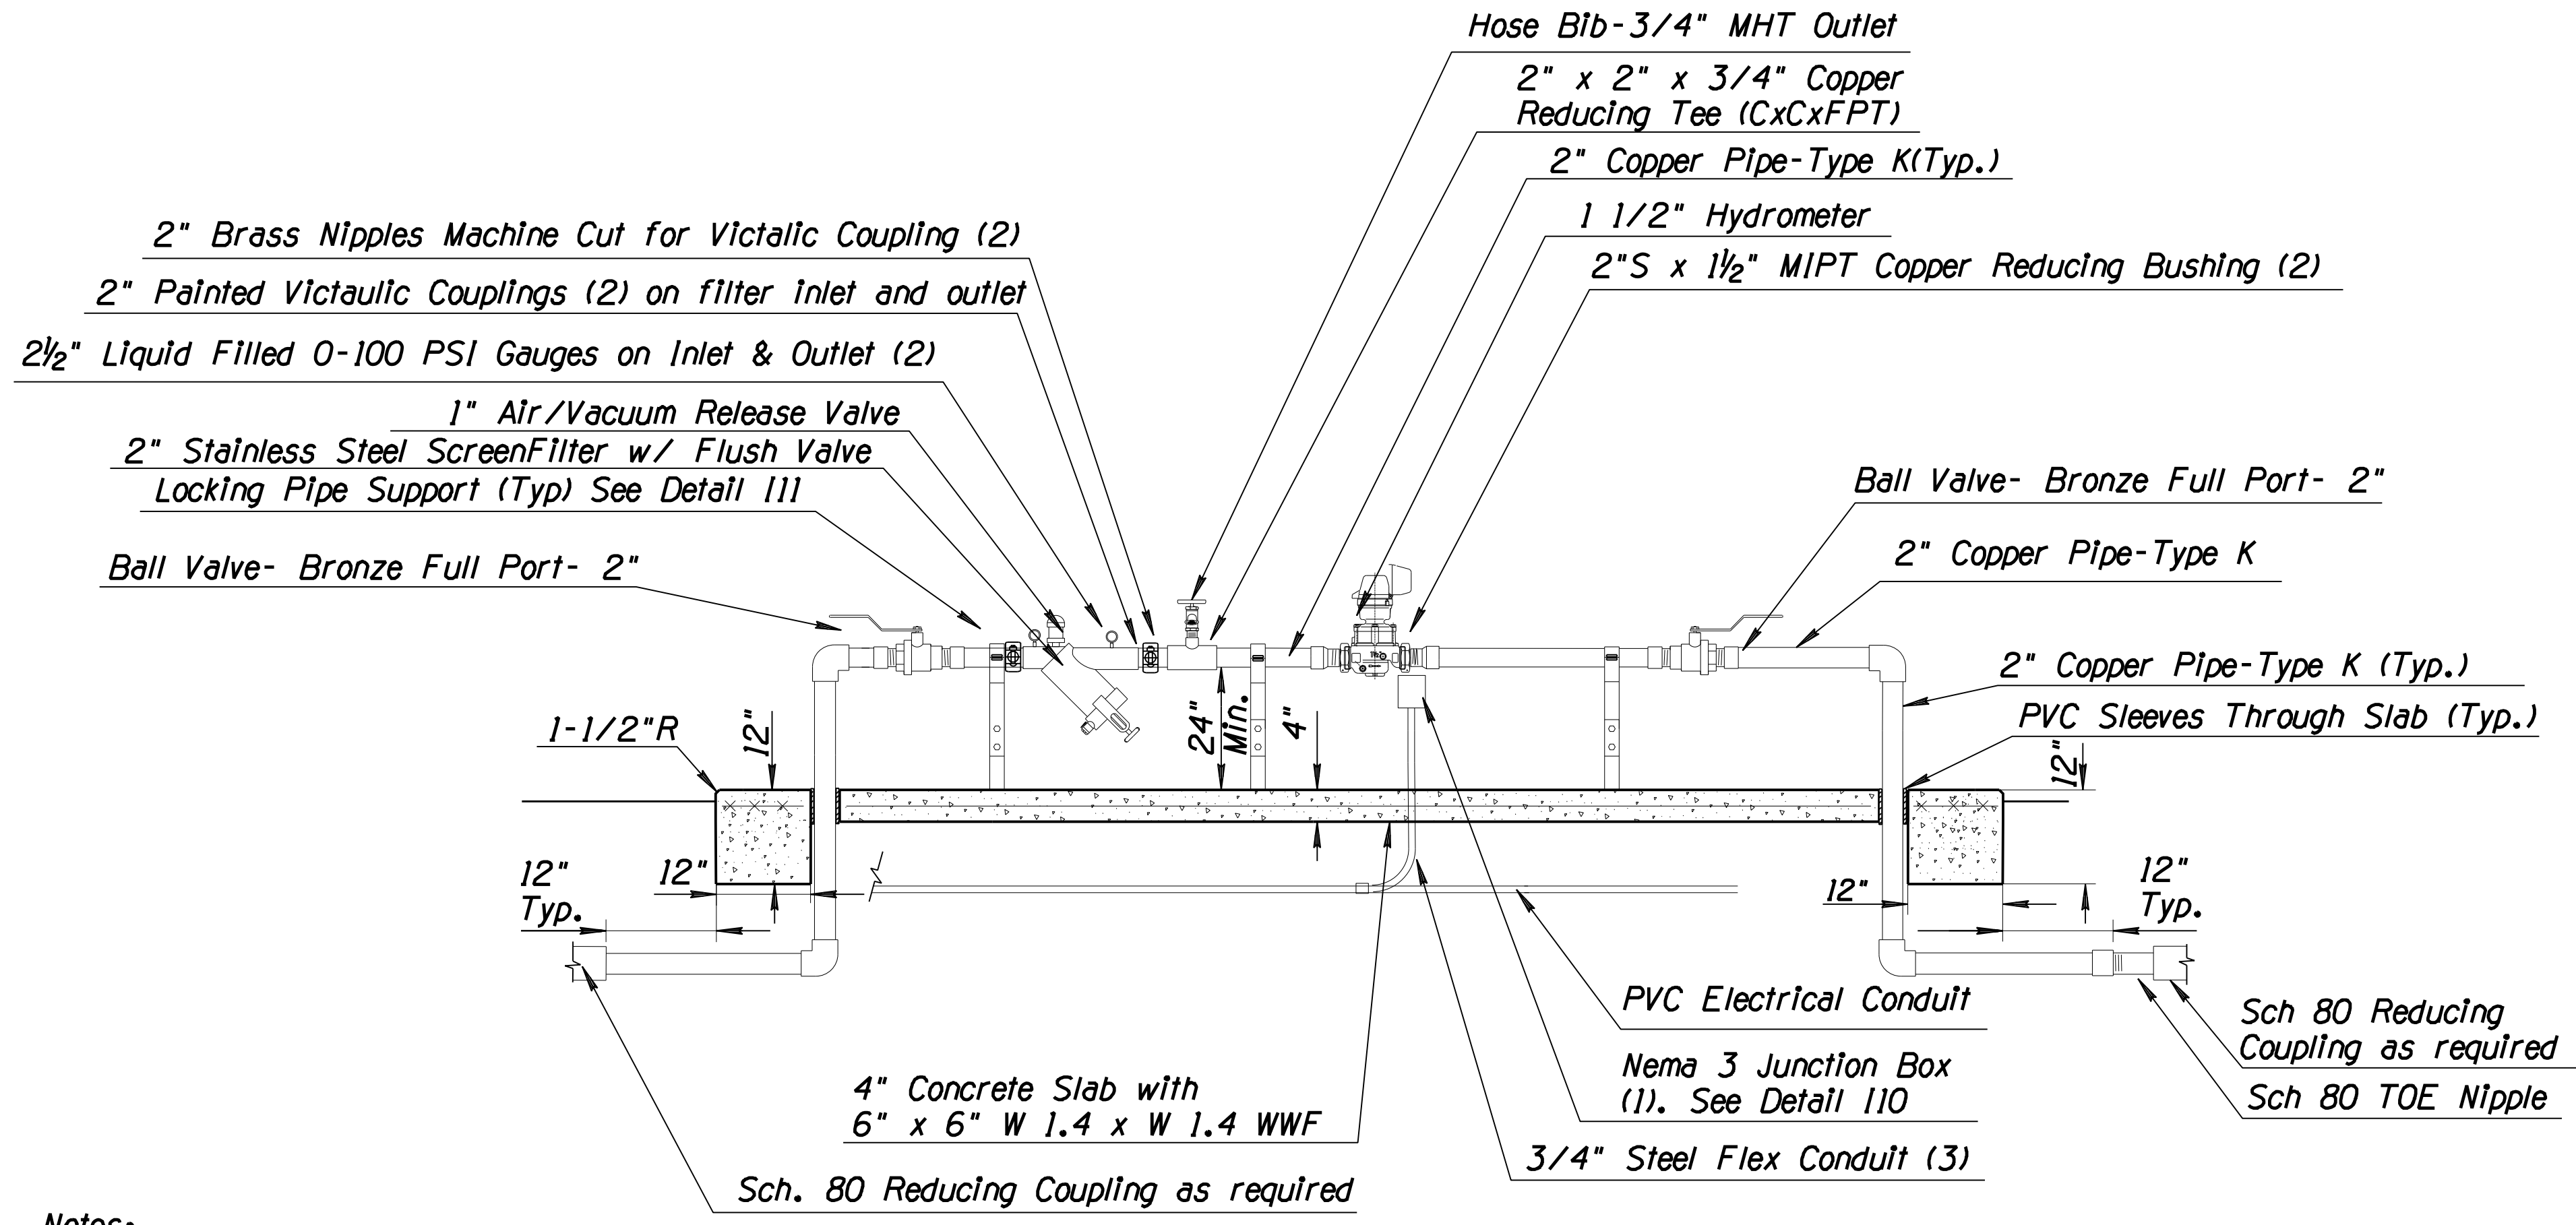


Note:  
This detail applies to all PVC-to-Metal connections throughout the project.


**DETAIL 18**  
PVC TO METAL CONNECTION DETAIL

- Notes:
1. Where possible, all wire shall be routed within conduit.
  2. All wiring not in conduit shall be bundled.
  3. All electric components and installations shall be in accordance with applicable codes.
  4. All pipe to be Type K copper.
  5. Test prior to final acceptance.
  6. Stainless steel screen shall be 40 mesh for filter.
  7. See Irrigation Summary & Project Specifications for sizes, approved manufacturers, model numbers, and colors of all equipment.
  8. Two parallel assemblies required for ADOT Enclosure.

**DETAIL 16**  
HYDROMETER/FILTER ASSEMBLY

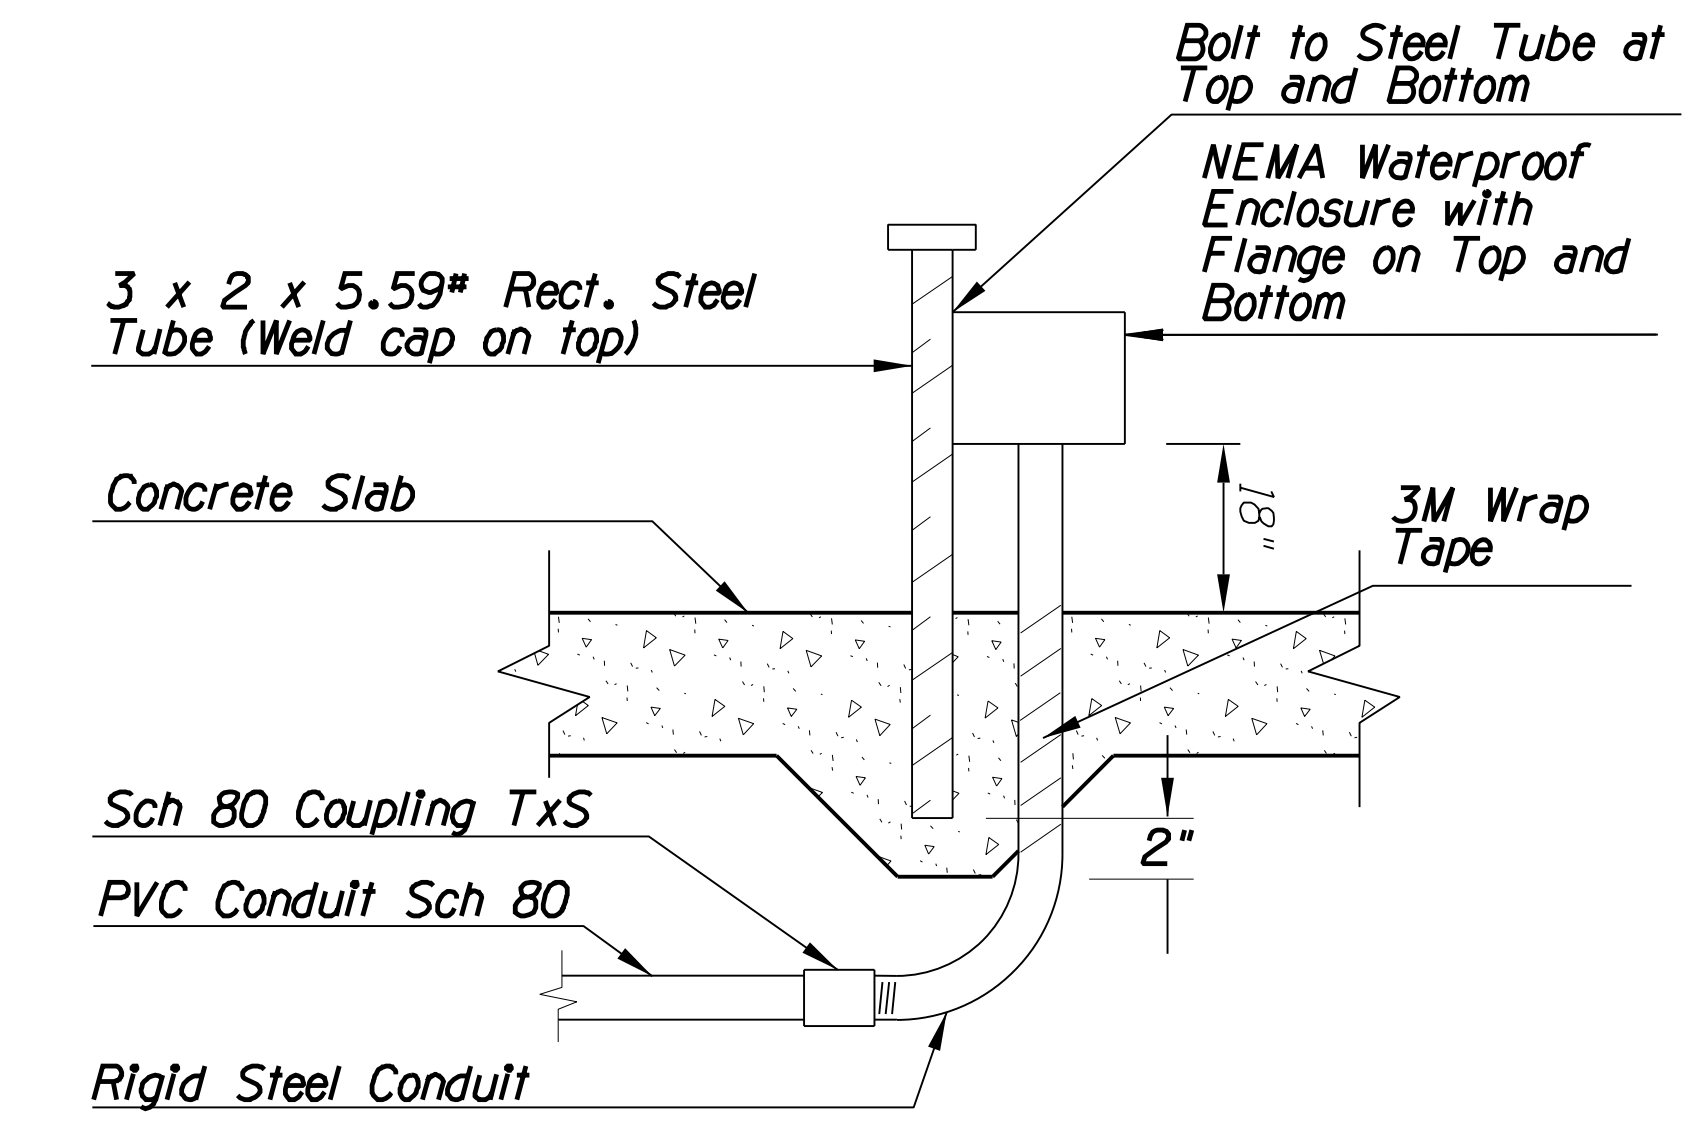


**DETAIL 19**  
NEMA BOX (ADOT)

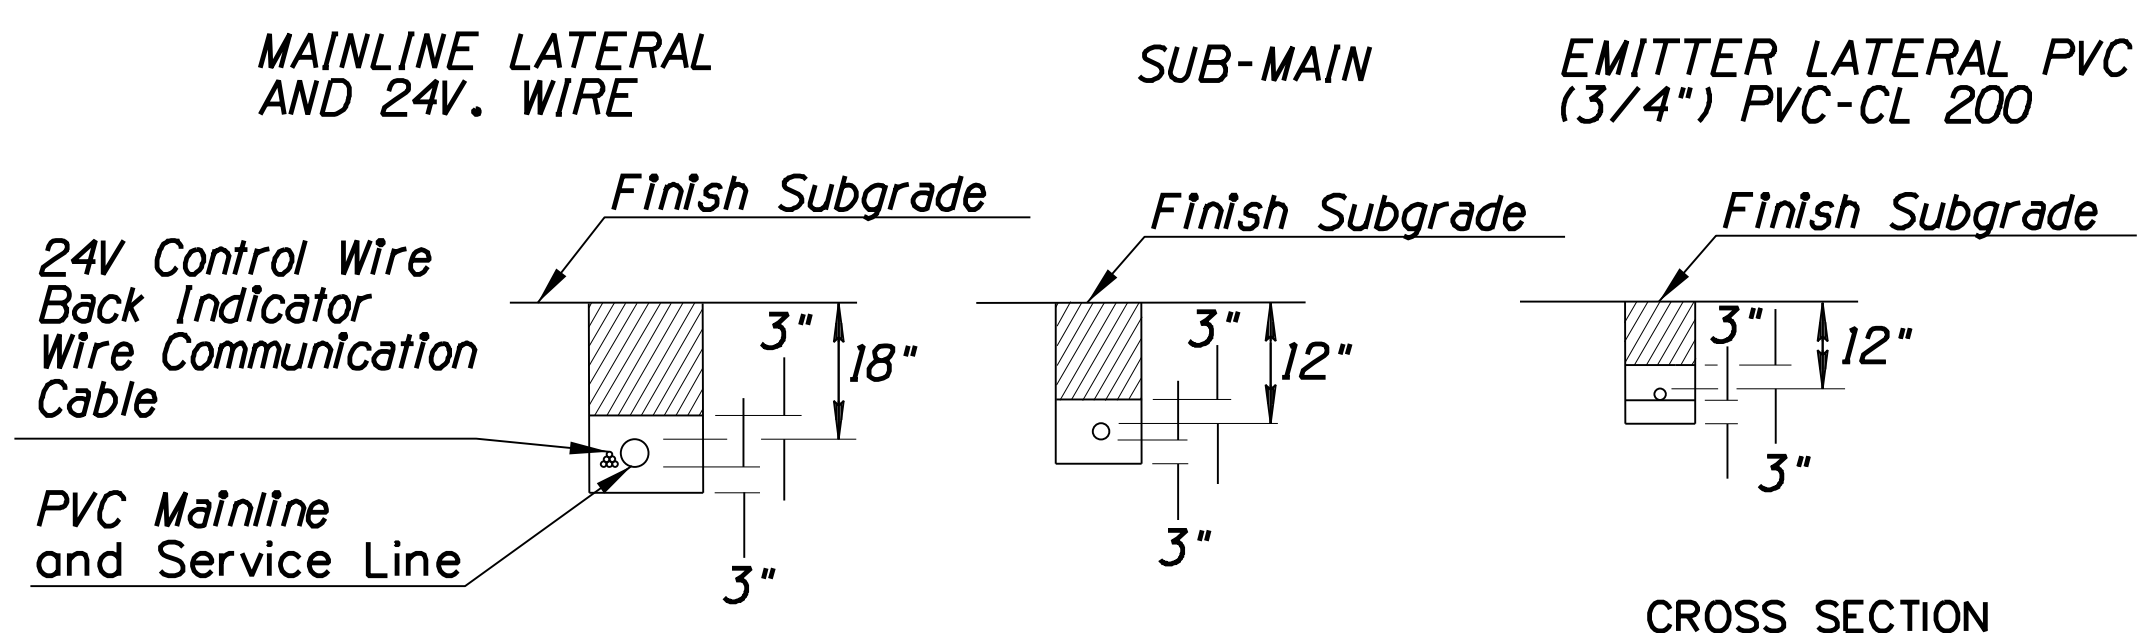

Excavated Material  
Bedding & Cover Material


- Notes:
1. Trench width may vary with number of pipes in trench and soil type. Provide a min. of 2" clearance to side of trench and between pipes both vertically and horizontally.
  2. Where two mainlines are shown in the same trench, place lines at same depth and maintain 3" separation between mainlines.
  3. Magnetic tape/locator wire shall be installed in all supply line/mainline locations where there is no control wire.

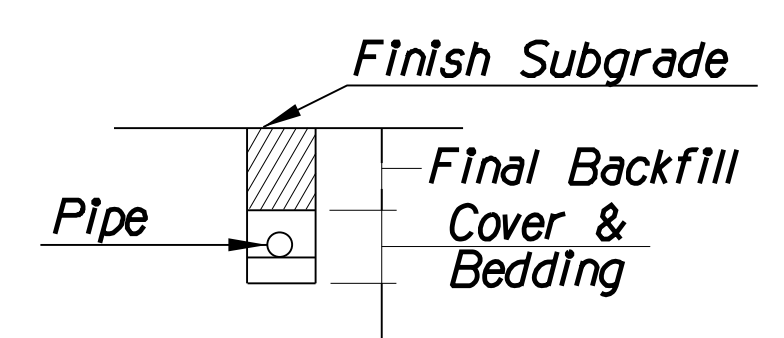

**DETAIL 17**  
TRENCHING CROSS SECTION

IRRIGATION CONSULTANT:  
Carl Kominsky, RLA, ASIC  
CARL KOMINSKY LANDSCAPE ARCHITECT, INC.  
Tucson, Arizona  
Phone: (520) 740-0700  
Email: ckominsky@comcast.net

DESIGN	CK	DATE	3/19	ARIZONA DEPARTMENT OF TRANSPORTATION INFRASTRUCTURE DELIVERY AND OPERATIONS DIVISION ROADSIDE DEVELOPMENT SECTION
DRAWN	WDC	DATE	3/19	
CHECKED	CK/LEM	DATE	3/19	
<b>WHEAT DESIGN GROUP</b>		LANDSCAPE ARCHITECTS		IRRIGATION PLAN DETAIL SHEET
500 N TUCSON BLVD, SUITE 150, TUCSON AZ 85716				
ROUTE	LOCATION		RUTHRAUFF ROAD T1	
TRACS NO. H 8480 OIC		010-D(213)S		DWG NO. 1-3.03

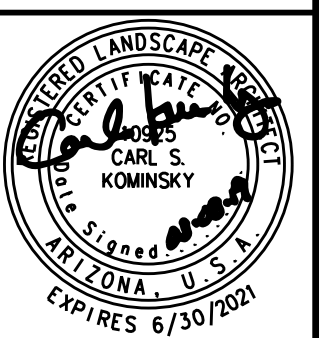






F.H.W.A. REGION	STATE	PROJECT NO.	SHEET NO.	TOTAL SHEETS	RECORD DRAWING
9	ARIZ.	010-D(213)S	788	849	

010 PM 252

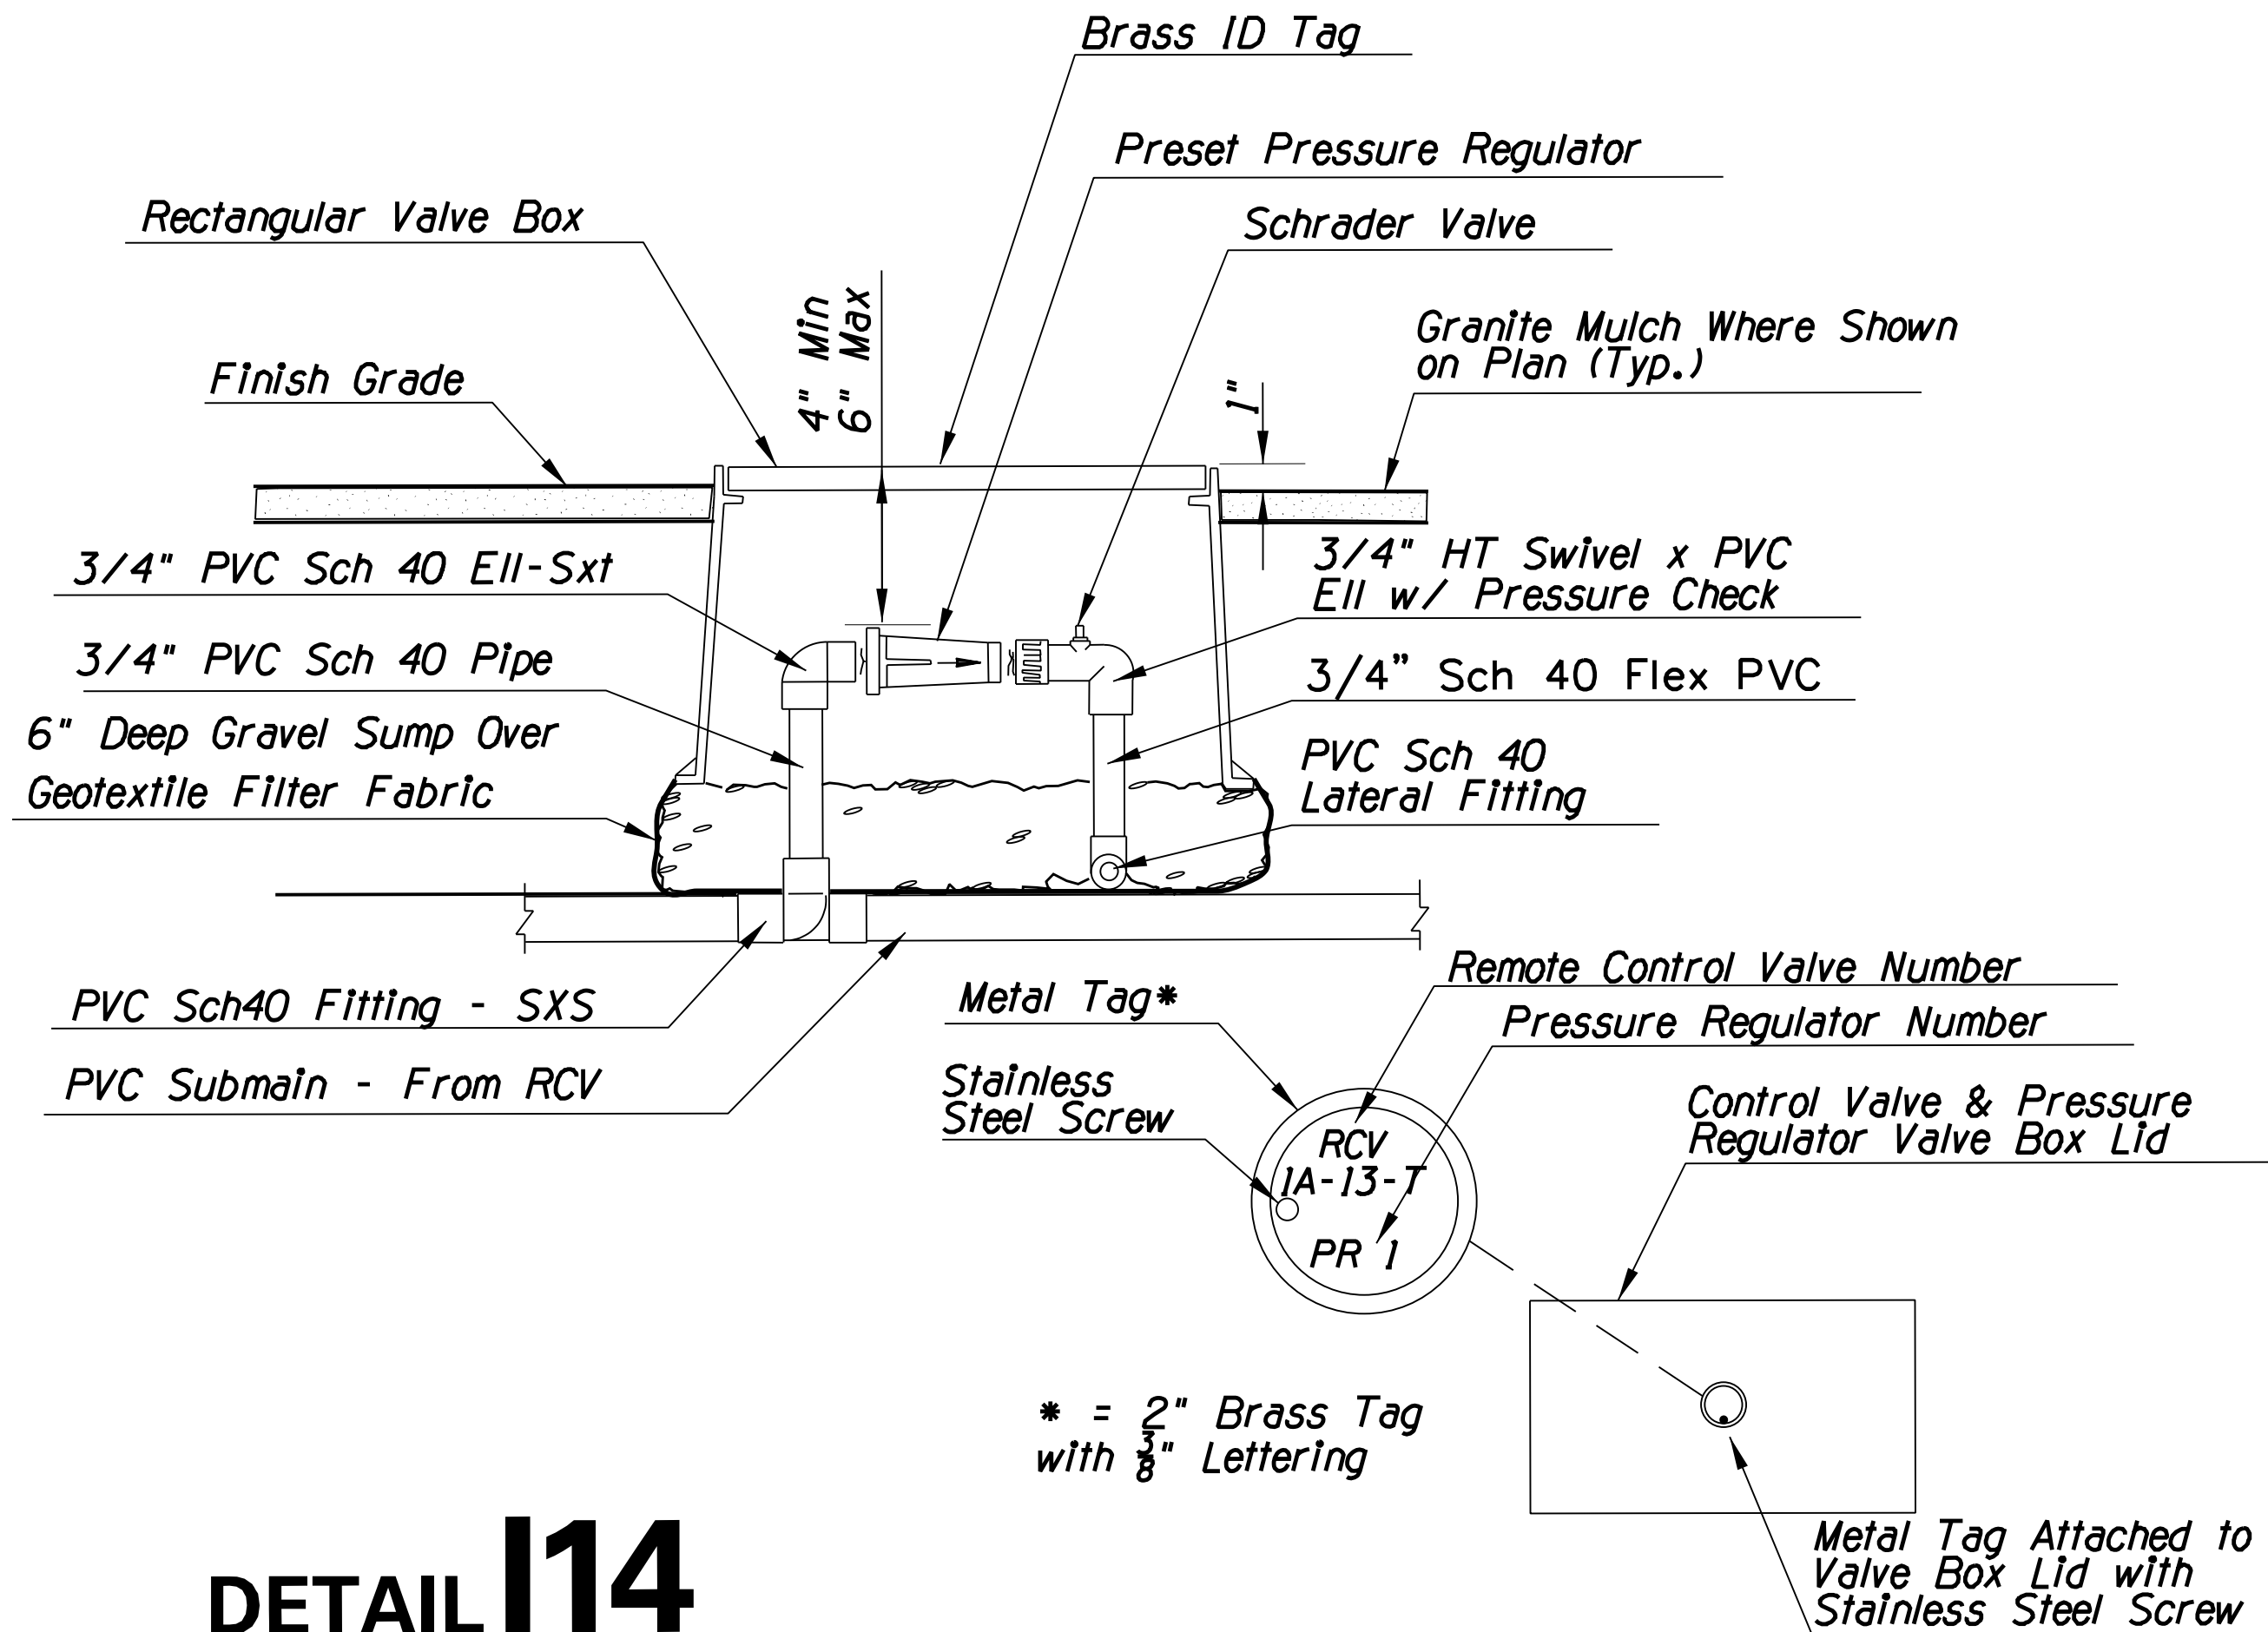


# DETAIL 14

PRESSURE REGULATOR RISER (ADOT)

REMOTE CONTROL AND PRESSURE REGULATOR VALVE IDENTIFICATION


\* = 2" Brass Tag with 3/8" Lettering

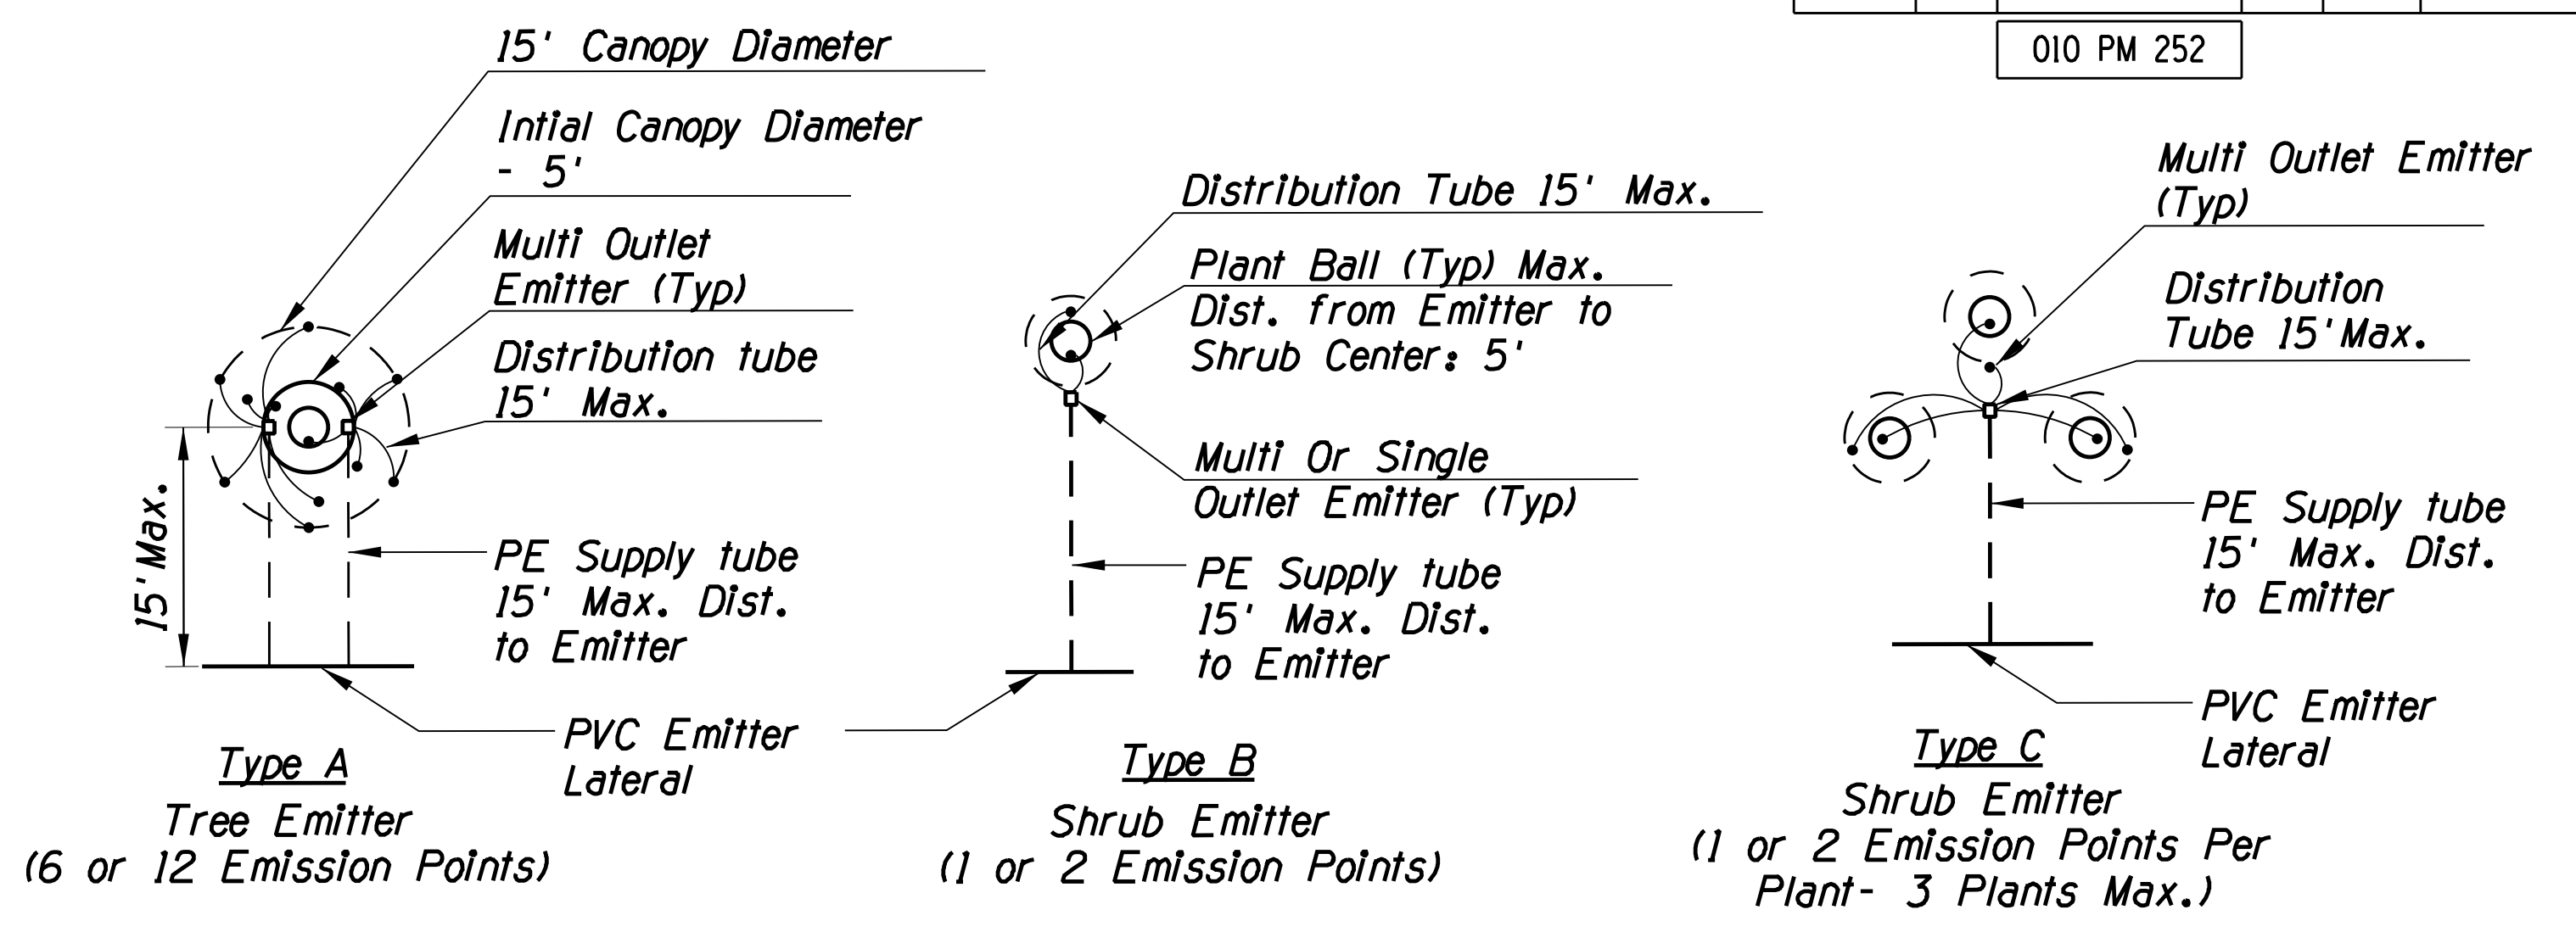

- Notes:
1. Where tree center exceeds 15'-0" from PVC emitter lateral, contractor to install a PVC sublateral branch to tree, as required.
  2. All emission points shall be located on the uphill side of plant material where slopes occur.
  3. Distribution tubing shall not exceed 15'-0" in length, as shown.
  4. Elevation differences between emission points (along common laterals) shall not exceed 8'-0".
  5. Locate 1 emission point directly over the root ball as shown.
  6. Multiple plants (shrubs) can be serviced by one emitter when the distribution tube length does not exceed 15', and when the plant water requirements are the same.
  7. See Emitter Schedule on Dwg No 1-1.02 for required number of emission points per plant species.


# DETAIL 16

EMITTER/EMISSION POINT PLACEMENT

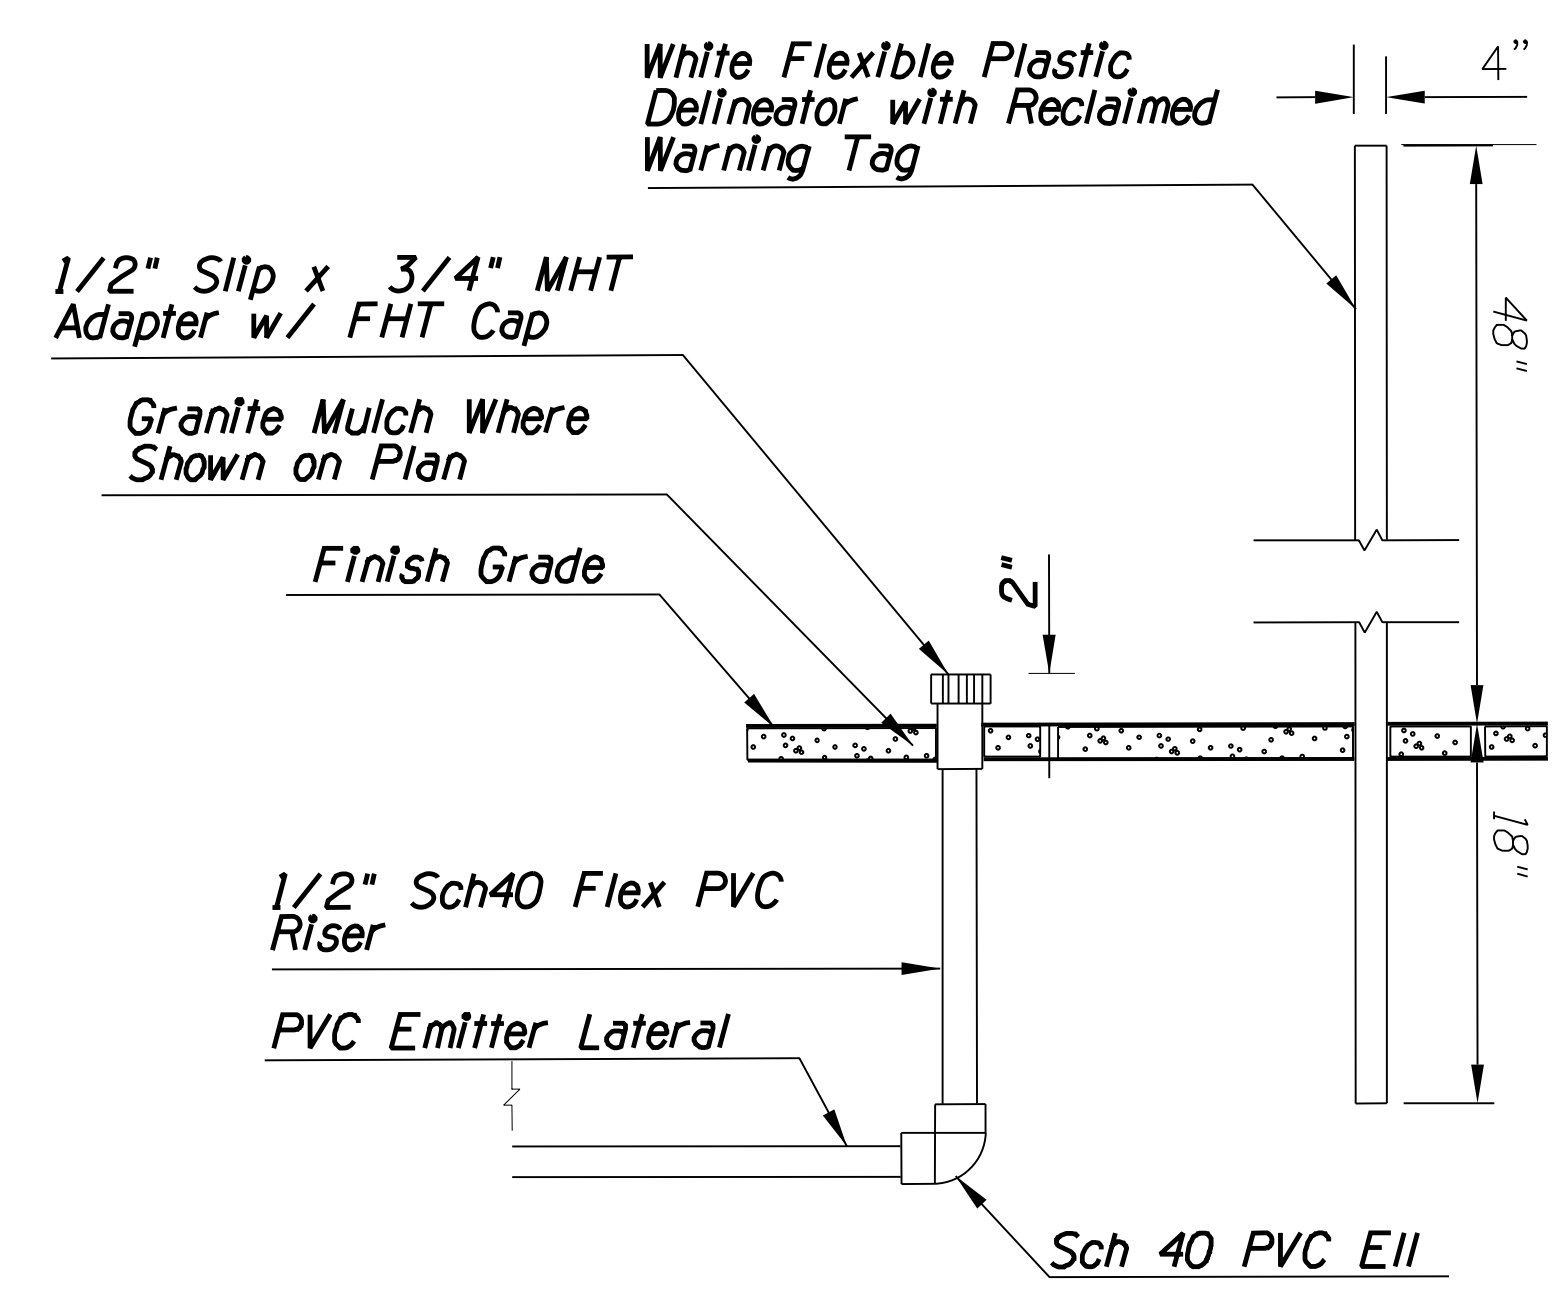

# DETAIL 15

LATERAL END CAP (ADOT)

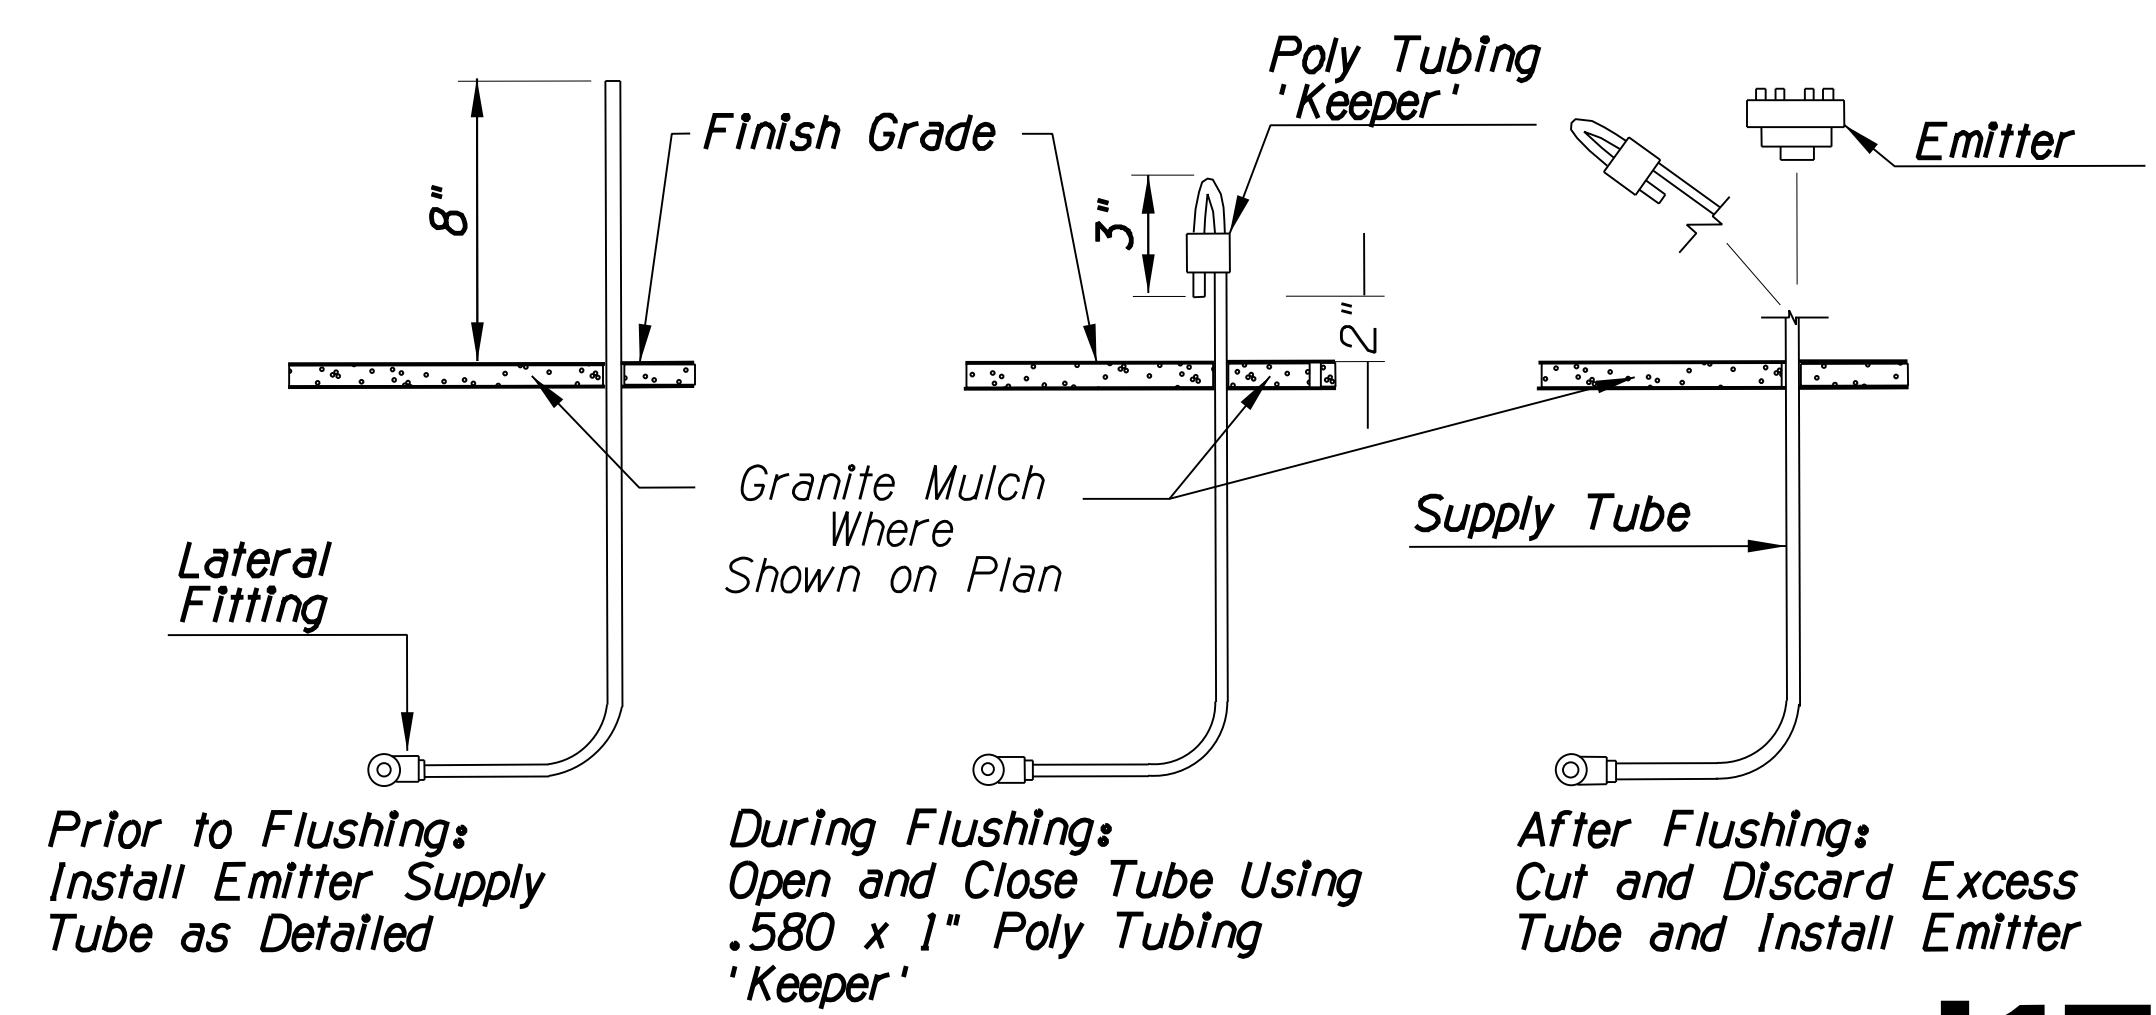

- Notes:
1. Crimp in supply tube must be in discarded portion of tube.

# DETAIL 17

EMITTER FLUSHING (ADOT)


IRRIGATION CONSULTANT:  
 Carl Kominsky, RLA, ASIC  
 CARL KOMINSKY LANDSCAPE ARCHITECT, INC.  
 Tucson, Arizona  
 Phone: (520) 740-0700  
 Email: ckominsky@comcast.net

DESIGN	CK	DATE	3/19	ARIZONA DEPARTMENT OF TRANSPORTATION INFRASTRUCTURE DELIVERY AND OPERATIONS DIVISION ROADSIDE DEVELOPMENT SECTION	
DRAWN	WDC	DATE	3/19		
CHECKED	CK/LEM	DATE	3/19		
<b>WHEAT DESIGN GROUP</b>		LANDSCAPE ARCHITECTS		IRRIGATION PLAN DETAIL SHEET	
500 N TUCSON BLVD, SUITE 150, TUCSON AZ 85716					
ROUTE	LOCATION		RUTHRAUFF ROAD T1		
TRACS NO. H 8480 OIC		010-D(213)S		DWG NO. 1-3.05	



F.H.W.A. REGION	STATE	PROJECT NO.	SHEET NO.	TOTAL SHEETS	RECORD DRAWING
9	ARIZ.	010-D(213)S	790	849	

010 PM 252

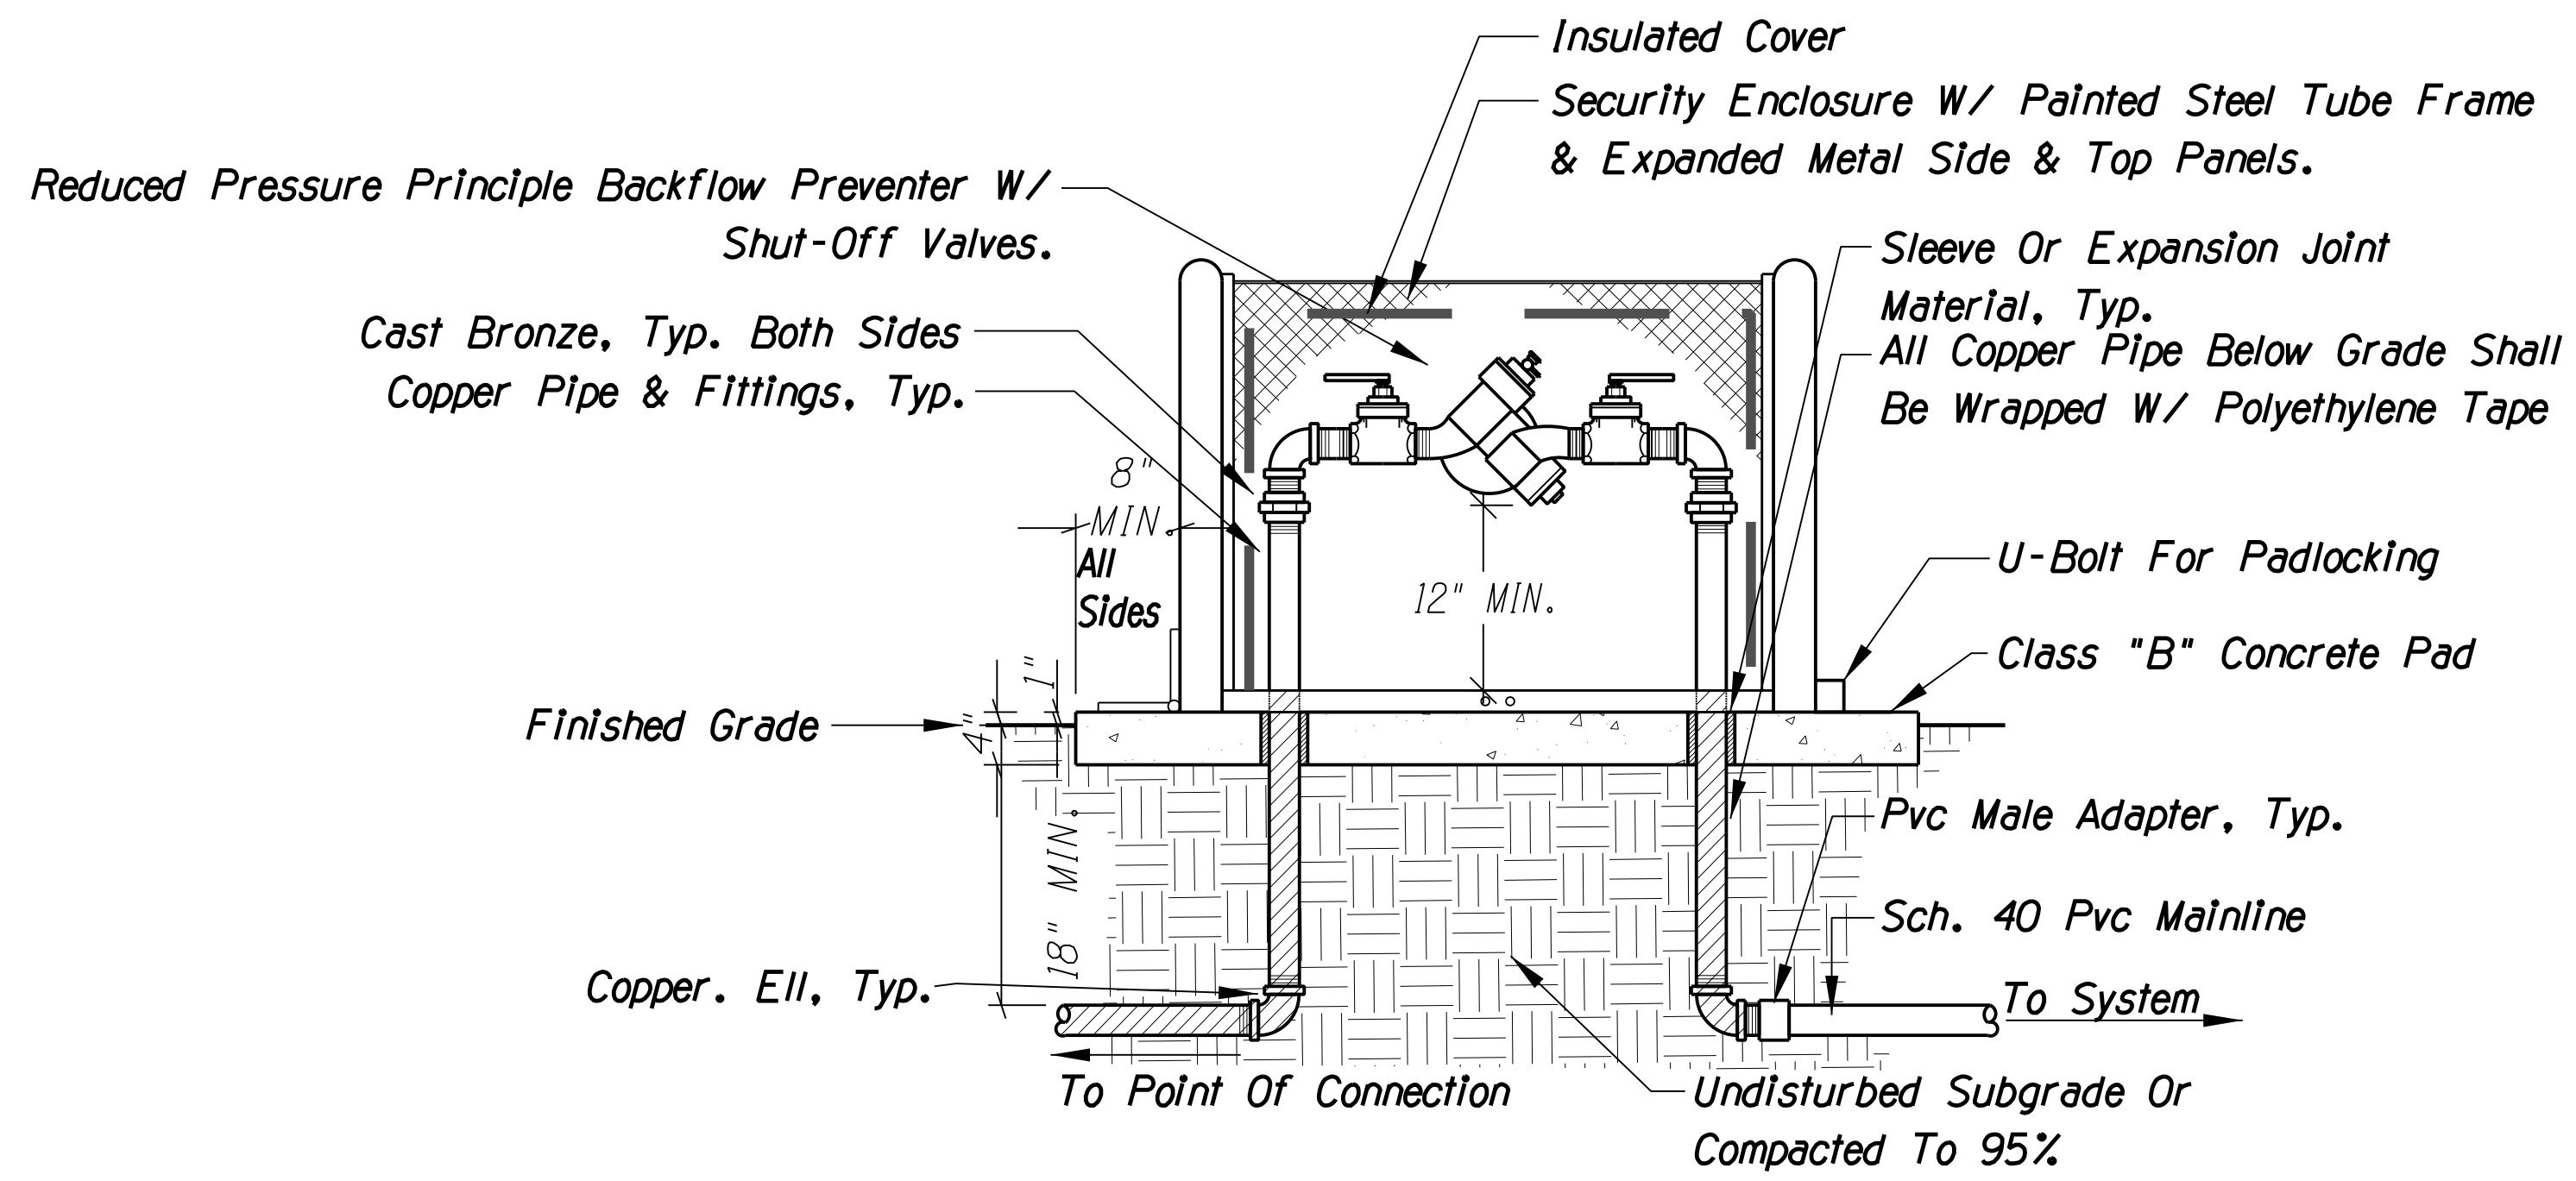

1 REDUCED PRESSURE PRINCIPLE BACKFLOW PREVENTER IN SECURITY ENCLOSURE

N.T.S.



IRRIGATION CONSULTANT:  
 Carl Kominsky, RLA, ASIC  
 CARL KOMINSKY LANDSCAPE ARCHITECT, INC.  
 Tucson, Arizona  
 Phone: (520) 740-0700  
 Email: ckominsky@comcast.net

DESIGN	CK	DATE	3/19	ARIZONA DEPARTMENT OF TRANSPORTATION INFRASTRUCTURE DELIVERY AND OPERATIONS DIVISION ROADSIDE DEVELOPMENT SECTION	
DRAWN	WDC	DATE	3/19		
CHECKED	CK/LEM	DATE	3/19		
<b>WHEAT DESIGN GROUP</b>		LANDSCAPE ARCHITECTS		IRRIGATION PLAN DETAIL SHEET	
500 N TUCSON BLVD, SUITE 150, TUCSON AZ 85716					
ROUTE	LOCATION			DWG NO. 1-3.07	
I-10	RUTHRAUFF ROAD TI				
TRACS NO. H 8480 01C			010-D(213)S		OF



F.H.W.A. REGION	STATE	PROJECT NO.	SHEET NO.	TOTAL SHEETS	RECORD DRAWING
9	ARIZ.	010-D(213)S	791	849	

010 PM 252

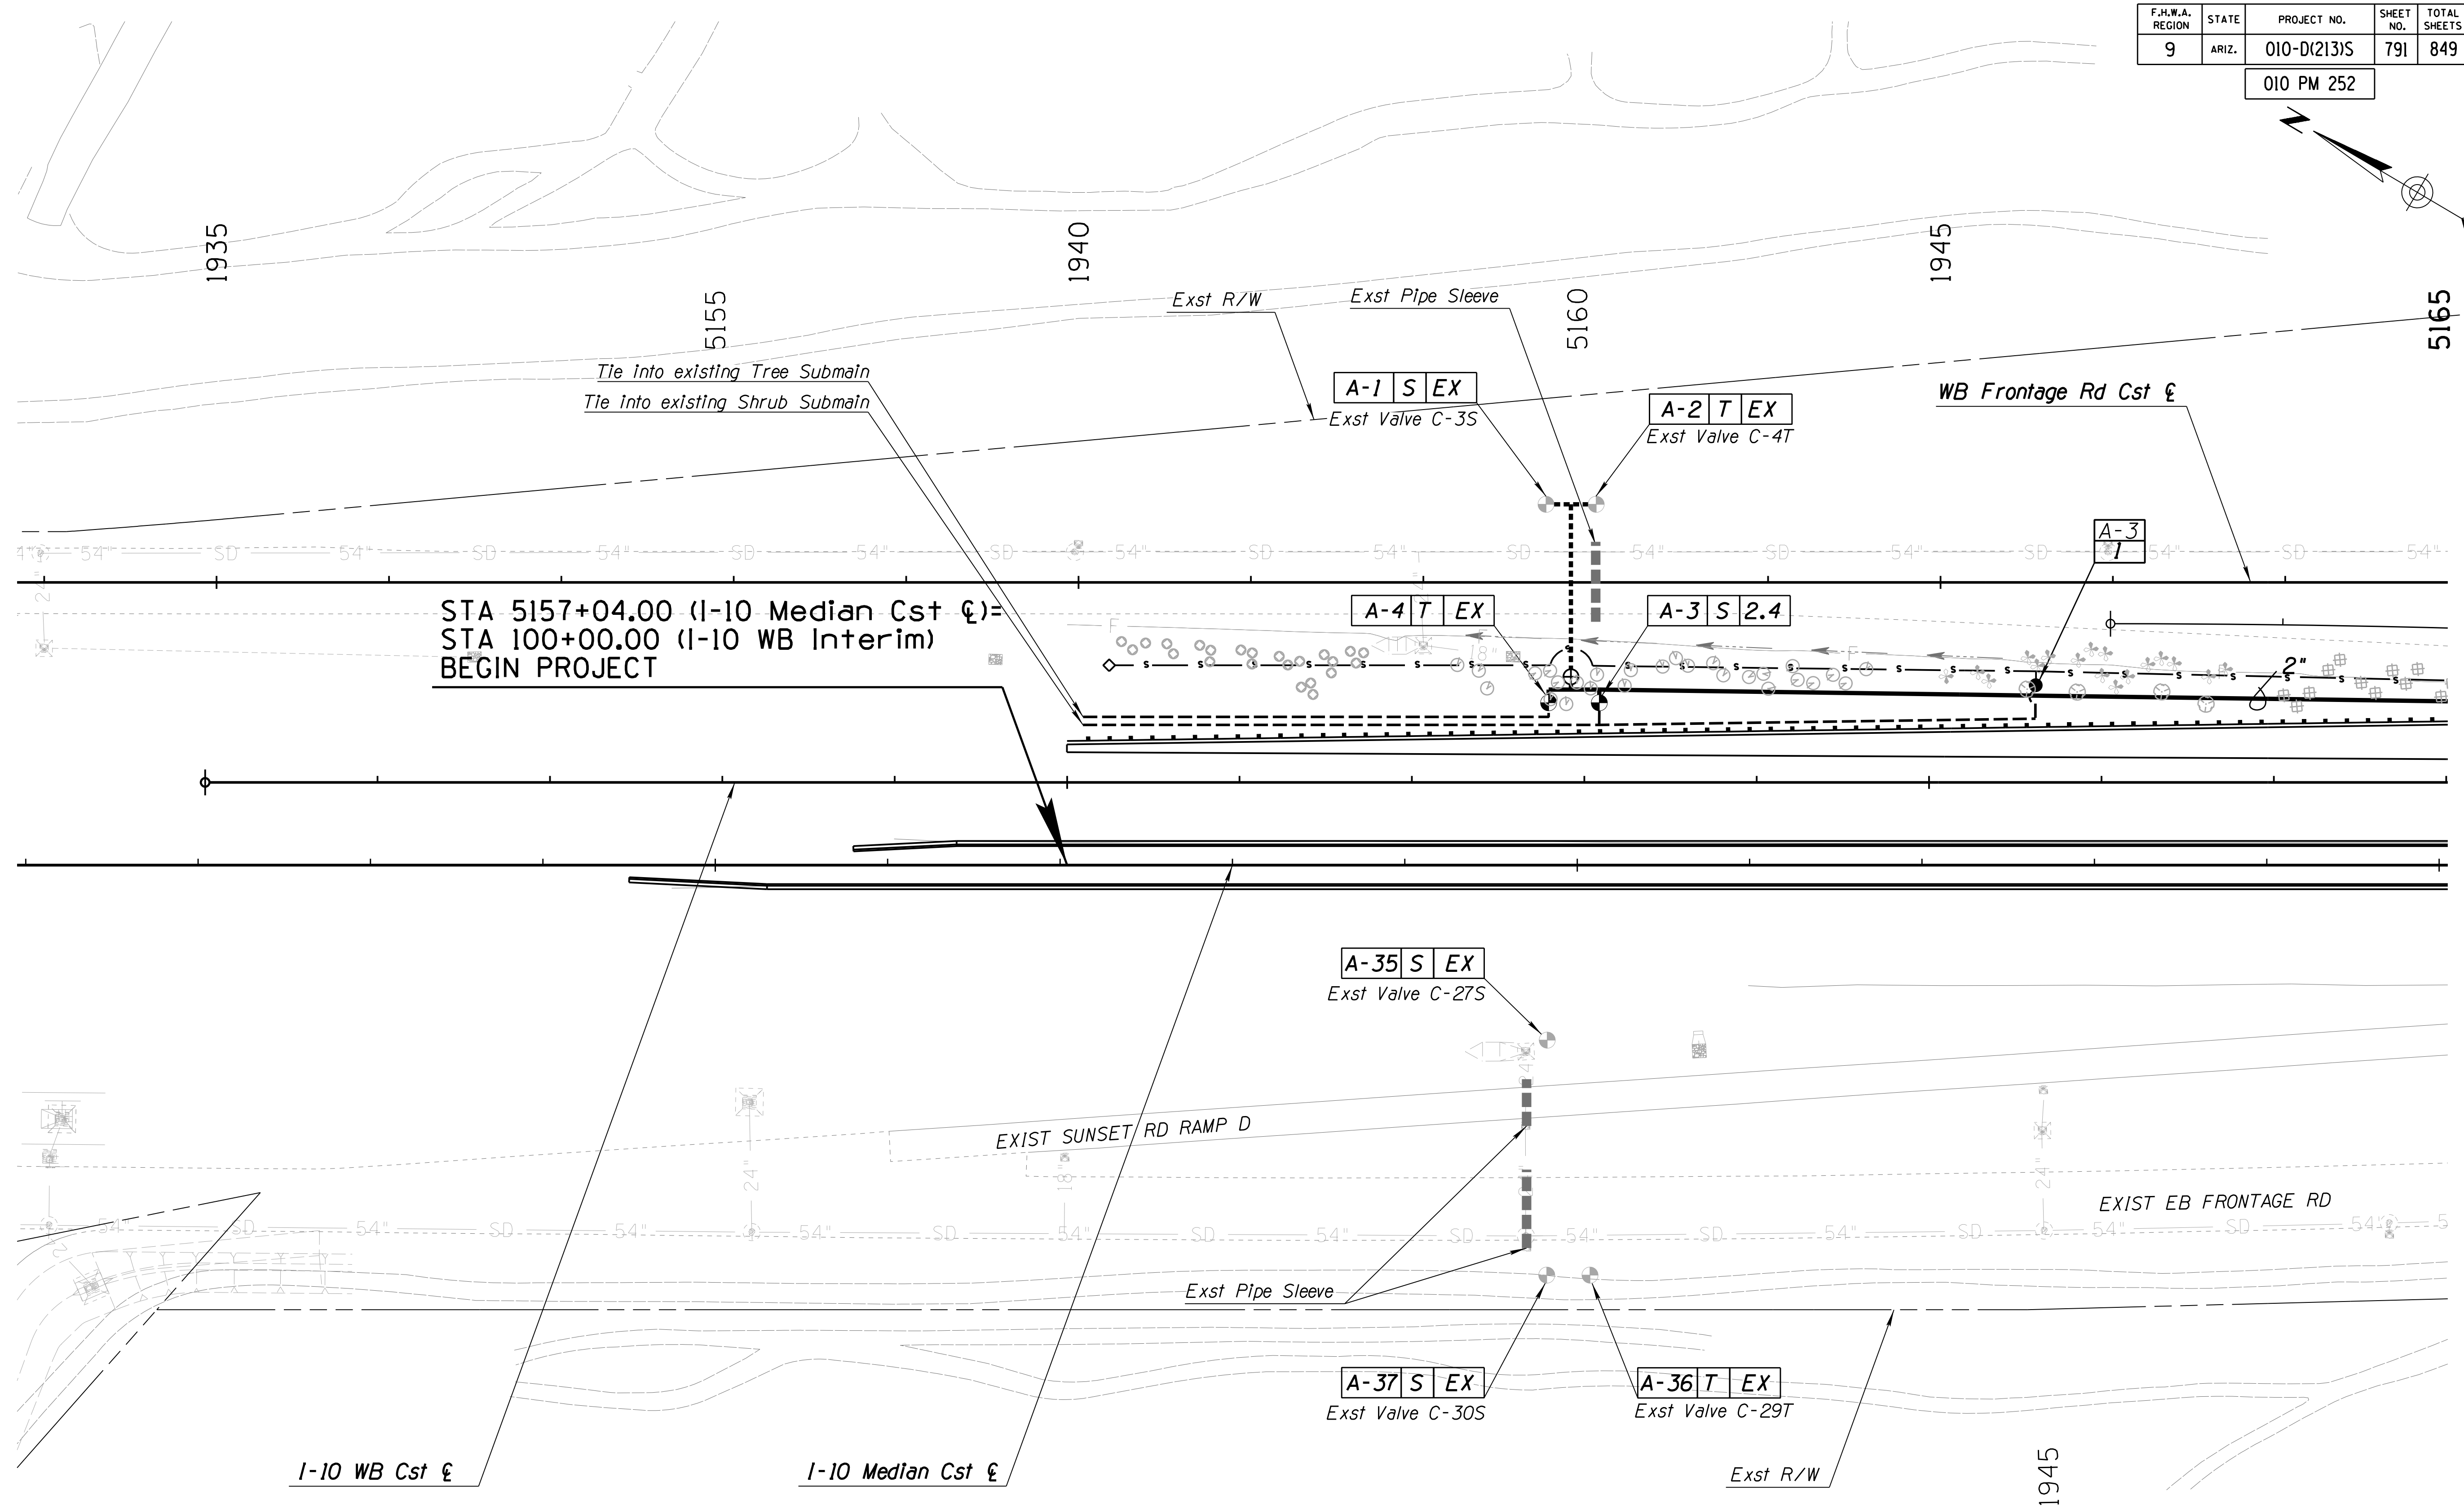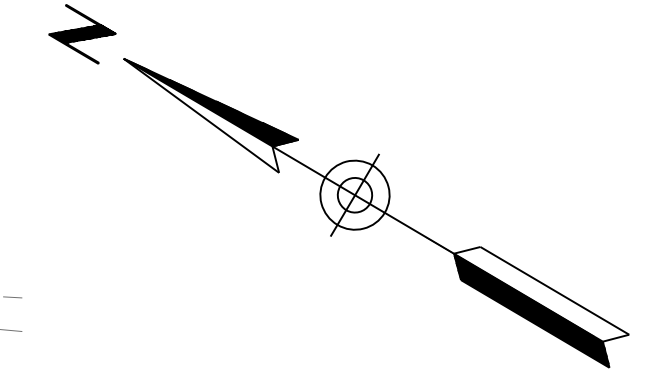

SURVEY NO. FINISHED PLANS DATE LOCATION REVISIONS FINISHED PLANS DATE SURVEY NO. FINISHED PLANS DATE

IRRIGATION CONSULTANT:  
 Carl Kominsky, RLA, ASIC  
 CARL KOMINSKY LANDSCAPE ARCHITECT, INC.  
 Tucson, Arizona  
 Phone: (520) 740-0700  
 Email: ckominsky@comcast.net

DESIGN	CK	NAME	DATE	ARIZONA DEPARTMENT OF TRANSPORTATION INFRASTRUCTURE DELIVERY AND OPERATIONS DIVISION ROADSIDE DEVELOPMENT SECTION
DRAWN	WDC		3/19	
CHECKED	CK/LEM		3/19	
<b>WHEAT DESIGN GROUP</b> LANDSCAPE ARCHITECTS <small>500 N TUCSON BLVD, SUITE 150, TUCSON AZ 85716</small>		<b>IRRIGATION PLAN</b> <b>I-10 MED CONST &amp;I</b> <b>STA 5151+00 TO 5165+00</b>		
ROUTE	I-10	LOCATION	RUTHRAUFF ROAD TI	
TRACS NO. H 8480 01C		010-D(213)S		DWG NO. I-4.01



ccccSYTIMEcccc

ccccDGNcSPECIFICATIONcccc

OF

F.H.W.A. REGION	STATE	PROJECT NO.	SHEET NO.	TOTAL SHEETS	RECORD DRAWING
9	ARIZ.	010-D(213)S	792	849	

010 PM 252

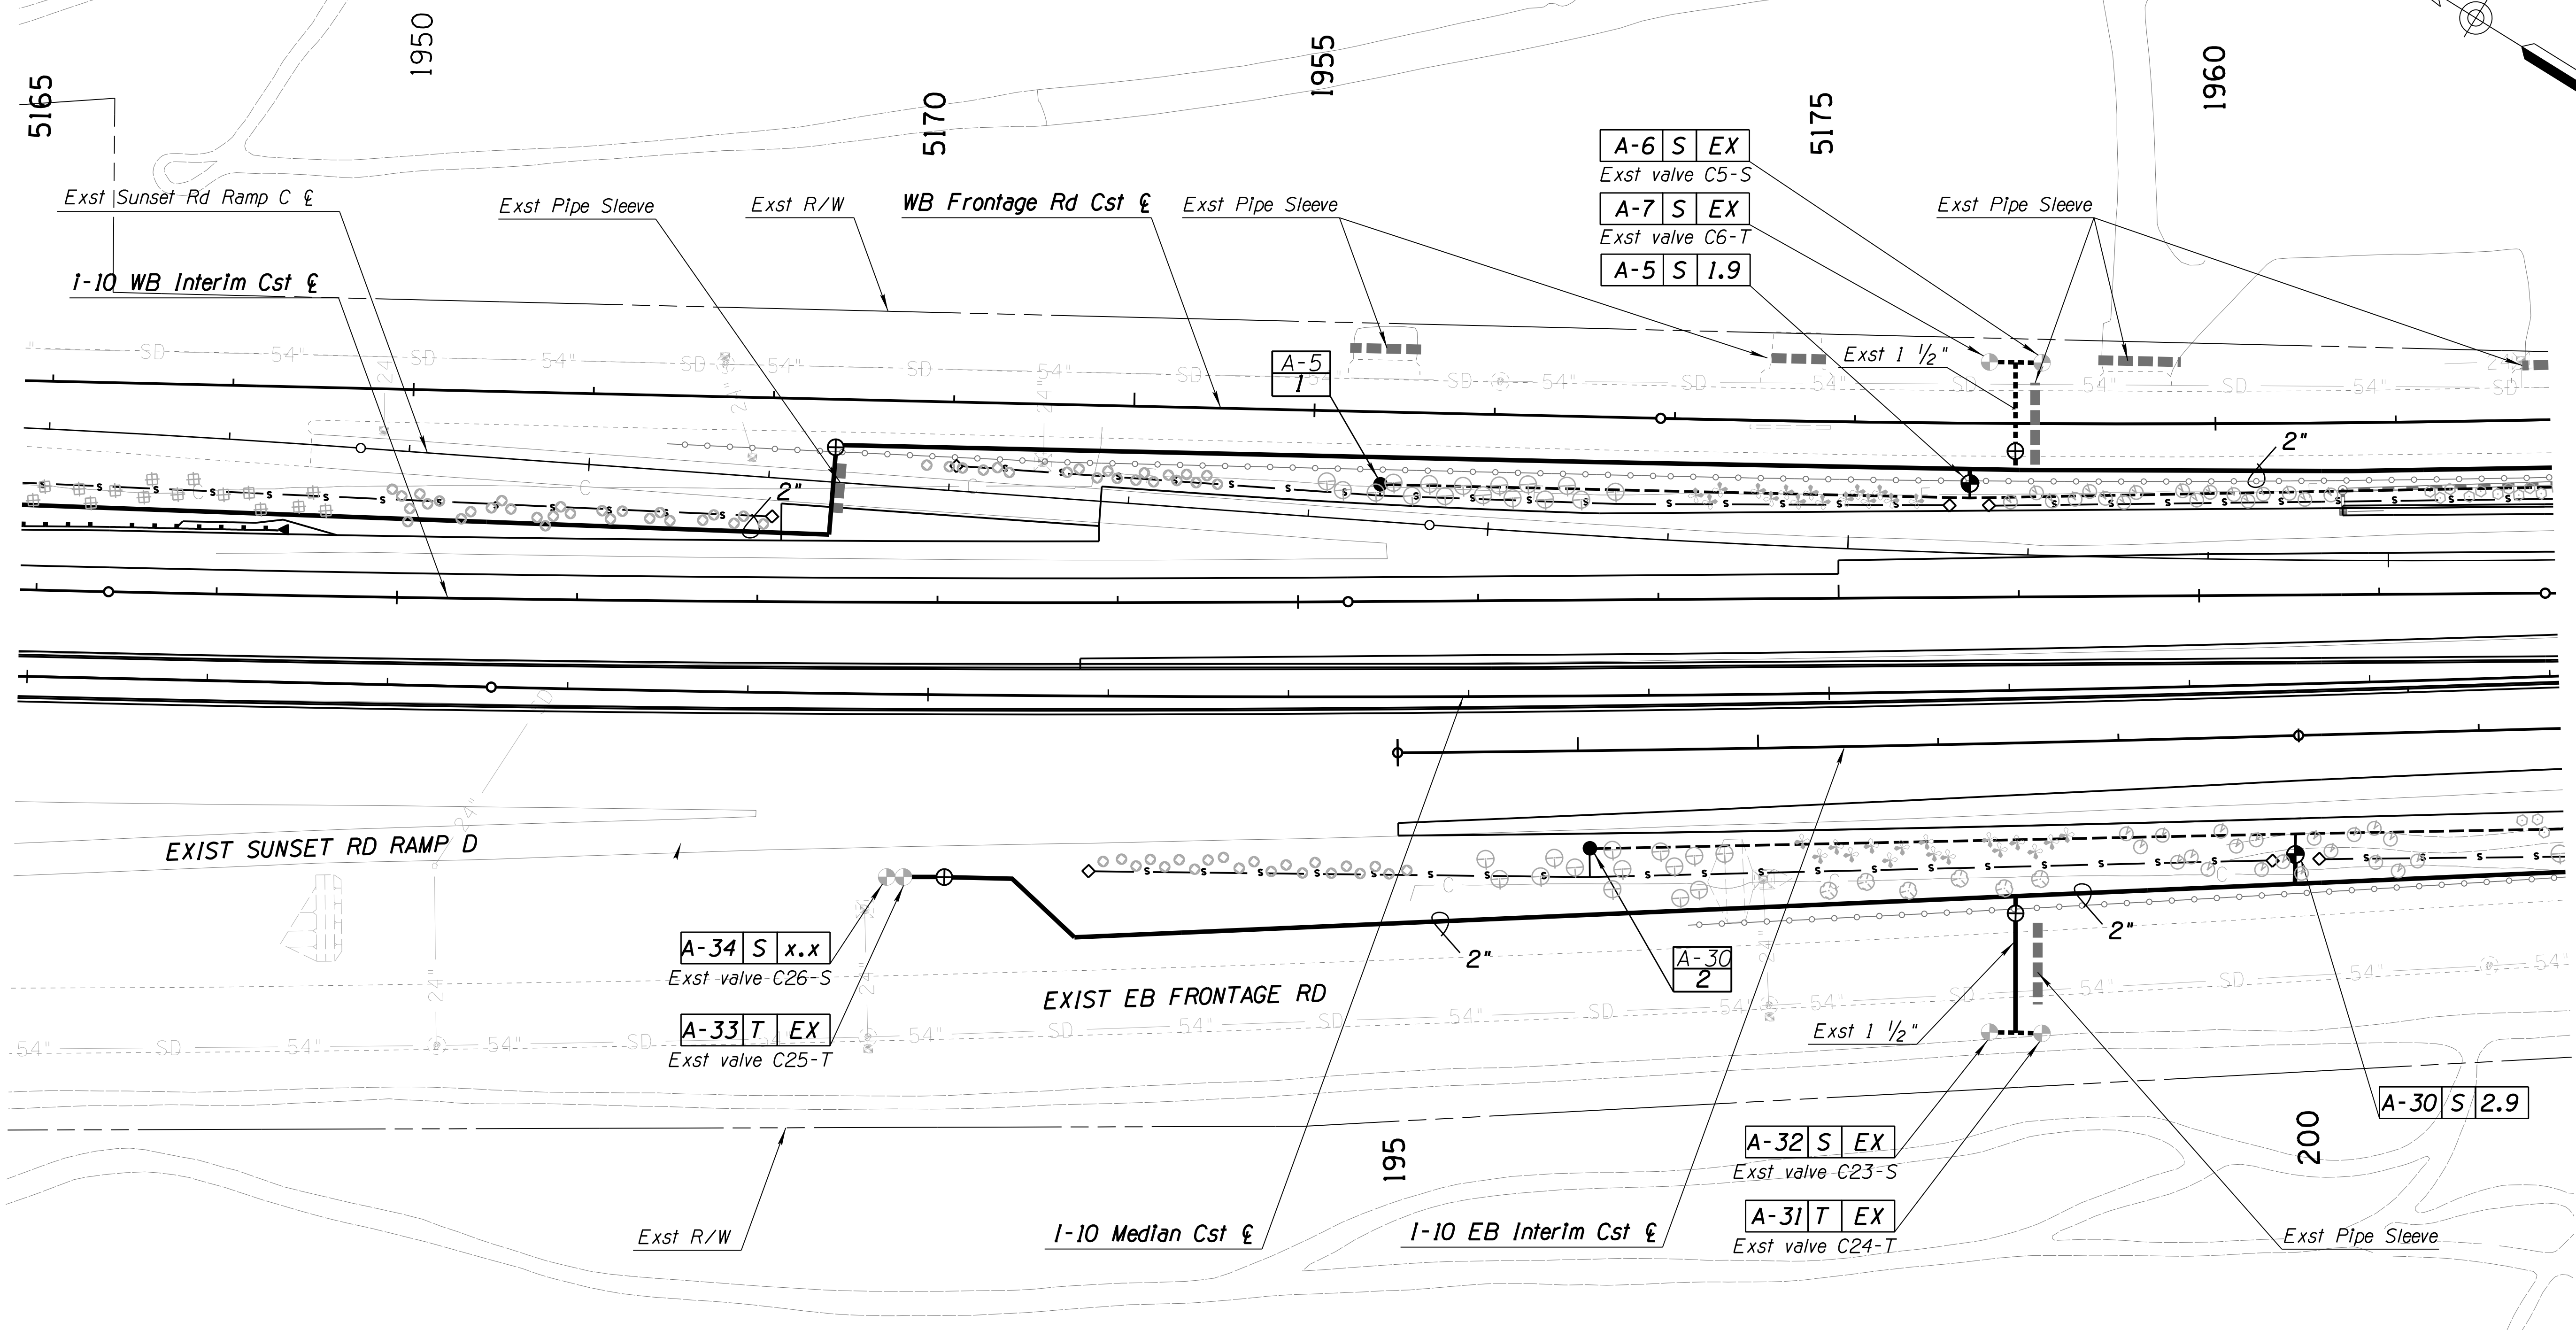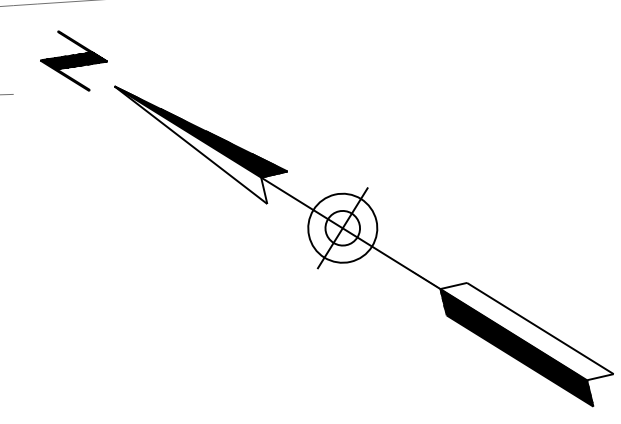

REVISIONS- LOCATION- DATE-  
 FINISHED PLANS- SURVEY NO. DATE-  
 REVISIONS- LOCATION- DATE-  
 FINISHED PLANS- SURVEY NO. DATE-

IRRIGATION CONSULTANT:  
 Carl Kominsky, RLA, ASIC  
 CARL KOMINSKY LANDSCAPE ARCHITECT, INC.  
 Tucson, Arizona  
 Phone: (520) 740-0700  
 Email: ckominsky@comcast.net


DESIGN	CK	NAME	DATE	ARIZONA DEPARTMENT OF TRANSPORTATION INFRASTRUCTURE DELIVERY AND OPERATIONS DIVISION ROADSIDE DEVELOPMENT SECTION	
DRAWN	WDC		3/19		
CHECKED	CK/LEM		3/19		
<b>WHEAT DESIGN GROUP</b> LANDSCAPE ARCHITECTS <small>500 N TUCSON BLVD, SUITE 150, TUCSON AZ 85716</small>		<b>IRRIGATION PLAN</b> <b>1-10 MED CONST</b> <b>STA 5165+00 TO 5179+00</b>			
ROUTE	LOCATION				
I-10	RUTHRAUFF ROAD TI				
TRACS NO. H 8480 OIC		010-D(213)S		DWG NO. 1-4.02	
				OF	






F.H.W.A. REGION	STATE	PROJECT NO.	SHEET NO.	TOTAL SHEETS	RECORD DRAWING
9	ARIZ.	010-D(213)S	794	849	

010 PM 252

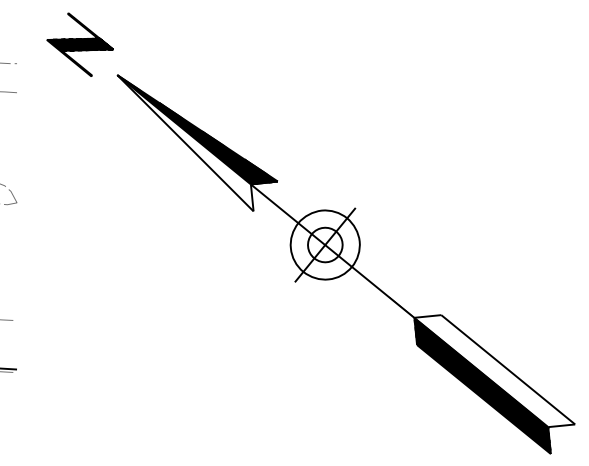

SURVEY NO. FINISHED PLANS DATE LOCATION REVISIONS FINISHED PLANS DATE SURVEY NO. FINISHED PLANS DATE LOCATION REVISIONS FINISHED PLANS DATE SURVEY NO.

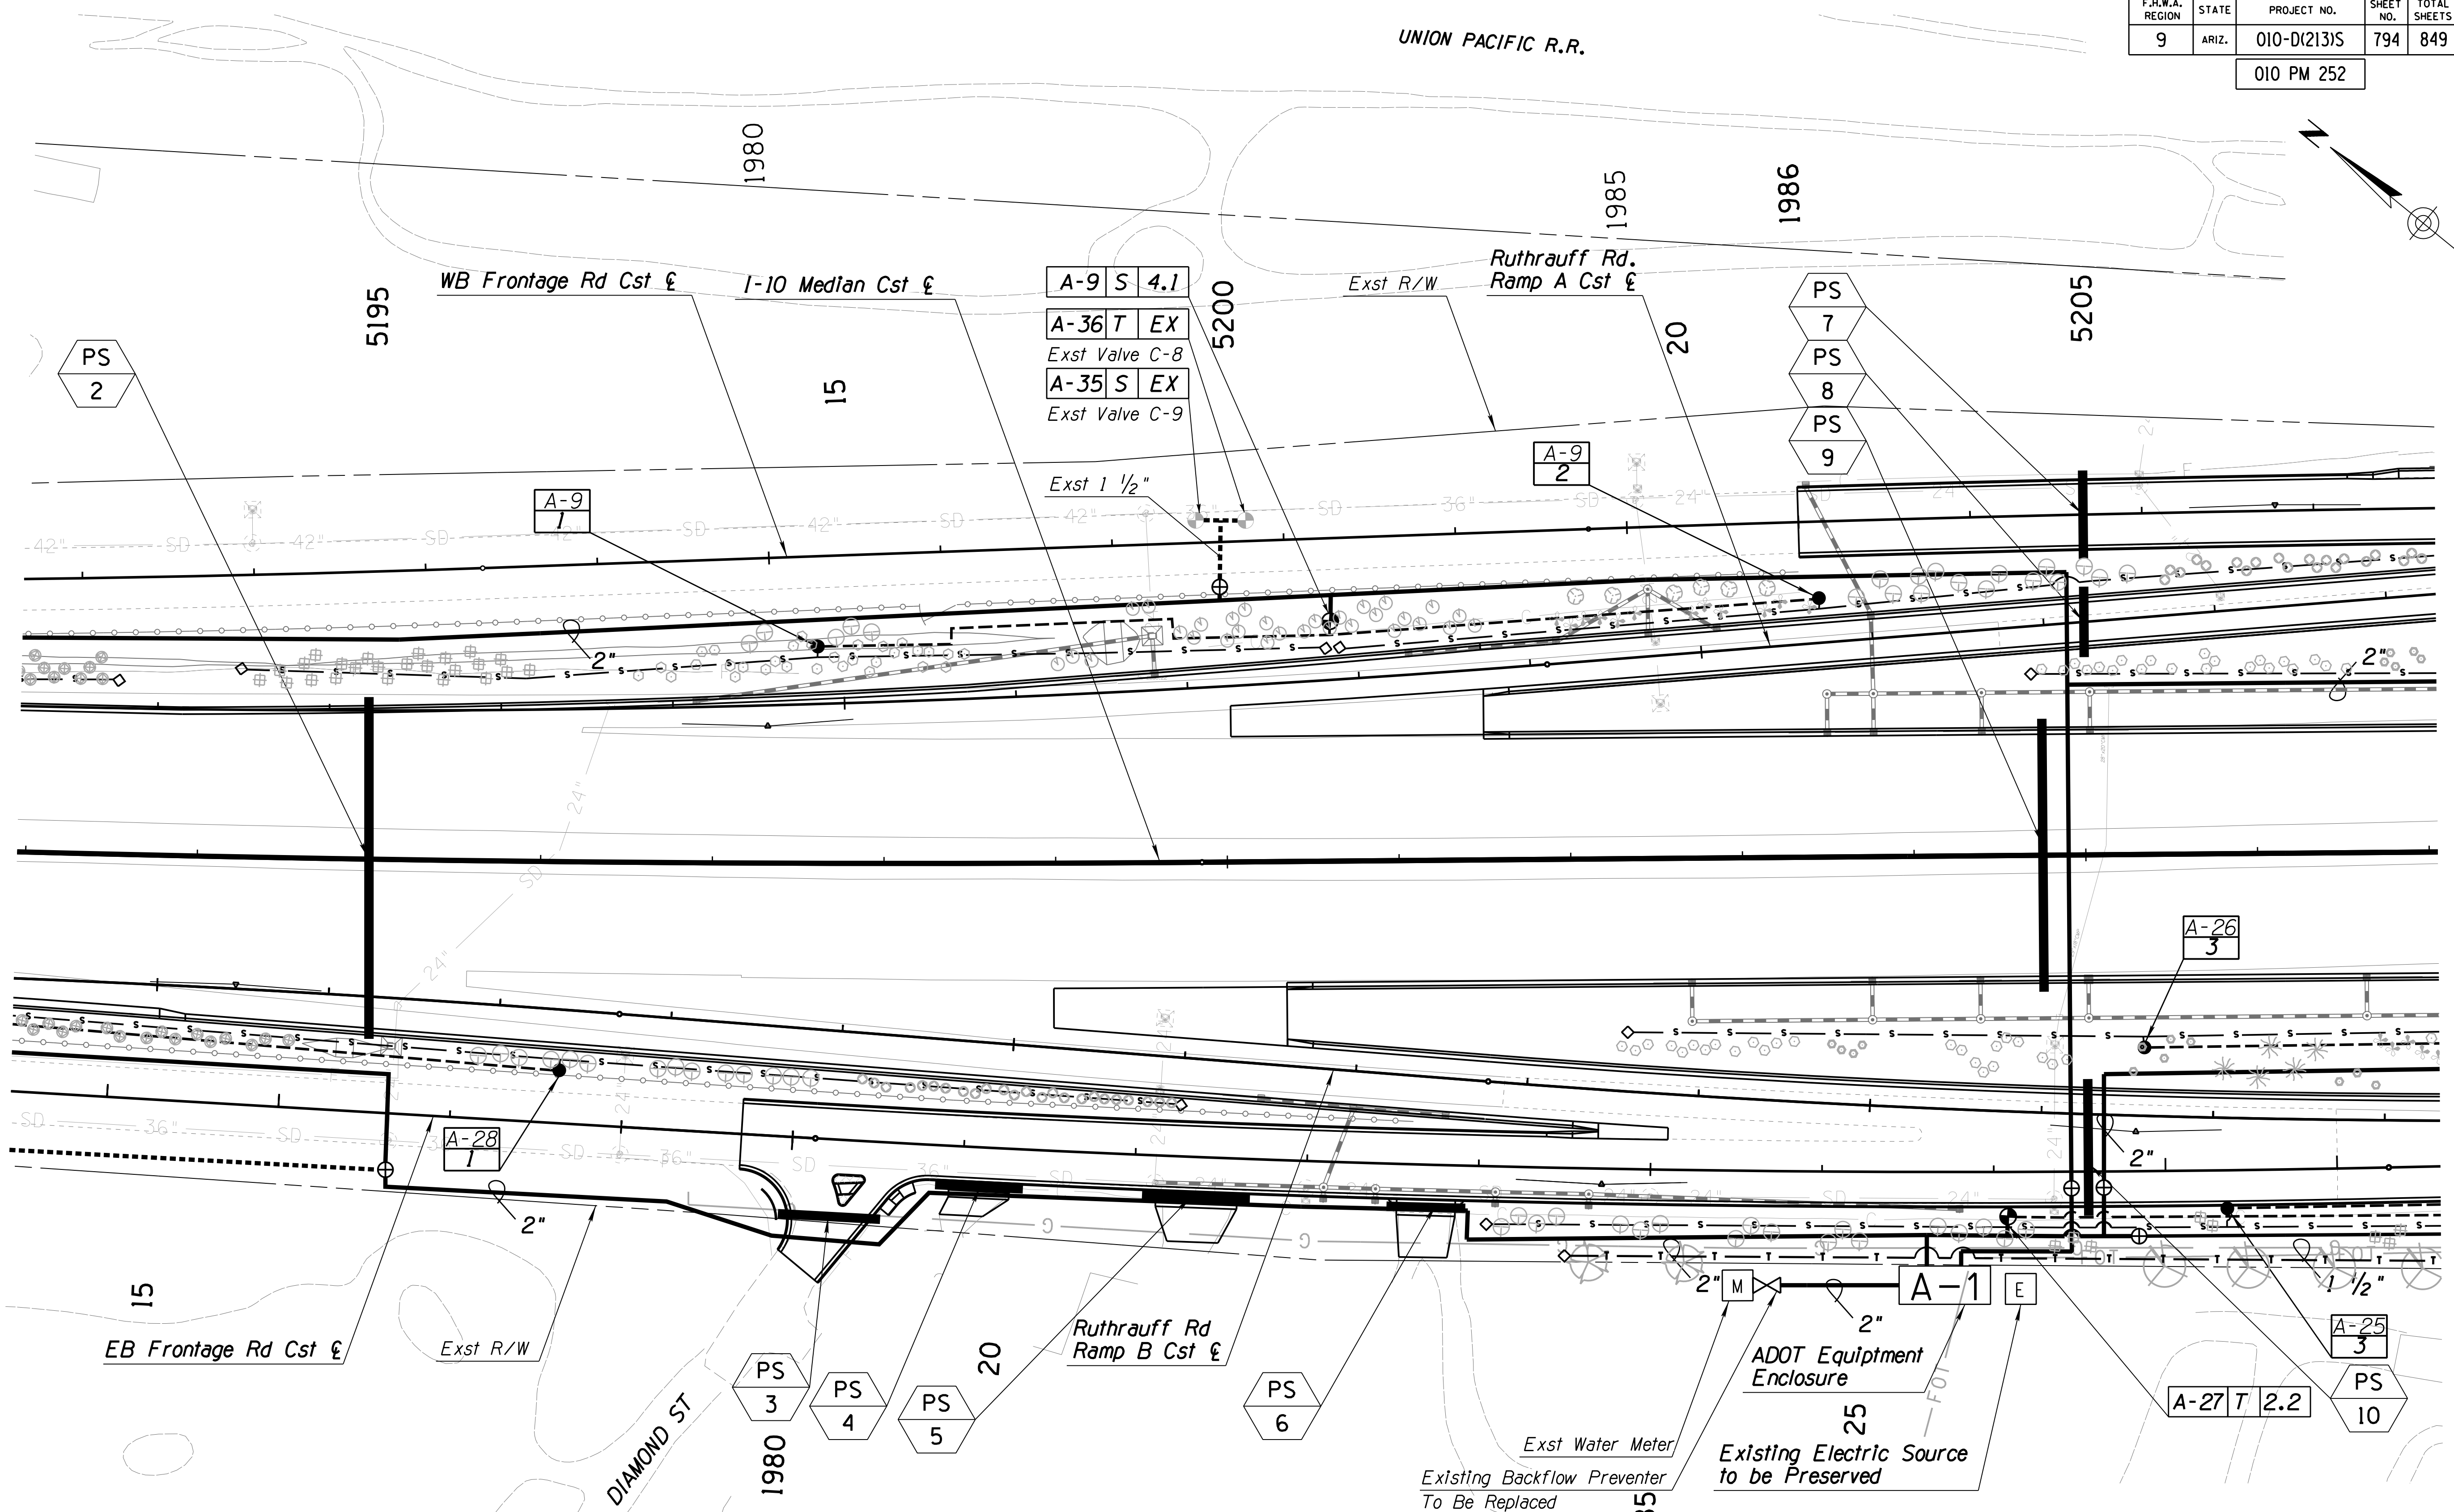

IRRIGATION CONSULTANT:  
 Carl Kominsky, RLA, ASIC  
 CARL KOMINSKY LANDSCAPE ARCHITECT, INC.  
 Tucson, Arizona  
 Phone: (520) 740-0700  
 Email: ckominsky@comcast.net

DESIGN	CK	NAME	DATE	ARIZONA DEPARTMENT OF TRANSPORTATION INFRASTRUCTURE DELIVERY AND OPERATIONS DIVISION ROADSIDE DEVELOPMENT SECTION  <b>IRRIGATION PLAN</b> <b>I-10 MED CONST &amp;</b> <b>STA 5193+00 TO 5207+00</b>	
DRAWN	WDC		3/19		
CHECKED	CK/LEM		3/19		
<b>WHEAT DESIGN GROUP</b> LANDSCAPE ARCHITECTS <small>500 N TUCSON BLVD, SUITE 150, TUCSON AZ 85716</small>		ROUTE: I-10      LOCATION: RUTHRAUFF ROAD TI		DWG NO. 1-4.04	
TRACS NO. H 8480 OIC		010-D(213)S		OF	











F.H.W.A. REGION	STATE	PROJECT NO.	SHEET NO.	TOTAL SHEETS	RECORD DRAWING
9	ARIZ.	010-D(213)S	797	849	

010 PM 252

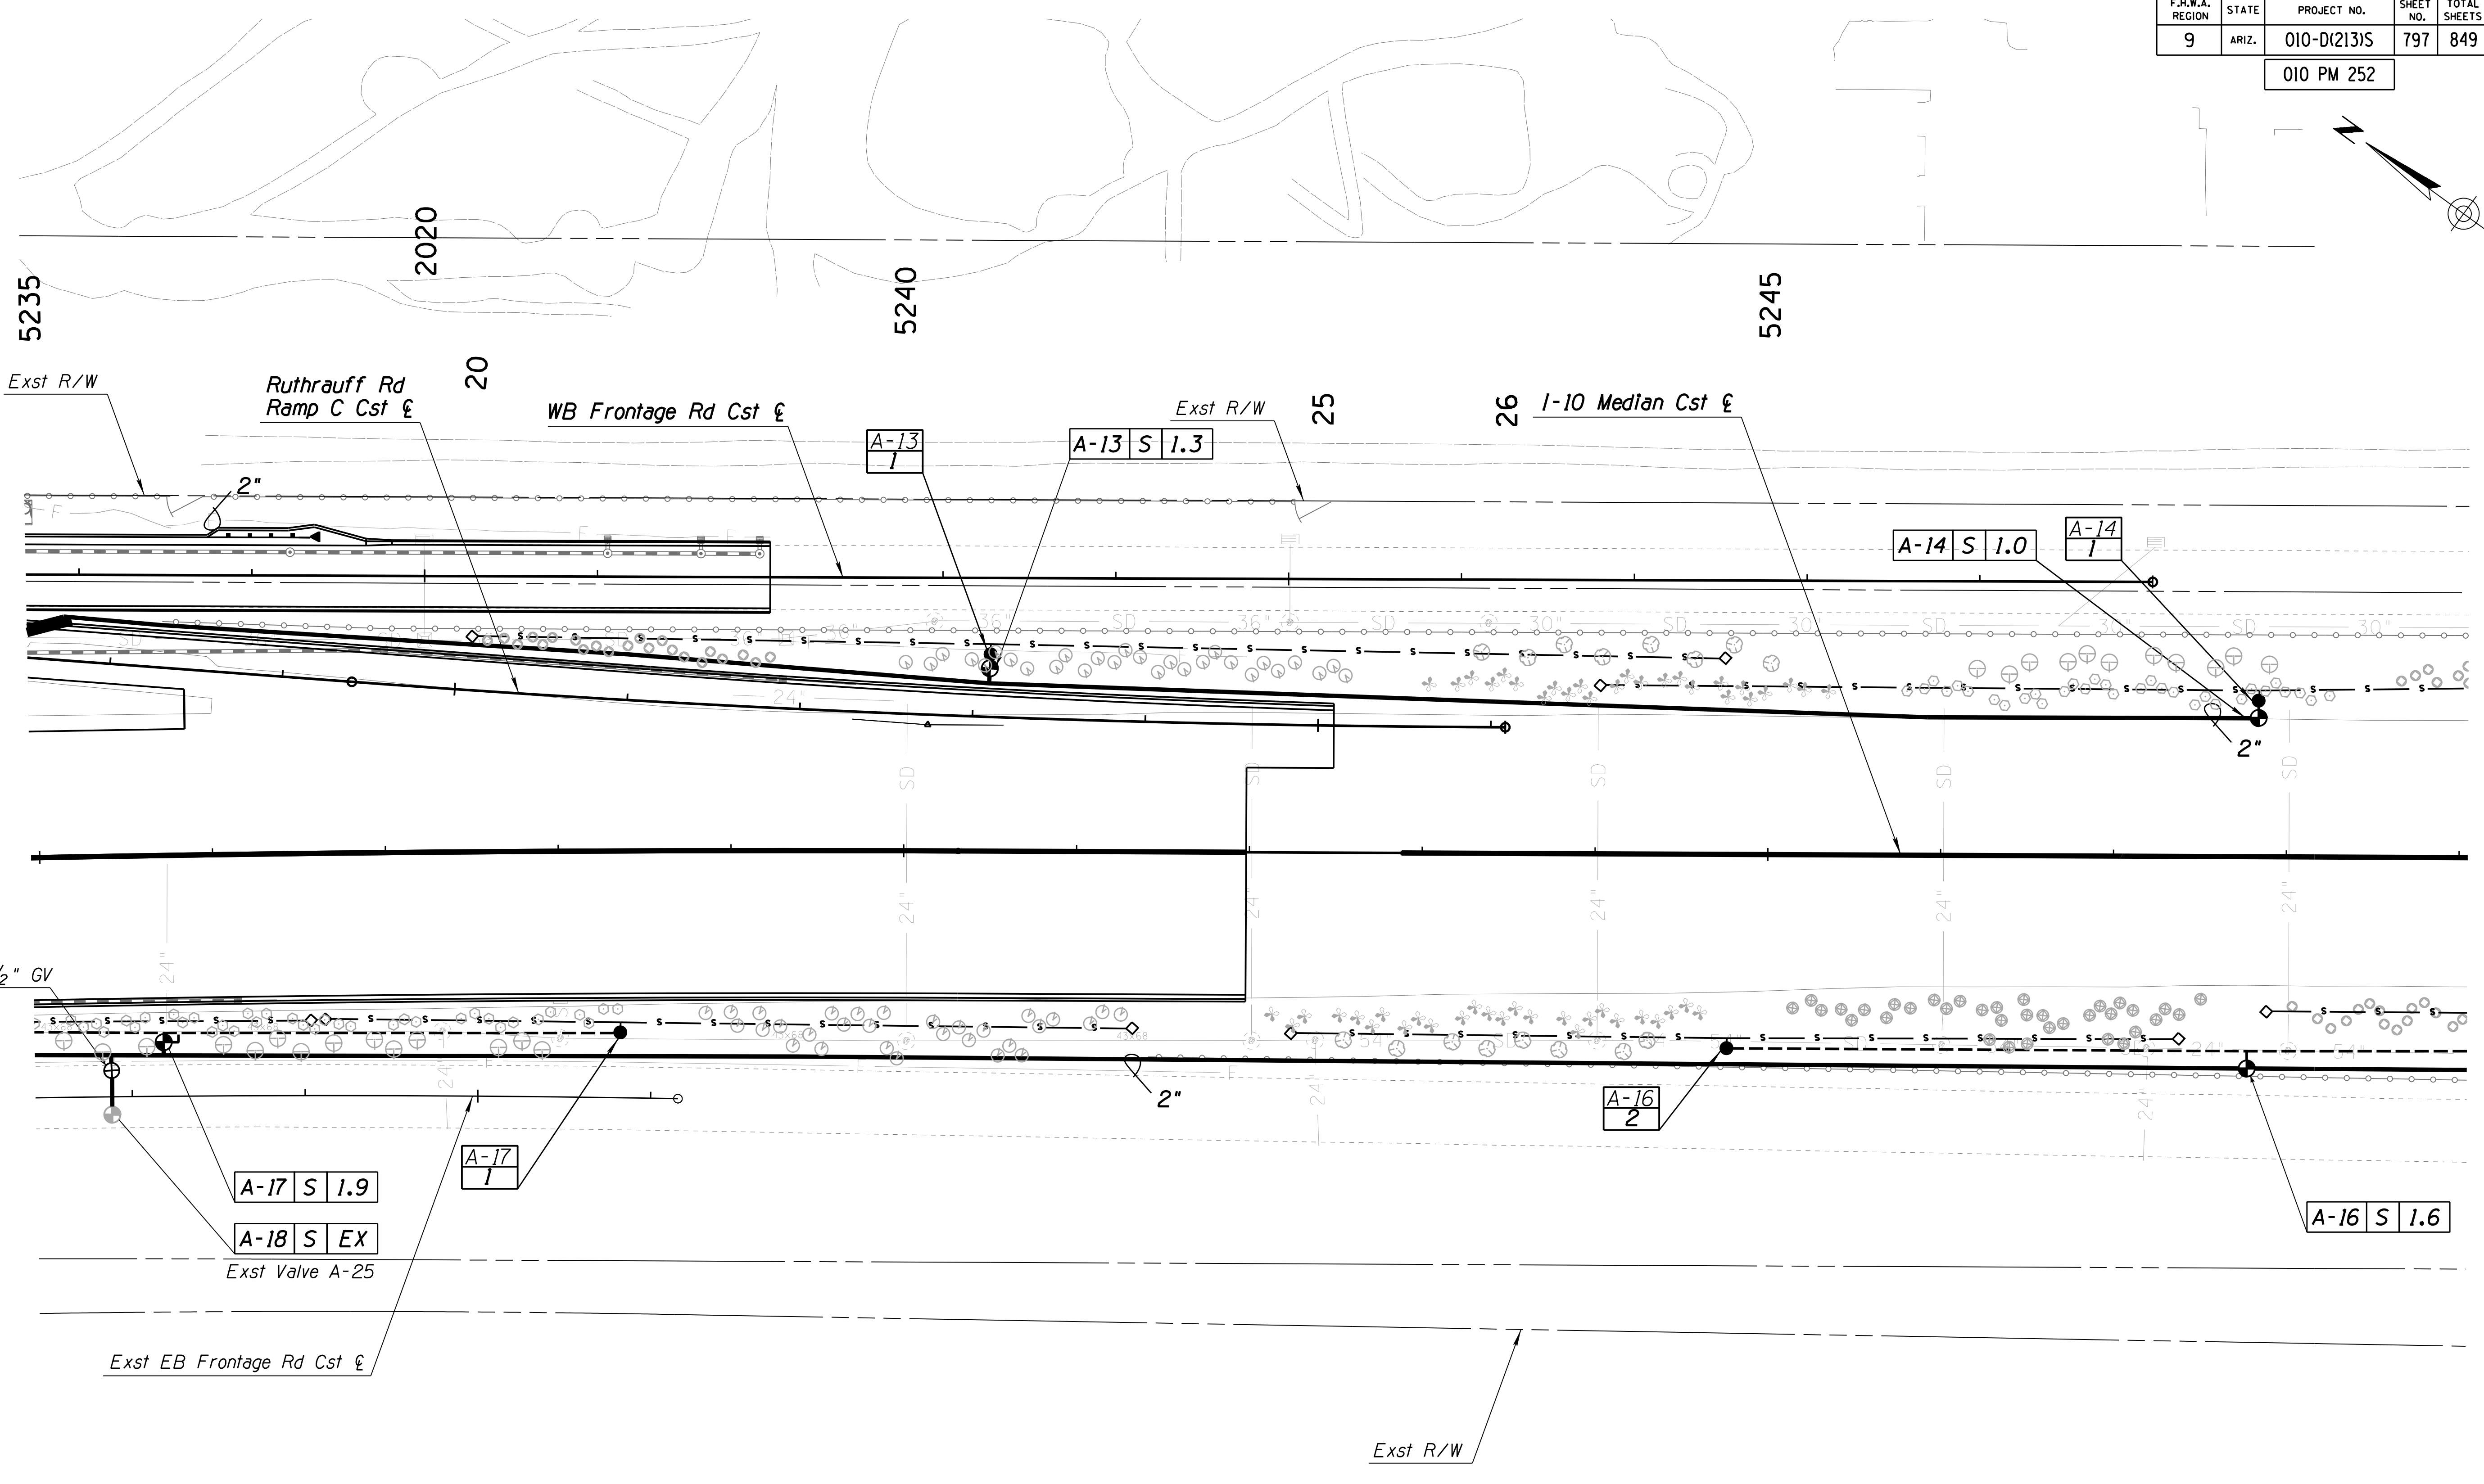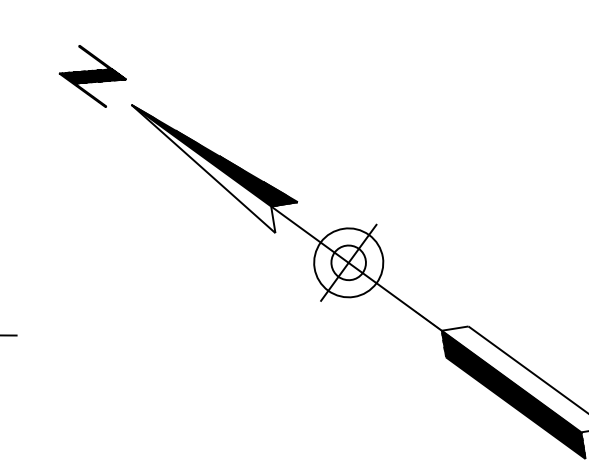


REVISIONS- LOCATION- DATE- SURVEY NO. FINISHED PLANS- SURVEY NO. DATE- REVISIONS- LOCATION- DATE- SURVEY NO. FINISHED PLANS- SURVEY NO. DATE-

ccccSYTIMEcccc      ccccDGNcSPECIFICATIONcccc

IRRIGATION CONSULTANT:  
 Carl Kominsky, RLA, ASIC  
 CARL KOMINSKY LANDSCAPE ARCHITECT, INC.  
 Tucson, Arizona  
 Phone: (520) 740-0700  
 Email: ckominsky@comcast.net



DESIGN	CK	NAME	DATE	ARIZONA DEPARTMENT OF TRANSPORTATION INFRASTRUCTURE DELIVERY AND OPERATIONS DIVISION ROADSIDE DEVELOPMENT SECTION  <b>IRRIGATION PLAN</b> <b>I-10 MED CONST</b> <b>STA 5235+00 TO 5249+00</b>
DRAWN	WDC		3/19	
CHECKED	CK/LEM		3/19	
<b>WHEAT DESIGN GROUP</b>		LANDSCAPE ARCHITECTS		DWG NO. 1-4.07 OF
500 N TUCSON BLVD, SUITE 150, TUCSON AZ 85716		ROUTE I-10 LOCATION RUTHRAUFF ROAD TI		
TRACS NO. H 8480 OIC		010-D(213)S		

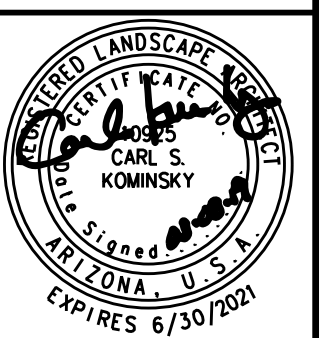



F.H.W.A. REGION	STATE	PROJECT NO.	SHEET NO.	TOTAL SHEETS	RECORD DRAWING
9	ARIZ.	010-D(213)S	799	849	

010 PM 252

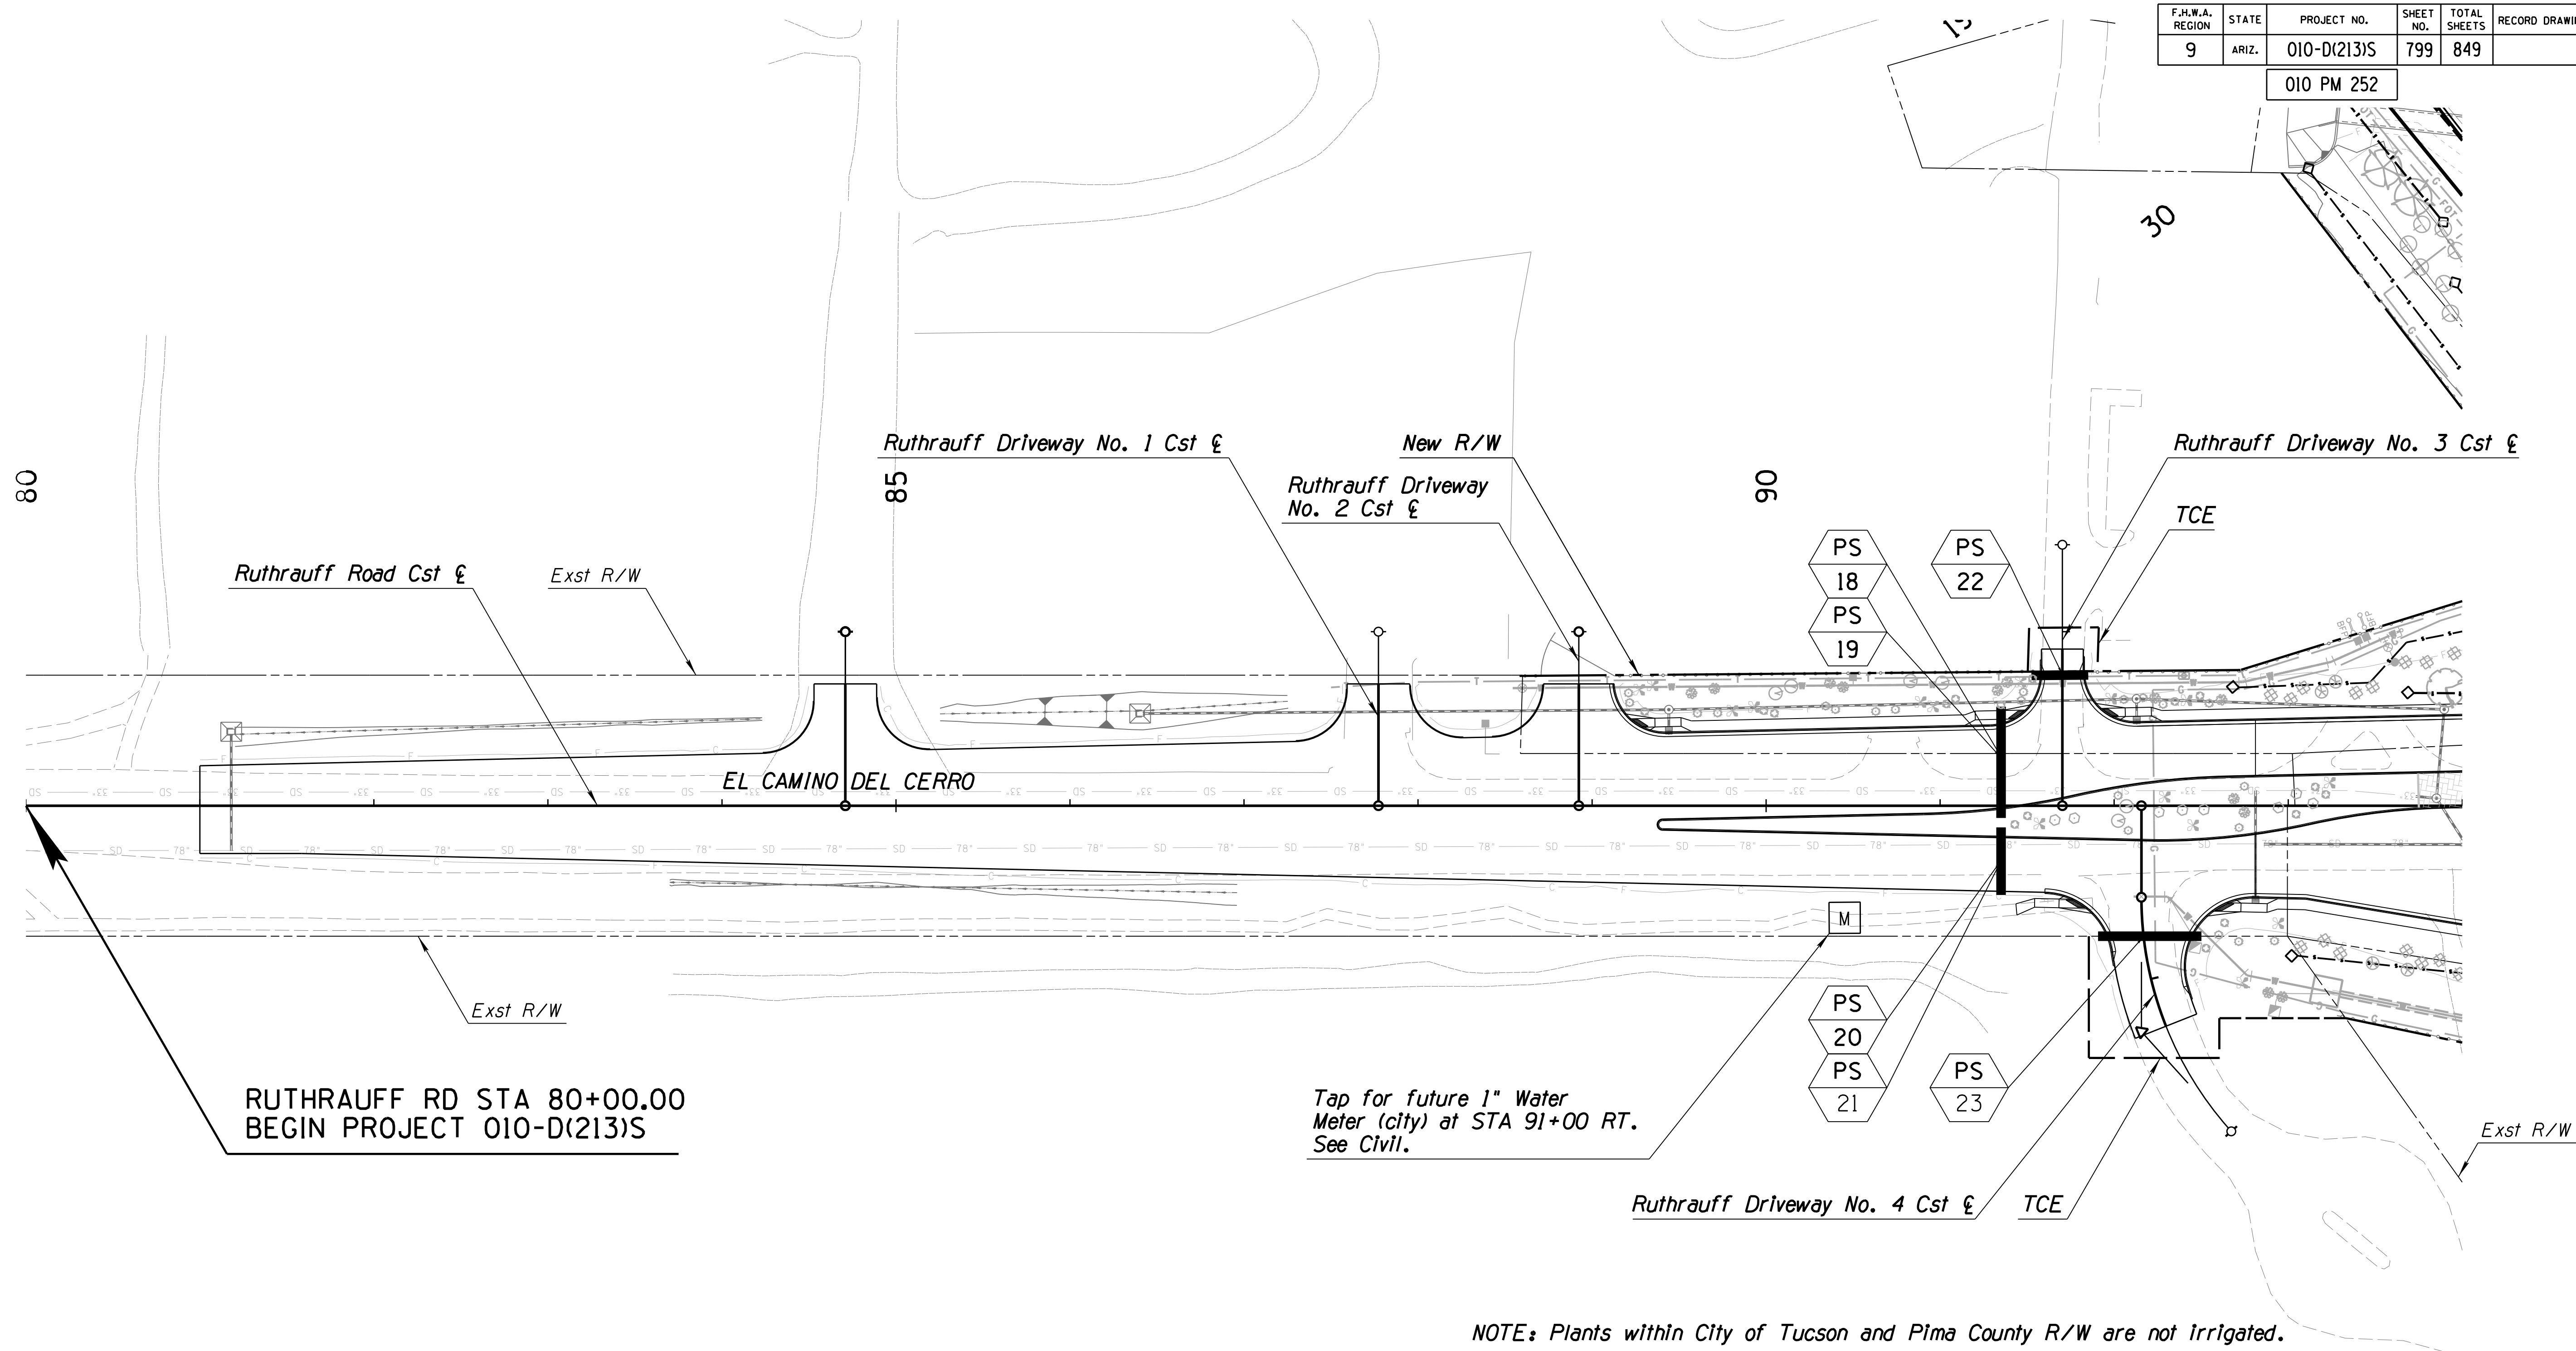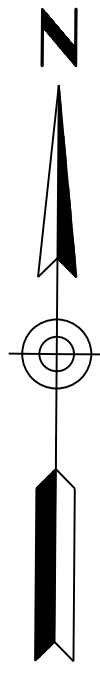

RUTHRAUFF RD STA 80+00.00  
BEGIN PROJECT 010-D(213)S

Tap for future 1" Water  
Meter (city) at STA 91+00 RT.  
See Civil.

NOTE: Plants within City of Tucson and Pima County R/W are not irrigated.

NOTE: The local street names are El Camino Del Cerro west of I-10 and Ruthrauff Road east of I-10. The construction  $\xi$  has been designated as Ruthrauff Road Cst  $\xi$  for entire length.

IRRIGATION CONSULTANT:  
Carl Kominsky, RLA, ASIC  
CARL KOMINSKY LANDSCAPE ARCHITECT, INC.  
Tucson, Arizona  
Phone: (520) 740-0700  
Email: ckominsky@comcast.net

DESIGN	CK	DATE	3/19	ARIZONA DEPARTMENT OF TRANSPORTATION INFRASTRUCTURE DELIVERY AND OPERATIONS DIVISION ROADSIDE DEVELOPMENT SECTION
DRAWN	WDC	DATE	3/19	
CHECKED	CK/LEM	DATE	3/19	
<b>WHEAT DESIGN GROUP</b>		LANDSCAPE ARCHITECTS		IRRIGATION PLAN RUTHRAUFF ROAD STA 81+00 TO 94+00
500 N TUCSON BLVD, SUITE 150, TUCSON AZ 85716				
ROUTE	I-10	LOCATION	RUTHRAUFF ROAD TI	DWG NO. 1-4.09
TRACS NO.	H 8480 OIC		010-D(213)S	OF











F.H.W.A. REGION	STATE	PROJECT NO.	SHEET NO.	TOTAL SHEETS	RECORD DRAWING
9	ARIZ.	010-D(213)S	801	849	

010 PM 252

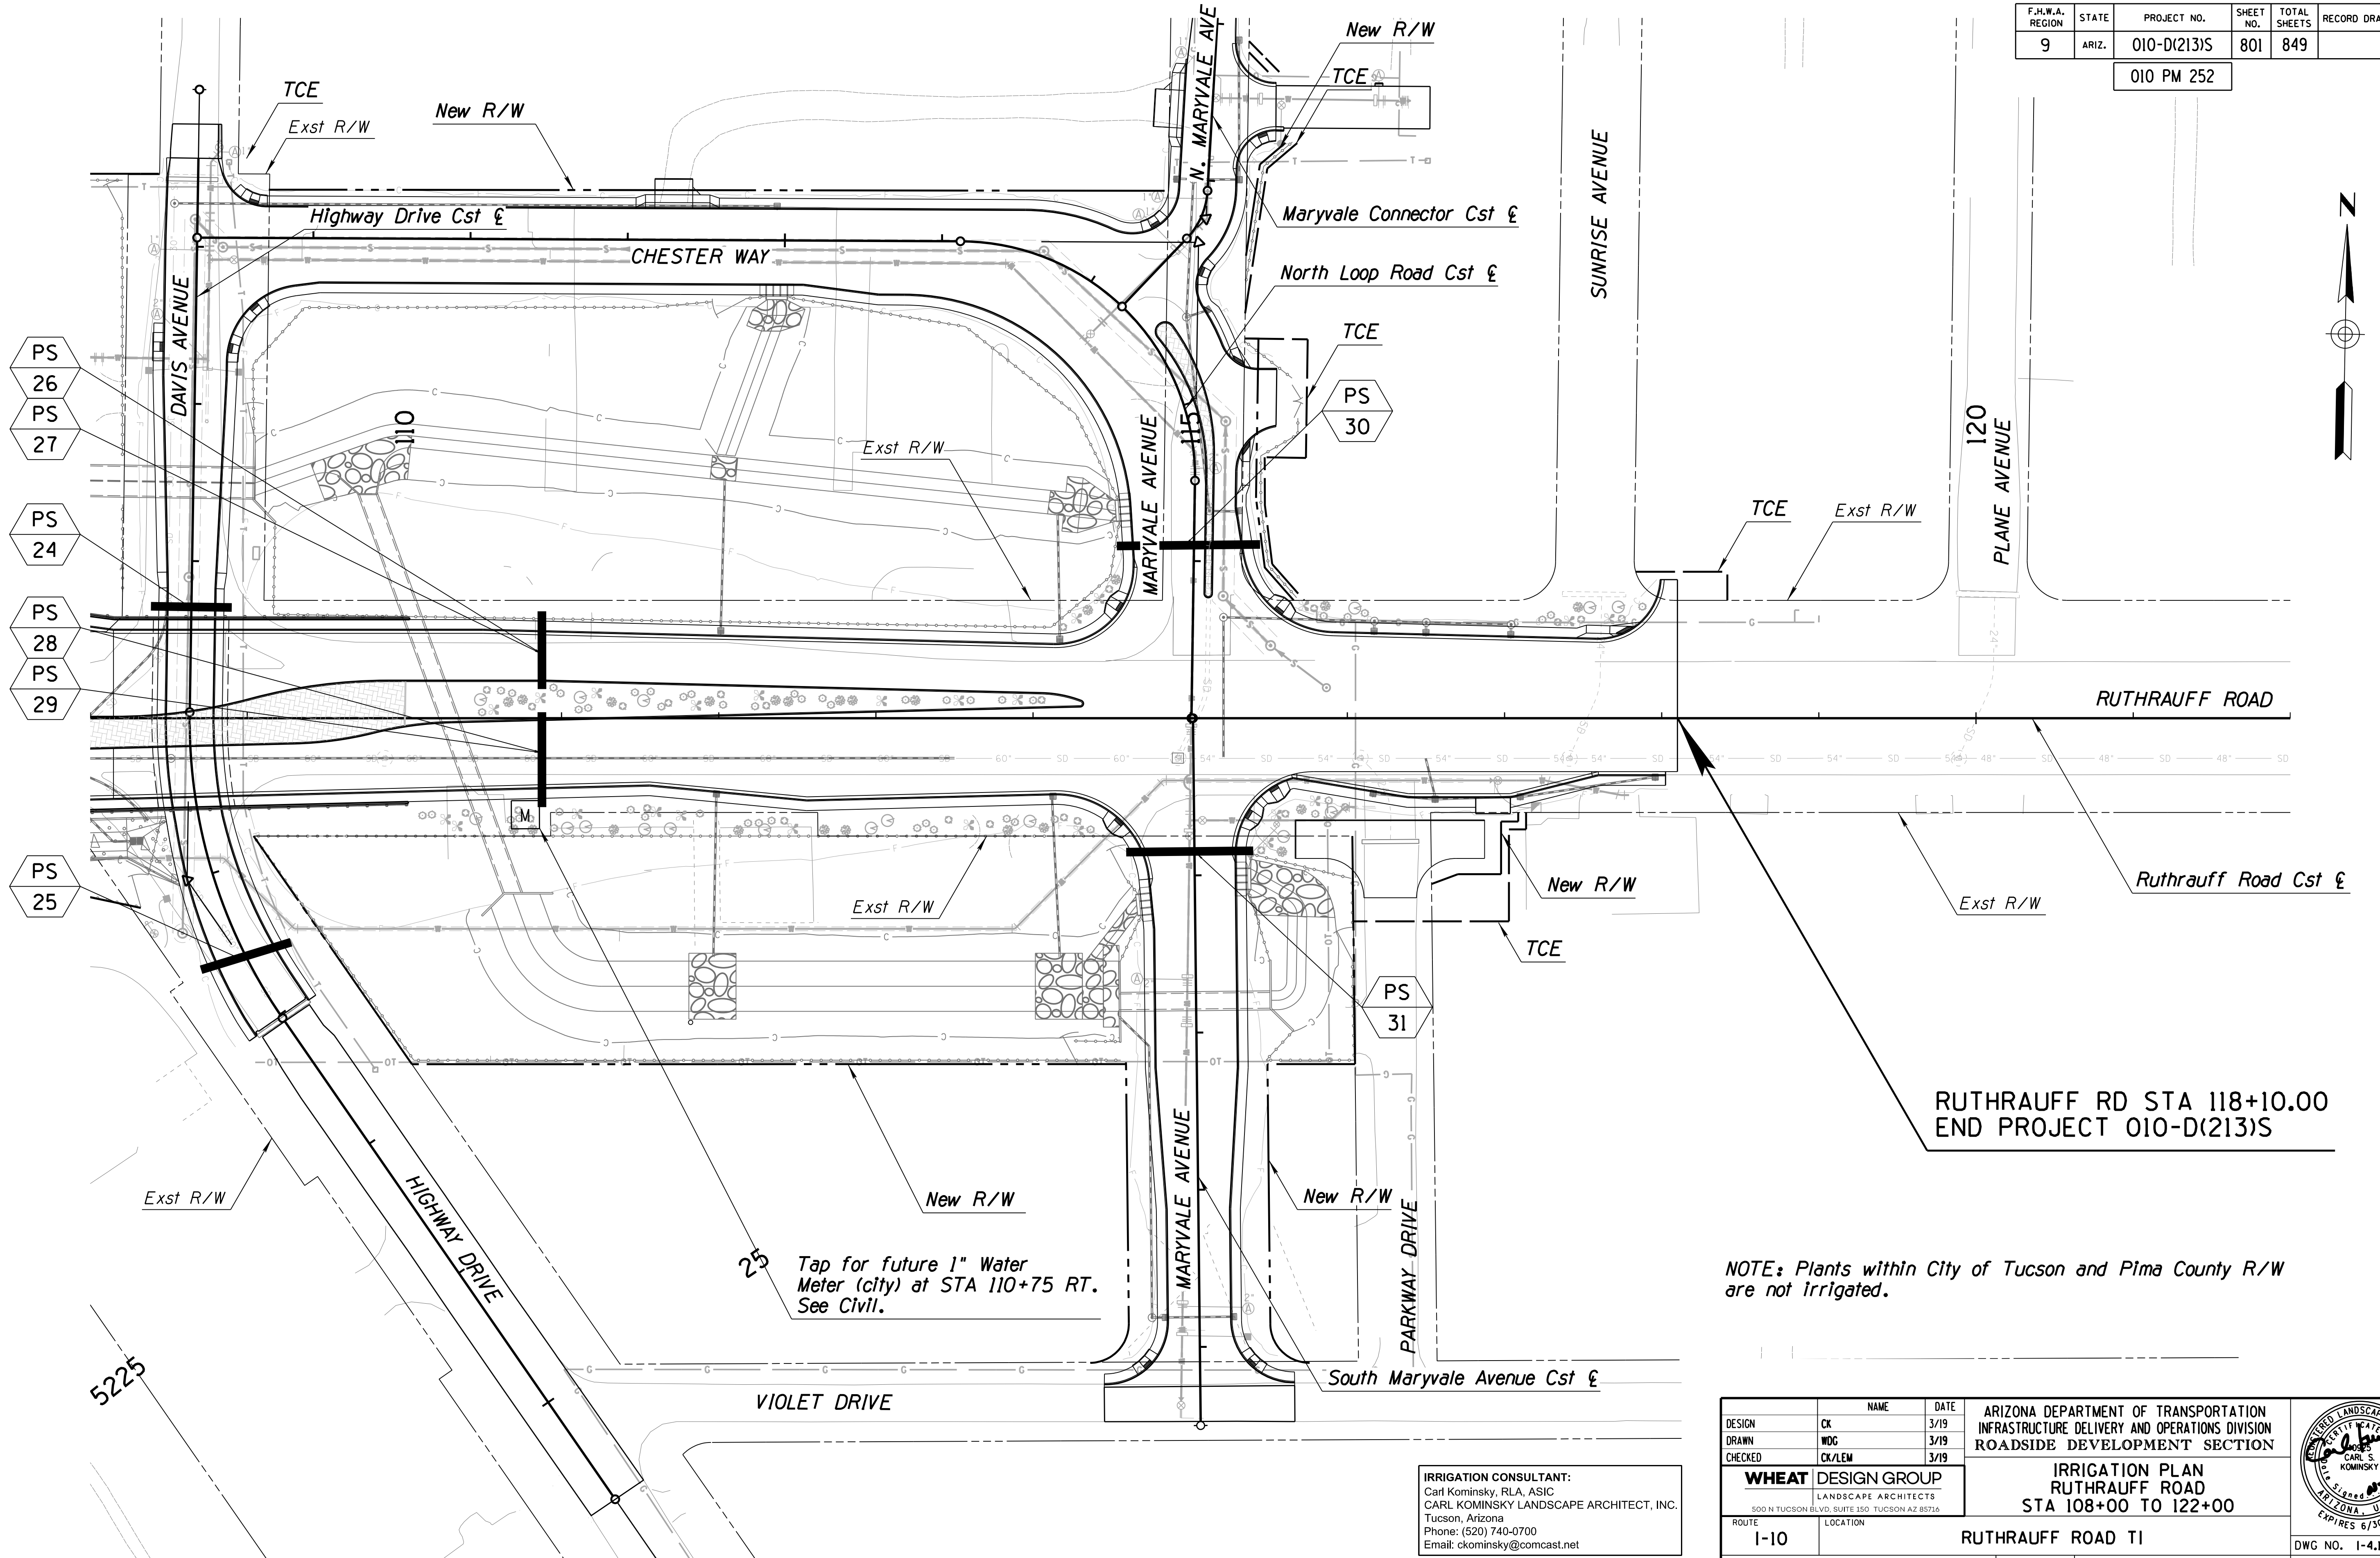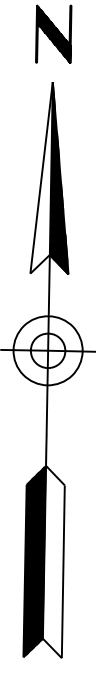

PS 26  
PS 27

PS 24

PS 28  
PS 29

PS 25

PS 30

PS 31


Tap for future 1" Water Meter (city) at STA 110+75 RT. See Civil.

RUTHRAUFF RD STA 118+10.00 END PROJECT 010-D(213)S

NOTE: Plants within City of Tucson and Pima County R/W are not irrigated.

IRRIGATION CONSULTANT:  
Carl Kominsky, RLA, ASIC  
CARL KOMINSKY LANDSCAPE ARCHITECT, INC.  
Tucson, Arizona  
Phone: (520) 740-0700  
Email: ckominsky@comcast.net

DESIGN	CK	3/19	ARIZONA DEPARTMENT OF TRANSPORTATION INFRASTRUCTURE DELIVERY AND OPERATIONS DIVISION ROADSIDE DEVELOPMENT SECTION
DRAWN	WDC	3/19	
CHECKED	CK/LEM	3/19	
<b>WHEAT DESIGN GROUP</b> LANDSCAPE ARCHITECTS 500 N TUCSON BLVD, SUITE 150 TUCSON AZ 85716			IRRIGATION PLAN RUTHRAUFF ROAD STA 108+00 TO 122+00
ROUTE	LOCATION		
I-10	RUTHRAUFF ROAD TI		DWG NO. I-4.11
TRACS NO. H 8480 OIC			010-D(213)S

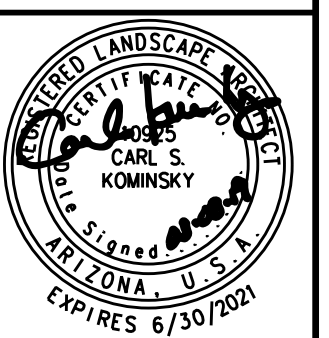

ccccSYSTEMEcccc



ccccDGNcSPECIFICATIONcccc

DATE- LOCATION- REVISIONS- FINISHED PLANS- SURVEY NO. DATE- LOCATION- REVISIONS- FINISHED PLANS- SURVEY NO. DATE- LOCATION- REVISIONS- FINISHED PLANS- SURVEY NO.

F.H.W.A. REGION	STATE	PROJECT NO.	SHEET NO.	TOTAL SHEETS	RECORD DRAWING
9	ARIZ.	010-D(213)S	802	849	

010 PM 252

# UTILITY RELOCATION PLANS

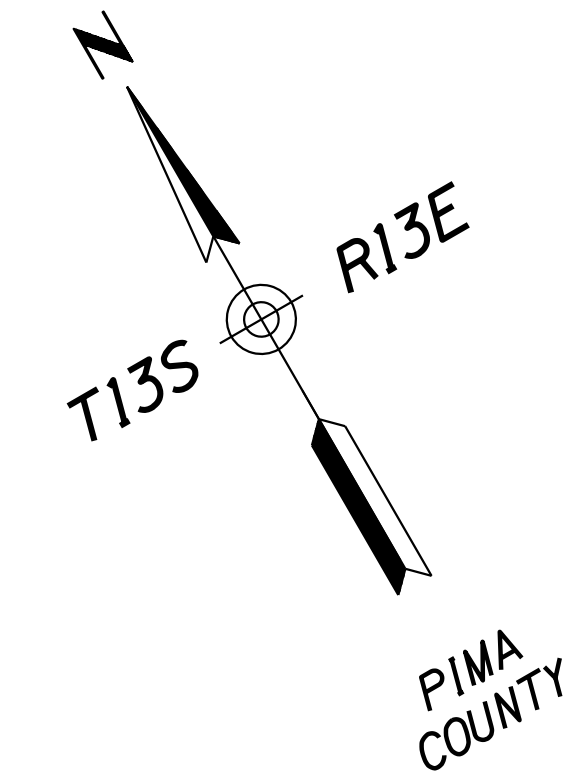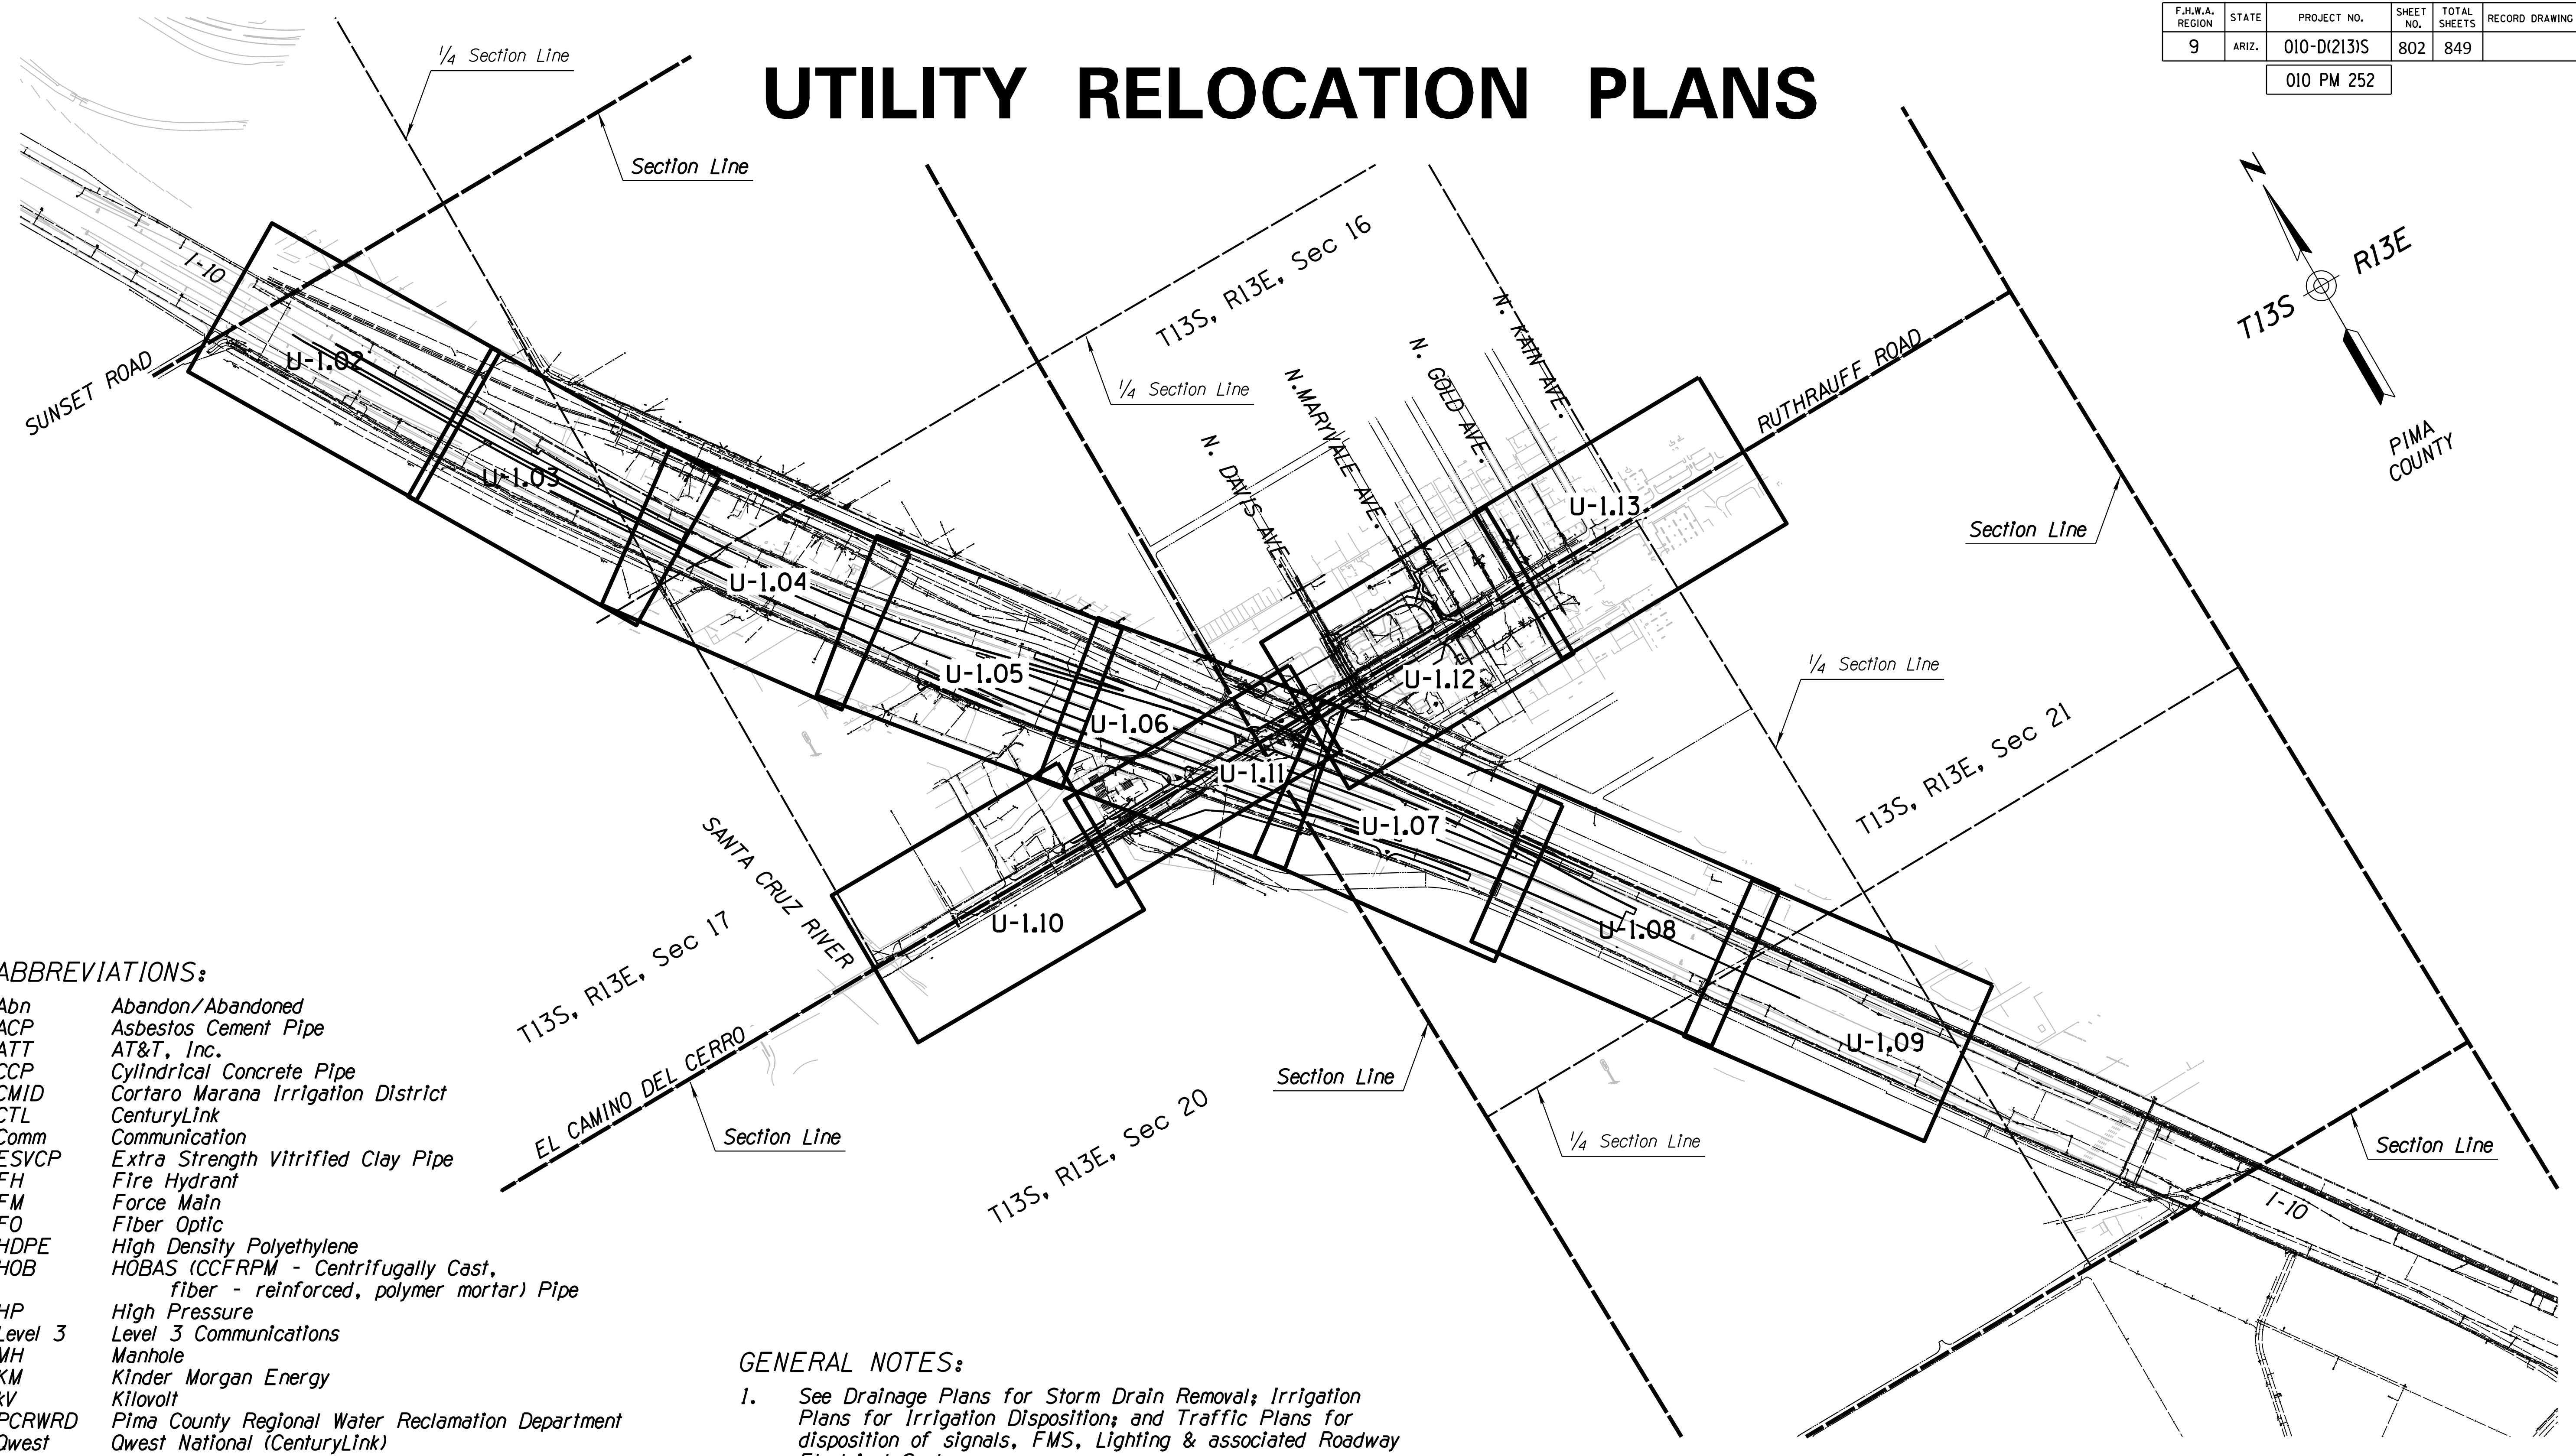

**ABBREVIATIONS:**

Abn	Abandon/Abandoned
ACP	Asbestos Cement Pipe
ATT	AT&T, Inc.
CCP	Cylindrical Concrete Pipe
CMID	Cortaro Marana Irrigation District
CTL	CenturyLink
Comm	Communication
ESVCP	Extra Strength Vitrified Clay Pipe
FH	Fire Hydrant
FM	Force Main
FO	Fiber Optic
HDPE	High Density Polyethylene
HOB	HOBAS (CCFRPM - Centrifugally Cast, fiber - reinforced, polymer mortar) Pipe
HP	High Pressure
Level 3	Level 3 Communications
MH	Manhole
KM	Kinder Morgan Energy
kV	Kilovolt
PCRWRD	Pima County Regional Water Reclamation Department
Qwest	Qwest National (CenturyLink)
SCADA	
Stl	Steel
SWG	Southwest Gas
Tel	Telephone
TEP	Tucson Electric Power
TLOC	T-LOC Lined Pipe
TW	Tucson Water
UPRR	Union Pacific Railroad
WT	WilTel Communications
WV	Water Valve

**GENERAL NOTES:**

1. See Drainage Plans for Storm Drain Removal; Irrigation Plans for Irrigation Disposition; and Traffic Plans for disposition of signals, FMS, Lighting & associated Roadway Electrical Systems.
2. All existing utilities are shown to Quality Level "B" and existing drainage facilities are shown to Quality Level "C", unless noted otherwise.
3. Sheets U02-U09 Station & Offsets are referenced from I-10 Cst & and Sheets U10-U13 Station & Offsets are referenced from El Camino Del Cerro/Ruthrauff Rd &, unless otherwise noted.

DESIGN	DL	DATE	3-19	ARIZONA DEPARTMENT OF TRANSPORTATION INFRASTRUCTURE DELIVERY AND OPERATIONS DIVISION ROADWAY DESIGN SERVICES		
DRAWN	CPG	DATE	3-19			
CHECKED	FF	DATE	3-19			
		WSP USA Inc. 177 N. Church Ave. Suite 1105 Tucson, AZ 85701		<b>UTILITY RELOCATION PLAN KEY MAP &amp; ABBREVIATIONS</b>		
ROUTE	I-10	LOCATION	RUTHRAUFF ROAD TI		DWG NO.	U-1.01
TRACS NO.	H 8480 OIC		010-D(213)S		OF	

DATE: \_\_\_\_\_ LOCATION: \_\_\_\_\_ REVISIONS: \_\_\_\_\_ FINISHED PLANS: \_\_\_\_\_ SURVEY NO.: \_\_\_\_\_ DATE: \_\_\_\_\_ LOCATION: \_\_\_\_\_ REVISIONS: \_\_\_\_\_ FINISHED PLANS: \_\_\_\_\_ SURVEY NO.: \_\_\_\_\_




UTILITY DISPOSITION LEGEND

- A** To Remain in Service
- B** Remove
- C** Adjust to Grade
- D** Remove by Others
- E** Relocate by Others
- F** Abandon in Place

F.H.W.A. REGION	STATE	PROJECT NO.	SHEET NO.	TOTAL SHEETS	RECORD DRAWING
9	ARIZ.	010-D(213)S	803	849	

010 PM 252

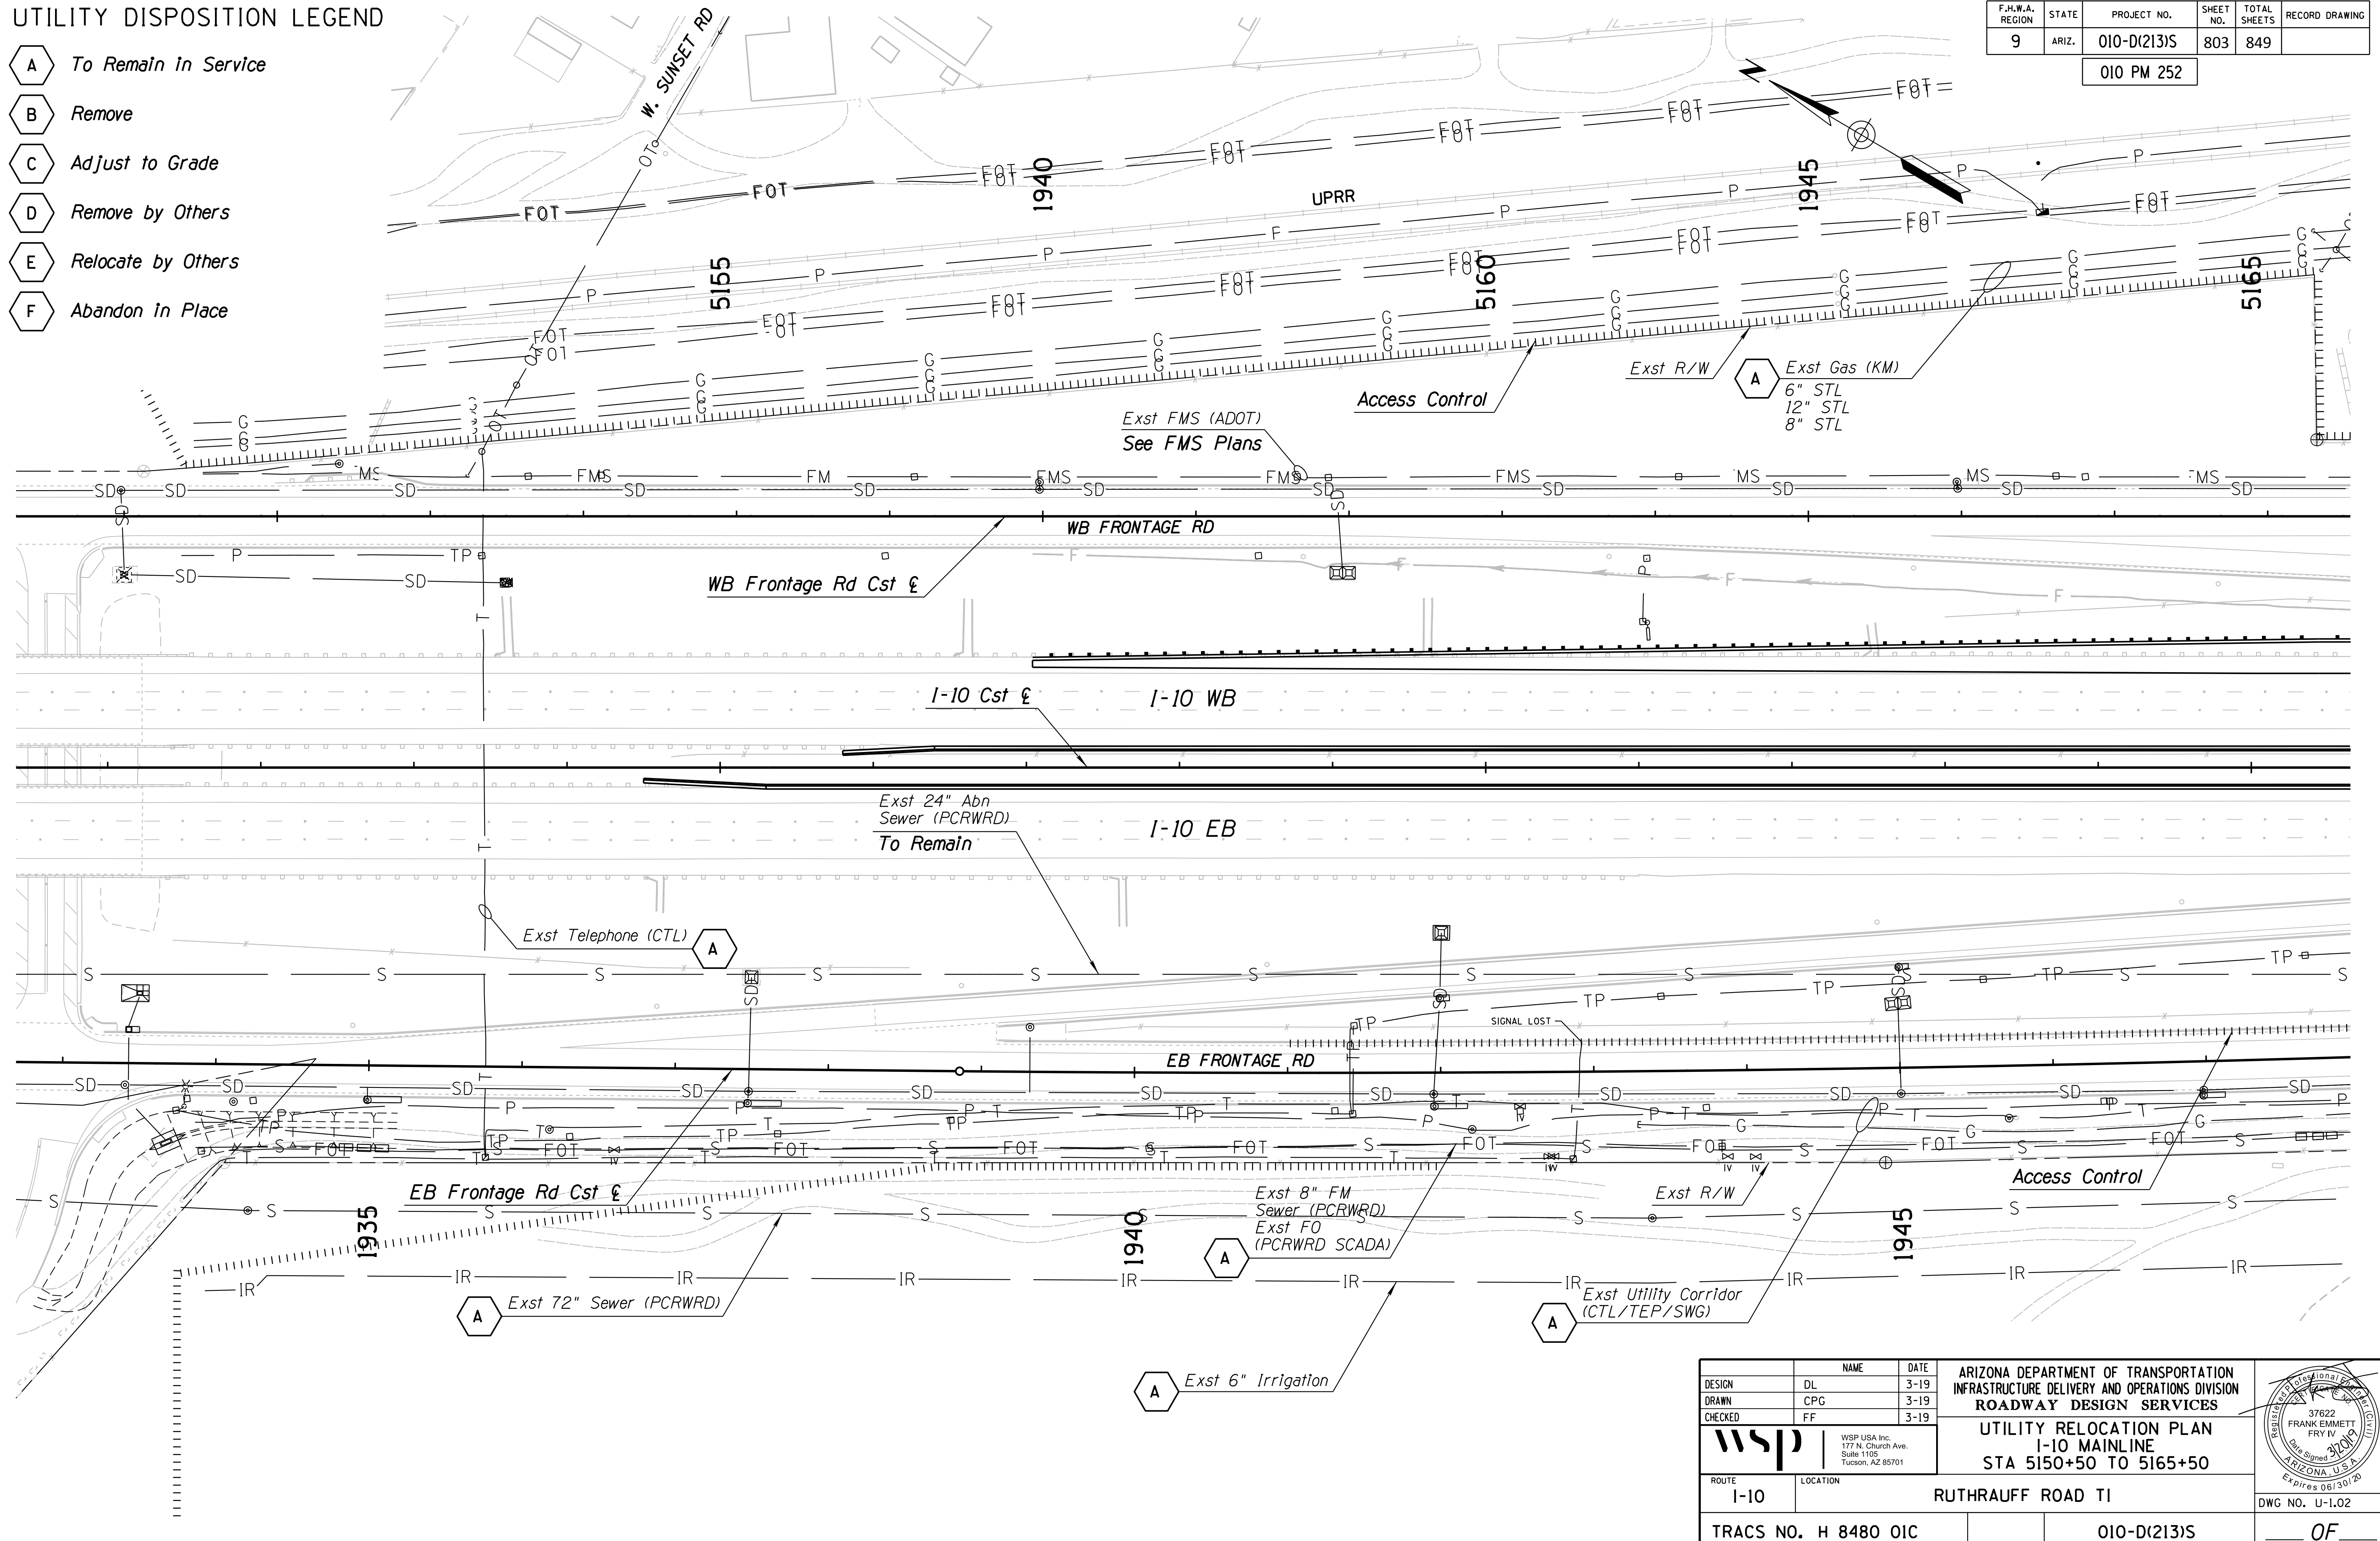

DATE: \_\_\_\_\_ LOCATION: \_\_\_\_\_ REVISIONS: \_\_\_\_\_ FINISHED PLANS: \_\_\_\_\_ SURVEY NO.: \_\_\_\_\_ DATE: \_\_\_\_\_ LOCATION: \_\_\_\_\_ REVISIONS: \_\_\_\_\_ FINISHED PLANS: \_\_\_\_\_ SURVEY NO.: \_\_\_\_\_

DESIGN	DL	DATE	3-19
DRAWN	CPG	DATE	3-19
CHECKED	FF	DATE	3-19

WSP USA Inc. 177 N. Church Ave. Suite 1105 Tucson, AZ 85701	ARIZONA DEPARTMENT OF TRANSPORTATION INFRASTRUCTURE DELIVERY AND OPERATIONS DIVISION ROADWAY DESIGN SERVICES
	UTILITY RELOCATION PLAN I-10 MAINLINE STA 5150+50 TO 5165+50


ROUTE	I-10	LOCATION	RUTHRAUFF ROAD TI
TRACS NO.	H 8480 OIC	PROJECT NO.	010-D(213)S

DWG NO. U-1.02 OF
----------------------

F.H.W.A. REGION	STATE	PROJECT NO.	SHEET NO.	TOTAL SHEETS	RECORD DRAWING
9	ARIZ.	010-D(213)S	804	849	

010 PM 252

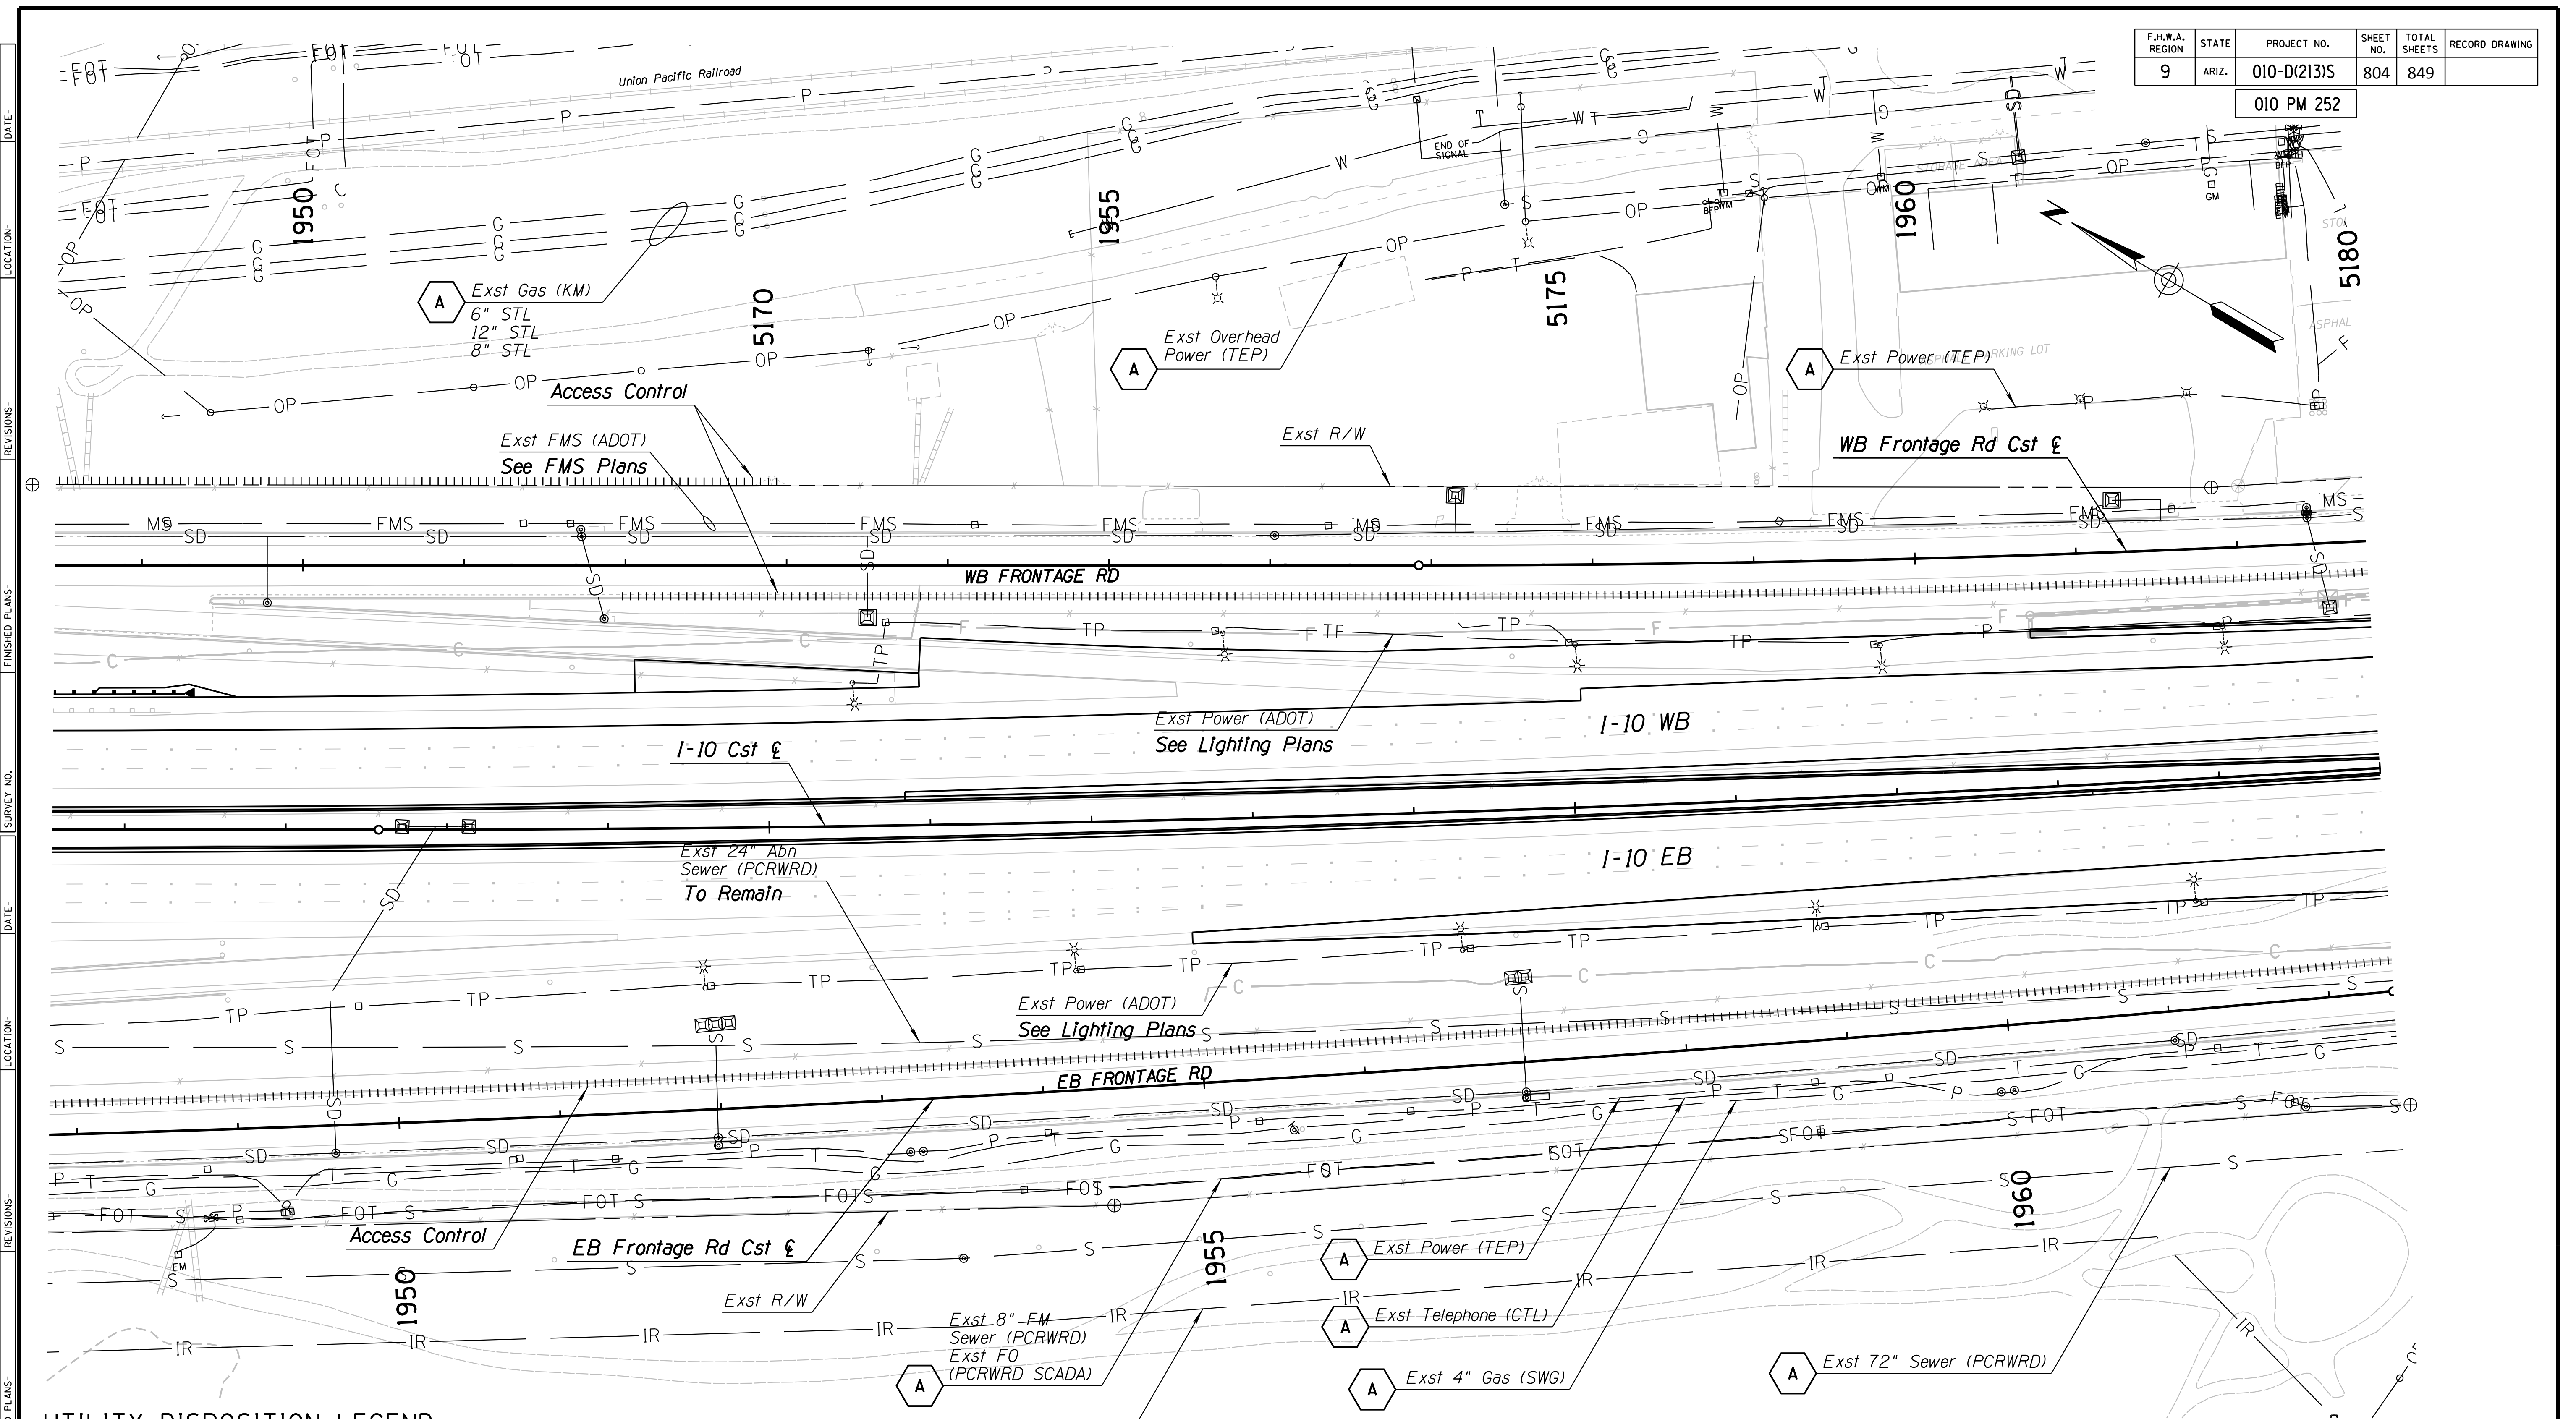


**UTILITY DISPOSITION LEGEND**

<b>A</b> To Remain in Service	<b>E</b> Relocate by Others
<b>B</b> Remove	<b>F</b> Abandon in Place
<b>C</b> Adjust to Grade	
<b>D</b> Remove by Others	

DESIGN	DL	DATE	3-19	<b>ARIZONA DEPARTMENT OF TRANSPORTATION</b> <b>INFRASTRUCTURE DELIVERY AND OPERATIONS DIVISION</b> <b>ROADWAY DESIGN SERVICES</b>
DRAWN	CPG	DATE	3-19	
CHECKED	FF	DATE	3-19	
		WSP USA Inc. 177 N. Church Ave. Suite 1105 Tucson, AZ 85701		<b>UTILITY RELOCATION PLAN</b> <b>I-10 MAINLINE</b> <b>STA 5165+50 TO 5180+00</b>
ROUTE	I-10	LOCATION	RUTHRAUFF ROAD TI	
TRACS NO. H 8480 OIC		010-D(213)S		OF

F.H.W.A. REGION	STATE	PROJECT NO.	SHEET NO.	TOTAL SHEETS	RECORD DRAWING
9	ARIZ.	010-D(213)S	805	849	

010 PM 252

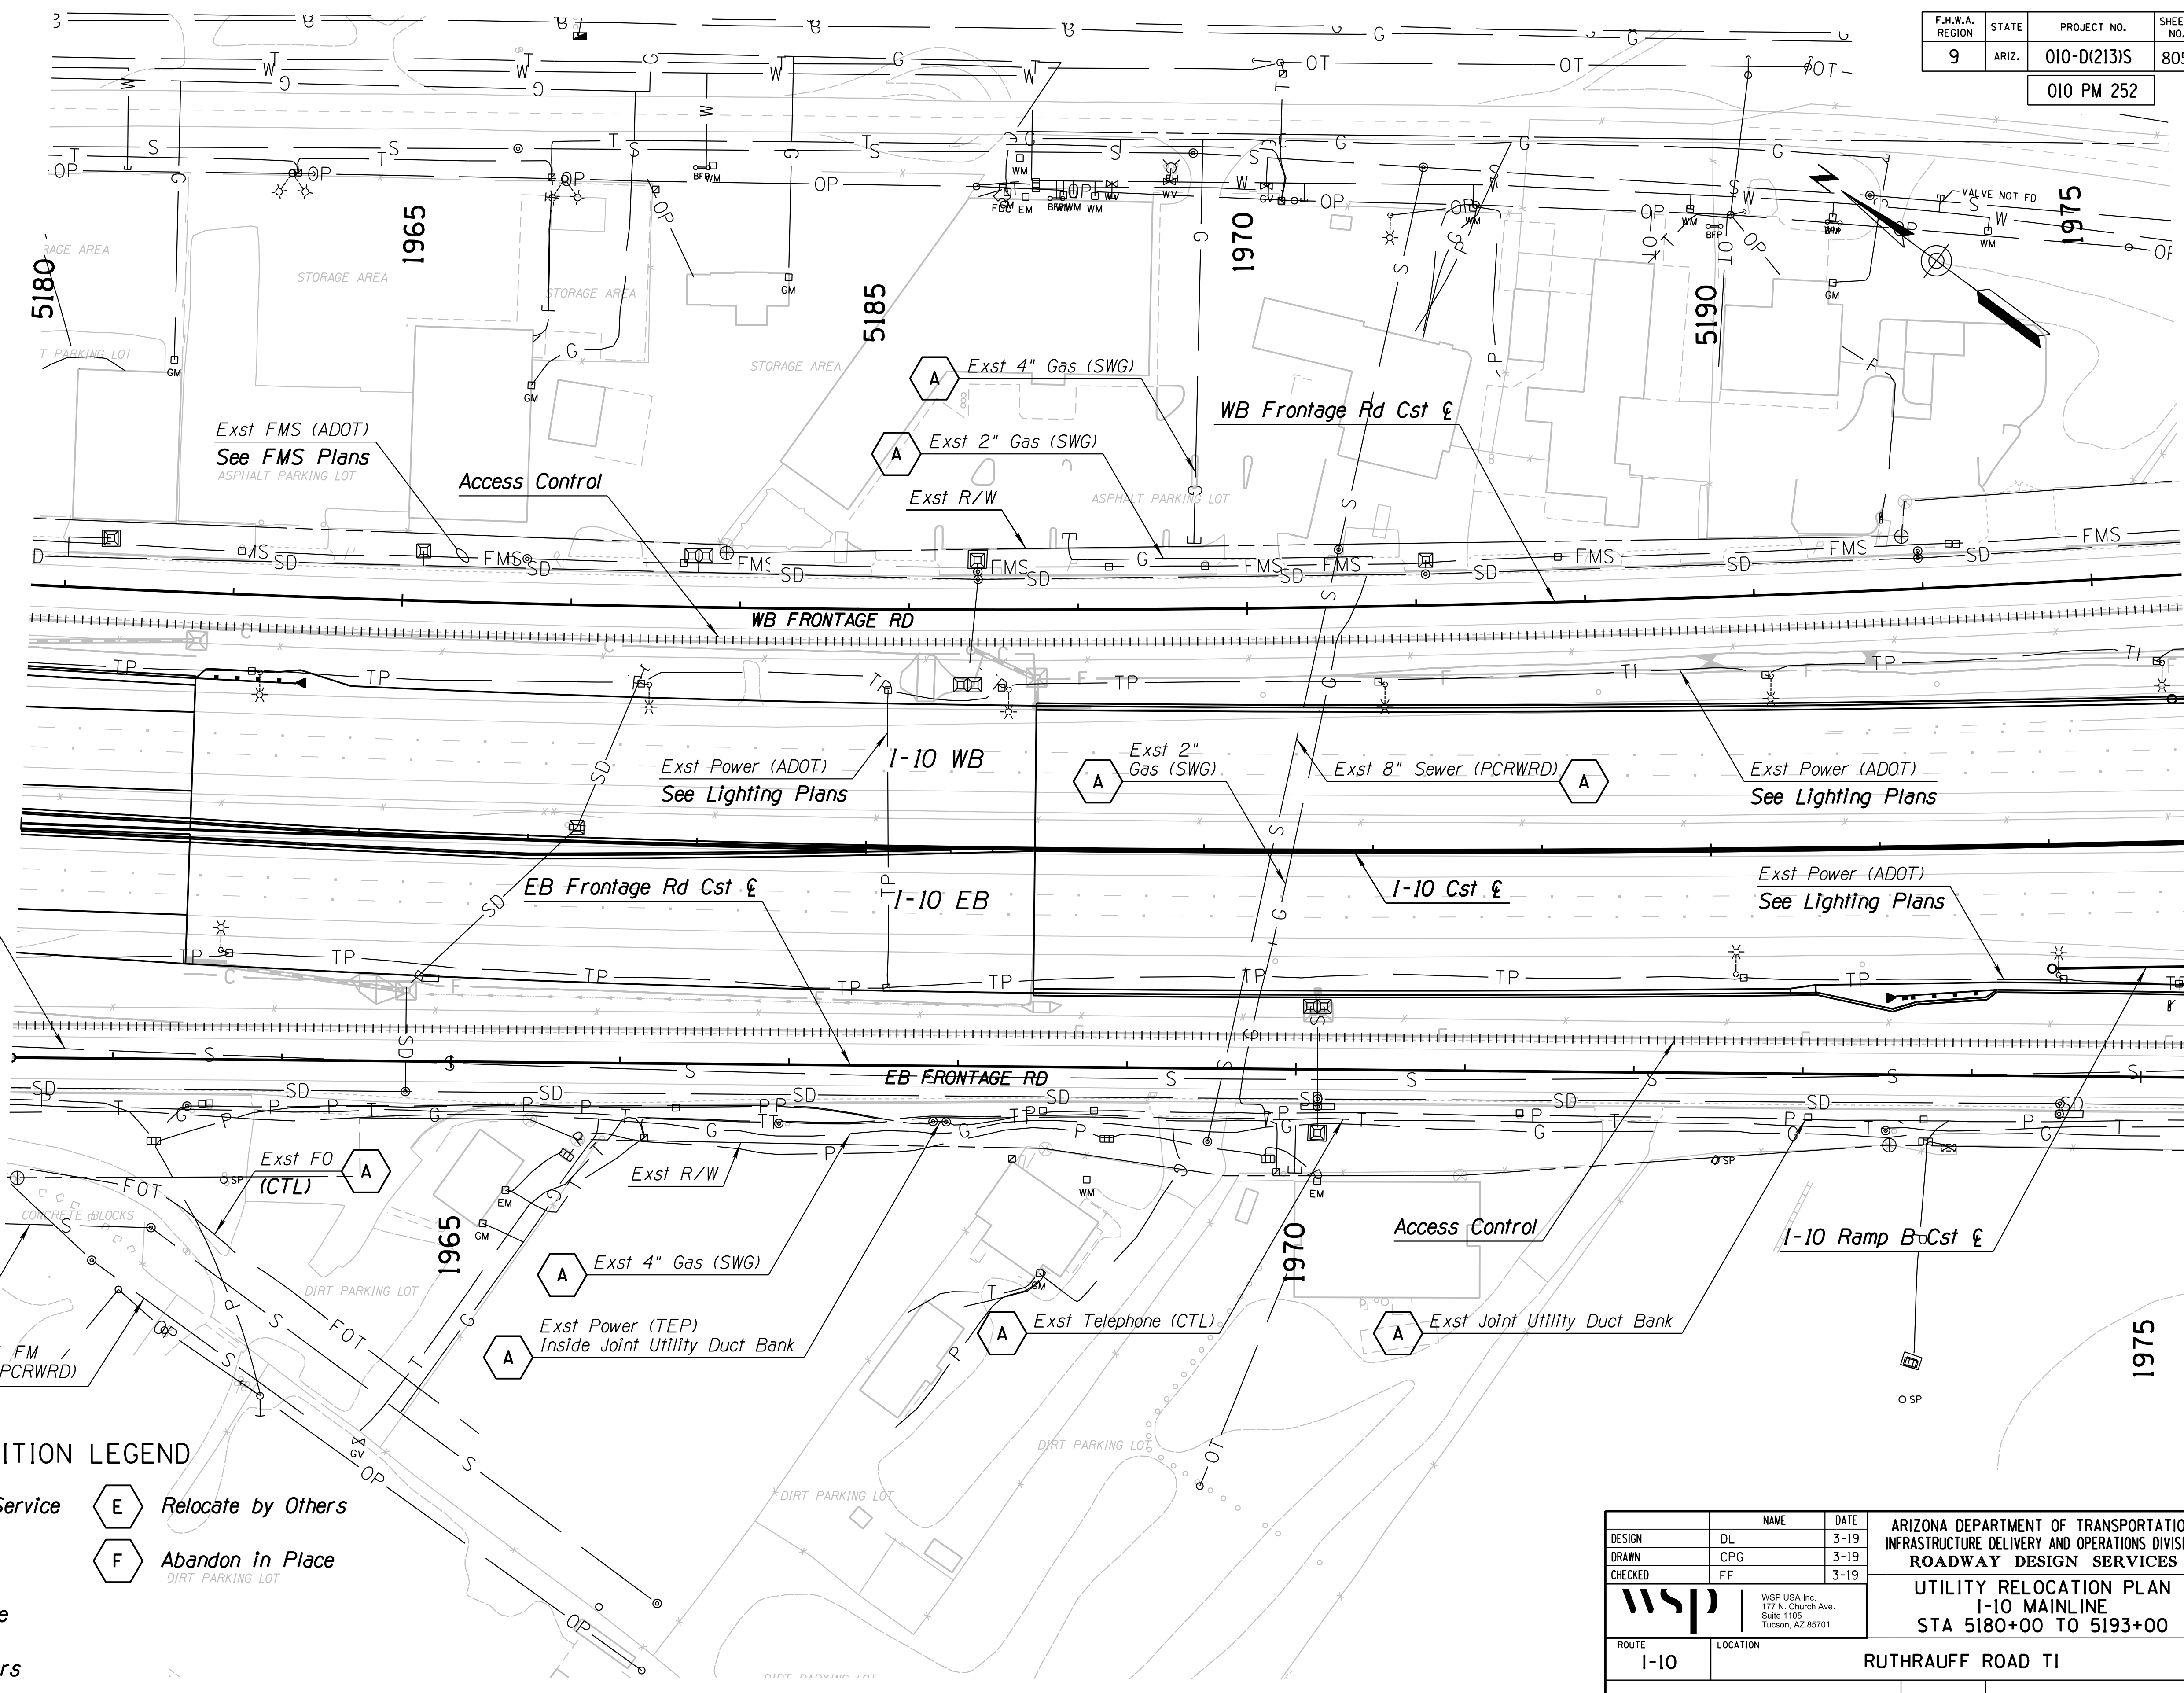

Exst 24" Abn Sewer (PCRWRD)  
To Remain

Exst 72" Sewer (PCRWRD)

Exst 8" FM Sewer (PCRWRD)

Exst FO (CTL)

Exst 4" Gas (SWG)

Exst Power (TEP) Inside Joint Utility Duct Bank

Exst Telephone (CTL)

Exst Joint Utility Duct Bank

**UTILITY DISPOSITION LEGEND**

- A** To Remain in Service
- B** Remove
- C** Adjust to Grade
- D** Remove by Others
- E** Relocate by Others
- F** Abandon in Place

DESIGN	DL	DATE	3-19
DRAWN	CPG	DATE	3-19
CHECKED	FF	DATE	3-19
<b>wsp</b>			
WSP USA Inc. 177 N. Church Ave. Suite 1105 Tucson, AZ 85701			
ROUTE	LOCATION		
I-10	RUTHRAUFF ROAD TI		
TRACS NO. H 8480 OIC		010-D(213)S	

ARIZONA DEPARTMENT OF TRANSPORTATION  
INFRASTRUCTURE DELIVERY AND OPERATIONS DIVISION  
**ROADWAY DESIGN SERVICES**

**UTILITY RELOCATION PLAN**  
I-10 MAINLINE  
STA 5180+00 TO 5193+00

Professional Engineer  
37622  
FRANK EMMETT  
FRY IV  
Date Signed: 3/20/19  
Expires 06/30/20  
ARIZONA U.S.A.

DWG NO. U-1.04  
OF

SURVEY NO. FINISHED PLANS DATE LOCATION REVISIONS FINISHED PLANS DATE SURVEY NO. FINISHED PLANS DATE LOCATION REVISIONS FINISHED PLANS DATE SURVEY NO.




UTILITY DISPOSITION LEGEND

- A** To Remain In Service
- B** Remove
- C** Adjust to Grade
- D** Remove by Others
- E** Relocate by Others
- F** Abandon In Place

F.H.W.A. REGION	STATE	PROJECT NO.	SHEET NO.	TOTAL SHEETS	RECORD DRAWING
9	ARIZ.	010-D(213)S			

010 PM 252

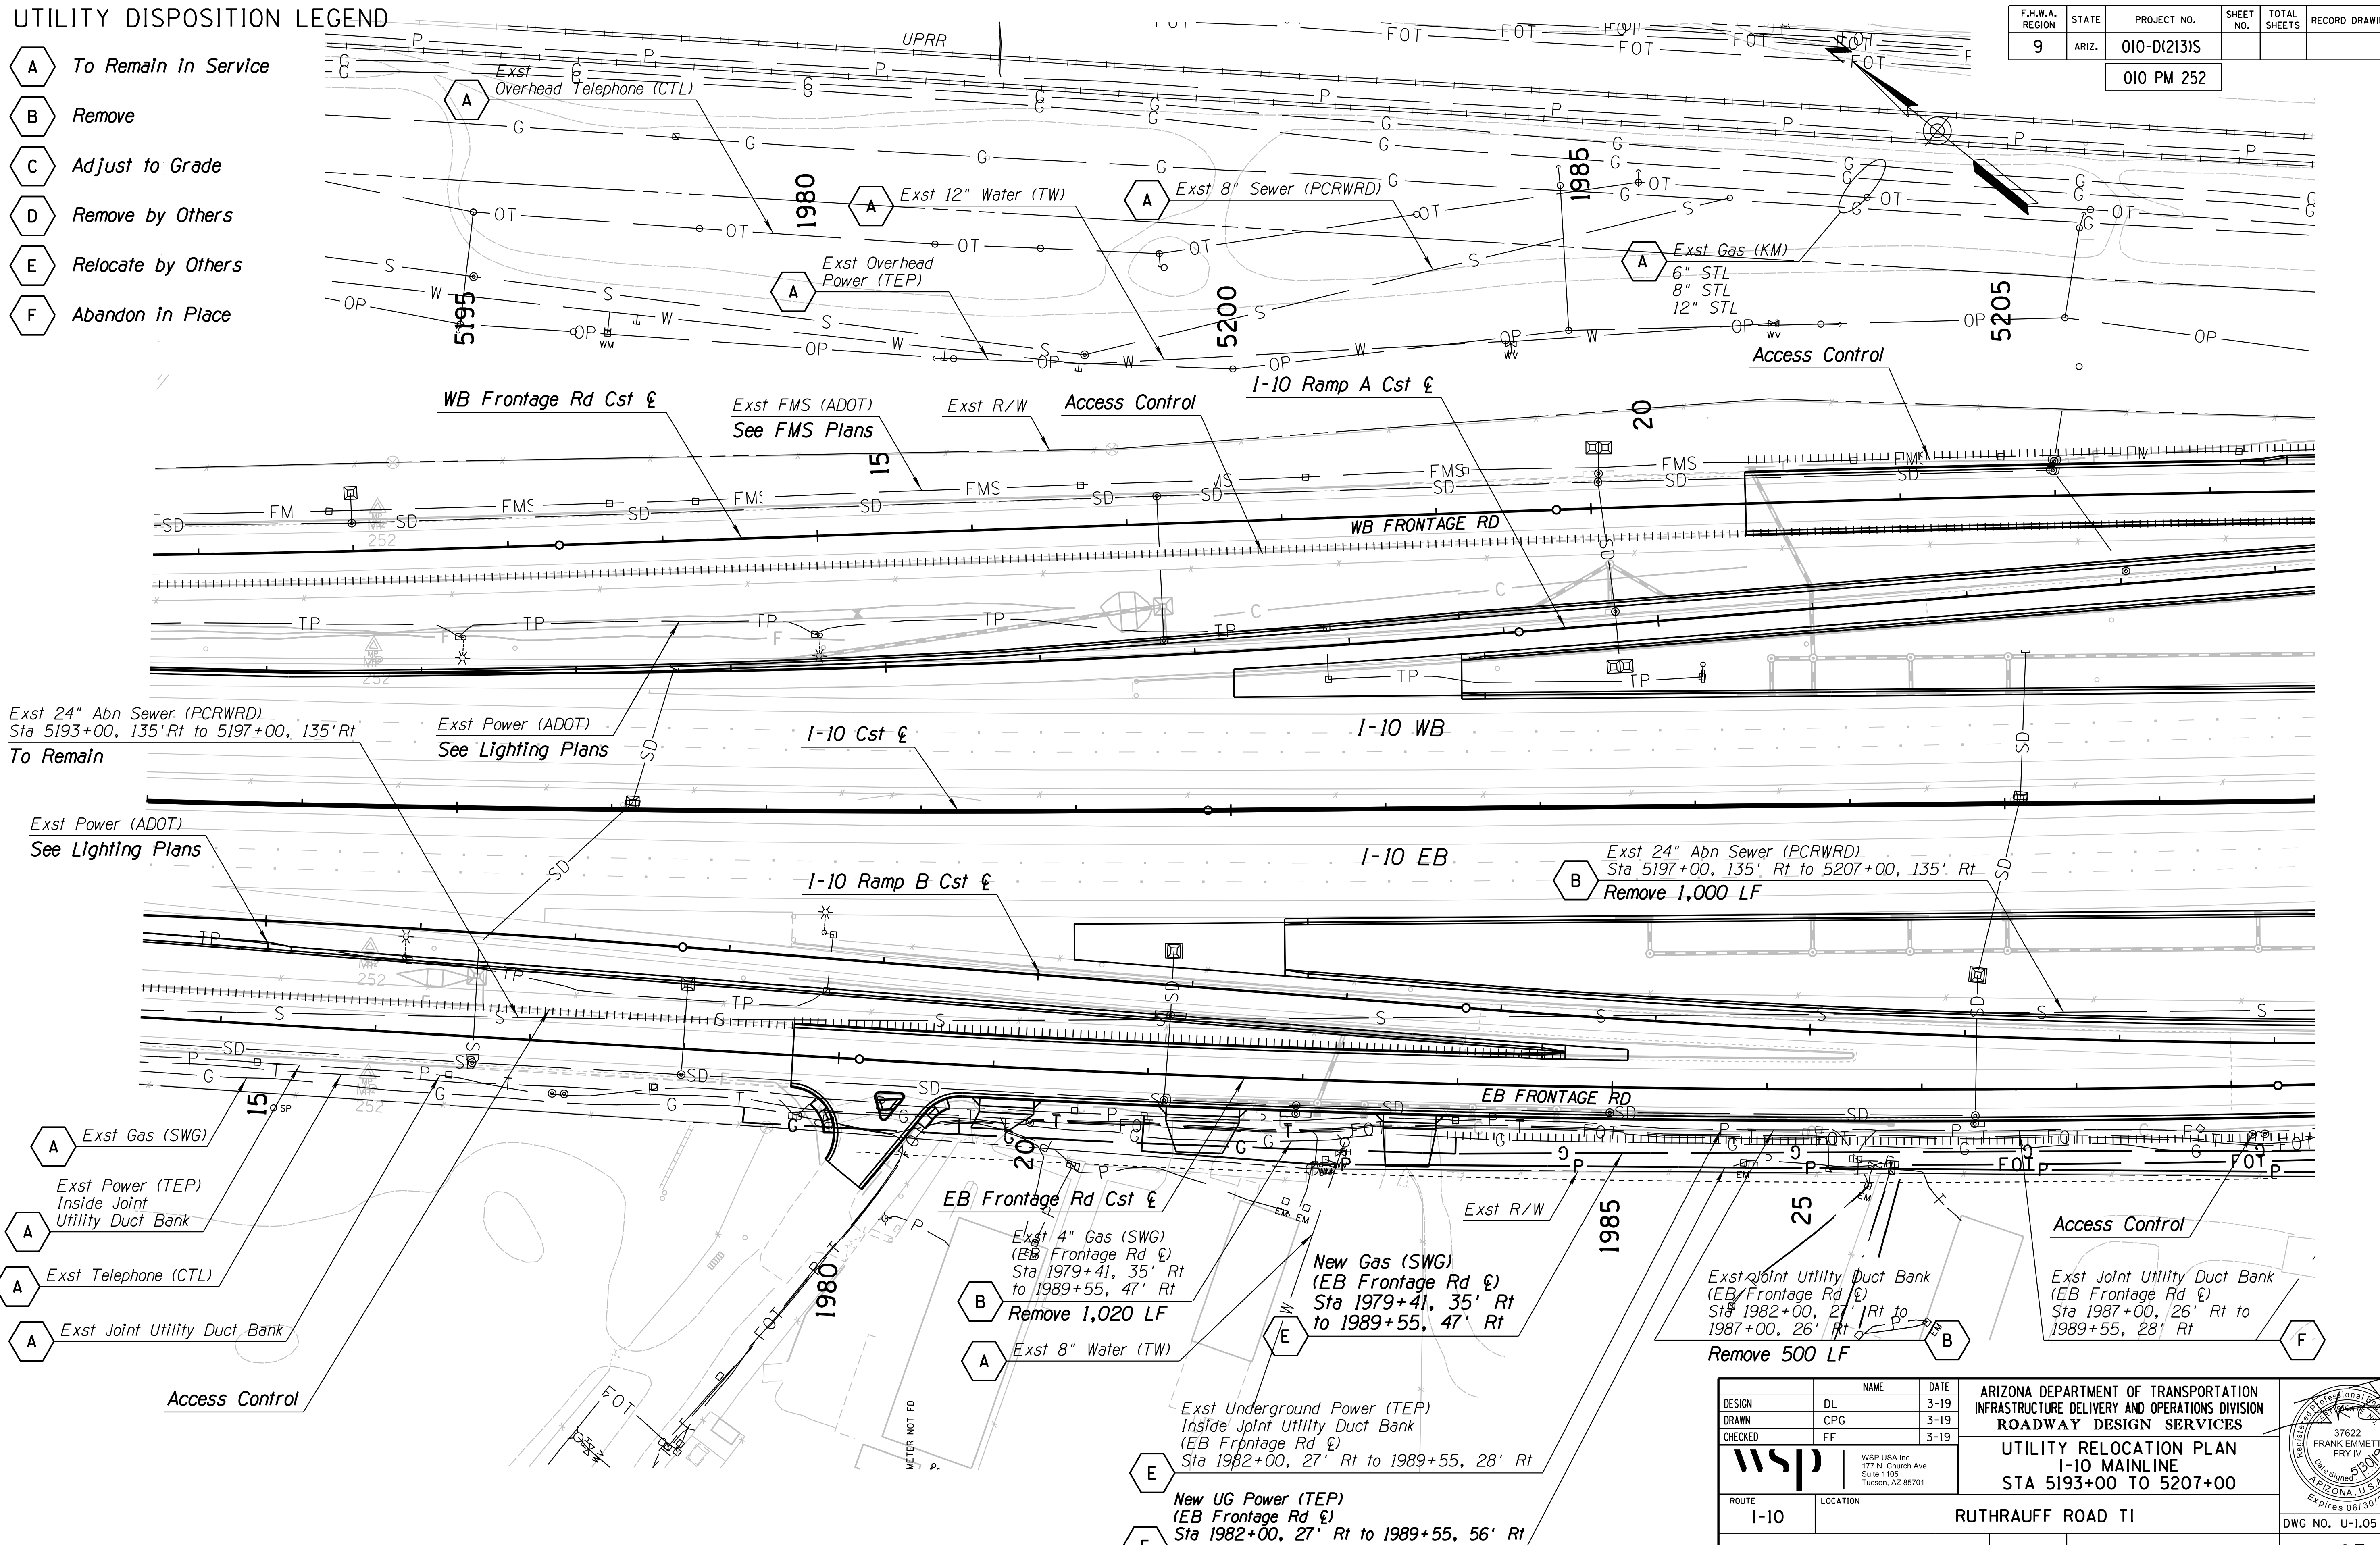

Exst 24" Abn Sewer (PCRWRD)  
Sta 5193+00, 135' Rt to 5197+00, 135' Rt  
To Remain

Exst Power (ADOT)  
See Lighting Plans

Exst 24" Abn Sewer (PCRWRD)  
Sta 5197+00, 135' Rt to 5207+00, 135' Rt  
Remove 1,000 LF

- A** Exst Gas (SWG)
- A** Exst Power (TEP) Inside Joint Utility Duct Bank
- A** Exst Telephone (CTL)
- A** Exst Joint Utility Duct Bank

Exst 4" Gas (SWG) (EB Frontage Rd) Sta 1979+41, 35' Rt to 1989+55, 47' Rt  
Remove 1,020 LF

Exst 8" Water (TW)

New Gas (SWG) (EB Frontage Rd) Sta 1979+41, 35' Rt to 1989+55, 47' Rt


Exst Underground Power (TEP) Inside Joint Utility Duct Bank (EB Frontage Rd) Sta 1982+00, 27' Rt to 1989+55, 28' Rt

New UG Power (TEP) (EB Frontage Rd) Sta 1982+00, 27' Rt to 1989+55, 56' Rt

DESIGN	NAME	DATE
DL		3-19
CPG		3-19
FF		3-19

ARIZONA DEPARTMENT OF TRANSPORTATION  
INFRASTRUCTURE DELIVERY AND OPERATIONS DIVISION  
ROADWAY DESIGN SERVICES

UTILITY RELOCATION PLAN  
I-10 MAINLINE  
STA 5193+00 TO 5207+00

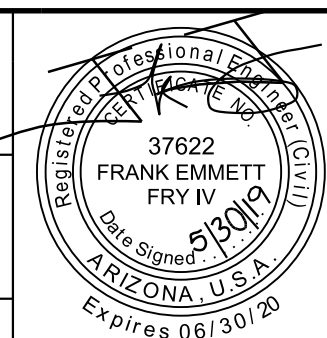

ROUTE	LOCATION	DWG NO.
I-10	RUTHERAUFF ROAD TI	U-1.05
TRACS NO.	H 8480 OIC	010-D(213)S
		OF












F.H.W.A. REGION	STATE	PROJECT NO.	SHEET NO.	TOTAL SHEETS	RECORD DRAWING
9	ARIZ.	010-D(213)S	809	849	

010 PM 252

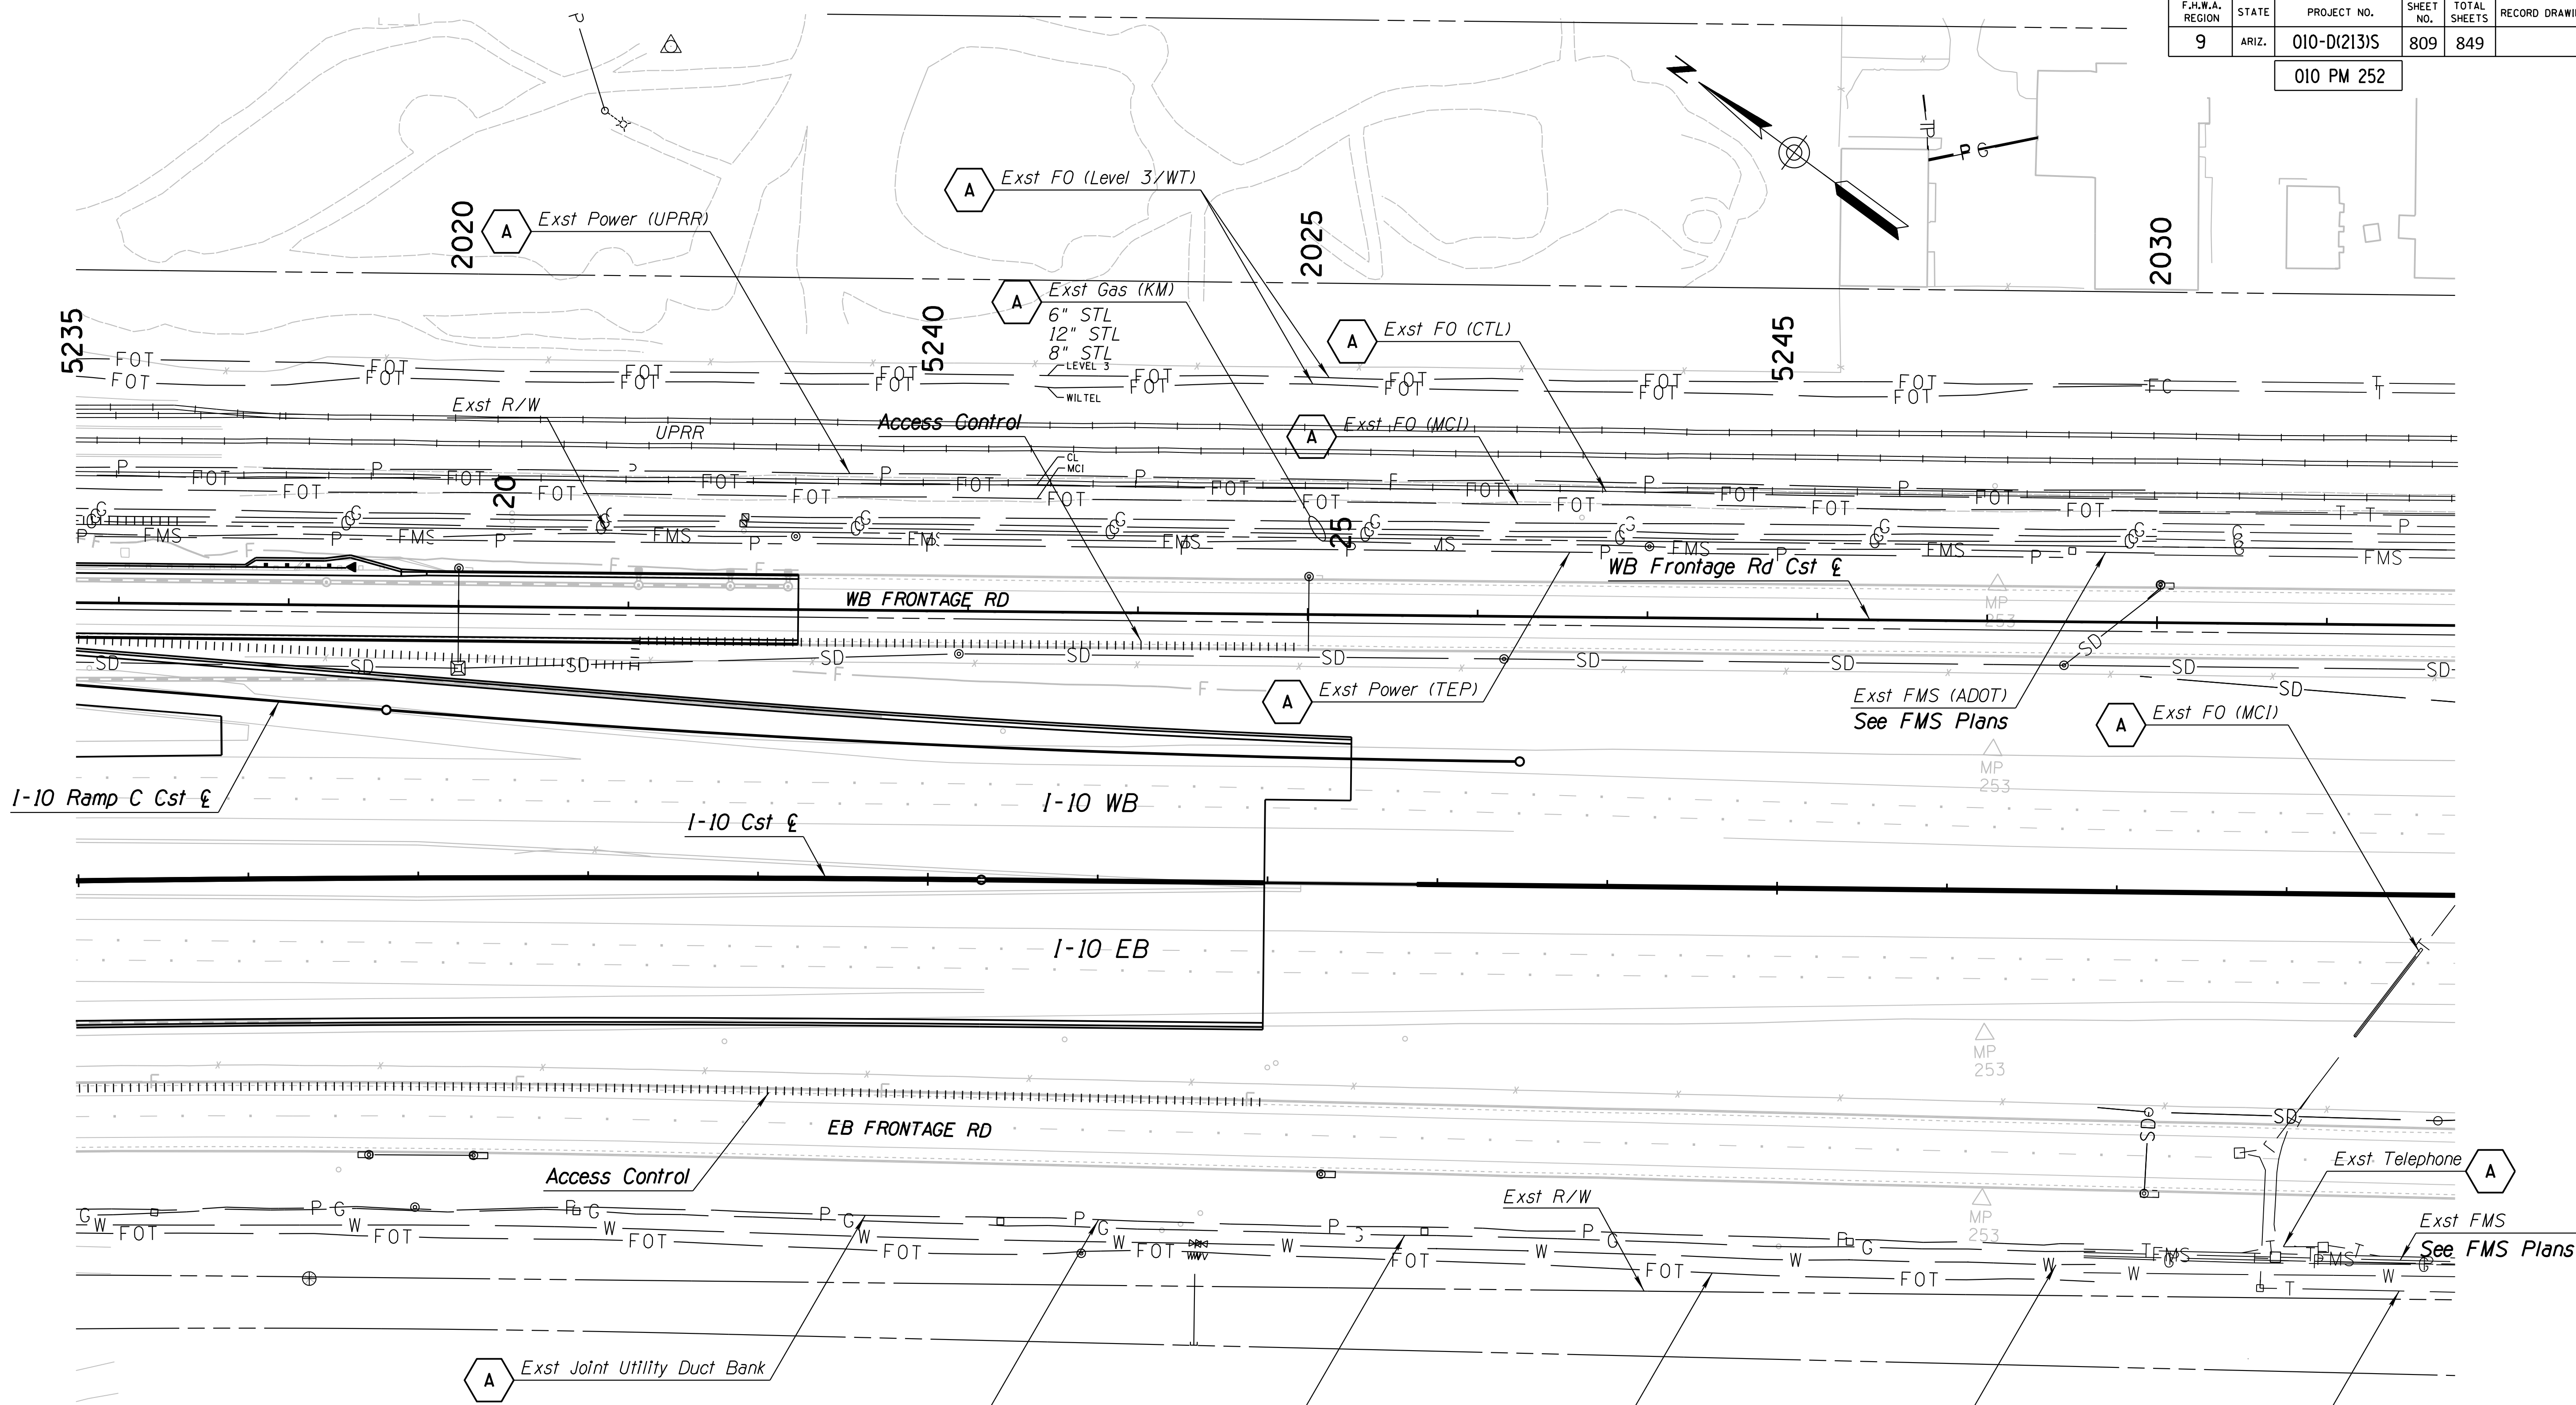


**UTILITY DISPOSITION LEGEND**

- |                               |                             |
|-------------------------------|-----------------------------|
| <b>A</b> To Remain in Service | <b>E</b> Relocate by Others |
| <b>B</b> Remove               | <b>F</b> Abandon in Place   |
| <b>C</b> Adjust to Grade      |                             |
| <b>D</b> Remove by Others     |                             |

- |   |                            |                               |                              |                                  |
|---|----------------------------|-------------------------------|------------------------------|----------------------------------|
| <b>A</b> Exst Power (TEP)<br>Inside Joint Utility Duct Bank | <b>A</b> Exst 4" Gas (SWG) | <b>A</b> Exst Telephone (CTL) | <b>A</b> Exst 16" Water (TW) | <b>A</b> Exst 4" Telephone (CTL) |
|---|----------------------------|-------------------------------|------------------------------|----------------------------------|


DESIGN	DL	DATE	3-19	<b>ARIZONA DEPARTMENT OF TRANSPORTATION</b> <b>INFRASTRUCTURE DELIVERY AND OPERATIONS DIVISION</b> <b>ROADWAY DESIGN SERVICES</b>
DRAWN	CPG	DATE	3-19	
CHECKED	FF	DATE	3-19	
		WSP USA Inc. 177 N. Church Ave. Suite 1105 Tucson, AZ 85701		<b>UTILITY RELOCATION PLAN</b> <b>I-10 MAINLINE</b> <b>STA 5235+00 TO 5249+00</b>
ROUTE	I-10	LOCATION	RUTHRAUFF ROAD TI	
TRACS NO. H 8480 OIC		010-D(213)S		DWG NO. U-1.08 OF

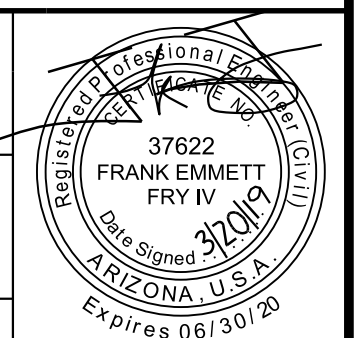

SURVEY NO. FINISHED PLANS DATE LOCATION REVISIONS FINISHED PLANS DATE SURVEY NO. FINISHED PLANS DATE LOCATION REVISIONS FINISHED PLANS DATE SURVEY NO.


F.H.W.A. REGION	STATE	PROJECT NO.	SHEET NO.	TOTAL SHEETS	RECORD DRAWING
9	ARIZ.	010-D(213)S	810	849	

010 PM 252

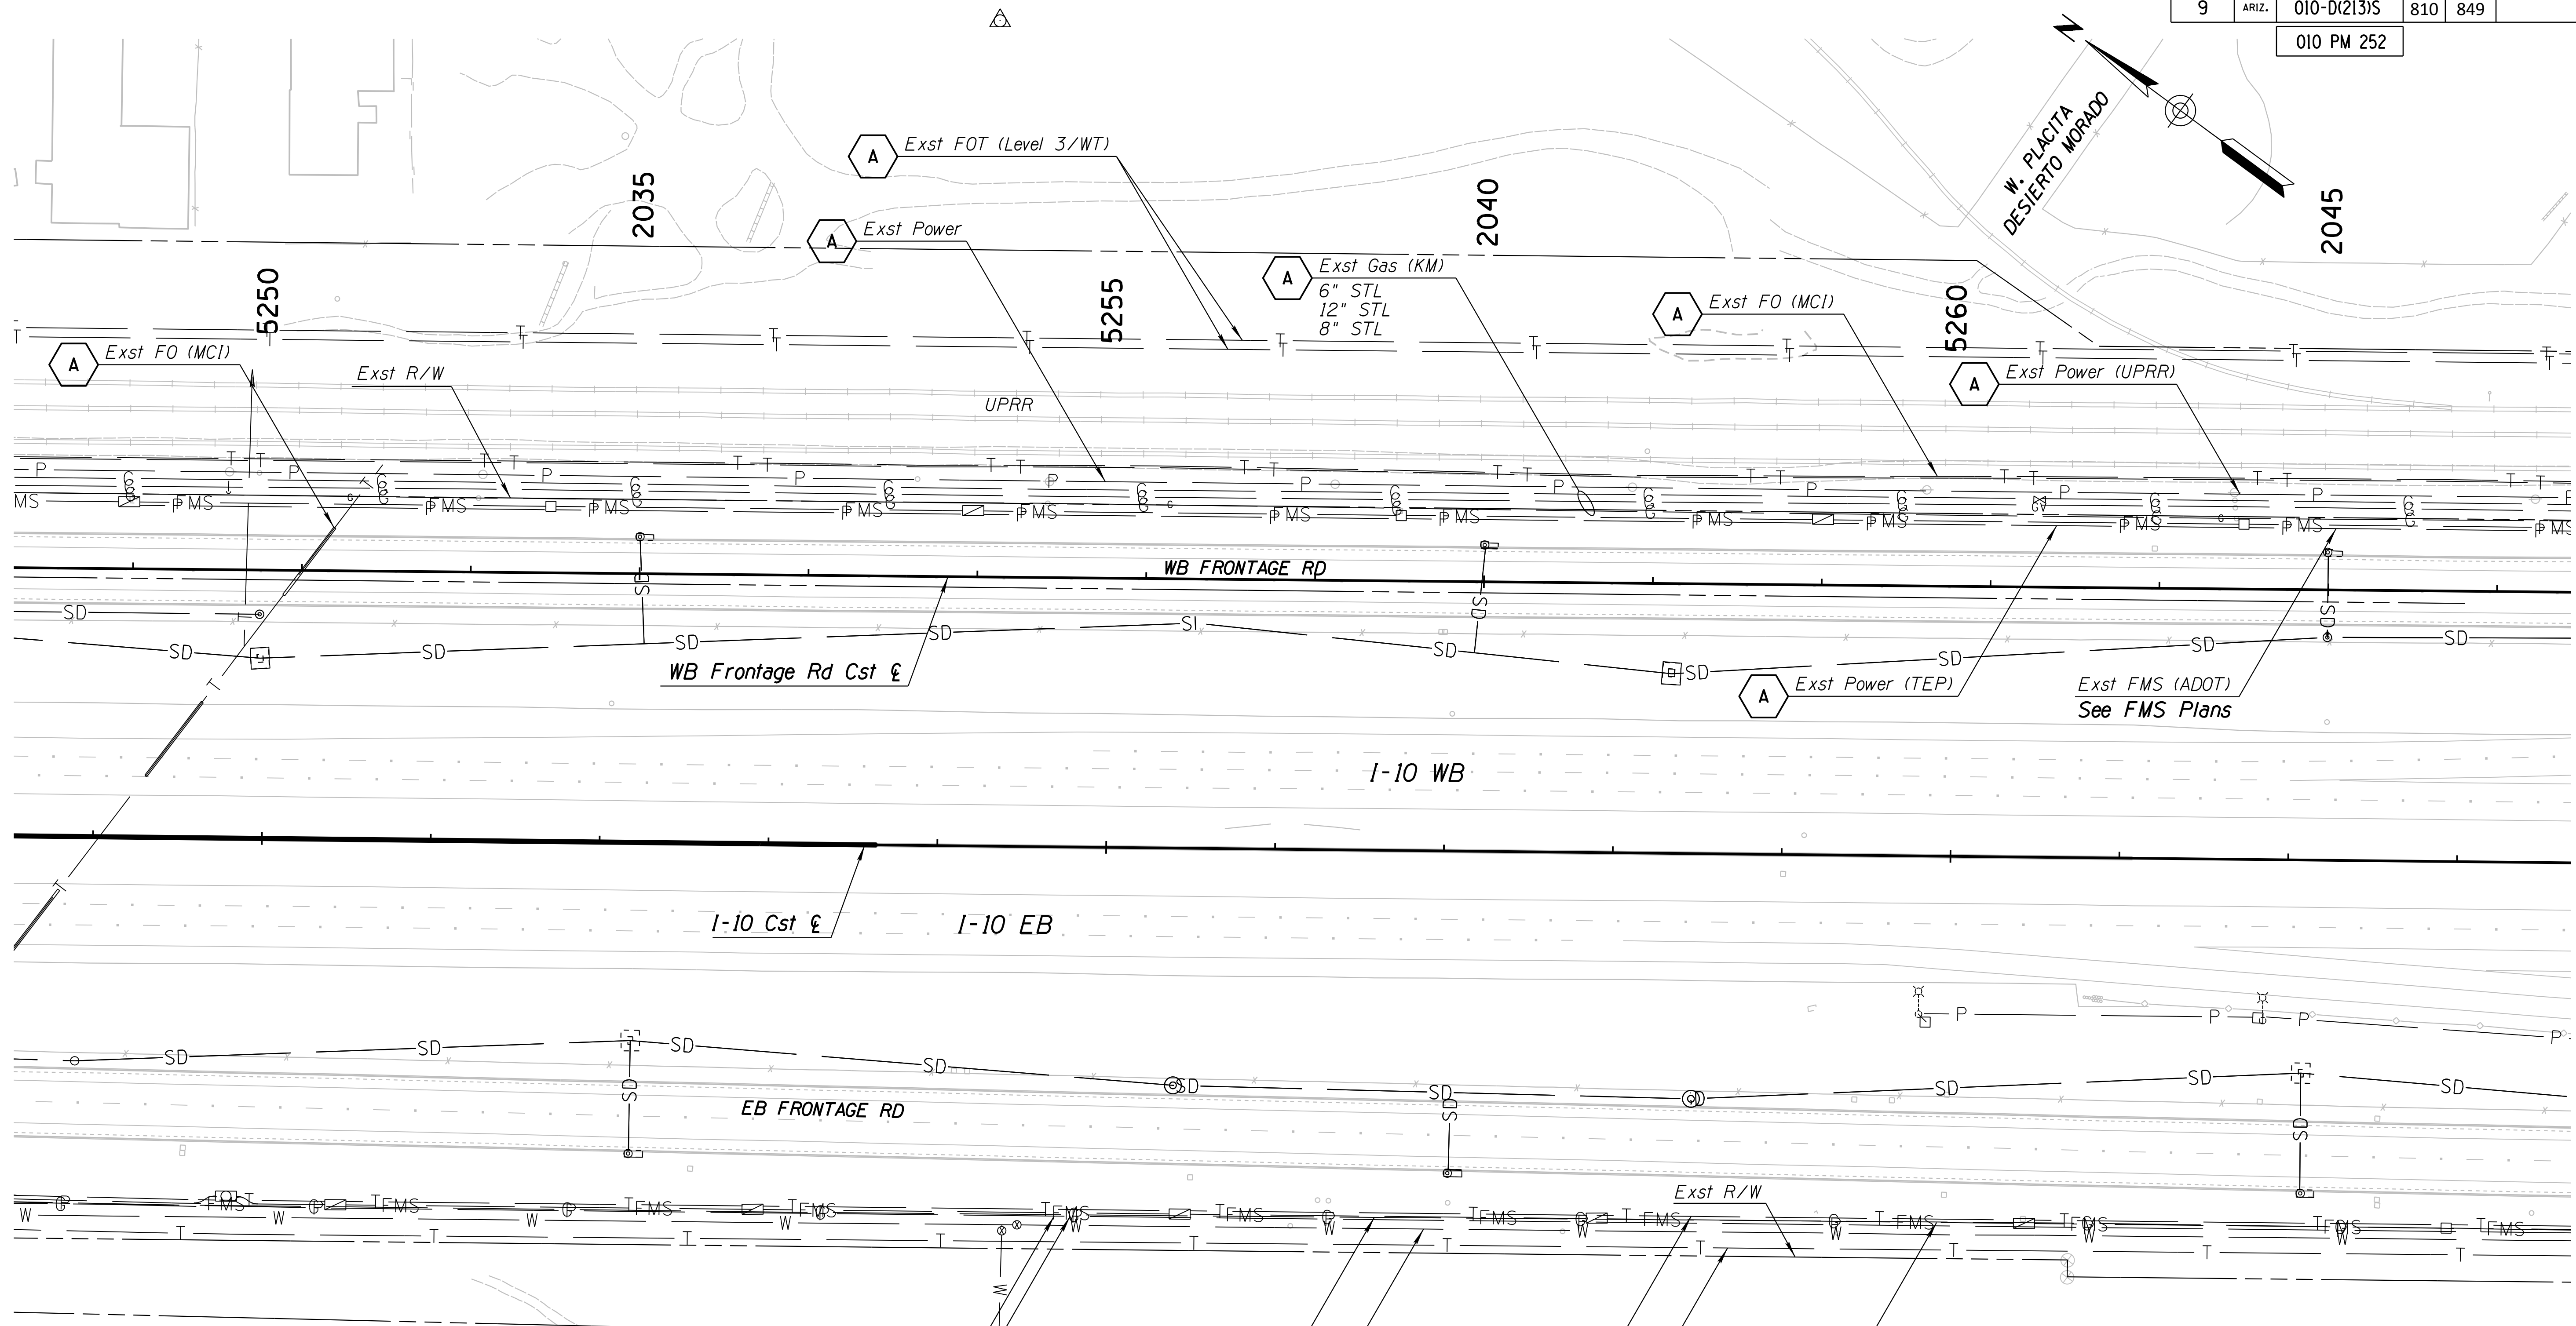

**UTILITY DISPOSITION LEGEND**

- A** To Remain in Service
- B** Remove
- C** Adjust to Grade
- D** Remove by Others
- E** Relocate by Others
- F** Abandon in Place

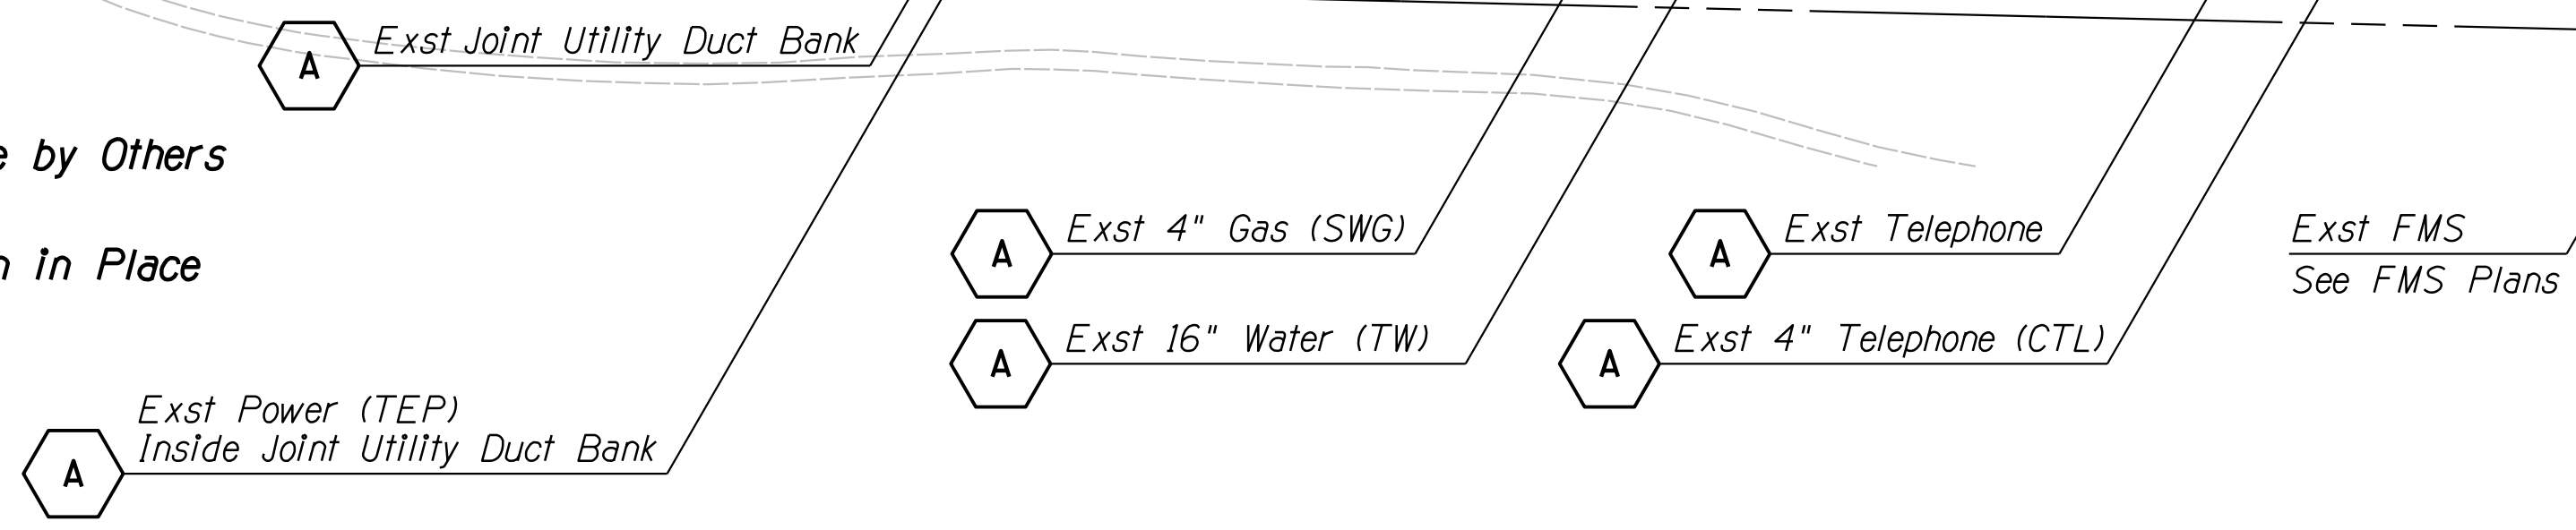

DESIGN	DL	DATE	3-19	<b>ARIZONA DEPARTMENT OF TRANSPORTATION</b> <b>INFRASTRUCTURE DELIVERY AND OPERATIONS DIVISION</b> <b>ROADWAY DESIGN SERVICES</b>  <b>UTILITY RELOCATION PLAN</b> <b>I-10 MAINLINE</b> <b>STA 5249+00 TO 5263+00</b>	
DRAWN	CPG	DATE	3-19		
CHECKED	FF	DATE	3-19		
		<small>WSP USA Inc. 177 N. Church Ave. Suite 1105 Tucson, AZ 85701</small>		<b>ROUTE</b> I-10 <b>LOCATION</b> RUTHRAUFF ROAD TI  <b>TRACS NO.</b> H 8480 OIC <b>010-D(213)S</b> <b>DWG NO.</b> U-1.09 <b>OF</b>	


SURVEY NO.    FINISHED PLANS    REVISIONS    LOCATION    DATE    FINISHED PLANS    SURVEY NO.    DATE    LOCATION    REVISIONS    DATE

UTILITY DISPOSITION LEGEND

- A To Remain in Service
- B Remove
- C Adjust to Grade
- D Remove by Others
- E Relocate by Others
- F Abandon in Place
- See Sewer Plans
- See Water Plans
- HOBAS Pipe Protection Area

F.H.W.A. REGION	STATE	PROJECT NO.	SHEET NO.	TOTAL SHEETS	RECORD DRAWING
9	ARIZ.	010-D(213)S	811	849	

010 PM 252

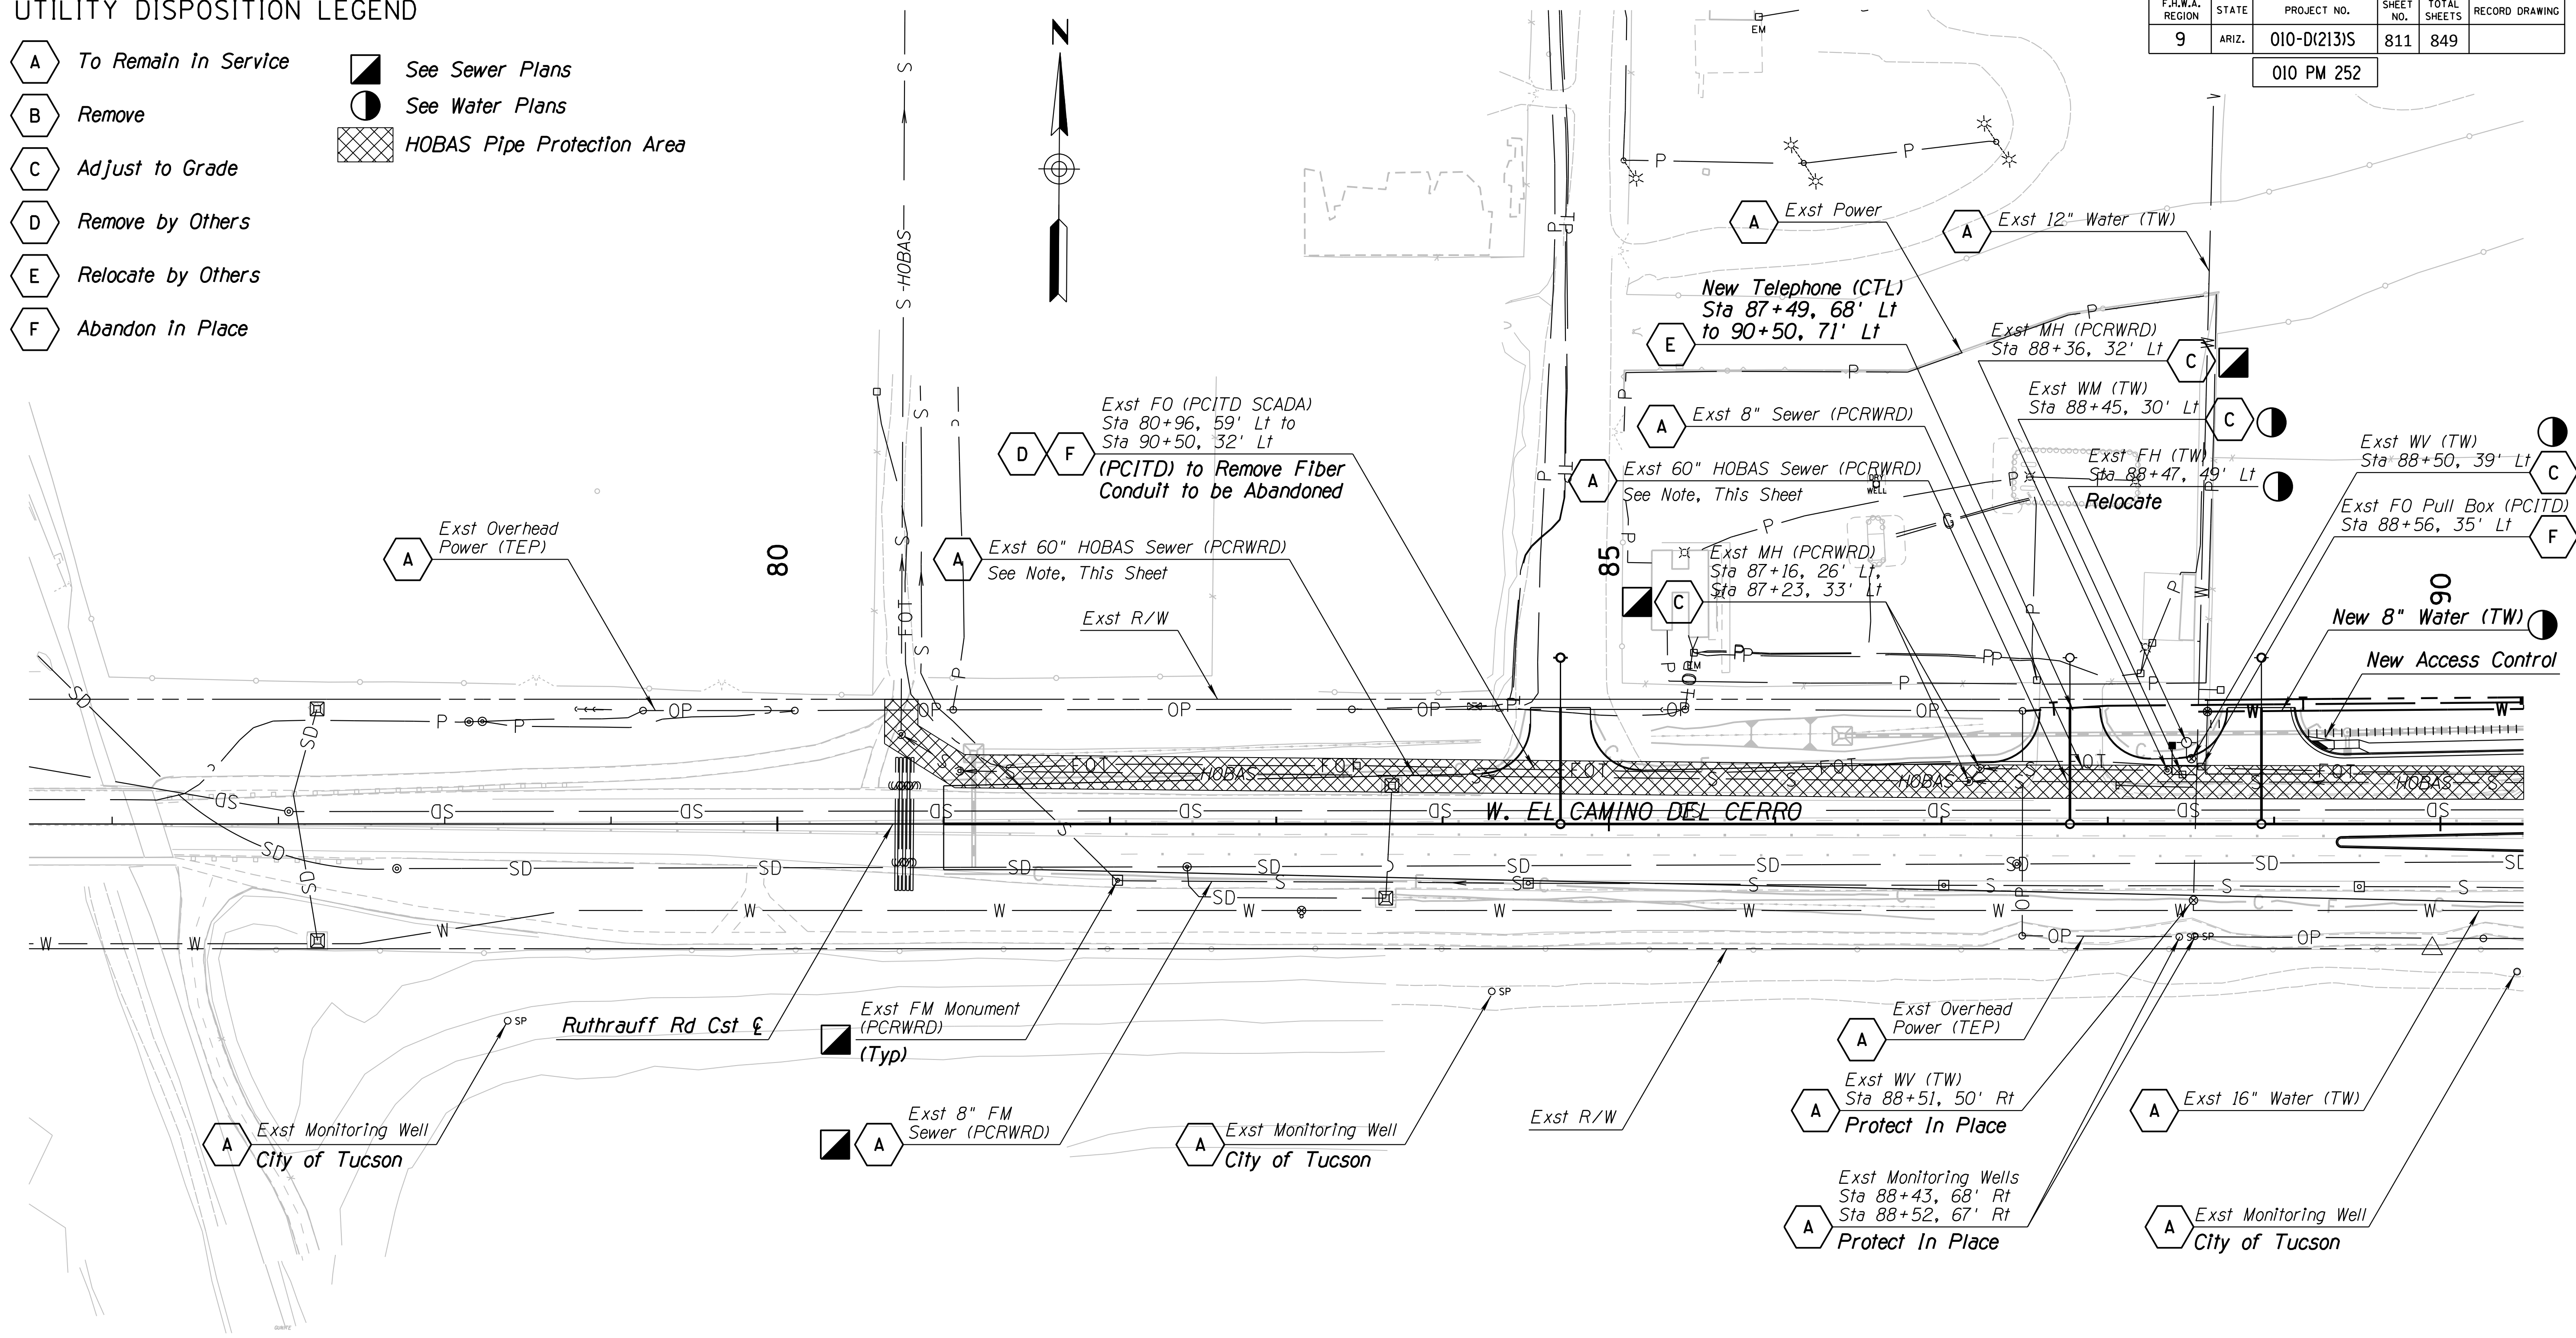


**NOTE:**  
 1. Contractor shall protect the existing HOBAS pipe in place. Live Loads exceeding HL-93 loading, including heavy hauls, crane pad placement, etc., are not acceptable within 10 feet either side of the existing HOBAS pipe (as measured from the pipe centerline). Only non-vibratory compaction methods shall be used within the HOBAS Pipe Protection Area. Excavation depths shall not exceed 2 feet within the Protection Area without approval by the Engineer. Roadway Overexcavation per Detail Q shall not be performed within the Protection Area. Stockpiling, placement of spoils and/or material is not acceptable within the Protection Area. See the General Requirements section of the Special Provisions for additional information.

DESIGN	DL	DATE	3-19	ARIZONA DEPARTMENT OF TRANSPORTATION INFRASTRUCTURE DELIVERY AND OPERATIONS DIVISION ROADWAY DESIGN SERVICES
DRAWN	CPG	DATE	3-19	
CHECKED	FF	DATE	3-19	
		WSP USA Inc. 177 N. Church Ave. Suite 1105 Tucson, AZ 85701		UTILITY RELOCATION PLAN EL CAMINO DEL CERRO STA 80+00 TO 90+50
ROUTE	LOCATION	RUTHRAUFF ROAD TI		DWG NO. U-1.10 OF
TRACS NO.	H 8480 OIC	010-D(213)S		







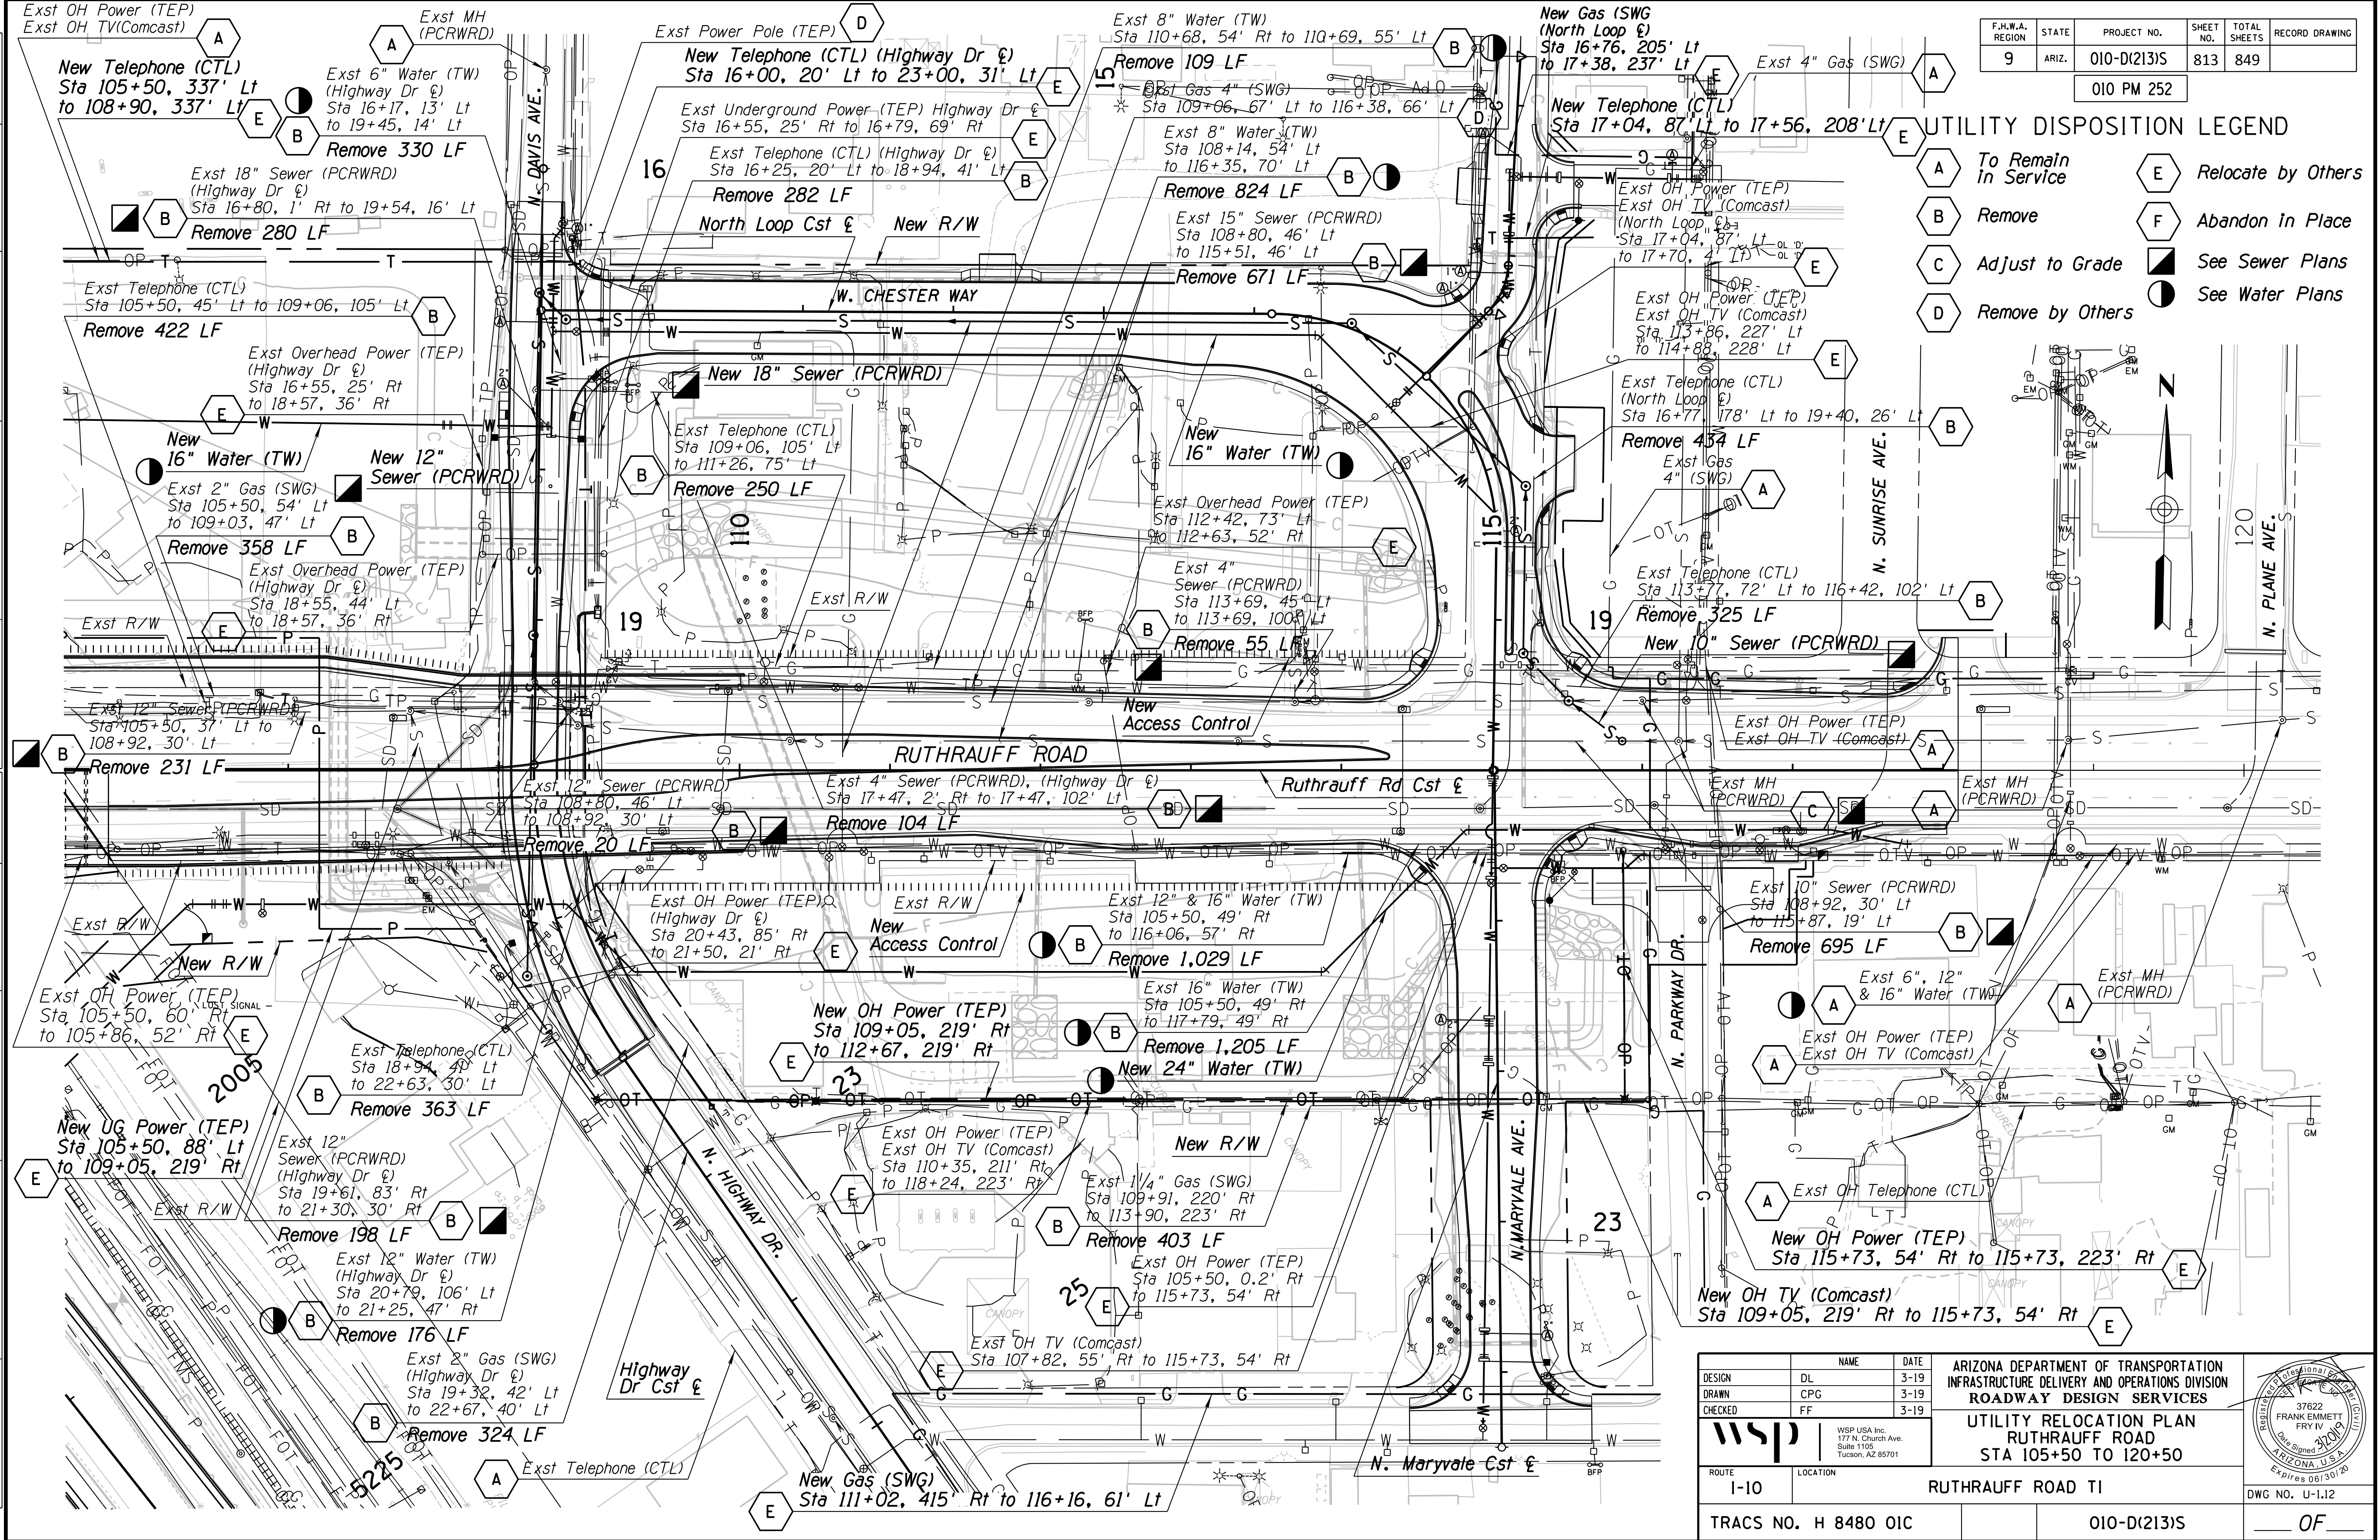

DATE: \_\_\_\_\_ LOCATION: \_\_\_\_\_ REVISIONS: \_\_\_\_\_ FINISHED PLANS: \_\_\_\_\_ SURVEY NO.: \_\_\_\_\_ DATE: \_\_\_\_\_ LOCATION: \_\_\_\_\_ REVISIONS: \_\_\_\_\_ FINISHED PLANS: \_\_\_\_\_ SURVEY NO.: \_\_\_\_\_

DESIGN	DL	DATE	3-19
DRAWN	CPG	DATE	3-19
CHECKED	FF	DATE	3-19

**WSP** WSP USA Inc.  
177 N. Church Ave.  
Suite 1105  
Tucson, AZ 85701

**ARIZONA DEPARTMENT OF TRANSPORTATION**  
INFRASTRUCTURE DELIVERY AND OPERATIONS DIVISION  
**ROADWAY DESIGN SERVICES**

**UTILITY RELOCATION PLAN**  
RUTHRAUFF ROAD  
STA 105+50 TO 120+50


ROUTE: I-10 LOCATION: RUTHRAUFF ROAD TI

TRACS NO. H 8480 OIC

010-D(213)S

DWG NO. U-1.12

OF

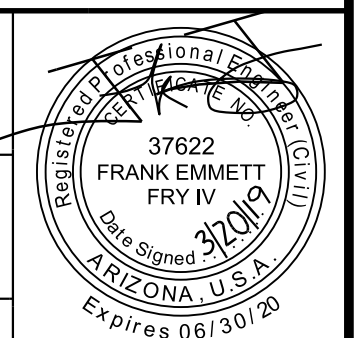








F.H.W.A. REGION	STATE	PROJECT NO.	SHEET NO.	TOTAL SHEETS	RECORD DRAWING
9	ARIZ.	010-D(213)S	815	849	
010 PM 252					


# INTERSTATE 10 - RUTHRAUFF ROAD T.I. PROJECT NO. 010 PM 252 H8480 01C

## WATER SYSTEM MODIFICATIONS PN 5-176-2018

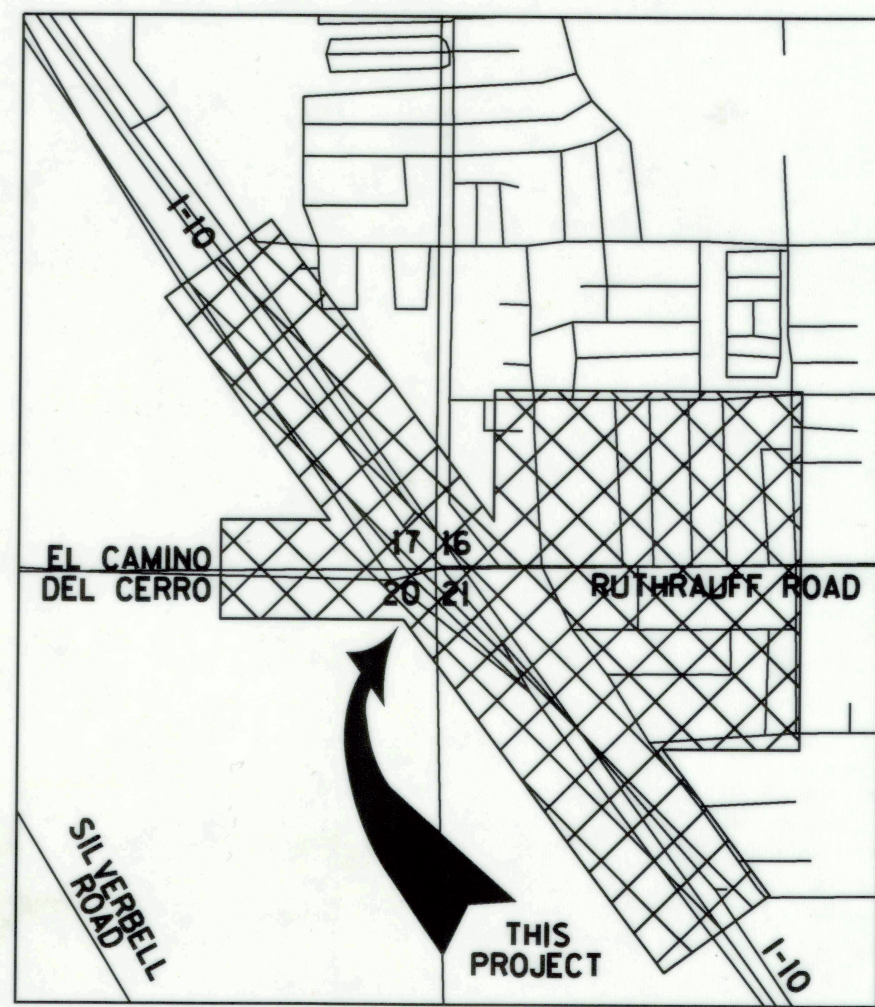

LOCATION MAP  
3" = 1 MILE

SEC. 16, 17, 20 & 21, T13S, R13E  
G & S R M, PIMA COUNTY, ARIZONA  
LATITUDE 32°17'39" N  
LONGITUDE 111°01'48" W  
CITY OF TUCSON

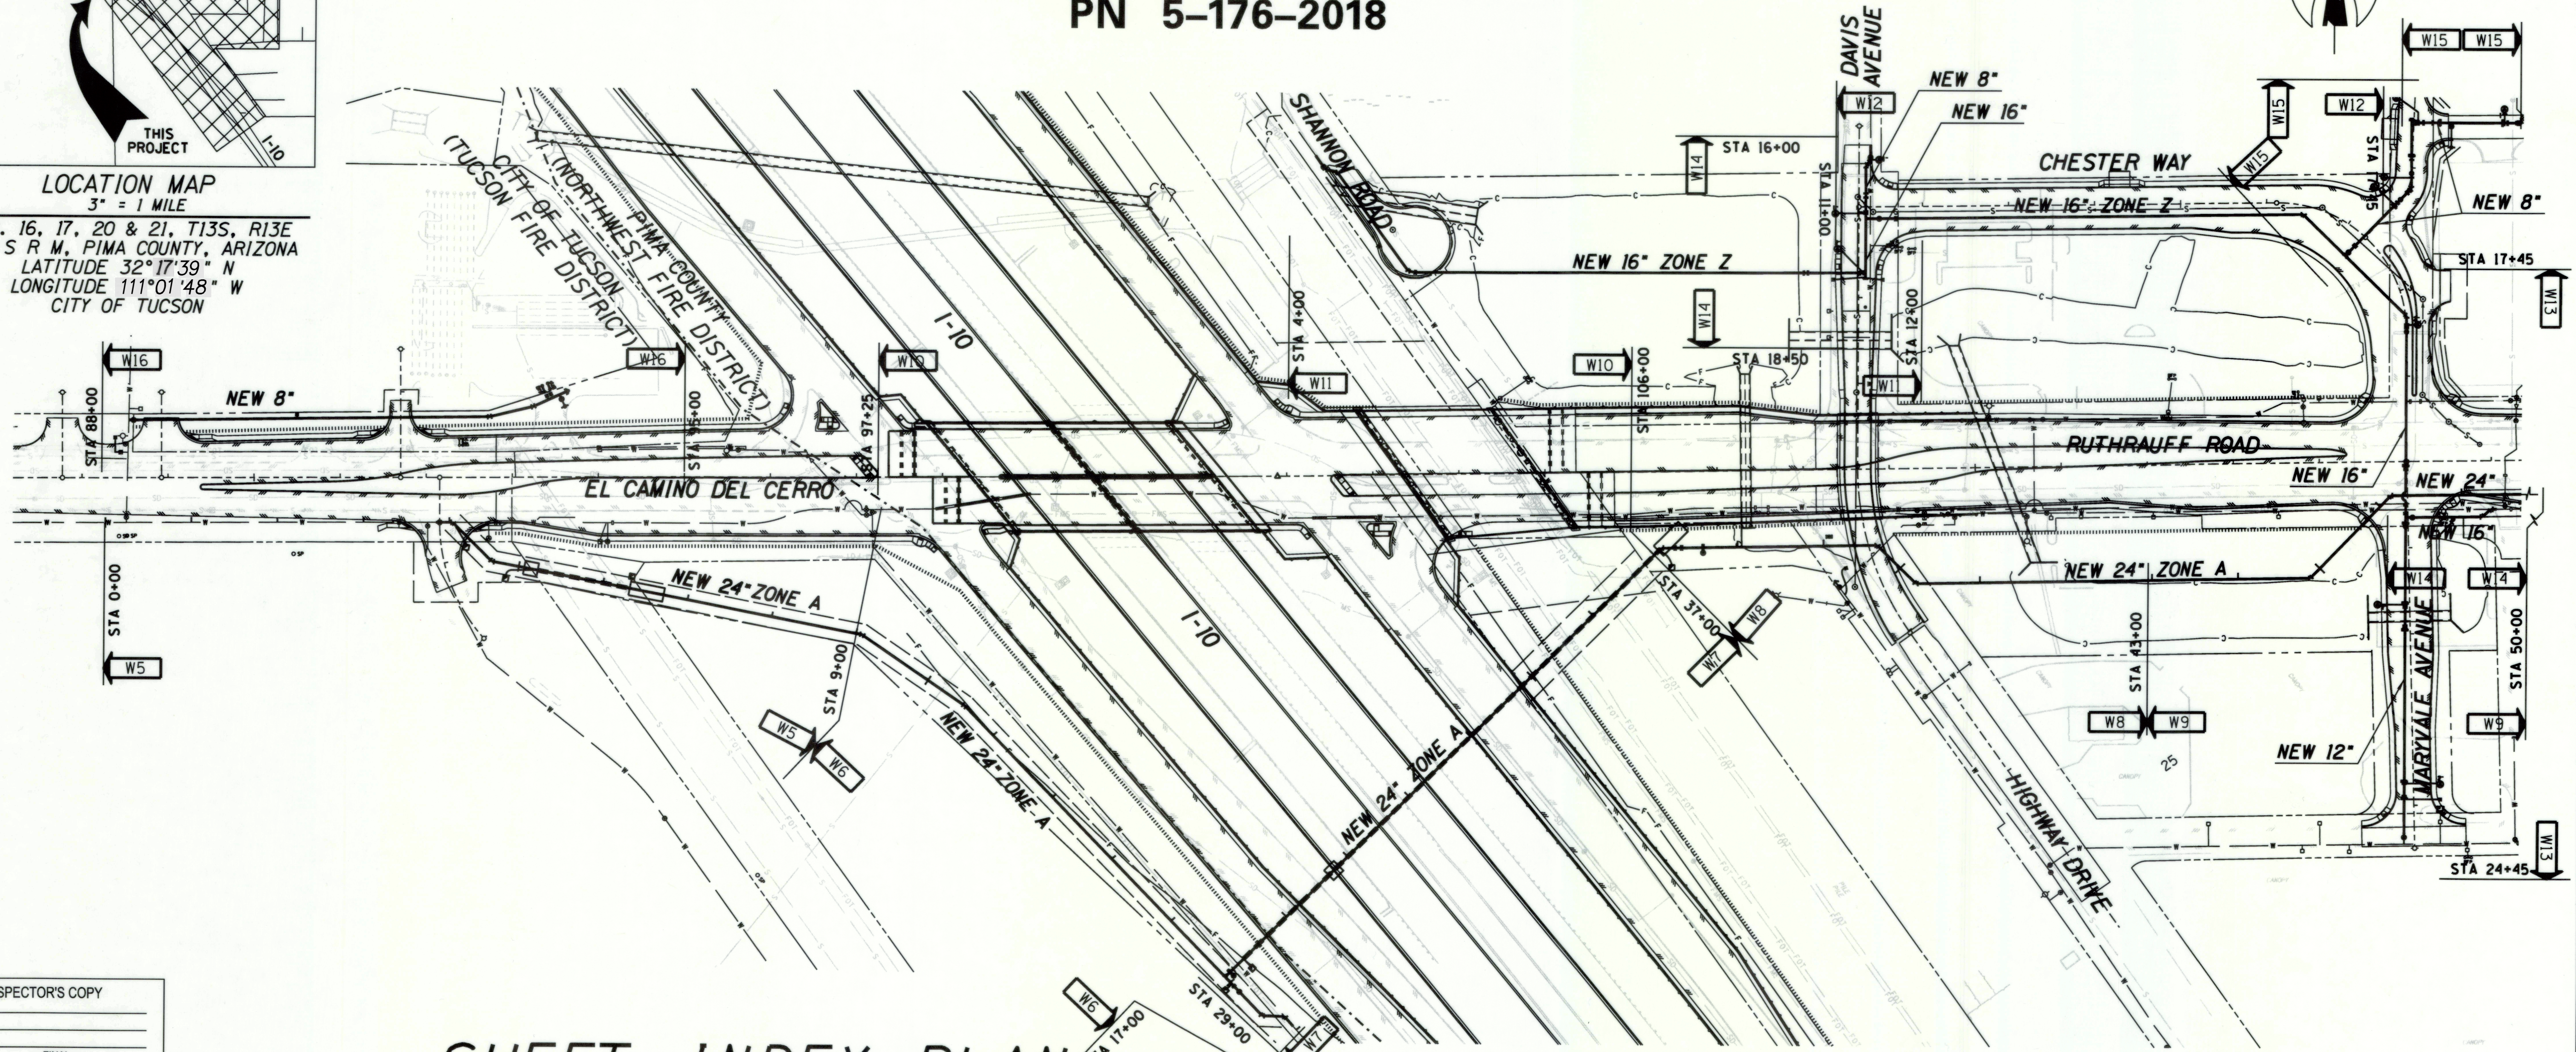

### SHEET INDEX PLAN

1"=100'

PAGE NO.	SHEET NO.	DESCRIPTION
815	W1	COVER SHEET
816	W2	NOTES
817	W3	GEOMETRY CONTROL SHEET
818	W4	MATERIAL QUANTITIES SUMMARY
819-823	W5-W9	TRANSMISSION PLAN & PROFILE
824	W10	TRANSMISSION REMOVALS
825-828	W11-W13	TRANSMISSION PLAN & PROFILE
829-830	W14-W16	DISTRIBUTION PLAN & PROFILE

FOR ACCEPTANCE CONDITIONS, SEE WATER SYSTEM MODIFICATION NOTES, NOTE 1, SHEET W2 OF W16.

INSPECTOR'S COPY

INSPCT. \_\_\_\_\_  
CONTR. \_\_\_\_\_

START \_\_\_\_\_ FINAL \_\_\_\_\_  
PIPE \_\_\_\_\_ DI \_\_\_\_\_ HDPE \_\_\_\_\_ PVC \_\_\_\_\_  
SVC LINE MAT \_\_\_\_\_  
B.F.'S \_\_\_\_\_  
GATES \_\_\_\_\_  
F.H.S. \_\_\_\_\_ MAT \_\_\_\_\_

MAGNETIC TAPE INST. YES  NO   
REBAR RINGS INST. YES  NO

ZONE \_\_\_\_\_ PSI \_\_\_\_\_

MAPPING INFO  
PLOTTED \_\_\_\_\_ ON VM \_\_\_\_\_  
checked \_\_\_\_\_ date \_\_\_\_\_

ALL VALVES WERE INSTALLED PER PLAN.

Signature \_\_\_\_\_  
Date \_\_\_\_\_

RESERVED FOR ENGINEERING  
AS-BUILT STAMP

*WSP* 3-20-19  
TUCSON FIRE DISTRICT DATE  
*FR* 5-20-2019  
NORTHWEST FIRE DISTRICT DATE

*Jignesh Patel* 3/21/2019  
CITY OF TUCSON WATER DEPARTMENT DATE

DESIGN	DL	DATE	3-19
DRAWN	CPG	DATE	3-19
CHECKED	FF	DATE	3-19

WATER SHEET W1 OF W16

ARIZONA DEPARTMENT OF TRANSPORTATION  
INFRASTRUCTURE DELIVERY AND OPERATIONS DIVISION  
ROADWAY DESIGN SERVICES

RUTHRAUFF ROAD  
WATER MODIFICATION PLANS  
COVER SHEET

37622  
FRANK EMMETT  
FRY IV  
DATE SIGNED 3/19/19  
ARIZONA, U.S.A.  
Expires 06/30/20

ROUTE	LOCATION	TRACS NO.	PROJECT NO.	DWG NO.
I-10	RUTHRAUFF ROAD TI	H 8480 OIC	010-D(213)S	U-2.01

NO.	DATE	REVISION	BY	CHKD.	APPR.

DATE- LOCATION- REVISIONS- FINISHED PLANS- SURVEY NO. DATE- LOCATION- REVISIONS- FINISHED PLANS- SURVEY NO.



# WATER SYSTEM MODIFICATION NOTES

- ACCEPTANCE CONDITIONS:**
  - THIS PROJECT IS ACCEPTED BY THE CITY OF TUCSON WATER DEPARTMENT FOR SUBSTANTIAL CONCURRENCE WITH STANDARD SPECIFICATIONS AND DETAILS.
  - ACCEPTANCE OF THESE PLANS IS VALID FOR 2 YEARS AFTER THE DATE OF THE SIGNATURE.
  - THE WARRANTY AND GUARANTEE DURATION FOR ALL WATER WORK ON THIS PROJECT SHALL BE TWO (2) YEARS COMMENCING ON THE DATE OF FINAL ACCEPTANCE OF THE I-10 AND RUTHRAUFF ROAD IMPROVEMENT PROJECT.
- CURRENT STANDARDS:**
  - ALL WATER SYSTEM MODIFICATION CONSTRUCTION WORK SHALL CONFORM TO THE FOLLOWING STANDARDS AND SPECIAL PROVISIONS:
  - THE CITY OF TUCSON STANDARD SPECIFICATIONS AND DETAILS FOR PUBLIC IMPROVEMENTS, 2017 EDITION.
  - THE WATER SYSTEMS MODIFICATIONS SPECIAL PROVISIONS FOR THIS PROJECT.
- WATER SYSTEM MODIFICATION PRE-CONSTRUCTION PROCEDURE:**
  - THE CONTRACTOR SHALL CONTACT THE CITY OF TUCSON WATER DEPARTMENT CONSTRUCTION SECTION (791-2665) A MINIMUM OF FIVE (5) DAYS PRIOR TO ANY WATER WORK. THE CONTRACTOR SHALL REFER TO THE CITY OF TUCSON WATER DEPARTMENT PLAN NO. 5-176-2018.
  - THE CITY OF TUCSON WATER DEPARTMENT CONSTRUCTION SECTION WILL SCHEDULE THE TIME AND PLACE FOR THE MEETING.
  - NO WATER SYSTEM CONSTRUCTION SHALL BEGIN UNTIL A "NOTICE TO PROCEED" HAS BEEN ISSUED BY THE CITY OF TUCSON WATER DEPARTMENT.
  - ANY WATER WORK INSTALLED PRIOR TO THE NOTICE TO PROCEED DATE SHALL BE REMOVED BY THE CONTRACTOR AT THE CONTRACTOR'S EXPENSE.
- DIMENSIONS SLOPES AND GRADES:**
  - ALL DIMENSIONS, SLOPES, AND GRADES OF EXISTING WATER LINES ARE TAKEN FROM "AS BUILT" DRAWINGS, VALVE NUT, SURVEY DATA OR POT HOLE DATA. IT SHALL BE THE CONTRACTOR'S RESPONSIBILITY TO DETERMINE EXACT INFORMATION BEFORE ORDERING ANY SPECIAL FITTINGS OR EQUIPMENT.
- SHUT DOWN OF TRANSMISSION MAINS (16" AND LARGER):**
  - CONSTRUCTION ON ZONE 2 TRANSMISSION MAIN SHALL TAKE PLACE ONLY IN THE OFF PEAK SEASON BETWEEN OCTOBER 1 AND MARCH 30. THE ZONE 2 TRANSMISSION MAIN THAT RUNS EAST-WEST SHALL NOT BE INTERRUPTED EXCEPT FOR CONNECTION PURPOSES ONLY. WHILE CONNECTING THE ZONE 2 TRANSMISSION MAIN TO EXISTING, THE SHUT DOWN PERIOD SHALL NOT EXCEED 12 HOURS, OR AS APPROVED BY THE ENGINEER. BYPASS PIPING, 10" OR LARGER, MEETING THE APPROVAL OF TUCSON WATER, MAY BE USED BUT WILL BE CONSIDERED TO THE BENEFIT OF THE CONTRACTOR AND SHALL BE INCIDENTAL. NO ADDITIONAL PAYMENT WILL BE MADE.
  - THE CONTRACTOR SHALL BE ALLOWED A MAXIMUM OF FIVE (5) CALENDAR DAYS DOWN TIME FOR ANY ONE SHUT-DOWN.
  - MULTIPLE SHUT-DOWNS WILL BE ALLOWED WITH A MINIMUM OF FIVE (5) CALENDAR DAYS BETWEEN SHUT-DOWNS.
- DEPTH OF NEW WATER MAINS:**
  - NEW WATER MAINS SHALL BE INSTALLED AT A MINIMUM DEPTH OF THREE FEET (3.0') FROM THE BOTTOM OF ANY EXCAVATION OR SCARIFICATION TO THE TOP OF THE NEW PIPE. THIS DEPTH SHALL BE MAINTAINED FOR FIVE FEET (5.0') BEYOND ANY EXCAVATION, MEASURED PERPENDICULAR TO THE PROPOSED STRUCTURE OR EDGE OF THE PROPOSED ROADWAY.
  - IN NO CASE SHALL NEW WATER MAINS BE INSTALLED LESS THAN THREE AND SIXTY SEVEN HUNDREDTHS OF A FOOT (3.67') DEEP FROM THE FINISHED GRADE TO THE TOP OF THE NEW PIPE.
  - THESE MINIMUMS SHALL APPLY TO ALL WATER MAINS UNLESS OTHERWISE NOTED ON THE PLANS.
- DEPTH OF NEW SERVICE LINES:**
  - NEW SERVICE LINES, TWO INCH (2") AND SMALLER, SHALL BE INSTALLED AT A MINIMUM DEPTH OF TWO FEET (2.0') FROM THE BOTTOM OF ANY EXCAVATION OR SCARIFICATION TO THE TOP OF THE NEW SERVICE LINE. THIS DEPTH SHALL BE MAINTAINED FOR FIVE FEET (5') BEYOND ANY EXCAVATION, MEASURED PERPENDICULAR TO THE PROPOSED STRUCTURE OR EDGE OF THE PROPOSED ROADWAY.
  - IN NO CASE SHALL NEW SERVICE LINES BE INSTALLED LESS THAN THREE FEET (3.0') DEEP FROM THE FINISHED GRADE TO THE TOP OF THE NEW SERVICE LINE.
  - THESE MINIMUMS SHALL APPLY TO ALL SERVICE LINES UNLESS OTHERWISE NOTED ON THE PLANS.
- WATER METERS AND METER BOXES:**
  - THE CONTRACTOR SHALL BE RESPONSIBLE FOR ALL WATER METERS AND METER BOXES IN THE CONSTRUCTION AREA. THIS WILL INCLUDE BUT NOT BE LIMITED TO:
  - REMOVAL OF EXISTING METERS, REPLACEMENT COORDINATION AND INSTALLATION OF THE NEW AUTOMATIC METER READING (AMR) WATER METERS.
  - DURING THIS OPERATION, EXISTING METERS SHALL BE TAGGED WITH THE CORRECT ADDRESS AND RETURNED TO TUCSON WATER. ALL EXISTING WATER METERS THAT ARE TO BE LOCATED AS PART OF THIS PROJECT THAT ARE NOT ALREADY AUTOMATED, ARE TO BE REPLACED WITH AMR TYPE METERS AT LOCATIONS/ADDRESSES SPECIFIED ON THE PLANS.
  - PROTECTION OF METERS. AT ALL TIMES THE CONTRACTOR SHALL TAKE PRECAUTIONS TO AVOID ANY DAMAGE TO METERS. THE CONTRACTOR SHALL PROVIDE FOR THEIR SAFE STORAGE AND THE PROPER EQUIPMENT FOR THEIR HANDLING.
  - ACCESS TO METERS. THE CONTRACTOR SHALL MAINTAIN ACCESS TO ALL IN-SERVICE METERS DURING CONSTRUCTION. AT THE CLOSE OF THE PROJECT THE CONTRACTOR SHALL ENSURE THAT ALL METERS ARE LEFT ACCESSIBLE AND THAT ALL METER BOXES ARE ADJUSTED TO FINAL GRADE.
  - TUCSON WATER SHALL SUPPLY ALL NEW AMR WATER METERS TO BE INSTALLED AS PART OF THIS PROJECT.
- FIRE PROTECTION SHUT DOWN:**
  - FORTY-EIGHT (48) HOURS PRIOR TO SHUT-DOWN OF ANY FIRE HYDRANTS OR FIRE PROTECTION SERVICE LINES THE CONTRACTOR SHALL PROVIDE THE CITY OF TUCSON WATER DEPARTMENT CONSTRUCTION INSPECTOR WITH A WRITTEN REPORT INDICATING THE LOCATION AND DURATION OF ANY FIRE HYDRANT OR FIRE PROTECTION SERVICE SHUT-DOWNS.

THE CONTRACTOR SHALL NOTIFY THE CITY OF TUCSON WATER DEPARTMENT CONSTRUCTION INSPECTOR WHEN FIRE HYDRANTS OR FIRE PROTECTION SERVICES ARE BACK IN SERVICE.

- MAINTAIN SERVICE TO CUSTOMERS:**

THE CONTRACTOR SHALL BE RESPONSIBLE FOR MAINTAINING SERVICE TO ALL WATER CUSTOMERS DURING CONSTRUCTION.

IT SHALL BE THE CONTRACTOR'S RESPONSIBILITY TO DETERMINE WHICH SERVICES WILL BE AFFECTED BY THIS PROJECT.

IT MAY BE NECESSARY TO ACCOMPLISH TIE-OVERS, RE-CONNECTIONS, ETC., WHILE BUSINESS CUSTOMERS ARE CLOSED.

IF INTERRUPTION OF SERVICE IS UNAVOIDABLE THE CONTRACTOR SHALL NOTIFY THE WATER INSPECTOR A MINIMUM OF A 48 HOURS IN ADVANCE TO COORDINATE SHUT-DOWNS. EVERY EFFORT SHALL BE MADE TO MINIMIZE DISRUPTION TO THE CUSTOMER.

IF THE CONTRACTOR CHOOSES TO ABANDON ANY PORTION OF THE EXISTING WATER SUPPLY SYSTEM WITHOUT CONCURRENT NEW CONSTRUCTION AS CALLED FOR ON THE PLANS THE CONTRACTOR SHALL PROVIDE ANY AND ALL MATERIALS AND CONSTRUCTION OF A TEMPORARY OR PERMANENT WATER SYSTEM TO MAINTAIN CONTINUED WATER SERVICE TO CUSTOMERS AT NO ADDITIONAL COST.
- SPECIAL USE WATER PERMITS:**

PRIOR TO COMMENCING WORK, THE CONTRACTOR SHALL APPLY FOR TWO (2) SPECIAL WATER USE PERMITS FROM THE CITY OF TUCSON DEPARTMENT COMMERCIAL SECTION

  - CONSTRUCTION WATER SPECIAL PERMIT:**

THERE WILL BE NO CHARGE FOR THIS PERMIT, BUT THE CONTRACTOR MUST PAY THE SUM OF (\$821.38) PLUS TAX AS THE ESTIMATED COST OF THE WATER TO BE USED. THIS WATER IS TO BE USED FOR TRENCH SETTLING, DISINFECTION AND TESTING.
  - METERED FIRE HYDRANT ONLY PERMIT:**

THIS NON-TRANSFERABLE PERMIT WILL ENTITLE THE CONTRACTOR TO USE WATER THROUGH A METER FROM EXISTING FIRE HYDRANTS AT APPROVED LOCATIONS. WATER USED UNDER THIS PERMIT IS FOR GENERAL CONSTRUCTION PURPOSES SUCH AS DUST CONTROL, SITE PREPARATION, ETC.
- NEW MATERIAL:**

ALL MATERIALS, FITTINGS, AND APPURTENANCES CALLED FOR ON THE PLANS, OR REQUIRED FOR A COMPLETE INSTALLATION, SHALL BE NEW. NO REFURBISHED ITEMS OR MATERIALS WILL BE ALLOWED.
- VALVE BOXES:**

THE CONTRACTOR SHALL BE RESPONSIBLE FOR ADJUSTING ALL NEW AND EXISTING WATER VALVE BOXES TO THE FINISHED GRADE PER SD-300.
- JOINT RESTRAINT:**

THE CONTRACTOR SHALL USE MECHANICALLY RESTRAINED JOINTS AT ALL CHANGES OF DIRECTION IN THE WATER MAINS. THE LENGTHS OF RESTRAINED PIPE ON BOTH SIDES OF THE RESTRAINED JOINT SHALL BE AS CALLED FOR ON THE PLANS OR AS PER STANDARD DETAIL W-600. WITH THE APPROVAL OF THE ENGINEER AND THE CITY OF TUCSON WATER DEPARTMENT, THE CONTRACTOR MAY USE CONCRETE THRUST BLOCKING IN LIEU OF MECHANICALLY RESTRAINED JOINTS. CONCRETE THRUST BLOCKING SHALL COMPLY WITH STANDARD DETAIL SD-610.
- MARKING TAPE:**

IF ANY EXISTING DETECTABLE MARKING TAPE IS DISTURBED OR DESTROYED DURING CONSTRUCTION, THE CONTRACTOR SHALL FURNISH AND INSTALL APPROVED NEW TAPE. NEW MARKING TAPE SHALL BE INCIDENTAL TO CONSTRUCTION AND THERE SHALL BE NO ADDITIONAL CHARGE FOR REINSTALLATION.
- TRACER WIRE:**

THIS PROJECT WILL HAVE TRACER WIRE INSTALLED. IF ANY EXISTING TRACER WIRE IS DISTURBED OR DESTROYED DURING CONSTRUCTION, THE CONTRACTOR SHALL FURNISH AND INSTALL NEW TRACER WIRE TO REPLACE THE EXISTING. THERE SHALL BE NO ADDITIONAL CHARGE FOR THIS REINSTALLATION. THE TRACER WIRE SHALL BE CERTIFIED BY A LICENSED ELECTRICAL CONTRACTOR FOR CONTINUITY PRIOR TO FINAL ROADWAY PAVEMENT. FINAL ACCEPTANCE WILL NOT BE GRANTED UNTIL CERTIFICATION IS RECEIVED BY TUCSON WATER.
- WATERLINE CONNECTION:**

THE CONTRACTOR SHALL FIELD VERIFY THE HORIZONTAL AND VERTICAL LOCATION AND DEPTH OF EACH WATER MAIN TIE-IN LOCATION AND CONNECTION. ASSOCIATED COSTS ARE TO BE INCIDENTAL TO WATER LINE WORK.
- EASEMENTS:**

EASEMENTS AND THEIR LOCATIONS ARE PRESENTED BASED ON LIMITED RECORD DOCUMENTS. CONTRACTOR SHALL COORDINATE WITH UTILITIES REGARDING WORK IN THE VICINITY OF THEIR LINES.
- CLEARANCES:**

THE MINIMUM HORIZONTAL SEPARATION IS FIVE (5) FEET (FROM OUTSIDE WATER LINE TO OUTSIDE ELECTRICAL POLE/CONDUIT). MINIMUM VERTICAL SEPARATION IS ONE (1) FOOT (FROM OUTSIDE WATER LINE TO OUTSIDE ELECTRICAL CONDUIT) OR ANY OTHER FEATURE.
- VERTICAL DATUM:**

ELEVATION BASED UPON NAVD 88.

MAP COORDINATES ARE NAD 83/92 MODIFIED CENTRAL ZONE STATE PLANE COORDINATES USING G.A.F. = 1,00016
- BASIS OF BEARING:**

BASIS OF BEARING: DESIGN INFORMATION BASED UPON AERIAL PHOTOGRAMMETRIC MAPPING SUPPLIED BY ADOT. PHOTOGRAMMETRY JOB NO. 3803 - AERIAL PHOTOGRAPHY DATED OCTOBER 29, 2008.
- EXISTING UTILITIES:**

EXISTING UTILITIES, AS DEPICTED ON THE PROJECT PLANS, ARE BASED ON LEVEL "D", "C", "B" & "A" SUE AND/OR AS-BUILT PLANS. EXISTING UTILITY ELEVATION DATA, AS DEPICTED IN PROFILE, IS BASED ON LEVEL "A" SUE (POT HOLE DATA), AS-BUILT PLANS AND/OR APPROXIMATE BURIAL DEPTH. CONTRACTOR SHALL FIELD VERIFY UTILITY CONFLICTS AND ADJUST WATER LINE INSTALLATION, AT THE DIRECTION OF THE ENGINEER.
- LEAD FREE:**

THE CONTRACTOR SHALL FURNISH AND INSTALL ALL PIPE, FITTINGS, APPURTENANCES OR ANY OTHER MATERIALS TO BE IN CONTACT WITH POTABLE WATER IN ACCORDANCE WITH THE LEAD-FREE REQUIREMENTS DEFINED BY THE "REDUCTION OF LEAD IN DRINKING WATER ACT OF 2011" AMENDING SECTION 1417 OF THE "SAFE DRINKING WATER ACT."
- PVC PIPE DEFLECTION:**
  - THE CONTRACTOR MAY NOT DEFLECT PVC PIPE AT BELL & SPIGOT GASKETED JOINTS OR AS LONGITUDINAL BENDING IN THE PIPE SEGMENT.
  - THE CONTRACTOR SHALL ONLY DEFLECT PVC PIPE AT DUCTILE IRON BENDS/FITTINGS PROVIDED THE DEFLECTION DOES NOT EXCEED MANUFACTURER'S ALLOWABLE DEFLECTION.

# ABBREVIATIONS

- |            |                         |
|------------|-------------------------|
| ARV        | AIR RELEASE VALVE       |
| AVE.       | AVENUE                  |
| BOT        | BOTTOM                  |
| B & C      | BOX AND COVER           |
| CA         | CEMENT ASBESTOS         |
| CL         | CENTERLINE              |
| CON        | CONNECTION              |
| CU         | COPPER                  |
| DIA.       | DIAMETER                |
| DR         | DIMENSION RATIO         |
| DRWY.      | DRIVEWAY                |
| DIP        | DUCTILE IRON PIPE       |
| EA         | EACH                    |
| EXIST.     | EXISTING                |
| FPS        | FIRE PROTECTION SERVICE |
| FL         | FLANGE                  |
| ELEV.      | ELEVATION               |
| G          | GAS                     |
| HZ/HORIZ.  | HORIZONTAL              |
| INV.       | INVERT                  |
| LT.        | LEFT                    |
| LF         | LINEAR FOOT             |
| MATL.      | MATERIAL                |
| MJ         | MECHANICAL JOINT        |
| MIN.       | MINIMUM                 |
| NPI        | NOW PAY ITEM            |
| N.         | NORTH                   |
| PVC        | POLYVINYL CHLORIDE      |
| R          | RIGHT                   |
| RT.        | RIGHT-OF-WAY            |
| R/W OR ROW | RIGHT-OF-WAY            |
| ST.        | STREET                  |
| STA.       | STATION                 |
| SD         | STORM DRAIN             |
| TH         | THICKNESS               |
| VT/VERT.   | VERTICAL                |

# SERVICE WORK SYMBOLS

	SERVICE STUB (NO METER): SIMILAR TO SD-310 SERVICE RENEWAL, WITH NEW METER BOX. METER AND ALL CONNECTION FEES TO BE THE RESPONSIBILITY OF THE OWNER AND OBTAINED THROUGH THE NEW SERVICES DIVISION.		CENTER LINE
	PROPOSED TIE-OVER OF EXISTING SERVICE LINE.		RIGHT-OF-WAY
	PROPOSED ADJUSTMENT OF EXISTING WATER METER AND BOX.		FENCE
	PROPOSED RELOCATION OF EXISTING WATER METER AND BOX, WITH RENEWAL OF EXISTING WATER SERVICE LINE.		BARRICADE RAILING
	REMOVAL OF SERVICE. INCLUDES REMOVAL OF SERVICE LINE, METER, METER BOX, AND ALL APPURTENANCES PER SD-350. SALVAGE METER TO TUCSON WATER.		EASEMENT BOUNDARY LINE
	FOT		WALL
	SANITARY SEWER		UTILITIES SYMBOLS
	UNDERGROUND PHONE LINE		FIBER OPTIC TELEPHONE
	TELEVISION LINE		SANITARY SEWER
	STORM DRAIN		UNDERGROUND PHONE LINE
	UNDERGROUND POWER		TELEVISION LINE
	OVERHEAD POWER & POLES		STORM DRAIN
	GAS		UNDERGROUND POWER
	CUT LINE		OVERHEAD POWER & POLES
	FILL LINE		GAS
	DRAINAGE CULVERTS		CUT LINE
	PROFILE SYMBOLS		FILL LINE
	POTABLE GATE VALVE		DRAINAGE CULVERTS
	POTABLE WATER MAIN		PROFILE SYMBOLS
	END CAP TAPPED		POTABLE GATE VALVE
	CORROSION TEXT STATION		POTABLE WATER MAIN
	CULTURE SYMBOLS		END CAP TAPPED
	PAVED ROADWAY		CORROSION TEXT STATION

F.H.W.A. REGION	STATE	PROJECT NO.	SHEET NO.	TOTAL SHEETS	RECORD DRAWING
9	ARIZ.	010-D(213)S	816	849	

010 PM 252


# WATER SYSTEM MODIFICATION LEGEND

EXISTING	WATER SYMBOLS	NEW
	WATER MAIN	
	GATE VALVE	
	FIRE HYDRANT	
	FIRE SERVICE	
	SERVICE LINE & METER BOX	
	CUT & PLUG	
	BENDS, HORIZ. & VERT.	
	REDUCER/INCR. symbol"/>	
	END CAP	
	AIR RELEASE VALVE W/SIZE	
	DRAIN VALVE ASSEMBLY	
	MATERIAL CHANGE	
	SHEET NUMBER	
	SERVICE LINE TIE-OVER	
	METER RELOCATION	
	SERVICE LINE ADJUSTMENT	
	WATER RELOCATION	
	SERVICE LINE RENEWAL	
	WATER RELOCATION	
	SERVICE LINE REMOVAL	
	SERVICE STUB	
	CORROSION TEXT STATION	
	BOUNDARY SYMBOLS	
	CENTER LINE	
	RIGHT-OF-WAY	
	FENCE	
	BARRICADE RAILING	
	EASEMENT BOUNDARY LINE	
	WALL	
	UTILITIES SYMBOLS	
	FIBER OPTIC TELEPHONE	
	SANITARY SEWER	
	UNDERGROUND PHONE LINE	
	TELEVISION LINE	
	STORM DRAIN	
	UNDERGROUND POWER	
	OVERHEAD POWER & POLES	
	GAS	
	CUT LINE	
	FILL LINE	
	DRAINAGE CULVERTS	
	PROFILE SYMBOLS	
	POTABLE GATE VALVE	
	POTABLE WATER MAIN	
	END CAP TAPPED	
	CORROSION TEXT STATION	
	CULTURE SYMBOLS	
	PAVED ROADWAY	


DESIGN	DL	DATE	3-19	<b>ARIZONA DEPARTMENT OF TRANSPORTATION</b> <b>INFRASTRUCTURE DELIVERY AND OPERATIONS DIVISION</b> <b>ROADWAY DESIGN SERVICES</b>	
DRAWN	CPG	3-19			
CHECKED	FF	3-19			
<b>WATER SHEET W2 OF W16</b>		<b>ROUTE</b>		<b>RUTHRAUFF ROAD</b>	
		<b>1-10</b>		<b>LOCATION</b>	
		<b>TRACS NO. H 8480 OIC</b>		<b>RUTHRAUFF ROAD TI</b>	
		<b>010-D(213)S</b>		<b>GENERAL NOTES</b>	
<b>NO.</b>		<b>DATE</b>		<b>DWG NO.</b>	
<b>REVISION</b>		<b>BY</b>		<b>U-2.02</b>	
<b>CHKD.</b>		<b>APPR.</b>		<b>OF</b>	

F.H.W.A. REGION	STATE	PROJECT NO.	SHEET NO.	TOTAL SHEETS	RECORD DRAWING
9	ARIZ.	010-D(213)S	817	849	

010 PM 252

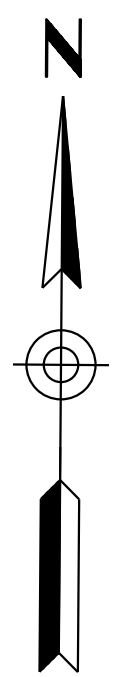

SURVEY NO. LOCATION DATE FINISHED PLANS REVISIONS LOCATION DATE FINISHED PLANS REVISIONS LOCATION DATE FINISHED PLANS REVISIONS

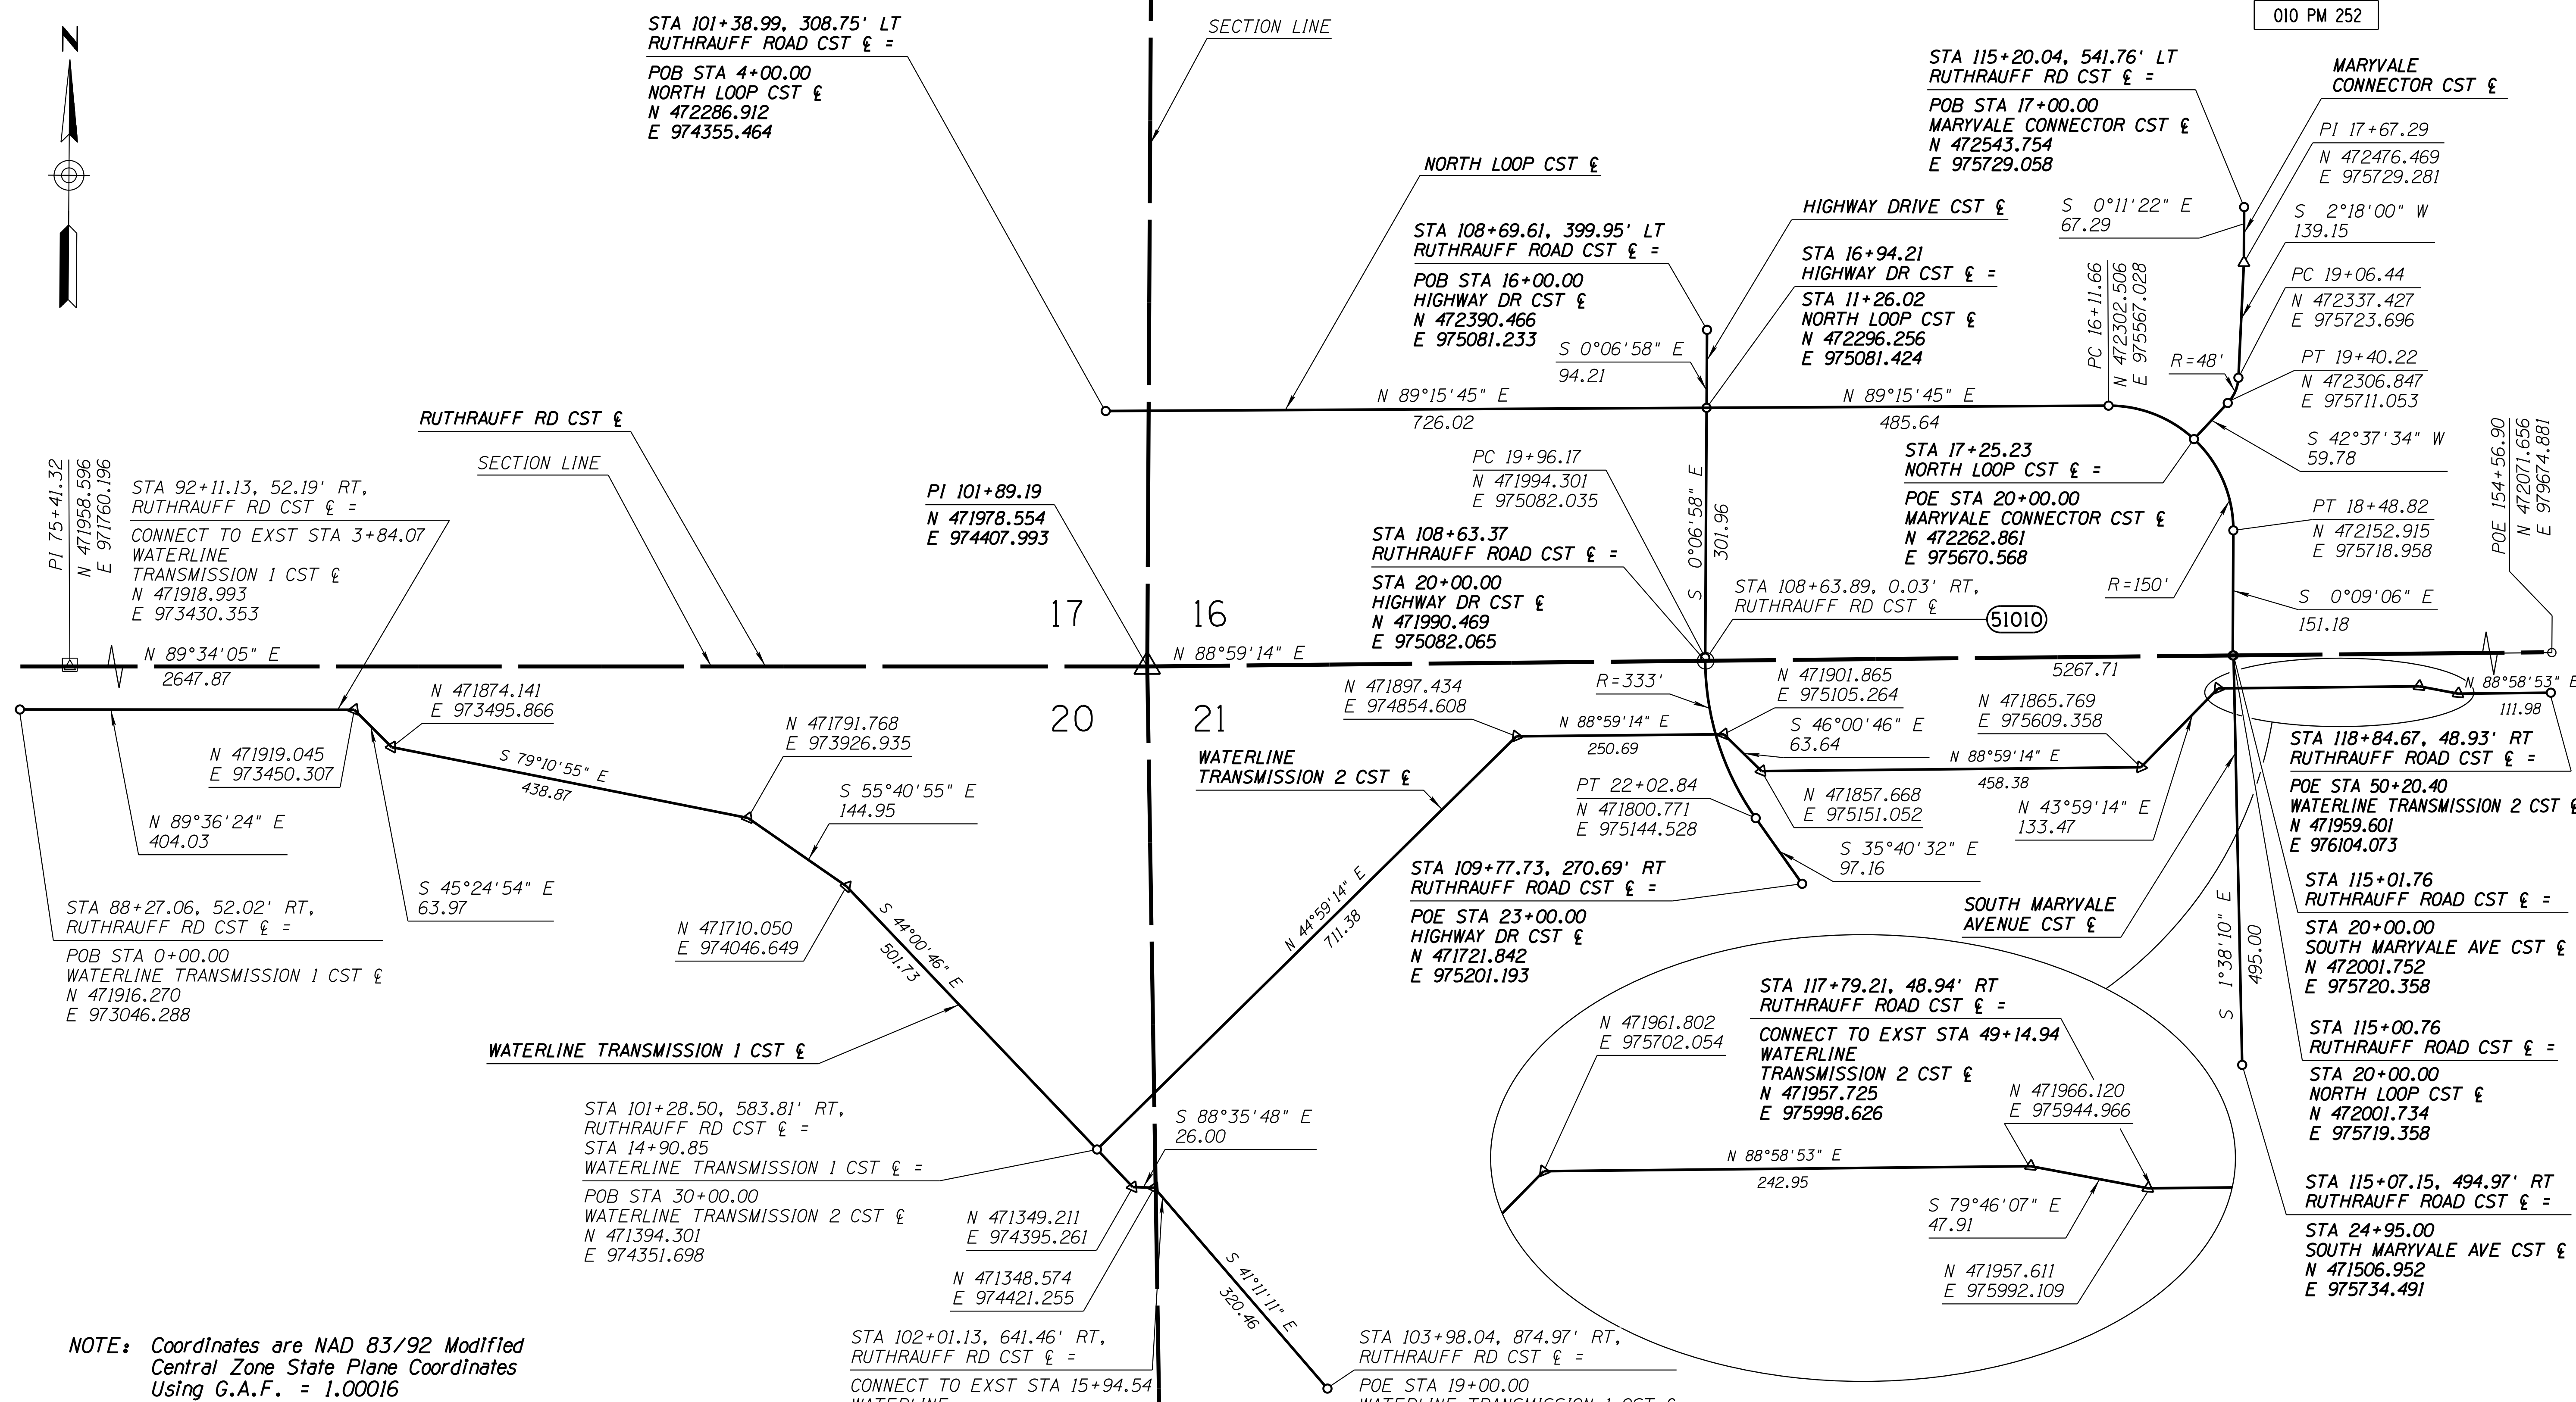


NOTE: Coordinates are NAD 83/92 Modified Central Zone State Plane Coordinates Using G.A.F. = 1.00016

GEOMETRIC CONTROL POINT DATA			
	NORTHING	EASTING	DESCRIPTION
51010	471990.451	975082.589	FND 2IN BCFL RUTHRAUFF DAVIS



DESIGN	DL	DATE	NAME
DRAWN	CPG	3-19	
CHECKED	FF	3-19	

ARIZONA DEPARTMENT OF TRANSPORTATION  
 INFRASTRUCTURE DELIVERY AND OPERATIONS DIVISION  
 ROADWAY DESIGN SERVICES  
 RUTHRAUFF ROAD  
 WATER MODIFICATION PLANS  
 GEOMETRIC CONTROL SHEET

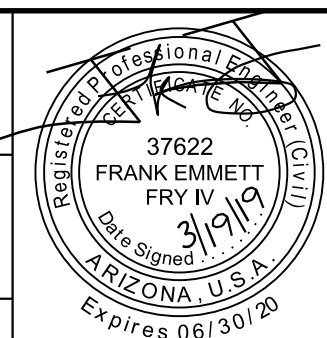

VERT: 1" = 4'  
HORZ: 1" = 40'

NO.	DATE	REVISION	BY	CHKD.	APPR.

ROUTE	LOCATION	DWG NO.	U-2.03
I-10	RUTHRAUFF ROAD TI		
TRACS NO.	H 8480 OIC	PROJECT NO.	010-D(213)S
		DATE	OF




F.H.W.A. REGION	STATE	PROJECT NO.	SHEET NO.	TOTAL SHEETS	RECORD DRAWING
9	ARIZ.	010-D(213)S	818	849	

010 PM 252


BID SCHEDULE MATERIAL QUANTITIES SUMMARY

ITEM NO.	ITEM DESCRIPTION		SHEET W05		SHEET W06		SHEET W07		SHEET W08		SHEET W09		SHEET W10		SHEET W11		SHEET W12		SHEET W13		SHEET W14		SHEET W15		SHEET W16		TOTALS		
			EST.	AS BUILT	EST.	AS BUILT	EST.	AS BUILT	EST.	AS BUILT	EST.	AS BUILT	EST.	AS BUILT	EST.	AS BUILT	EST.	AS BUILT	EST.	AS BUILT	EST.	AS BUILT	EST.	AS BUILT	EST.	AS BUILT	EST.	AS BUILT	
2020121	REMOVE (WATER LINE PIPE) (CA)	LF	474						1819		1386		285		257						330						4551		
2020123	REMOVE (WATER LINE PIPE) (NON CA)	LF	261		745			65		25		568											3				1667		
2020155	REMOVE (FIRE HYDRANT)	EA	1					2		2																	5		
2020173	REMOVE (BACKFLOW PREVENTION)	EA	2							3		1								1		3					10		
5010600	JACKING, BORING OR TUNNELING PIPE	LF	110			515		7																			632		
8080032	BACKFLOW PREVENTION UNIT (REDUCED PRESSURE) (1")	EA																						1			1		
8080035	BACKFLOW PREVENTION UNIT (REDUCED PRESSURE) (2")	EA																						1			1		
8080188	AIR/VACUUM RELEASE VALVE (1")	EA																		2		4					6		
8080189	AIR/VACUUM RELEASE VALVE (2")	EA												1							3						4		
8080221	GATE VALVE (6")	EA																			1						1		
8080222	GATE VALVE (8")	EA																				1	2	1			4		
8080224	GATE VALVE (12")	EA																			1						1		
8080232	GATE VALVE (16")	EA	1		1						1				1						1						6		
8080288	PIPE (PVC) (6") (DR14) (CL305)	LF																		6		8					14		
8080293	PIPE (PVC) (12") (DR14) (CL305)	LF																			324						324		
8080299	PIPE (PVC) (8") (DR14) (CL305)	LF																					199		515		714		
8080378	PIPE (PVC) (16") (DR18) (CL235)	LF			91									616		596				259		181					1743		
8080617	PROVIDE WATER SERVICE (1")	EA						1												1		2			1		5		
8080638	RELOCATE WATER METER (MR)	EA																							3		3		
8080646	RESET FRAME AND COVER FOR VALVE BOX	EA																							2		2		
8080651	FIRE HYDRANT	EA																						1	1	1	3		
8080901	DRAIN VALVE ASSEMBLY	EA						1																			1		
8081714	PIPE, DUCTILE IRON (24") (CL 200)	LF	387		605		30		588		529																2139		
8082106	PIPE, DUCTILE IRON, 6" (CL 350)	LF																								5		5	
8082108	PIPE, DUCTILE IRON, 8" (CL 350)	LF																								80	130	210	
8082112	PIPE, DUCTILE IRON, 12" (CL 350)	LF																								46		46	
8082116	PIPE, DUCTILE IRON, 16" (CL 200)	LF	20								86				105											72		283	
8082124	PIPE, DUCTILE IRON, 24" (CL 250)	LF	110			670		11																			791		
8084024	BUTTERFLY VALVE (24")	EA				1		1																			2		
8090704	CASING (40", OPEN CUT)	LF				155																					155		
9240160	MISCELLANEOUS WORK (ABANDON AND GROUT, 16" PIPE)	LF											352														352		
9240169	MISCELLANEOUS WORK (REMOVE STEEL CASING PIPE)	LF											184														184		
9240172	MISCELLANEOUS WORK (WATER SERVICE REMOVAL) (SR)	EA						2		7		1								1		3					14		
9240173	MISCELLANEOUS WORK (THRUST RESTRAINT PER SD-610)	EA	1												1						1		1				5		
9240176	MISCELLANEOUS WORK (CORROSION TEST STATIONS)	EA	3		1		1		1		1																7		
9240178	MISCELLANEOUS WORK (JACK AND BORE EQUIP, SURVEY, ETC.)	EA	1			0.9		0.1																			2		

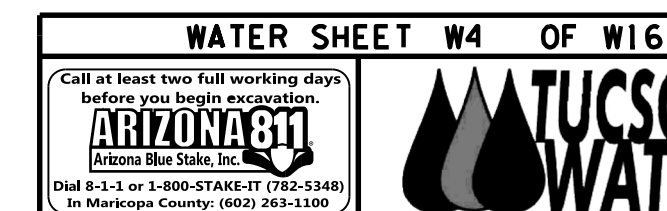

DESIGN	DL	DATE	3-19
DRAWN	CPG	DATE	3-19
CHECKED	FF	DATE	3-19


ARIZONA DEPARTMENT OF TRANSPORTATION  
INFRASTRUCTURE DELIVERY AND OPERATIONS DIVISION  
ROADWAY DESIGN SERVICES  
RUTHRAUFF ROAD  
WATER MODIFICATION PLANS  
QUANTITIES SUMMARY SHEET

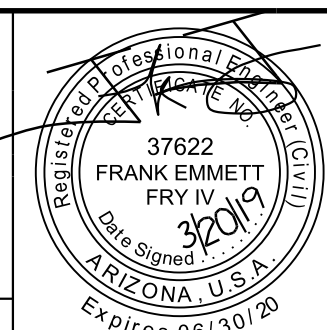

NO.	DATE	REVISION	BY	CHKD.	APPR.	TRACS NO. H 8480 OIC	010-D(213)S	DWG NO. U-2.04
-----	------	----------	----	-------	-------	----------------------	-------------	----------------

F.H.W.A. REGION	STATE	PROJECT NO.	SHEET NO.	TOTAL SHEETS	RECORD DRAWING
9	ARIZ.	010-D(213)S	819	849	

010 PM 252

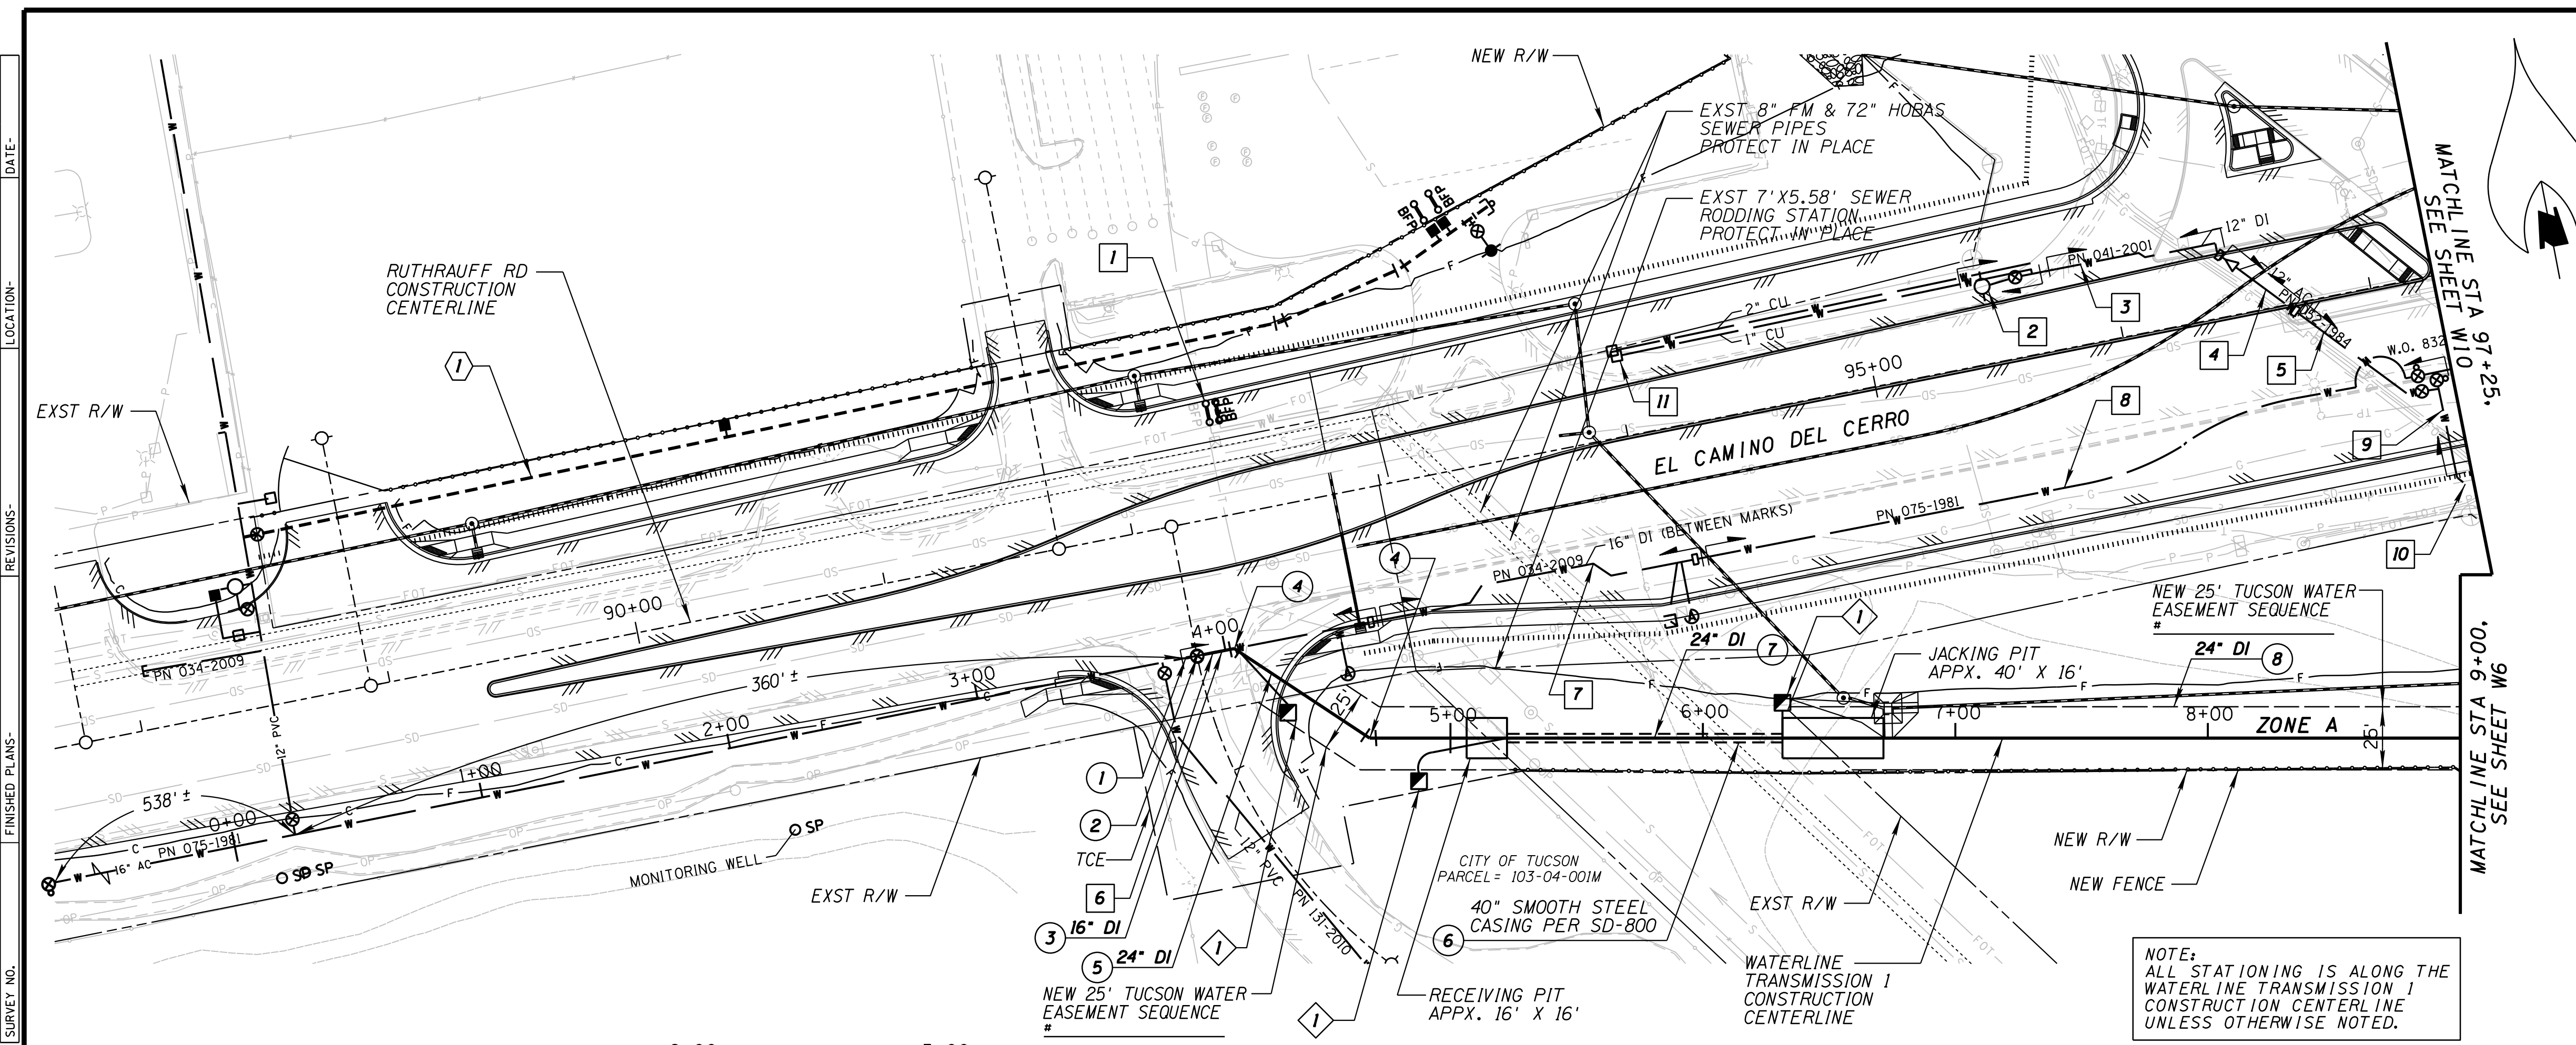


- REMOVE / ABANDON NOTES
- 1 RUTHRAUFF RD & STA. 92+39, 41' LT. STA. 92+42, 41' LT. REMOVE BACKFLOW PREVENTION 2 EA
  - 2 RUTHRAUFF RD & STA. 95+52, 31' LT. REMOVE FIRE HYDRANT INSTALLATION PER SD-500 1 EA
  - 3 RUTHRAUFF RD & STA. 95+65, 32' LT. TO 96+43.29' LT. REMOVE AND DISPOSE 6" DI PIPE 79 LF
  - 4 RUTHRAUFF RD & STA. 96+43, 29' LT. TO 96+69, 3' RT. REMOVE AND DISPOSE 12" DI PIPE 40 LF
  - 5 RUTHRAUFF RD & STA. 96+69, 3' RT. TO 97+19, 44' RT. REMOVE AND DISPOSE 12" CA PIPE 68 LF
  - 6 RUTHRAUFF RD & STA. 92+11, 52' RT. TO 92+86, 53' RT. REMOVE AND DISPOSE 16" CA PIPE 75 LF
  - 7 RUTHRAUFF RD & STA. 92+86, 53' RT. TO 94+17, 53' RT. REMOVE AND DISPOSE 16" DI PIPE 136 LF
  - 8 RUTHRAUFF RD & STA. 94+17, 53' RT. TO 97+25, 38' RT. REMOVE AND DISPOSE 16" CA PIPE 311 LF
  - 9 RUTHRAUFF RD & STA. 97+19, 38' RT. TO 97+19, 58' RT. REMOVE AND DISPOSE 16" CA PIPE 20 LF
  - 10 STA. 8+94, 125' LT. TO 9+00, 102' LT. REMOVE AND DISPOSE 16" PVC PIPE 6 LF
  - 11 SEE SHEET W16 FOR SERVICE WORK

- CONSTRUCTION NOTES
- 1 STA. 3+84, & CONNECT TO EXIST. 16" CA PIPE 1 EA(NP1)
  - 2 STA. 3+89, & 16" GATE VALVE, B&C W/ THRUST BLOCK PER SD-610 (MODIFIED) 1 EA SEE DIMENSION TABLE, THIS SHEET.
  - 3 STA. 3+89, & TO STA. 4+04, & 16" DI (CL 200) 20 LF
  - 4 STA. 4+04, & STA. 4+68, & 24" X 45" BEND (RO) 2 EA(NP1) 24" TO 16" ECCENTRIC REDUCER 1 EA(NP1)
  - 5 STA. 4+04, & TO STA. 5+22, & 24" DI (CL 200) 119 LF
  - 6 STA. 5+22, & TO STA. 6+32, & 40" STEEL CASING PIPE (TH=3/16") PER SD-800 JACKING AND BORING 110 LF
  - 7 STA. 5+22, & TO STA. 6+32, & 24" DI (CL 250) 110 LF
  - 8 STA. 6+32, & TO STA. 9+00, & 24" DI (CL 200) 268 LF

- REFERENCE NOTES
- 1 DISTRIBUTION WATER MAIN PLAN & PROFILE, SEE SHEET W16

- MONITORING AND PROTECTION
- 1 STA. 4+34, 7' RT., TYPE 5, DTL. NO. CP-1 STA. 4+88, 14' RT., TYPE 2/5, DTL. NO. CP-3 STA. 6+32, 11' LT., TYPE 2/5, DTL. NO. CP-4 CTS ABOVE GROUND PER TYPE & DETAIL SPECIFY ABOVE & TUCSON WATER STANDARD DETAIL SD-706. SEE ITEM NO. 9240176 IN THE SPECIAL PROVISIONS 3 EA

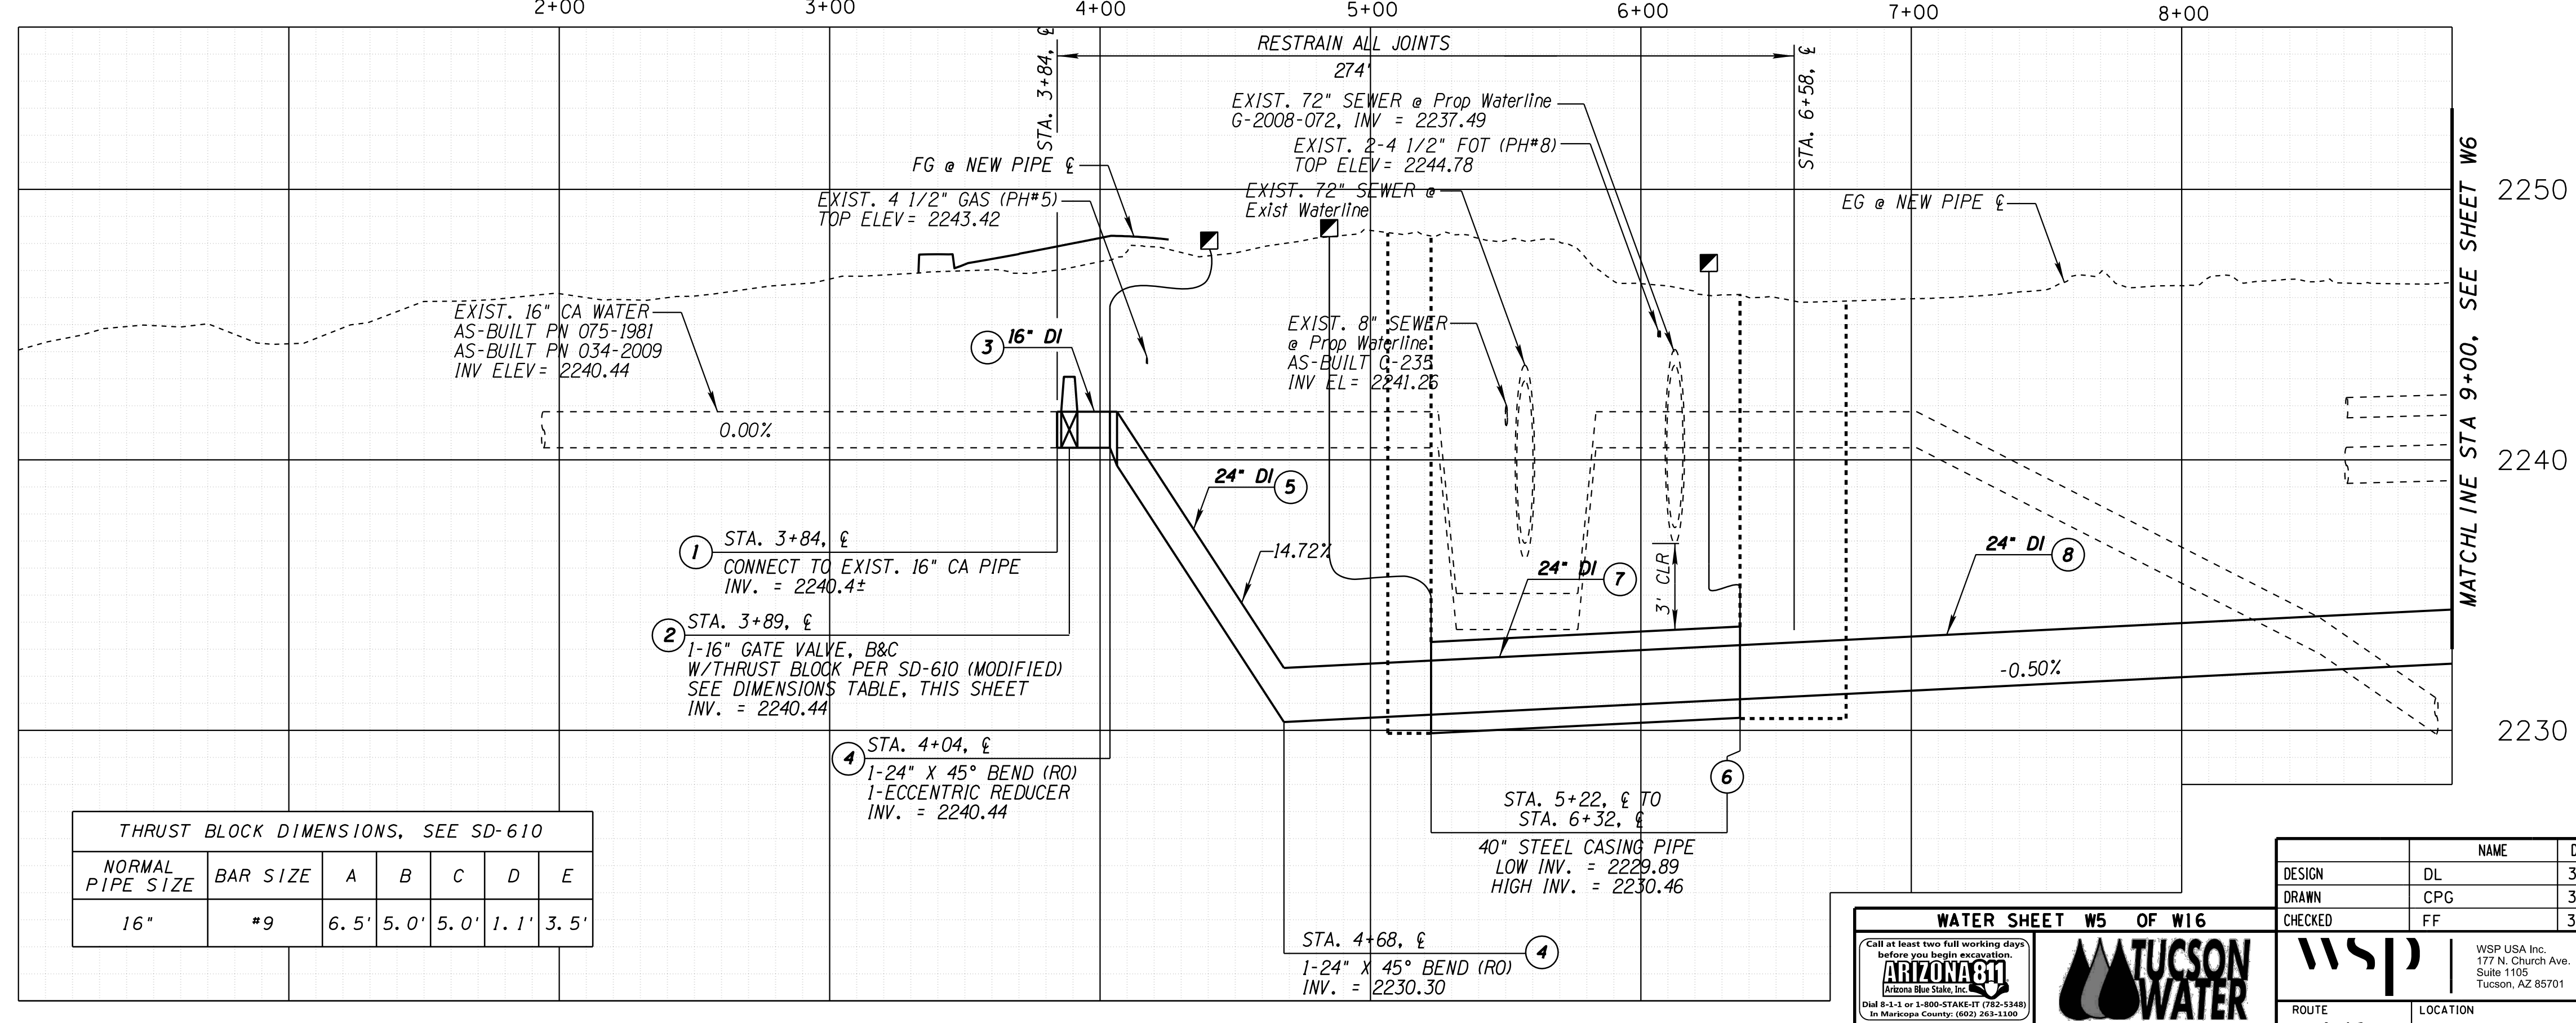

THRUST BLOCK DIMENSIONS, SEE SD-610

NORMAL PIPE SIZE	BAR SIZE	A	B	C	D	E
16"	#9	6.5'	5.0'	5.0'	1.1'	3.5'

VERT: 1" = 4'  
HORIZ: 1" = 40'

WATER SHEET W5 OF W16

ARIZONA WATER

WSP USA INC. 177 N. Church Ave. Suite 1105 Tucson, AZ 85701

ARIZONA DEPARTMENT OF TRANSPORTATION INFRASTRUCTURE DELIVERY AND OPERATIONS DIVISION ROADWAY DESIGN SERVICES

RUTHRAUFF ROAD WATER MODIFICATION PLANS TRANSMISSION PLAN AND PROFILE

ROUTE 1-10 LOCATION RUTHRAUFF ROAD TI

TRACS NO. H 8480 OIC

010-D(213)S

DWG NO. U-2.05

NO.	DATE	REVISION	BY	CHKD.	APPR.










F.H.W.A. REGION	STATE	PROJECT NO.	SHEET NO.	TOTAL SHEETS	RECORD DRAWING
9	ARIZ.	010-D(213)S	821	849	

010 PM 252

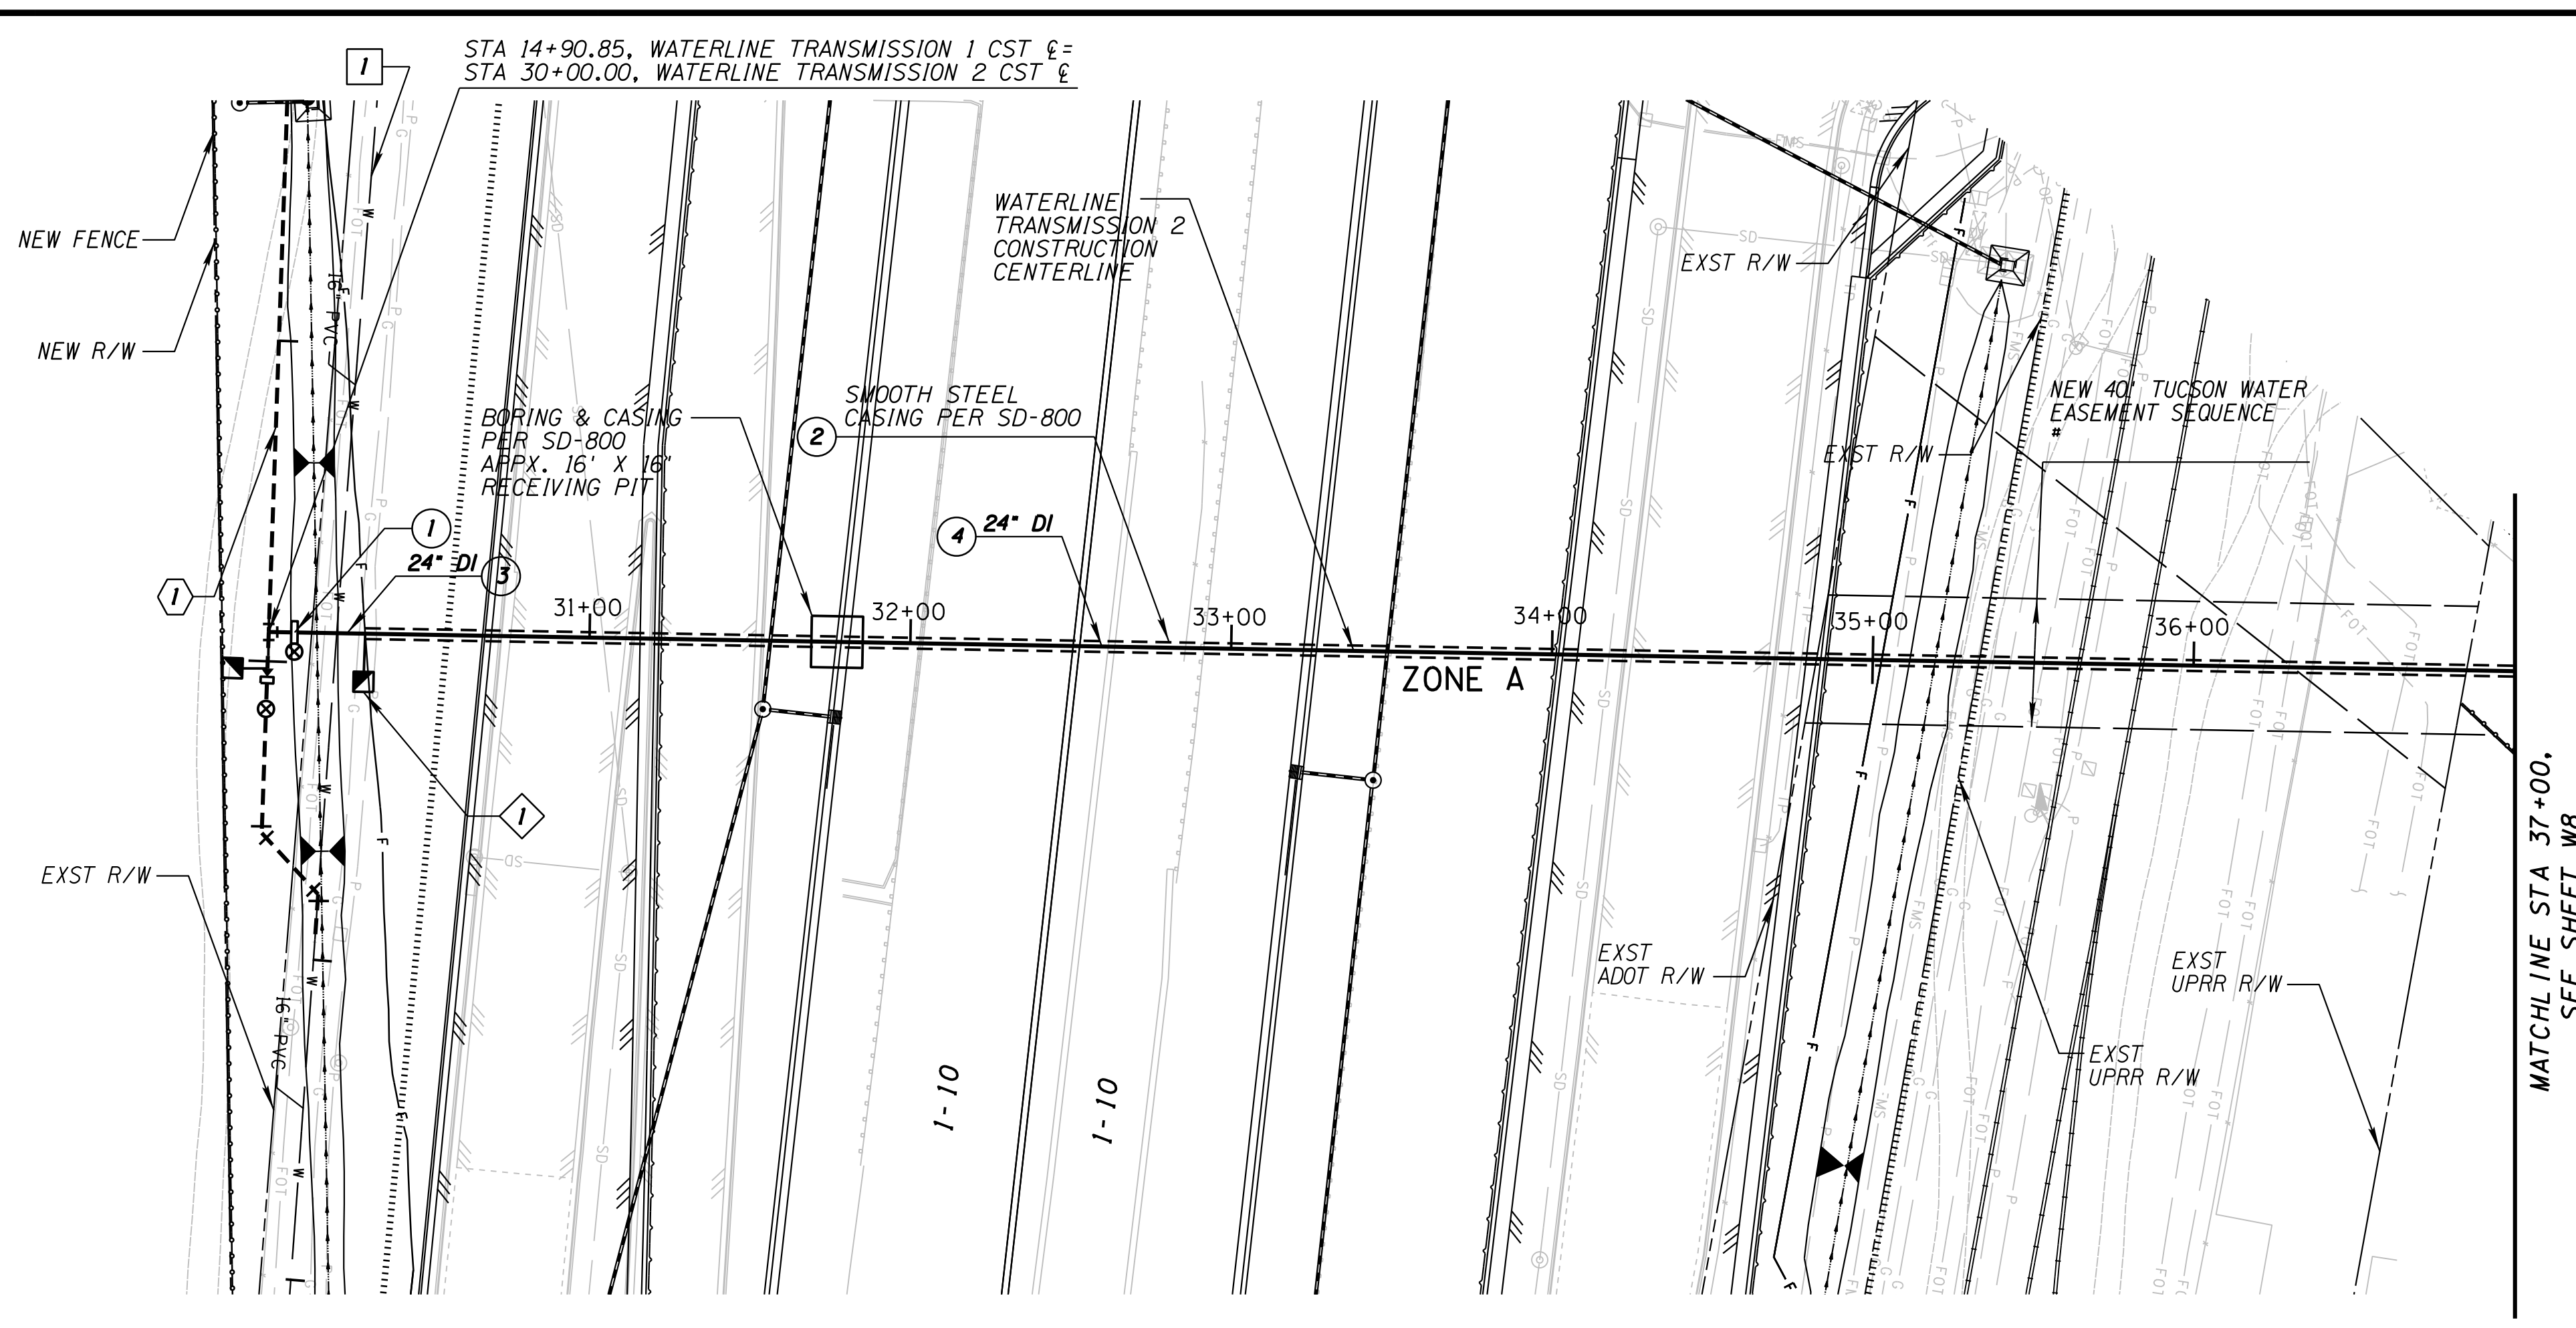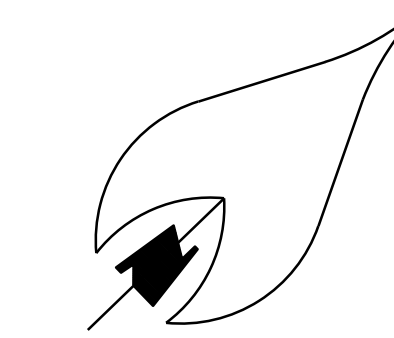

NOTE:  
ALL STATIONING IS ALONG THE WATERLINE TRANSMISSION 2 CONSTRUCTION CENTERLINE UNLESS OTHERWISE NOTED.

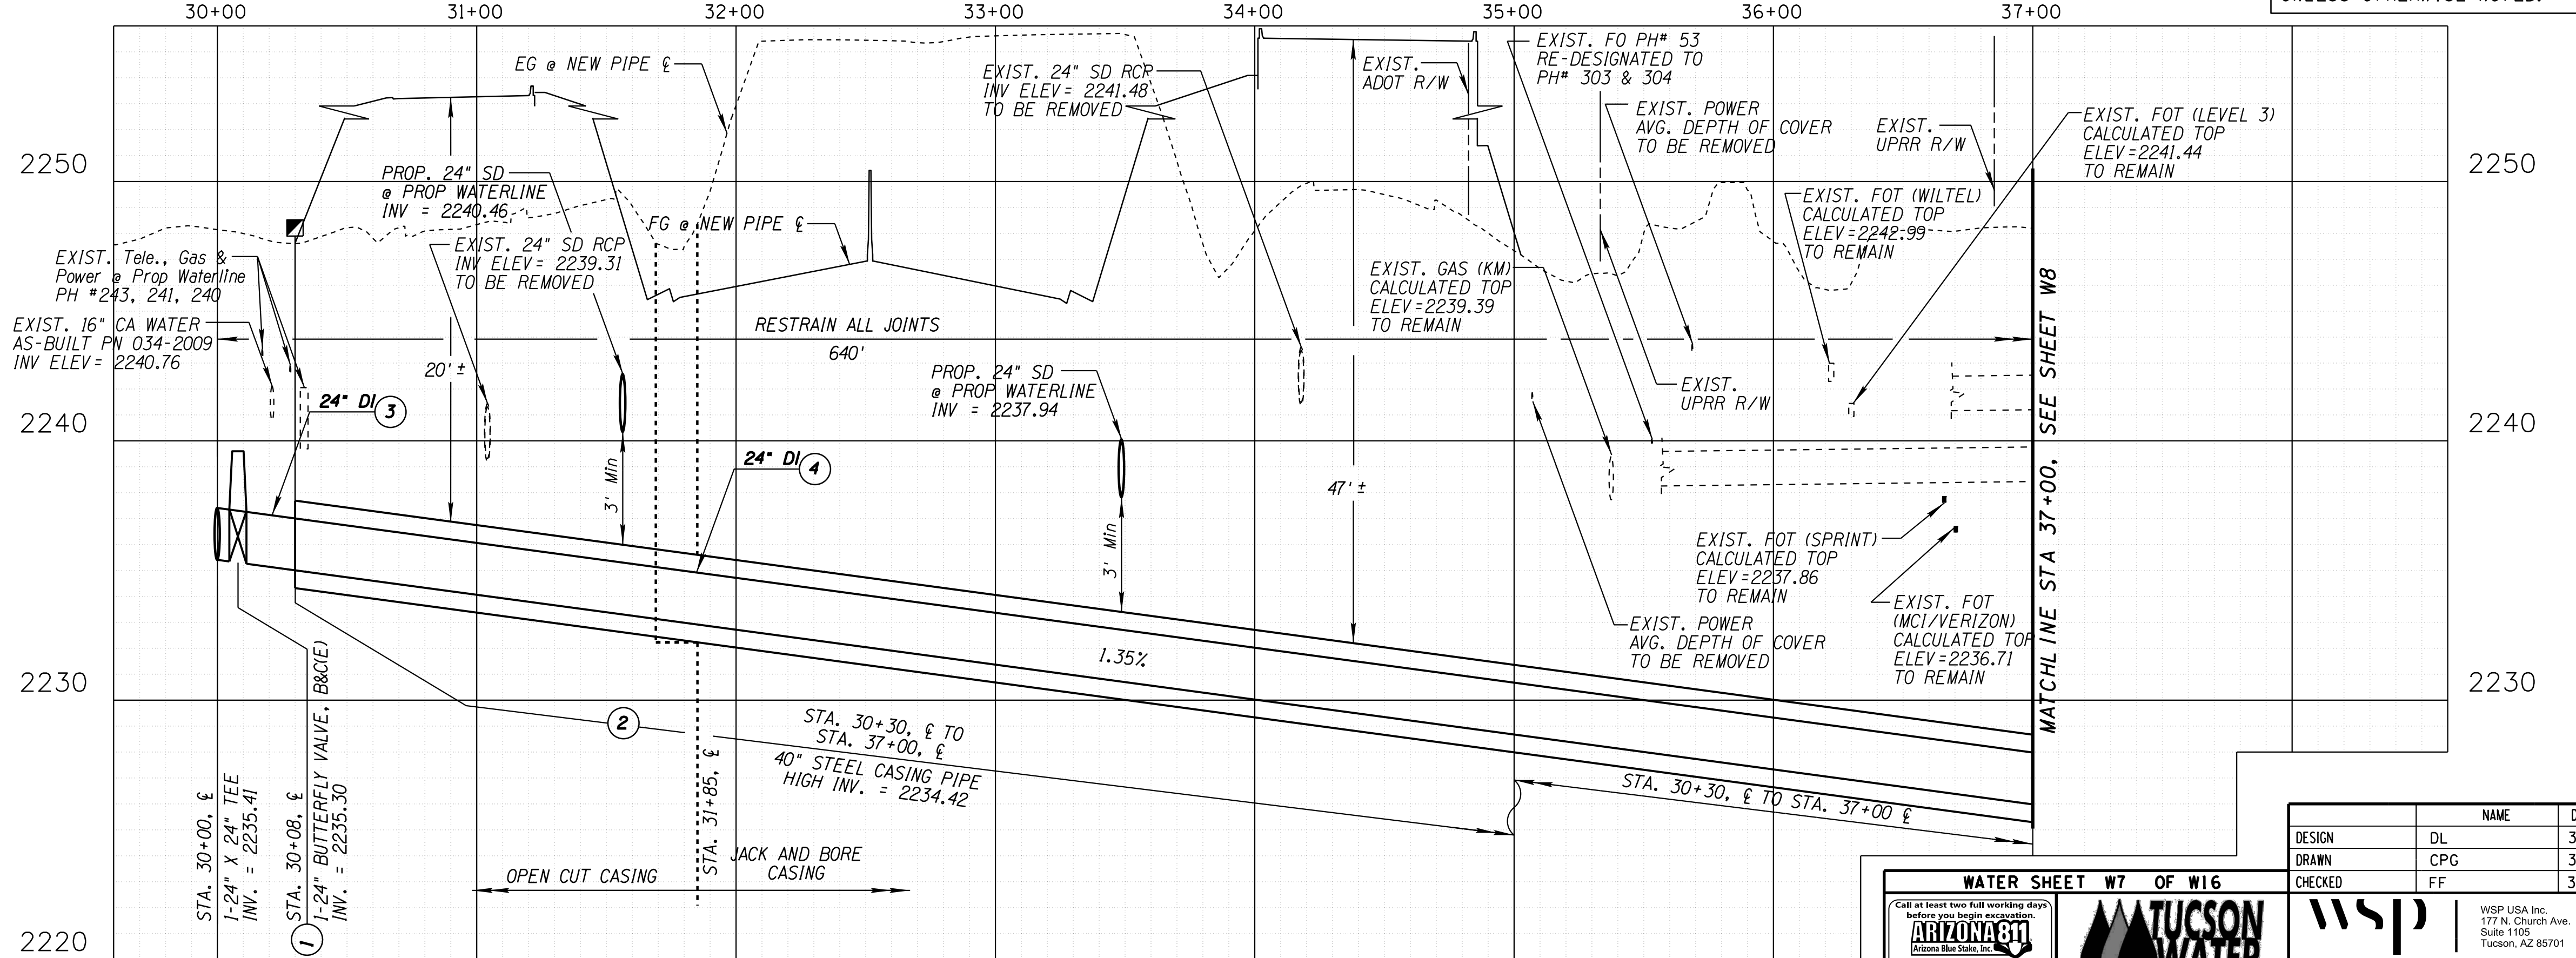


REMOVE / ABANDON NOTES	
1	SEE SHEET W6 FOR REMOVAL OF EXISTING PIPE
CONSTRUCTION NOTES	
1	STA. 30+08, $\epsilon$ TO 24" BUTTERFLY VALVE, B&C(E) 1 EA
2	STA. 30+30, $\epsilon$ TO STA. 31+85, $\epsilon$ TO 40" STEEL CASING PIPE PER SD-800 OPEN CUT 155 LF STA. 31+85, $\epsilon$ TO STA. 35+00, $\epsilon$ TO 40" STEEL CASING PIPE (TH=3/16") PER SD-800 JACKING AND BORING 515 LF
3	STA. 30+00, $\epsilon$ TO STA. 30+30, $\epsilon$ TO 24" DI (CL 200) 30 LF
4	STA. 30+30, $\epsilon$ TO STA. 37+00, $\epsilon$ TO 24" DI (CL 250) 670 LF
REFERENCE NOTES	
1	TRANSMISSION WATER MAIN PLAN & PROFILE, SEE SHEET W6
MONITORING AND PROTECTION	
1	STA. 30+30, 12' RT. TYPE 2/5 ABOVE GROUND CTS PER DETAIL NO. CP-4 & TUCSON WATER STANDARD DETAIL SD-706. SEE ITEM NO. 9240176 IN THE SPECIAL PROVISIONS 1 EA

DESIGN	NAME	DATE
DL		3-19
CPG		3-19
FF		3-19

ARIZONA DEPARTMENT OF TRANSPORTATION  
INFRASTRUCTURE DELIVERY AND OPERATIONS DIVISION  
ROADWAY DESIGN SERVICES

RUTHRAUFF ROAD  
WATER MODIFICATION PLANS  
TRANSMISSION PLAN AND PROFILE

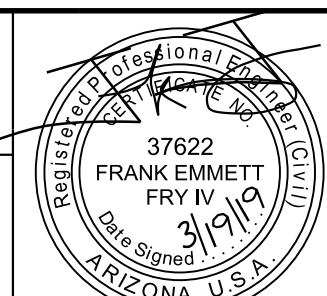

ROUTE 1-10 LOCATION RUTHRAUFF ROAD TI

TRACS NO. H 8480 OIC

010-D(213)S

DWG NO. U-2.07 OF

VERT: 1" = 4'  
HORIZ: 1" = 40'

F.H.W.A. REGION	STATE	PROJECT NO.	SHEET NO.	TOTAL SHEETS	RECORD DRAWING
9	ARIZ.	010-D(213)S	822	849	

010 PM 252


DATE: LOCATION: REVISIONS: FINISHED PLANS: SURVEY NO. DATE: LOCATION: REVISIONS: FINISHED PLANS: SURVEY NO.

REMOVE / ABANDON NOTES


13	RUTHRAUFF RD & STA. 110+00, 55' LT. TO 112+04, 55' LT. REMOVE AND DISPOSE 8" CA PIPE	204 LF
14	RUTHRAUFF RD & STA. 110+17, 72' LT. REMOVE FIRE HYDRANT INSTALLATION PER SD-500	1 EA
15	RUTHRAUFF RD & STA. 110+59, 86' RT. REMOVE FIRE HYDRANT INSTALLATION PER SD-500	1 EA
16	RUTHRAUFF RD & STA. 108+42, 139' RT. TO 108+65, 116' RT. REMOVE AND DISPOSE 12" CA PIPE	32 LF
17	RUTHRAUFF RD & STA. 108+65, 116' RT. TO 108+72, 109' RT. REMOVE AND DISPOSE 12" DI PIPE	10 LF
18	RUTHRAUFF RD & STA. 108+72, 109' RT. TO 109+76, 54' RT. REMOVE AND DISPOSE 12" CA PIPE	134 LF
19	SEE SHEET W14 FOR REMOVAL OF EXISTING PIPE	
20	SEE SHEET W14 FOR REMOVAL OF EXISTING PIPE	

SERVICE WORK

#	ADDRESS/STA	EXST. SERV.	SERV. WORK	EXIST. CONNECTION DIA. - MATL.	NEW CONNECTION DIA. - MATL.
1	2755 W. RUTHRAUFF RD	M ( )	⊠		
2	2745 W. RUTHRAUFF RD	M ( )	⊠		
3	STA. 108+47 ± 116' RT (IRRIGATION)	-	⊠		1" - CU

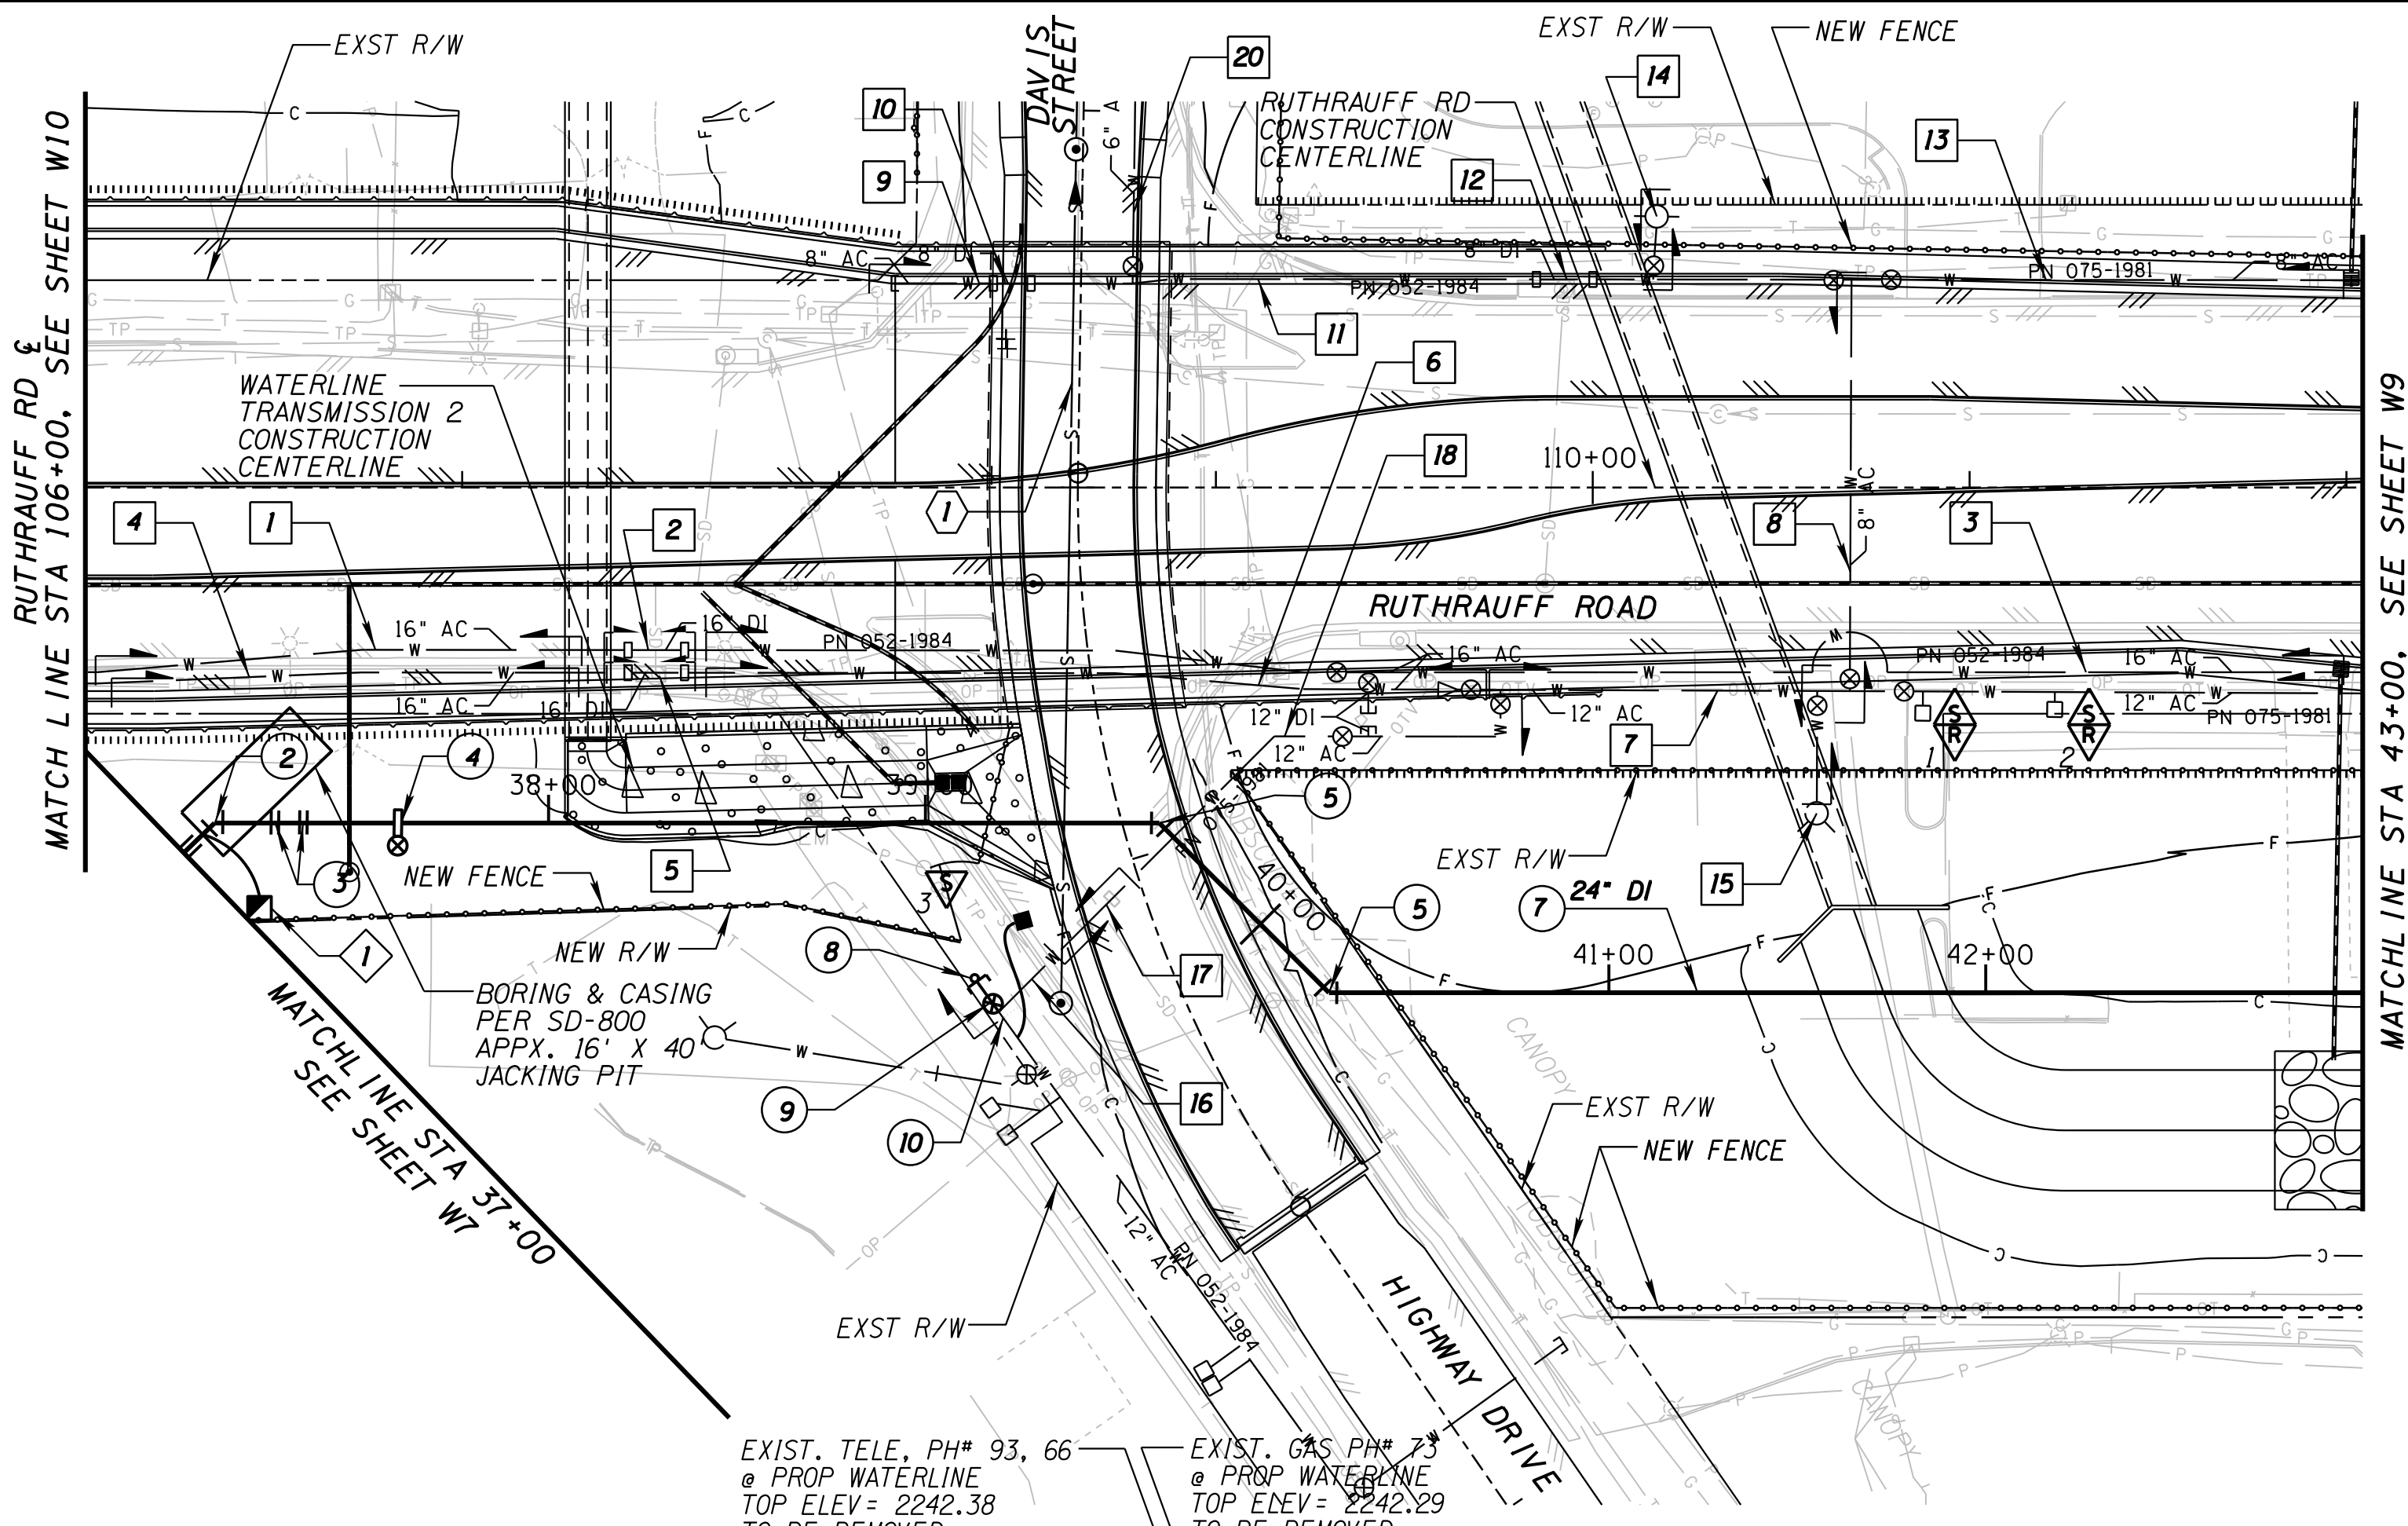

NOTE: ALL STATIONING IS ALONG THE WATERLINE TRANSMISSION 2 CONSTRUCTION CENTERLINE UNLESS OTHERWISE NOTED.

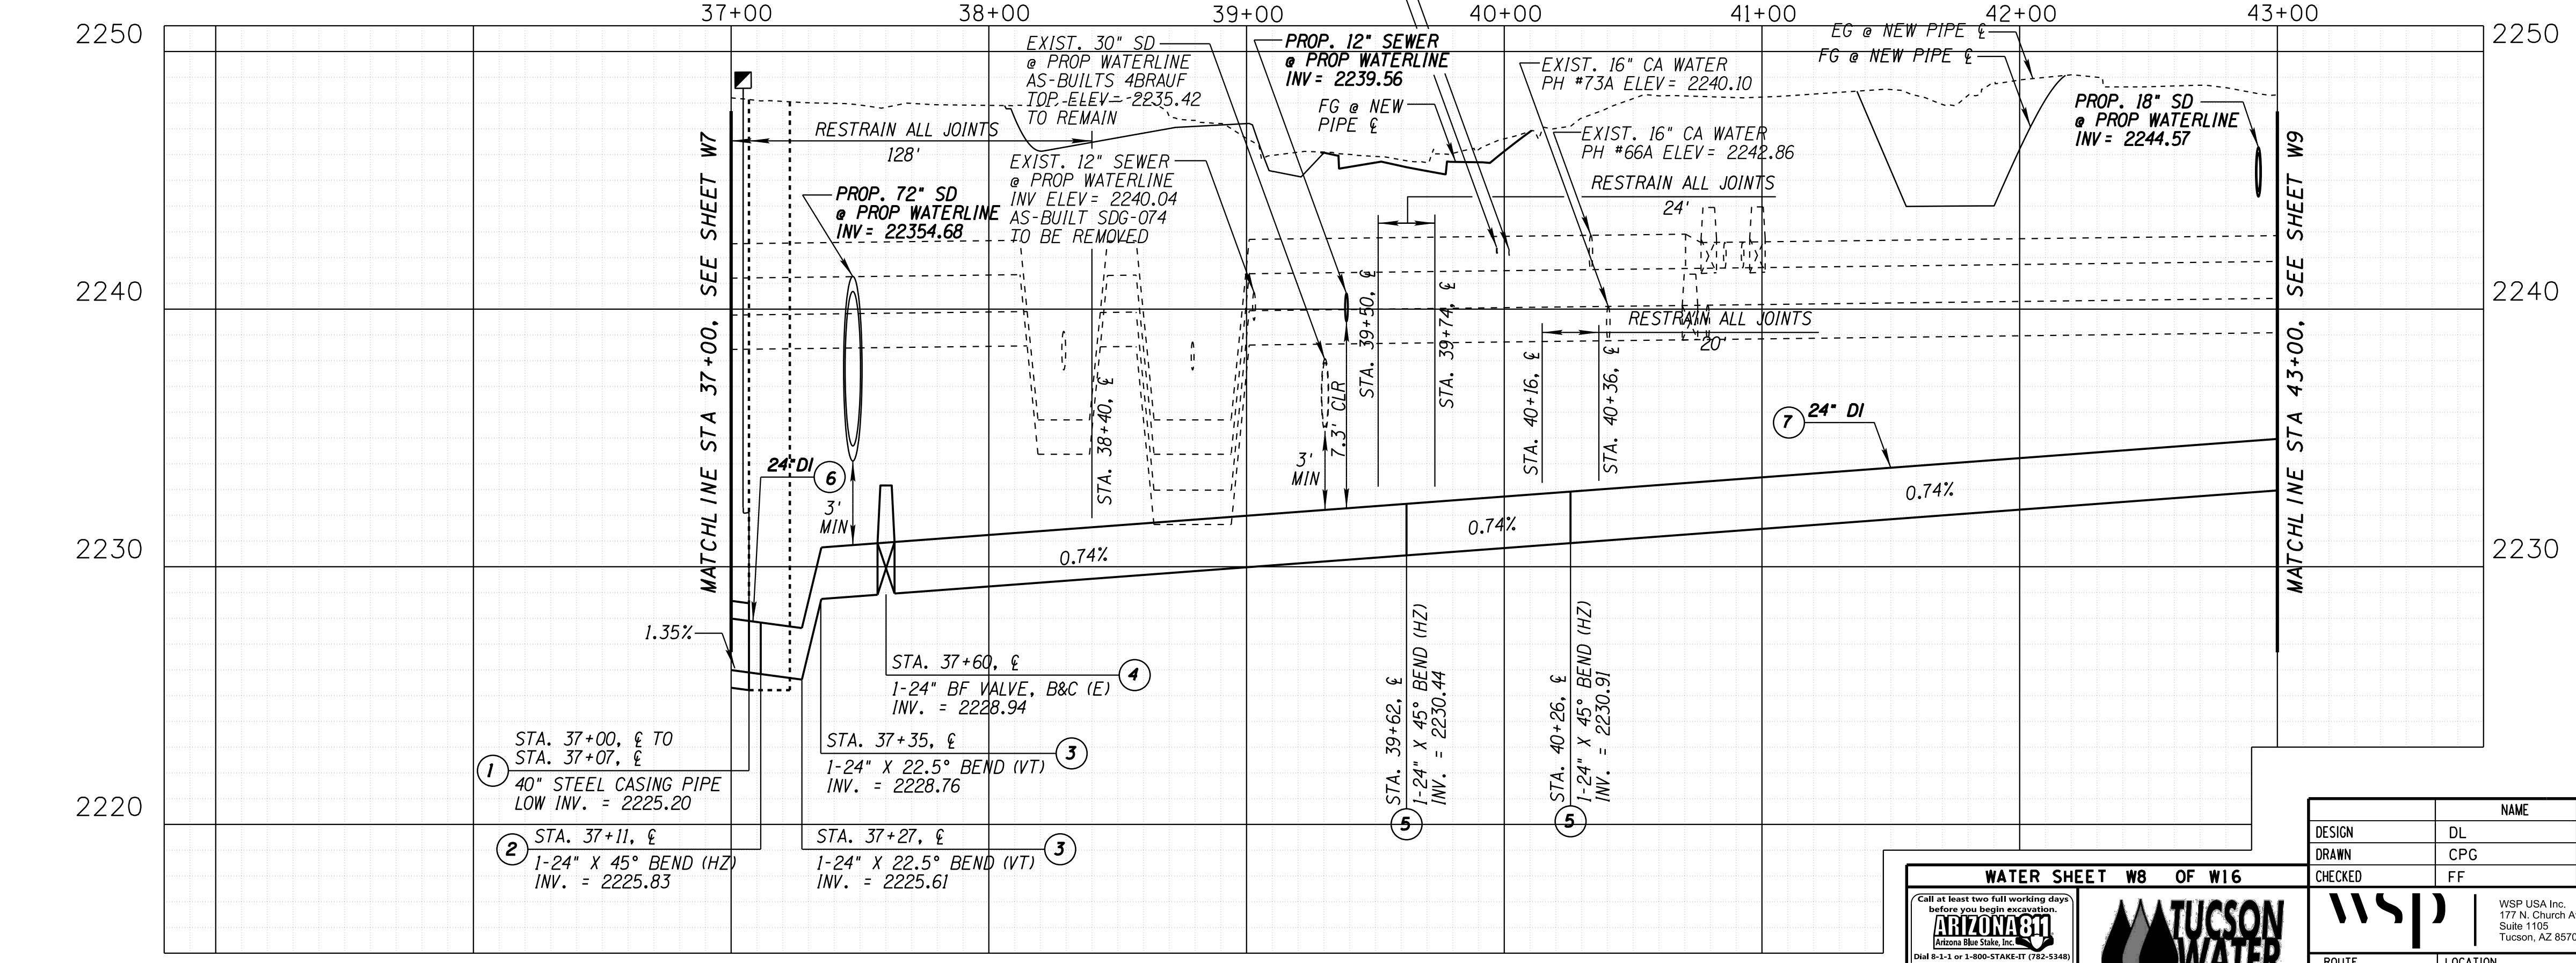

REMOVE / ABANDON NOTES

1	RUTHRAUFF RD & STA. 106+00, 49' RT. TO 107+44, 43' RT. REMOVE AND DISPOSE 16" CA PIPE	144 LF
2	RUTHRAUFF RD & STA. 107+44, 43' RT. TO 107+59, 43' RT. REMOVE AND DISPOSE 16" DI PIPE	15 LF
3	RUTHRAUFF RD & STA. 107+59, 43' RT. TO 112+04, 49' RT. REMOVE AND DISPOSE 16" CA PIPE	446 LF
4	RUTHRAUFF RD & STA. 106+00, 52' RT. TO 107+44, 49' RT. REMOVE AND DISPOSE 16" CA PIPE	144 LF
5	RUTHRAUFF RD & STA. 107+44, 49' RT. TO 107+59, 49' RT. REMOVE AND DISPOSE 16" DI PIPE	15 LF
6	RUTHRAUFF RD & STA. 107+59, 49' RT. TO 109+64, 54' RT. REMOVE AND DISPOSE 16" CA PIPE	205 LF
7	RUTHRAUFF RD & STA. 109+64, 54' RT. TO 112+04, 55' RT. REMOVE AND DISPOSE 12" CA PIPE	240 LF
8	RUTHRAUFF RD & STA. 110+68, 54' RT. TO 110+69, 55' LT. REMOVE AND DISPOSE 8" CA PIPE	109 LF
9	RUTHRAUFF RD & STA. 108+14, 54' LT. TO 108+41, 54' LT. REMOVE AND DISPOSE 8" CA PIPE	27 LF
10	RUTHRAUFF RD & STA. 108+41, 54' LT. TO 108+51, 54' LT. REMOVE AND DISPOSE 8" DI PIPE	10 LF
11	RUTHRAUFF RD & STA. 108+51, 54' LT. TO 109+85, 55' LT. REMOVE AND DISPOSE 8" CA PIPE	134 LF
12	RUTHRAUFF RD & STA. 109+85, 55' LT. TO 110+00, 55' LT. REMOVE AND DISPOSE 8" DI PIPE	15 LF

CONSTRUCTION NOTES

1	STA. 35+00, & TO STA. 37+07, & 40" STEEL CASING PIPE PER SD-800	7 LF
2	STA. 37+11, & 24" x 45° BEND (HZ)	1 EA(NP1)
3	STA. 37+27, & STA. 37+35, & 24" x 22.5° BEND (VT)	2 EA(NP1)
4	STA. 37+60, & 24" BUTTERFLY VALVE, B&C(E)	1 EA
5	STA. 39+62, & STA. 40+26, & 24" x 45° BEND (HZ)	2 EA(NP1)
6	STA. 37+00, & TO STA. 37+11, & 24" DI (CL 250)	11 LF
7	STA. 37+11, & TO STA. 43+00, & 24" DI (CL 200)	588 LF
8	STA. 39+14, 42' RT. END CAP STANDARD METER BOX PER SD-307	1 EA(NP1)
9	STA. 39+18, 48' RT. DRAIN VALVE ASSEMBLY PER SD-400	1 EA
10	STA. 39+20, 50' RT. CONNECT TO EXIST. 12" CA PIPE	1 EA(NP1)

REFERENCE NOTES

1 SANITARY SEWER PLAN & PROFILE, SEE SHEET SS6

MONITORING AND PROTECTION

1 STA. 37+21, 19' RT. TYPE 2/5 ABOVE GROUND CTS PER DETAIL NO. CP-4 & TUCSON WATER STANDARD DETAIL SD-706. SEE ITEM NO. 9240176 IN THE SPECIAL PROVISIONS

DESIGN	DL	DATE	3-19
DRAWN	CPG	DATE	3-19
CHECKED	CFG	DATE	3-19

WATER SHEET W8 OF W16

ARIZONA WATER

Call at least two full working days before you begin excavation.

ARIZONA WATER

177 N. Church Ave. Suite 1105 Tucson, AZ 85701

ARIZONA DEPARTMENT OF TRANSPORTATION INFRASTRUCTURE DELIVERY AND OPERATIONS DIVISION ROADWAY DESIGN SERVICES

RUTHRAUFF ROAD WATER MODIFICATION PLANS TRANSMISSION PLAN & PROFILE

ROUTE 1-10 LOCATION RUTHRAUFF ROAD TI

TRACS NO. H 8480 OIC

010-D(213)S

DWG NO. U-2.08


OF

VERT: 1" = 4'  
HORZ: 1" = 40'




F.H.W.A. REGION	STATE	PROJECT NO.	SHEET NO.	TOTAL SHEETS	RECORD DRAWING
9	ARIZ.	010-D(213)S	823	849	

010 PM 252

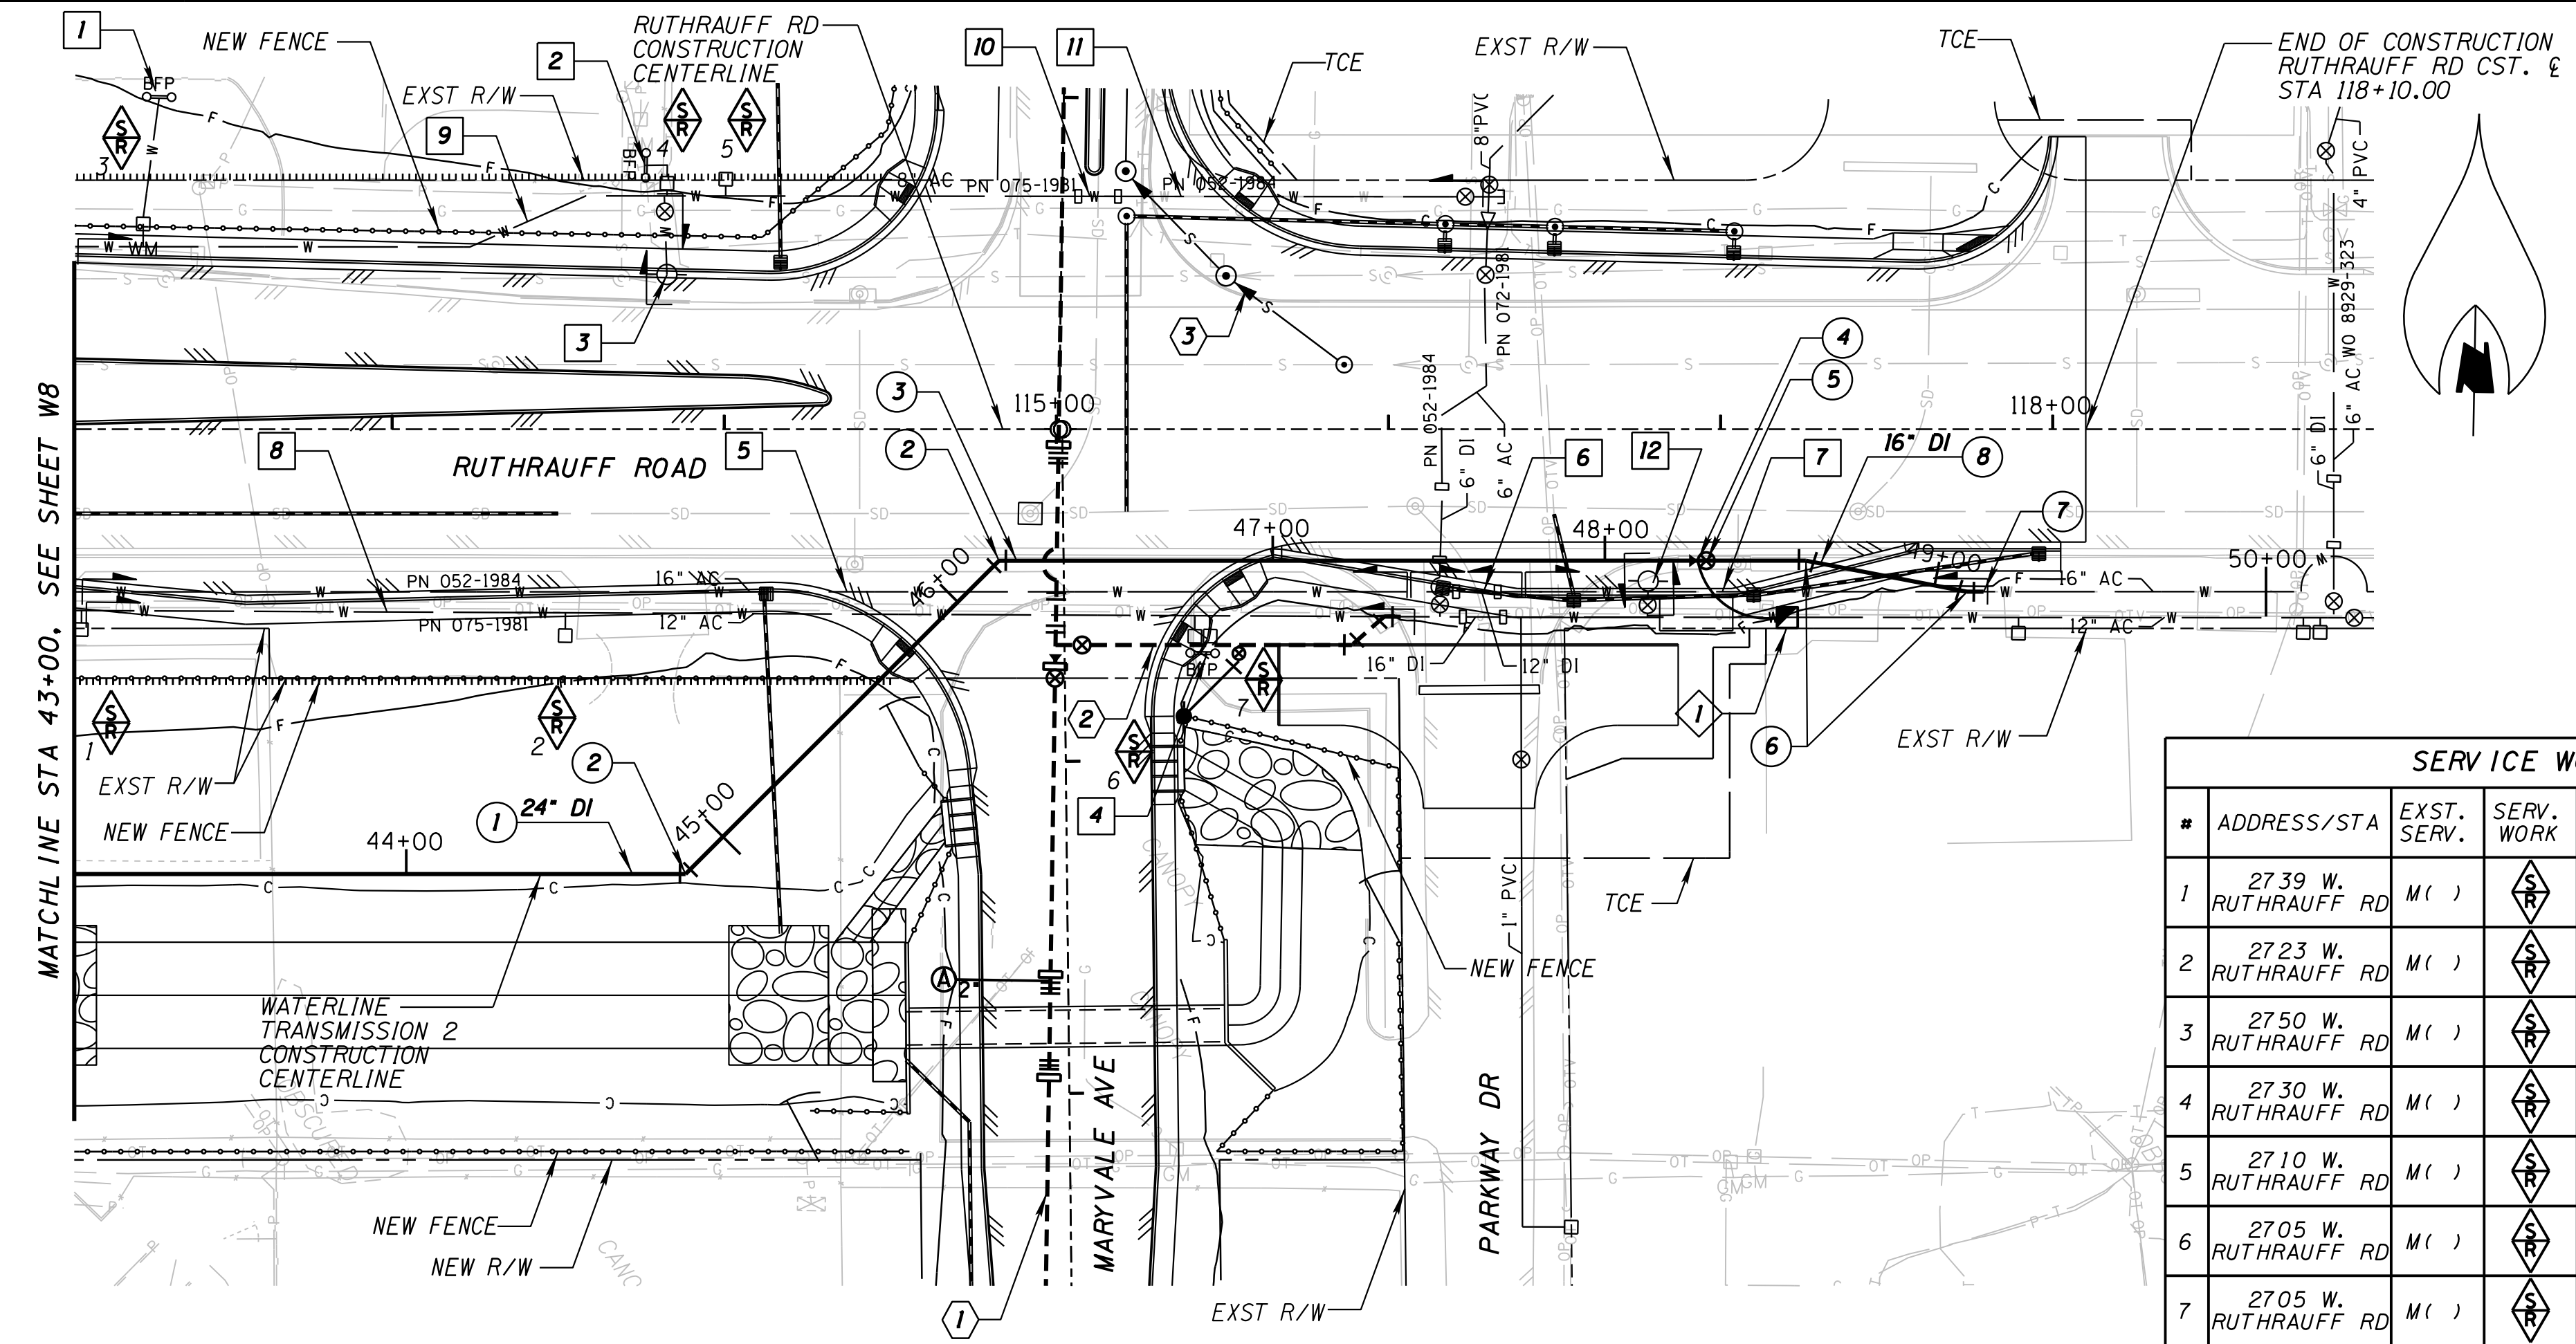

SERVICE WORK				
#	ADDRESS/STA	EXST. SERV.	EXST. CONNECTION DIA. - MATL.	NEW CONNECTION DIA. - MATL.
1	2739 W. RUTHRAUFF RD	M ( )	1" - CU	
2	2723 W. RUTHRAUFF RD	M ( )	1" - CU	
3	2750 W. RUTHRAUFF RD	M ( )	1" - CU	
4	2730 W. RUTHRAUFF RD	M ( )	1" - CU	
5	2710 W. RUTHRAUFF RD	M ( )	1" - CU	
6	2705 W. RUTHRAUFF RD	M ( )	1-1/2" - CU	
7	2705 W. RUTHRAUFF RD	M ( )	1" - CU	

NOTE: ALL STATIONING IS ALONG THE WATERLINE TRANSMISSION 2 CONSTRUCTION CENTERLINE UNLESS OTHERWISE NOTED.

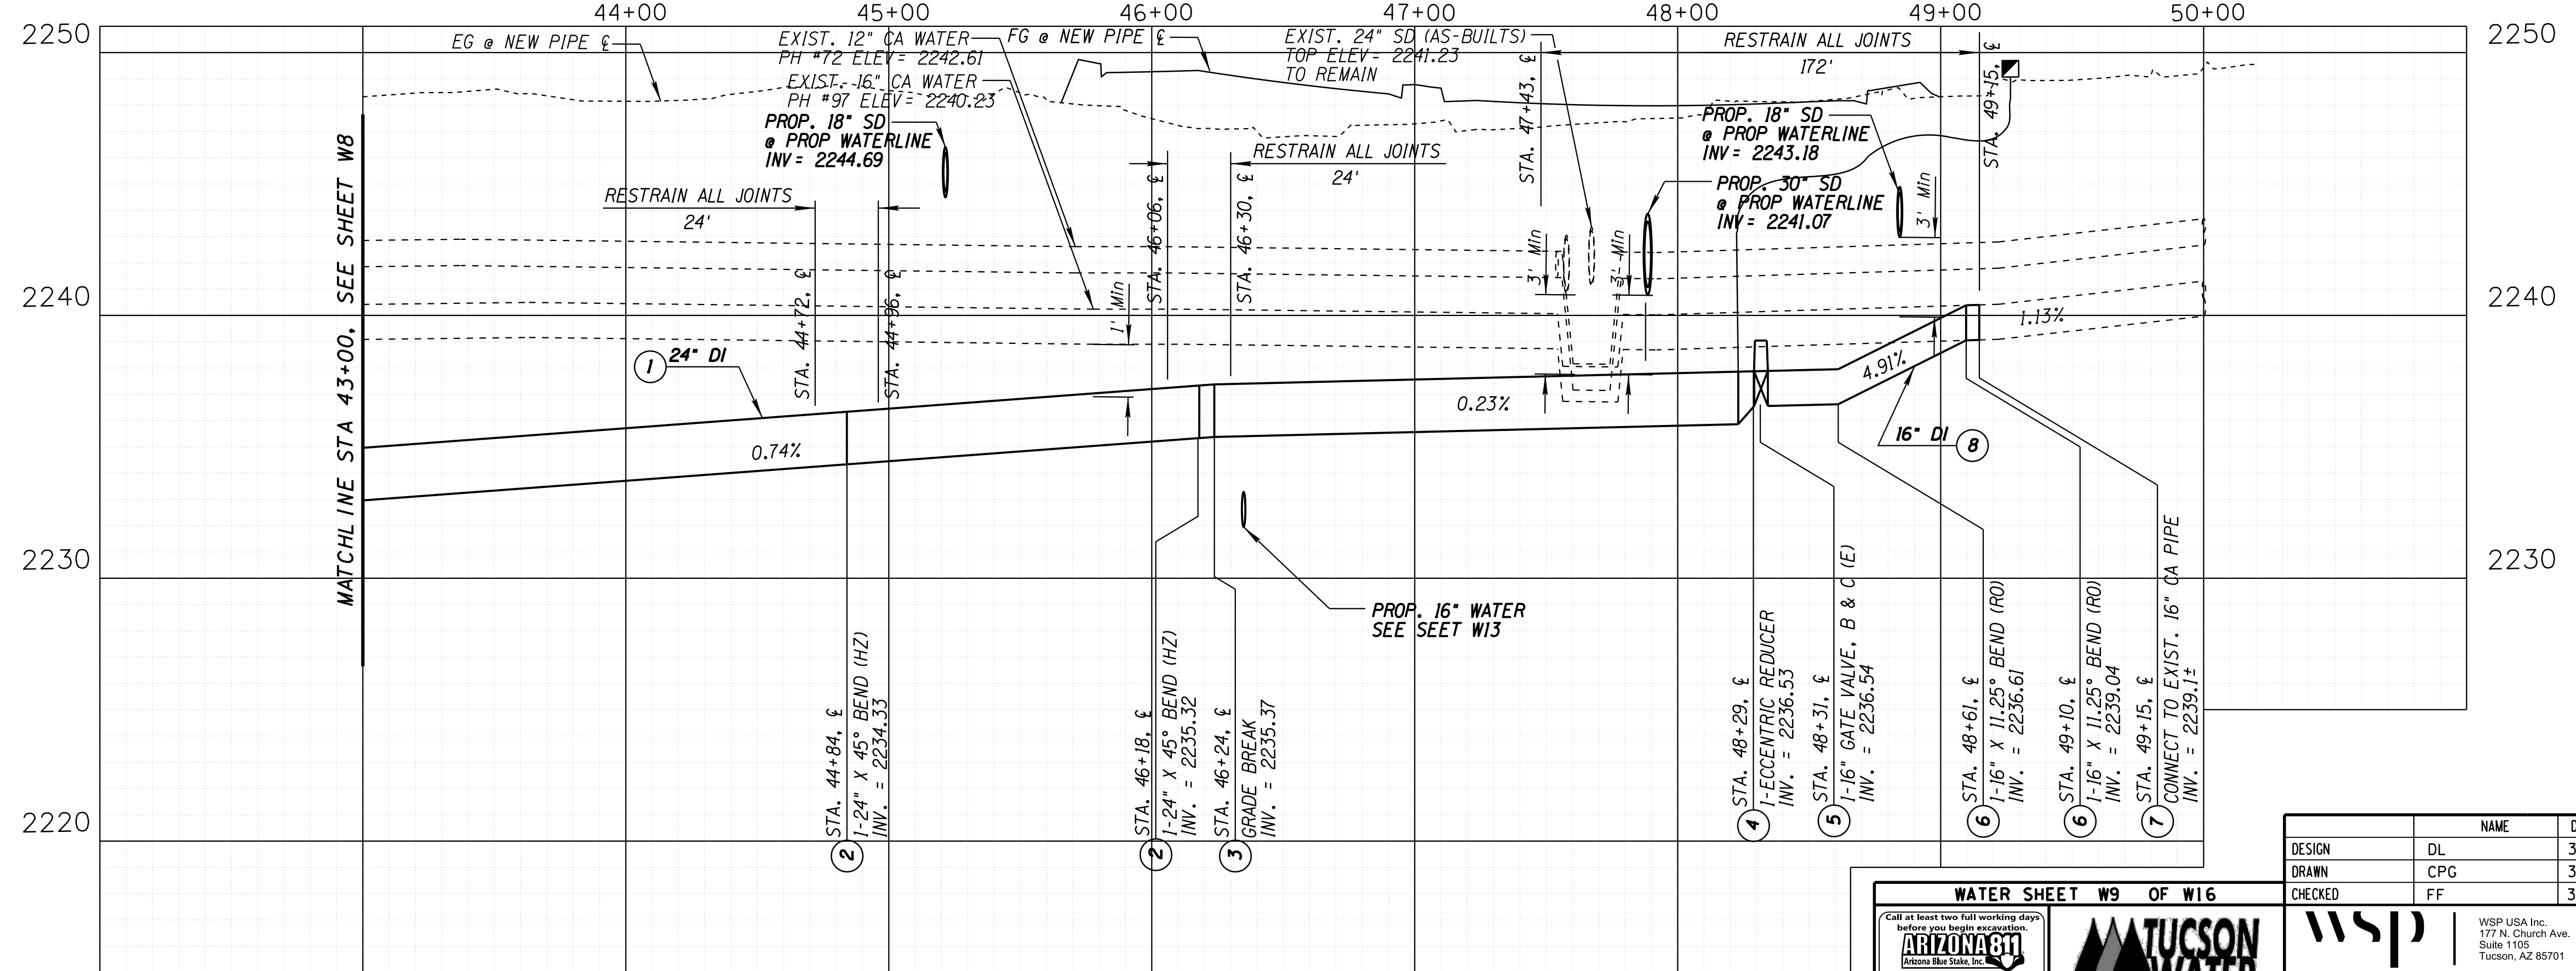

- REMOVE / ABANDON NOTES
- 1 RUTHRAUFF RD STA. 112+30, 100' LT. REMOVE BACKFLOW PREVENTION 1 EA
  - 2 RUTHRAUFF RD STA. 113+76, 80' LT. REMOVE BACKFLOW PREVENTION 1 EA
  - 3 RUTHRAUFF RD STA. 113+82, 47' LT. REMOVE FIRE HYDRANT INSTALLATION PER SD-500 1 EA
  - 4 RUTHRAUFF RD STA. 45+44, 67' RT. REMOVE BACKFLOW PREVENTION 1 EA
  - 5 RUTHRAUFF RD STA. 112+04, 49' RT. TO 116+20, 49' RT. REMOVE AND DISPOSE 16" CA PIPE 416 LF
  - 6 RUTHRAUFF RD STA. 116+20, 49' RT. TO 116+33, 49' RT. REMOVE AND DISPOSE 16" DI PIPE 13 LF
  - 7 RUTHRAUFF RD STA. 116+33, 49' RT. TO 117+79, 49' RT. REMOVE AND DISPOSE 16" CA PIPE 146 LF
  - 8 RUTHRAUFF RD STA. 112+04, 55' RT. TO 116+06, 56' RT. REMOVE AND DISPOSE 12" CA PIPE 402 LF
  - 9 RUTHRAUFF RD STA. 112+04, 55' LT. TO 115+07, 70' LT. REMOVE AND DISPOSE 8" CA PIPE 306 LF
  - 10 RUTHRAUFF RD STA. 115+07, 70' LT. TO 115+19, 70' LT. REMOVE AND DISPOSE 8" DI PIPE 12 LF
  - 11 RUTHRAUFF RD STA. 115+19, 70' LT. TO 116+35, 70' LT. REMOVE AND DISPOSE 8" CA PIPE 116 LF
  - 12 RUTHRAUFF RD STA. 116+78, 46' RT. REMOVE FIRE HYDRANT PER SD-500 1 EA

- CONSTRUCTION NOTES
- 1 STA. 43+00, TO STA. 48+29, 24" DI (CL 200) 529 LF
  - 2 STA. 44+84, STA. 46+18, 24" X 45" BEND (HZ) 2 EA(NPI)
  - 3 STA. 46+24, GRADE BREAK 1 EA(NPI)
  - 4 STA. 48+29, 24" TO 16" ECCENTRIC REDUCER 1 EA(NPI)
  - 5 STA. 48+31, 16" GATE VALVE, B&C (E) 1 EA
  - 6 STA. 48+61, STA. 49+10, 16" X 11.25" BEND (RO) 2 EA(NPI)
  - 7 STA. 49+15, CONNECT TO EXIST. 16" CA PIPE 1 EA(NPI)
  - 8 STA. 48+29, TO STA. 49+15, 16" DI (CL 200) 86 LF

- REFERENCE NOTES
- 1 TRANSMISSION WATER MAIN PLAN & PROFILE, SEE SHEET W13
  - 2 DISTRIBUTION WATER MAIN PLAN & PROFILE, SEE SHEET W14
  - 3 SANITARY SEWER PLAN & PROFILE, SEE SHEET SSB
- MONITORING AND PROTECTION
- 1 STA. 48+55, 17' RT. TYPE 5 ABOVE GROUND CTS PER DETAIL NO. CP-2 & TUCSON WATER STANDARD DETAIL SD-706. SEE ITEM NO. 9240176 IN THE SPECIAL PROVISIONS 1 EA

DESIGN	DL	DATE	3-19
DRAWN	CPG	DATE	3-19
CHECKED	FF	DATE	3-19

WATER SHEET W9 OF W16

Call at least two full working days before you begin excavation.

**ARIZONA 811**

1-800-STAKE-IT (782-5348)  
In Maricopa County: (602) 262-3100


**TUCSON WATER**

**WSP**

WSP USA Inc.  
177 N. Church Ave.  
Suite 1105  
Tucson, AZ 85701

ARIZONA DEPARTMENT OF TRANSPORTATION  
INFRASTRUCTURE DELIVERY AND OPERATIONS DIVISION  
ROADWAY DESIGN SERVICES

RUTHRAUFF ROAD  
WATER MODIFICATION PLANS  
TRANSMISSION PLAN & PROFILE

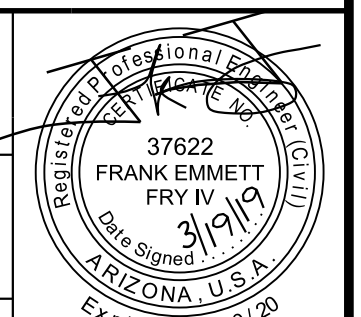

ROUTE	I-10	LOCATION	RUTHRAUFF ROAD TI
TRACS NO.	H 8480 OIC	PROJECT NO.	010-D(213)S
DWG NO.	U-2.09	DATE	OF

VERT: 1" = 4'  
HORIZ: 1" = 40'

NO.	DATE	REVISION	BY	CHKD.	APPR.



F.H.W.A. REGION	STATE	PROJECT NO.	SHEET NO.	TOTAL SHEETS	RECORD DRAWING
9	ARIZ.	010-D(213)S	824	849	

010 PM 252

REMOVE / ABANDON NOTES


- 1 SEE SHEET W11 FOR REMOVAL OF EXISTING PIPE
- 2 SEE SHEET W6 FOR REMOVAL OF EXISTING PIPE
- 3 STA. 97+25, 38' RT. TO 97+63, 37' RT. REMOVE AND DISPOSE 16" CA PIPE 38 LF
- 4 STA. 97+63, 37' RT. TO 103+24, 49' RT. REMOVE AND DISPOSE 16" DI PIPE 568 LF
- 5 STA. 97+93, 37' RT. TO 99+00, 20' RT. REMOVE AND DISPOSE 30" X 5/16" STEEL CASING PIPE 109 LF
- 6 STA. 102+29, 49' RT. TO 103+04, 48' RT. REMOVE AND DISPOSE 30" X 5/16" STEEL CASING PIPE 75 LF
- 7 STA. 103+24, 49' RT. TO 103+31, 49' RT. REMOVE AND DISPOSE 16" CA PIPE 7 LF
- 8 STA. 103+31, 49' RT. TO 105+75, 49' RT. ABANDON AND GROUT 16" CA PIPE AND 30" STEEL CASING PIPE IN UPRR R/W PER SD-350 AND UPRR PIPELINE CROSSING AGREEMENT, FOLDER 03133-65 244 LF
- 9 STA. 105+75, 49' RT. TO 106+00, 49' RT. REMOVE AND DISPOSE 16" CA PIPE 25 LF
- 10 STA. 103+85, 156' LT. TO 104+97, 52' RT. REMOVE AND DISPOSE 16" CA PIPE 192 LF
- 11 STA. 104+97, 52' RT. TO 105+77, 52' RT. ABANDON AND GROUT 16" CA PIPE IN UPRR R/W PER SD-350 AND UPRR PIPELINE CROSSING AGREEMENT, FOLDER 03133-65 108 LF
- 12 STA. 105+77, 52' RT. TO 106+00, 52' RT. REMOVE AND DISPOSE 16" CA PIPE 23 LF
- 13 STA. 104+79, 109' LT. REMOVE BACKFLOW PREVENTION 1 EA

REFERENCE NOTES

- 1 TRANSMISSION WATER MAIN PLAN & PROFILE, SEE SHEET W6
- 2 TRANSMISSION WATER MAIN PLAN & PROFILE, SEE SHEET W7

SERVICE WORK

#	ADDRESS/STA	EXST. SERV.	SERV. WORK	EXIST. CONNECTION DIA. - MATL.	NEW CONNECTION DIA. - MATL.
1	2840 W. RUTHRAUFF RD	M ( )	57		

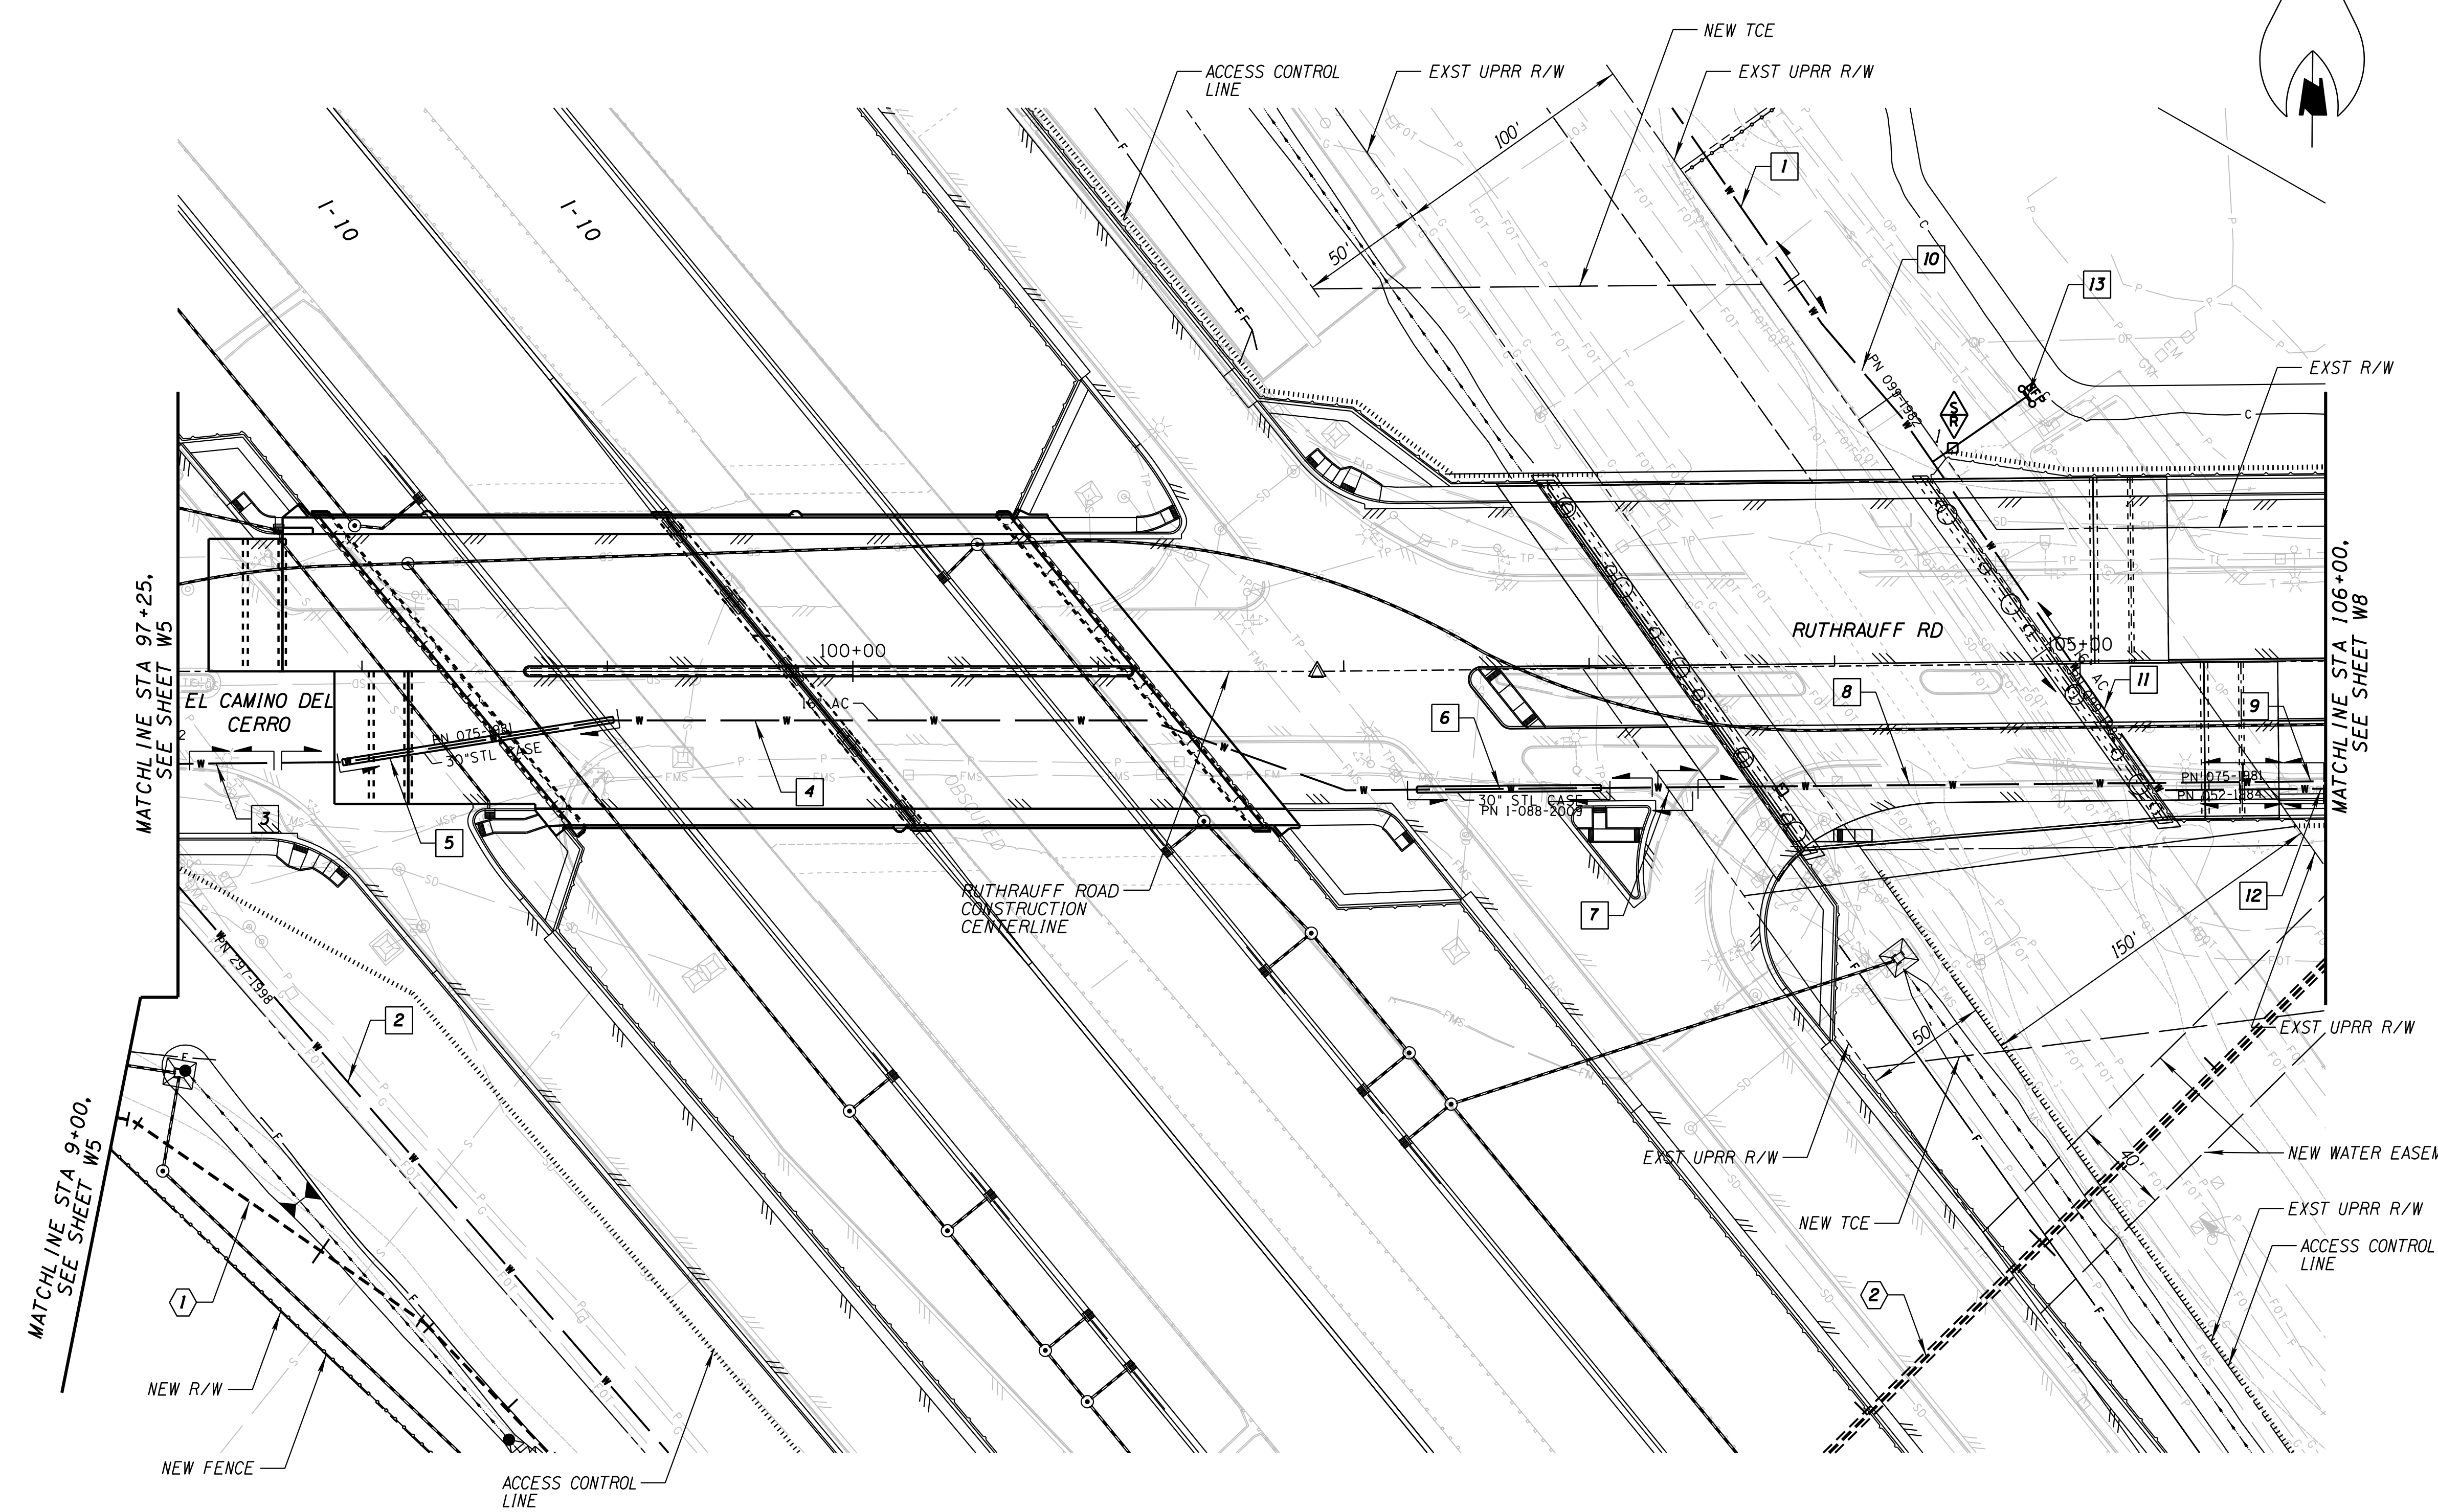

NOTE:  
ALL STATIONING IS ALONG THE RUTHRAUFF ROAD CONSTRUCTION CENTERLINE UNLESS OTHERWISE NOTED.

WATER SHEET W10 OF W16

ARIZONA 811  
Call at least two full working days before you begin excavation.  
Arizona Blue State, Inc.  
In Maricopa County: (602) 263-3100

TUCSON WATER

DESIGN	NAME	DATE
DL		3-19
CPG		3-19
FF		3-19

ARIZONA DEPARTMENT OF TRANSPORTATION  
INFRASTRUCTURE DELIVERY AND OPERATIONS DIVISION  
ROADWAY DESIGN SERVICES

RUTHRAUFF ROAD  
WATER MODIFICATION PLANS  
REMOVAL

Professional Engineer  
37622  
FRANK EMMETT  
FRV IV - C  
3/19  
Expire 08/30/20  
ARIZONA U.S.

VERT: 1" = 4'  
HORZ: 1" = 40'


NO.	DATE	REVISION	BY	CHKD.	APPR.

ROUTE	LOCATION	DWG NO.
I-10	RUTHRAUFF ROAD TI	U-2.10
TRACS NO.	H 8480 OIC	010-D(213)S
		OF



F.H.W.A. REGION	STATE	PROJECT NO.	SHEET NO.	TOTAL SHEETS	RECORD DRAWING
9	ARIZ.	010-D(213)S	825	849	


010 PM 252

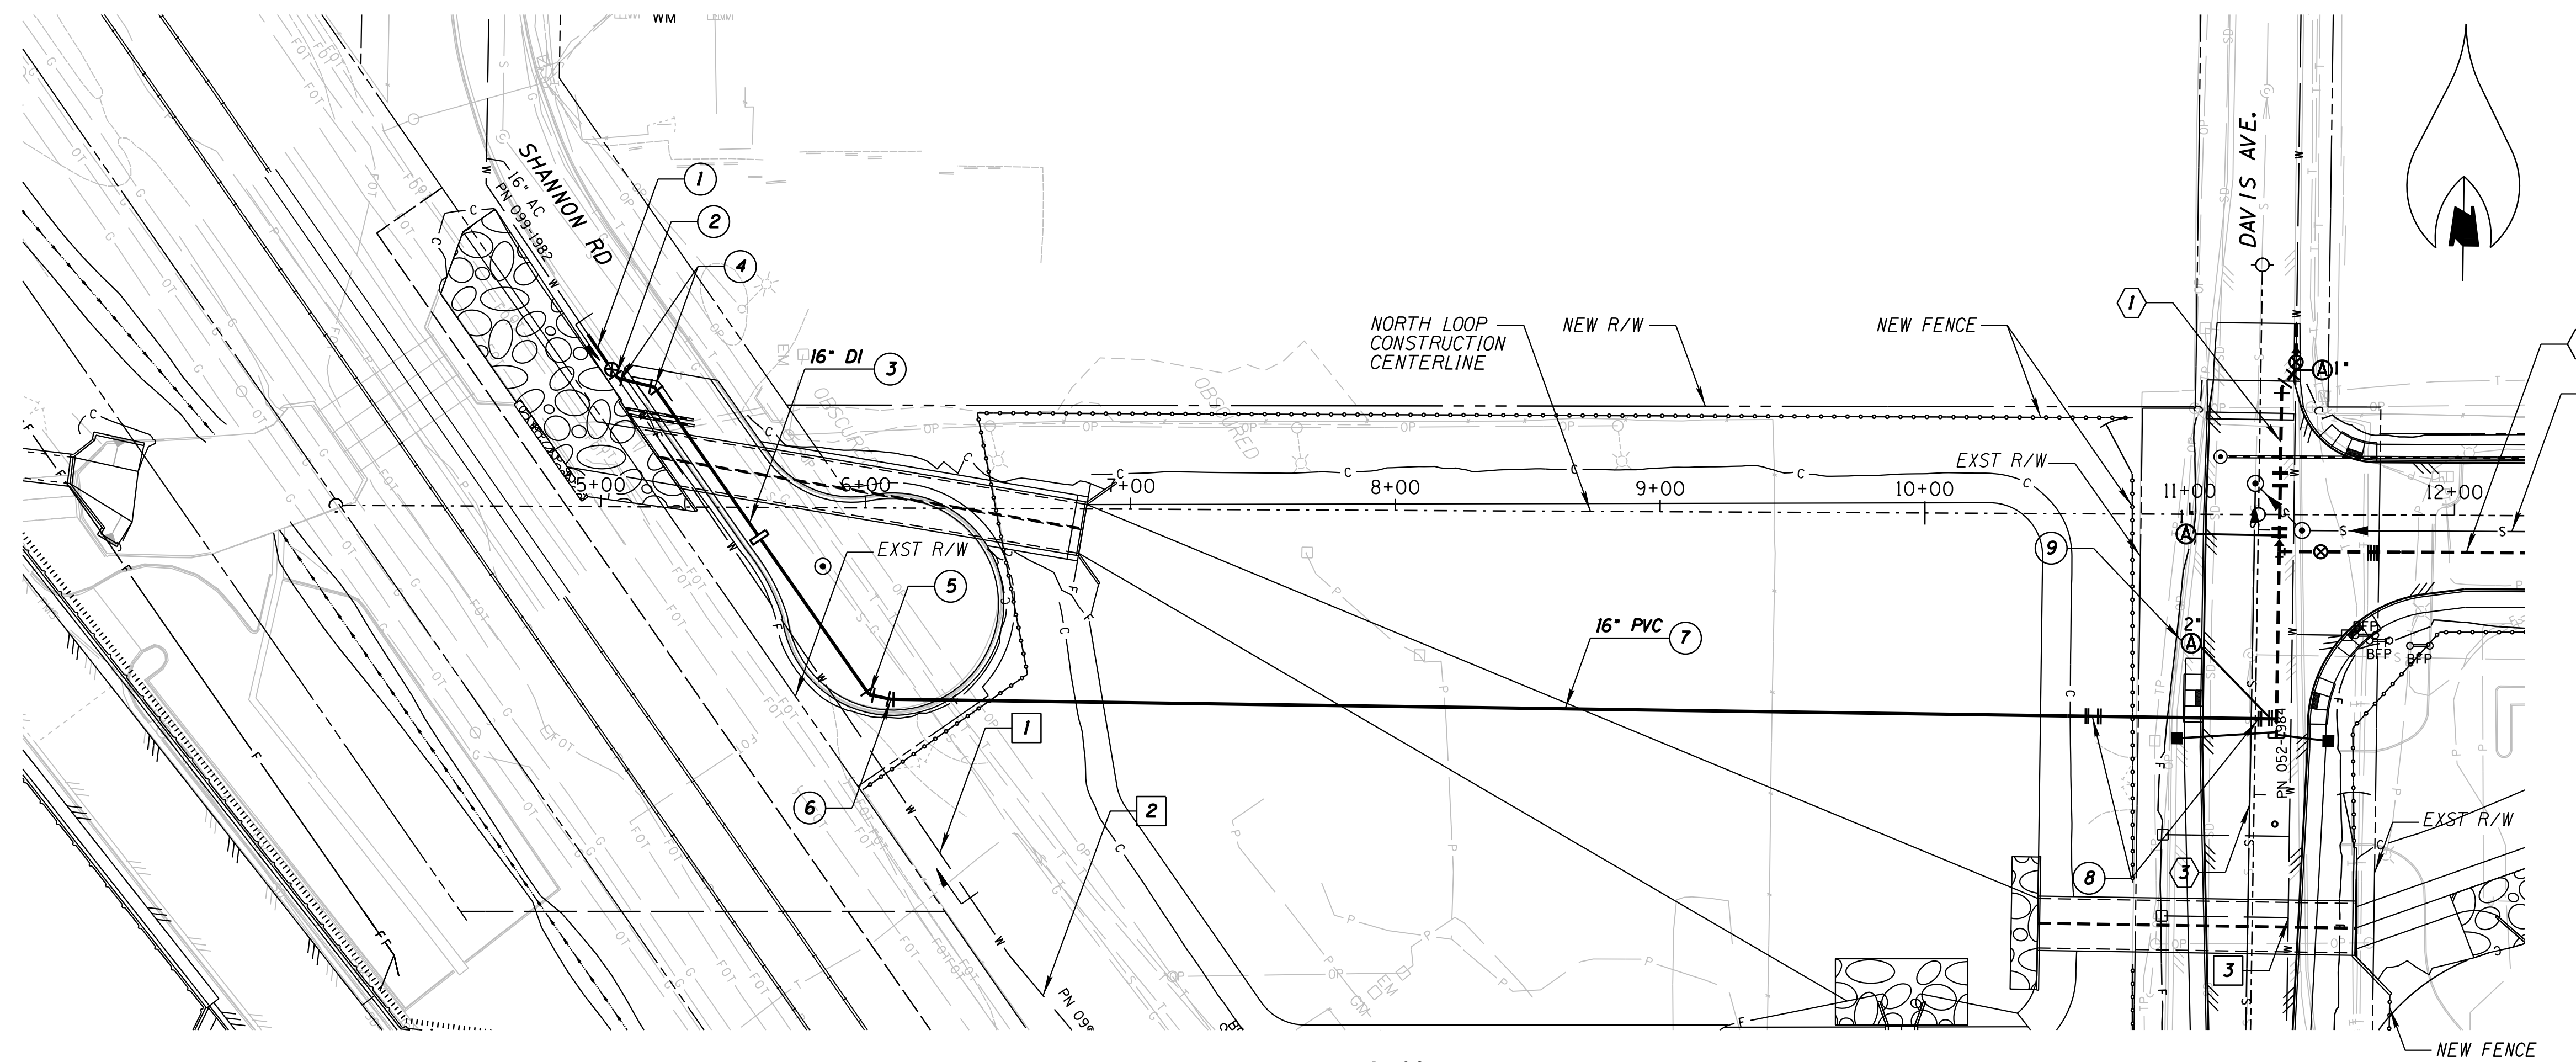

- REMOVE / ABANDON NOTES
- 1 STA. 4+98, 60' LT. TO 6+44, 152' RT. REMOVE AND DISPOSE 16" CA PIPE 257 LF
  - 2 SEE SHEET W10 FOR REMOVAL OF EXISTING PIPE
  - 3 SEE SHEET W14 FOR REMOVAL OF EXISTING PIPE

- CONSTRUCTION NOTES
- 1 STA. 4+95, 65' LT. CONNECT TO EXST. 16" CA PIPE 1 EA (NPI)
  - 2 STA. 5+04, 52' LT. 16" GATE VALVE, B&C (E) 1 EA  
W/ THRUST BLOCK PER SD-610(MODIFY) 1 EA  
SEE TABLE, SHEET W5
  - 3 STA. 4+95, 65' LT. TO STA. 5+61, 12' RT. 16" DI (CL 200) 105 LF
  - 4 STA. 5+06, 48' LT. TO STA. 5+20, 45' LT. 16" X 45° BEND (RO) 2 EA (NPI)
  - 5 STA. 6+02, 71' RT. 16" X 45° BEND (HZ) 1 EA (NPI)
  - 6 STA. 6+10, 72' RT. 16" X 11.25° BEND (HZ) 1 EA (NPI)
  - 7 STA. 5+61, 12' RT. TO STA. 11+33, 77' RT. 16" PVC DR18 (CL 235) 616 LF
  - 8 STA. 10+62, 77' RT. STA. 10+66, 77' RT. STA. 11+27, 77' RT. STA. 11+31, 77' RT. 16" X 45° BEND (VT) 4 EA (NPI)
  - 9 STA. 11+04, 50' RT. (LOCATION OF ARV) 2" ARV PER SD-331 1 EA


- REFERENCE NOTES
- 1 DISTRIBUTION WATER MAIN PLAN & PROFILE, SEE SHEET W14
  - 2 TRANSMISSION WATER MAIN PLAN & PROFILE, SEE SHEET W12
  - 3 SANITARY SEWER PLAN & PROFILE, SEE SHEET SS6
  - 4 SANITARY SEWER PLAN & PROFILE, SEE SHEET SS7

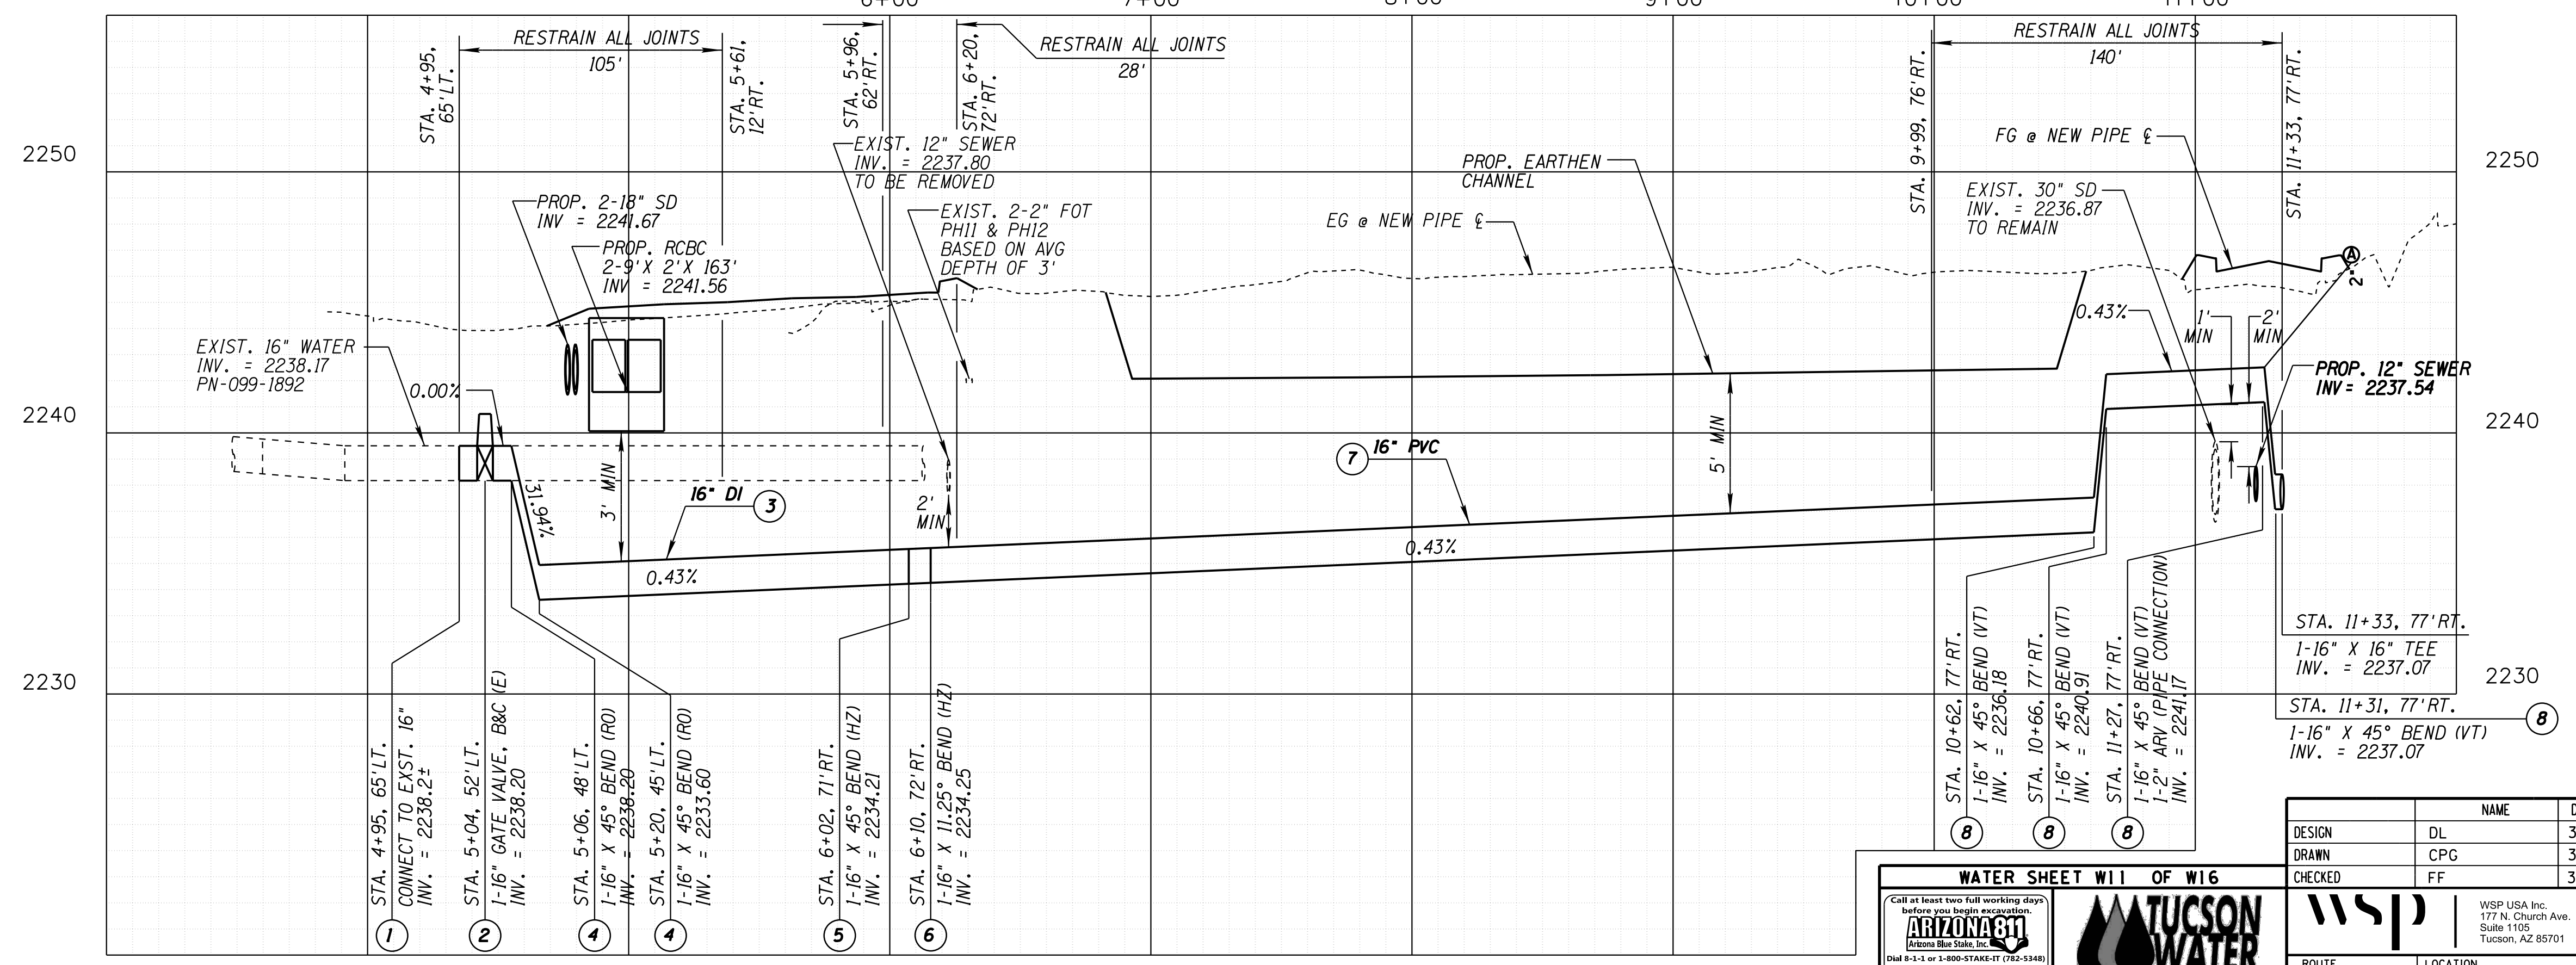

NAME	DATE
DESIGN DL	3-19
DRAWN CPG	3-19
CHECKED FF	3-19

ARIZONA DEPARTMENT OF TRANSPORTATION  
INFRASTRUCTURE DELIVERY AND OPERATIONS DIVISION  
ROADWAY DESIGN SERVICES

RUTHRAUFF ROAD  
WATER MODIFICATION PLANS  
DISTRIBUTION PLAN AND PROFILE

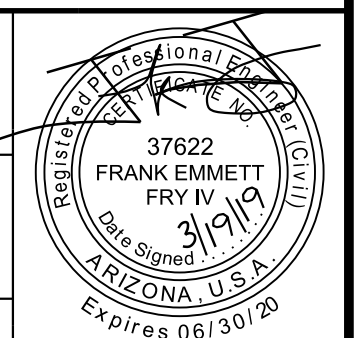

WSP USA INC.  
177 N. Church Ave.  
Suite 1105  
Tucson, AZ 85701

ROUTE 1-10 LOCATION RUTHRAUFF ROAD TI  
DWG NO. U-2.11

VERT: 1" = 4'  
HORZ: 1" = 40'

NO.	DATE	REVISION	BY	CHKD.	APPR.

TRACS NO. H 8480 OIC

010-D(213)S OF



F.H.W.A. REGION	STATE	PROJECT NO.	SHEET NO.	TOTAL SHEETS	RECORD DRAWING
9	ARIZ.	010-D(213)S	826	849	

010 PM 252

REMOVE / ABANDON NOTES



1 SEE SHEET W14 FOR REMOVAL OF EXISTING PIPES AND SERVICE WORK

CONSTRUCTION NOTES

- 1 STA. 11+50, 14' RT., 16" GATE VALVE B & C (E) 1 EA
- 2 STA. 11+68, 14' RT., STA. 11+70, 14' RT., 16" X 45° BEND (VT) 2 EA (NPI)
- 3 STA. 11+34, 14' RT. TO STA. 17+45, 31' RT., 16" PVC DR18 (CL 235) 596 LF
- 4 STA. 16+45, 11' RT., 16" X 45° BEND (HZ) 1 EA (NPI)
- 5 STA. 17+22, 32' RT., 16" X 8" TEE 1 EA (NPI)

REFERENCE NOTES

- 1 TRANSMISSION WATER MAIN PLAN & PROFILE, SEE SHEET W11
- 2 DISTRIBUTION WATER MAIN PLAN & PROFILE, SEE SHEET W14
- 3 SANITARY SEWER PLAN & PROFILE, SEE SHEET SS7
- 4 DISTRIBUTION PLAN AND PROFILE, SEE SHEET W15
- 5 SANITARY SEWER PLAN & PROFILE, SEE SHEET SS6

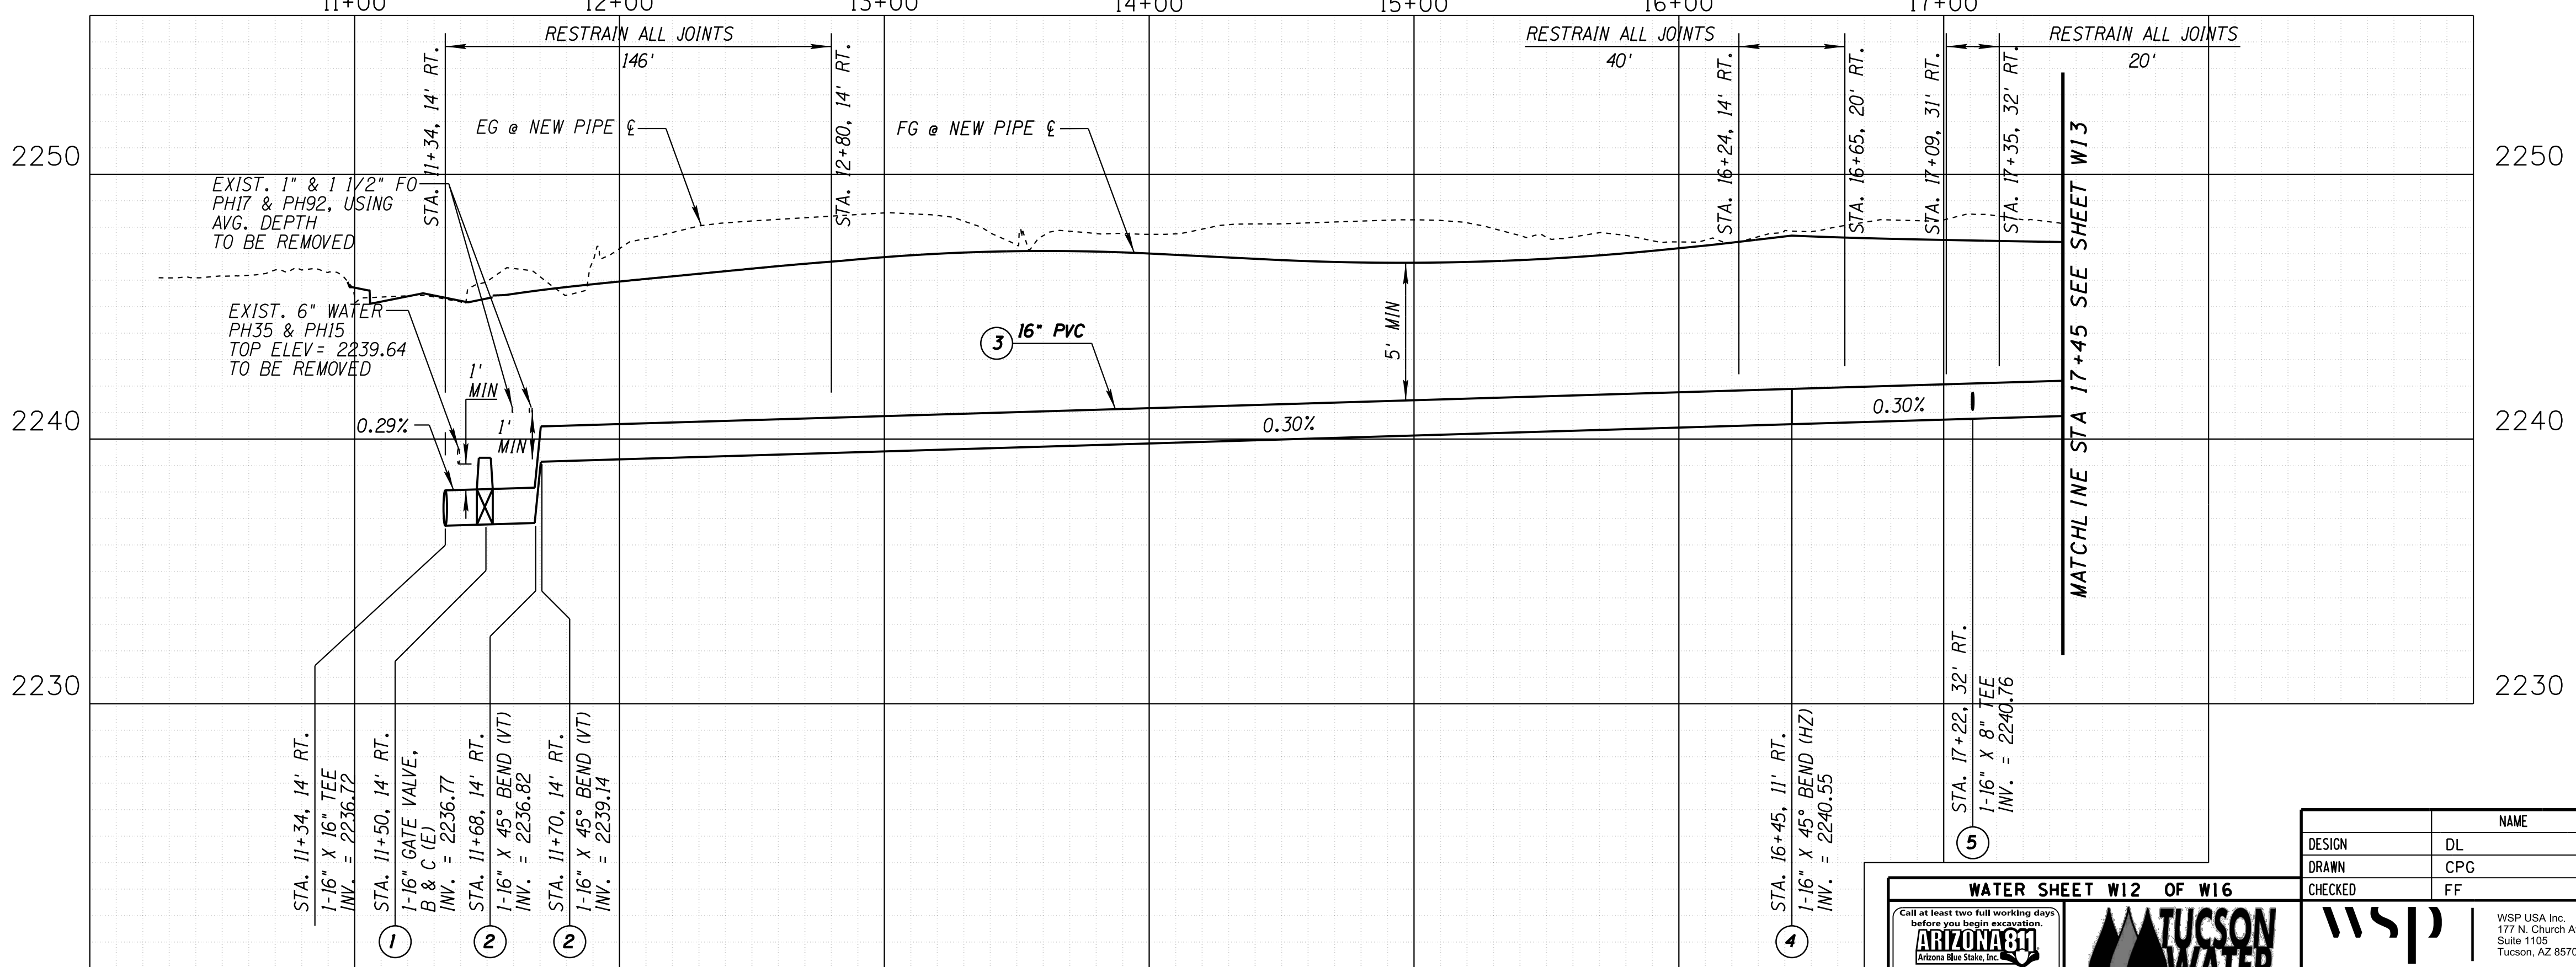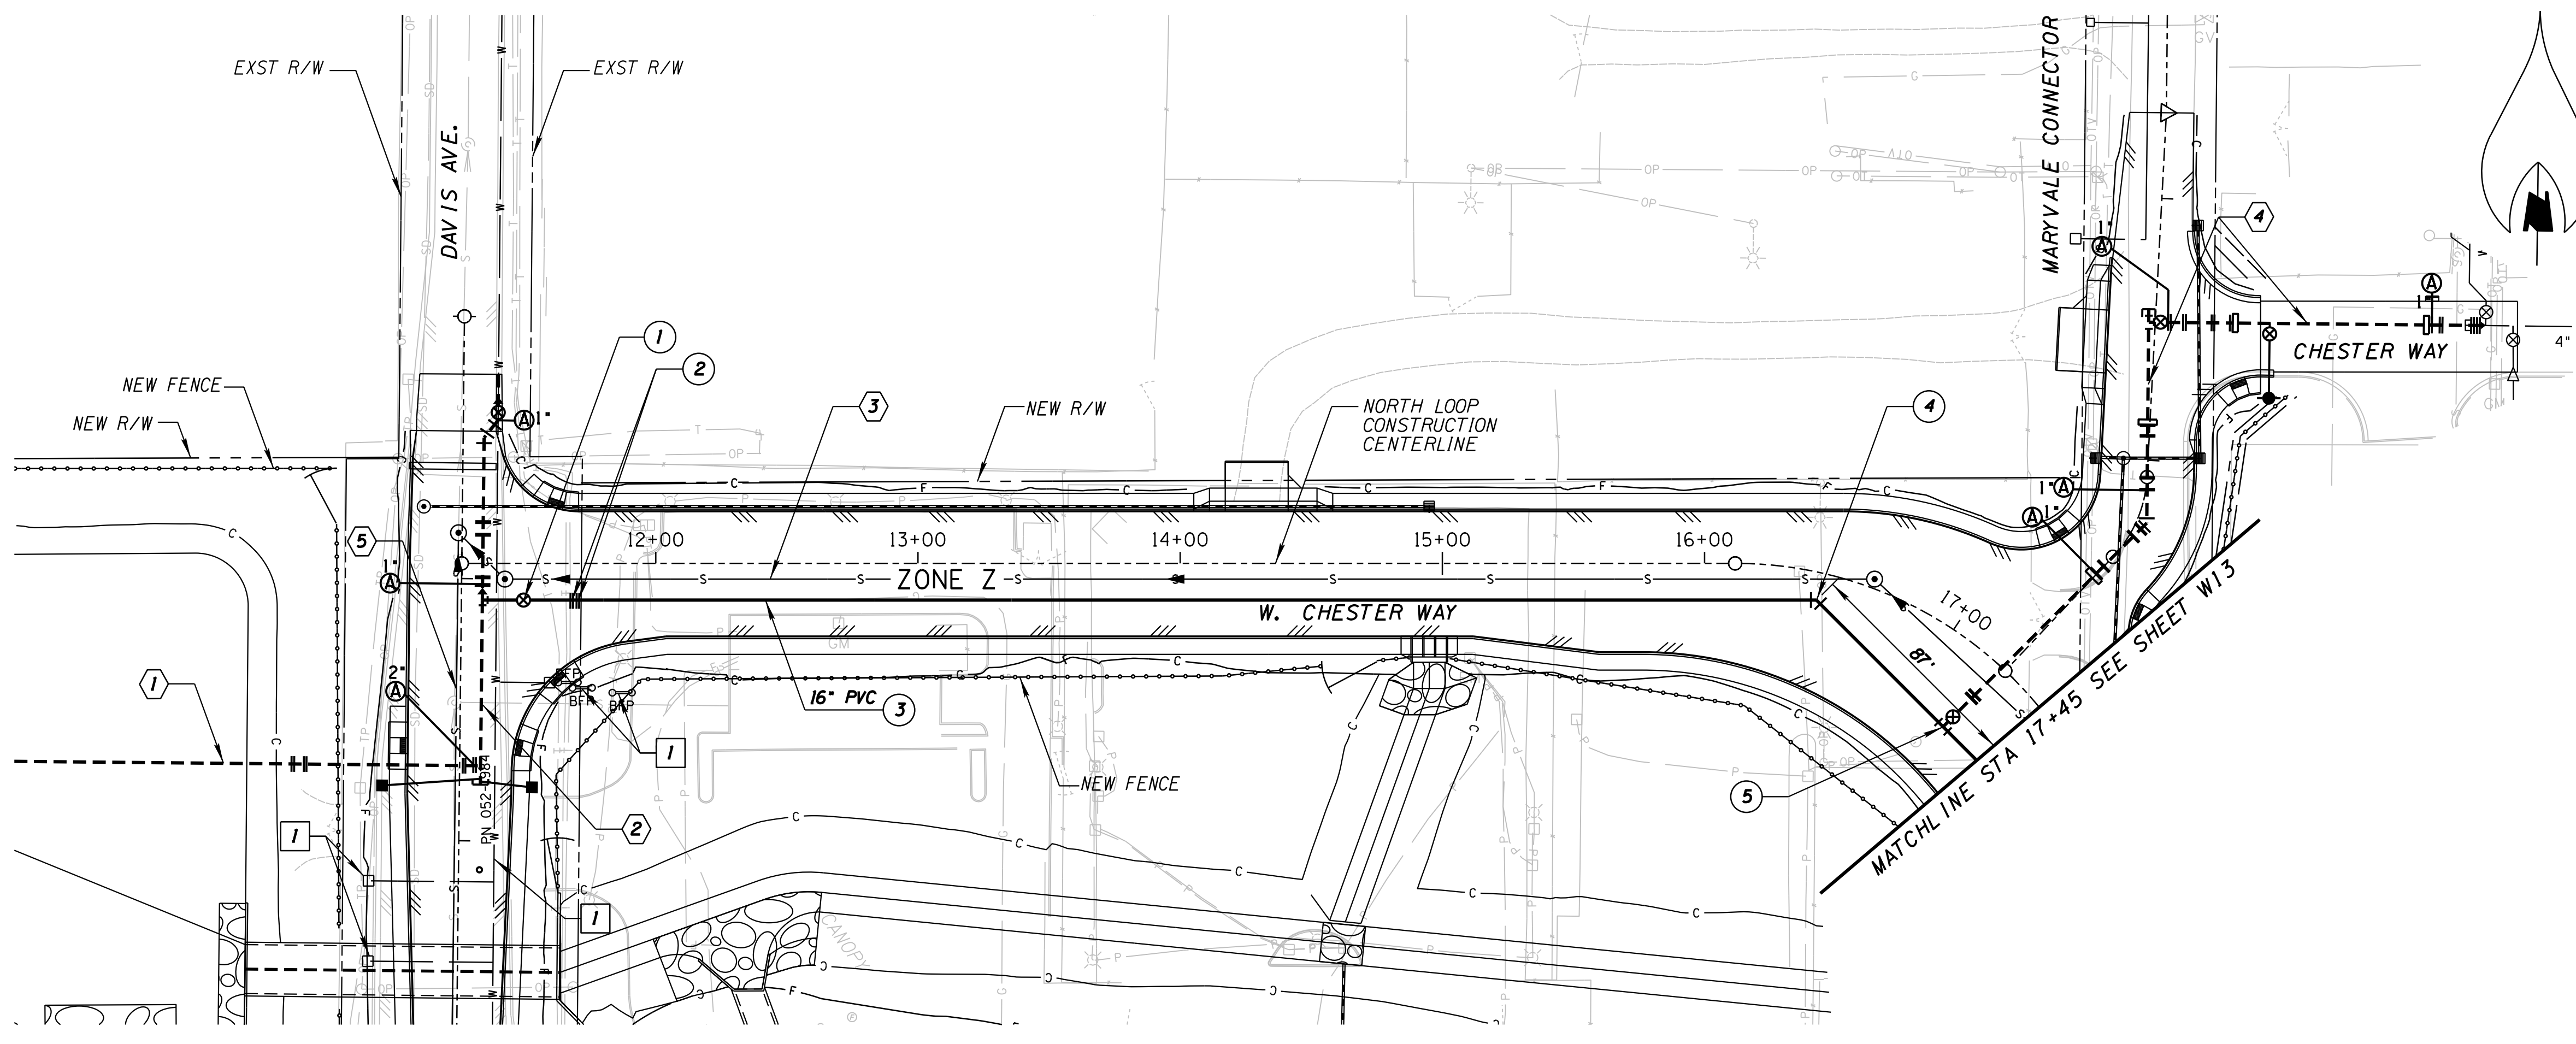


DESIGN	DL	DATE	3-19
DRAWN	CPG	DATE	3-19
CHECKED	FF	DATE	3-19

**ARIZONA 811**  
Call at least two full working days before you begin excavation.  
177 N. Church Ave., Suite 1105, Tucson, AZ 85701  
Dial 8-1-1 or 1-800-STAKE-IT (782-5348) in Maricopa County (520) 243-3100

**TUCSON WATER**

ARIZONA DEPARTMENT OF TRANSPORTATION  
INFRASTRUCTURE DELIVERY AND OPERATIONS DIVISION  
ROADWAY DESIGN SERVICES

**RUTHRAUFF ROAD**  
WATER MODIFICATION PLANS  
DISTRIBUTION PLAN AND PROFILE

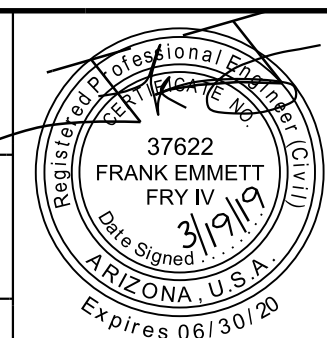

ROUTE: I-10  
LOCATION: RUTHRAUFF ROAD TI  
TRACS NO. H 8480 OIC


DWG NO. U-2.12  
010-D(213)S  
OF

VERT: 1" = 4'  
HORZ: 1" = 40'

NO.	DATE	REVISION	BY	CHKD.	APPR.

F.H.W.A. REGION	STATE	PROJECT NO.	SHEET NO.	TOTAL SHEETS	RECORD DRAWING
9	ARIZ.	010-D(213)S	827	849	

010 PM 252

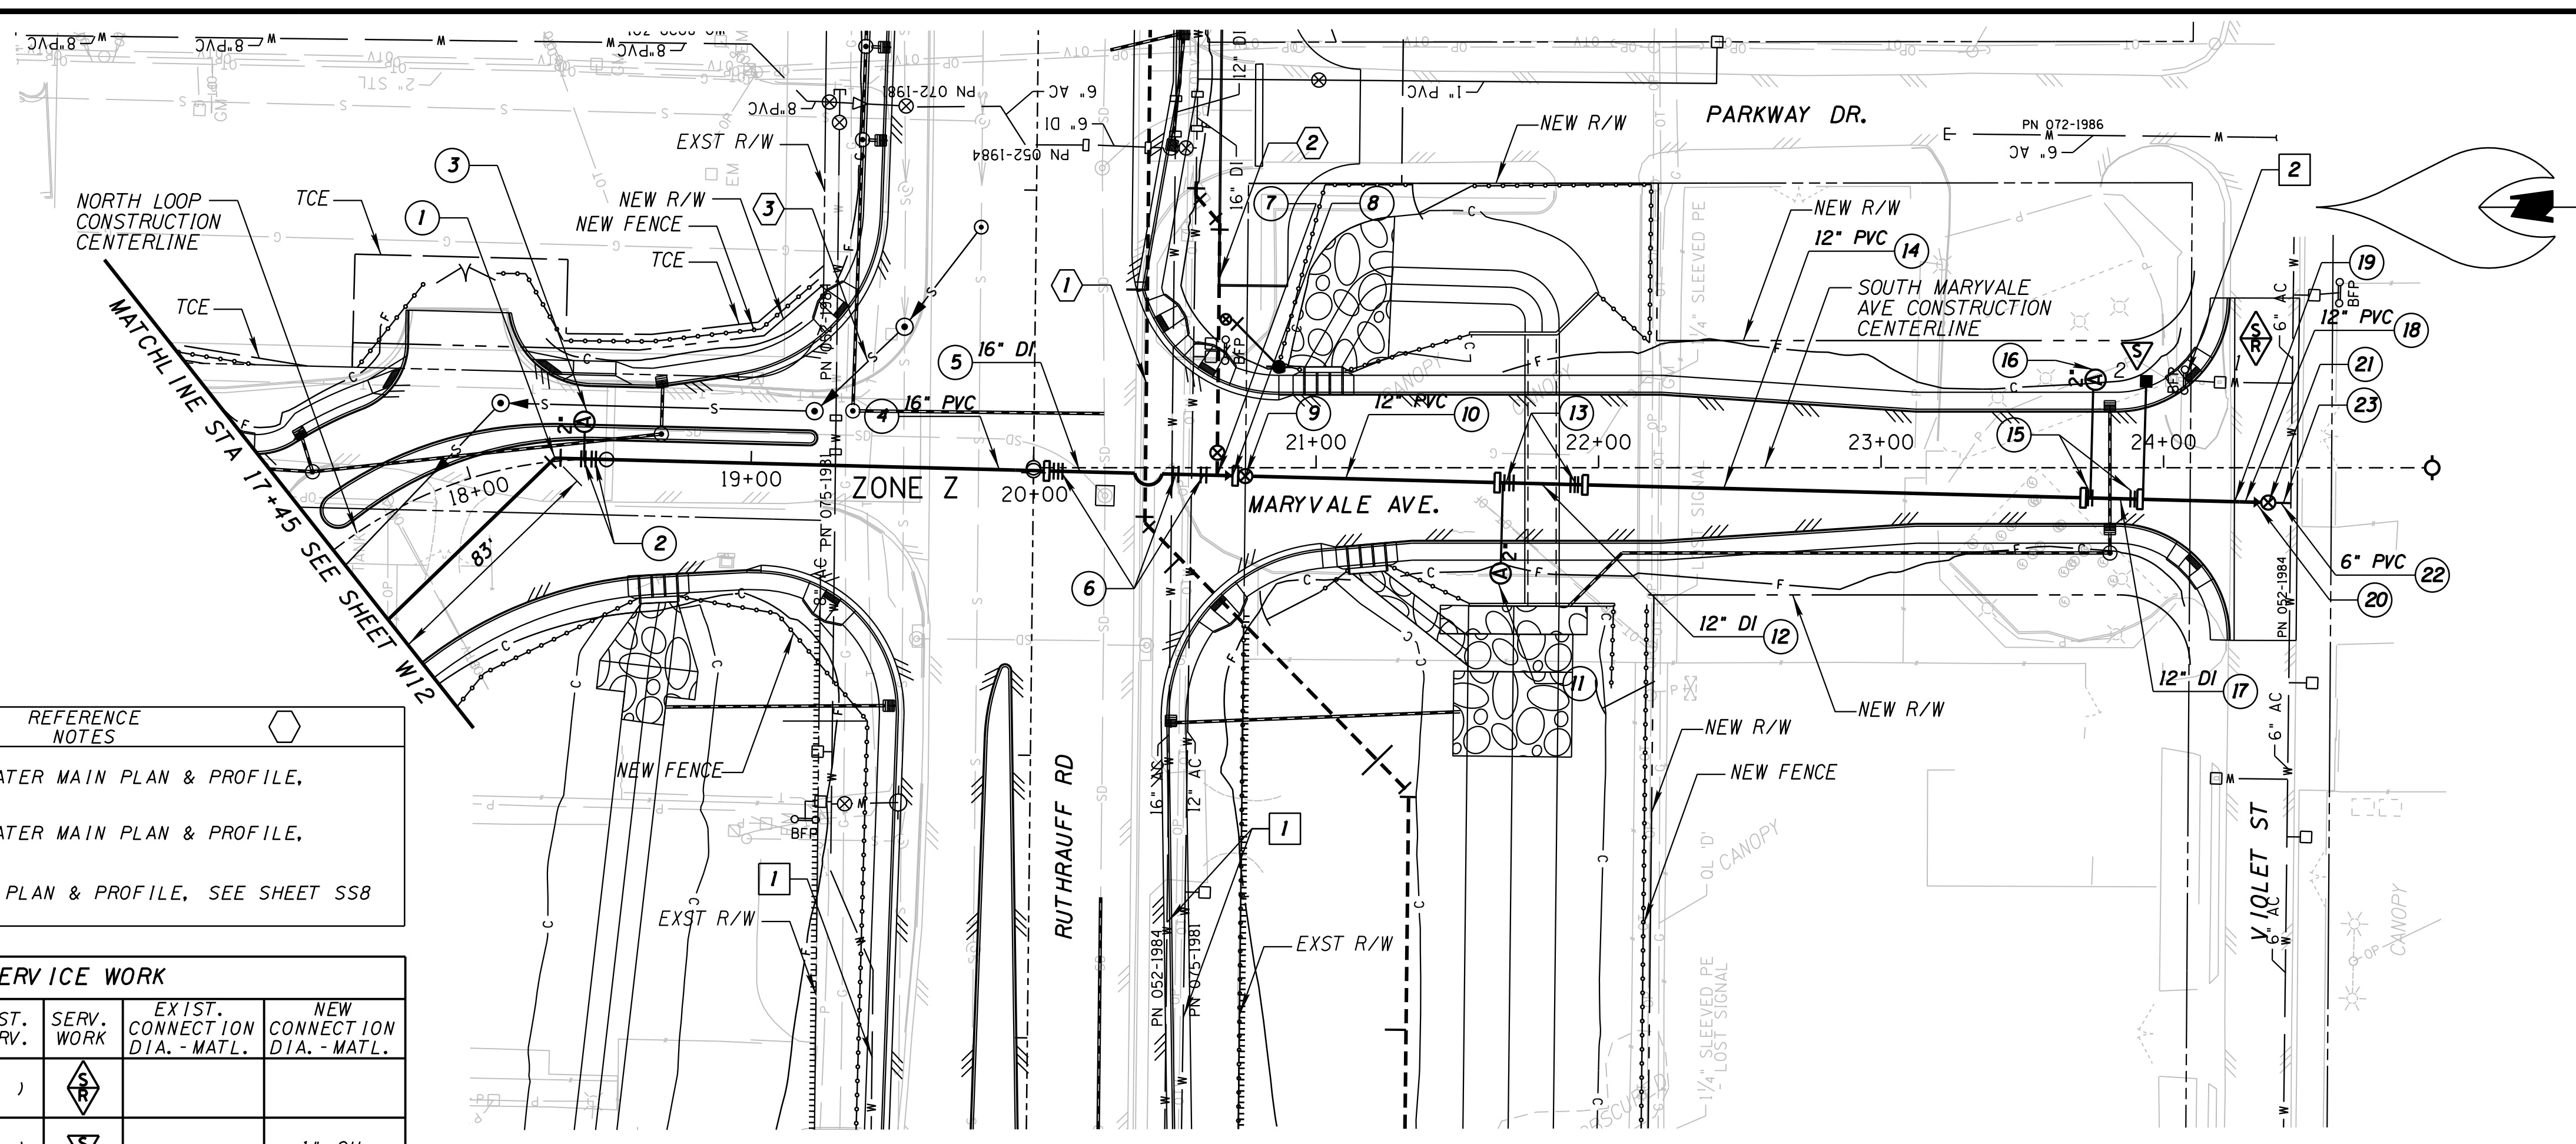

REFERENCE NOTES

- TRANSMISSION WATER MAIN PLAN & PROFILE, SEE SHEET W9
- DISTRIBUTION WATER MAIN PLAN & PROFILE, SEE SHEET W14
- SANITARY SEWER PLAN & PROFILE, SEE SHEET SS8

SERVICE WORK


#	ADDRESS/STA	EXST. SERV.	SERV. WORK	EXIST. CONNECTION D.I.A. - MATL.	NEW CONNECTION D.I.A. - MATL.
1	4703 N. PARKWAY DR	M ( )	SR		
2	4703 N. PARKWAY DR	M ( )	S		1\"/>

REMOVE / ABANDON NOTES

- SEE SHEET W9 FOR REMOVAL OF EXISTING PIPE
- SOUTH MARYVALE AVE CST @ STA 24+08, 31' LT. REMOVE BACKFLOW PREVENTION 1 EA

CONSTRUCTION NOTES

- STA. 18+30, 1' LT., 16\"/>
- STA. 18+41, 0' LT., STA. 18+44, 0' LT., 16\"/>
- STA. 18+41, 13' LT., (LOCATION OF ARV) 2\"/>
- STA. 17+45, 31' RT. TO STA. 20+06, 1' RT., 16\"/>
- STA. 20+06, 1' RT. TO STA. 20+73, 3' RT., 16\"/>
- STA. 20+06, 1' RT., STA. 20+09, 1' RT., STA. 20+50, 2' RT., STA. 20+60, 3' RT., 16\"/>
- STA. 20+65, 3' RT., 16\"/>
- STA. 20+72, 3' RT., 16\"/>
- STA. 20+75, 3' RT., 12\"/>
- STA. 20+72, 3' RT. TO STA. 21+66, 5' RT., 12\"/>
- STA. 21+65, 37' RT., (LOCATION OF ARV) 2\"/>
- STA. 21+66, 5' RT. TO STA. 21+93, 6' RT., 12\"/>
- STA. 21+66, 5' RT., STA. 21+69, 5' RT., STA. 21+91, 6' RT., STA. 21+93, 6' RT., 12\"/>
- STA. 21+93, 6' RT. TO STA. 23+74, 11' RT., 12\"/>
- STA. 23+74, 11' RT., STA. 23+75, 11' RT., STA. 23+87, 11' RT., STA. 23+89, 11' RT., 12\"/>
- STA. 23+76, 31' RT., (LOCATION OF ARV) 2\"/>
- STA. 23+74, 11' RT. TO STA. 23+89, 11' RT., 12\"/>
- STA. 23+89, 11' RT. TO STA. 24+39, 12' RT., 12\"/>
- STA. 24+26, 12' RT., GRADE BREAK
- STA. 24+39, 12' RT., 12\"/>
- STA. 24+42, 12' RT., 6\"/>
- STA. 24+39, 12' RT. TO STA. 24+45, 13' RT., 6\"/>
- STA. 24+45, 13' RT., CONNECT TO EXST. 6\"/>

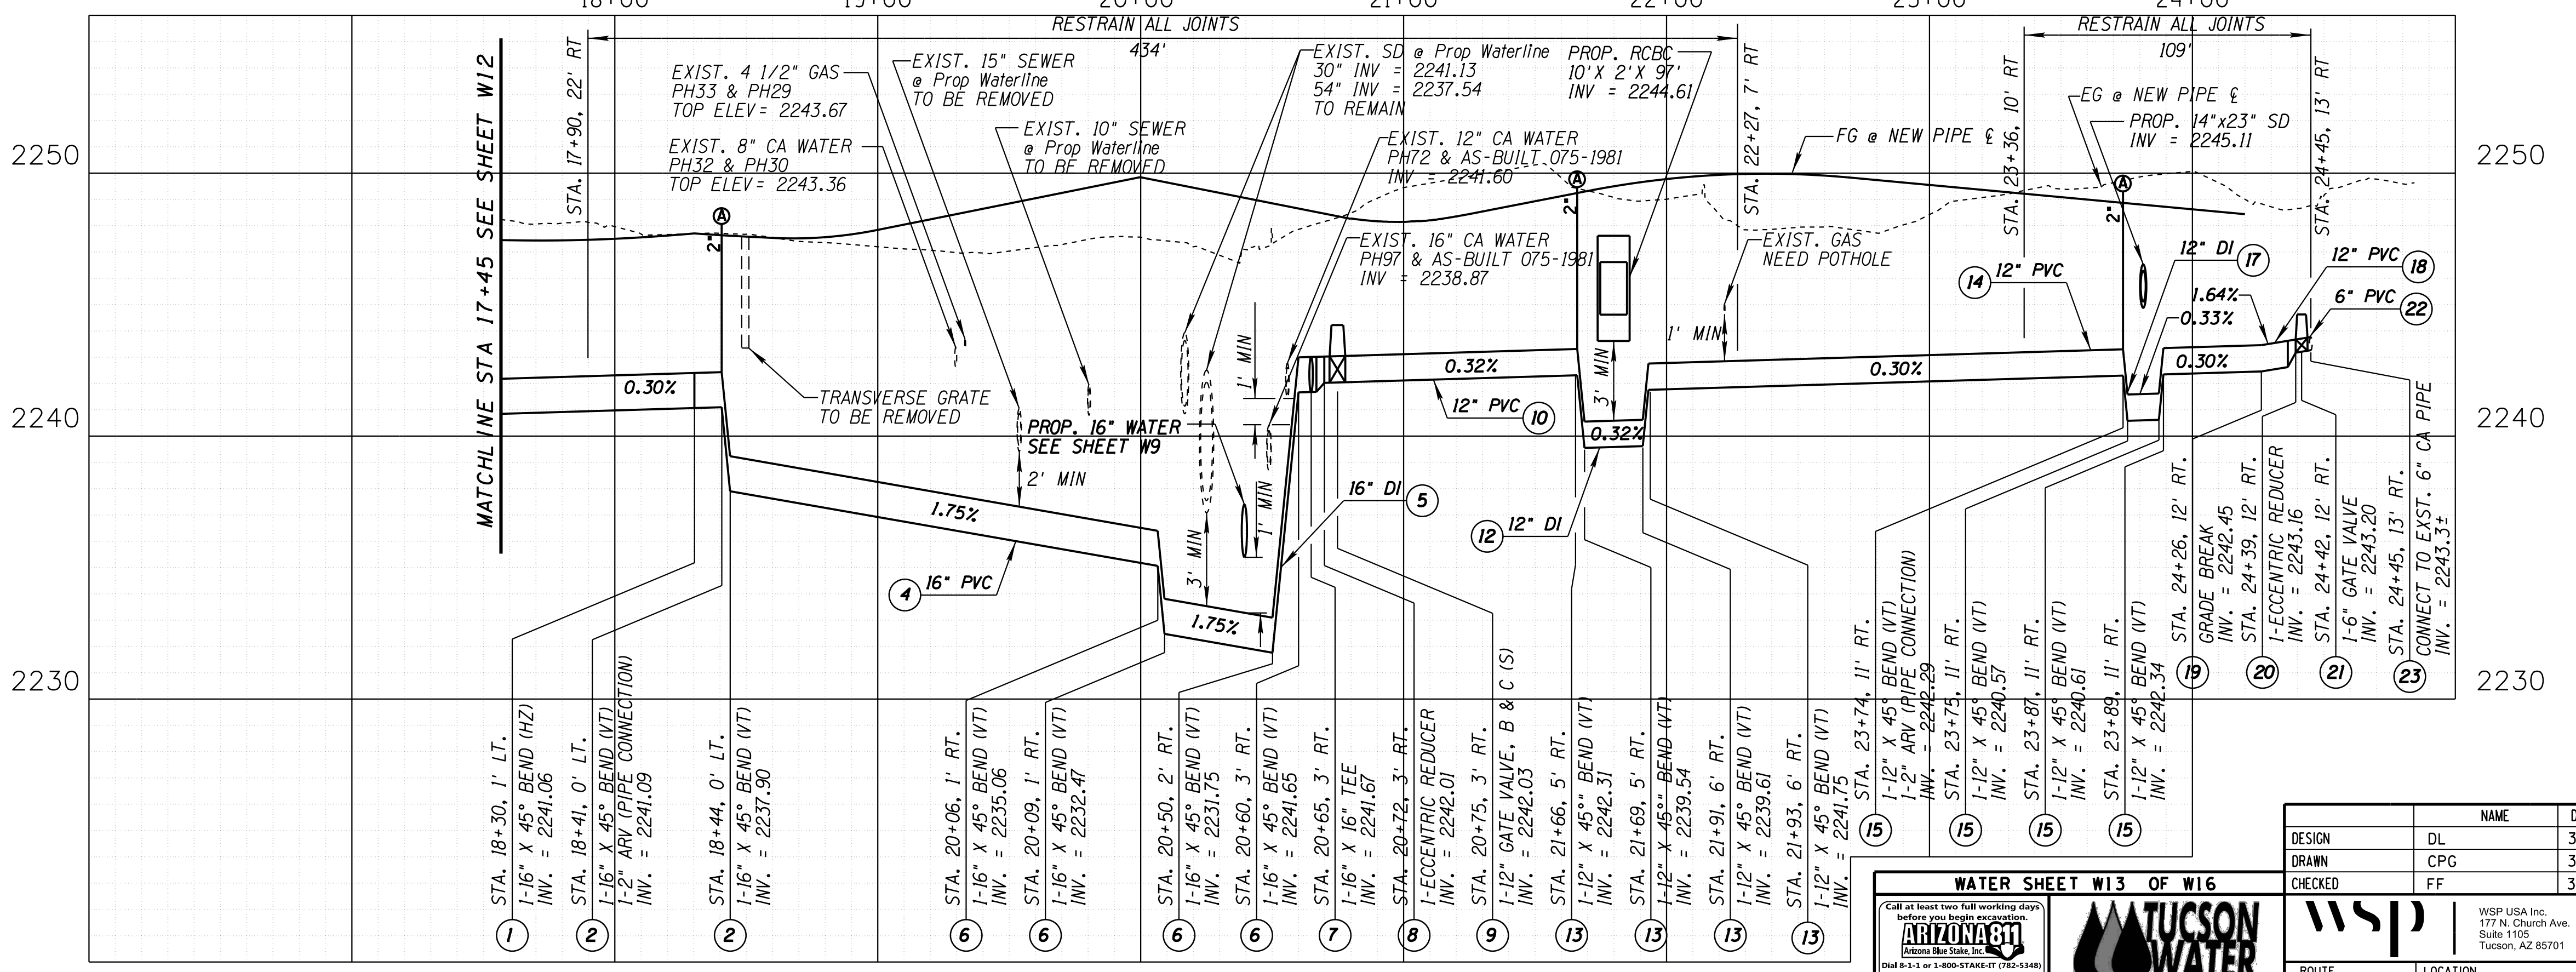

DESIGN	DL	DATE	3-19
DRAWN	CPG		3-19
CHECKED	FF		3-19

WATER SHEET W13 OF W16

Call at least two full working days before you begin excavation.

**ARIZONA 811**

**TUCSON WATER**

WSP USA Inc.  
177 N. Church Ave.  
Suite 1105  
Tucson, AZ 85701

ARIZONA DEPARTMENT OF TRANSPORTATION  
INFRASTRUCTURE DELIVERY AND OPERATIONS DIVISION  
ROADWAY DESIGN SERVICES

RUTHRAUFF ROAD  
WATER MODIFICATION PLANS  
DISTRIBUTION PLAN & PROFILE

ROUTE: I-10 LOCATION: RUTHRAUFF ROAD TI

TRACS NO. H 8480 OIC

010-D(213)S


DWG NO. U-2.13

OF




F.H.W.A. REGION	STATE	PROJECT NO.	SHEET NO.	TOTAL SHEETS	RECORD DRAWING
9	ARIZ.	010-D(213)S	828	849	


010 PM 252

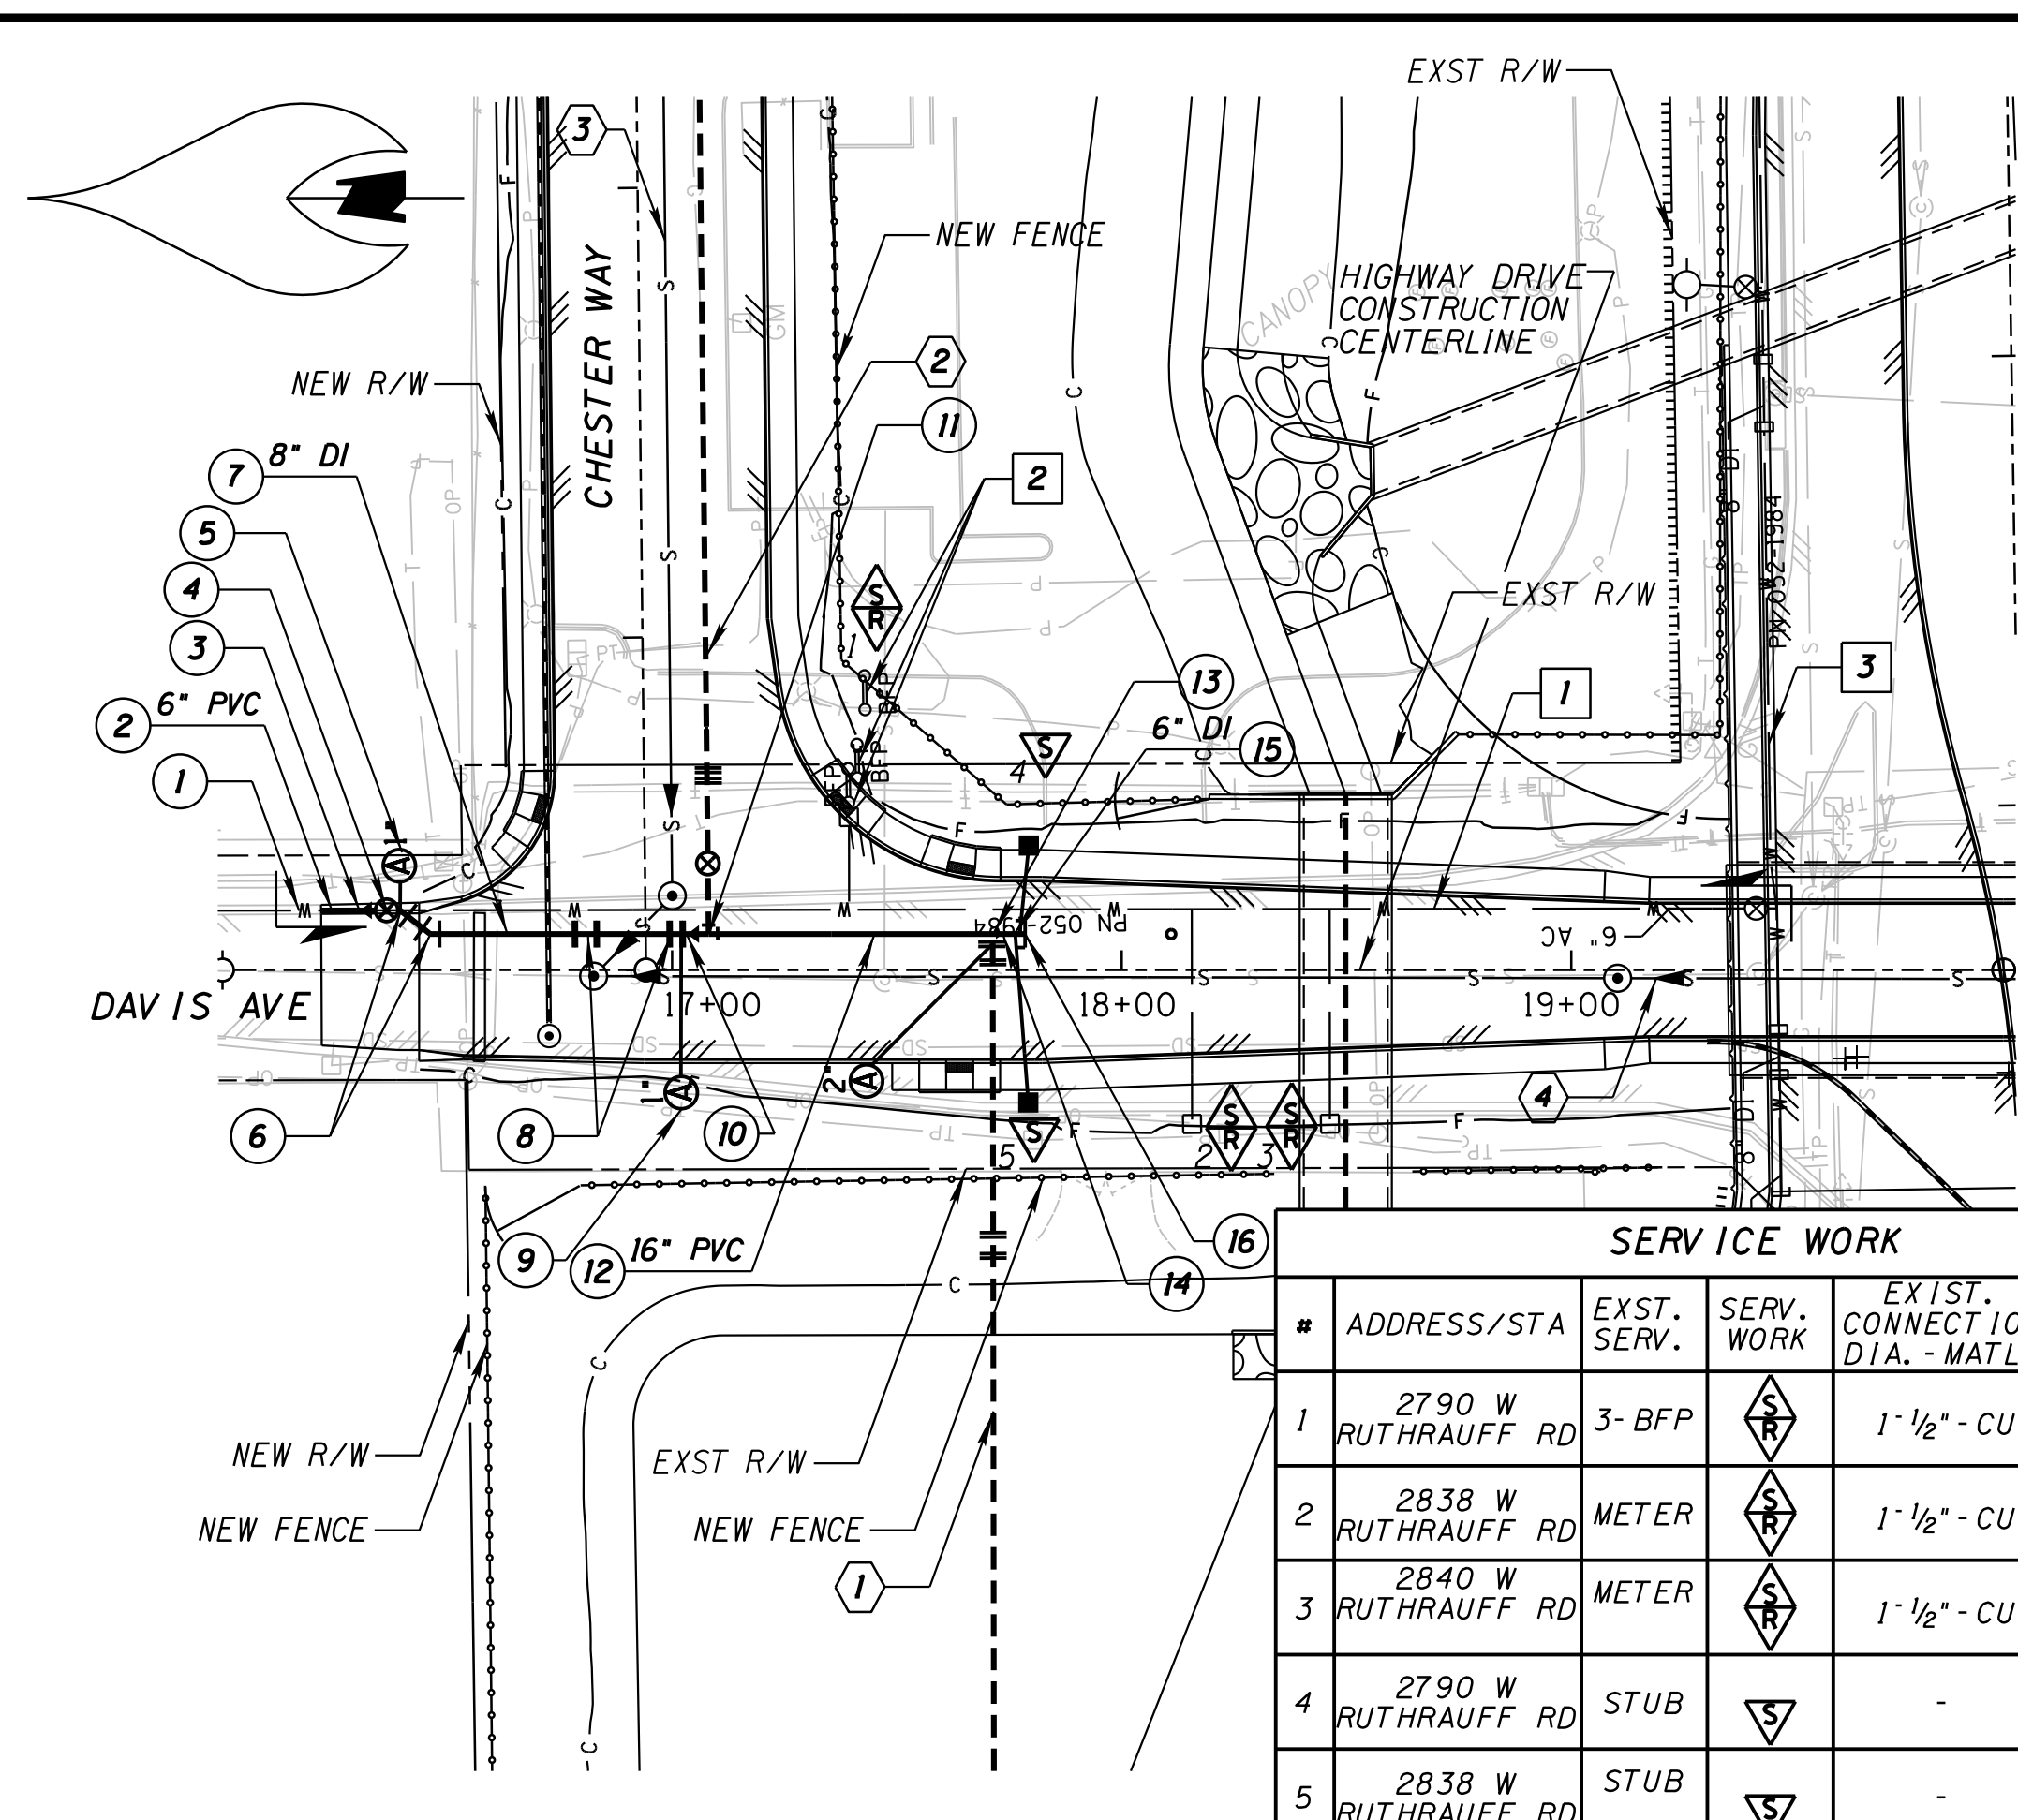


SERVICE WORK				
#	ADDRESS/STA	EXST. SERV.	SERV. WORK	NEW CONNECTION DIA. - MATL.
1	2790 W RUTHRAUFF RD	3-BFP	1 1/2" - CU	-
2	2838 W RUTHRAUFF RD	METER	1 1/2" - CU	-
3	2840 W RUTHRAUFF RD	METER	1 1/2" - CU	-
4	2790 W RUTHRAUFF RD	STUB	-	1" - CU
5	2838 W RUTHRAUFF RD	STUB	-	1" - CU

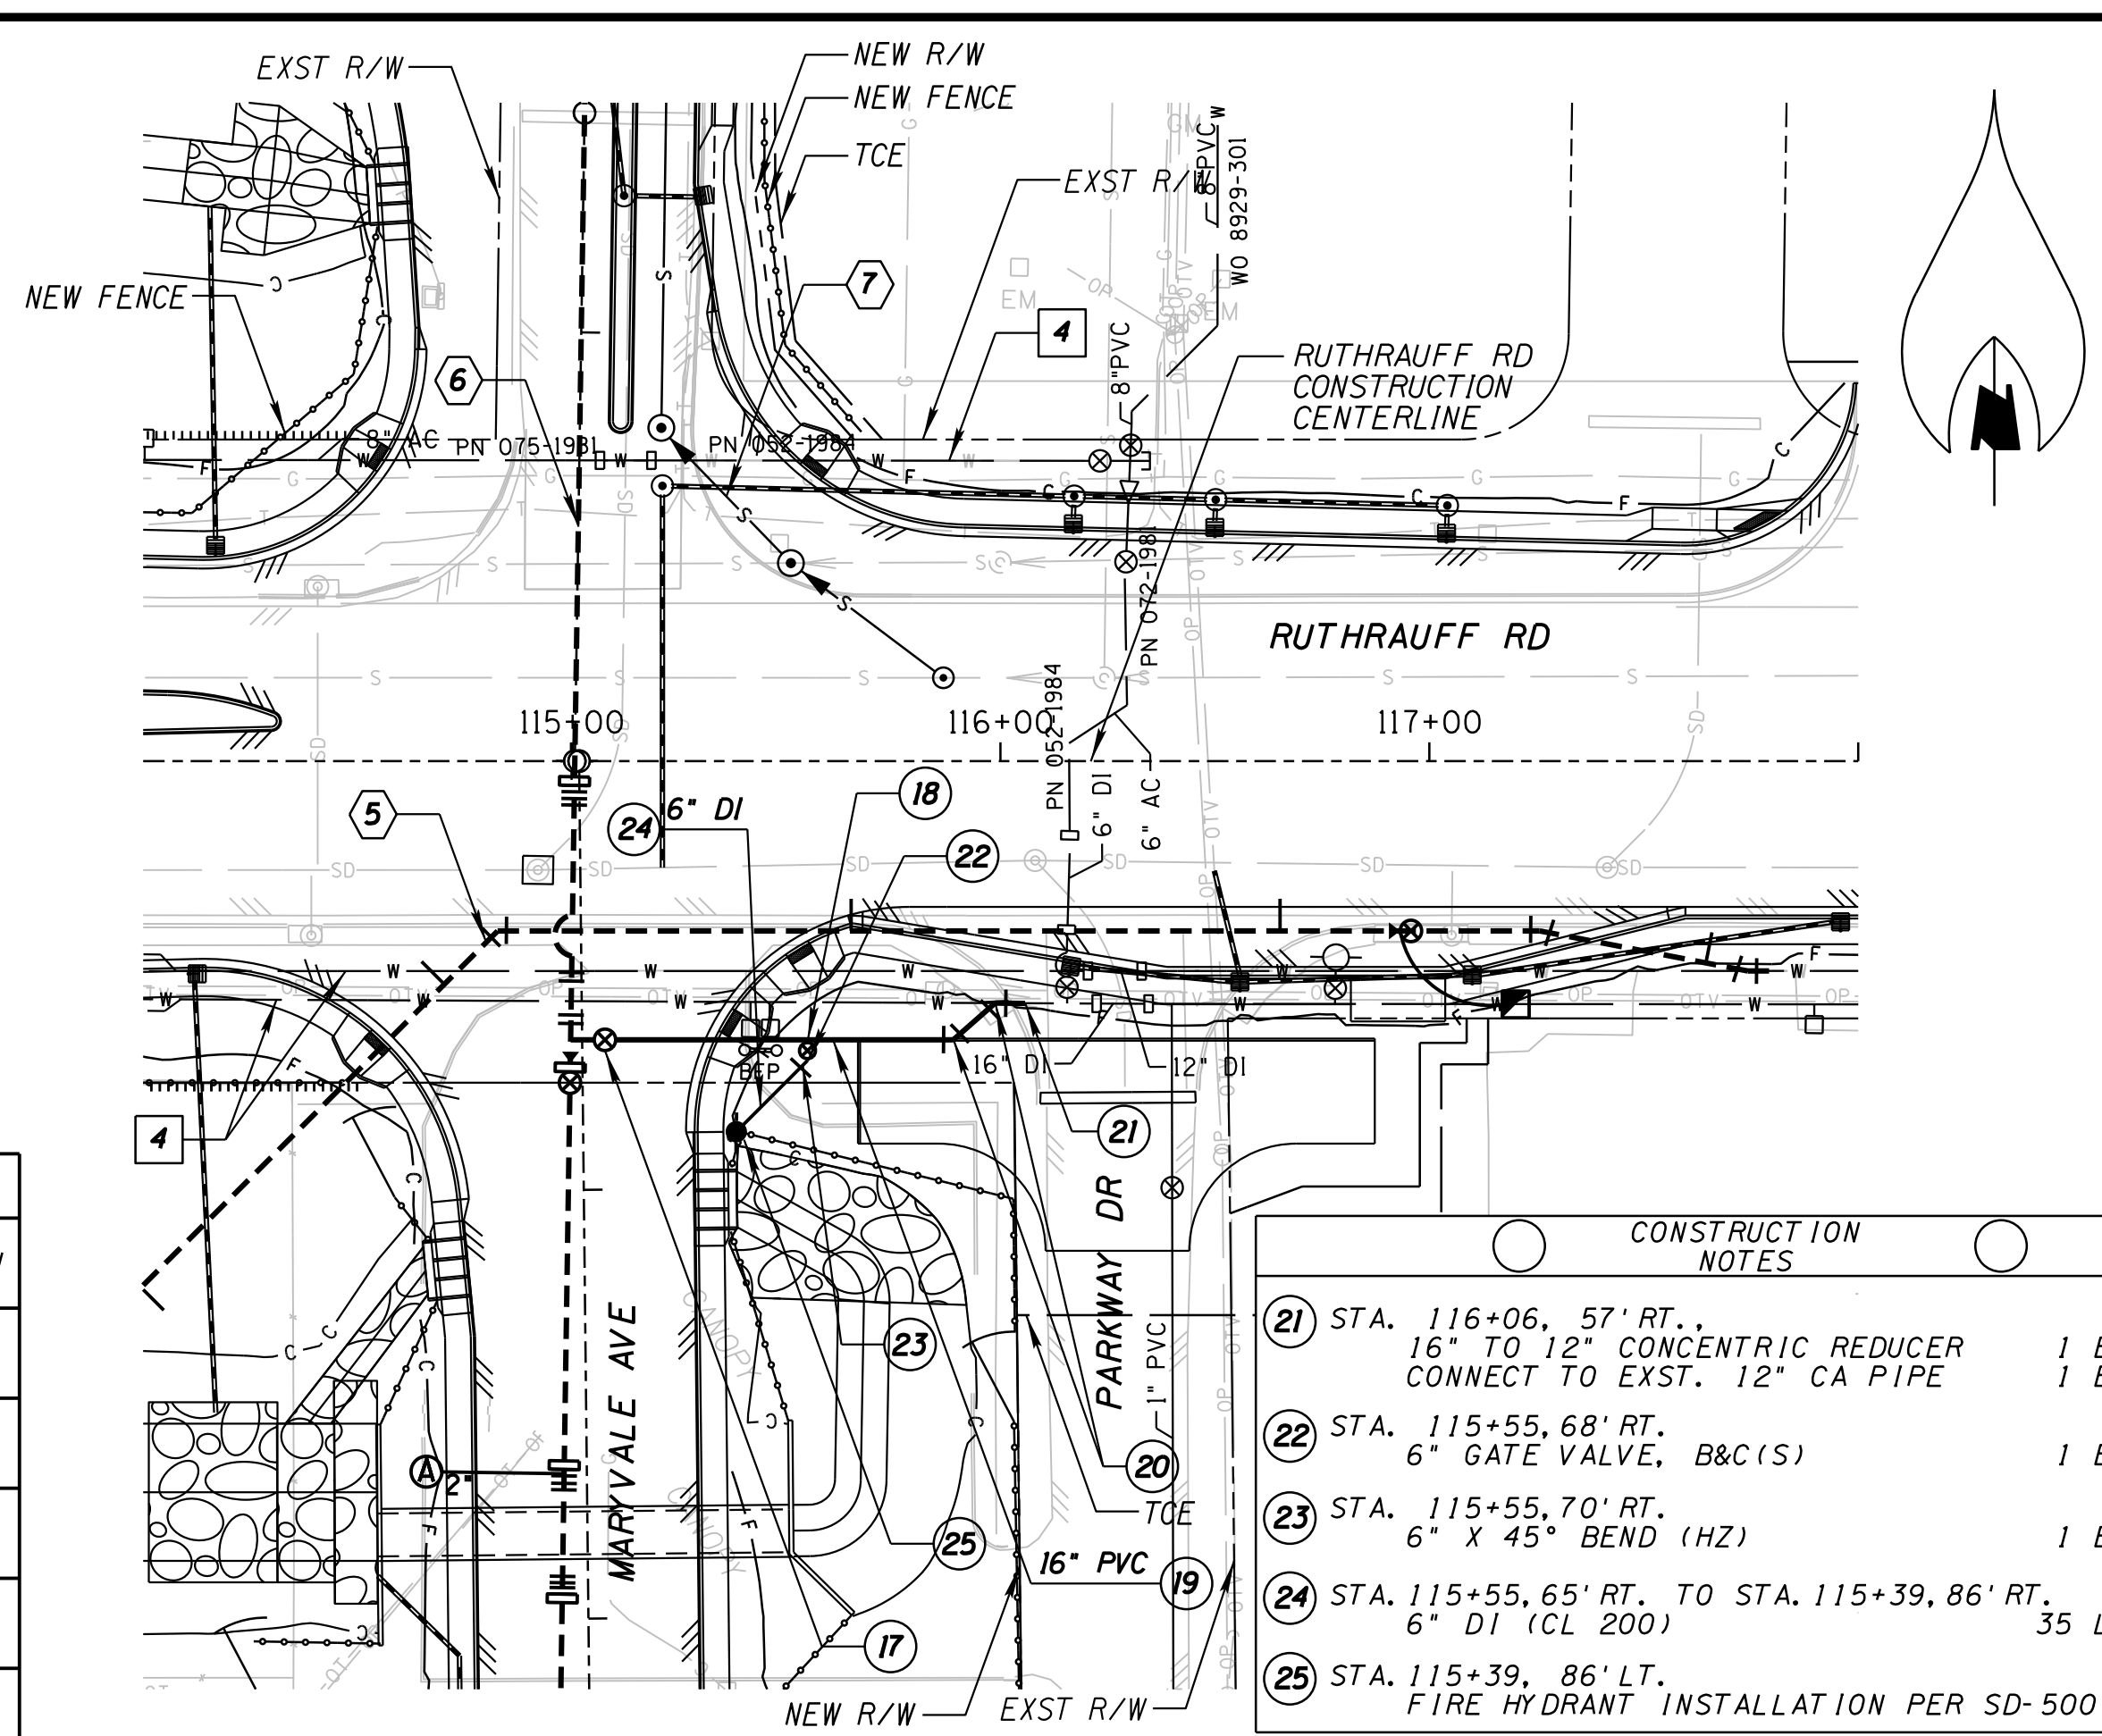

CONSTRUCTION NOTES		
21	STA. 116+06, 57' RT. 16" TO 12" CONCENTRIC REDUCER CONNECT TO EXST. 12" CA PIPE	1 EA(NP1)
22	STA. 115+55, 68' RT. 6" GATE VALVE, B&C(S)	1 EA(NP1)
23	STA. 115+55, 70' RT. 6" X 45° BEND (HZ)	1 EA(NP1)
24	STA. 115+55, 65' RT. TO STA. 115+39, 86' RT. 6" DI (CL 200)	35 LF(NP1)
25	STA. 115+39, 86' RT. FIRE HYDRANT INSTALLATION PER SD-500	1 EA

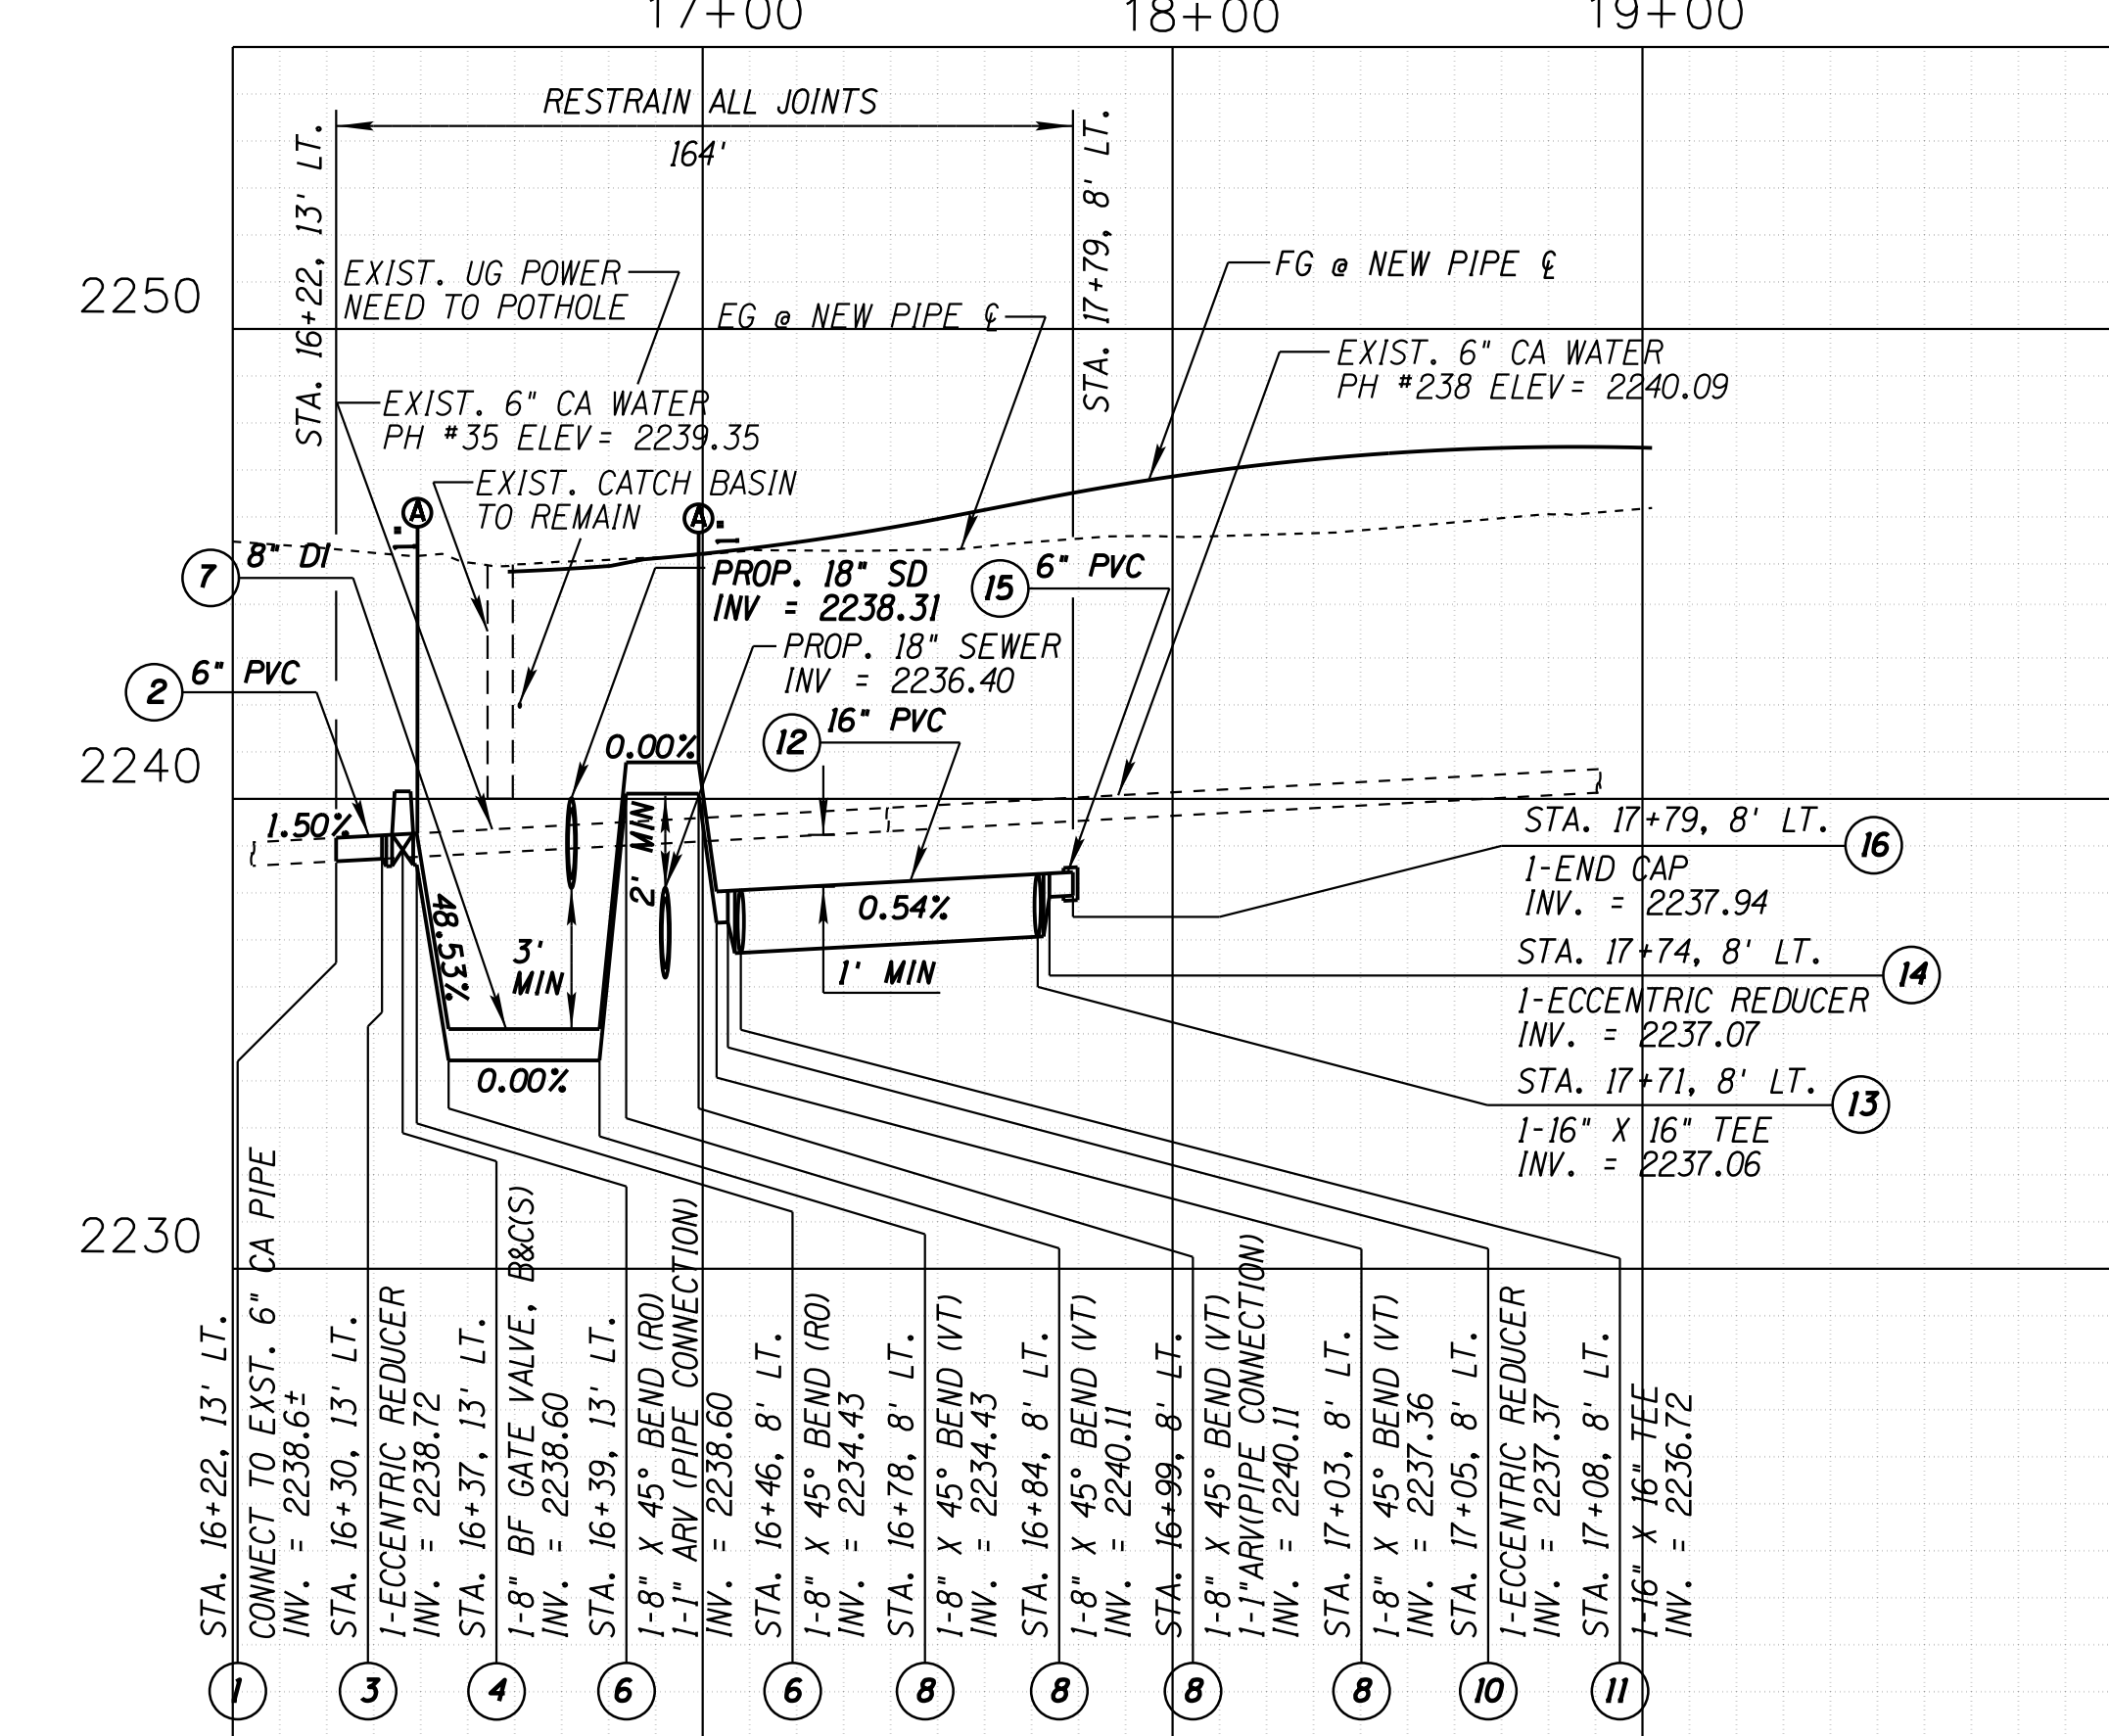

1	STA. 16+22, 13' LT. CONNECT TO EXST. 6" CA PIPE INV. = 2238.6±
2	STA. 16+30, 13' LT. 1-ECCENTRIC REDUCER INV. = 2238.72
3	STA. 16+37, 13' LT. 1-8" BF GATE VALVE, B&C(S) INV. = 2238.60
4	STA. 16+39, 13' LT. 1-8" X 45° BEND (RO) INV. = 2238.60
5	1-1" ARV (PIPE CONNECTION) INV. = 2238.60
6	STA. 16+46, 8' LT. 1-8" X 45° BEND (RO) INV. = 2234.43
7	STA. 16+78, 8' LT. 1-8" X 45° BEND (WT) INV. = 2234.43
8	STA. 16+84, 8' LT. 1-8" X 45° BEND (WT) INV. = 2240.11
9	STA. 16+99, 8' LT. 1-8" X 45° BEND (WT) INV. = 2240.11
10	STA. 17+03, 8' LT. 1-8" X 45° BEND (WT) INV. = 2237.36
11	STA. 17+05, 8' LT. 1-ECCENTRIC REDUCER INV. = 2237.37
12	STA. 17+08, 8' LT. 1-16" X 16" TEE INV. = 2236.72
13	STA. 17+71, 8' LT. 1-16" X 16" TEE INV. = 2237.06
14	STA. 17+74, 8' LT. 1-ECCENTRIC REDUCER INV. = 2237.07
15	STA. 17+79, 8' LT. 1-END CAP INV. = 2237.94
16	STA. 17+79, 8' LT. 1-16" X 16" TEE INV. = 2237.06

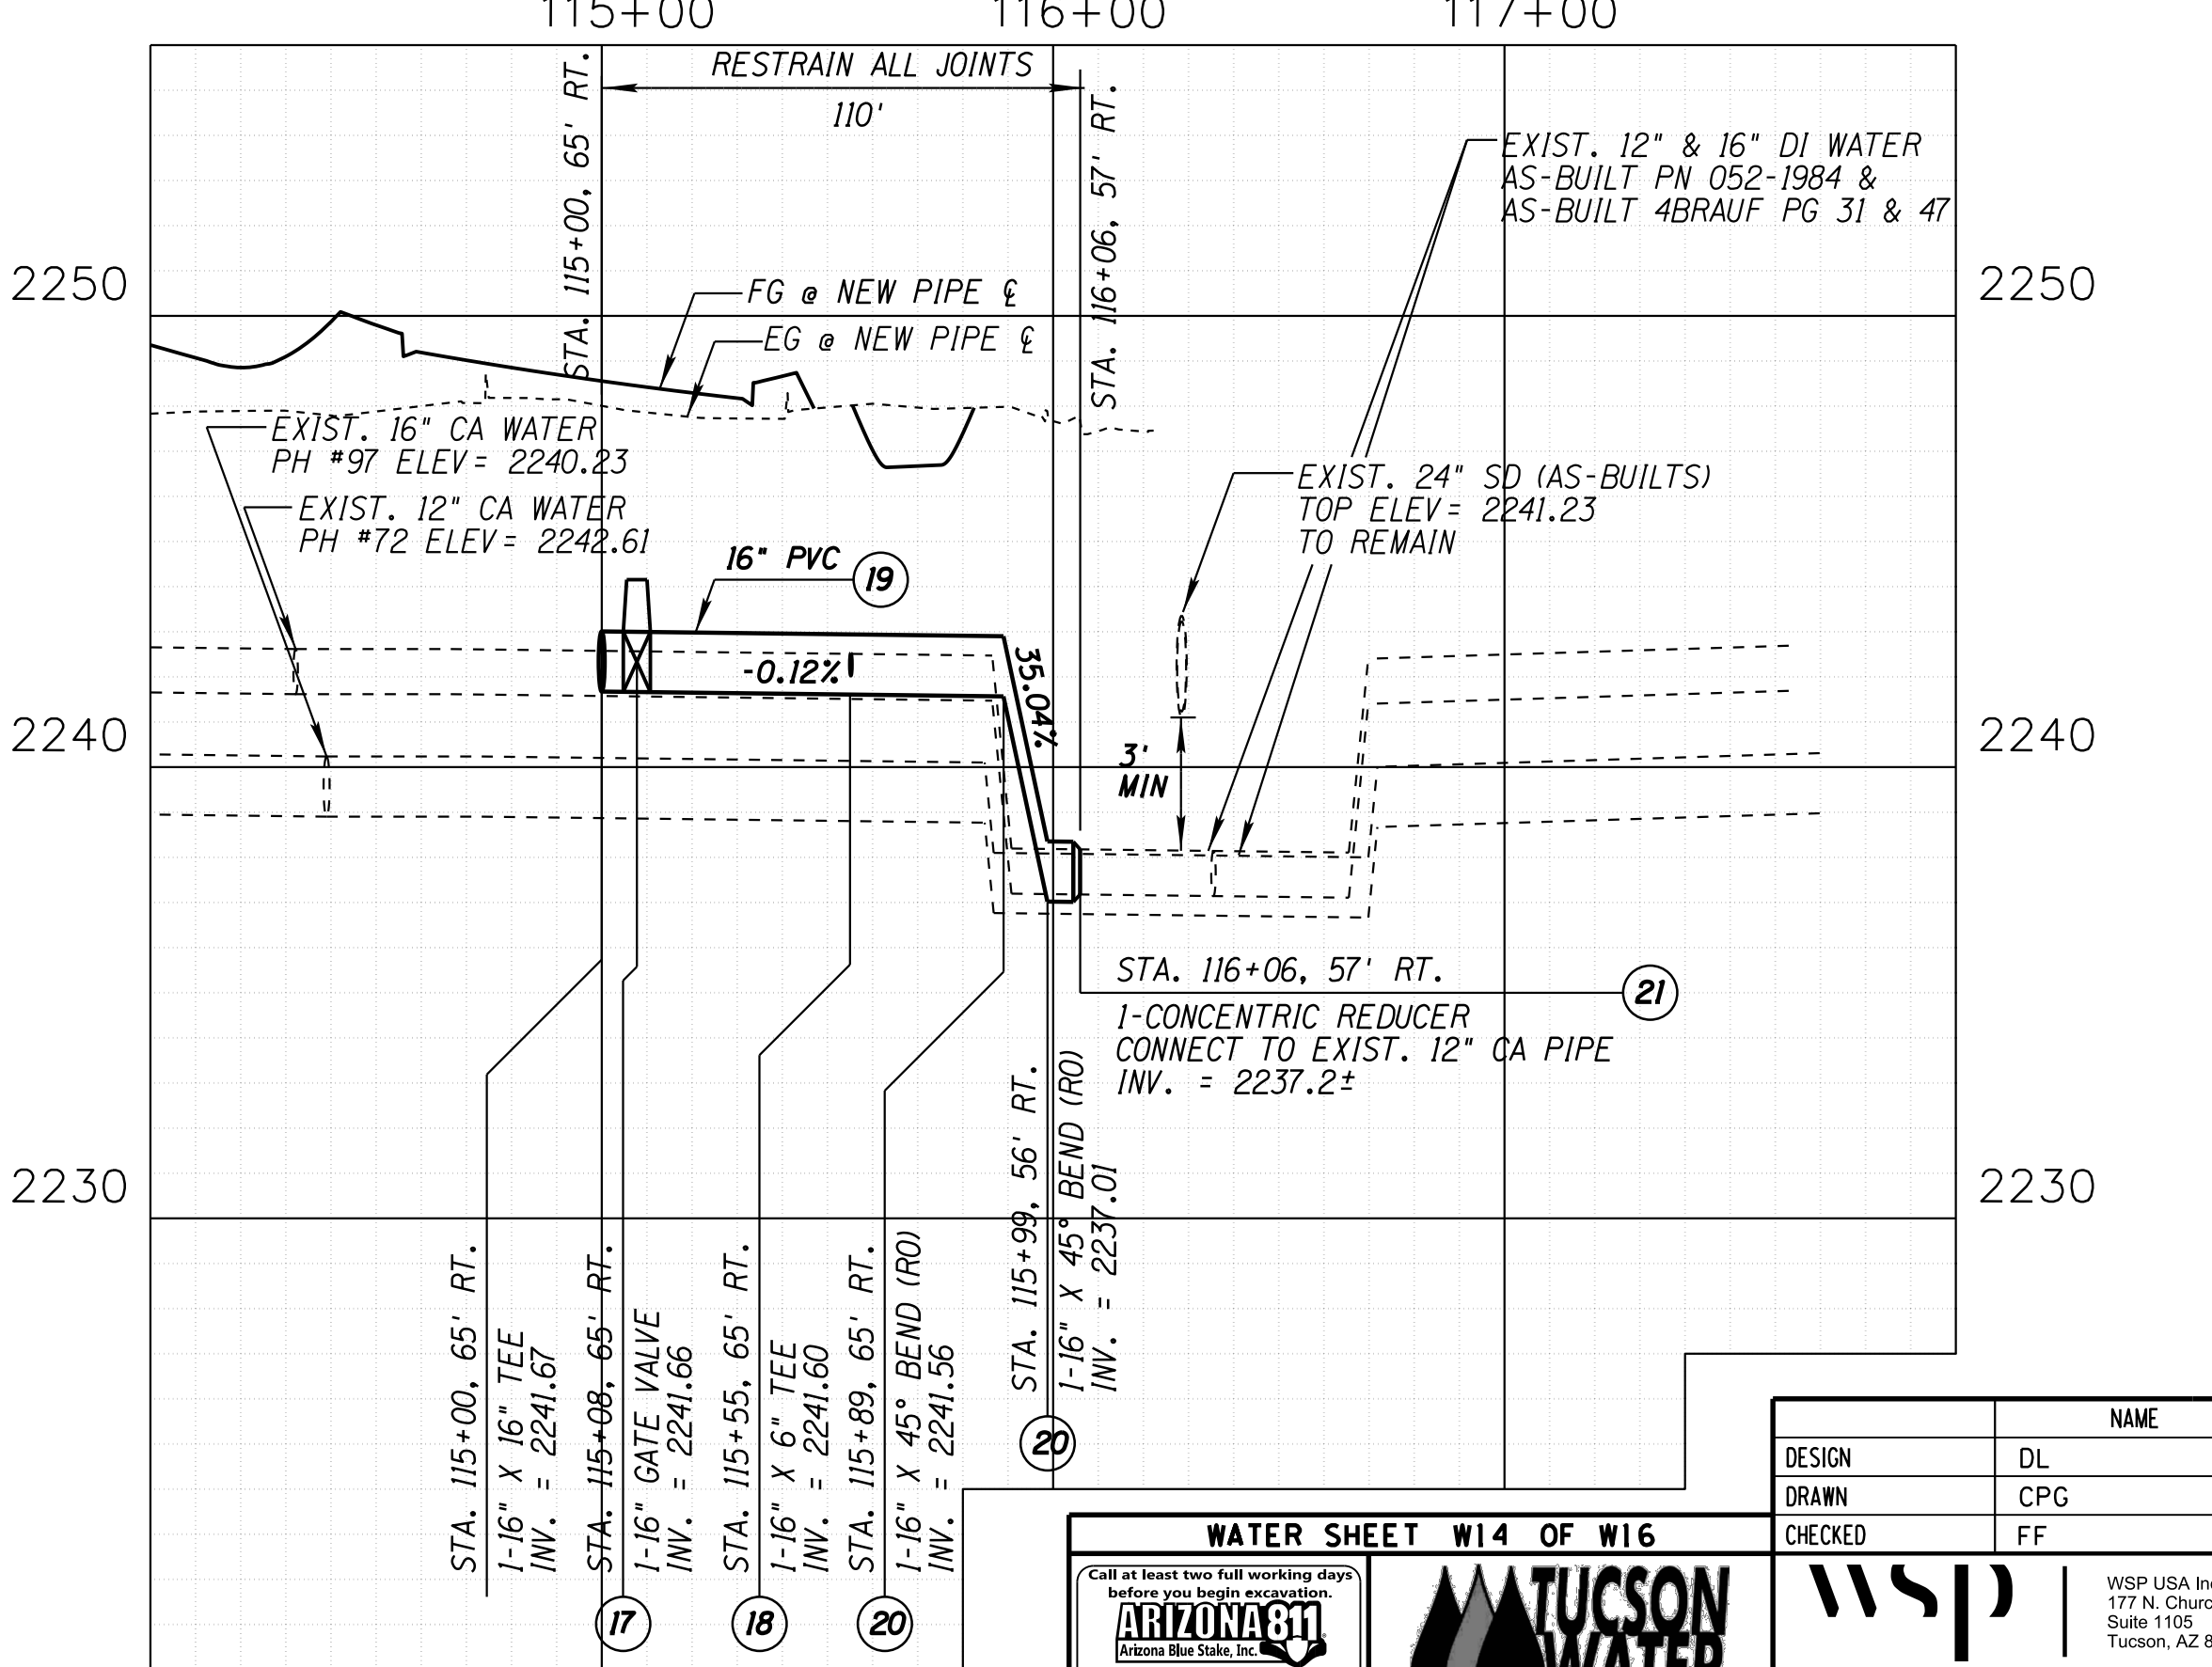

17	STA. 115+00, 65' RT. 1-16" X 16" TEE INV. = 2241.67
18	STA. 115+08, 65' RT. 1-16" GATE VALVE INV. = 2241.66
19	STA. 115+55, 65' RT. 1-16" X 6" TEE INV. = 2241.60
20	STA. 115+89, 65' RT. 1-16" X 45° BEND (RO) INV. = 2241.56
21	STA. 116+06, 57' RT. 1-16" X 45° BEND (RO) INV. = 2237.01

- REMOVE / ABANDON NOTES
- 1 STA. 16+17, 13' LT. TO 19+45, 14' LT REMOVE AND DISPOSE 6" CA PIPE 330 LF
  - 2 STA. 17+39, 41' LT. STA. 17+41, 46' LT. STA. 17+43, 62' LT. REMOVE BACKFLOW PREVENTION 3 EA
  - 3 SEE SHEET W8 FOR REMOVAL OF EXISTING PIPE
  - 4 SEE SHEET W9 FOR REMOVAL OF EXISTING PIPE

- CONSTRUCTION NOTES
- 1 STA. 16+22, 13' LT. CONNECT TO EXST. 6" CA PIPE 1 EA(NP1)
  - 2 STA. 16+22, 13' LT. TO STA. 16+30, 13' LT. 6" PVC DR14 (CL305) 8 LF
  - 3 STA. 16+30, 13' LT. 8" TO 6" ECCENTRIC REDUCER 1 EA(NP1)
  - 4 STA. 16+37, 13' LT. 8" GATE VALVE, B & C(S) W/ THRUST BLOCK PER SD-610 1 EA
  - 5 STA. 16+39, 23' LT. (LOCATION OF ARV). 1" ARV PER SD-330 1 EA
  - 6 STA. 16+39, 13' LT. STA. 16+46, 8' LT. 8" X 45° BEND (RO) 2 EA(NP1)
  - 7 STA. 16+30, 13' LT. TO STA. 17+05, 8' LT. 8" DI (CL 350) 80 LF
  - 8 STA. 16+78, 8' LT. STA. 16+84, 8' LT. STA. 16+99, 8' LT. STA. 17+03, 8' LT. 8" X 45° BEND (VT) 4 EA(NP1)
  - 9 STA. 17+02, 27' LT. (LOCATION OF ARV). 1" ARV PER SD-330 1 EA
  - 10 STA. 17+05, 8' LT. 16" TO 8" ECCENTRIC REDUCER 1 EA(NP1)
  - 11 STA. 17+08, 8' LT. 16" X 16" TEE 1 EA(NP1)
  - 12 STA. 17+05, 8' LT. TO STA. 17+34, 8' LT. 16" PVC DR18 (CL235) 71 LF
  - 13 STA. 17+71, 8' LT. 16" X 16" TEE 1 EA(NP1)
  - 14 STA. 17+74, 8' LT. 16" TO 6" ECCENTRIC REDUCER 1 EA(NP1)
  - 15 STA. 17+74, 8' LT. TO STA. 17+79, 8' LT. 6" DI (CL 200) 5 LF
  - 16 STA. 17+79, 8' LT. END CAP 1 EA(NP1)
  - 17 STA. 115+08, 65' RT. 16" GATE VALVE, B&C(S) 1 EA
  - 18 STA. 115+55, 65' RT. 16" X 6" TEE 1 EA(NP1)
  - 19 STA. 115+00, 65' RT. TO STA. 116+06, 57' RT. 16" PVC DR18 (CL235) 110 LF
  - 20 STA. 115+89, 65' RT. & STA. 115+99, 56' RT. 16" X 45° BEND (RO) 2 EA(NP1)

- REFERENCE NOTES
- 1 TRANSMISSION WATER MAIN PLAN & PROFILE, SEE SHEET W11
  - 2 TRANSMISSION WATER MAIN PLAN & PROFILE, SEE SHEET W12
  - 3 SANITARY SEWER PLAN & PROFILE, SEE SHEET SS7
  - 4 SANITARY SEWER PLAN & PROFILE, SEE SHEET SS6
  - 5 TRANSMISSION WATER MAIN PLAN & PROFILE, SEE SHEET W9
  - 6 TRANSMISSION WATER MAIN PLAN & PROFILE, SEE SHEET W13
  - 7 SANITARY SEWER PLAN & PROFILE, SEE SHEET SS8

WATER SHEET W14 OF W16

ARIZONA STATE WATER PROJECT

TUCSON WATER

WSP USA INC. 177 N. Church Ave. Suite 1105 Tucson, AZ 85701

ROUTE: I-10 LOCATION: RUTHRAUFF ROAD TI

DESIGN: DL DATE: 3-19

DRAWN: CPG DATE: 3-19

CHECKED: FF DATE: 3-19

TRACS NO. H 8480 OIC

010-D(213)S



DWG NO. U-2.14

OF





SURVEY NO. FINISHED PLANS DATE REVISIONS LOCATION DATE REVISIONS LOCATION DATE REVISIONS LOCATION DATE

F.H.W.A. REGION	STATE	PROJECT NO.	SHEET NO.	TOTAL SHEETS	RECORD DRAWING
9	ARIZ.	010-D(213)S			
010 PM 252					

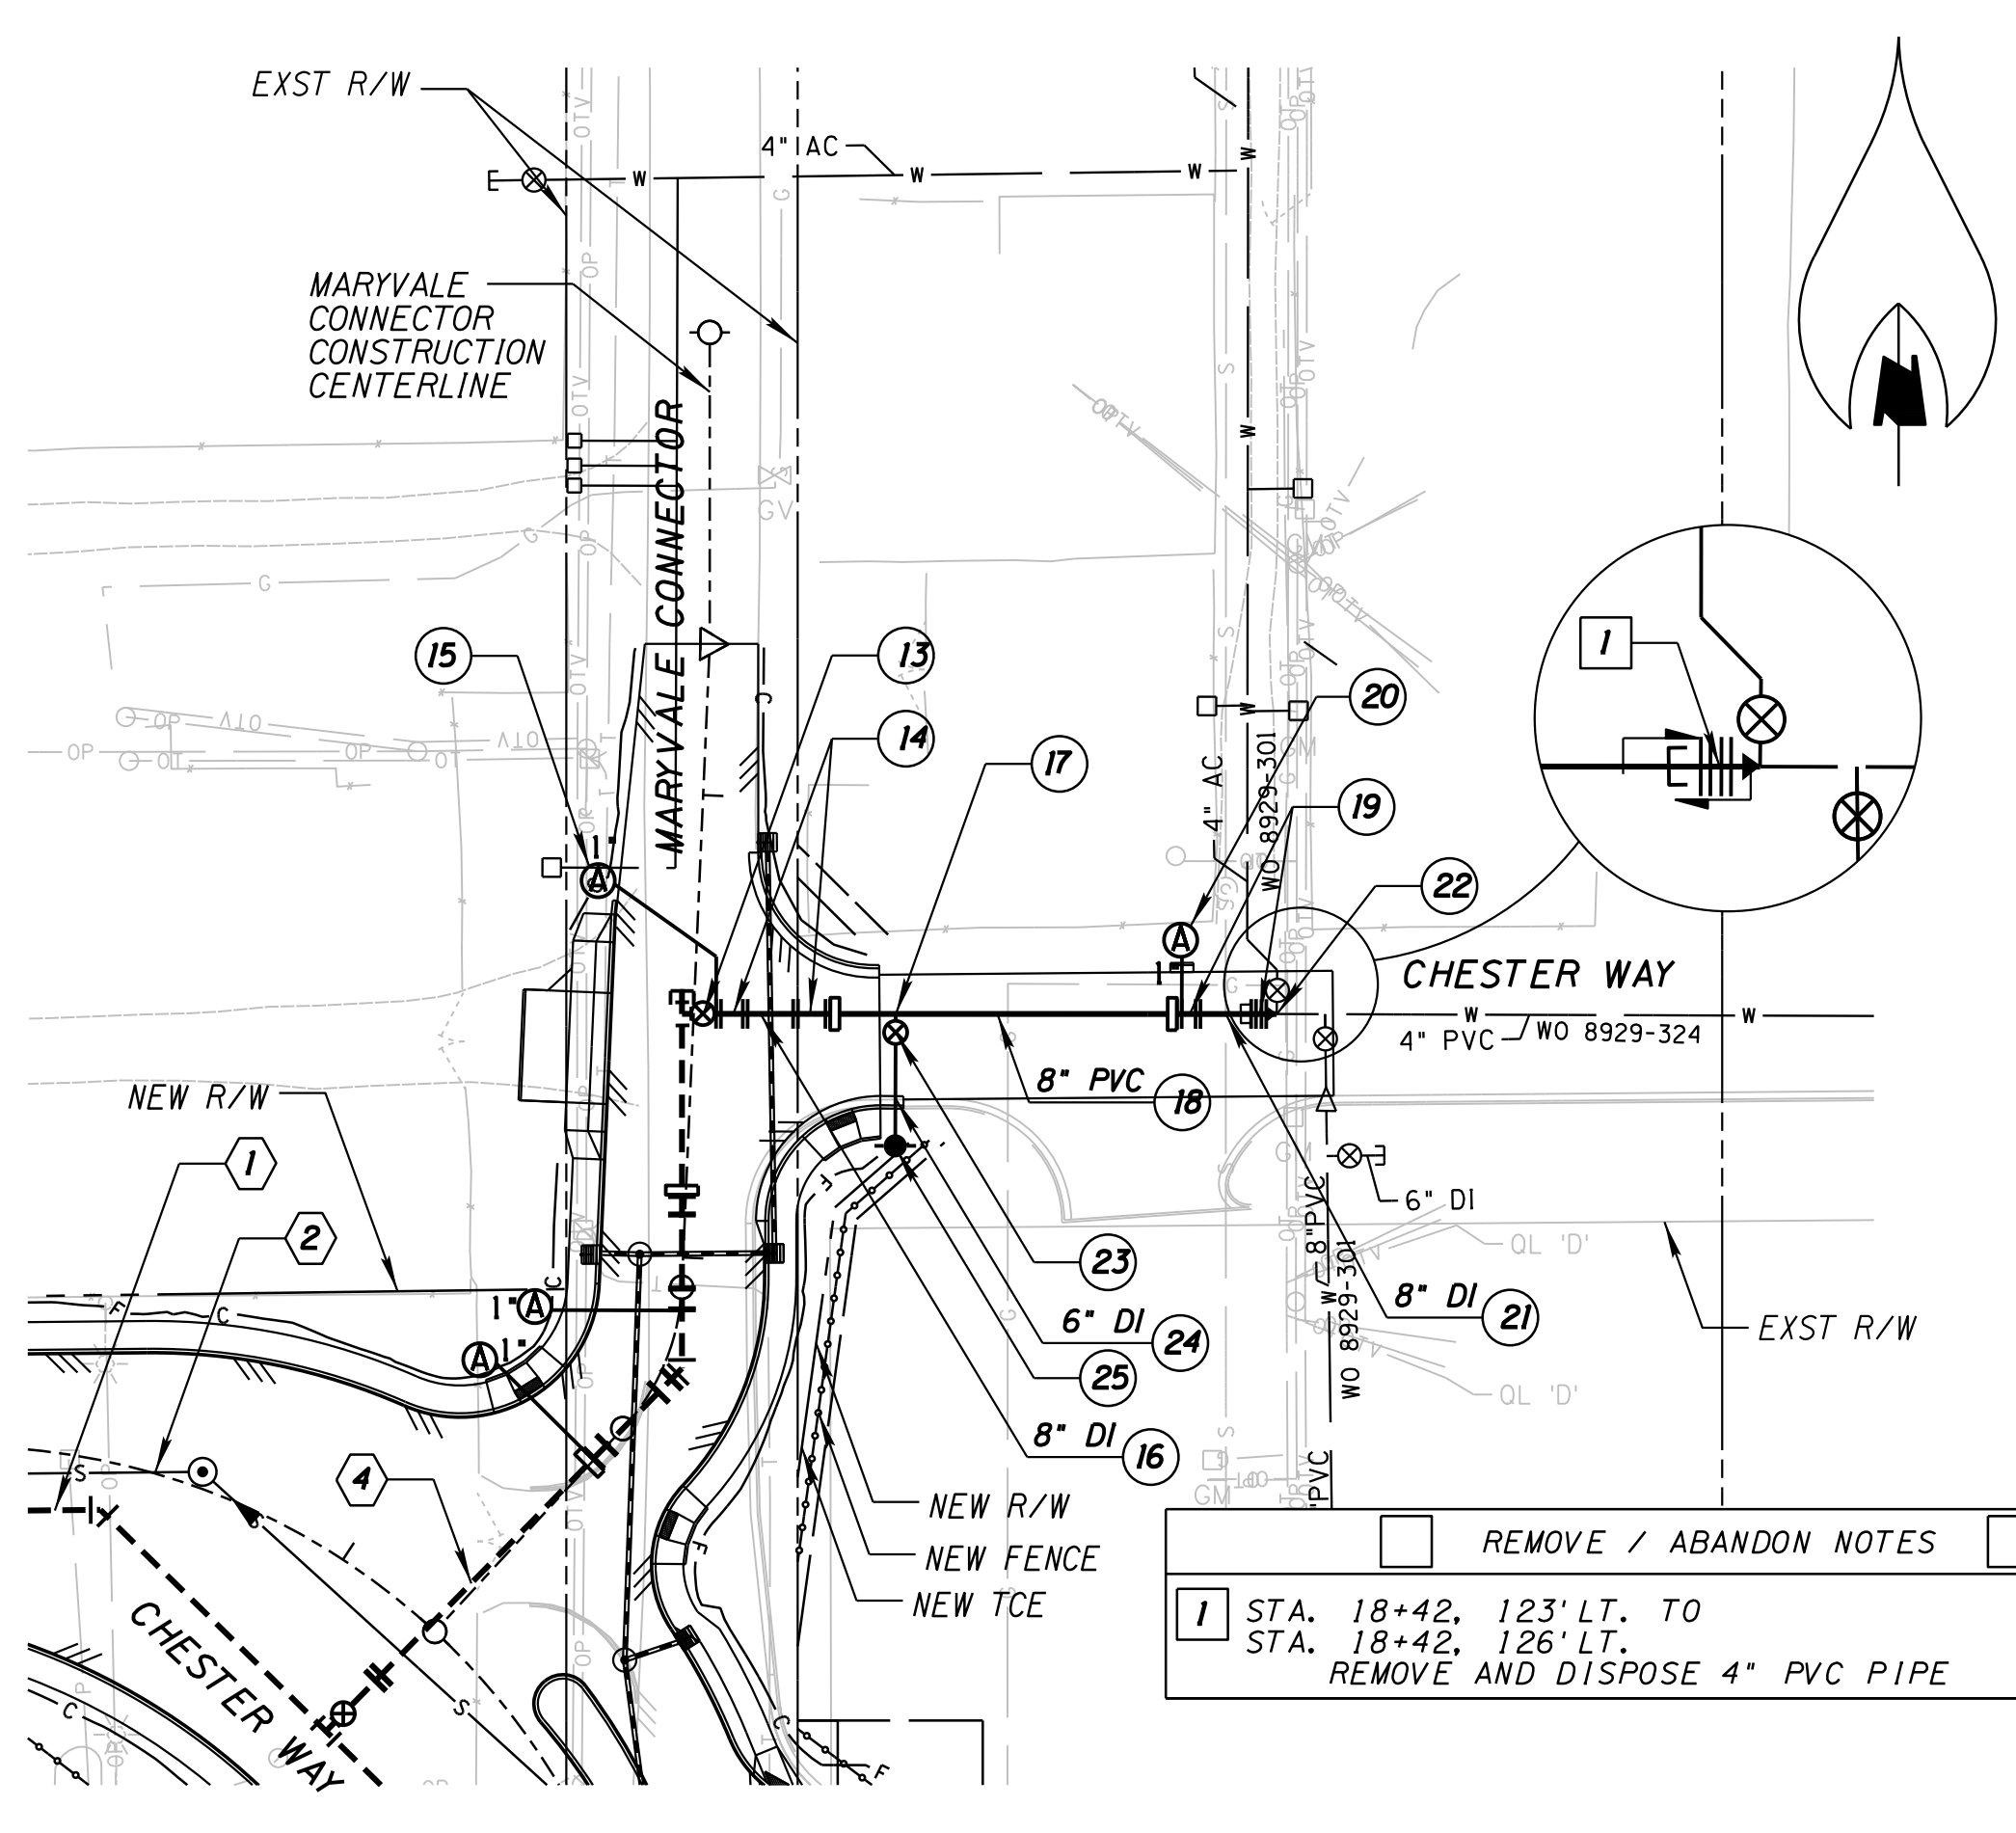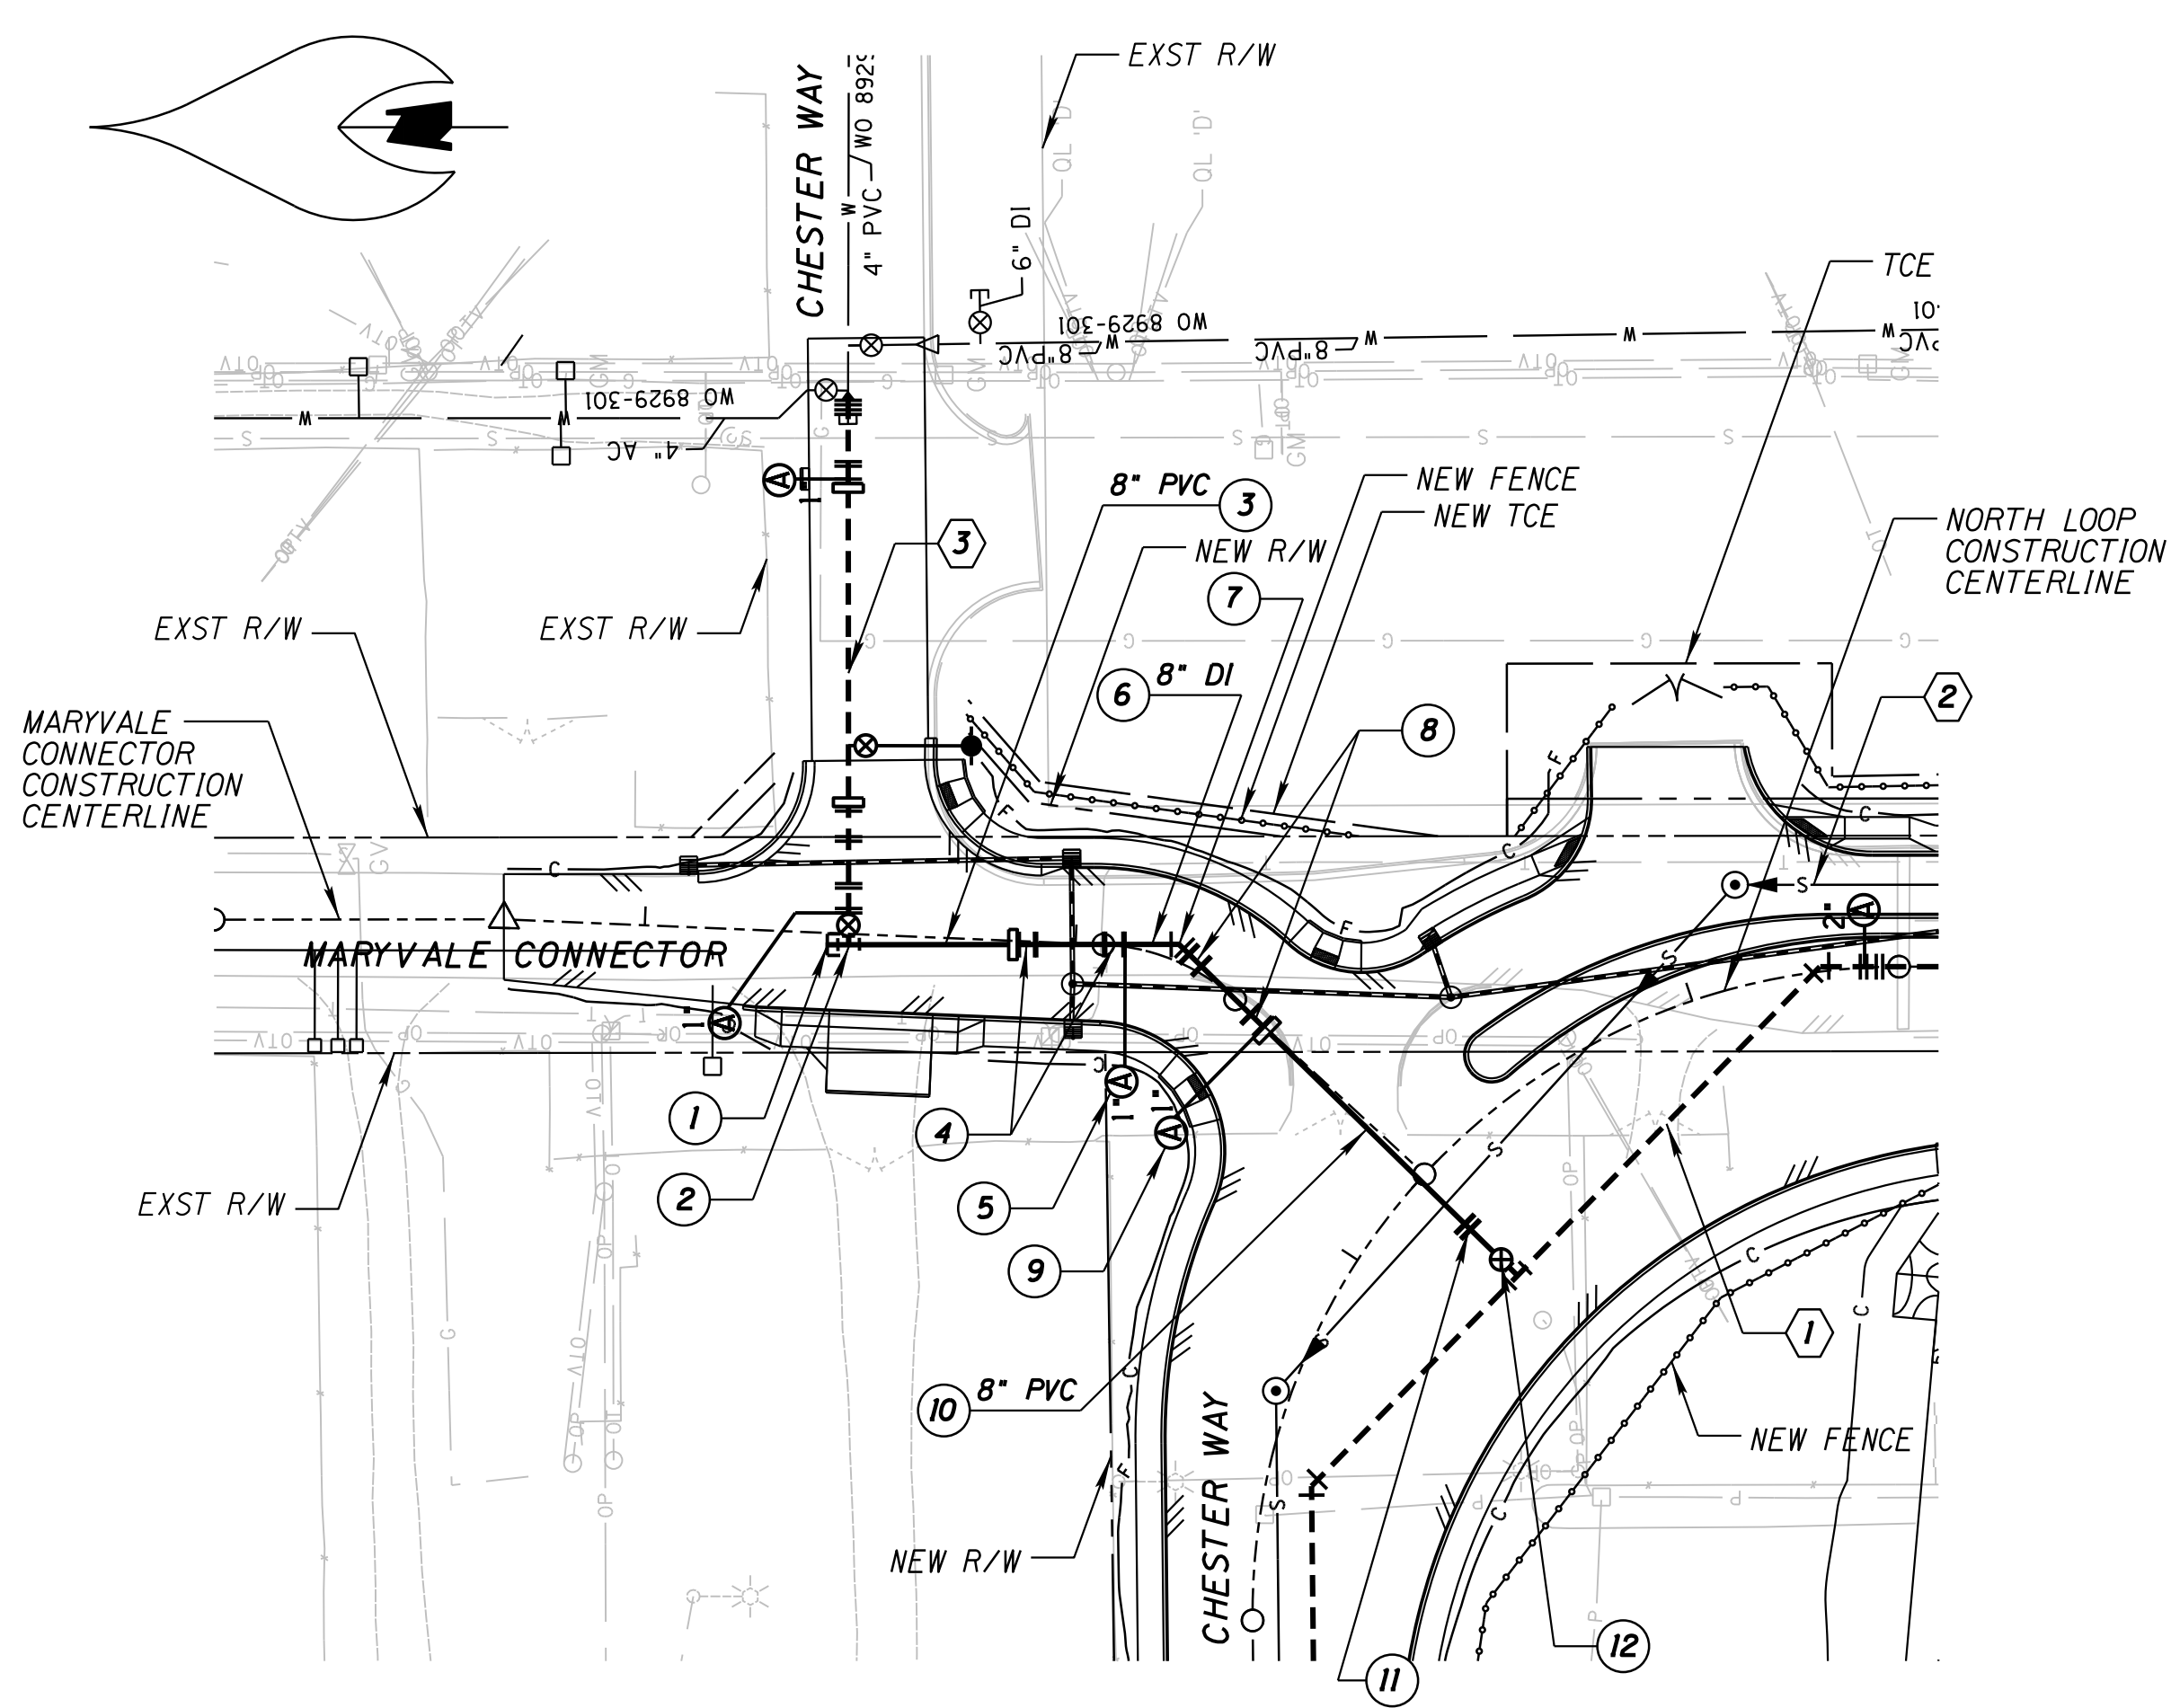

- CONSTRUCTION NOTES
- 1 STA. 18+42, 3' RT. END CAP 1 EA(NP1)
  - 2 STA. 18+47, 3' RT. 8" X 8" TEE 1 EA(NP1)
  - 3 STA. 18+42, 3' RT. TO STA. 18+86, 1' RT. 8" PVC DR14 (CL305) 43 LF
  - 4 STA. 18+86, 1' RT. & STA. 18+91, 1' RT. STA. 19+06, 0' RT. & STA. 19+11, 1' LT. 8" X 45° BEND (VT) 4 EA(NP1)
  - 5 STA. 17+22, 31' RT. (LOCATION OF ARV) 1" ARV PER SD-330 1 EA
  - 6 STA. 18+86, 1' RT. TO STA. 19+49, 0' RT. 8" DI (CL 350) 70 LF
  - 7 STA. 19+23, 4' LT., 8" X 45° BEND (HZ) 1 EA(NP1)
  - 8 STA. 19+26, 3' LT. & STA. 19+30, 2' LT. STA. 19+45, 0' LT. & STA. 19+49, 0' LT. 8" X 45° BEND (VT) 4 EA(NP1)
  - 9 STA. 19+50, 33' RT. (LOCATION OF ARV) 1" ARV PER SD-330 1 EA
  - 10 STA. 19+49, 0' RT. TO STA. 17+22, 32' RT. (NORTH LOOP CST E) 8" PVC DR14 (CL305) 83 LF
  - 11 STA. 17+23, 15' RT. & STA. 17+23, 16' RT. (NORTH LOOP CST E) 8" X 45° BEND (VT) 2 EA(NP1)
  - 12 STA. 17+22, 26' RT. (NORTH LOOP CST E) 8" GATE VALVE B & C 1 EA
  - 13 STA. 18+47, 2' LT., 8" GATE VALVE B & C 1 EA
  - 14 STA. 18+47, 5' LT. & STA. 18+47, 12' LT. STA. 18+46, 21' LT. & STA. 18+46, 29' LT. 8" X 45° BEND (VT) 4 EA(NP1)
  - 15 STA. 18+19, 22' RT. (LOCATION OF ARV) 1" ARV PER SD-330 1 EA
  - 16 STA. 18+47, 3' RT. TO STA. 18+46, 29' LT. 8" DI (CL 350) 36 LF
  - 17 STA. 18+45, 44' LT. 8" X 6" TEE 1 EA(NP1)
  - 18 STA. 18+46, 29' LT. TO STA. 18+43, 104' LT. 8" PVC DR 14 (CL 305) 73 LF
  - 19 STA. 18+43, 104' LT. & STA. 18+43, 109' LT., STA. 18+42, 121' LT. & STA. 18+42, 124' LT. 8" X 45° BEND (VT) 4 EA(NP1)
  - 20 STA. 18+27, 104' LT. (LOCATION OF ARV) 1" ARV PER SD-330 1 EA
  - 21 STA. 18+43, 104' LT. TO STA. 18+42, 126' LT. 8" DI (CL 350) 24 LF
  - 22 STA. 18+42, 126' LT. 8" TO 4" ECCENTRIC REDUCER CONNECT TO EXST. 4" X 4" TEE 1 EA(NP1)
  - 23 STA. 18+49, 44' LT. 6" GATE VALVE B & C 1 EA(NP1)
  - 24 STA. 18+45, 44' LT. TO STA. 18+74, 45' LT. 6" DI (CL 200) 29 LF(NP1)
  - 25 STA. 18+74, 45' LT. FIRE HYDRANT INSTALLATION PER SD-500 1 EA

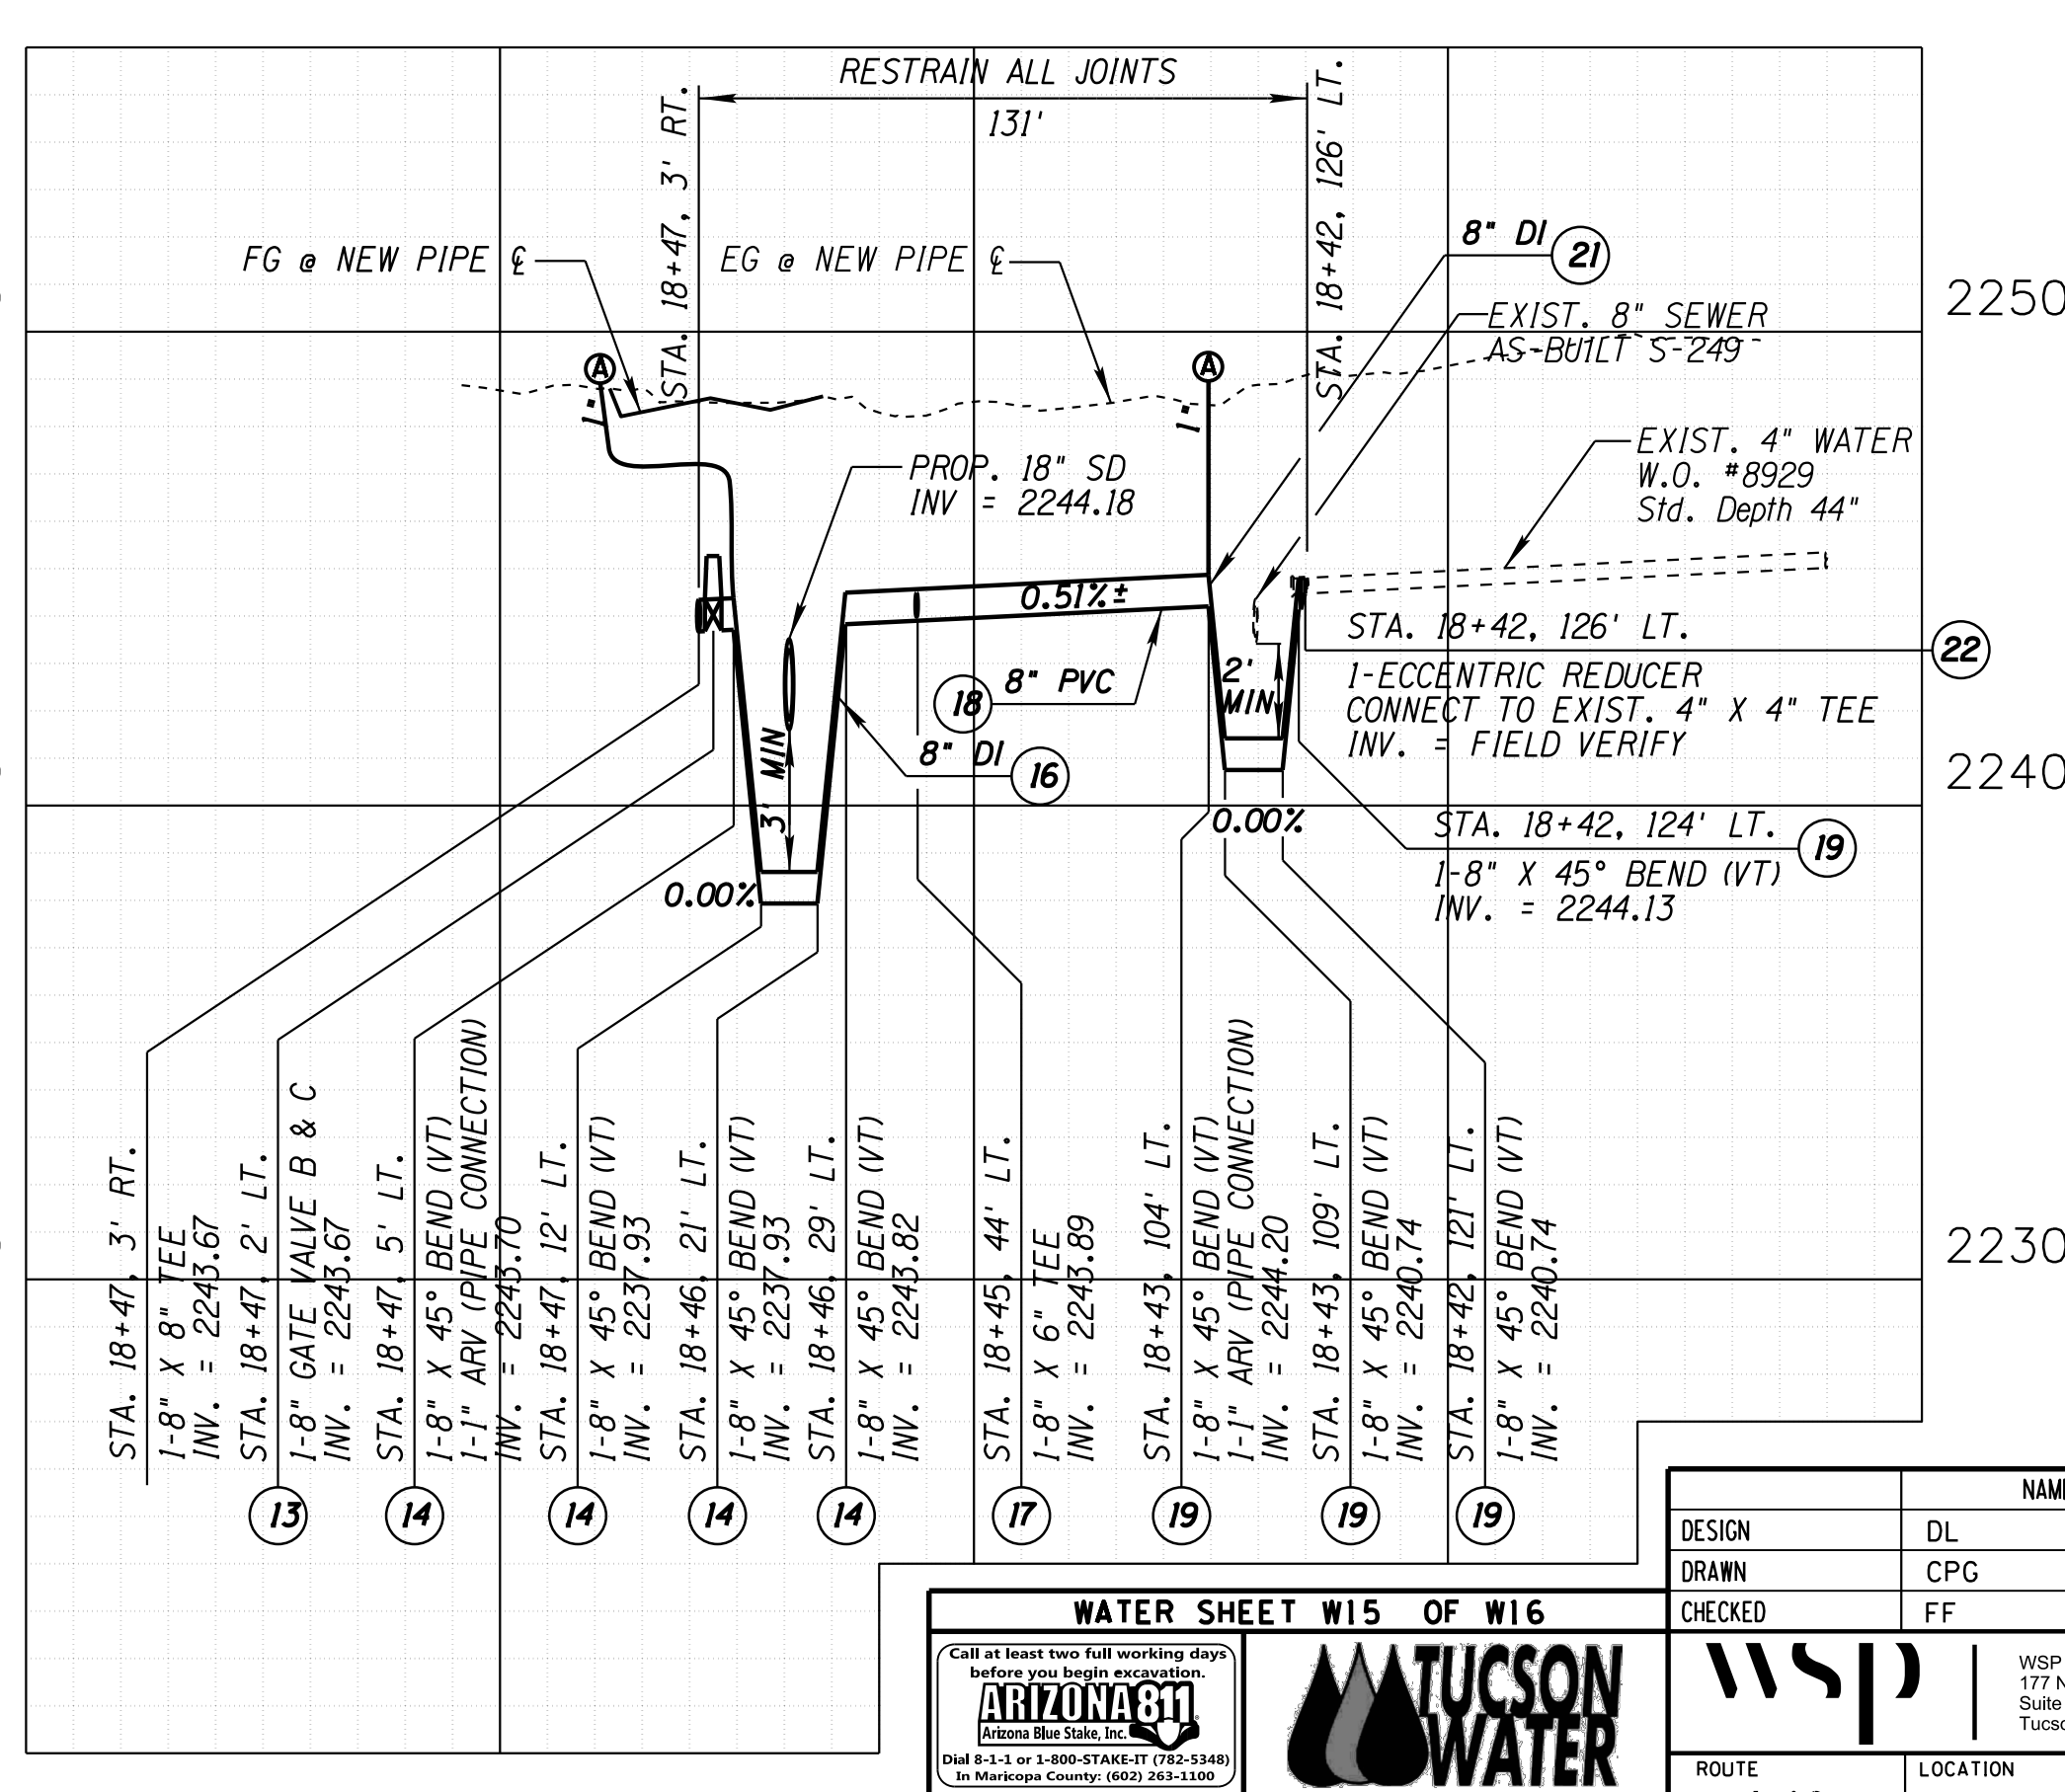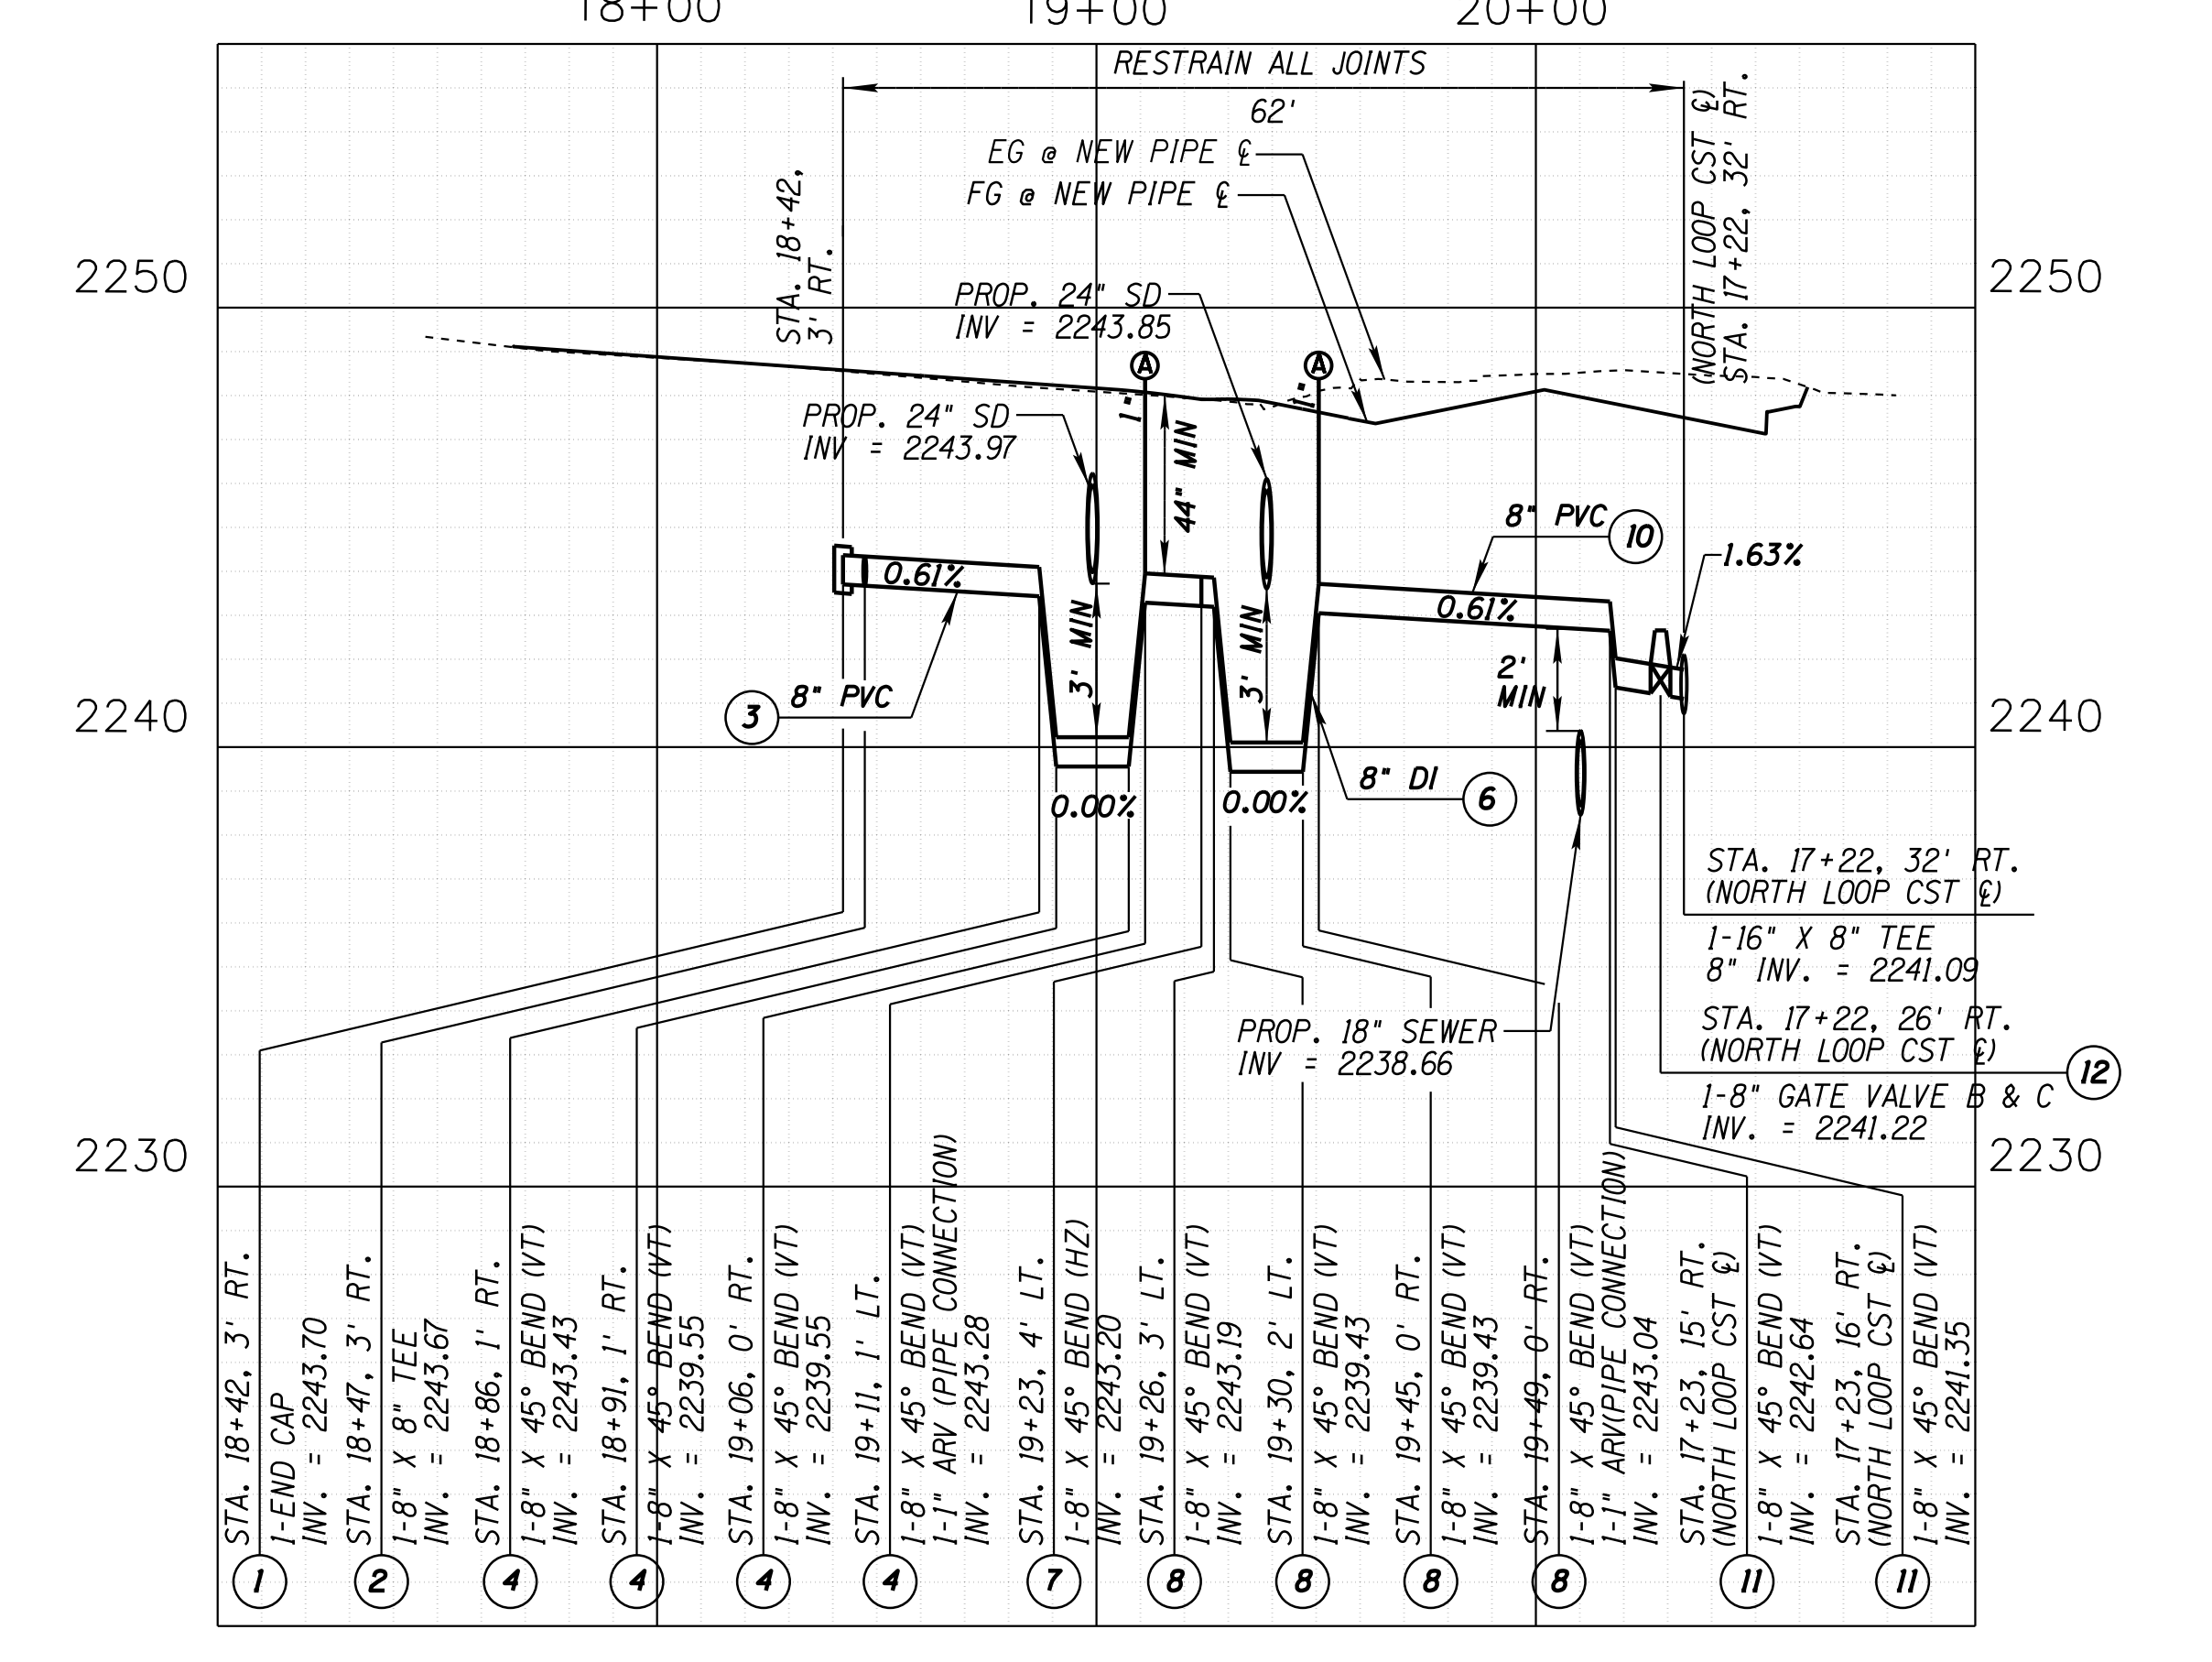

- REFERENCE NOTES
- 1 TRANSMISSION WATER MAIN PLAN & PROFILE SEE SHEET W12 & W13
  - 2 SANITARY SEWER PLAN & PROFILE, SEE SHEET S57 & S58
  - 3 DISTRIBUTION WATER MAIN, SEE SHEET W15, RIGHT PLAN & PROFILE
  - 4 DISTRIBUTION WATER MAIN, SEE SHEET W15, LEFT PLAN & PROFILE

VERT: 1" = 4'  
HORZ: 1" = 40'


NO.	DATE	REVISION	BY	CHKD.	APPR.

DESIGN	DL	DATE
DRAWN	CPG	3-19
CHECKED	FF	3-19

**ARIZONA DEPARTMENT OF TRANSPORTATION**  
**INFRASTRUCTURE DELIVERY AND OPERATIONS DIVISION**  
**ROADWAY DESIGN SERVICES**

**RUTHRAUFF ROAD**  
**WATER MODIFICATION PLANS**  
**LATERAL PLAN & PROFILE**

ROUTE: I-10 LOCATION: RUTHRAUFF ROAD TI  
 TRACS NO. H 8480 OIC  
 010-D(213)S  
 DWG NO. U-2.15  
 OF

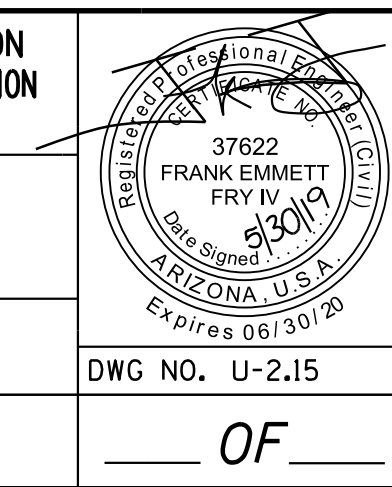



F.H.W.A. REGION	STATE	PROJECT NO.	SHEET NO.	TOTAL SHEETS	RECORD DRAWING
9	ARIZ.	010-D(213)S	830	849	

010 PM 252

REMOVE / ABANDON NOTES

1 SEE SHEET W5 FOR REMOVAL OF EXISTING PIPE.

CONSTRUCTION NOTES

- 1 STA. 88+54, 68' LT. CONNECT TO EXST 12" PVC PIPE 8" TAPPING SLEEVE 1 EA(NP1)  
1 EA(NP1)
- 2 STA. 88+60, 68' LT. 8" GATE VALVE, B&C(S) WITH THRUST BLOCK PER SD-610 1 EA  
1 EA
- 3 STA. 88+54, 68' LT. TO STA. 93+64, 100' LT. 8" PVC DR14 (CL305) 515 LF
- 4 STA. 92+74, 71' LT. STA. 93+24, 83' LT. 8" X 11.25" BEND (HZ) 2 EA(NP1)
- 5 STA. 93+55, 96' LT. 8" X 6" TEE W/ BLIND FLANGE 1 EA(NP1)
- 6 STA. 93+64, 100' LT. END CAP 1 EA(NP1)
- 7 STA. 93+57, 91' LT. 6" GATE VALVE B & C 1 EA(NP1)
- 8 STA. 93+61, 83' LT. FIRE HYDRANT INSTALLATION PER SD-500 1 EA
- 9 STA. 93+55, 96' LT. TO STA. 93+61, 83' LT. 6" DI (CL350) 20 LF(NP1)
- 10 STA. 88+50, 39' LT. STA. 88+52, 46' RT. ADJUST VALVE TO GRADE PER SD-305 2 EA
- 11 BACKFLOW DEVICE, 2" 3030 W. EL CAMINO DEL CERRO LOCATE SERVICE ACCORDING TO EXISTING PLUMBING. 1 EA
- 12 BACKFLOW DEVICE, 1" 3030 W. EL CAMINO DEL CERRO LOCATE SERVICE ACCORDING TO EXISTING PLUMBING. 1 EA

REFERENCE NOTES


1 TRANSMISSION WATER MAIN PLAN & PROFILE, SEE SHEET W5

SERVICE WORK

#	ADDRESS/STA	EXST. SERV.	SERV. WORK	EXIST. CONNECTION DIA. - MATL.	NEW CONNECTION DIA. - MATL.
1	3030 W. EL CAMINO DEL CERRO	M ( )	▽	2" - CU	2" - CU
2	STA. 93+47 ± 93' LT (IRRIGATION)	M ( )	▽	1" - CU	1" - CU
3	STA. 88+54 ± 45' LT	M (5/8")	▽	1" - CU	1" - CU
4	STA. 9+50 ± 69' LT (IRRIGATION)	-	▽	-	1" - CU



ARIZONA DEPARTMENT OF TRANSPORTATION INFRASTRUCTURE DELIVERY AND OPERATIONS DIVISION ROADWAY DESIGN SERVICES

RUTHRAUFF ROAD WATER MODIFICATION PLANS DISTRIBUTION PLAN AND PROFILES

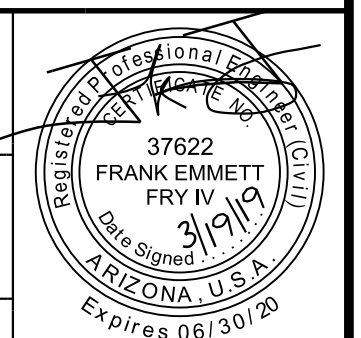


DWG NO. U-2.16

TRACS NO. H 8480 OIC 010-D(213)S OF

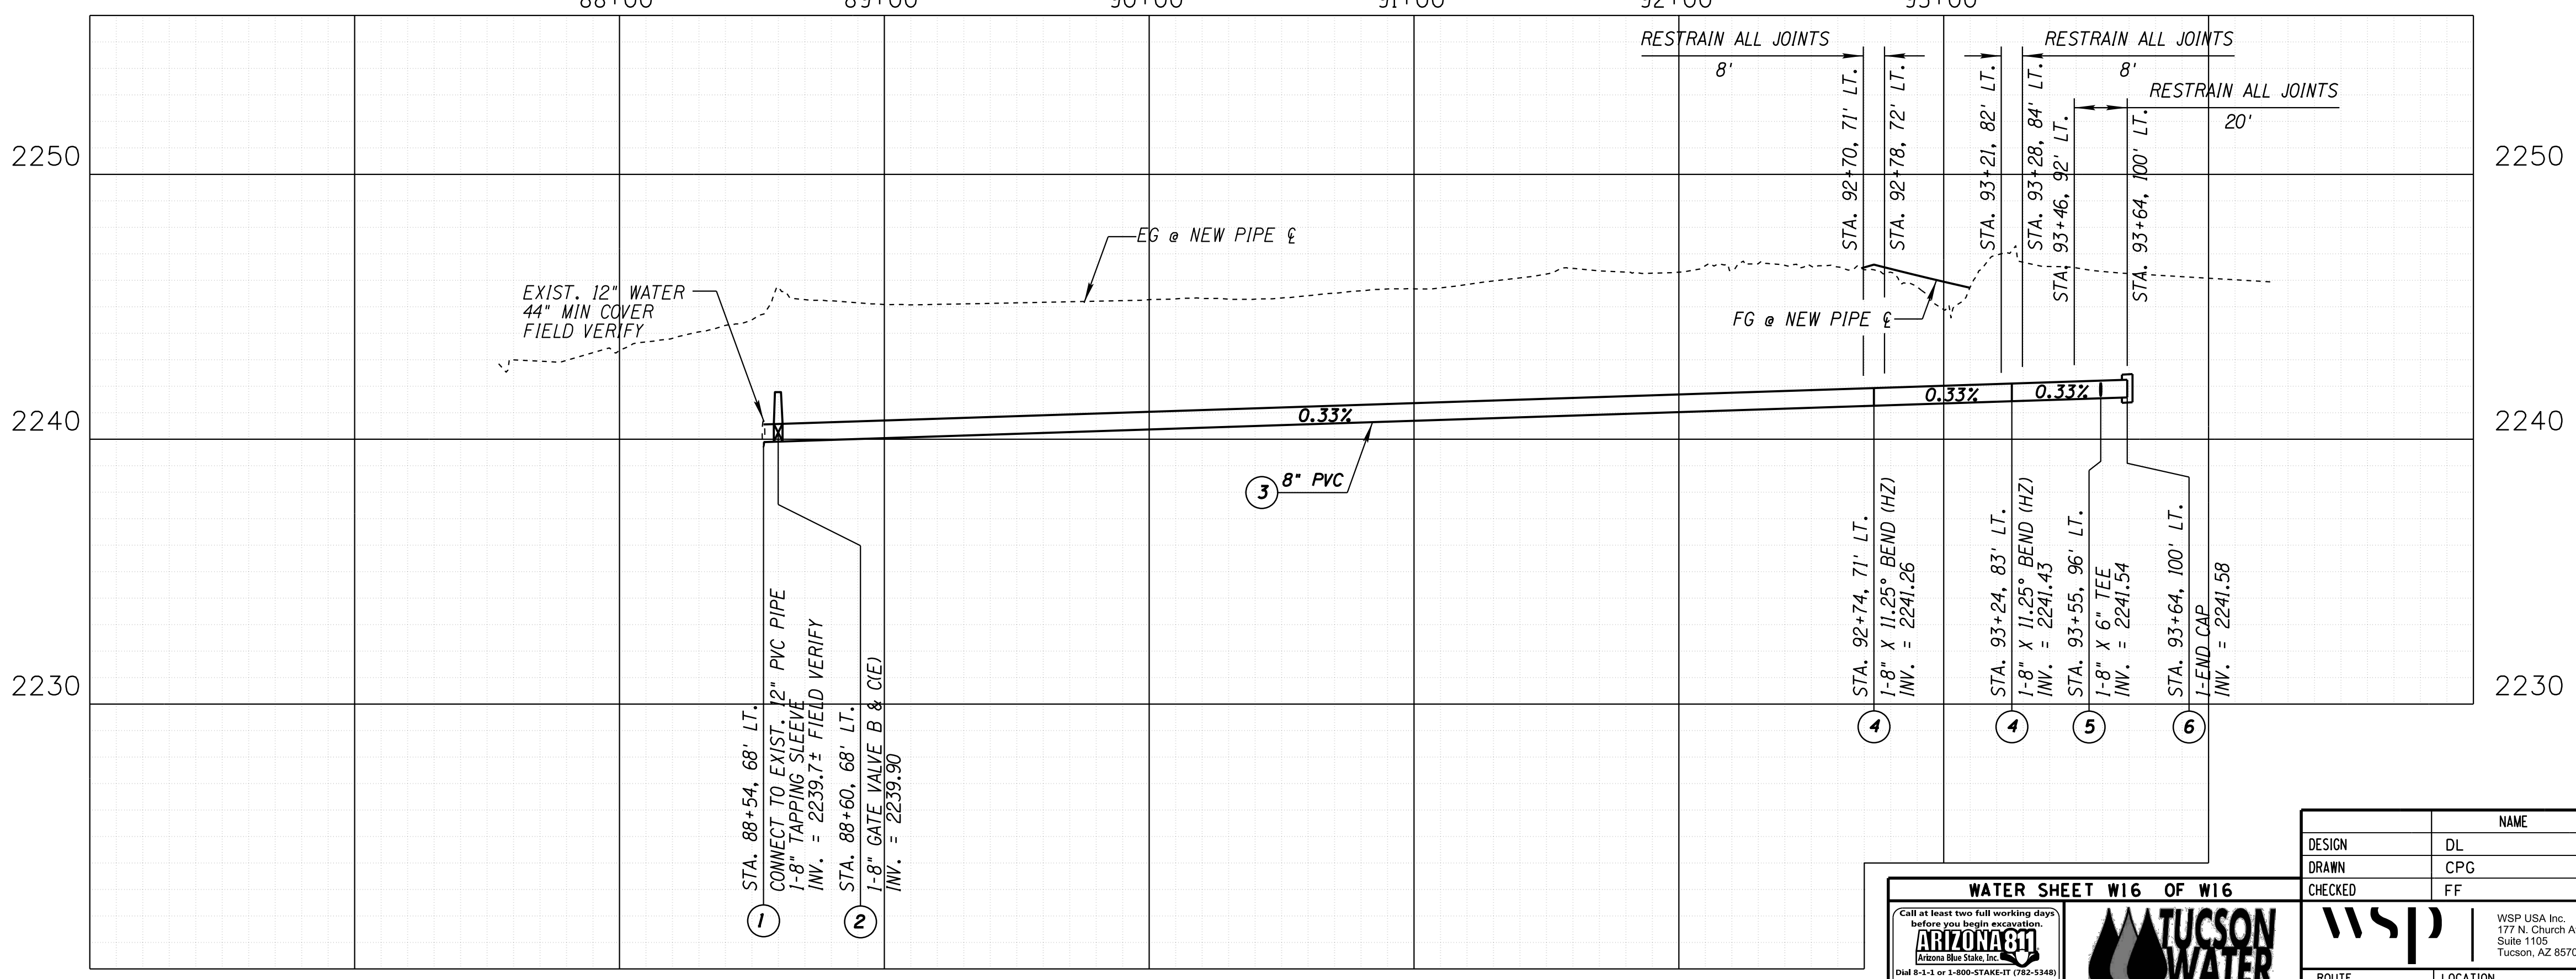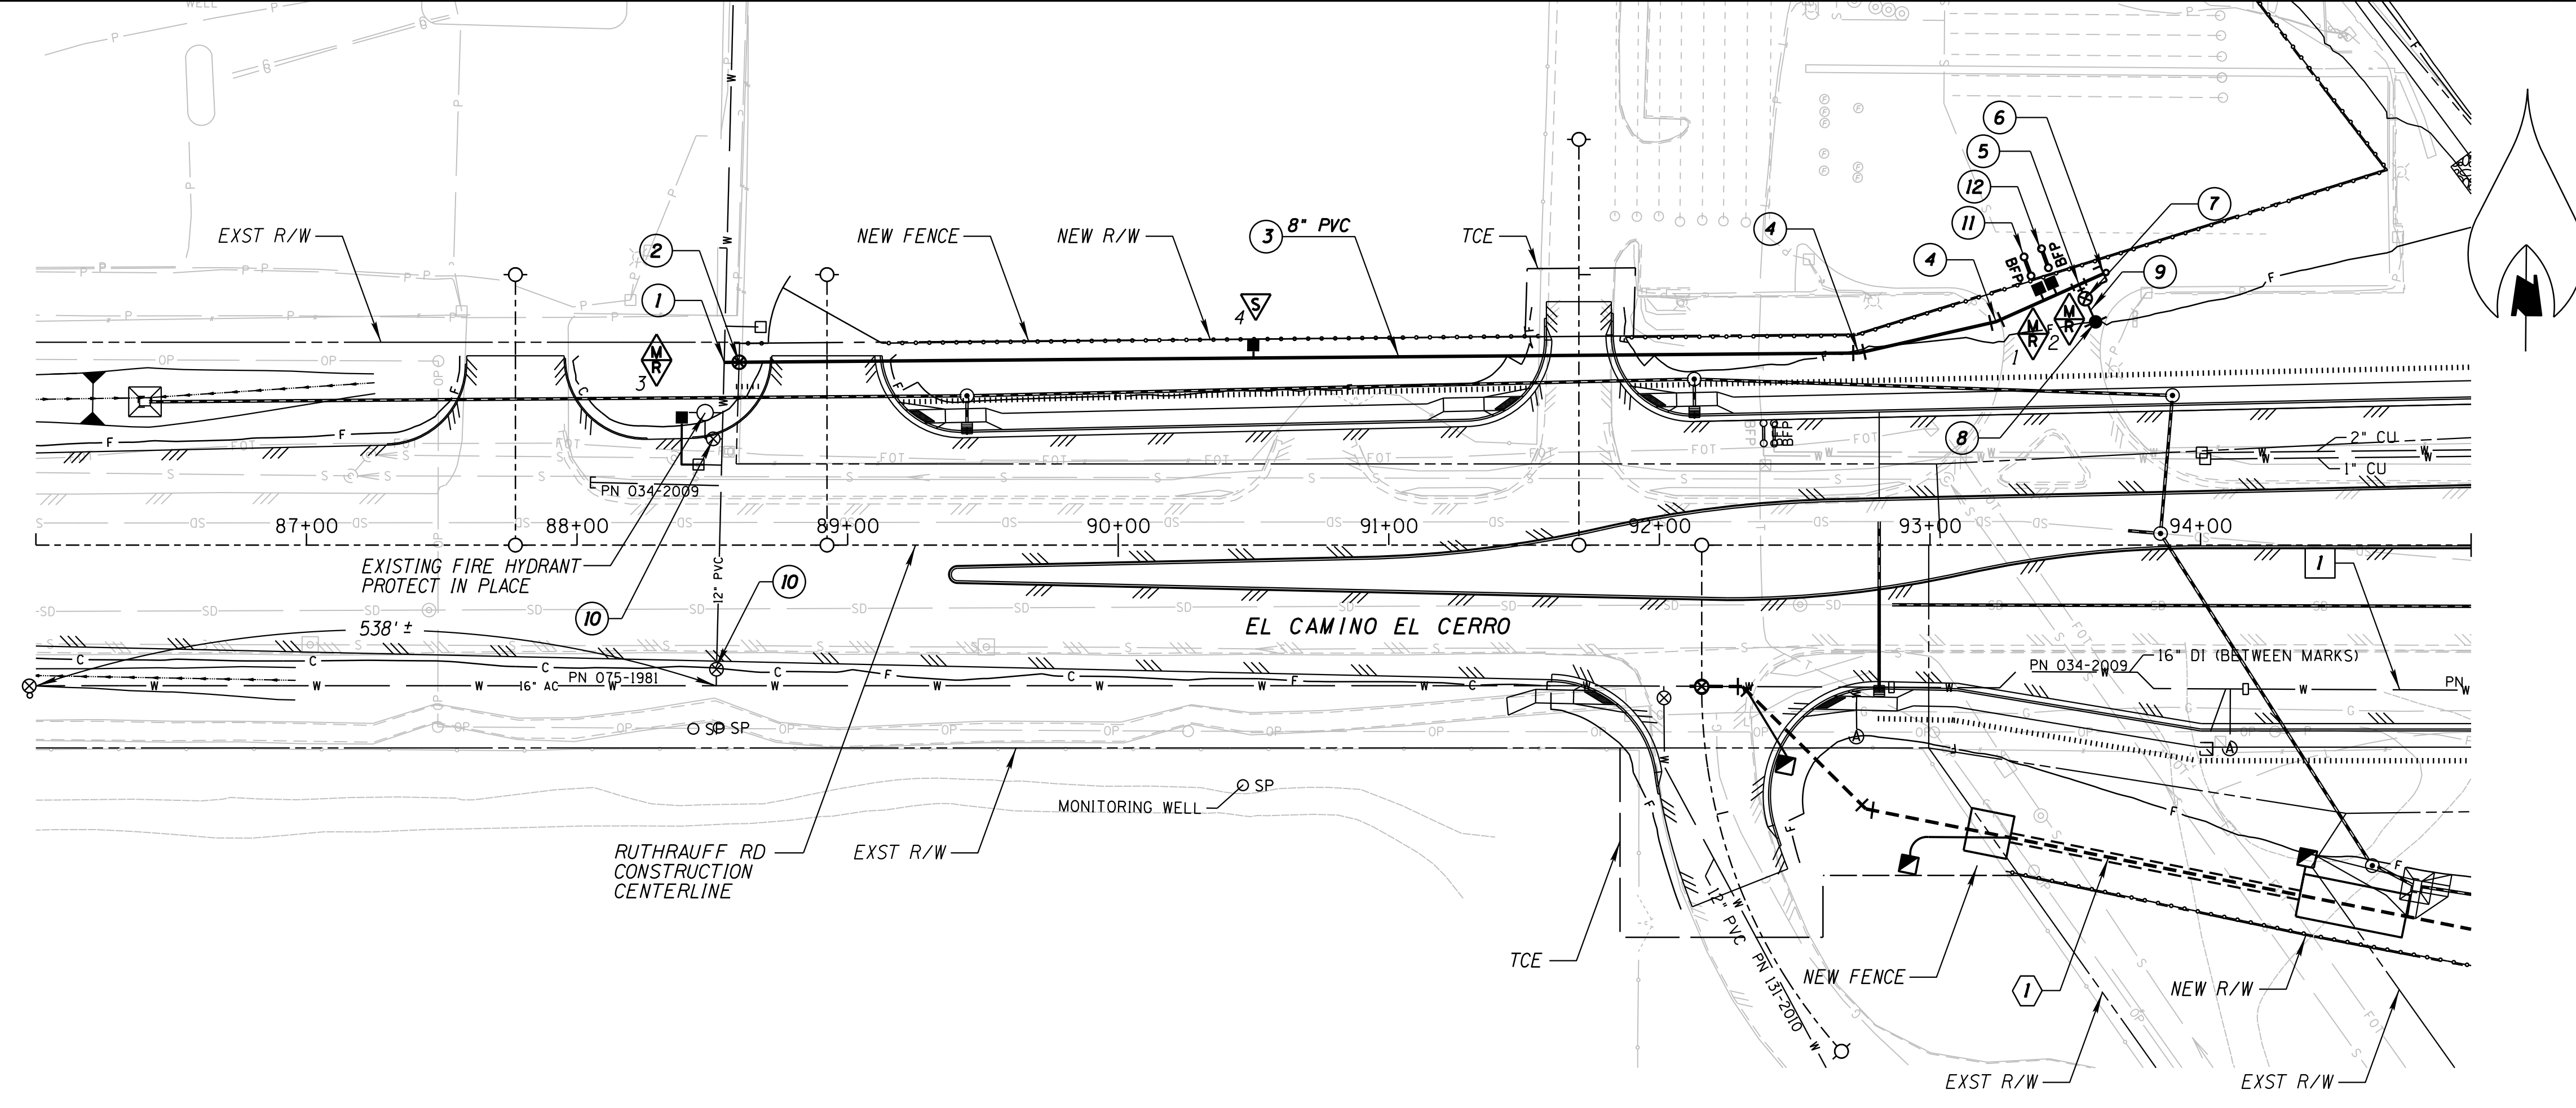

VERT: 1" = 4'  
HORIZ: 1" = 40'

NO.	DATE	REVISION	BY	CHKD.	APPR.

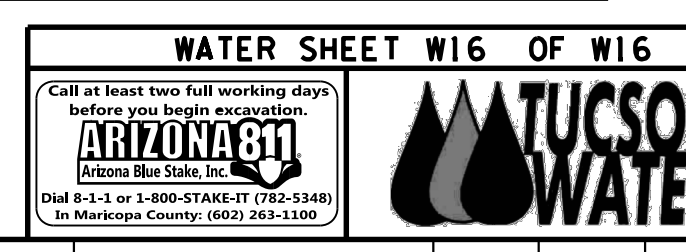

DESIGN	DL	DATE
DRAWN	CPG	3-19
CHECKED	FF	3-19



ROUTE 1-10 LOCATION RUTHRAUFF ROAD TI

WSP USA INC. 177 N. Church Ave. Suite 1105 Tucson, AZ 85701



F.H.W.A. REGION	STATE	PROJECT NO.	SHEET NO.	TOTAL SHEETS	RECORD DRAWING
9	ARIZ.	010-D(213)S	831	849	

010 PM 252

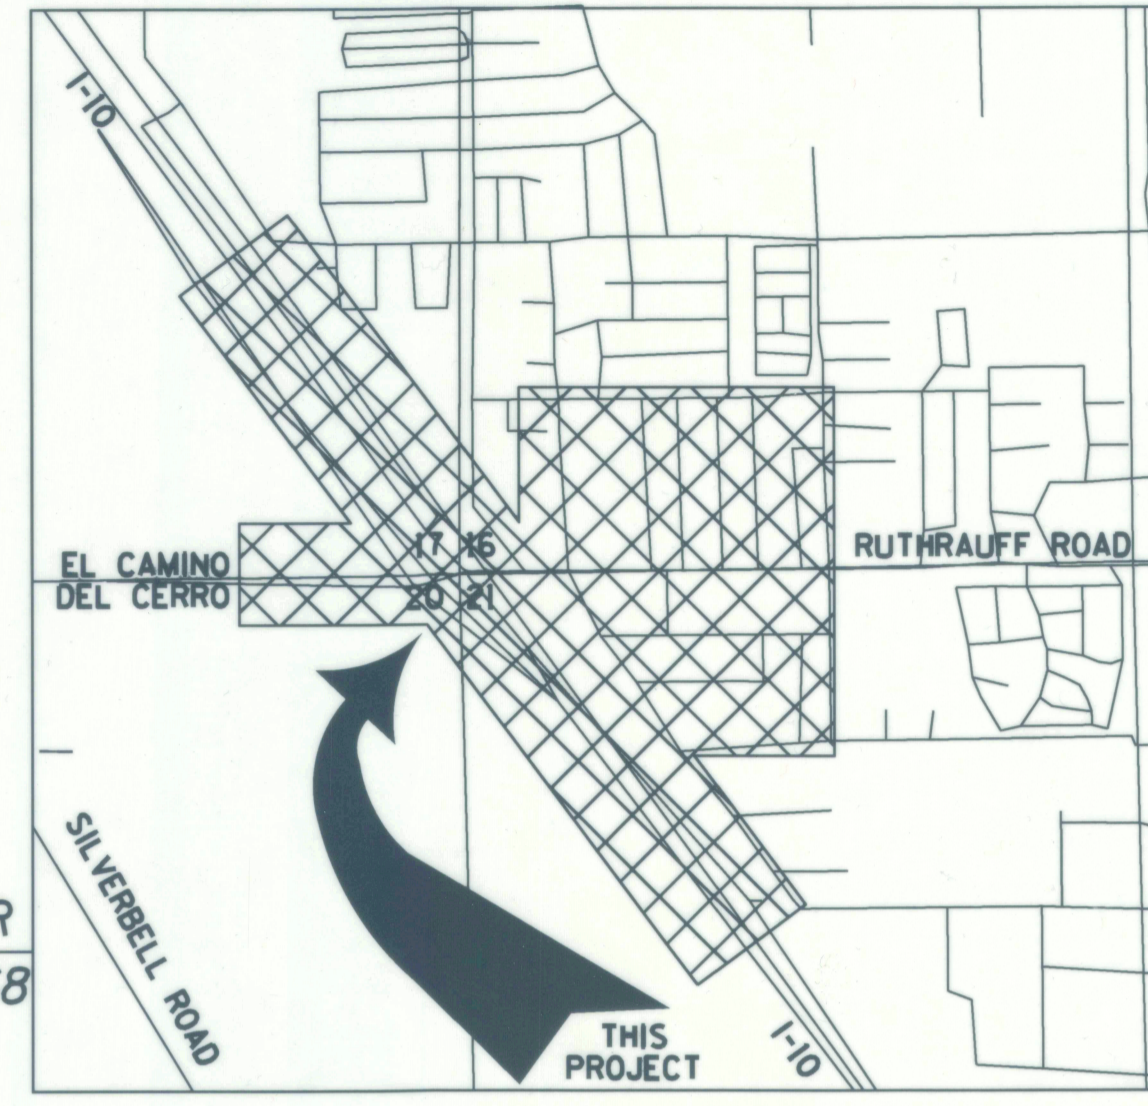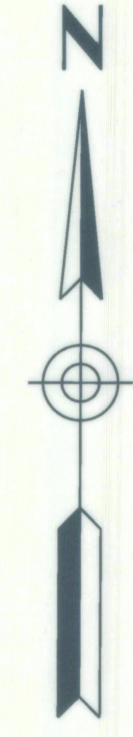

LOCATION MAP

SEC. 16, 17, 20 & 21, T13S, R13E  
G & S R M, PIMA COUNTY, ARIZONA  
LATITUDE 32°17'39" N  
LONGITUDE 111°01'48" W  
CITY OF TUCSON  
3" = 1 MILE

EXISTING MH  
SEE SHEET SS8

INDEX OF SHEETS

PAGE NO.	SHEET NO.	DESCRIPTION
831	SS1	COVER SHEET
832-833	SS2-SS3	GENERAL NOTES
834	SS4	FRAME AND COVER ADJUST
835	SS5	SEWER PLAN
836-838	SS6-SS8	PLAN & PROFILE
839-845	SS9-SS15	PCRWRD DETAIL SHEETS
846-847	SS16-SS17	FLOW MANAGEMENT
848-849	SS18-SS19	SEWER PIPE REMOVAL

BOARD OF SUPERVISORS

DISTRICT 1	ALLY MILLER	MEMBER
DISTRICT 2	RAMÓN VALADEZ	MEMBER
DISTRICT 3	SHARON BRONSON	MEMBER
DISTRICT 4	STEVE CHRISTY	MEMBER
DISTRICT 5	RICHARD ELÍAS	CHAIR

PIMA COUNTY REGIONAL WASTEWATER RECLAMATION DEPARTMENT


PIMA COUNTY DEPARTMENT OF TRANSPORTATION  
(For Sewer Locations In R/W ONLY) DATE

CITY OF TUCSON  
(For Sewer Locations In R/W ONLY) DATE

SHEET SSI OF SS19

ARIZONA DEPARTMENT OF TRANSPORTATION  
INFRASTRUCTURE DELIVERY AND OPERATIONS DIVISION  
ROADWAY DESIGN SERVICES

RUTHRAUFF ROAD  
SEWER MODIFICATION PLANS  
COVER SHEET

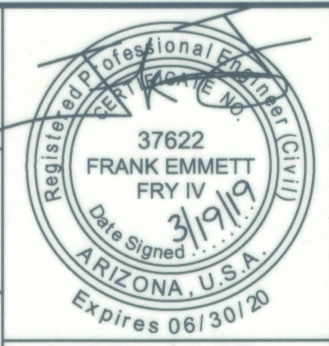

ROUTE I-10 LOCATION RUTHRAUFF ROAD T1

TRACS NO. H 8480 OIC 010-D(213)S


DWG NO. U-3.01 OF

# PIMA COUNTY REGIONAL WASTEWATER RECLAMATION DEPARTMENT

## RUTHRAUFF ROAD GRAVITY SEWER MODIFICATION PLANS

### I-10 AND RUTHRAUFF ROAD

#### PCRWRD G-2014-085

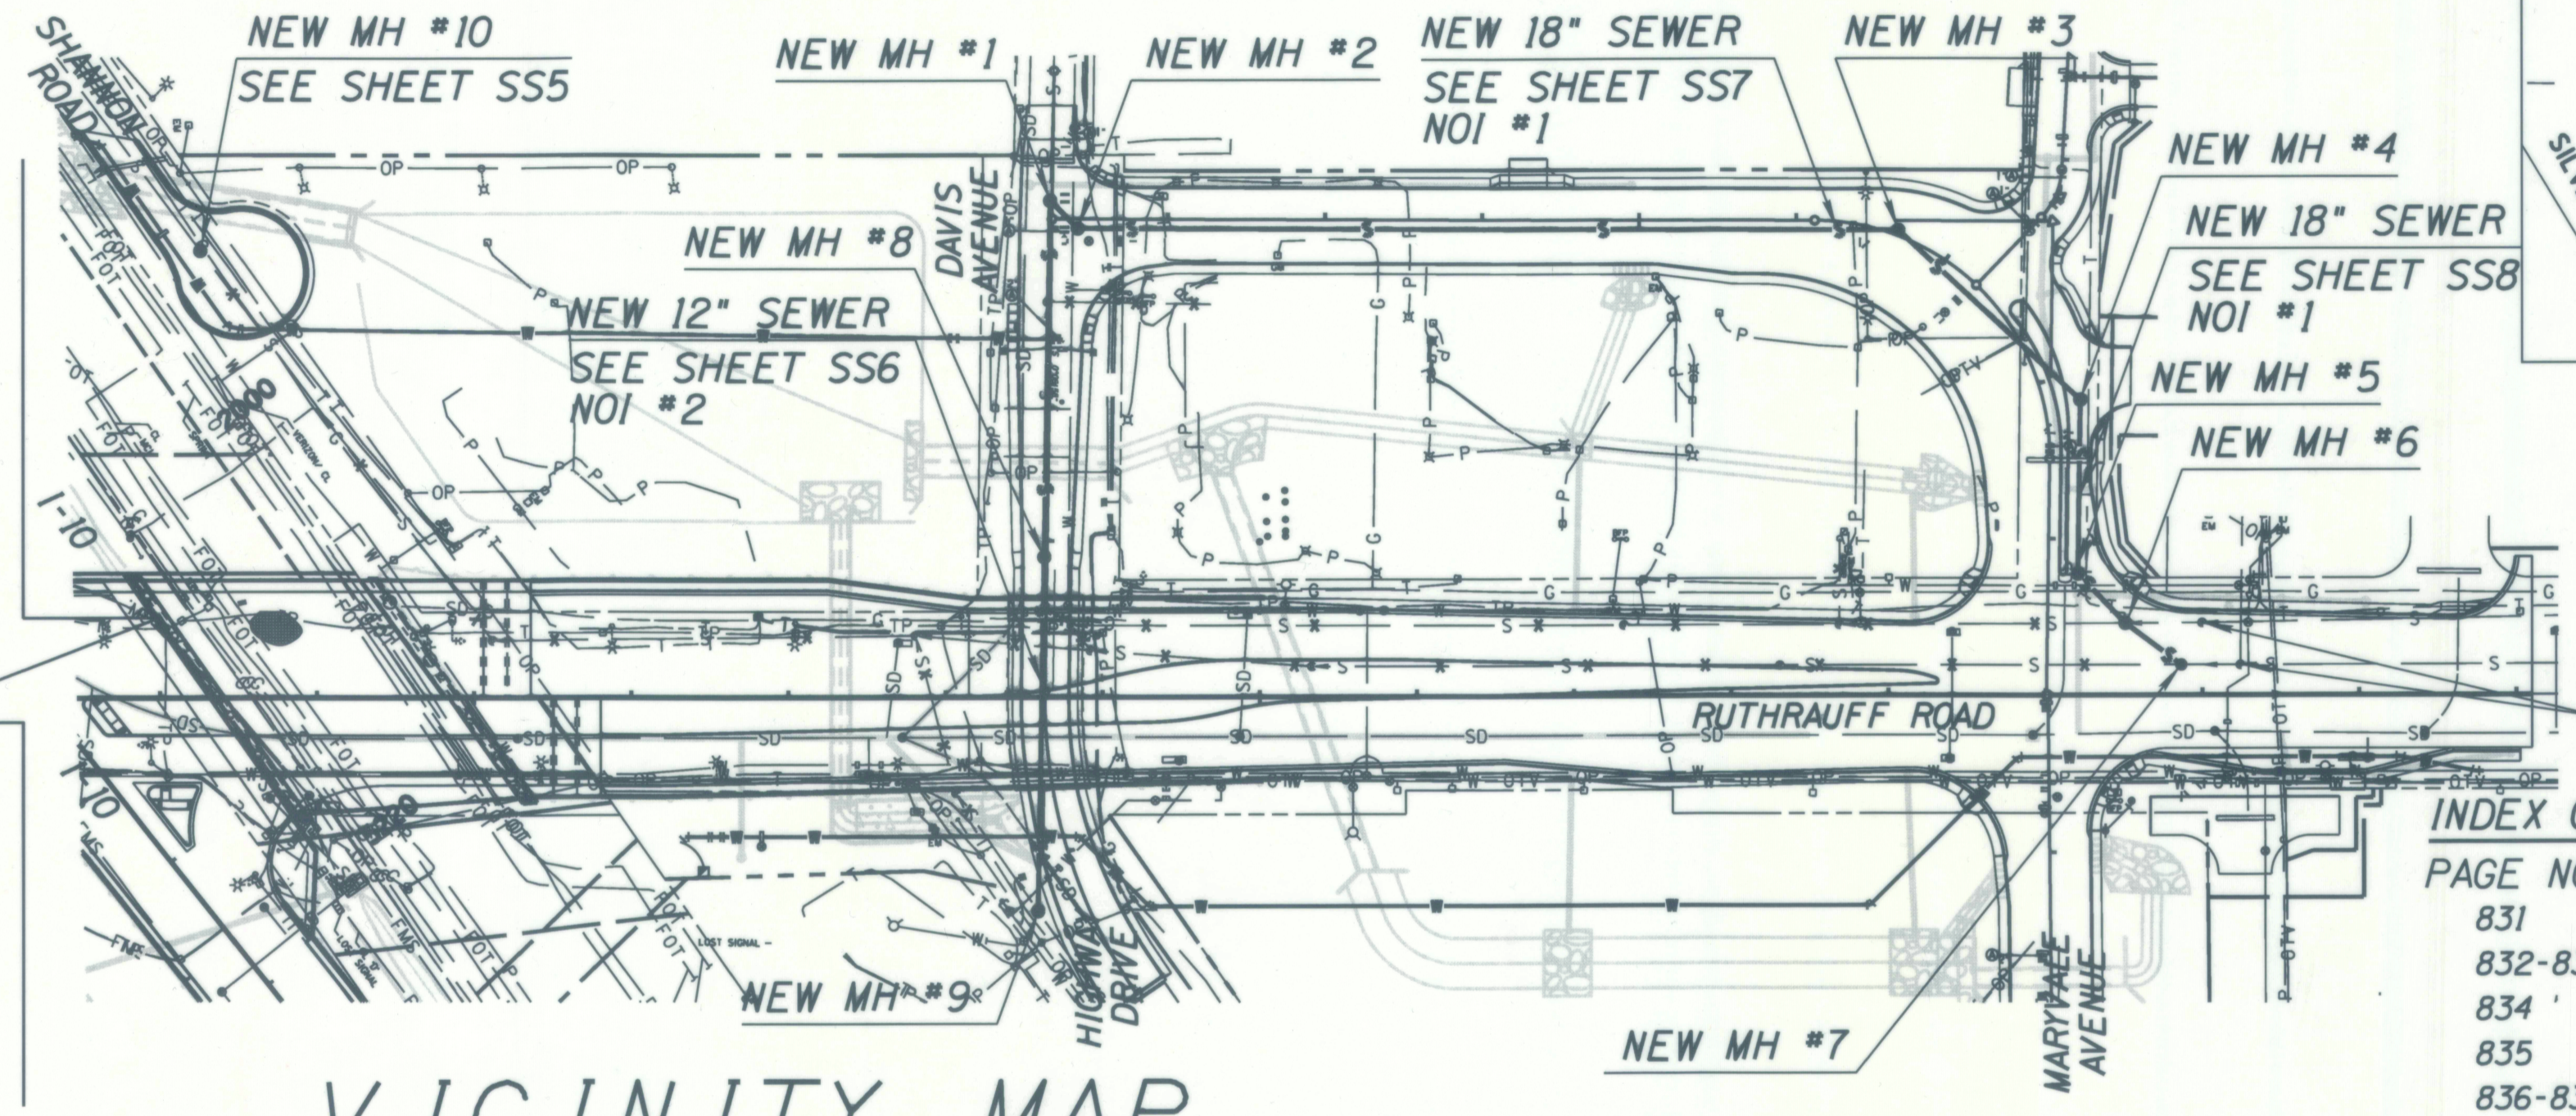

VICINITY MAP

1"=100'

ACCEPTED BY:  
PIMA COUNTY REGIONAL WASTEWATER RECLAMATION DEPARTMENT  
DIRECTOR  
*Jackson Jenkins* 3/27/19  
JACKSON JENKINS DATE

DEPUTY DIRECTOR, PLANNING AND ENGINEERING  
*Eric Wieduwilt* 3/27/19  
ERIC WIEDUWILT, PE DATE

DEPUTY DIRECTOR, CONVEYANCE  
*Jaime Rivera* 27 Mar 19  
JAIME RIVERA DATE

ORGANIZATION	PHONE NUMBER
TUCSON ELECTRIC POWER	(520) 918-8246
COX CABLE	(520) 629-8511
CENTURY LINK COMM.	(520) 292-7555
COMCAST CABLE	(520) 744-1900
TUCSON WATER	(520) 791-2648
PIMA COUNTY DOT	(520) 724-6367
SOUTHWEST GAS	(520) 794-6021

As-Built Certificate  
As-BUILT:  
I hereby certify that the As-Built annotations provided on these drawings were based on an As-Built survey conducted under my supervision and accurately depict existing field conditions to the best of my knowledge and belief.  
REGISTERED LAND SURVEYOR (OR REGISTERED P.E.) DATE  
CONTACT INFORMATION

DATE: \_\_\_\_\_ REVISIONS: \_\_\_\_\_ FINISHED PLANS: \_\_\_\_\_ SURVEY NO.: \_\_\_\_\_

G-2014-085



SEWER GENERAL NOTES

F.H.W.A. REGION	STATE	PROJECT NO.	SHEET NO.	TOTAL SHEETS	RECORD DRAWING
9	ARIZ.	010-D(213)S	832	849	

010 PM 252

1. BASIS OF BEARING: DESIGN INFORMATION BASED UPON AERIAL PHOTOGRAMMETRIC MAPPING SUPPLIED BY ADOT. PHOTOGRAMMETRY JOB NO. 3803 - AERIAL PHOTOGRAPHY DATED OCTOBER 29, 2008. SEE SURVEY CONTROL SHEETS (C-1.01 TO C-1.02) AND GEOMETRIC DATA SHEETS (C-2.01 TO C-2.12).
2. VERTICAL DATUM: ELEVATION BASED UPON NAVD 88.  
  
MAP COORDINATES ARE NAD 83/92 MODIFIED CENTRAL ZONE STATE PLANE COORDINATES USING G.A.F. = 1.00016. SEE SURVEY CONTROL SHEETS (C-1.01 TO C-1.02) AND GEOMETRIC DATA SHEETS (C-2.01 TO C-2.12).
3. ALL DESIGN STANDARDS, MATERIALS AND WORKMANSHIP FOR PUBLIC SANITARY SEWERS SHALL BE IN ACCORDANCE WITH THE PIMA COUNTY REGIONAL WASTEWATER RECLAMATION DEPARTMENT (PCRWRD) ENGINEERING DESIGN STANDARDS 2016 (EDS 2016) WITH JUNE 2017 UPDATES AND THE STANDARD SPECIFICATIONS AND DETAILS FOR CONSTRUCTION 2016 (SSDC 2016) WITH JUNE 2017 UPDATES. SAID DOCUMENTS ARE AVAILABLE THROUGH THE PCRWRD WEBSITE ([www.pima.gov/wastewaterreclamation](http://www.pima.gov/wastewaterreclamation)).
4. CONSTRUCTION LIMITS TO BE USED BY THE CONTRACTOR SHALL BE WITHIN THE RIGHT-OF-WAY & UTILITY EASEMENTS. THE CONTRACTOR, EXCEPT TO TRANSPORT EQUIPMENT & MATERIALS, SHALL CONFINE OPERATIONS TO WITHIN THESE LIMITS.
5. SEWER CONSTRUCTION SHALL NOT COMMENCE UNTIL: (A) THE ARIZONA DEPARTMENT OF ENVIRONMENTAL QUALITY (ADEQ) OR ITS DELEGATED AUTHORITY HAS ISSUED A CONSTRUCTION AUTHORIZATION FOR THIS PROJECT; (B) THE CONTRACTOR HAS OBTAINED A PCRWRD PUBLIC SEWER CONSTRUCTION PERMIT (CONTACT THE PCRWRD PERMITS SECTION AT (520) 724-6649 FOR PERMIT APPLICATION REQUIREMENTS); (C) THE CONTRACTOR'S FLOW MANAGEMENT PLAN HAS BEEN SUBMITTED THIRTY (30) CALENDAR DAYS PRIOR TO THE PRE-CONSTRUCTION MEETING AND APPROVED BY PCRWRD FIELD ENGINEERING; AND (D) A PRE-CONSTRUCTION MEETING WITH THE ASSIGNED PIMA COUNTY PROJECT FIELD INSPECTOR OR SCHEDULED AT LEAST THREE (3) FULL BUSINESS DAYS PRIOR TO COMMENCING WITH SEWER CONSTRUCTION.
6. IMMEDIATELY REPORT ANY OF THE FOLLOWING TO THE PCRWRD OPERATIONS CONTROL CENTER (OCC) AT (520) 724-6500: ANY RELEASE OF SEWAGE, ANY DAMAGE TO THE PUBLIC SANITARY SEWER SYSTEM, OR THE DROPPING OF DEBRIS INTO A PUBLIC SANITARY SEWER MANHOLE. A PCRWRD REPRESENTATIVE WILL BE DISPATCHED TO THE SITE. THE CONTRACTOR SHALL TAKE IMMEDIATE ACTION TO CONTAIN A SANITARY SEWAGE OVERFLOW (SSO). THE CONTRACTOR SHALL BE RESPONSIBLE FOR ALL COSTS TO REPAIR THE SYSTEM, MITIGATE THE RELEASE OF SEWAGE, DISINFECT THE RELEASE AREAS, AND ANY REGULATORY PENALTIES LEVIED ON PCRWRD FOR SEWAGE ENTERING A NATURAL DRAINAGE WAY OR STORM WATER DRAINAGE SYSTEM. THE CONTRACTOR SHALL REPAIR ALL DAMAGE AS DIRECTED AND APPROVED BY THE PCRWRD FIELD REPRESENTATIVE.
7. THE CONTRACTOR SHALL COMPLY WITH ALL APPLICABLE OCCUPATIONAL SAFETY & HEALTH ADMINISTRATION (OSHA) REGULATIONS AT ALL TIMES.
8. THE CONTRACTOR SHALL CONTACT "ARIZONA 811" (DIAL 1-800-782-5348) A MINIMUM OF TWO (2) BUSINESS DAYS PRIOR TO COMMENCING CONSTRUCTION ACTIVITIES. THE CONTRACTOR SHALL KEEP ALL UNDERGROUND FACILITY LOCATION REQUESTS UP-TO-DATE AND COMPLY WITH ARIZONA REVISED STATUTES (A.R.S.), TITLE 40, CHAPTER 1, ARTICLE 6.3, SECTION 40-360.22. CONCERNS REGARDING THE ACCURACY BETWEEN THE UNDERGROUND FACILITY MARKINGS AND THE PROJECT PLANS SHALL BE IMMEDIATELY REPORTED TO THE DESIGN ENGINEER.
9. THE PCRWRD CONVEYANCE DIVISION SHALL BE NOTIFIED AT (520) 724-3400 A MINIMUM OF TWO (2) BUSINESS DAYS PRIOR TO COMMENCING ANY CONSTRUCTION ACTIVITIES THAT IMPACTS THE FLOW WITHIN A LIVE SANITARY SEWER SYSTEM OR INVOLVES CONNECTING TO A LIVE SANITARY SEWER. SEE PCRWRD SSDC 2016, SECTION 2 FOR MORE INFORMATION.
10. THE CONTRACTOR SHALL ADJUST OR RECONSTRUCT ALL SANITARY SEWER MANHOLES TO FINISHED GRADE. ALL FRAMES AND COVER ADJUSTMENTS SHALL BE IN ACCORDANCE WITH PCRWRD SSDC 2016, DETAIL NOS. RWRD 211, 212, 304 OR 305 (AS APPLICABLE). THE CONTRACTOR SHALL PROTECT THE BENCH AND FLOW CHANNELS WITH A COVER PER PCRWRD SSDC 2016, DETAIL NO. RWRD 306. PRIOR TO COMMENCING ANY WORK TO THE MANHOLE AND REMOVE THE COVER AFTER ALL WORK IS COMPLETED.

10. CONT. THE CONTRACTOR SHALL ENSURE THAT FRAMES AND COVERS ARE CLEAN AND FREE FROM ANY AND ALL ATTACHED MATERIALS (ASPHALT, CONCRETE, ETC.) AND THAT ALL VENT HOLES ARE OPEN AND CLEAR OF OBSTRUCTIONS, AS APPROVED BY THE PCRWRD FIELD ENGINEER. EXISTING FRAMES AND/OR COVERS THAT ARE DAMAGED OR CANNOT BE COMPLETELY CLEANED SHALL BE REPLACED WITH A NEW FRAME AND COVER IN ACCORDANCE WITH PCRWRD SSDC 2016, DETAIL NO. RWRD 213 - 218. COSTS ASSOCIATED WITH EXISTING FRAMES AND COVERS THAT ARE LOST OR DAMAGED DUE TO THE CONTRACTOR SHALL BE THE RESPONSIBILITY OF THE CONTRACTOR.
11. STORM WATER AND SEDIMENT CONTROL MEASURES SHALL BE PROPERLY INSTALLED TO PROTECT PCRWRD MANHOLES AT THE BEGINNING OF CONSTRUCTION. IT IS THE RESPONSIBILITY OF THE CONTRACTOR TO CONSTANTLY MAINTAIN STORM WATER AND SEDIMENT CONTROL MEASURES THAT PROTECT PCRWRD FACILITIES UNDER ALL CONDITIONS FOR THE DURATION OF THE PROJECT. UNDER NO CIRCUMSTANCES SHALL THE CONTRACTOR ALLOW STORM WATER, SEDIMENT, OR POTENTIAL POLLUTANTS FROM A CONSTRUCTION SITE TO ENTER A PCRWRD MANHOLE. THE CONTRACTOR SHALL ENSURE THAT THEIR FLOW MANAGEMENT OPERATIONS INCLUDE CONTROLS TO PREVENT ANY INTRODUCTION OF STORM WATER, SEDIMENT, OR POLLUTANTS INTO THE PUBLIC SANITARY SEWER SYSTEM. FAILURE TO CONFORM TO THESE REQUIREMENTS SHALL RESULT IN CANCELLATION OF THE SEWER CONSTRUCTION PERMIT.
12. SPECIAL CARE SHALL BE TAKEN TO ENSURE DESIGN SLOPES ARE MAINTAINED. SEWERS CONSTRUCTED AT INSUFFICIENT SLOPES WILL NOT BE ACCEPTED BY PCRWRD FIELD ENGINEERING AND/OR ADEQ. CORRECTIVE ACTION, INCLUDING RE-CONSTRUCTION OF THE SEWER(S), WILL BE AT THE SOLE EXPENSE OF THE PROJECT OWNER/CONTRACTOR.
13. WHERE CONNECTIONS TO EXISTING MAHOLES ARE TO BE MADE, THE CONTRACTOR SHALL CONSTRUCT NEW INVERTS IN THE EXISTING BASE TO SMOOTHLY DIRECT THE FLOW IN THE PROPER DIRECTION.
14. THE WORDS "PIMA COUNTY SANITARY SEWER" SHALL BE IMPRINTED ONLY ON COVERS OF MANHOLES WHICH ARE TO BE PART OF THE PIMA COUNTY REGIONAL WASTEWATER RECLAMATION (PUBLIC) SANITARY SEWER CONVEYANCE SYSTEM.
15. ALL DISTURBED AREAS SHALL BE REGRADED TO PROVIDE POSITIVE DRAINAGE PATTERNS. WORK SHALL BE CONSIDERED INCIDENTAL TO THE PROJECT WITH NO SEPARATE COMPENSATION PROVIDED.
16. NO REGULATORY FEMA FLOODPLAINS EXIST WITHIN THE PROJECT LIMITS. THE PROJECT IS LOCATED ENTIRELY WITHIN ZONE X.
17. SEE SHEET SS17 & SS18 FOR ADDITIONAL REMOVAL OF SEWER PIPE.

ADEQ NOTES

1. ALL SEWER LINES SHALL BE COVERED WITH AT LEAST 4 FEET OF BACKFILL PER PIMA COUNTY REGIONAL WASTEWATER RECLAMATION DEPARTMENT (PCRWRD).
2. THE FULL LENGTH OF SEWER MAIN SHALL BE DEFLECTION TESTED PER A.A.C. R18-9-E301 (D) (2) (i).
3. EACH SEGMENT OF THE SEWER MAIN SHALL BE LEAKAGE TESTED PER A.A.C. R18-9-E301 (D) (2) (j).
4. THE FULL LENGTH OF SEWER MAIN SHALL BE TESTED FOR UNIFORM SLOPE PER A.A.C. R18-9-E301 (D) (2) (k).
5. ALL MANHOLES SHALL BE DESIGNED PER A.A.C. R18-9-E301 (D) (3) (c) AND THE PCRWRD.
6. ALL MANHOLES SHALL BE LEAK TESTED PER A.A.C. R18-9-E301 (D) (3) (e).

FLOW MANAGEMENT GENERAL NOTES


1. THE CONTRACTOR SHALL PROVIDE THE FINAL FLOW MGMT PLAN FOR THE PROJECT FOR REVIEW AND APPROVAL BY THE PCRWRD FIELD ENGINEERING MANAGER. THE WASTEWATER FLOW MGMT GUIDELINES PROVIDED HEREIN SHALL NOT SERVE AS THE APPROVED FLOW MANAGEMENT PLAN.
2. FOR THE DURATION OF ALL PUMPING, THE CONTRACTOR WILL PROVIDE CONTINUOUS PUMP WATCH BY TRAINED AND QUALIFIED PUMP PERSONNEL, WHO SHALL MONITOR PUMPS, FUEL SOURCE, HIGHLINES, FLOW THROUGH PLUGS, FITTINGS AND APPURTENANCES, SURCHARGING AT IMMEDIATE UPSTREAM MANHOLES, AND ALL EQUIPMENT ASSOCIATED WITH THE BYPASS PUMPING OPERATION.
3. A 1/2 INCH PLYWOOD COVER, PER RWRD 306, SHALL BE USED INSIDE THE MANHOLES TO COVER THE OPEN PIPE WHILE BEING STACKED.
4. THE PUMPS AND BACKUP PUMPS SHALL BE CAPABLE OF PUMPING THE PEAK DRY WEATHER FLOW AT A TOTAL DYNAMIC HEAD AS SHOWN IN THE FLOW AND PUMP DATA TABLE PROVIDED ON THIS SHEET. IT IS THE CONTRACTOR'S RESPONSIBILITY TO ASSURE THAT THE MINIMUM SUCTION HEAD (NPSH) IS SATISFIED.
5. SUFFICIENT FUEL SHALL BE STORED ON-SITE TO ACCOMMODATE 24 HOURS CONTINUOUS PUMPING AT FULL DUTY CYCLE. FUEL SHALL BE STORED USING DOUBLE WALL UL2085 CONTAINERS, INCLUDING SPILL CONTAINMENT. FUEL STORAGE SHALL BE OSHA SAFE. FUEL CONTAINMENT SHALL BE PROTECTED FROM RUNOFF RESULTING FROM STORM EVENTS.
6. PUMPS DISCHARGE TO BYPASS IN GENERAL CONFORMANCE WITH APPROVED FLOW MANAGEMENT PLAN, PUMPS AND SUCTION PIPING SHALL BE PROTECTED USING CONCRETE BARRIERS OR OTHER APPROVED CONTROL SECURED BY THE CONTRACTOR.
7. CONTRACTOR SHALL VERIFY FLOWS INTO THE EXISTING 18" SEWER IN DAVIS AVENUE PRIOR TO SUBMITTING THE FINAL FLOW MGMT PLAN TO THE THE ENGINEER FOR REVIEW AND APPROVAL.
8. ALL PIPING AND PUMP CONNECTIONS SHALL BE PRESSURE TESTED USING FRESH WATER TO 60 POUNDS PER SQUARE INCH PRIOR TO CONNECTION TO THE FLOW THROUGH PLUGS AND TO OPERATION OF THE PUMP(S).
9. ALL WORK PERFORMED SHALL BE IN ACCORDANCE WITH THE APPROVED PLANS AND SPECIFICATIONS. ALL EXCAVATION WITHIN 2 FT. OF A LIVE SEWER SHALL BE COMPLETED BY HAND.
10. PER RWRD SSDC 2.7.5, AT LEAST 6 GALLONS OF 12.5% LIQUID SODIUM HYPOCHLORITE SOLUTION WILL BE ON-SITE FOR 12-INCH OR LESS, AND 50 GALLONS FOR ANYTHING LARGER THAN 12-INCH.
11. PCRWRD SHALL NOT BE HELD LIABLE OR RESPONSIBLE FOR ANY ERRORS AND OR OMISSIONS ON THE FMP. ITEMS NOT MEETING PIMA COUNTY STANDARDS SHALL BE REPAIRED OR REPLACED AT NO COST TO THE DEPARTMENT.
12. THE CONTRACTOR SHALL PROVIDE ONE LANE IN EACH DIRECTION OF TRAVEL ON ANY ACTIVE ROADWAY FOR THE DURATION OF ALL BYPASS PUMPING. LANE CLOSURES MUST BE APPROVED BY THE ENGINEER PRIOR TO THE INSTALLATION OF THE BYPASS EQUIPMENT.
13. THE CONTRACTOR SHALL PLACE PUMPS AND SPILL PREVENTION MATERIALS NEAR THE UPSTREAM MANHOLE, ON A FLAT AREA CLEAR OF TRAFFIC AND/OR CONSTRUCTION ACTIVITIES. THE CONTRACTOR'S FINAL FMP SHALL CLEARLY DEPICT THESE LOCATIONS.

SHEET SS2 OF SS19

DESIGN	DL	DATE	3-19	ARIZONA DEPARTMENT OF TRANSPORTATION INFRASTRUCTURE DELIVERY AND OPERATIONS DIVISION ROADWAY DESIGN SERVICES
DRAWN	CPG	DATE	3-19	
CHECKED	FF	DATE	3-19	
ROUTE		LOCATION		RUTHRAUFF ROAD SEWER MODIFICATION PLANS GENERAL NOTES
I-10		RUTHRAUFF ROAD TI		
TRACS NO. H 8480 OIC			010-D(213)S	
NO. DATE REVISION			BY CHKD. APPR.	



WSP USA Inc.  
177 N. Church Ave.  
Suite 1105  
Tucson, AZ 85701

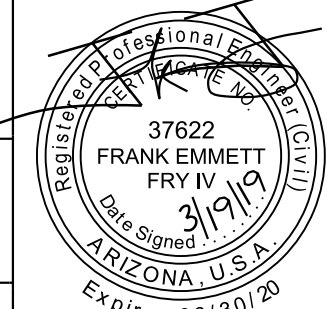

G-2014-085

F.H.W.A. REGION	STATE	PROJECT NO.	SHEET NO.	TOTAL SHEETS	RECORD DRAWING
9	ARIZ.	010-D(213)S	833	849	

010 PM 252

MANHOLE AS-BUILT INFO		
MH NO.	STATE PLANE COORDINATES (AZ CENTRAL) NAD 83/92 INTERNATIONAL FEET	
	NORTHING	EASTING
MH# 1		
MH# 2		
MH# 3		
MH# 4		
MH# 5		
MH# 6		
MH# 7		
MH# 8		
MH# 9		
MH# 10		

HCS AS-BUILT INFO				
PARCEL NO.	STATE PLANE COORDINATES (AZ CENTRAL) NAD 83/92 INTERNATIONAL FEET AT CLEANOUT		DISTANCE FROM TAP TO DOWNSTREAM MANHOLE	SEWER LINE STATIONING AT HCS/BCS CONNECTION
	NORTHING	EASTING		

**FORCE MAIN MONUMENT NOTES:**

1. THE CONTRACTOR SHALL DOCUMENT BY STATION & OFFSET AND BY GPS COORDINATES THE EXISTING FORCE MAIN (FM) MONUMENTS PRIOR TO PAVEMENT REMOVAL. THE CONTRACTOR SHALL PROVIDE FM MONUMENT LOCATION DOCUMENTATION TO PCRWRD. THE SURVEY GPS DATA SHALL BE IN THE MOST RECENT STATE PLANE COORDINATES (NAD 1983 STATE PLANE ARIZONA CENTRAL) AND WILL BE GATHERED USING SURVEY QUALITY EQUIPMENT, AND ACCURATE TO WITHIN 0.5- FEET. THE BASIS OF COORDINATES WILL BE INCLUDED. THE DATA WILL BE CATEGORIZED BY STREET SEGMENT AND LABELED WITH STREET NAMES AND SUPPLIED AS RAW DATA IN TEXT FORMAT, IN AN EXCEL WORKBOOK AND AUTOCAD DWG FORMAT. THE FORMAT SHALL INCLUDE COORDINATES IN NORTHINGS AND EASTINGS AS WELL AS BY STATION AND OFFSET. EACH POINT SHALL CONTAIN A DESCRIPTION OF THE SURVEY MONUMENT.
2. POT HOLE AND REFERENCE PER NOTE 1 THE LOCATIONS OF THE 8" FORCE MAIN (FM) INDICATED ON SHEET U-3.04, INCLUDING THE ELBOWS AT NEW MONUMENT NUMBERS 2 AND 7.
3. THE CONTRACTOR SHALL PROVIDE SWING TIE REFERENCE POINTS THAT WILL REMAIN UNDISTURBED FOR THE DURATION OF THE PROJECT, OR OTHER METHODS, IN ORDER TO AID IN THE LOCATION AND MARKING (BLUE-STAKE) OF THE PUBLIC FORCE MAIN SEWER DURING CONSTRUCTION.
4. THE CONTRACTOR SHALL FURNISH AND INSTALL NEW ELECTRONIC MARKER BALLS ABOVE THE FORCE MAIN SEWER AT LOCATION OF FORCE MAIN MONUMENTS, NO DEEPER THAN 3' FROM FINISH GRADE OF THESE PROJECT IMPROVEMENTS.
5. THE CONTRACTOR SHALL FURNISH AND INSTALL FORCE MAIN MONUMENTS ABOVE THE FORCE MAIN SEWER AND ELECTRONIC MARKER BALLS PER STANDARD DETAIL RWRD 503 AT ANY ANGLE POINTS AND A MAXIMUM SPACING OF 250'.
6. THE WORK DESCRIBED ABOVE TO LOCATE EXISTING AND PLACE NEW FM MONUMENTS AND TO INSTALL NEW ELECTRONIC MARKER BALLS SHALL BE PAID FOR BY BID ITEM NO. 9090005, SURVEY MONUMENT (FORCE MAIN MONUMENT) (RWRD 503) (WITH MARKER BALL).

FORCE MAIN/ABANDONMENT MONUMENT							
EXST MONUMENT NO.	NEW MONUMENT NO.	NORTHING	EASTING	ROAD	APPROX. STATION	OFFSET	COMMENTS
N/A	1	471984.10	972366.25	EL CAMINO DEL CERRO	81+48	20.93' LT	NEW
4	2	471929.74	972423.67	EL CAMINO DEL CERRO	82+05	33.85' RT	REPLACE EXISTING
3	3	471929.86	972670.60	EL CAMINO DEL CERRO	84+51	35.59' RT	REPLACE EXISTING
2	4	471930.48	972920.49	EL CAMINO DEL CERRO	87+01	36.86' RT	REPLACE EXISTING
1	5	471931.56	973170.36	EL CAMINO DEL CERRO	89+51	37.66' RT	REPLACE EXISTING
N/A	6	471932.96	973419.49	EL CAMINO DEL CERRO	92+00	38.14' RT	NEW
N/A	7	471930.68	973519.49	EL CAMINO DEL CERRO	93+00	41.18' RT	NEW

**NOTES:**

1. ALL FORCE MAIN MONUMENTS SHALL BE PER STANDARD DETAIL RWRD 503.
2. SEE SHEET U-3.04 FOR PLAN VIEW.


**MANHOLE LOCATING NOTES:**

1. THE CONTRACTOR SHALL GPS REFERENCE ALL SANITARY SEWER MANHOLES (CENTER OF BASES NOT THE CENTER OF THE FRAMES AND COVERS) WITH SURVEY QUALITY COORDINATES.
2. THE SURVEY GPS DATA SHALL BE IN THE MOST RECENT STATE PLANE COORDINATES (NAD 1983 STATE PLANE ARIZONA CENTRAL) AND WILL BE GATHERED USING SURVEY QUALITY EQUIPMENT, AND ACCURATE TO WITHIN 0.5- FEET. THE BASIS OF COORDINATES WILL BE INCLUDED. THE DATA WILL BE CATEGORIZED BY STREET NAMES AND SUPPLIED AS RAW DATA IN TEXT FORMAT, IN AN EXCEL WORKBOOK AND AUTOCAD DWG FORMAT. THE FORMAT SHALL INCLUDE COORDINATES IN NORTHINGS AND EASTINGS AS WELL AS BY STATION AND OFFSET. EACH POINT SHALL CONTAIN A DESCRIPTION OF THE MANHOLE.
3. THE CONTRACTOR WILL ASSIST PCRWRD WITH THE FIELD LOCATION (BLUE-STAKE) OF THE MANHOLES AND SEWER PIPE DURING CONSTRUCTION.
4. THE WORK DESCRIBED ABOVE SHALL BE INCIDENTAL TO THE WORK ITEMS DESCRIBED IN THE SEWER MODIFICATION PLANS.

G-2014-085

SHEET SS3 OF SS19

DESIGN	DL	DATE	3-19	ARIZONA DEPARTMENT OF TRANSPORTATION INFRASTRUCTURE DELIVERY AND OPERATIONS DIVISION <b>ROADWAY DESIGN SERVICES</b>  <b>RUTHRAUFF ROAD SEWER MODIFICATION PLANS GENERAL NOTES</b>	
DRAWN	CPG	DATE	3-19		
CHECKED	FF	DATE	3-19		
ROUTE		LOCATION		RUTHRAUFF ROAD TI	
1-10				DWG NO. U-3.03	
TRACS NO. H 8480 OIC			010-D(213)S		
			OF		

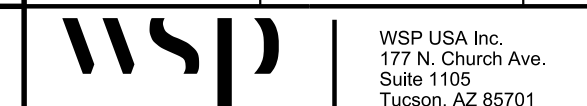


NO.	DATE	REVISION	BY	CHKD.	APPR.




F.H.W.A. REGION	STATE	PROJECT NO.	SHEET NO.	TOTAL SHEETS	RECORD DRAWING
9	ARIZ.	010-D(213)S	834	849	

010 PM 252

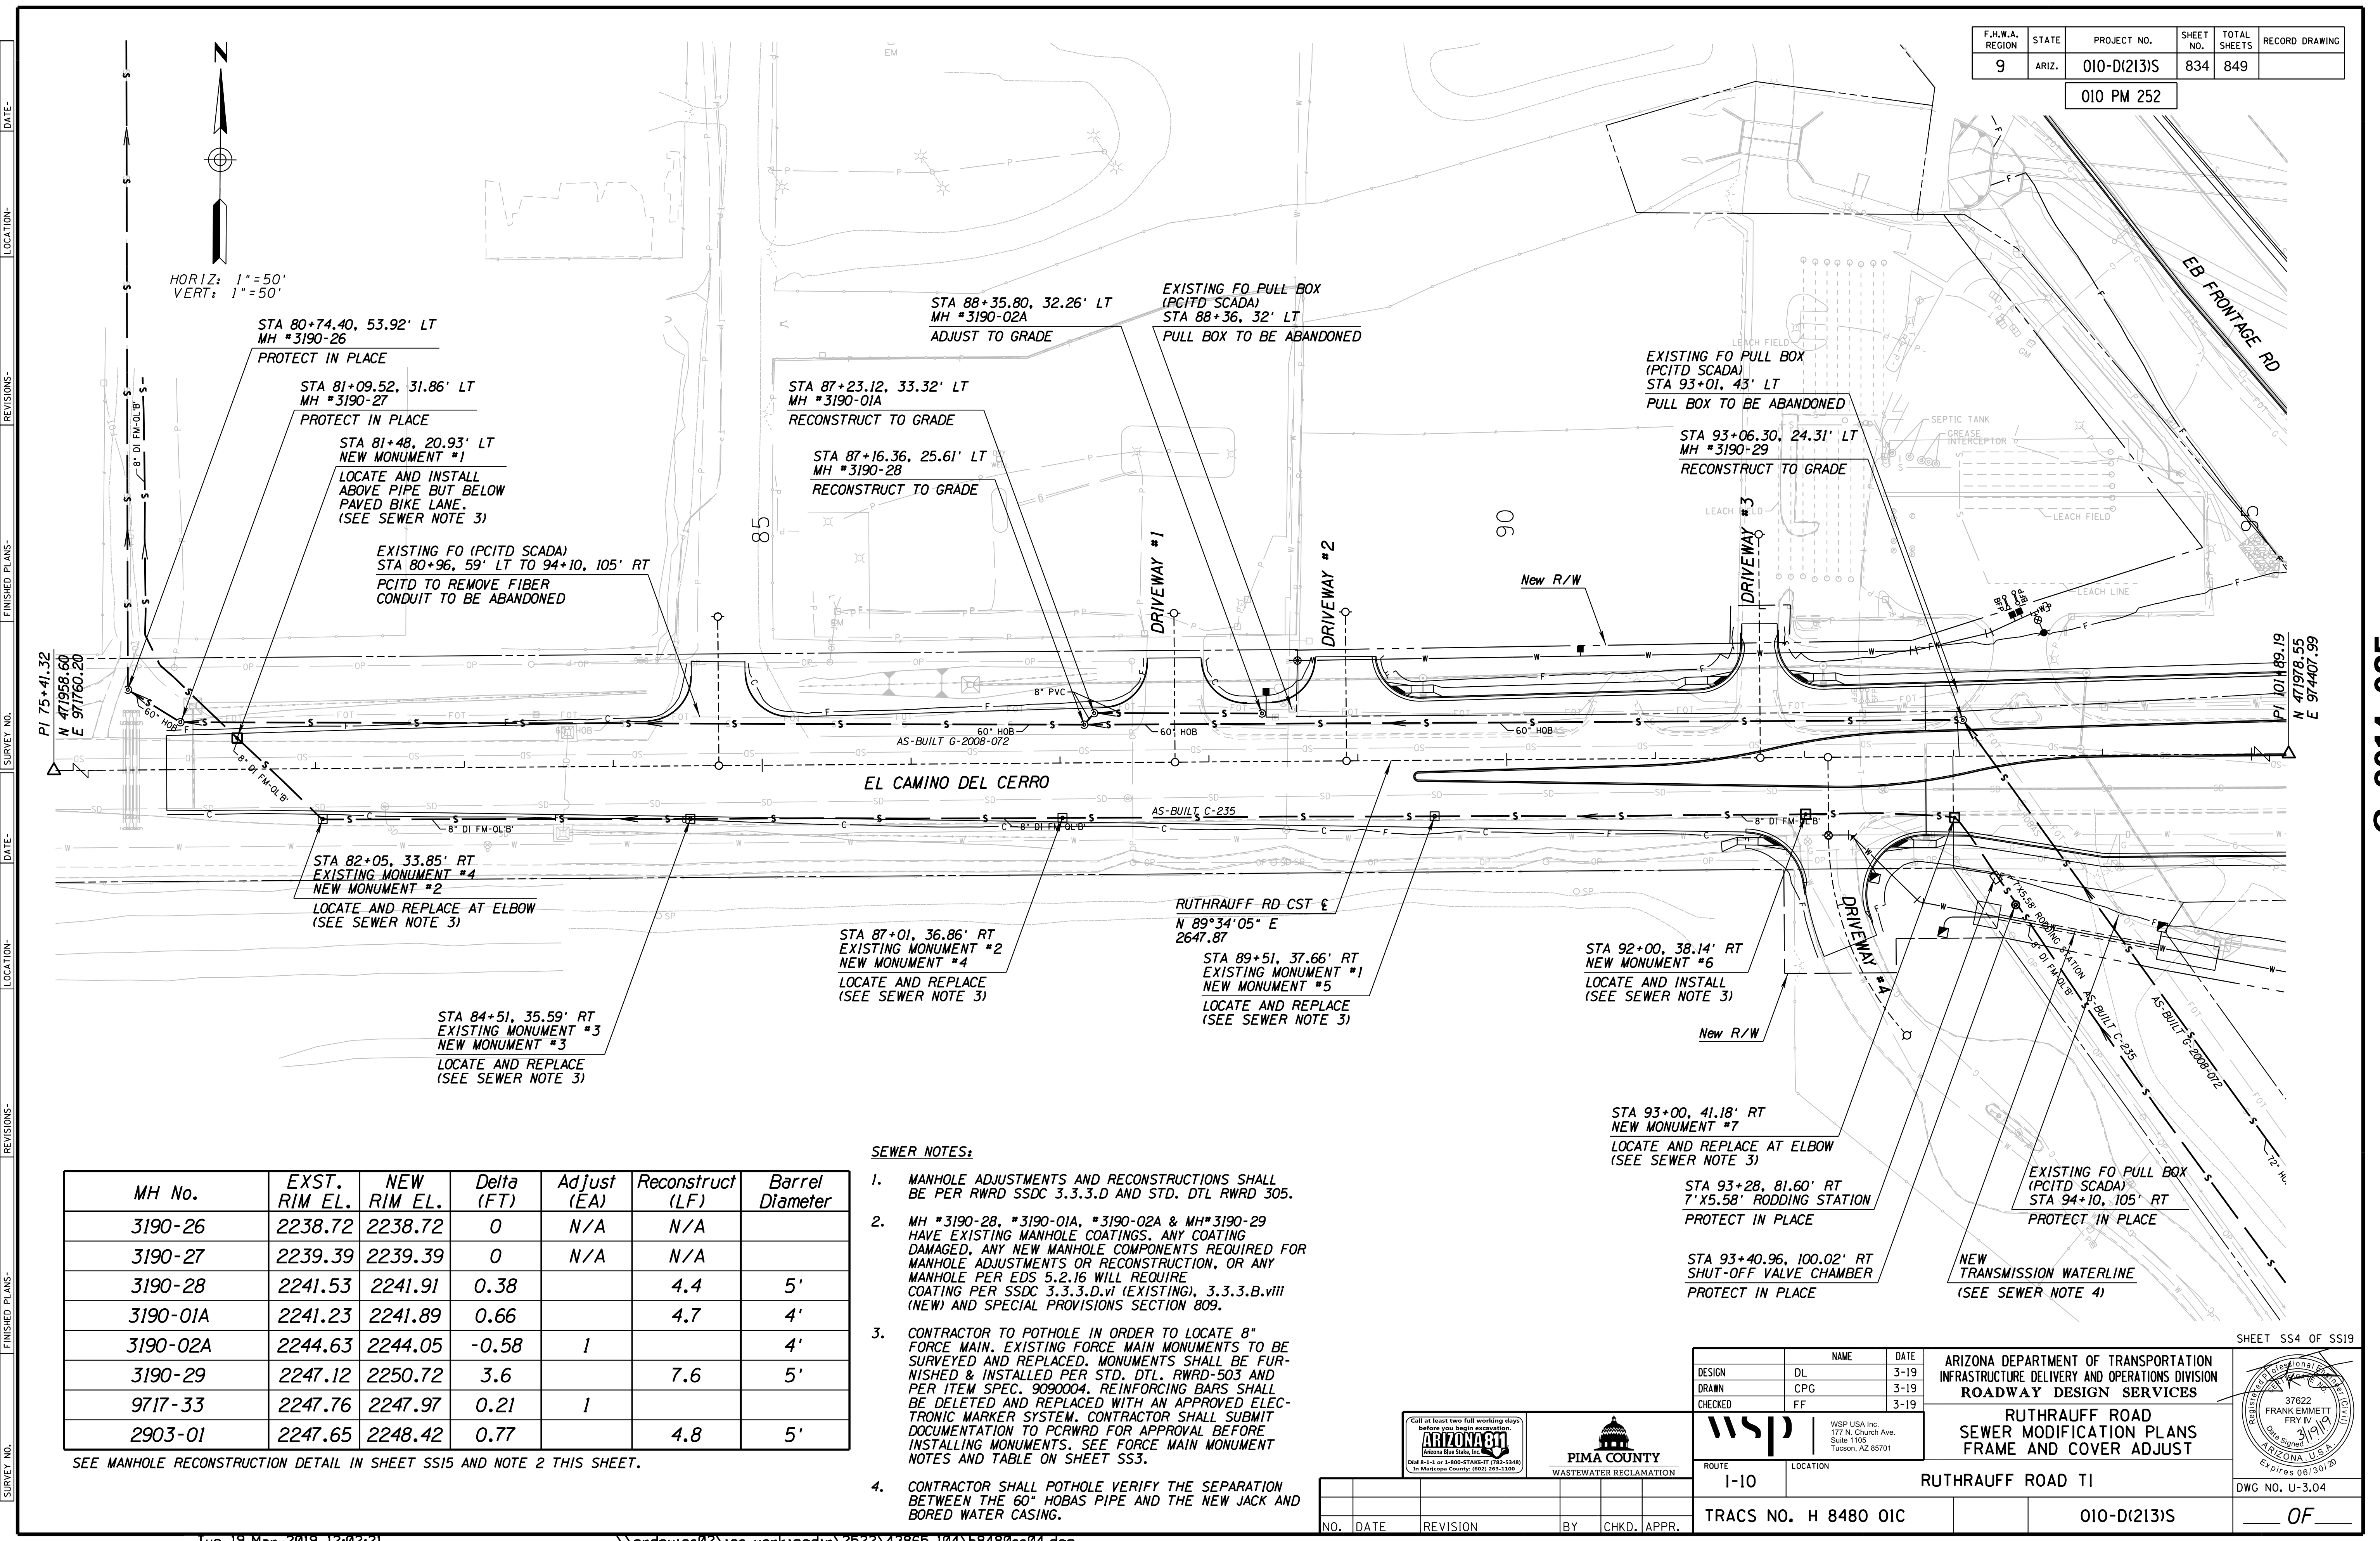

HORIZ: 1"=50'  
VERT: 1"=50'

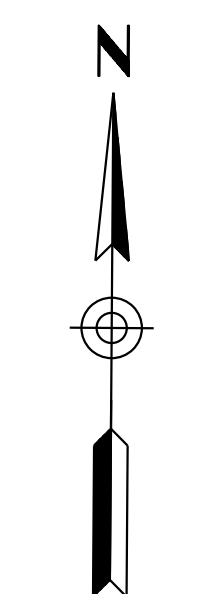

SURVEY NO. DATE REVISIONS FINISHED PLANS LOCATION DATE REVISIONS FINISHED PLANS LOCATION DATE REVISIONS FINISHED PLANS LOCATION DATE REVISIONS FINISHED PLANS LOCATION DATE REVISIONS FINISHED PLANS LOCATION

STA 80+74.40, 53.92' LT  
MH #3190-26  
PROTECT IN PLACE

STA 81+09.52, 31.86' LT  
MH #3190-27  
PROTECT IN PLACE

STA 81+48, 20.93' LT  
NEW MONUMENT #1  
LOCATE AND INSTALL ABOVE PIPE BUT BELOW PAVED BIKE LANE. (SEE SEWER NOTE 3)

EXISTING FO (PCITD SCADA)  
STA 80+96, 59' LT TO 94+10, 105' RT  
PCITD TO REMOVE FIBER CONDUIT TO BE ABANDONED

STA 87+23.12, 33.32' LT  
MH #3190-01A  
RECONSTRUCT TO GRADE

STA 87+16.36, 25.61' LT  
MH #3190-28  
RECONSTRUCT TO GRADE

STA 88+35.80, 32.26' LT  
MH #3190-02A  
ADJUST TO GRADE

EXISTING FO PULL BOX (PCITD SCADA)  
STA 88+36, 32' LT  
PULL BOX TO BE ABANDONED

EXISTING FO PULL BOX (PCITD SCADA)  
STA 93+01, 43' LT  
PULL BOX TO BE ABANDONED

STA 93+06.30, 24.31' LT  
MH #3190-29  
RECONSTRUCT TO GRADE

STA 82+05, 33.85' RT  
EXISTING MONUMENT #4  
NEW MONUMENT #2  
LOCATE AND REPLACE AT ELBOW (SEE SEWER NOTE 3)

STA 84+51, 35.59' RT  
EXISTING MONUMENT #3  
NEW MONUMENT #3  
LOCATE AND REPLACE (SEE SEWER NOTE 3)

STA 87+01, 36.86' RT  
EXISTING MONUMENT #2  
NEW MONUMENT #4  
LOCATE AND REPLACE (SEE SEWER NOTE 3)

RUTHRAUFF RD CST E  
N 89°34'05" E  
2647.87'

STA 89+51, 37.66' RT  
EXISTING MONUMENT #1  
NEW MONUMENT #5  
LOCATE AND REPLACE (SEE SEWER NOTE 3)

STA 92+00, 38.14' RT  
NEW MONUMENT #6  
LOCATE AND INSTALL (SEE SEWER NOTE 3)

STA 93+00, 41.18' RT  
NEW MONUMENT #7  
LOCATE AND REPLACE AT ELBOW (SEE SEWER NOTE 3)

STA 93+28, 81.60' RT  
7'x5.58' RODDING STATION  
PROTECT IN PLACE

STA 93+40.96, 100.02' RT  
SHUT-OFF VALVE CHAMBER  
PROTECT IN PLACE

EXISTING FO PULL BOX (PCITD SCADA)  
STA 94+10, 105' RT  
PROTECT IN PLACE

NEW TRANSMISSION WATERLINE  
(SEE SEWER NOTE 4)

**SEWER NOTES:**

- MANHOLE ADJUSTMENTS AND RECONSTRUCTIONS SHALL BE PER RWRD SSDC 3.3.3.D AND STD. DTL RWRD 305.
- MH #3190-28, #3190-01A, #3190-02A & MH#3190-29 HAVE EXISTING MANHOLE COATINGS. ANY COATING DAMAGED, ANY NEW MANHOLE COMPONENTS REQUIRED FOR MANHOLE ADJUSTMENTS OR RECONSTRUCTION, OR ANY MANHOLE PER EDS 5.2.16 WILL REQUIRE COATING PER SSDC 3.3.3.D.vi (EXISTING), 3.3.3.B.viii (NEW) AND SPECIAL PROVISIONS SECTION 809.
- CONTRACTOR TO POTHOLE IN ORDER TO LOCATE 8" FORCE MAIN. EXISTING FORCE MAIN MONUMENTS TO BE SURVEYED AND REPLACED. MONUMENTS SHALL BE FURNISHED & INSTALLED PER STD. DTL. RWRD-503 AND PER ITEM SPEC. 9090004. REINFORCING BARS SHALL BE DELETED AND REPLACED WITH AN APPROVED ELECTRONIC MARKER SYSTEM. CONTRACTOR SHALL SUBMIT DOCUMENTATION TO PCRWRD FOR APPROVAL BEFORE INSTALLING MONUMENTS. SEE FORCE MAIN MONUMENT NOTES AND TABLE ON SHEET SS3.
- CONTRACTOR SHALL POTHOLE VERIFY THE SEPARATION BETWEEN THE 60" HOBAS PIPE AND THE NEW JACK AND BORED WATER CASING.

MH No.	EXST. RIM EL.	NEW RIM EL.	Delta (FT)	Adjust (EA)	Reconstruct (LF)	Barrel Diameter
3190-26	2238.72	2238.72	0	N/A	N/A	
3190-27	2239.39	2239.39	0	N/A	N/A	
3190-28	2241.53	2241.91	0.38		4.4	5'
3190-01A	2241.23	2241.89	0.66		4.7	4'
3190-02A	2244.63	2244.05	-0.58	1		4'
3190-29	2247.12	2250.72	3.6		7.6	5'
9717-33	2247.76	2247.97	0.21	1		
2903-01	2247.65	2248.42	0.77		4.8	5'

SEE MANHOLE RECONSTRUCTION DETAIL IN SHEET SS15 AND NOTE 2 THIS SHEET.

DESIGN	DL	DATE	3-19	ARIZONA DEPARTMENT OF TRANSPORTATION INFRASTRUCTURE DELIVERY AND OPERATIONS DIVISION ROADWAY DESIGN SERVICES			
DRAWN	CPG	DATE	3-19	RUTHRAUFF ROAD SEWER MODIFICATION PLANS FRAME AND COVER ADJUST			
CHECKED	FF	DATE	3-19	SHEET SS4 OF SS19 DWG NO. U-3.04			
ROUTE		LOCATION		TRACS NO.		PROJECT NO.	
I-10		RUTHRAUFF ROAD TI		H 8480 OIC		010-D(213)S	
NO.		DATE		BY		CHKD, APPR.	
						OF	

G-2014-085





SURVEY NO. FINISHED PLANS DATE LOCATION REVISIONS FINISHED PLANS DATE SURVEY NO. REVISIONS FINISHED PLANS DATE LOCATION REVISIONS FINISHED PLANS DATE SURVEY NO.

F.H.W.A. REGION	STATE	PROJECT NO.	SHEET NO.	TOTAL SHEETS	RECORD DRAWING
9	ARIZ.	010-D(213)S	835	849	

010 PM 252

KEYNOTES

- ① EXISTING MANHOLES TO BE REMOVED. CONTRACTOR SHALL REMOVE THE FRAME AND COVER. THE SALVAGED FRAME AND COVER SHALL BE DELIVERED TO PCRWRD AT THE LOCATION SPECIFIED BY THE INSPECTOR. THE MANHOLES WILL BE COMPLETELY DEMOLISHED, THE EXCAVATION FILLED WITH SELECT MATERIAL AND COMPACTED IN ACCORDANCE WITH THE STANDARDS SET BY THE AGENCY CONTROLLING THE RIGHT-OF-WAY. IN ALL CASES A MINIMUM OF 95% OF THE STANDARD PROCTOR DENSITY, IN ACCORDANCE WITH THE PROVISIONS OF THE ARIZONA TEST METHOD 225, SHALL BE ACHIEVED. THE CONTRACTOR SHALL DISPOSE OF ALL MANHOLE DEMOLITION MATERIAL OFF-SITE AT A LANDFILL OR OTHER APPROVED LOCATION.
- ② REMOVE 311 LF OF EXST 12" CIPP LINED DIP PUBLIC SEWER FROM NEW MH#10 TO EXST MH#9672-03.
- ③ REMOVE 269 LF OF EXST 12" CIPP LINED ACP PUBLIC SEWER FROM EXST MH#9672-03 TO EXST MH#9672-04.
- ④ NEW SEWER MANHOLE #10 OVER EXST SEWER LINE PER PCRWRD STD. DTL. RWRD 303. CONSTRUCT MANHOLE PER PCRWRD STD. DTL. RWRD 201, 206 & 208. INSTALL BLOCK-OUT AT SE INVERT PER PCRWRD STD. DTL. RWRD 203. INSTALL CONCRETE COLLAR PER PCRWRD STD. DTL. RWRD 211. MANHOLE SHALL HAVE FRAME AND COVER PER PCRWRD STD. DTL. RWRD 213. (SEE NOTE 1)
- ⑤ SEE SHEET SS6 FOR REMOVAL OF EXISTING PIPE.

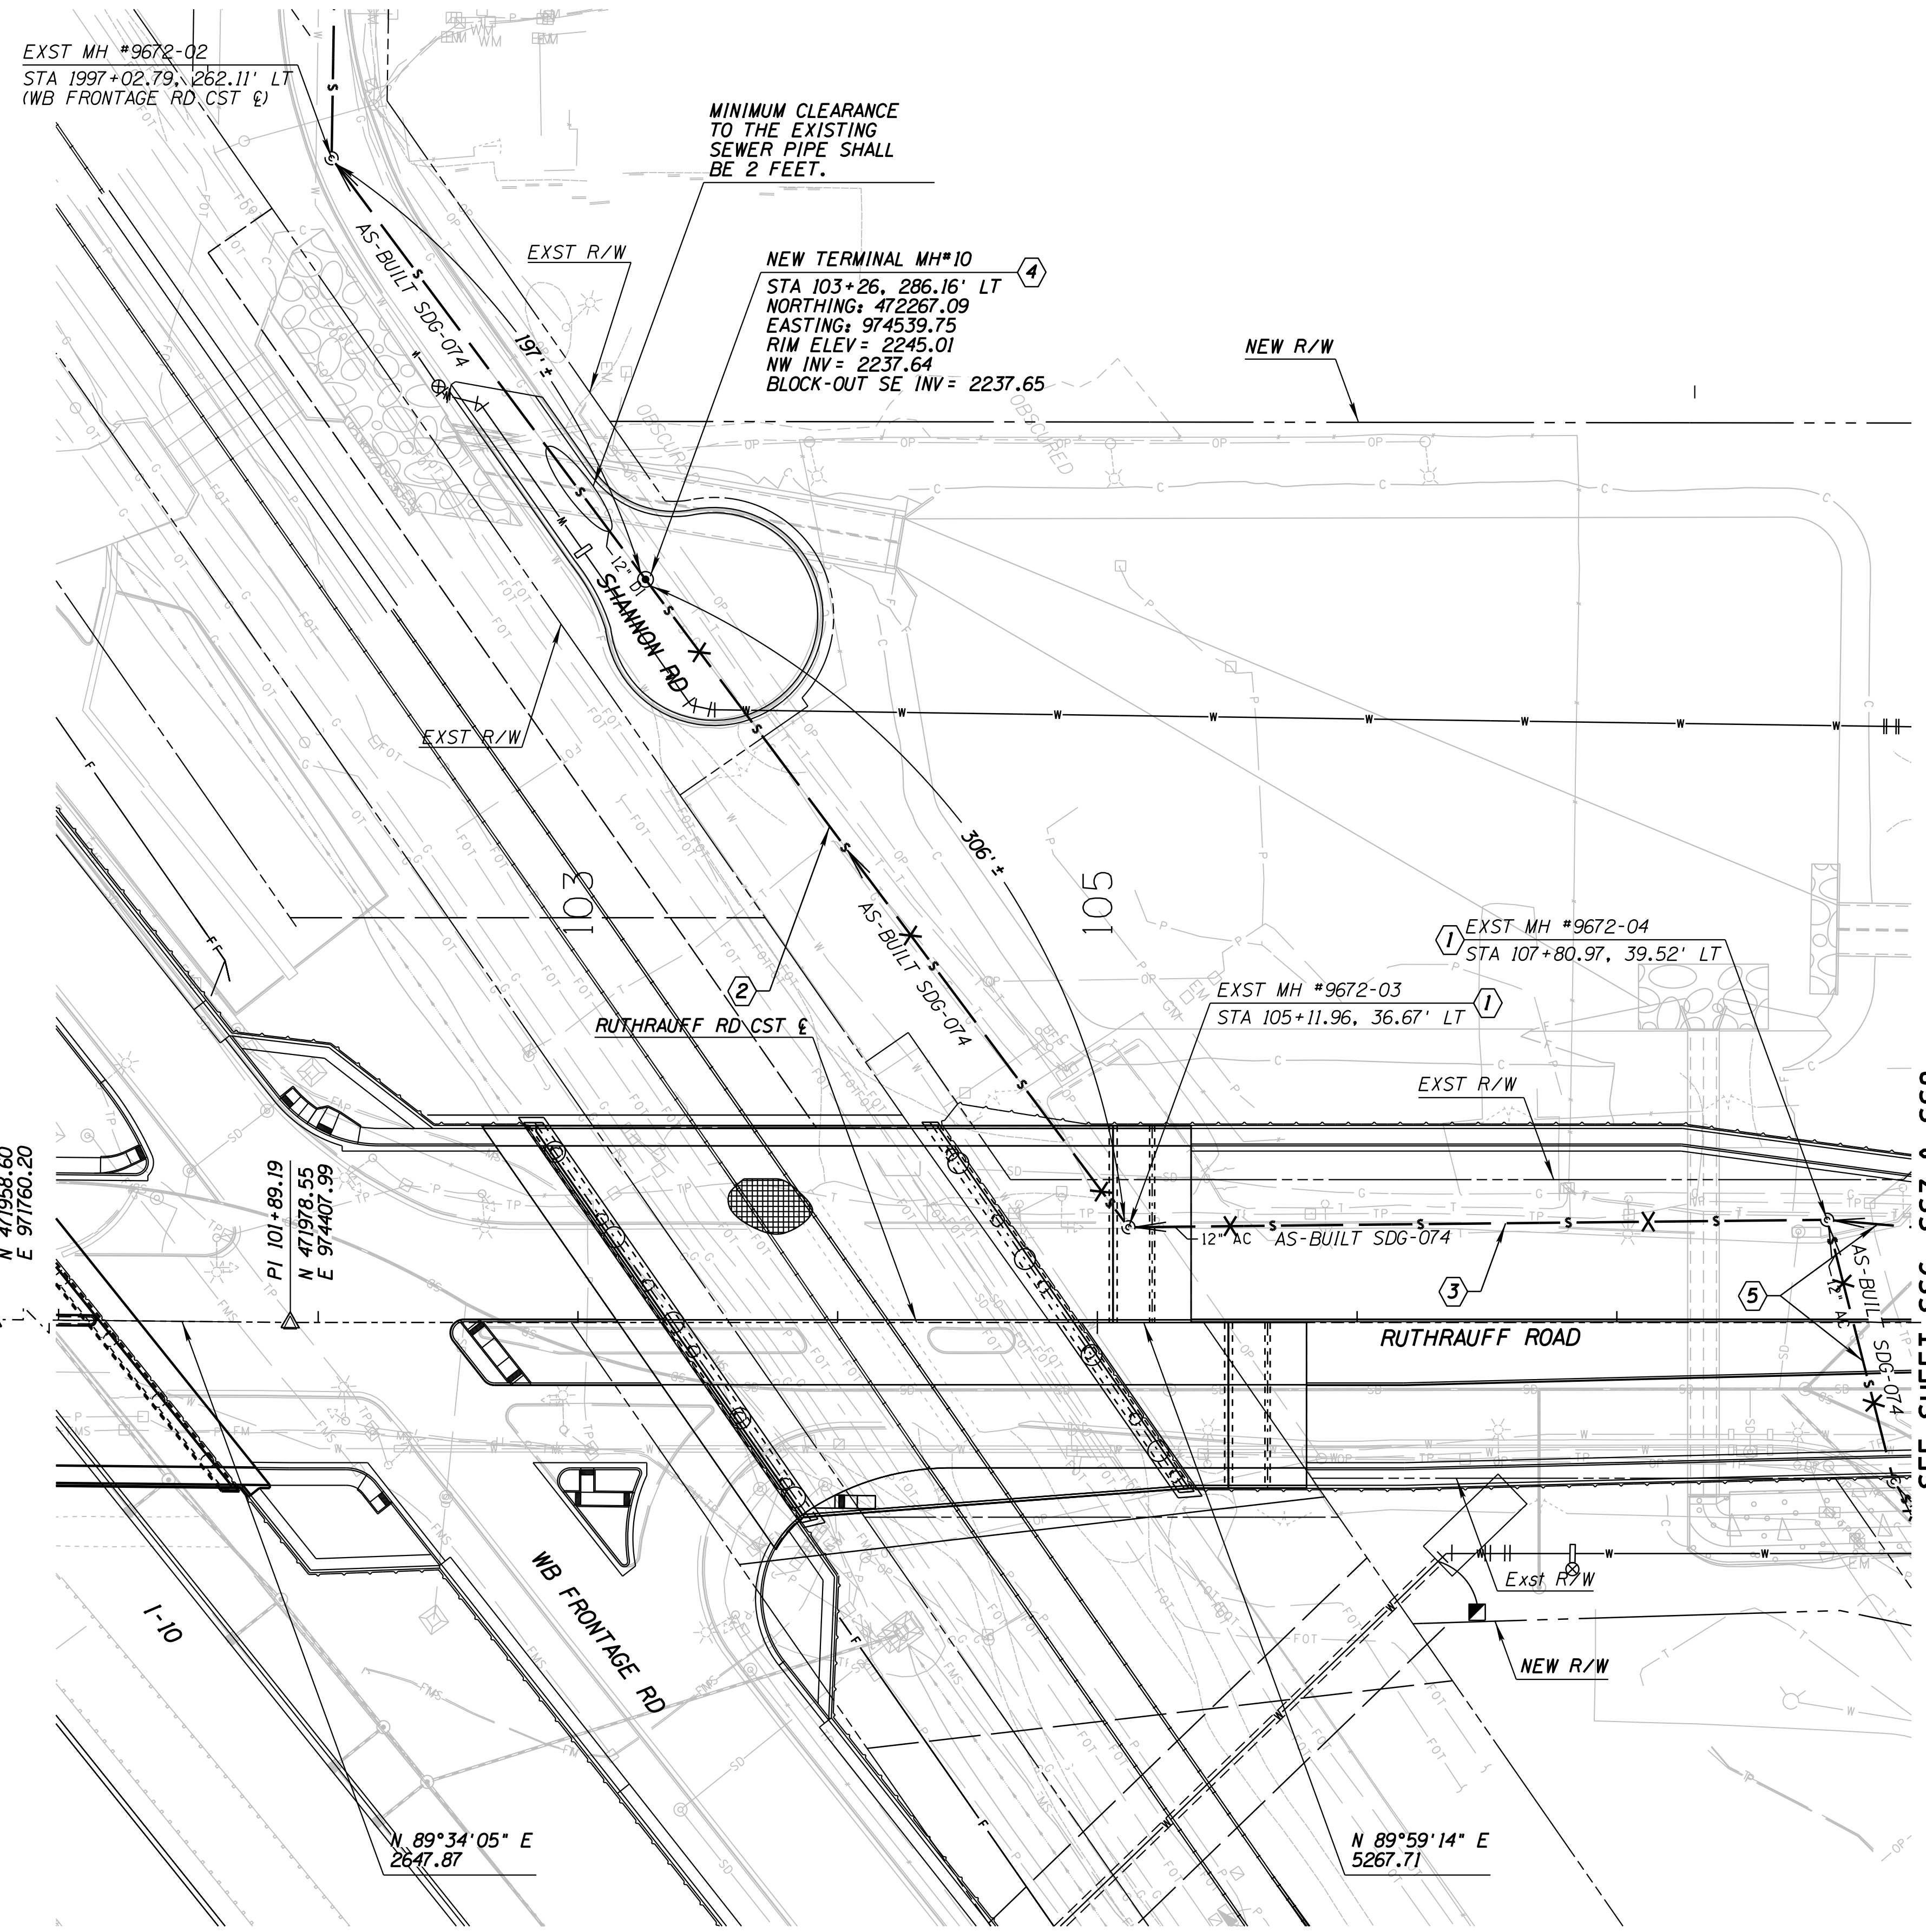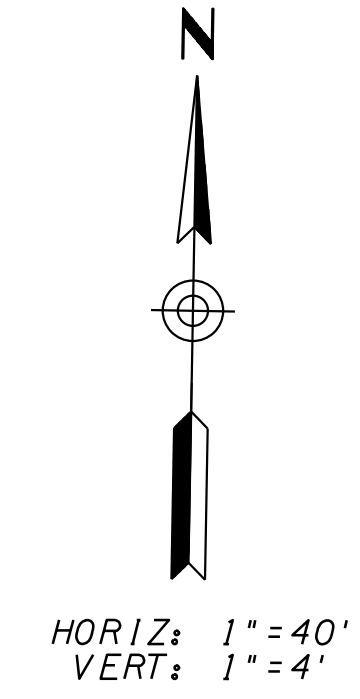

SEE SHEET SS6, SS7 & SS8

NOTES:


1. NEW MH #10 STATION & OFFSET BASED ON RUTHRAUFF ROAD CST E.
2. ANY COATING DAMAGED OR ANY MANHOLE PER EDS 5.2.16. WILL REQUIRE COATING PER SSDC 3.3.3 D vi (EXISTING), 3.3.3 B viii (NEW) AND SPECIAL PROVISIONS, SECTION 809.
3. SEE SHEET SS7 & SS8 FOR ADDITIONAL REMOVAL OF ABANDONED PIPE.

SHEET SS5 OF SS19

DESIGN	NAME	DATE
DL		3-19
CPG		3-19
FF		3-19

ARIZONA DEPARTMENT OF TRANSPORTATION  
INFRASTRUCTURE DELIVERY AND OPERATIONS DIVISION  
ROADWAY DESIGN SERVICES

RUTHRAUFF ROAD  
SEWER MODIFICATION PLANS  
SEWER PLAN

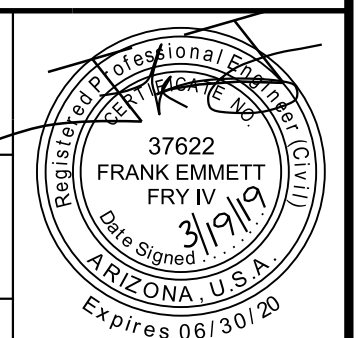

NO.	DATE	REVISION	BY	CHKD.	APPR.

ROUTE	LOCATION	DWG NO.
I-10	RUTHRAUFF ROAD TI	U-3.05
TRACS NO. H 8480 OIC	010-D(213)S	OF

G-2014-085




F.H.W.A. REGION	STATE	PROJECT NO.	SHEET NO.	TOTAL SHEETS	RECORD DRAWING
9	ARIZ.	010-D(213)S	836	849	


010 PM 252

KEYNOTES

- ① EXISTING MANHOLES TO BE REMOVED. CONTRACTOR SHALL REMOVE THE FRAME AND COVER. THE SALVAGED FRAME AND COVER SHALL BE DELIVERED TO PCRWRD AT THE LOCATION SPECIFIED BY THE INSPECTOR. THE MANHOLES WILL BE COMPLETELY DEMOLISHED, THE EXCAVATION FILLED WITH SELECT MATERIAL AND COMPACTED IN ACCORDANCE WITH THE STANDARDS SET BY THE AGENCY CONTROLLING THE RIGHT-OF-WAY. IN ALL CASES A MINIMUM OF 95% OF THE STANDARD PROCTOR DENSITY, IN ACCORDANCE WITH THE PROVISIONS OF THE ARIZONA TEST METHOD 225, SHALL BE ACHIEVED. THE CONTRACTOR SHALL DISPOSE OF ALL MANHOLE DEMOLITION MATERIAL OFF-SITE AT A LANDFILL OR OTHER APPROVED LOCATION.
- ② REMOVE 104 LF OF EXST 12" ACP PUBLIC SEWER FROM EXST MH#9672-04 TO EXST MH#9672-05.
- ③ REMOVE 92 LF OF EXST 12" ACP PUBLIC SEWER FROM EXST MH#9672-05 TO NEW MH#9.
- ④ REMOVE 112 LF OF EXST 12" VCP ABAN. PUBLIC SEWER FROM EXST MH#9672-04 TO EXST MH#9717-31B.
- ⑤ REMOVE 41 LF OF EXST 18" VCP & 12" DI PUBLIC SEWER FROM EXST MH#9717-31A TO EXST MH#9717-31.
- ⑥ REMOVE 141 LF OF EXST 10" VCP PUBLIC SEWER FROM EXST MH#9717-31B TO EXST MH#9672-16.
- ⑦ REMOVE 352 LF OF EXST 15" VCP PUBLIC SEWER FROM EXST MH#9717-31A TO EXST MH#9717-32 (SEE SHEET SS8).
- ⑧ NEW SEWER MANHOLE #1 OVER EXST SEWER LINE PER PCRWRD STD. DTL. RWRD 303. CONSTRUCT MANHOLE PER PCRWRD STD. DTL. RWRD 201, 206 & 208. INSTALL CONCRETE COLLAR PER PCRWRD STD. DTL. RWRD 211. MANHOLE SHALL HAVE FRAME AND COVER PER PCRWRD STD. DTL. RWRD 213. (SEE NOTE 1)
- ⑨ NEW SEWER MANHOLE #8 PER PCRWRD STD. DTL. RWRD 201, 206 & 208. INSTALL CONCRETE COLLAR PER PCRWRD STD. DTL. RWRD 211. MANHOLE SHALL HAVE FRAME AND COVER PER PCRWRD STD. DTL. RWRD 213.
- ⑩ NEW SEWER MANHOLE #9 OVER EXST SEWER LINE PER PCRWRD STD. DTL. RWRD 303. CONSTRUCT MANHOLE PER PCRWRD STD. DTL. RWRD 201, 207 (TYPE II) & 208. INSTALL CONCRETE COLLAR PER PCRWRD STD. DTL. RWRD 212. MANHOLE SHALL HAVE FRAME AND COVER PER PCRWRD STD. DTL. RWRD 216.
- ⑪ REMOVE 103 LF OF EXST 4" HCS FROM MH #6571-01 TO EXST HCS. CONTRACTOR TO REMOVE AND EXST HCS.
- ⑫ SEE SHEET SS7 FOR REMOVAL OF EXISTING PIPE.
- ⑬ SEE SHEET SS5 FOR REMOVAL OF EXISTING PIPE.

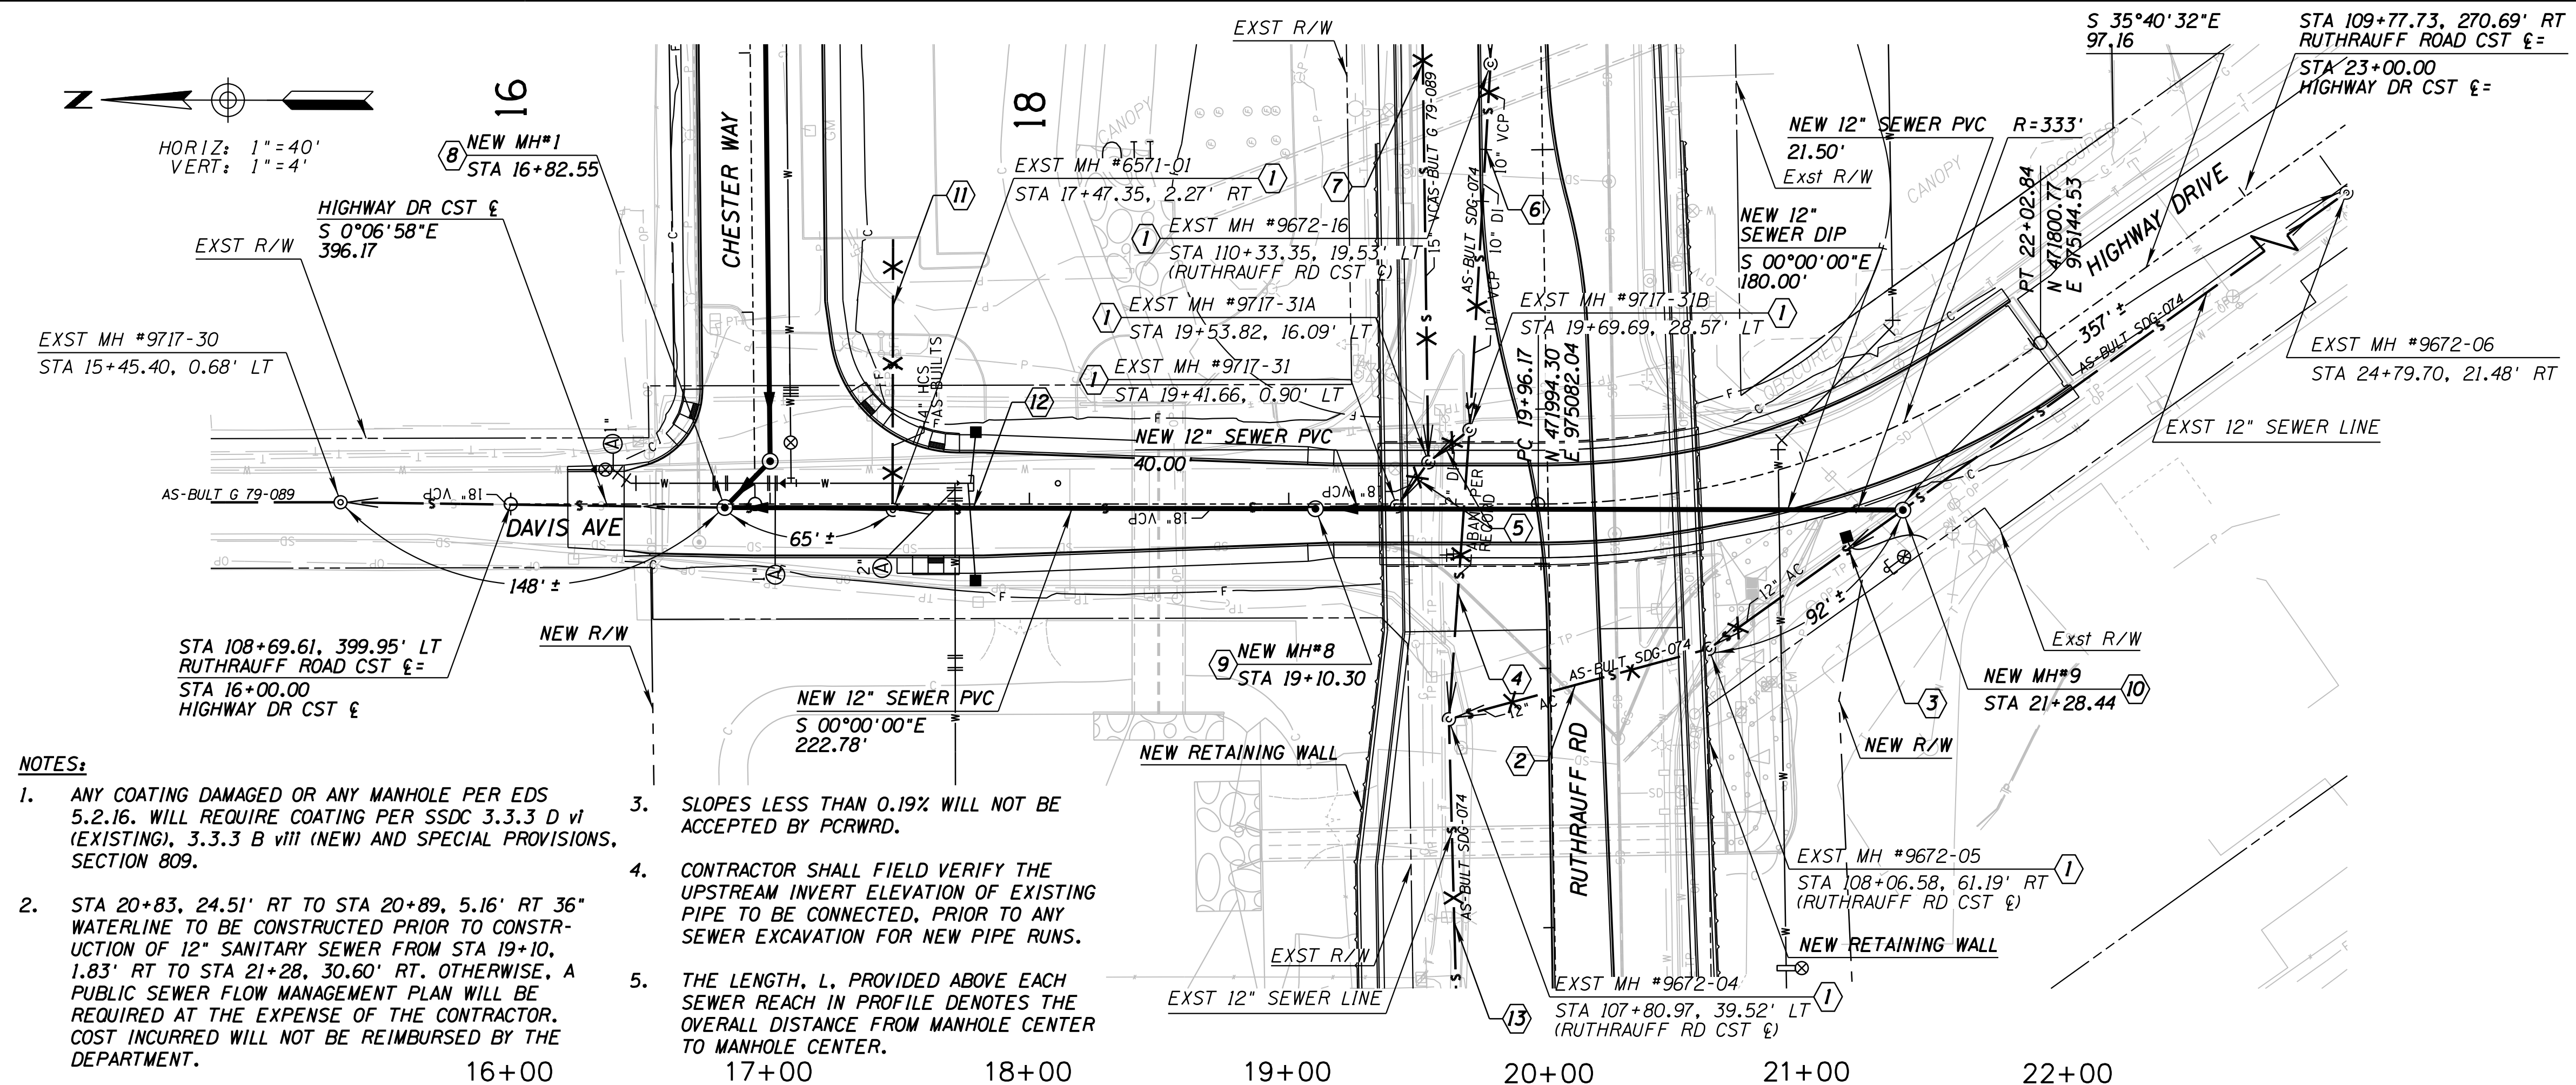


- NOTES:**
1. ANY COATING DAMAGED OR ANY MANHOLE PER EDS 5.2.16. WILL REQUIRE COATING PER SSDC 3.3.3 D vi (EXISTING), 3.3.3 B viii (NEW) AND SPECIAL PROVISIONS, SECTION 809.
  2. STA 20+83, 24.51' RT TO STA 20+89, 5.16' RT 36" WATERLINE TO BE CONSTRUCTED PRIOR TO CONSTRUCTION OF 12" SANITARY SEWER FROM STA 19+10, 1.83' RT TO STA 21+28, 30.60' RT. OTHERWISE, A PUBLIC SEWER FLOW MANAGEMENT PLAN WILL BE REQUIRED AT THE EXPENSE OF THE CONTRACTOR. COST INCURRED WILL NOT BE REIMBURSED BY THE DEPARTMENT.
  3. SLOPES LESS THAN 0.19% WILL NOT BE ACCEPTED BY PCRWRD.
  4. CONTRACTOR SHALL FIELD VERIFY THE UPSTREAM INVERT ELEVATION OF EXISTING PIPE TO BE CONNECTED, PRIOR TO ANY SEWER EXCAVATION FOR NEW PIPE RUNS.
  5. THE LENGTH, L, PROVIDED ABOVE EACH SEWER REACH IN PROFILE DENOTES THE OVERALL DISTANCE FROM MANHOLE CENTER TO MANHOLE CENTER.

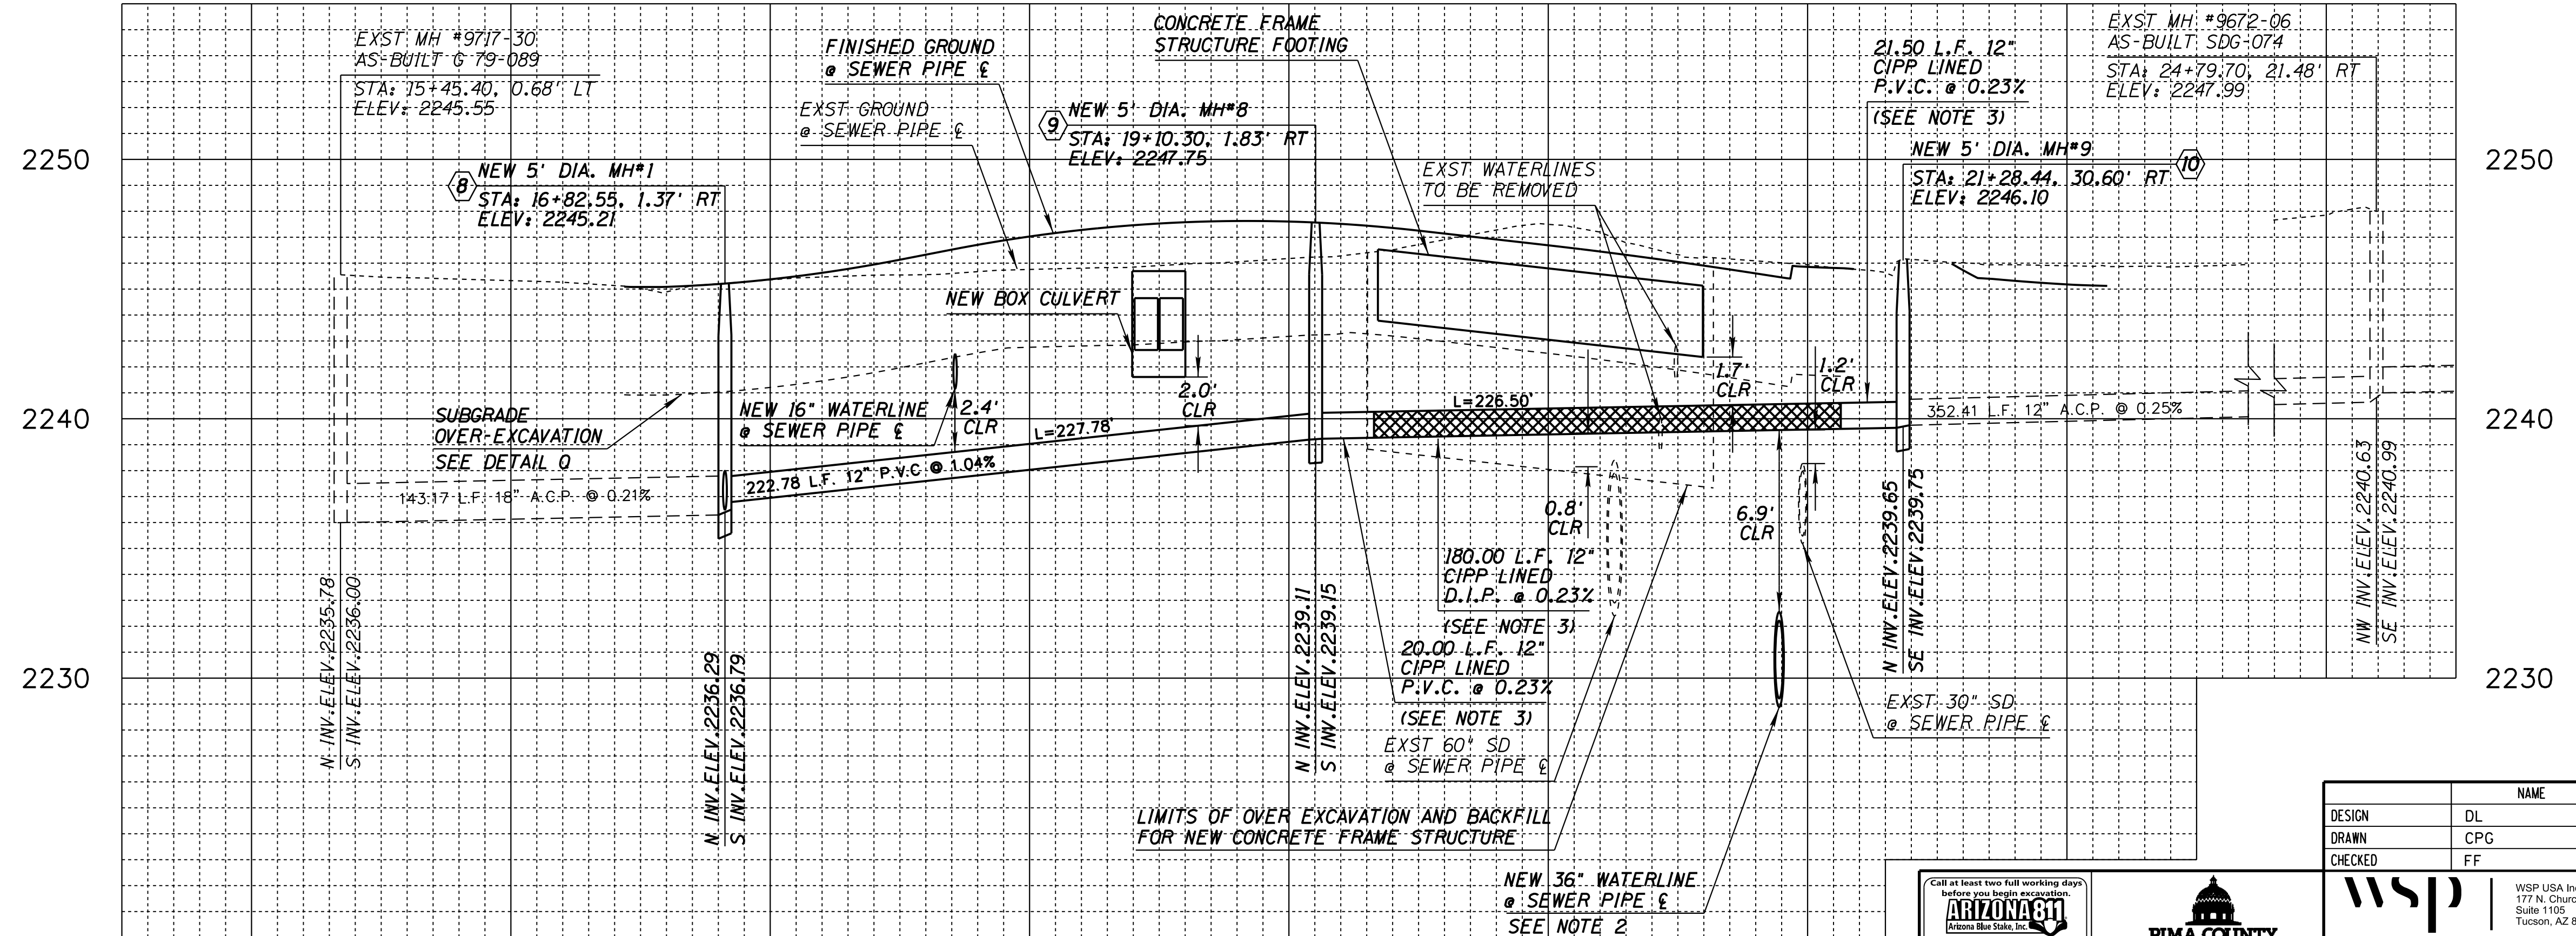

DESIGN	DL	DATE	3-19
DRAWN	CPG	DATE	3-19
CHECKED	FF	DATE	3-19

ARIZONA DEPARTMENT OF TRANSPORTATION  
INFRASTRUCTURE DELIVERY AND OPERATIONS DIVISION  
ROADWAY DESIGN SERVICES

RUTHRAUFF ROAD  
SEWER MODIFICATION PLANS  
PLAN AND PROFILE

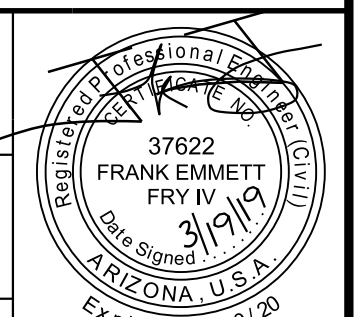

ROUTE 1-10 LOCATION RUTHRAUFF ROAD T1

TRACS NO. H 8480 OIC

010-D(213)S

DWG NO. U-3.06

OF

NO.	DATE	REVISION	BY	CHKD.	APPR.

G-2014-085

F.H.W.A. REGION	STATE	PROJECT NO.	SHEET NO.	TOTAL SHEETS	RECORD DRAWING
9	ARIZ.	010-D(213)S	837	849	

010 PM 252

KEYNOTES

- ① EXISTING MANHOLES TO BE REMOVED. CONTRACTOR SHALL REMOVE THE FRAME AND COVER. THE SALVAGED FRAME AND COVER SHALL BE DELIVERED TO PCRWRD AT THE LOCATION SPECIFIED BY THE INSPECTOR. THE MANHOLES WILL BE COMPLETELY DEMOLISHED, THE EXCAVATION FILLED WITH SELECT MATERIAL AND COMPACTED IN ACCORDANCE WITH THE STANDARDS SET BY THE AGENCY CONTROLLING THE RIGHT-OF-WAY. IN ALL CASES A MINIMUM OF 95% OF THE STANDARD PROCTOR DENSITY, IN ACCORDANCE WITH THE PROVISIONS OF THE ARIZONA TEST METHOD 225, SHALL BE ACHIEVED. THE CONTRACTOR SHALL DISPOSE OF ALL MANHOLE DEMOLITION MATERIAL OFF-SITE AT A LANDFILL OR OTHER APPROVED LOCATION.
- ② REMOVE 65 LF OF EXST 18" VCP PUBLIC SEWER FROM NEW MH#1 TO EXST MH#6571-01.
- ③ REMOVE 194 LF OF EXST 18" VCP PUBLIC SEWER FROM EXST MH#6571-01 TO EXST MH#9717-31 (SEE SHEET SS6).
- ④ NEW SEWER MANHOLE #1 OVER EXST SEWER LINE PER PCRWRD STD. DTL. RWRD 303. CONSTRUCT MANHOLE PER PCRWRD STD. DTL. RWRD 201, 206 & 208. INSTALL CONCRETE COLLAR PER PCRWRD STD. DTL. RWRD 211. MANHOLE SHALL HAVE FRAME AND COVER PER PCRWRD STD. DTL. RWRD 213. (SEE NOTE 1)
- ⑤ NEW SEWER MANHOLE #2 PER PCRWRD STD. DTL. RWRD 201, 206 & 208. INSTALL CONCRETE COLLAR PER PCRWRD STD. DTL. RWRD 211. MANHOLE SHALL HAVE FRAME AND COVER PER PCRWRD STD. DTL. RWRD 213. (SEE NOTE 1)
- ⑥ NEW SEWER MANHOLE #3 PER PCRWRD STD. DTL. RWRD 201, 206 & 208. INSTALL CONCRETE COLLAR PER PCRWRD STD. DTL. RWRD 211. MANHOLE SHALL HAVE FRAME AND COVER PER PCRWRD STD. DTL. RWRD 213. (SEE NOTE 1)

NOTES:


1. ANY COATING DAMAGED OR ANY MANHOLE PER EDS 5.2.16. WILL REQUIRE COATING PER SSDC 3.3.3 D vi (EXISTING), 3.3.3 B viii (NEW) AND SPECIAL PROVISIONS, SECTION 809.
2. CONTRACTOR SHALL FIELD VERIFY THE UPSTREAM INVERT ELEVATION OF EXISTING PIPE TO BE CONNECTED PRIOR TO ANY SEWER EXCAVATION FOR NEW PIPE RUNS.
3. THE LENGTH, L, PROVIDED ABOVE EACH SEWER REACH IN PROFILE DENOTES THE OVERALL DISTANCE FROM MANHOLE CENTER TO MANHOLE CENTER.

SHEET SS7 OF SS19

DESIGN	NAME	DATE
DL		3-19
CPCG		3-19
FF		3-19

ARIZONA DEPARTMENT OF TRANSPORTATION  
INFRASTRUCTURE DELIVERY AND OPERATIONS DIVISION  
ROADWAY DESIGN SERVICES

RUTHRAUFF ROAD  
SEWER MODIFICATION PLANS  
PLAN AND PROFILE

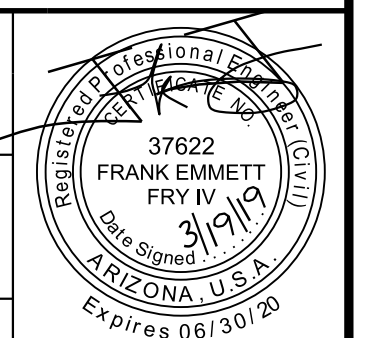




WSP USA Inc.  
177 N. Church Ave.  
Suite 1105  
Tucson, AZ 85701

NO.	DATE	REVISION	BY	CHKD.	APPR.

ROUTE 1-10 LOCATION RUTHRAUFF ROAD TI  
TRACS NO. H 8480 OIC

010-D(213)S

DWG NO. U-3.07  
OF

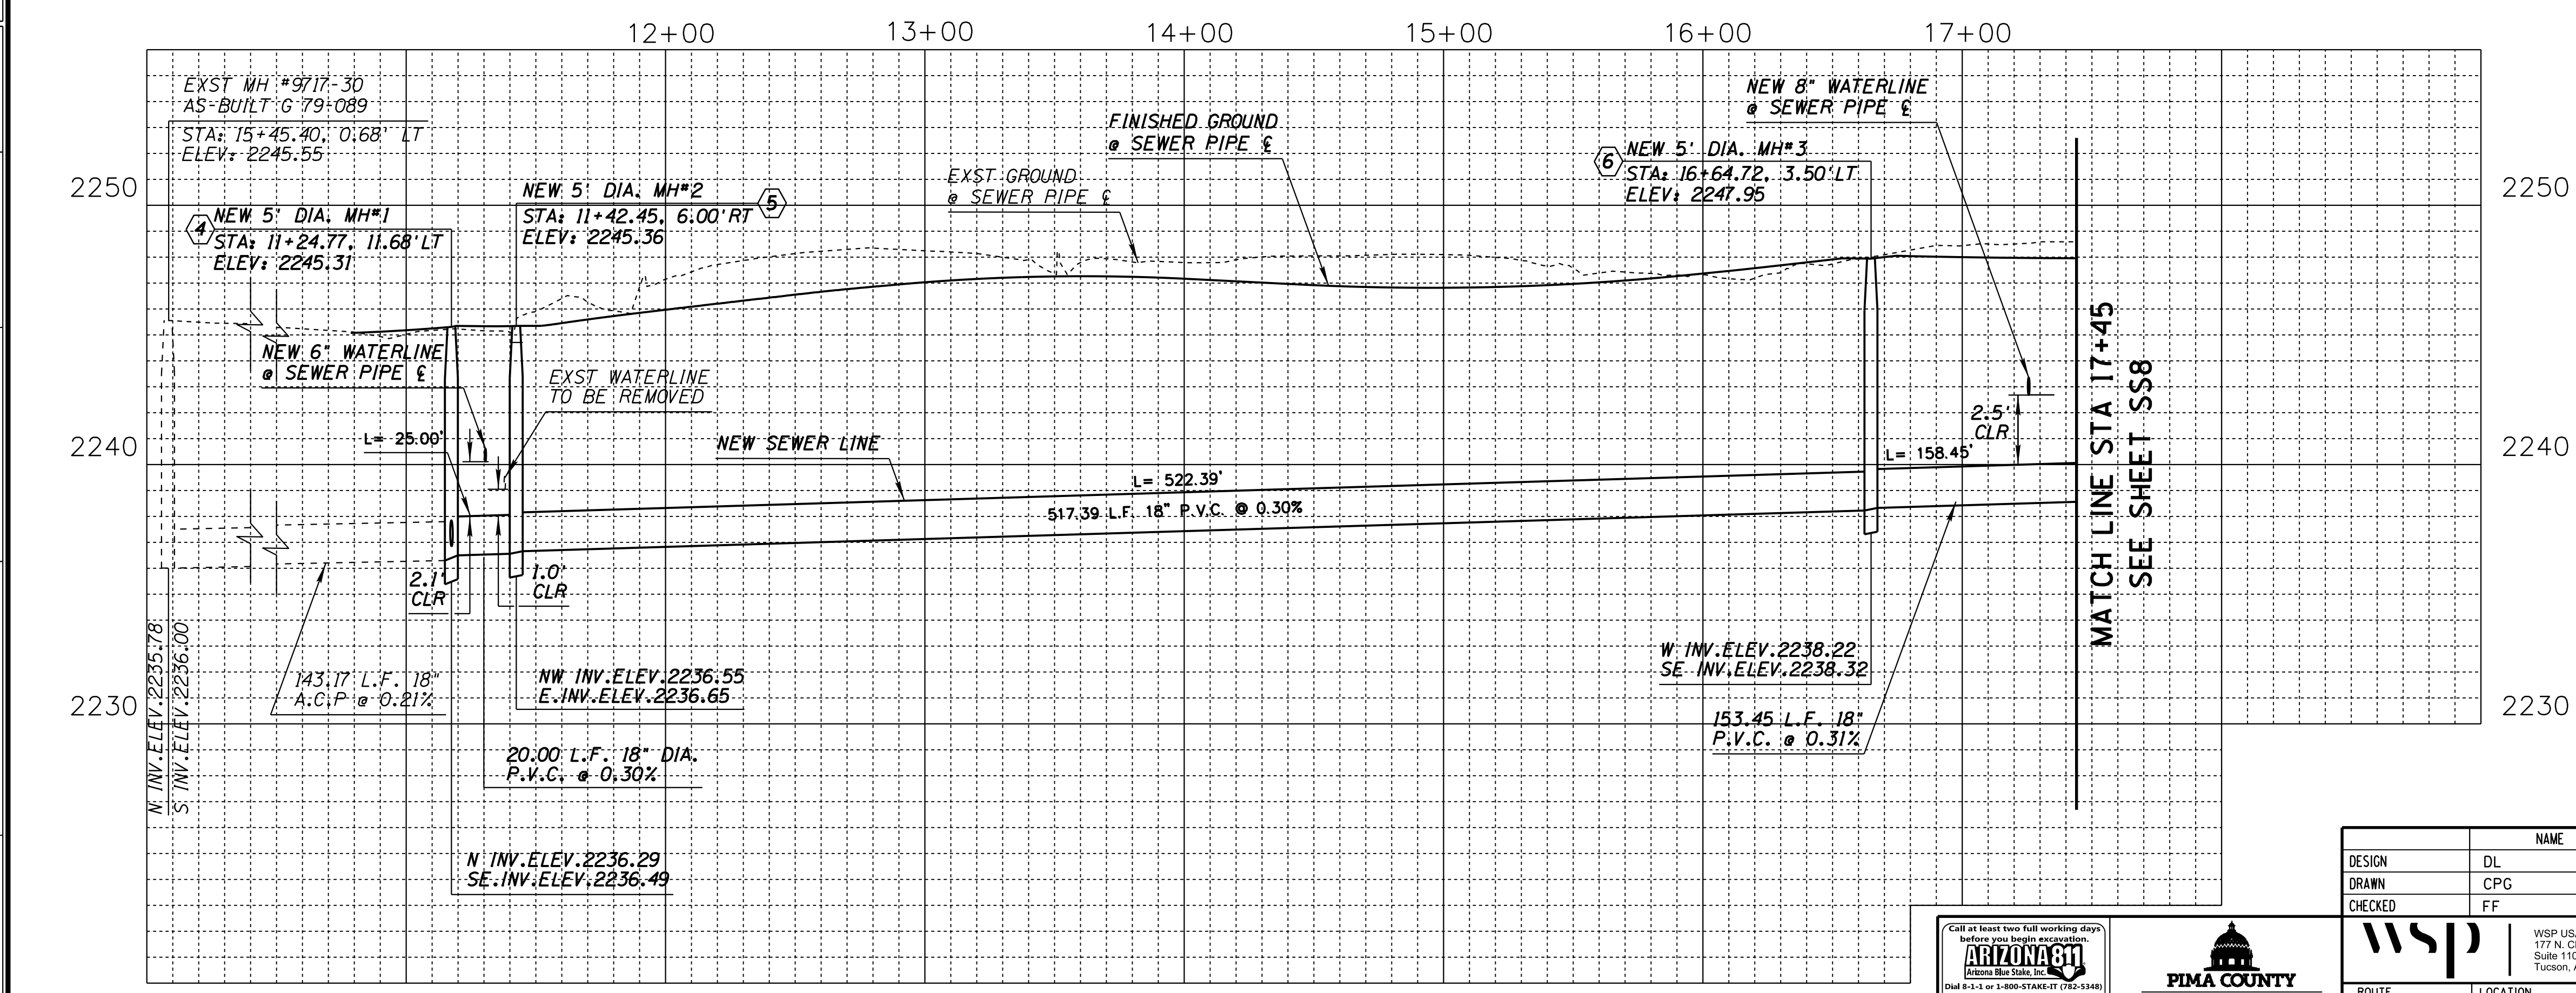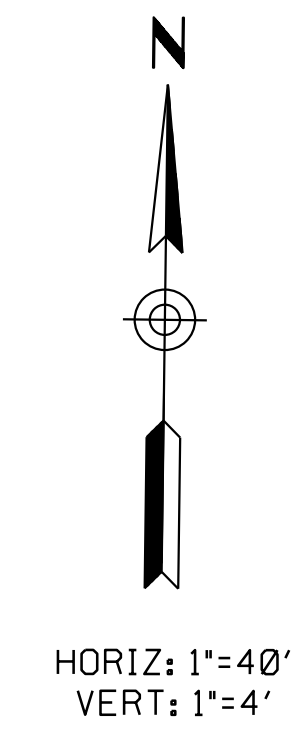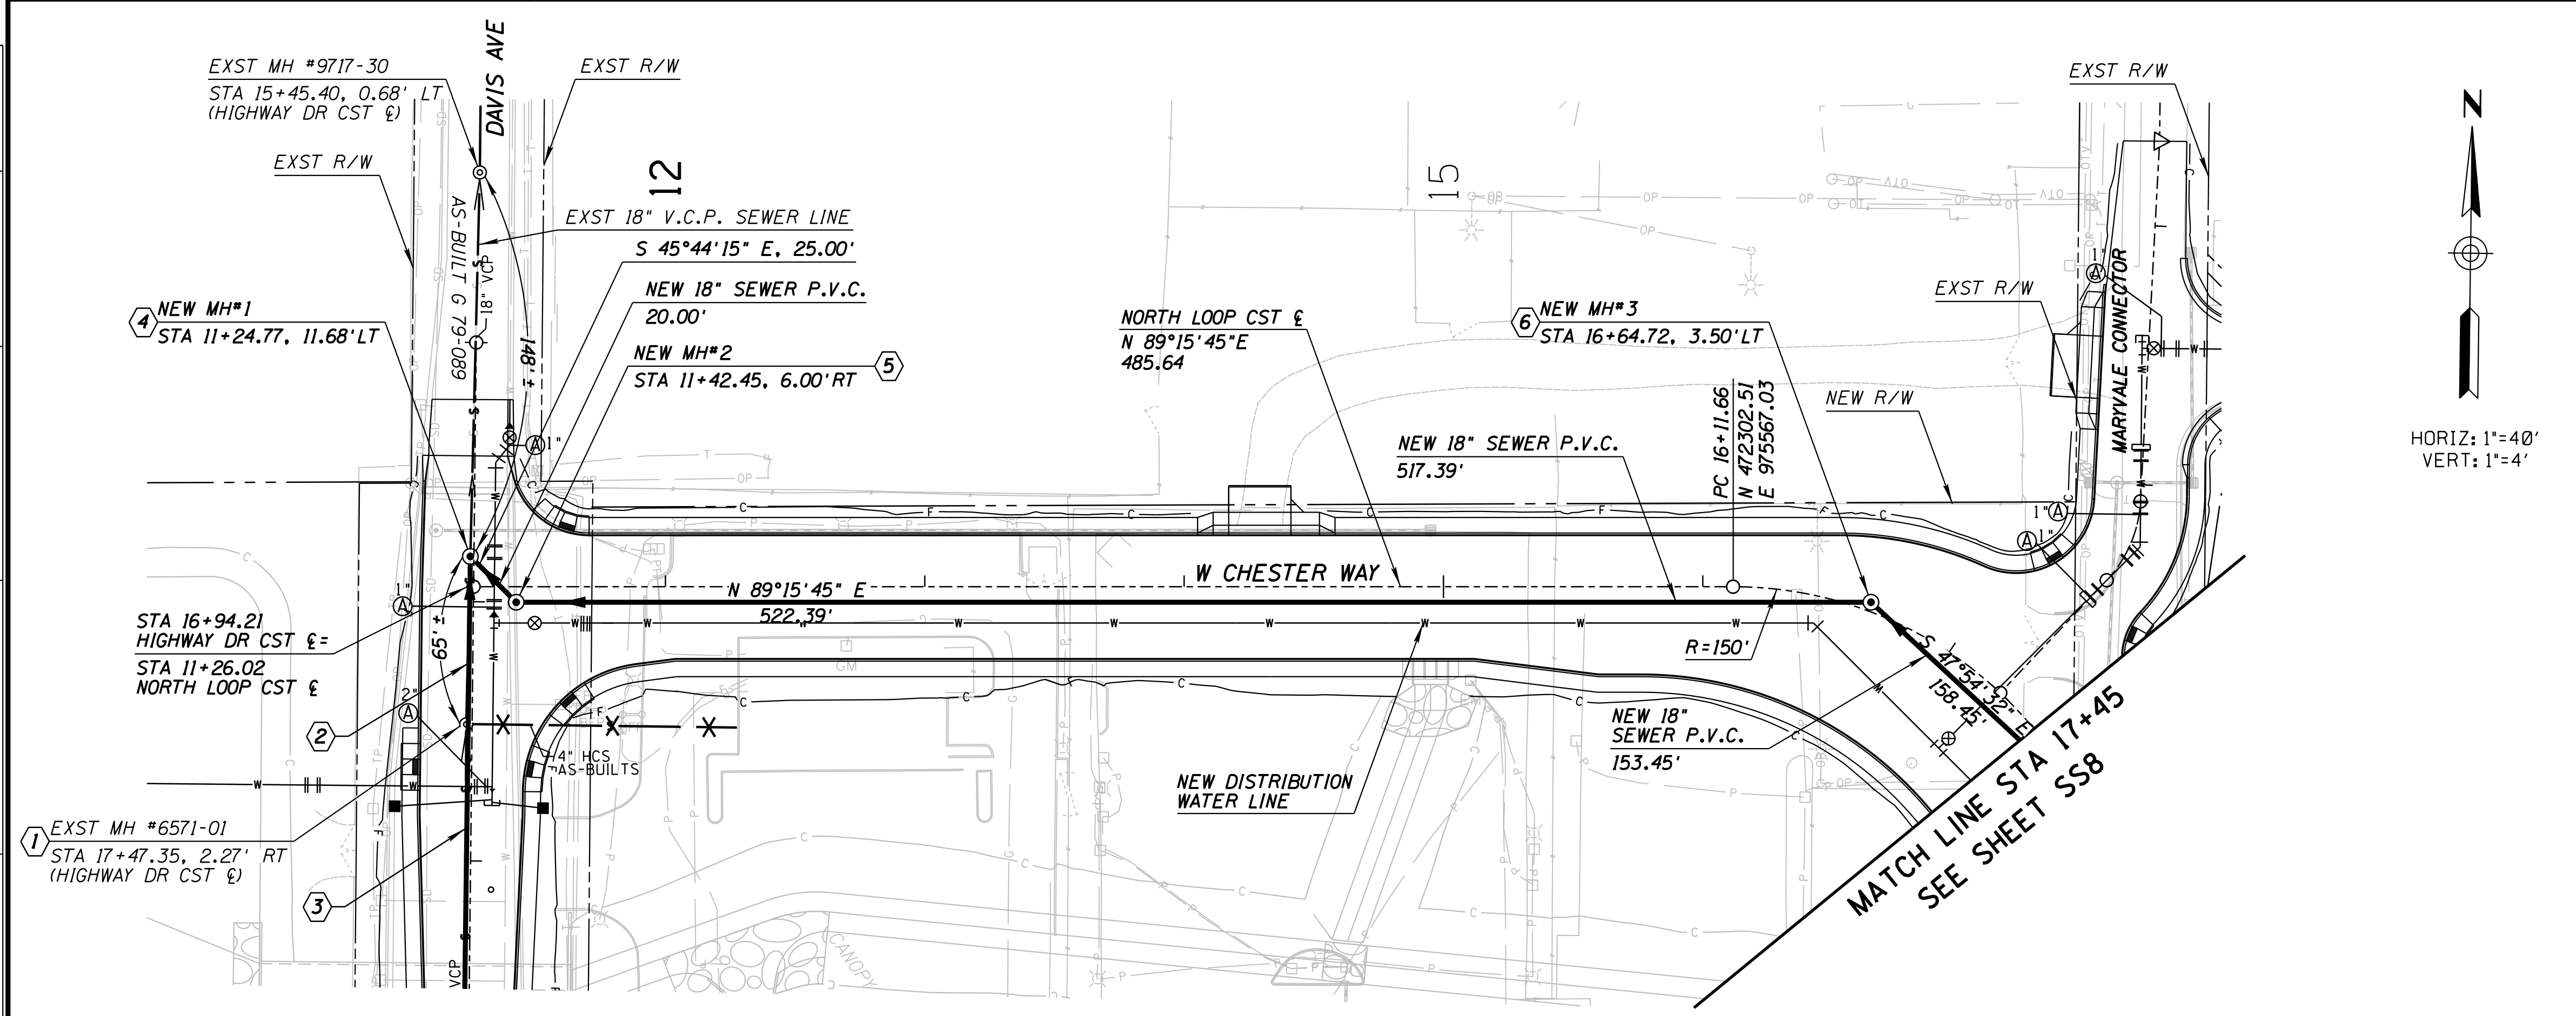

DATE: LOCATION: REVISIONS: FINISHED PLANS: SURVEY NO.


G-2014-085



DATE: LOCATION: REVISIONS: FINISHED PLANS: SURVEY NO.

F.H.W.A. REGION	STATE	PROJECT NO.	SHEET NO.	TOTAL SHEETS	RECORD DRAWING
9	ARIZ.	010-D(213)S	838	849	


010 PM 252

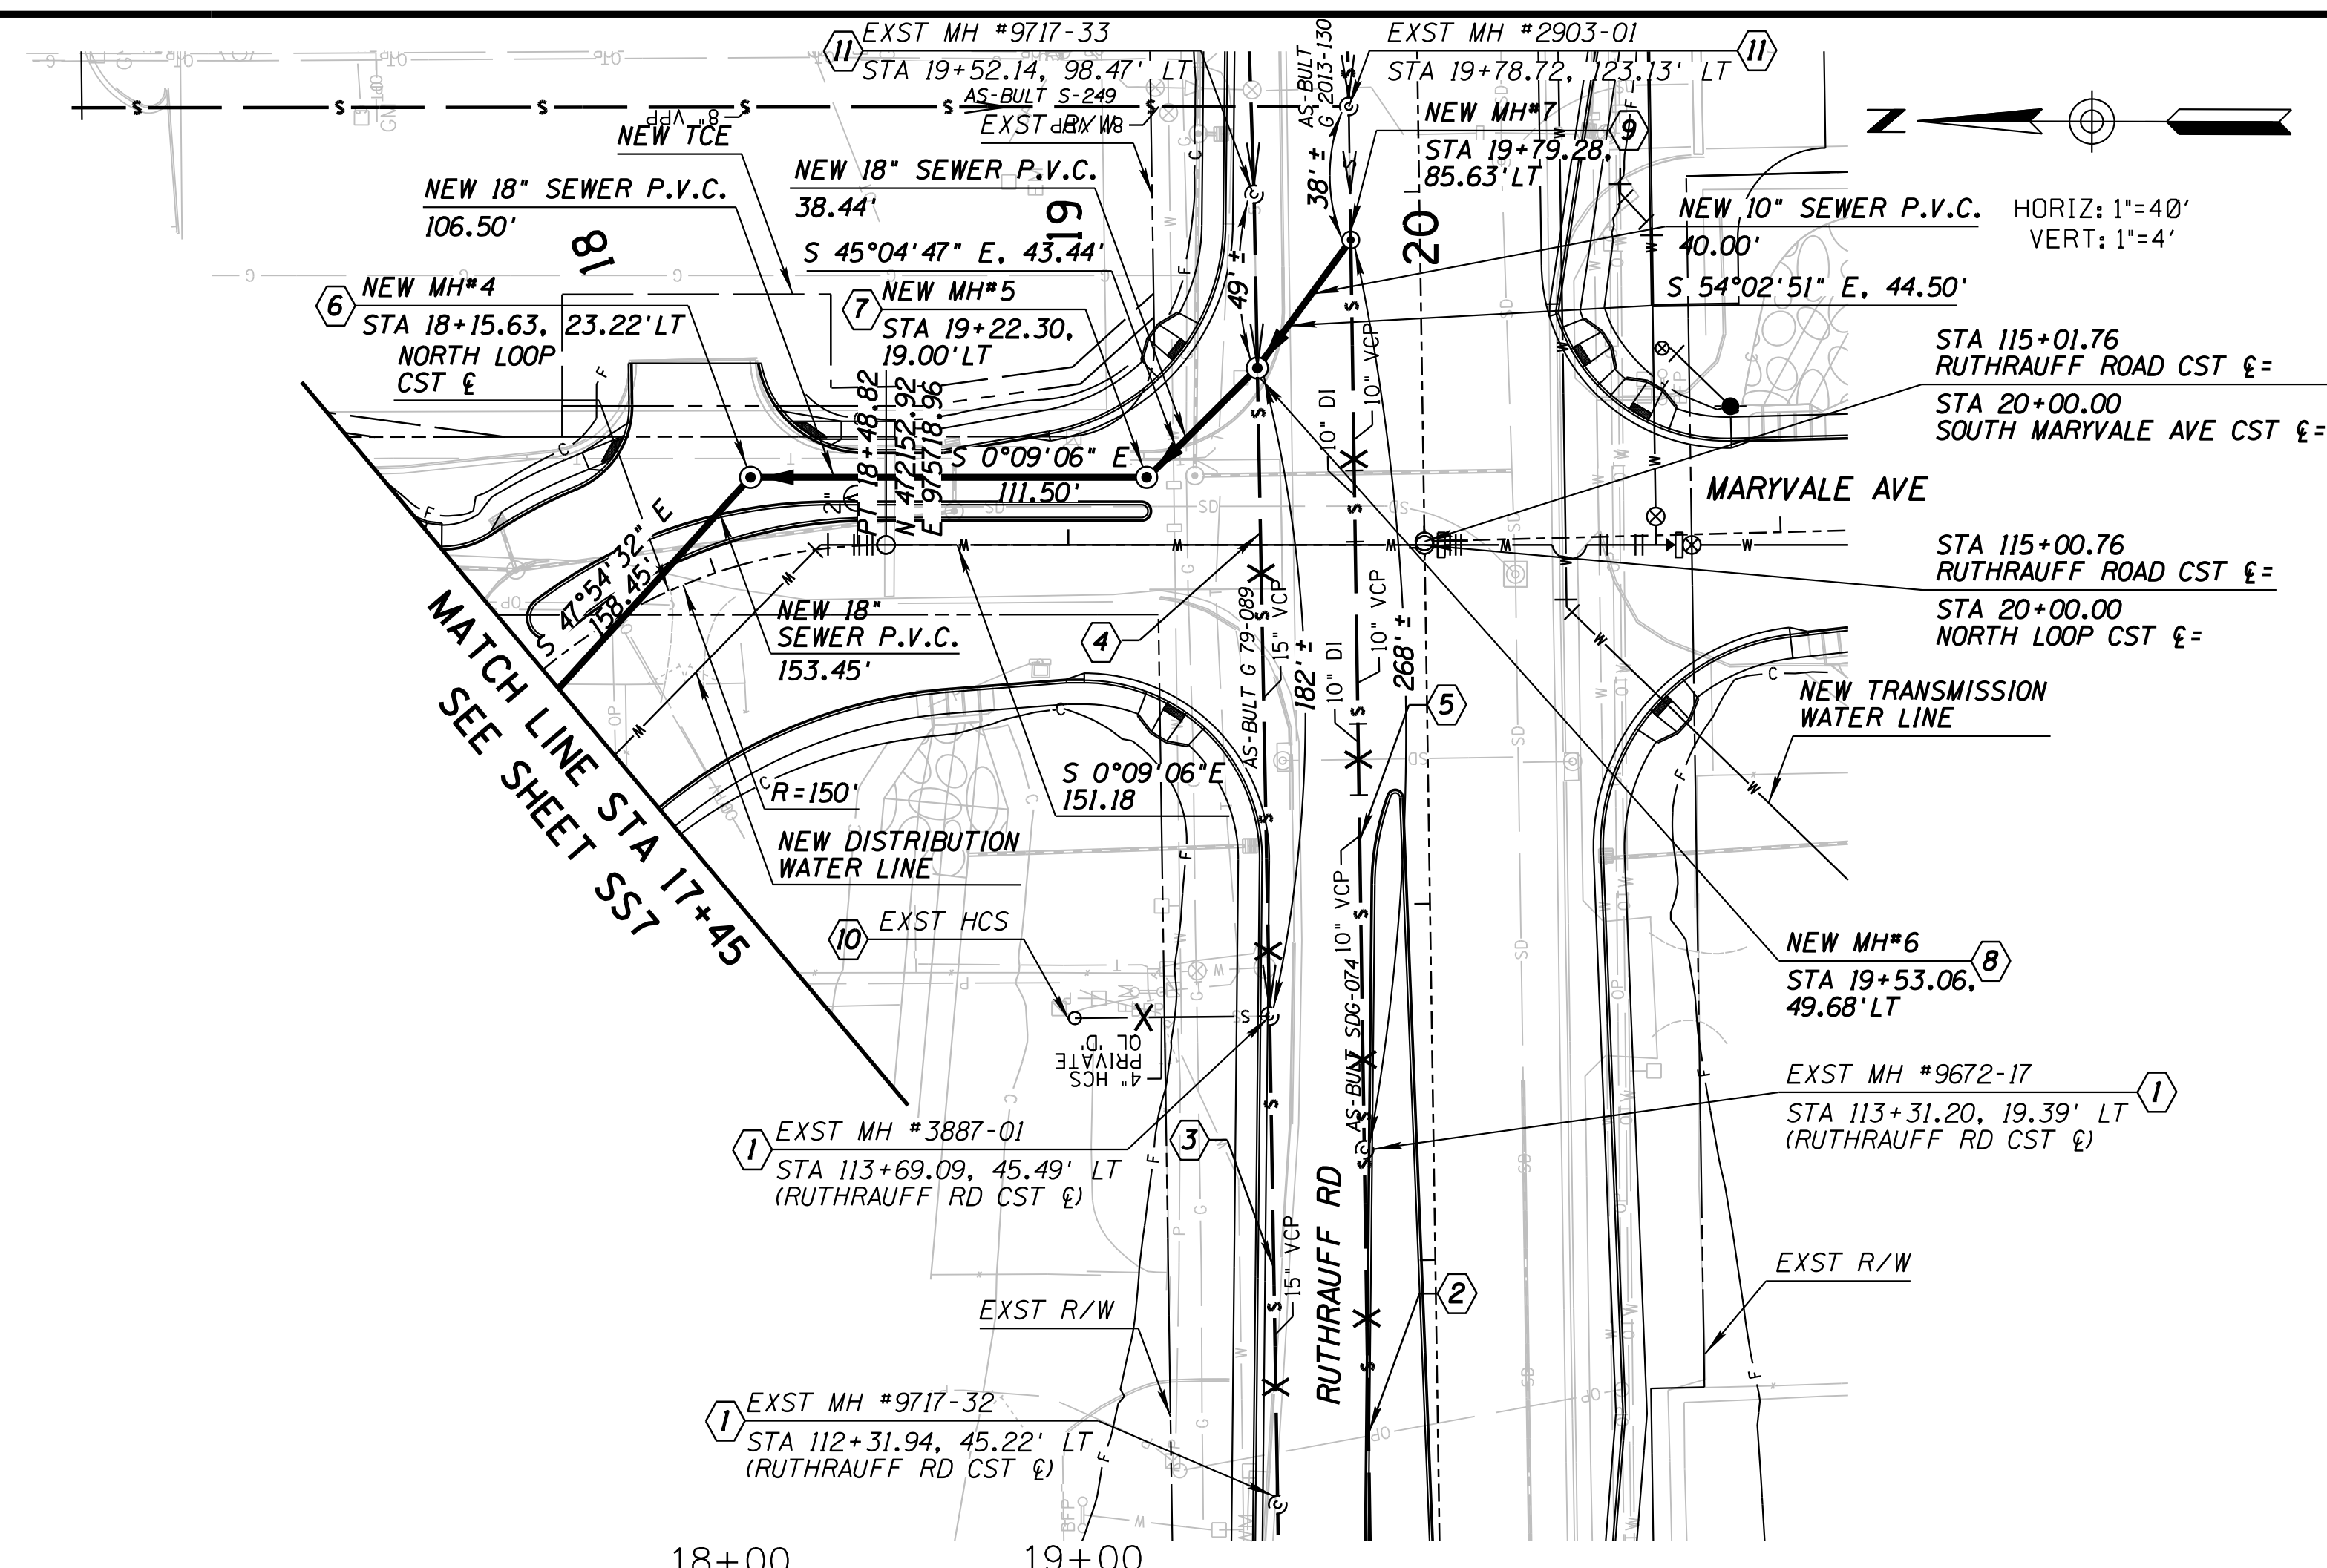

- NOTES: CON'T**
- CONTRACTOR SHALL FIELD VERIFY THE UPSTREAM INVERT ELEVATION OF EXISTING PIPE TO BE CONNECTED PRIOR TO ANY SEWER EXCAVATION FOR NEW PIPE RUNS.
  - THE LENGTH, L, PROVIDED ABOVE EACH SEWER REACH IN PROFILE DENOTES THE OVERALL DISTANCE FROM MANHOLE CENTER TO MANHOLE CENTER.

- KEYNOTES**
- EXISTING MANHOLES TO BE REMOVED. CONTRACTOR SHALL REMOVE THE FRAME AND COVER. THE SALVAGED FRAME AND COVER SHALL BE DELIVERED TO PCRWRD AT THE LOCATION SPECIFIED BY THE INSPECTOR. THE MANHOLES WILL BE COMPLETELY DEMOLISHED, THE EXCAVATION FILLED WITH SELECT MATERIAL AND COMPACTED IN ACCORDANCE WITH THE STANDARDS SET BY THE AGENCY CONTROLLING THE RIGHT-OF-WAY. IN ALL CASES A MINIMUM OF 95% OF THE STANDARD PROCTOR DENSITY, IN ACCORDANCE WITH THE PROVISIONS OF THE ARIZONA TEST METHOD 225, SHALL BE ACHIEVED. THE CONTRACTOR SHALL DISPOSE OF ALL MANHOLE DEMOLITION MATERIAL OFF-SITE AT A LANDFILL OR OTHER APPROVED LOCATION.
  - REMOVE 299 LF OF EXST 10" VCP PUBLIC SEWER FROM EXST MH#9672-17 TO EXST MH#9672-16 (SEE SHEET SS6).
  - REMOVE 137 LF OF EXST 15" VCP PUBLIC SEWER FROM EXST MH#3887-01 TO EXST MH#9717-32.
  - REMOVE 182 LF OF EXST 15" VCP PUBLIC SEWER FROM NEW MH#6 TO EXST MH#3887-01.
  - REMOVE 268 LF OF EXST 10" VCP PUBLIC SEWER FROM EXST MH#9672-17 TO NEW MH#7.
  - NEW SEWER MANHOLE #4 PER PCRWRD STD. DTL. RWRD 201, 206 & 208. INSTALL CONCRETE COLLAR PER PCRWRD STD. DTL. RWRD 211. MANHOLE SHALL HAVE FRAME AND COVER PER PCRWRD STD. DTL. RWRD 213. (SEE NOTE 1)
  - NEW SEWER MANHOLE #5 PER PCRWRD STD. DTL. RWRD 201, 206 & 208. INSTALL CONCRETE COLLAR PER PCRWRD STD. DTL. RWRD 211. MANHOLE SHALL HAVE FRAME AND COVER PER PCRWRD STD. DTL. RWRD 213. (SEE NOTE 1)
  - NEW SEWER MANHOLE #6 OVER EXST SEWER LINE PER PCRWRD STD. DTL. RWRD 303. CONSTRUCT MANHOLE PER PCRWRD STD. DTL. RWRD 201, 206 & 208. INSTALL CONCRETE COLLAR PER PCRWRD STD. DTL. RWRD 211. MANHOLE SHALL HAVE FRAME AND COVER PER PCRWRD STD. DTL. RWRD 213. (SEE NOTE 1)
  - NEW SEWER MANHOLE #7 OVER EXST SEWER LINE PER PCRWRD STD. DTL. RWRD 303. CONSTRUCT MANHOLE PER PCRWRD STD. DTL. RWRD 201, 205 & 208. INSTALL CONCRETE COLLAR PER PCRWRD STD. DTL. RWRD 211. MANHOLE SHALL HAVE FRAME AND COVER PER PCRWRD STD. DTL. RWRD 213. (SEE NOTE 1)
  - REMOVE 55 LF OF EXST 4" HCS FROM EXST MH#3887-01 TO EXST HCS. CONTRACTOR TO REMOVE AND DISPOSE EXST HCS.
  - ADJUST OR RECONSTRUCT EXISTING MH #9717-33 AT STA 115+99.94, 46.38' LT & FOR EXISTING MH #2903-01 AT STA 116+24.20, 19.42' LT PER PCRWRD STD. DTL. RWRD 305. INSTALL CONCRETE COLLAR PER STD. DTL. RWRD 211. SEE TABLE IN SHEET SS4. PROVIDE FULL MANHOLE COATING PER 3.3.3 B VIII (NEW). (SEE NOTE 1)

- NOTES:**
- ANY COATING DAMAGED, ANY NEW MANHOLE COMPONENTS REQUIRED FOR MANHOLE ADJUSTMENTS OR RECONSTRUCTION, OR ANY MANHOLE PER EDS 5.2.16. WILL REQUIRE COATING PER SSDC 3.3.3 D VI (EXISTING), 3.3.3 B VIII (NEW) AND SPECIAL PROVISIONS, SECTION 809.

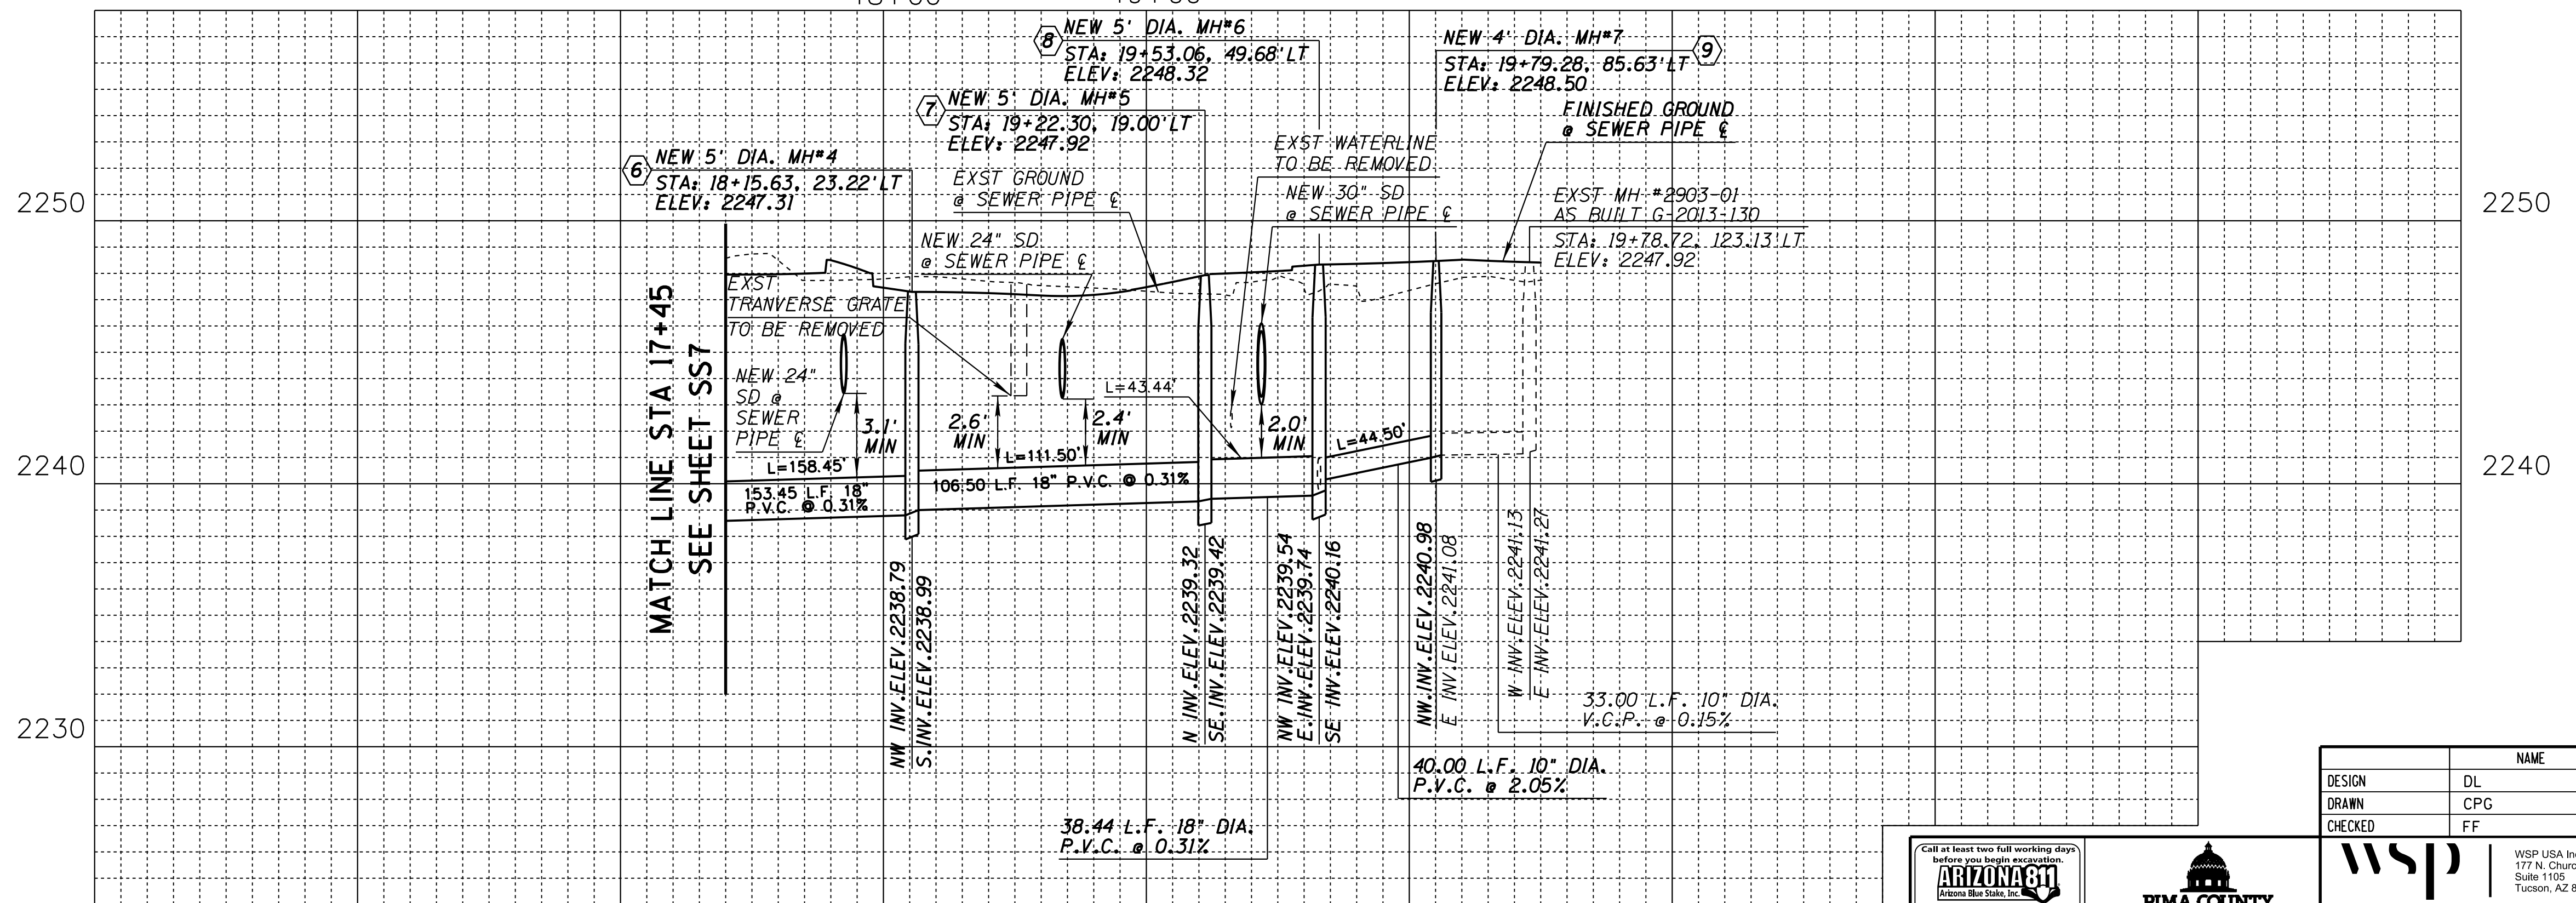


SHEET SS8 OF SS19

DESIGN	NAME	DATE
DL		3-19
DRAWN	CPG	3-19
CHECKED	FF	3-19

ARIZONA DEPARTMENT OF TRANSPORTATION  
INFRASTRUCTURE DELIVERY AND OPERATIONS DIVISION  
ROADWAY DESIGN SERVICES

RUTHRAUFF ROAD  
SEWER MODIFICATION PLANS  
PLAN AND PROFILE

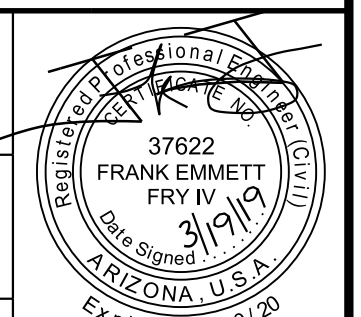


NO.	DATE	REVISION	BY	CHKD.	APPR.	ROUTE	LOCATION	DWG NO.
						I-10	RUTHRAUFF ROAD TI	U-3.08
						TRACS NO. H 8480 OIC	010-D(213)S	OF

G-2014-085

F.H.W.A. REGION	STATE	PROJECT NO.	SHEET NO.	TOTAL SHEETS	RECORD DRAWING
9	ARIZ.	010-D(213)S	839	849	


010 PM 252

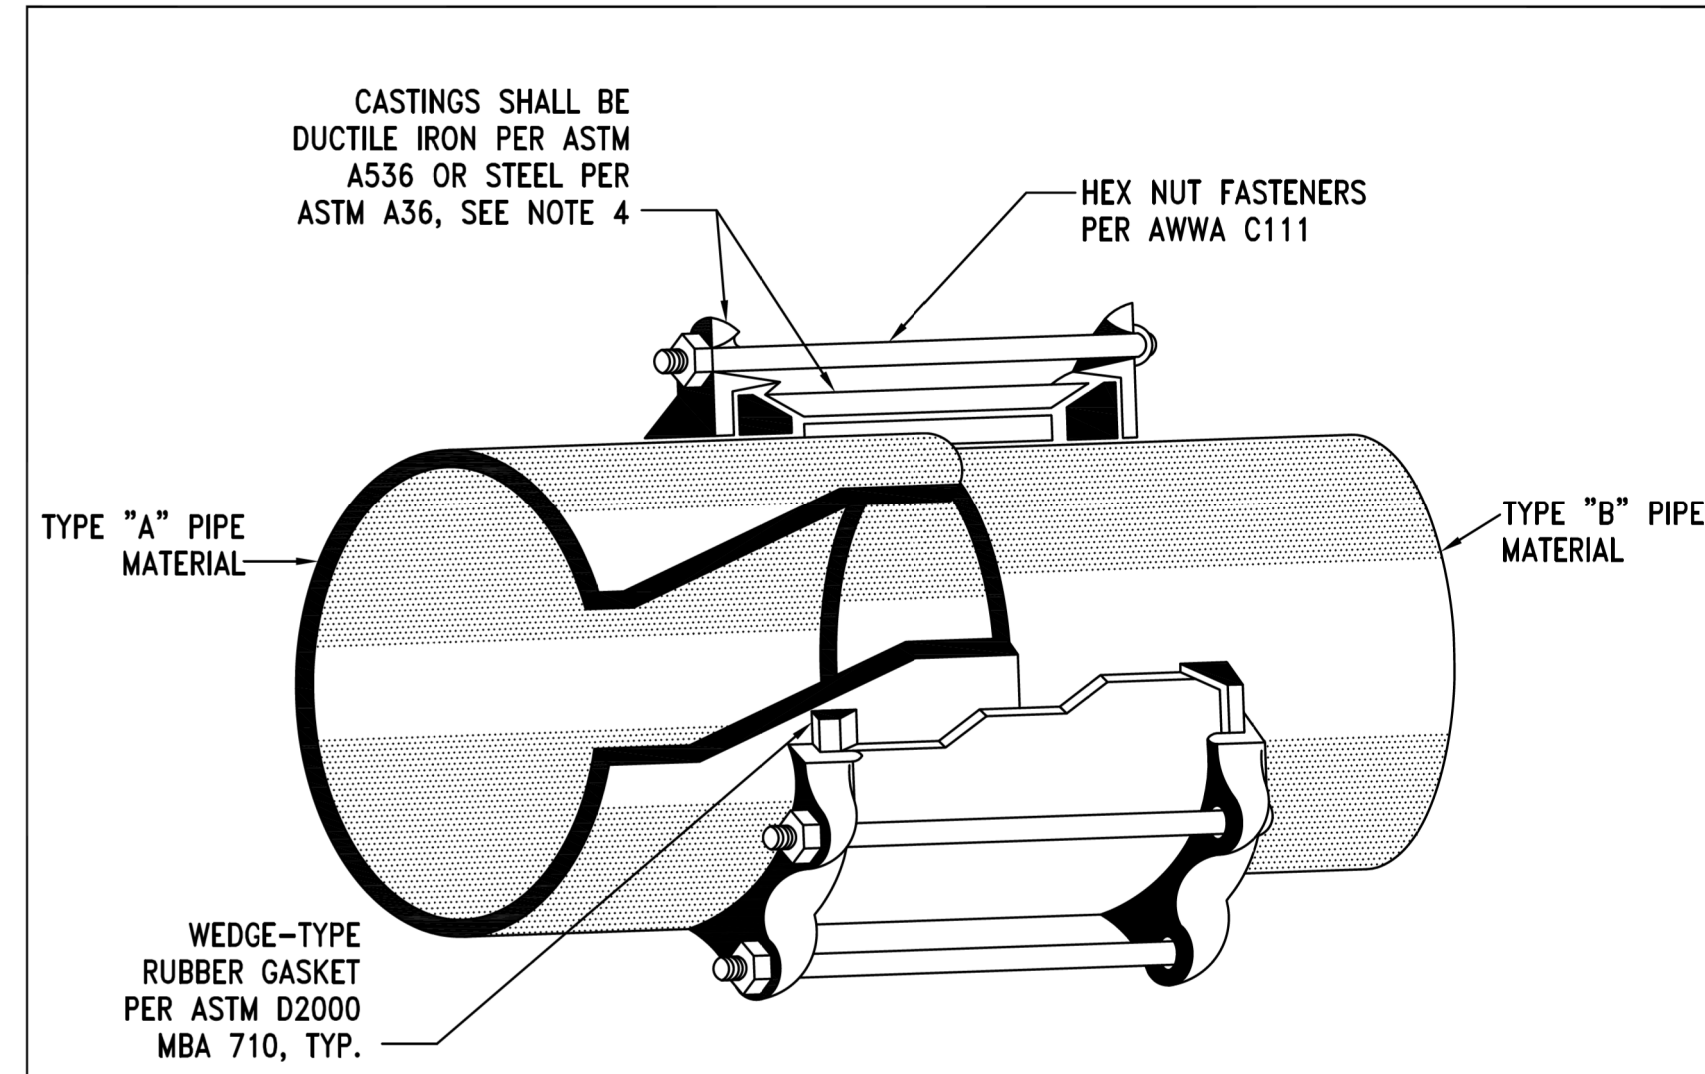

**NOTES:**

1. COUPLINGS SHALL BE RIGID, COMPRESSION TYPE COUPLINGS AS SHOWN, APPROPRIATELY SIZED AND SUITABLE FOR SANITARY SEWER APPLICATIONS. APPROVED COUPLINGS SHALL BE IN THE DEPARTMENT'S LIST OF APPROVED PRODUCTS.
2. ADJUSTABLE REPAIR COUPLINGS (I.E. MISSION) FOR SANITARY SEWER APPLICATIONS MAY BE PERMITTED ON A CASE-BY-CASE BASIS FOR EXISTING 12" DIAMETER VCP OR CONCRETE SEWER PIPE AND SMALLER, ONLY WITH PRIOR APPROVAL BY THE FIELD ENGINEER.
3. WHERE THERE IS A 1" DIFFERENTIAL IN INTERNAL DIAMETERS OF THE 2 DIFFERENT PIPE TYPES, A SPECIAL CONNECTION, APPROVED BY THE FIELD ENGINEER, SHALL BE USED TO ELIMINATE THE DIFFERENTIAL AT THE INVERT.
4. CASTINGS SHALL HAVE AN APPROVED FACTORY-APPLIED INTERIOR AND EXTERIOR CORROSION-RESISTANT COATINGS FOR SANITARY SEWER APPLICATIONS.
5. SEE SUBSECTION 3.4.3 - FOR A CURRENT LIST OF APPROVED PRODUCTS FOR PUBLIC SEWERS, CHECK THE DEPARTMENT'S WEBSITE OR CONTACT THE FIELD ENGINEERING SECTION.


ISSUED:	STANDARD DETAIL		DETAIL NO.
8/92	COUPLING FOR UNLIKE PIPE MATERIALS		RWRD 103
REVISED:			SHEET 1 OF 1
10/15			

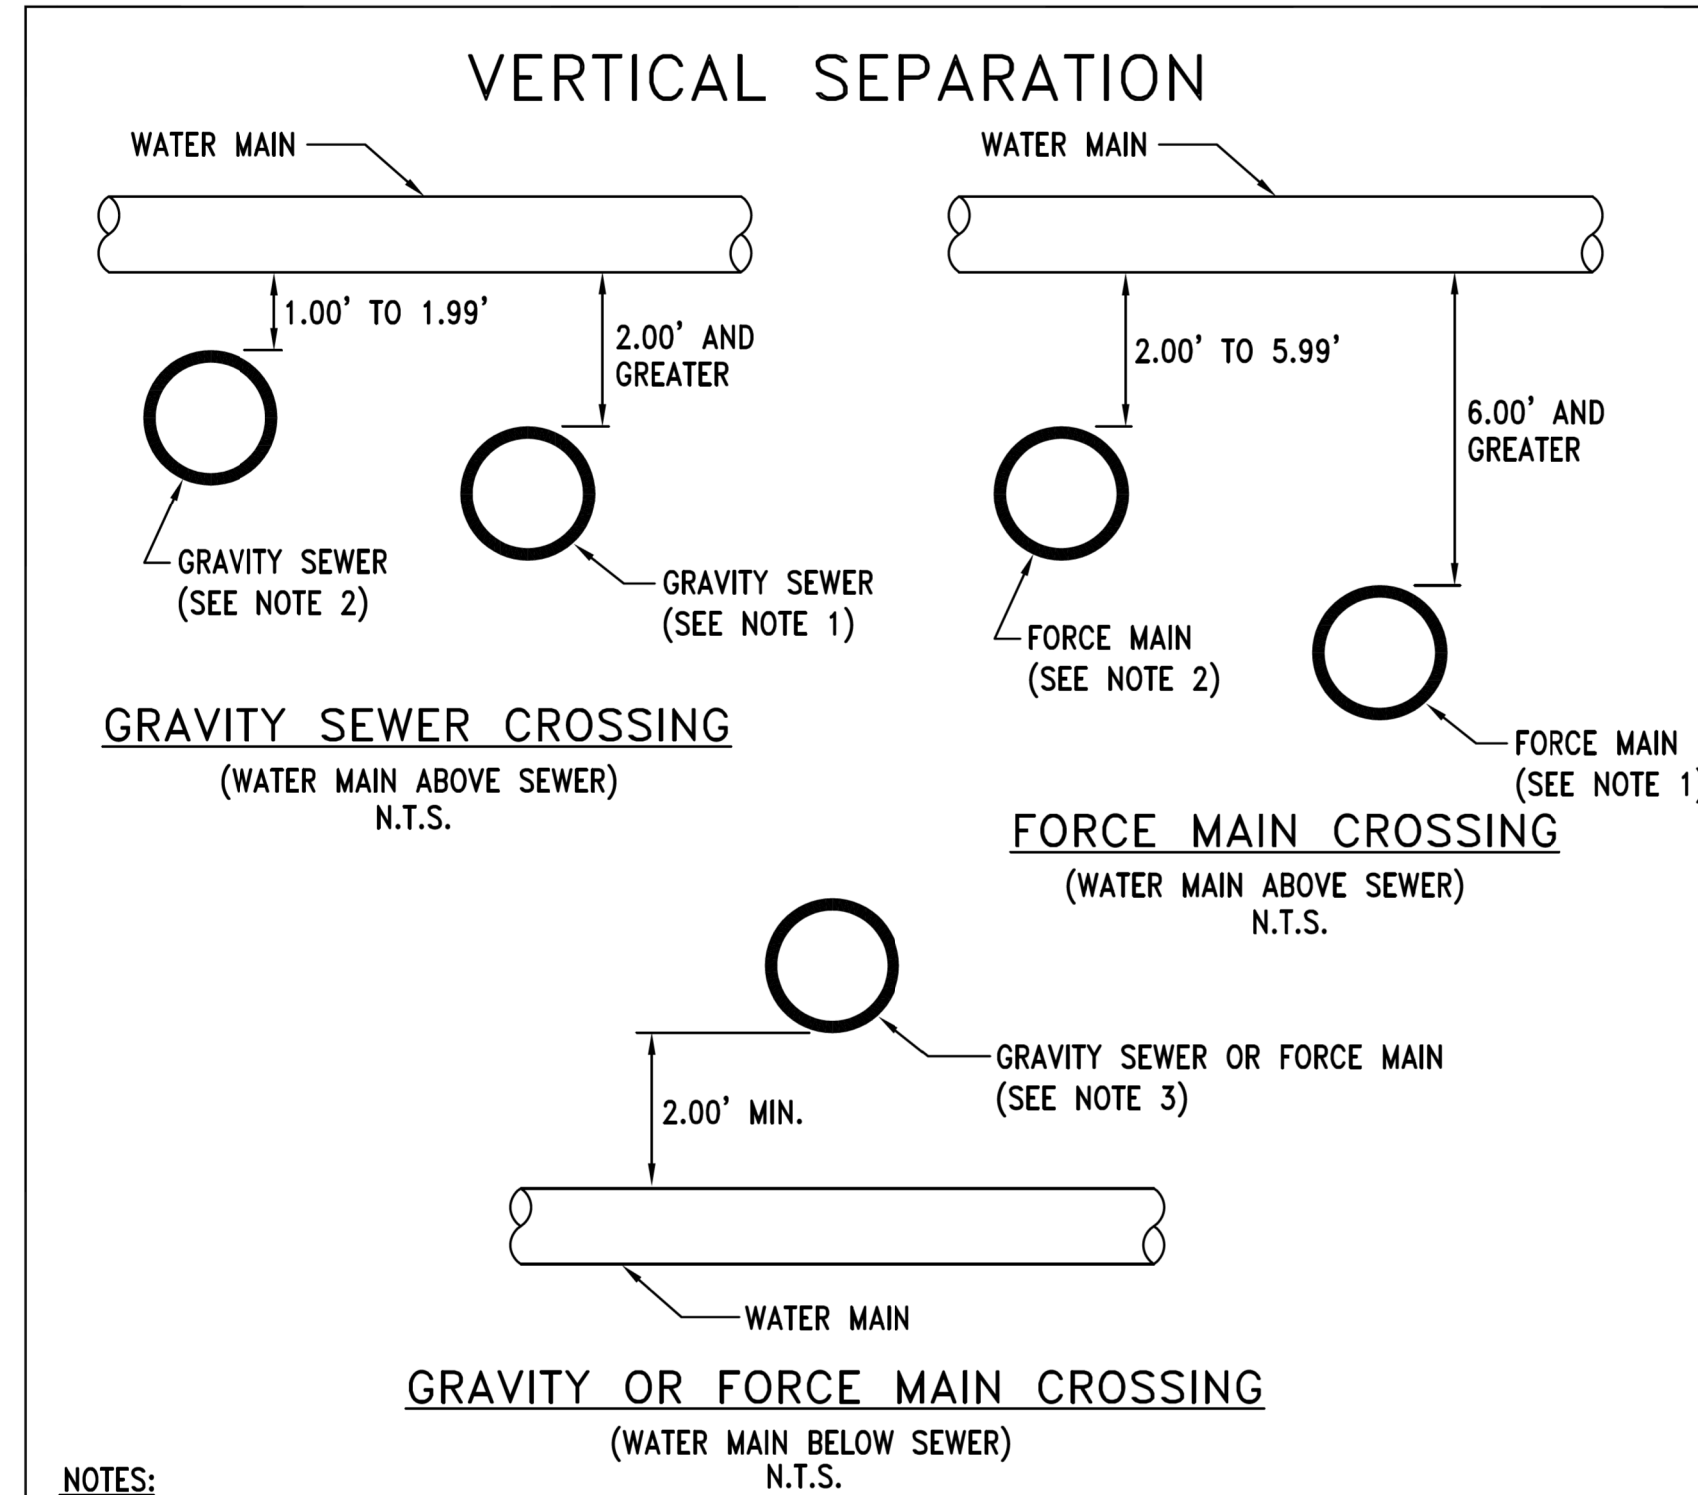

**NOTES:**

1. WHERE A WATER MAIN CROSSES ABOVE A GRAVITY SEWER WITH 2' OR GREATER VERTICAL CLEARANCE (OUTSIDE SURFACE TO OUTSIDE SURFACE), NO EXTRA PROTECTION IS REQUIRED. WHERE A WATER MAIN CROSSES ABOVE A FORCE MAIN WITH 6' OR GREATER VERTICAL CLEARANCE, NO EXTRA PROTECTION IS REQUIRED.
2. WHERE A WATER MAIN MUST CROSS ABOVE A GRAVITY SEWER WITH LESS THAN 2' OF CLEARANCE OR ABOVE A FORCE MAIN WITH LESS THAN 6' OF CLEARANCE, CONSTRUCT OR REPLACE THE SEWER LINE WITH DUCTILE IRON PIPE (D.I.P.) OR APPROVED EQUAL. IN NO CASE SHALL THE WATER MAIN HAVE LESS THAN 1' OF CLEARANCE ABOVE A GRAVITY SEWER OR 2' OF CLEARANCE ABOVE A FORCE MAIN. IF THE JOINT IS LOCATED LESS THAN 6' FROM THE OUTSIDE SURFACE OF THE WATER MAIN, THEN A RESTRAINED JOINT OR APPROVED EQUAL SHALL BE USED. REFER TO SHEET 3 OF 3.
3. WHERE A WATER MAIN CROSSES BELOW EITHER A GRAVITY SEWER OR A FORCE MAIN, CONSTRUCT OR REPLACE THE SEWER LINE WITH D.I.P. OR APPROVED EQUAL FOLLOWING THE GUIDELINES GIVEN IN NOTE NO. 2. IN NO CASE SHALL THE WATER MAIN BE LESS THAN 2' BELOW EITHER A GRAVITY SEWER OR FORCE MAIN.

ISSUED:	STANDARD DETAIL		DETAIL NO.
8/92	SEWER/WATER CROSSING DETAILS		RWRD 108
REVISED:			SHEET 1 OF 3
10/15			

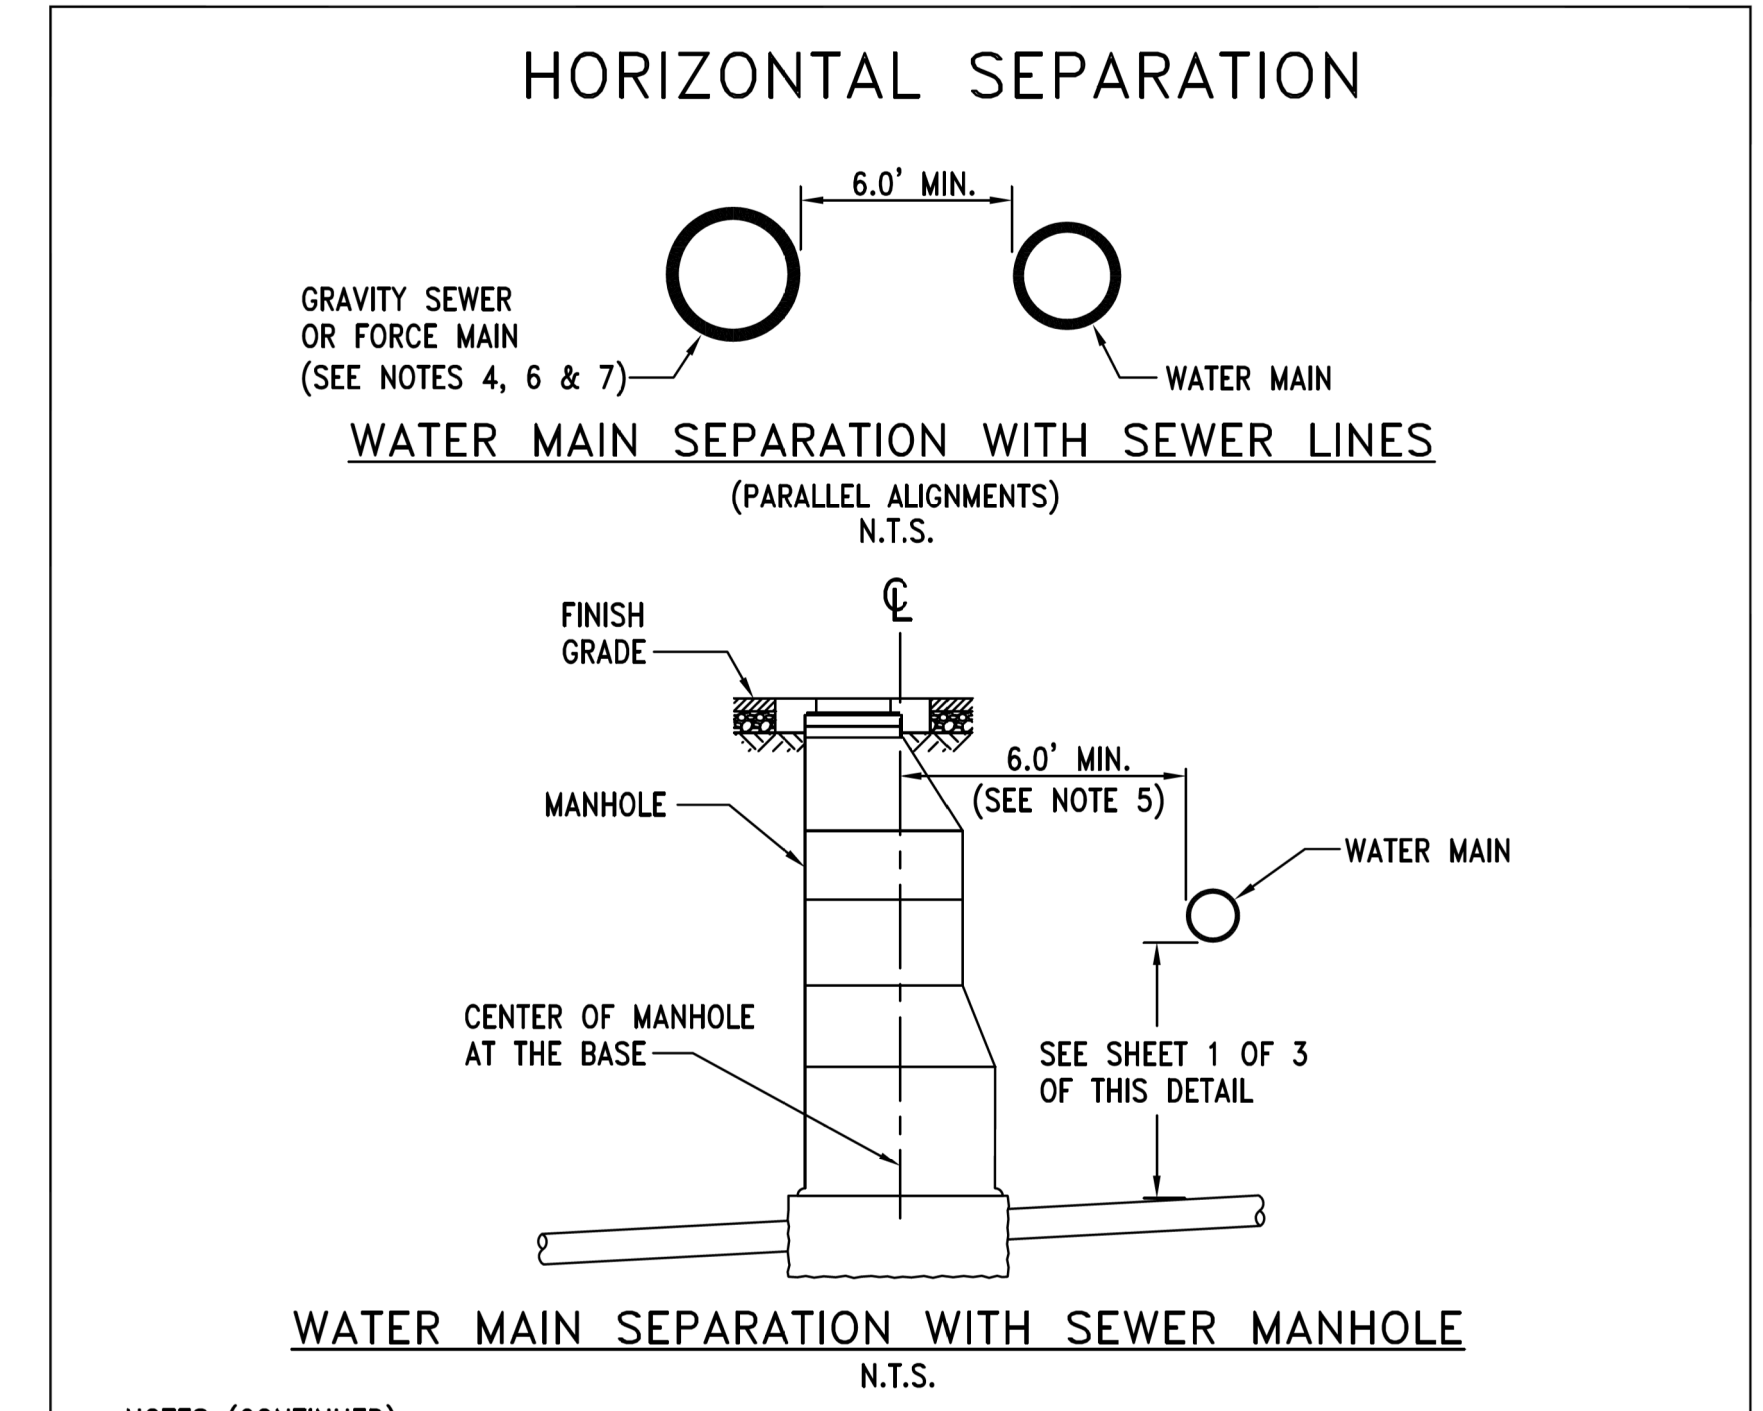

**NOTES (CONTINUED):**

4. THE MINIMUM HORIZONTAL CLEARANCE WITHOUT EXTRA PROTECTION BETWEEN A WATER MAIN AND A FORCE MAIN OR GRAVITY SEWER LINE SHALL BE 6' OUTSIDE SURFACE TO OUTSIDE SURFACE.
5. THE MINIMUM HORIZONTAL CLEARANCE BETWEEN A WATER MAIN AND A SEWER MANHOLE SHALL BE 6' FROM THE OUTSIDE SURFACE OF THE WATER MAIN TO THE CENTER OF MANHOLE.
6. WHERE A 6' HORIZONTAL CLEARANCE CANNOT BE MAINTAINED WITH A GRAVITY SEWER, CONSTRUCT OR REPLACE THE SEWER LINE WITH D.I.P. OR APPROVED EQUAL FOLLOWING THE GUIDELINES GIVEN IN NOTE NO. 2. IN NO CASE SHALL A GRAVITY SEWER LINE BE LOCATED LESS THAN 2' HORIZONTALLY FROM A WATER MAIN.
7. IN NO CASE SHALL A FORCE MAIN BE LOCATED LESS THAN 6' HORIZONTALLY FROM A WATER MAIN.
8. THE AMERICAN NATIONAL STANDARD FOR THE THICKNESS DESIGN OF D.I.P. (ANSI/AWWA C150/A21.50) SHALL BE USED TO DETERMINE THE REQUIRED PRESSURE CLASS EXCEPT FOR D.I.P. WITH A DIAMETER OF 3" THRU 24", A MINIMUM PRESSURE CLASS OF 350 IS REQUIRED. FOR D.I.P. WITH A DIAMETER GREATER THAN 24", A MINIMUM PRESSURE CLASS OF 200 IS REQUIRED.

ISSUED:	STANDARD DETAIL		DETAIL NO.
8/92	SEWER/WATER CROSSING DETAILS		RWRD 108
REVISED:			SHEET 2 OF 3
12/12			

G-2014-085


SHEET S59 OF S519

			WSP USA Inc. 177 N. Church Ave. Suite 1105 Tucson, AZ 85701	ARIZONA DEPARTMENT OF TRANSPORTATION INFRASTRUCTURE DELIVERY AND OPERATIONS DIVISION ROADWAY DESIGN SERVICES  RUTHRAUFF ROAD SEWER MODIFICATION PLANS DETAIL SHEET	
		ROUTE: I-10 LOCATION: RUTHRAUFF ROAD TI	DWG NO. U-3.09		
TRACS NO. H 8480 OIC		010-D(213)S		OF	



F.H.W.A. REGION	STATE	PROJECT NO.	SHEET NO.	TOTAL SHEETS	RECORD DRAWING
9	ARIZ.	010-D(213)S	840	849	


010 PM 252

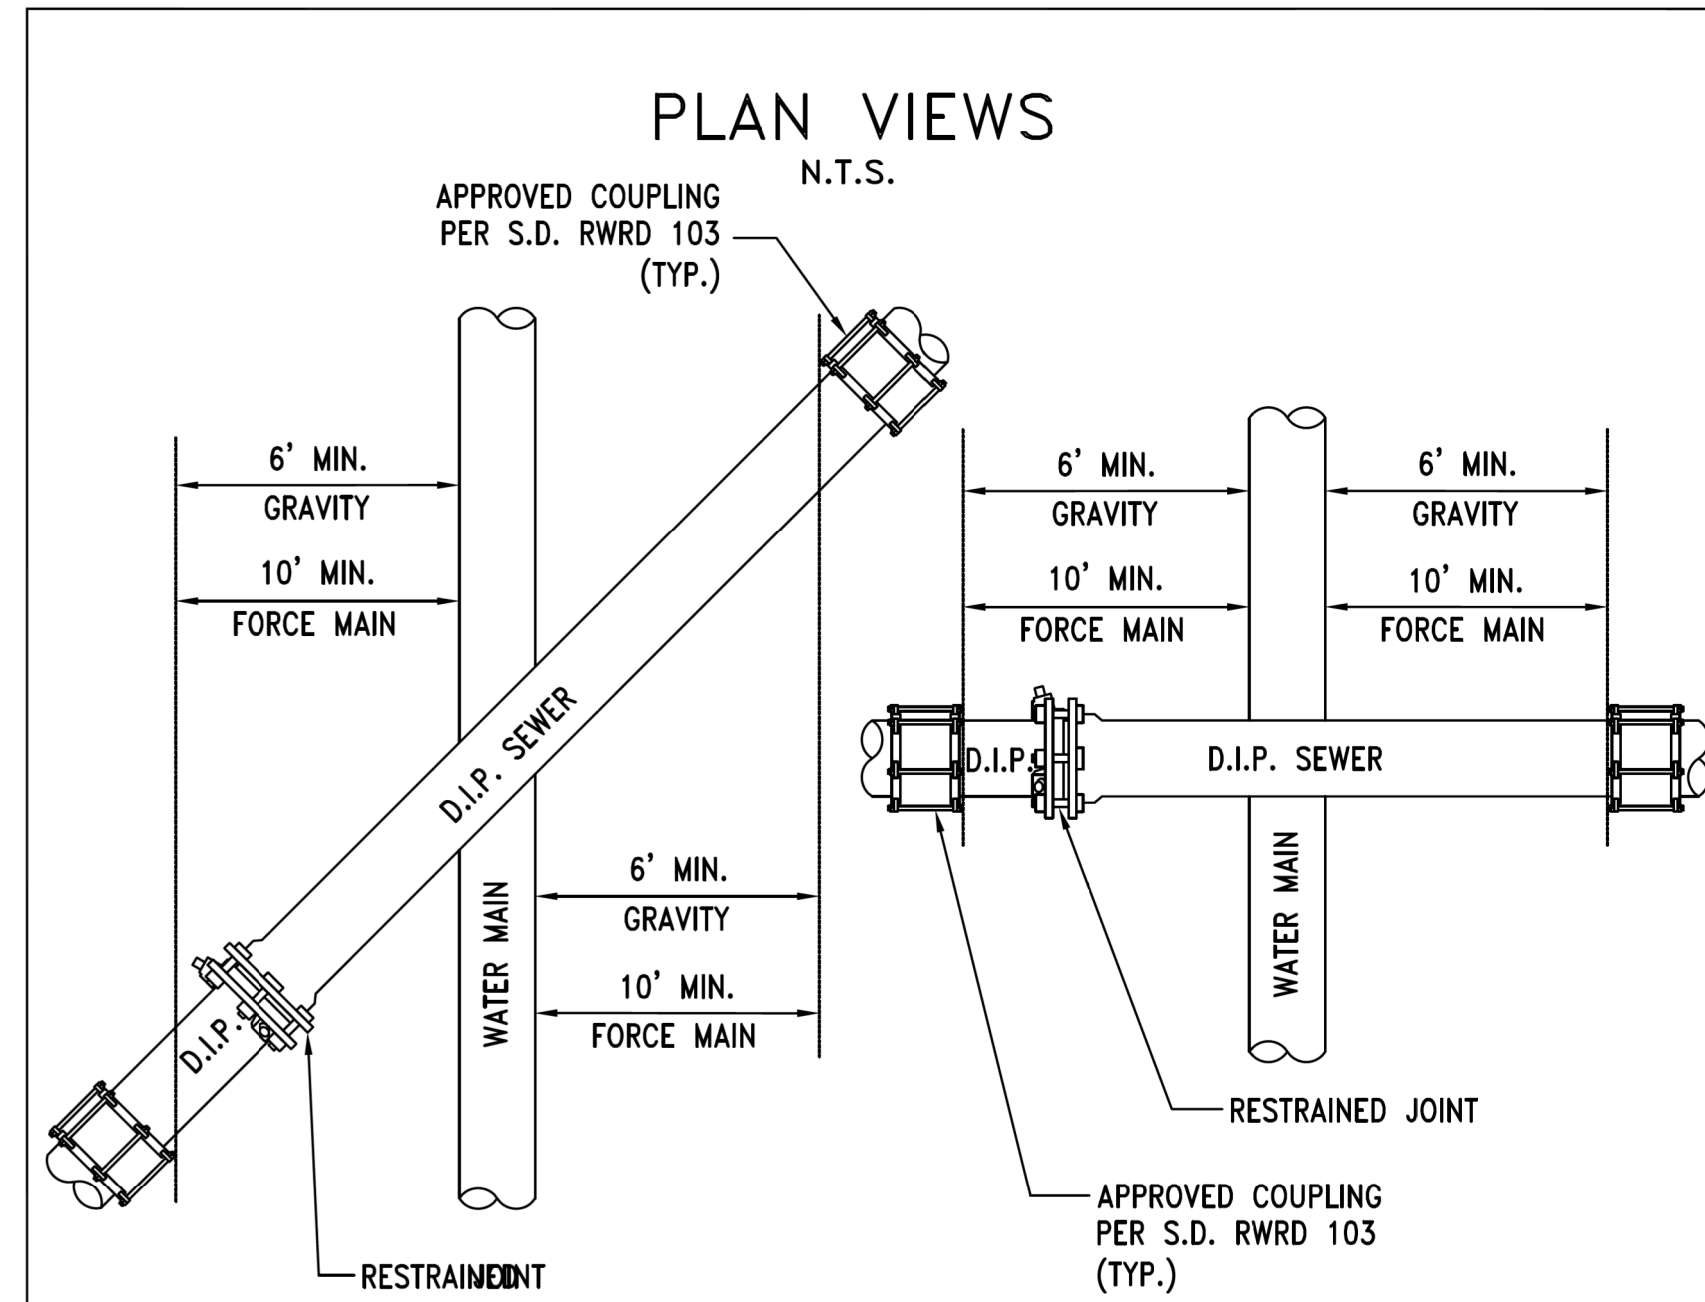

NOTES (CONTINUED):

- WHERE THE SEWER LINE IS A GRAVITY SEWER, THE D.I.P. INSTALLATION OR REPLACEMENT SHALL EXTEND A MINIMUM OF 6' BEYOND EACH SIDE OF THE WATER MAIN, MEASURED HORIZONTALLY FROM AND PERPENDICULAR TO THE WATER MAIN.
- WHERE THE SEWER LINE IS A FORCE MAIN, THE D.I.P. INSTALLATION OR REPLACEMENT SHALL EXTEND A MINIMUM OF 10' BEYOND EACH SIDE OF THE WATER MAIN, MEASURED HORIZONTALLY FROM AND PERPENDICULAR TO THE WATER MAIN.
- WHEN UNUSUAL CONDITIONS SUCH AS, BUT NOT LIMITED TO, HIGHWAY OR BRIDGE CROSSINGS PREVENT THE WATER AND SEWER LINE SEPARATIONS REQUIRED BY THIS DETAIL FROM BEING MET, PCRWRD WILL REVIEW AND MAY APPROVE (SUBJECT TO APPROVAL BY THE ENVIRONMENTAL REGULATORY AGENCY HAVING JURISDICTION), REQUESTS FOR AUTHORIZATION TO USE ALTERNATE CONSTRUCTION TECHNIQUES, MATERIALS AND JOINTS ON A CASE-BY-CASE BASIS.
- ALL DUCTILE IRON PIPE SHALL BE INTERNALLY LINED AND EXTERNALLY WRAPPED PER SUBSECTION 3.2.2(D).


ISSUED:	STANDARD DETAIL		DETAIL NO.
8/92	SEWER/WATER CROSSING DETAILS		RWRD 108
REVISD:			SHEET 3 OF 3
12/12			

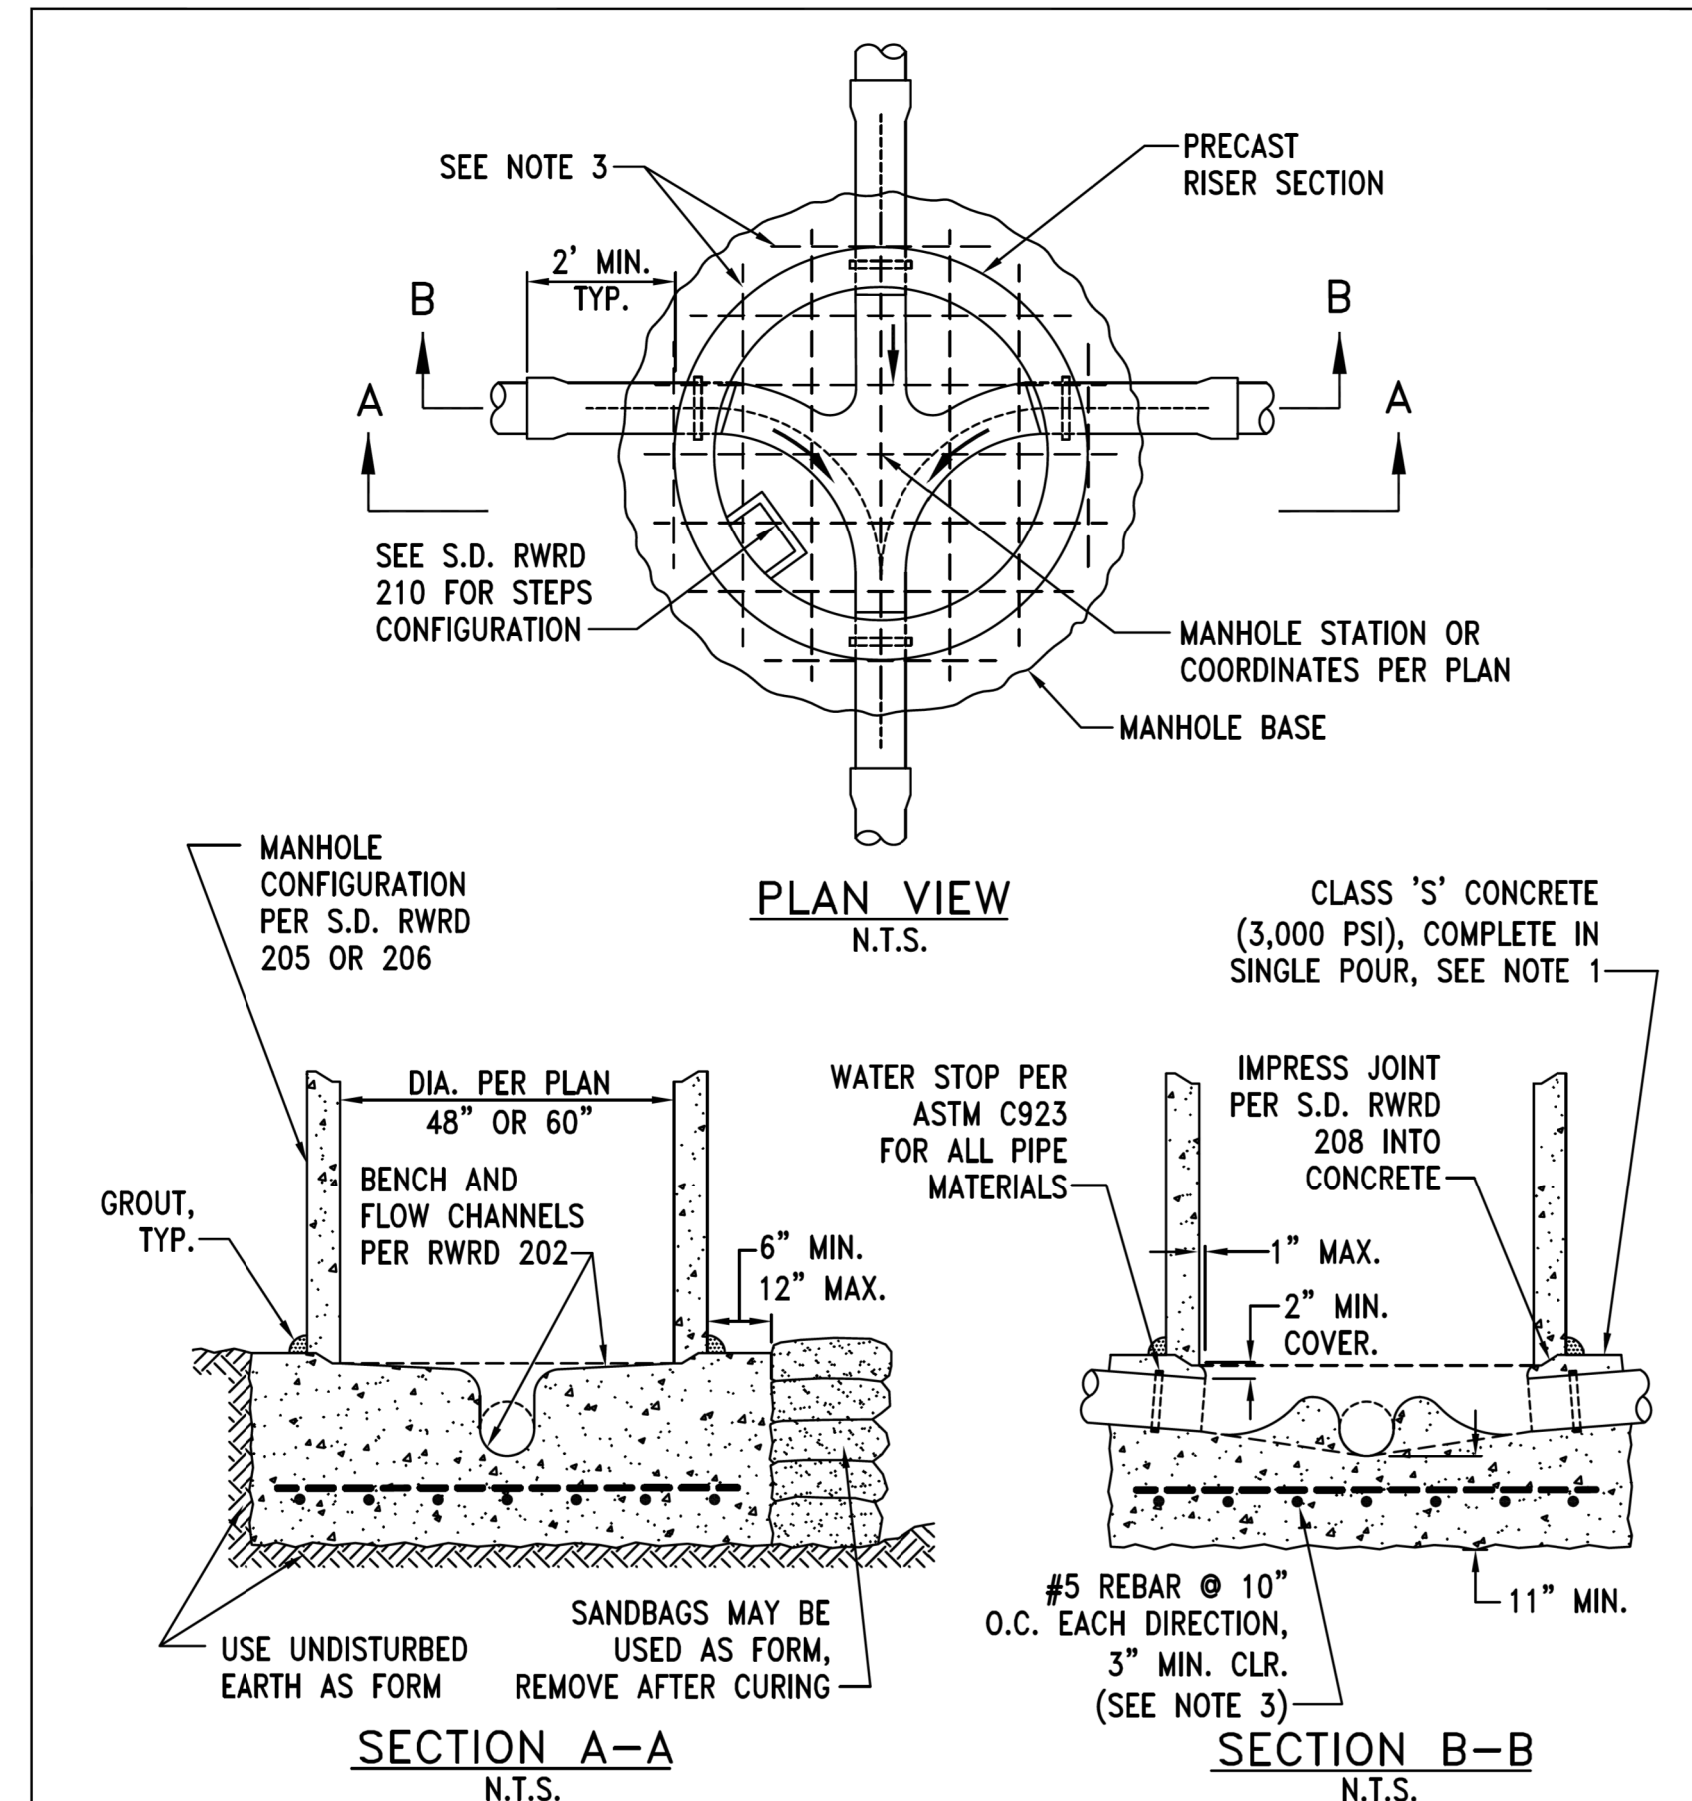

NOTES:

- FOR NEXT DAY INSTALLATIONS OF PRECAST SECTIONS ON A NEWLY-POURED CONCRETE BASE, USE HIGH-EARLY, CLASS 'S' CONCRETE HAVING A MIN. COMPRESSIVE STRENGTH OF 2,000 PSI AT 24 HOURS AS DEMONSTRATED BY LABORATORY TESTING OF SAMPLE CYLINDERS.
- SEE SUBSECTION 3.3.3(B)(i) FOR MORE INFORMATION.
- REINFORCEMENT REQUIRED FOR MANHOLE DEPTHS (RIM TO INVERT) OF 20' OR GREATER.

ISSUED:	STANDARD DETAIL		DETAIL NO.
8/92	CAST-IN-PLACE MANHOLE BASE		RWRD 201
REVISD:			SHEET 1 OF 1
10/15			

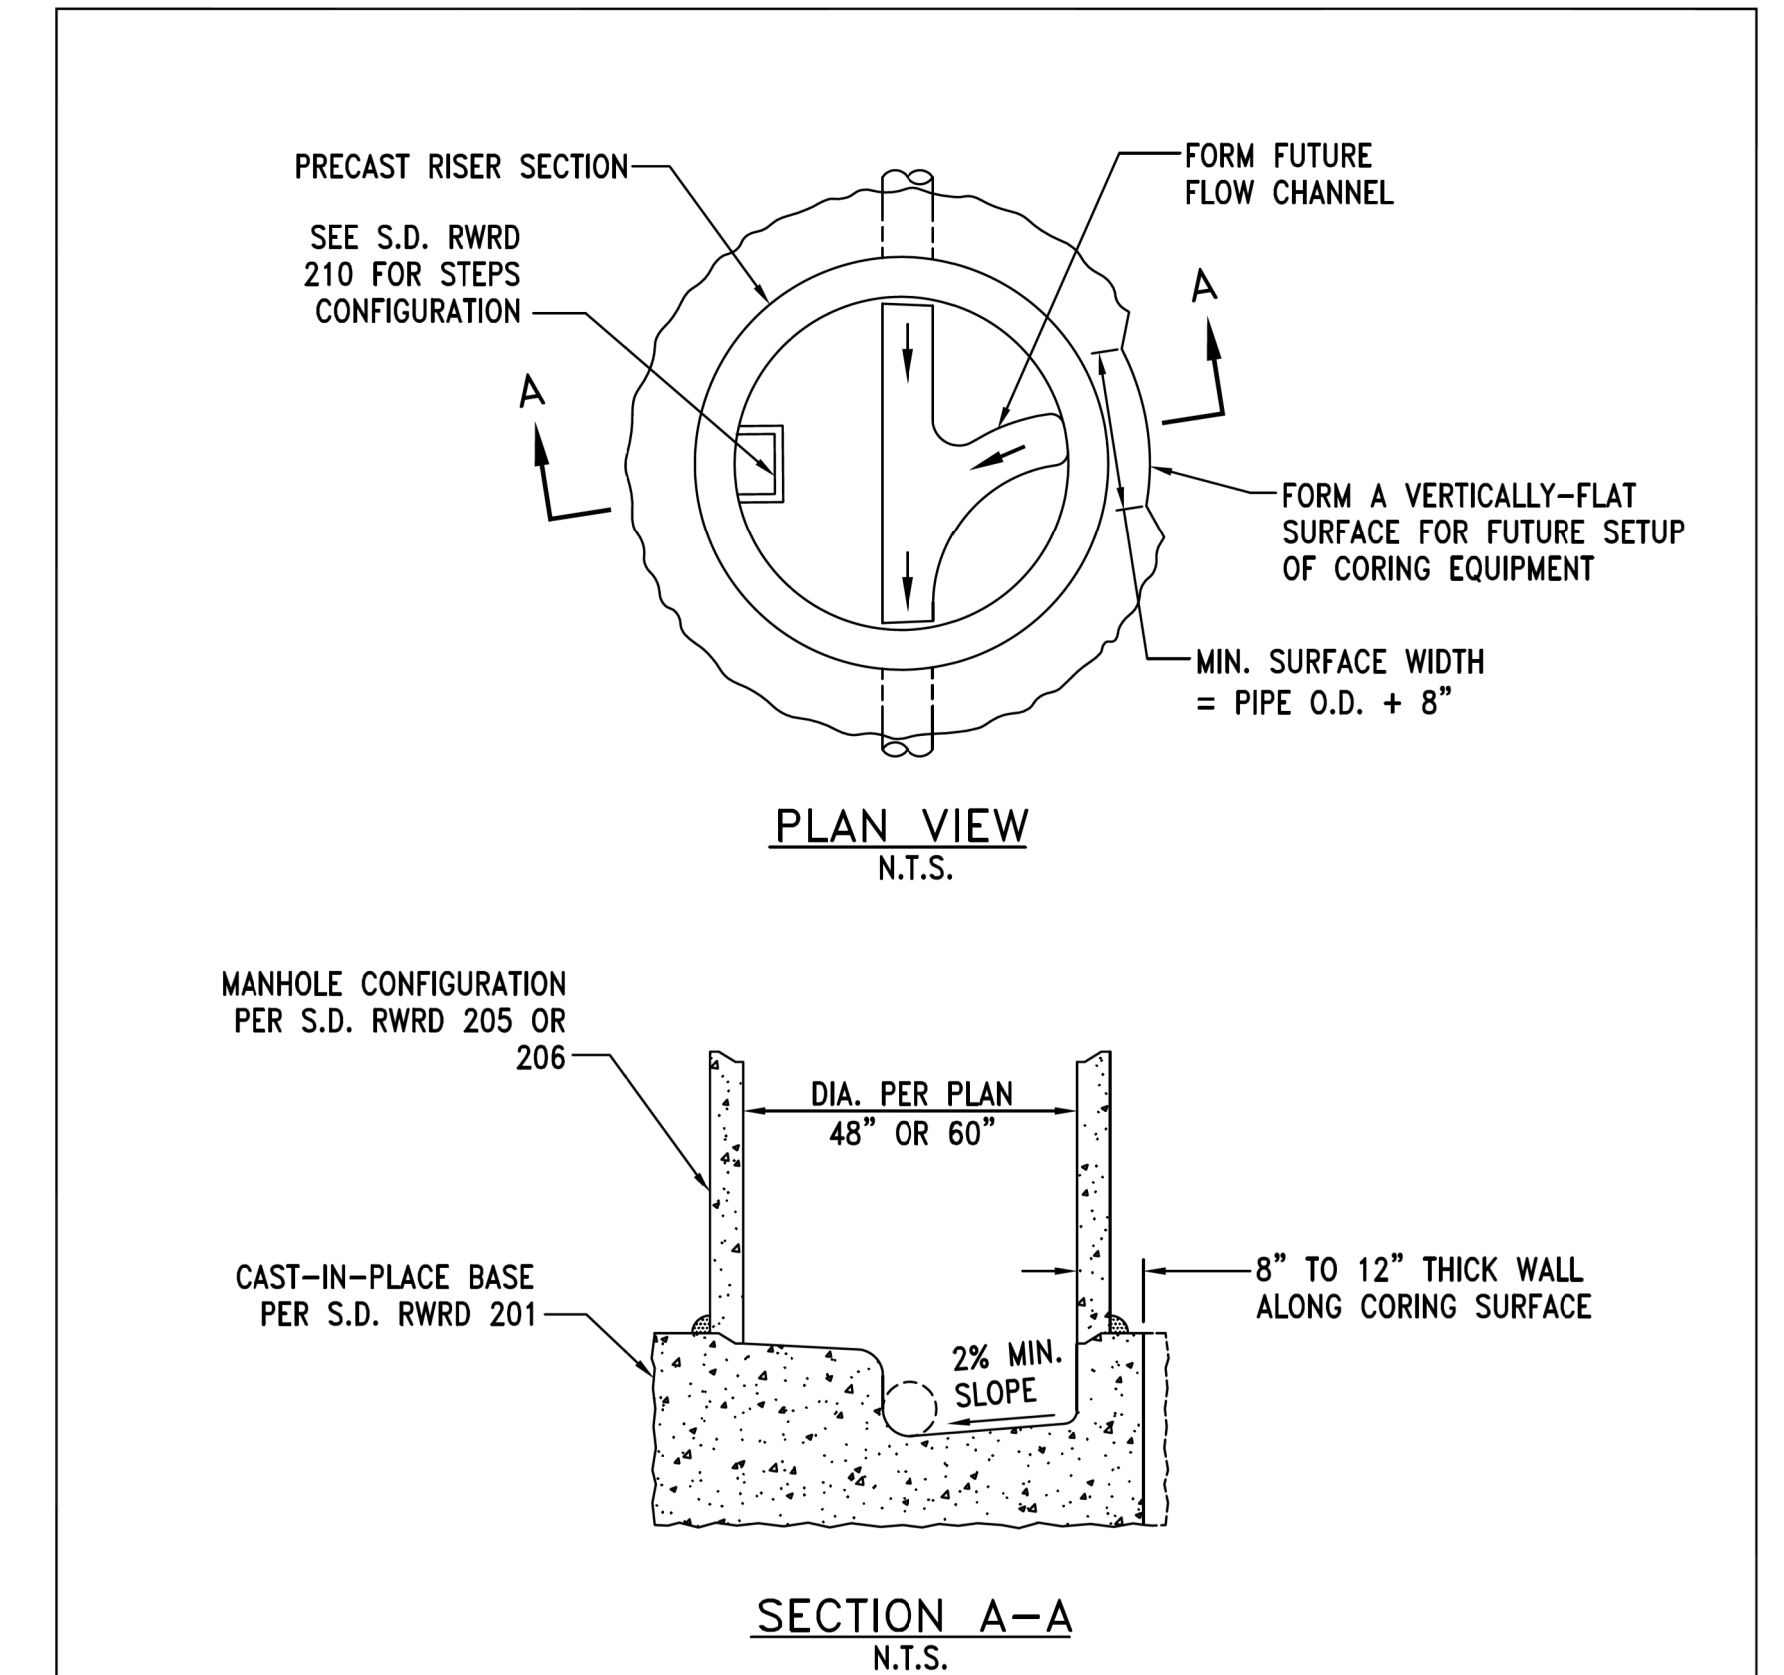

NOTES:

- THIS DETAIL APPLIES TO 4' AND 5' DIAMETER MANHOLES. FOR LARGER DIAMETER MANHOLES, REFER TO PLAN FOR BLOCK-OUT REQUIREMENTS.
- FOR PRECAST BASES, MANUFACTURER SHALL FURNISH BLOCK-OUT CAPS FOR THE PRE-INSTALLED MANHOLE CONNECTOR IN LIEU OF USING 2" MORTAR COVER.

ISSUED:	STANDARD DETAIL		DETAIL NO.
8/92	BLOCK-OUTS		RWRD 203
REVISD:			SHEET 1 OF 1
12/12			

G-2014-085

SHEET SS10 OF SS19


DESIGN	DL	DATE	3-19	ARIZONA DEPARTMENT OF TRANSPORTATION INFRASTRUCTURE DELIVERY AND OPERATIONS DIVISION ROADWAY DESIGN SERVICES	
DRAWN	CPG	DATE	3-19		
CHECKED	FF	DATE	3-19		
ROUTE		LOCATION		RUTHRAUFF ROAD T1	
TRACS NO. H 8480 OIC		010-D(213)S		DWG NO. U-3.10	



NO.	DATE	REVISION	BY	CHKD.	APPR.


F.H.W.A. REGION	STATE	PROJECT NO.	SHEET NO.	TOTAL SHEETS	RECORD DRAWING
9	ARIZ.	010-D(213)S	841	849	

010 PM 252

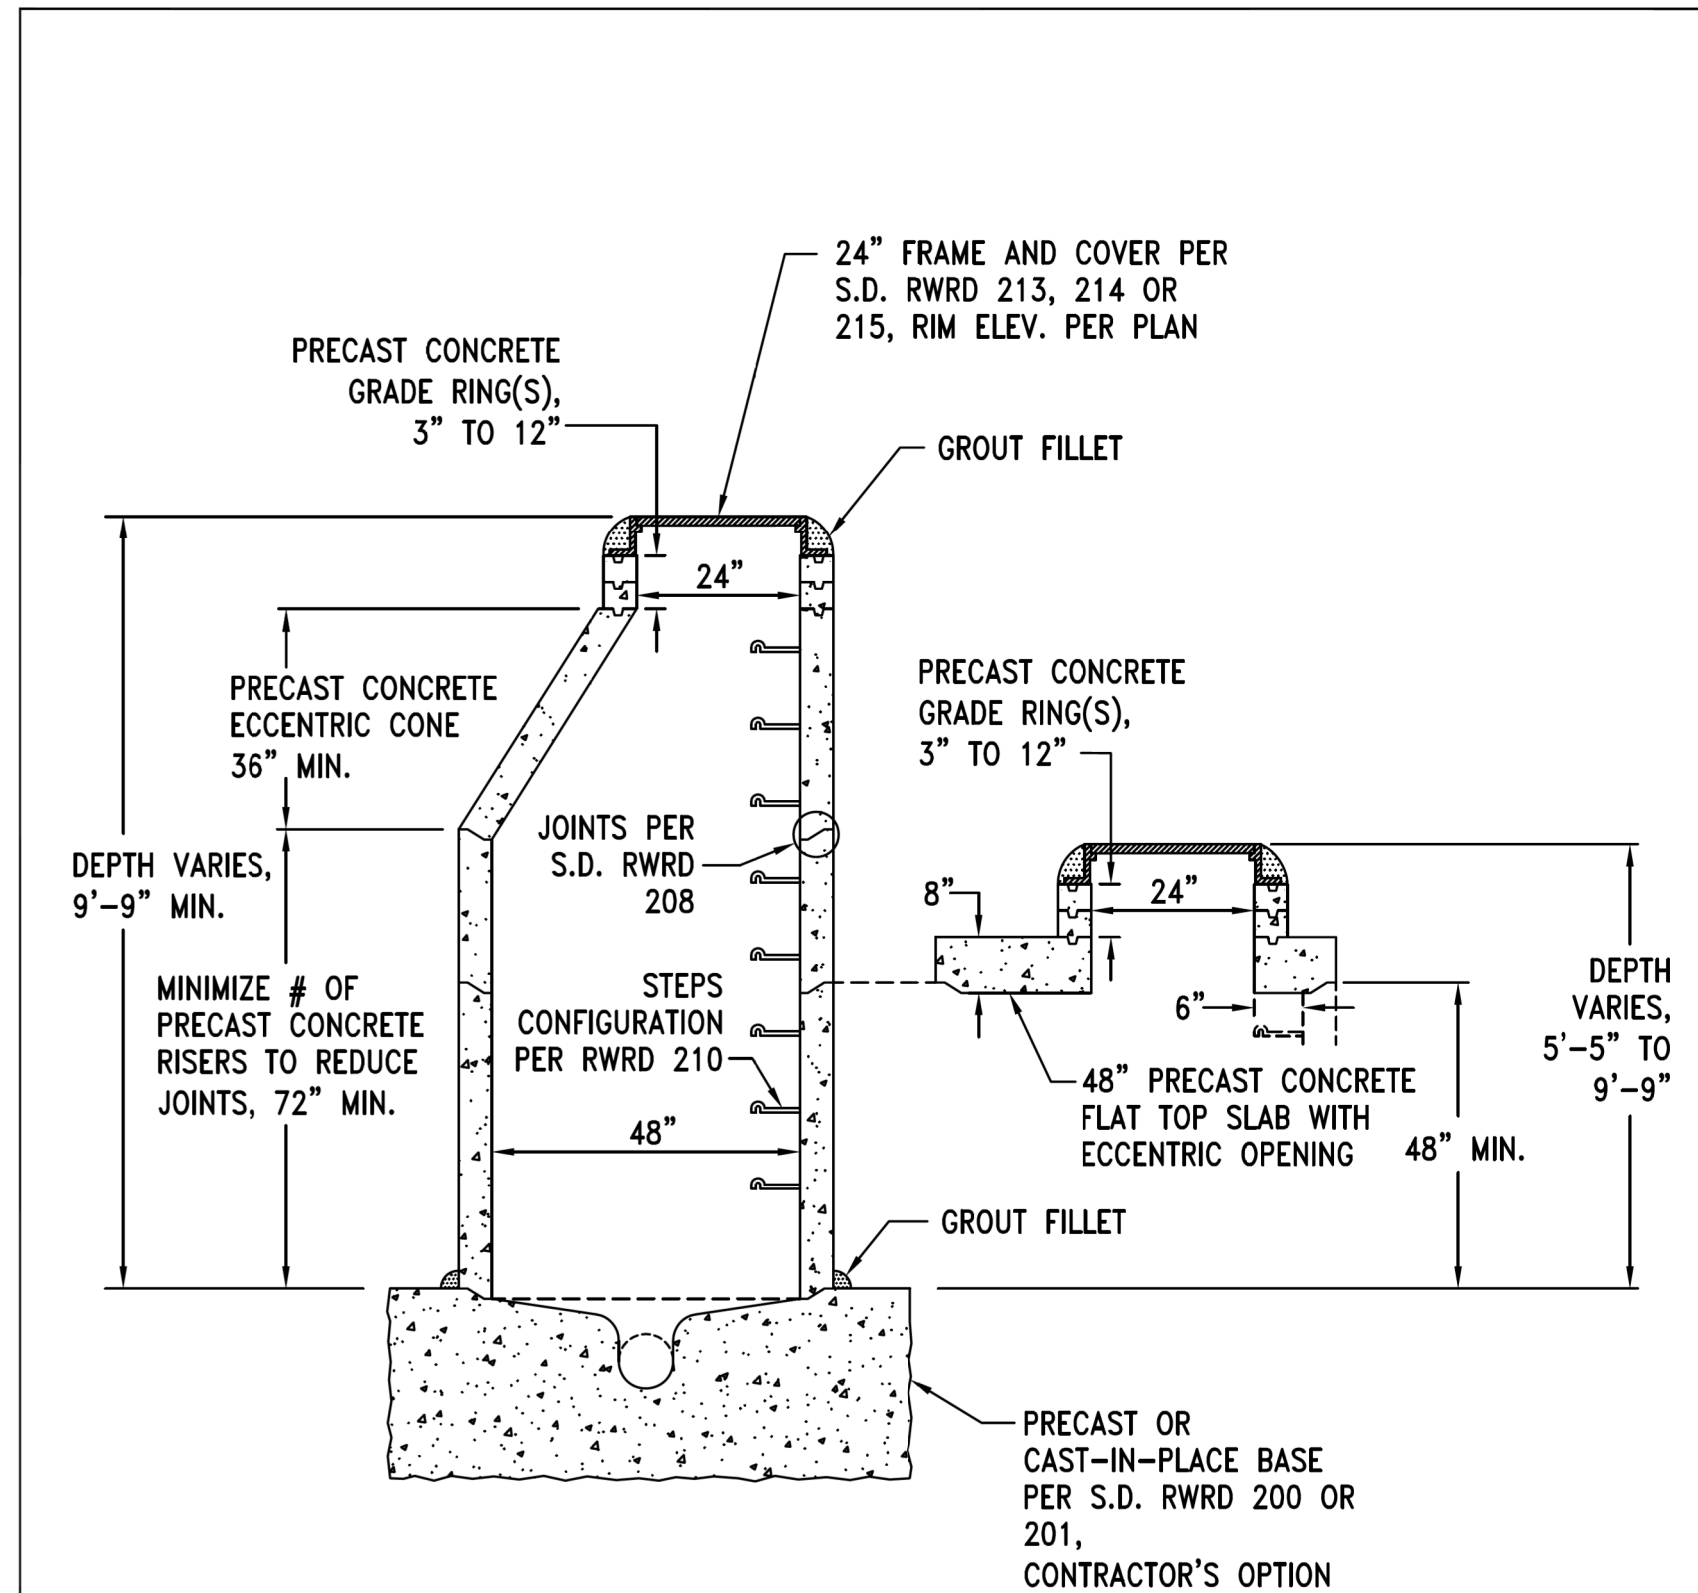


- NOTES:
1. PRECAST CONCRETE MANHOLE SECTIONS SHALL CONFORM TO ASTM C478 AND AASHTO M199.
  2. FOR 4' DIAMETER MANHOLE DEPTHS LESS THAN 5'-5" (SHALLOW MANHOLES), SEE S.D. RWRD 207; TYPE I.
  3. SEE SUBSECTIONS 3.3.2(E) AND 3.3.3 FOR MORE INFORMATION.

ISSUED:	STANDARD DETAIL	DETAIL NO.
8/92	4' DIAMETER MANHOLE CONFIGURATIONS	RWRD 205
REVISED:		
10/15		SHEET 1 OF 1

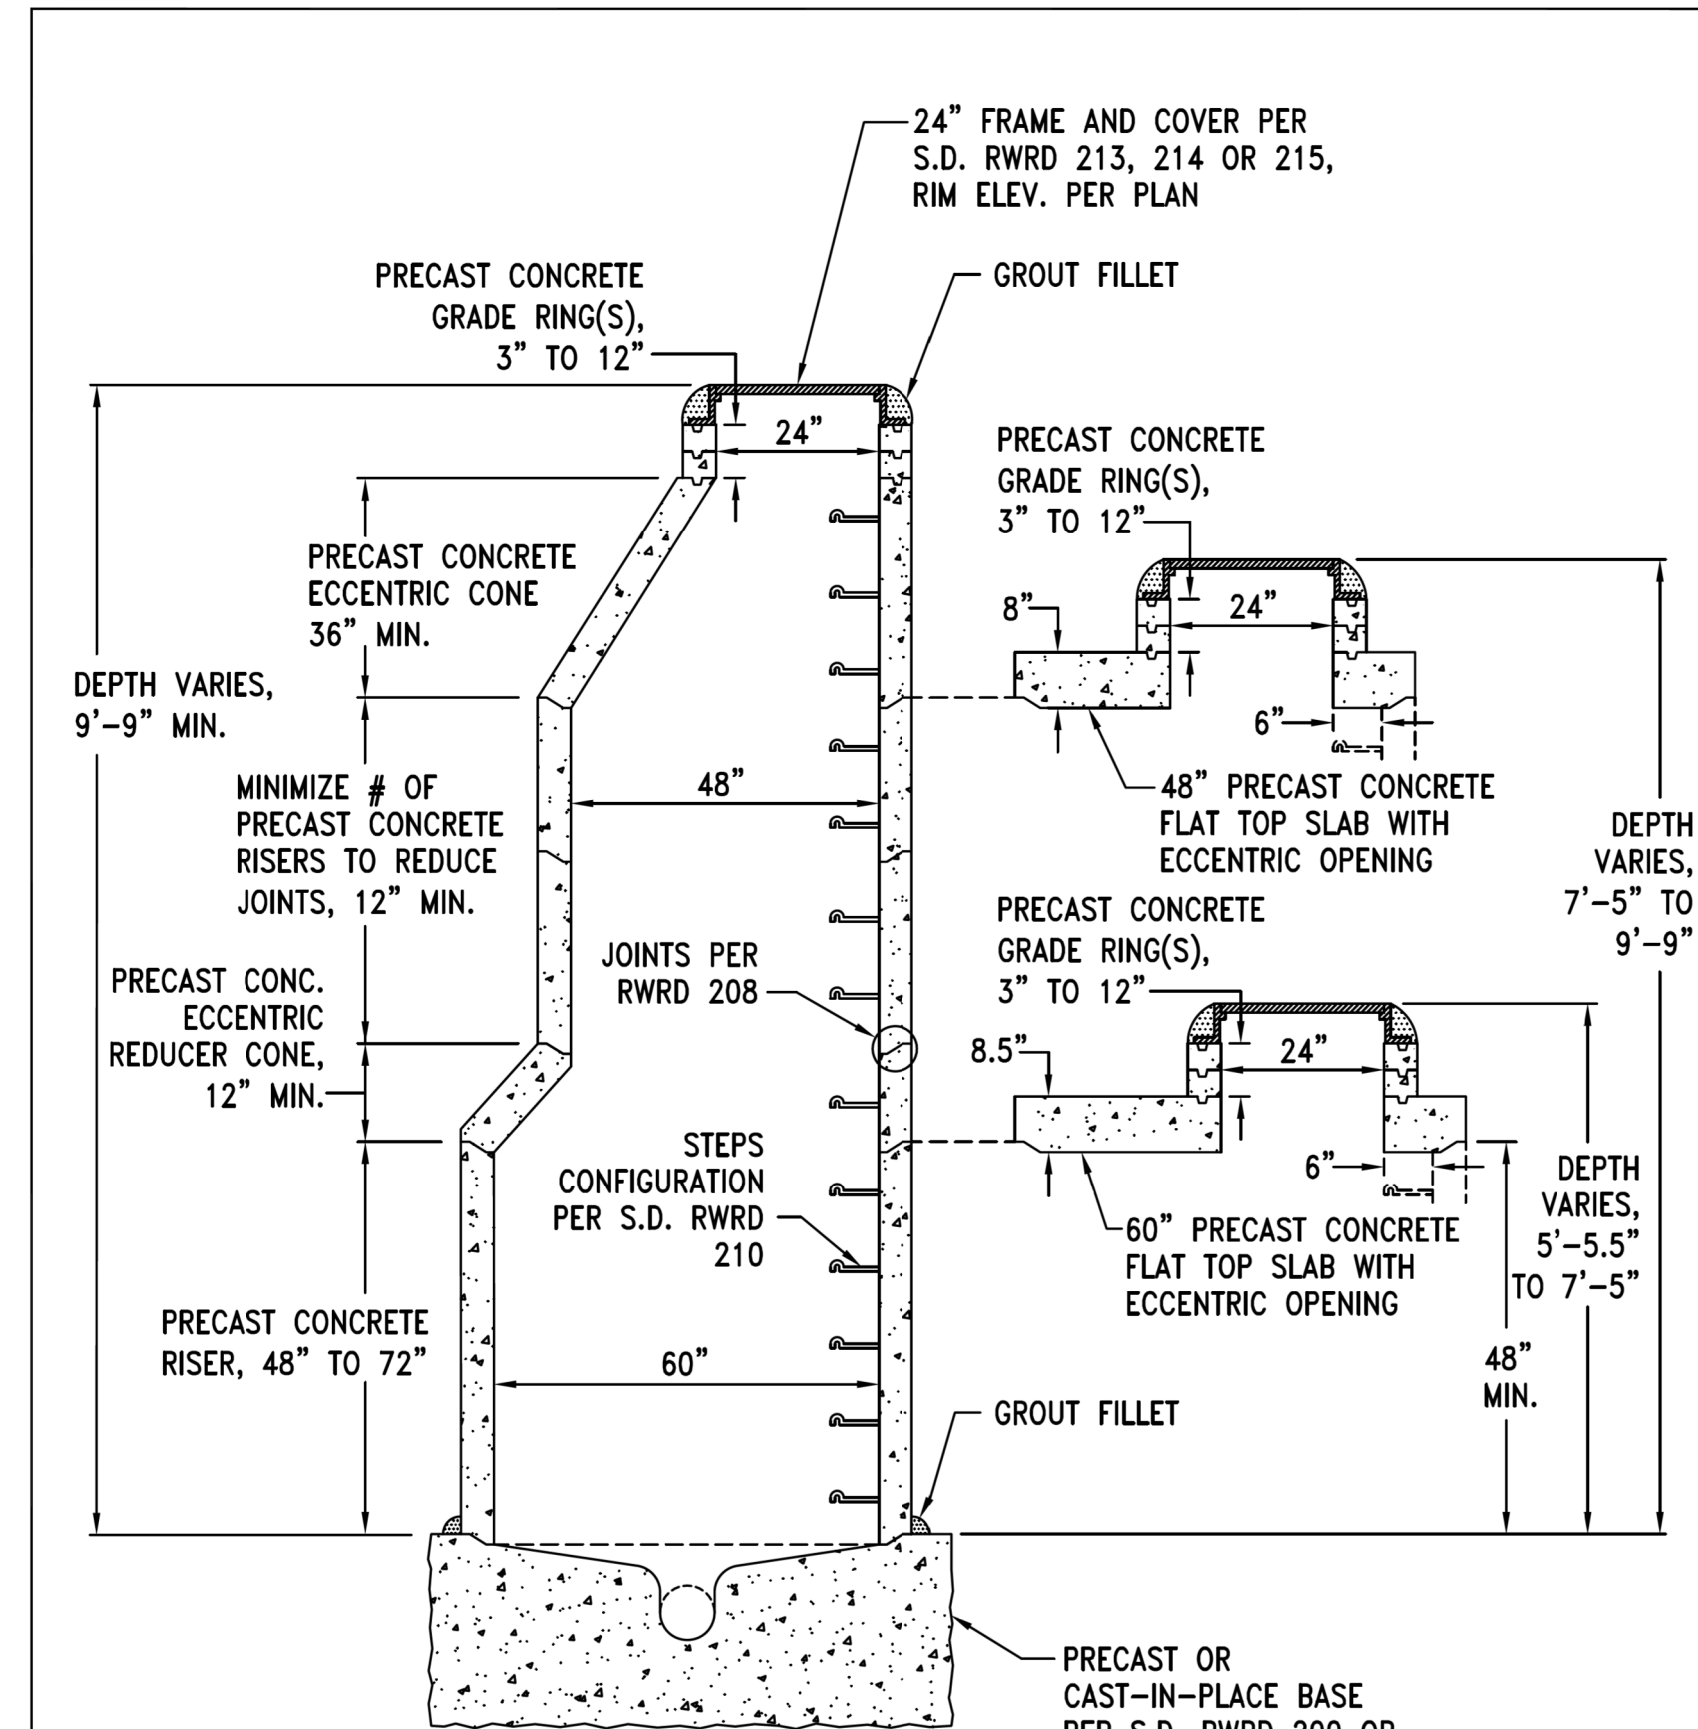

- NOTES:
1. PRECAST CONCRETE MANHOLE SECTIONS SHALL CONFORM TO ASTM C478 AND AASHTO M199.
  2. FOR 5' DIAMETER MANHOLE DEPTHS LESS THAN 5'-5.5" (SHALLOW MANHOLES), SEE S.D. RWRD 207; TYPE II.
  3. SEE SUBSECTIONS 3.3.2(E) AND 3.3.3 FOR MORE INFORMATION.

ISSUED:	STANDARD DETAIL	DETAIL NO.
8/92	5' DIAMETER MANHOLE CONFIGURATIONS	RWRD 206
REVISED:		
10/15		SHEET 1 OF 1

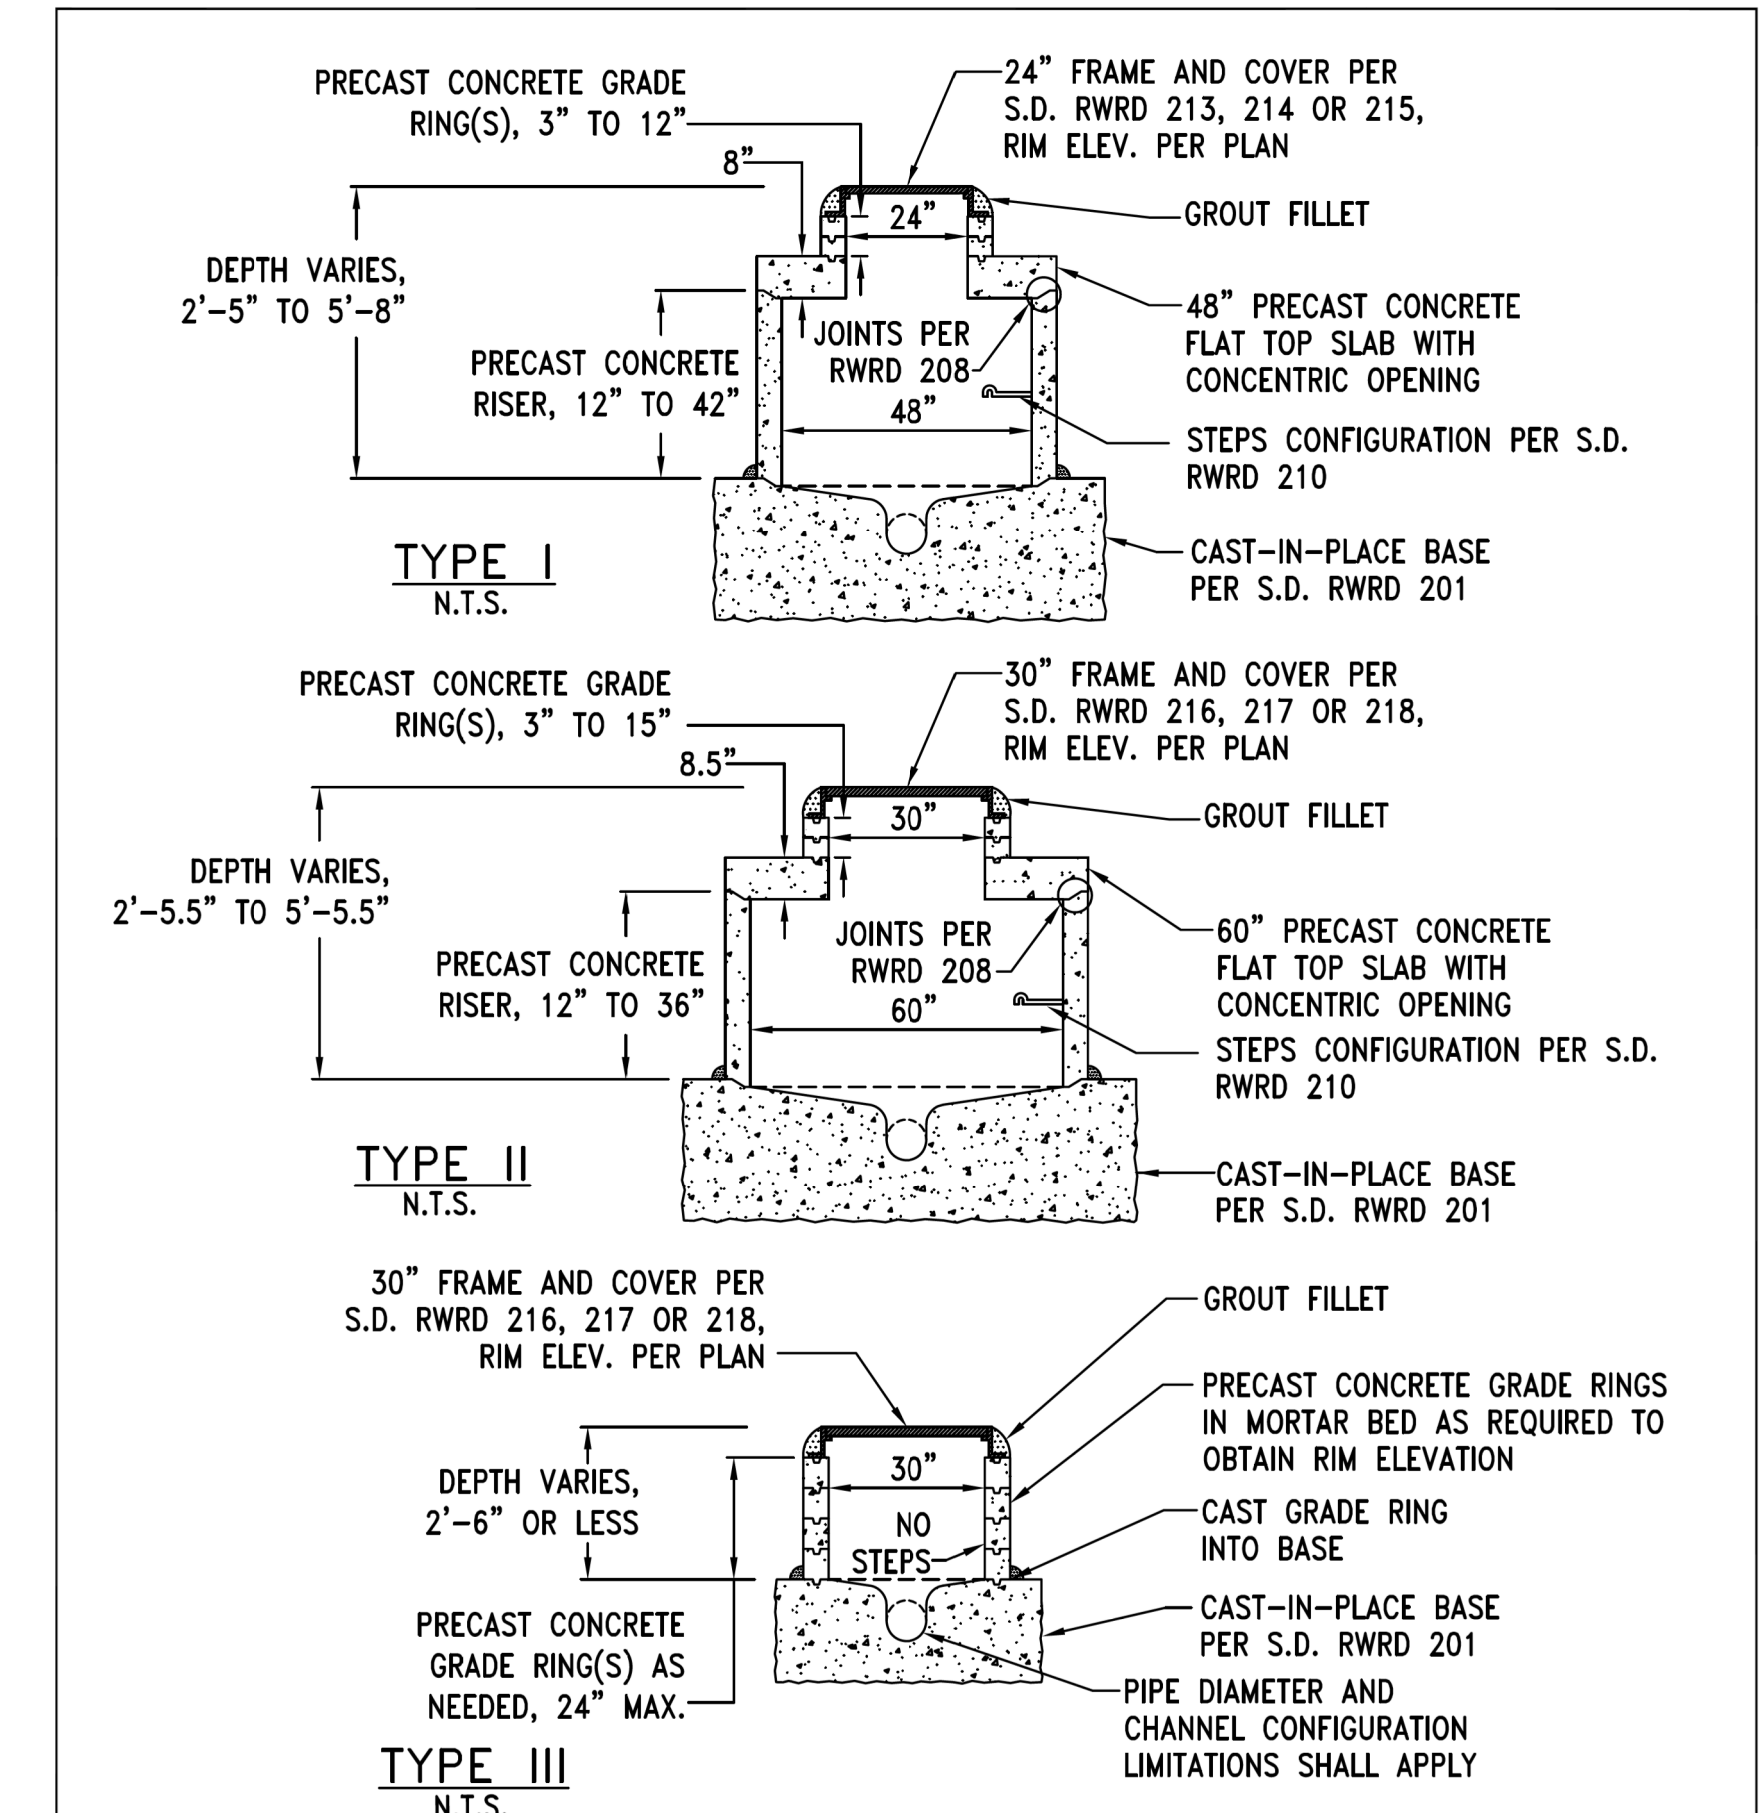


- NOTES:
1. THIS SPECIAL STANDARD DETAIL MAY BE USED BY THE CONTRACTOR IF APPROVED IN THE PLANS OR IN WRITING BY THE FIELD ENGINEER.
  2. PRECAST CONCRETE MANHOLE SECTIONS SHALL CONFORM TO ASTM C478 AND AASHTO M199.
  3. SEE SUBSECTIONS 3.3.2(E) AND 3.3.3 FOR MORE INFORMATION.

ISSUED:	SPECIAL STANDARD DETAIL	DETAIL NO.
8/92	SHALLOW MANHOLES	RWRD 207
REVISED:		
10/15		SHEET 1 OF 1



SHEET SS11 OF SS19

DESIGN	DL	DATE	3-19	ARIZONA DEPARTMENT OF TRANSPORTATION INFRASTRUCTURE DELIVERY AND OPERATIONS DIVISION ROADWAY DESIGN SERVICES
DRAWN	CPG	DATE	3-19	
CHECKED	FF	DATE	3-19	
ROUTE		LOCATION		RUTHRAUFF ROAD SEWER MODIFICATION PLANS DETAIL SHEET
I-10		RUTHRAUFF ROAD T1		
TRACS NO. H 8480 OIC		010-D(213)S		DWG NO. U-3.11

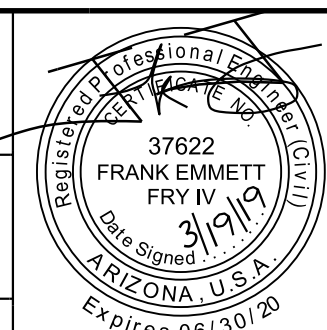


NO.	DATE	REVISION	BY	CHKD.	APPR.

G-2014-085




F.H.W.A. REGION	STATE	PROJECT NO.	SHEET NO.	TOTAL SHEETS	RECORD DRAWING
9	ARIZ.	010-D(213)S	842	849	

010 PM 252

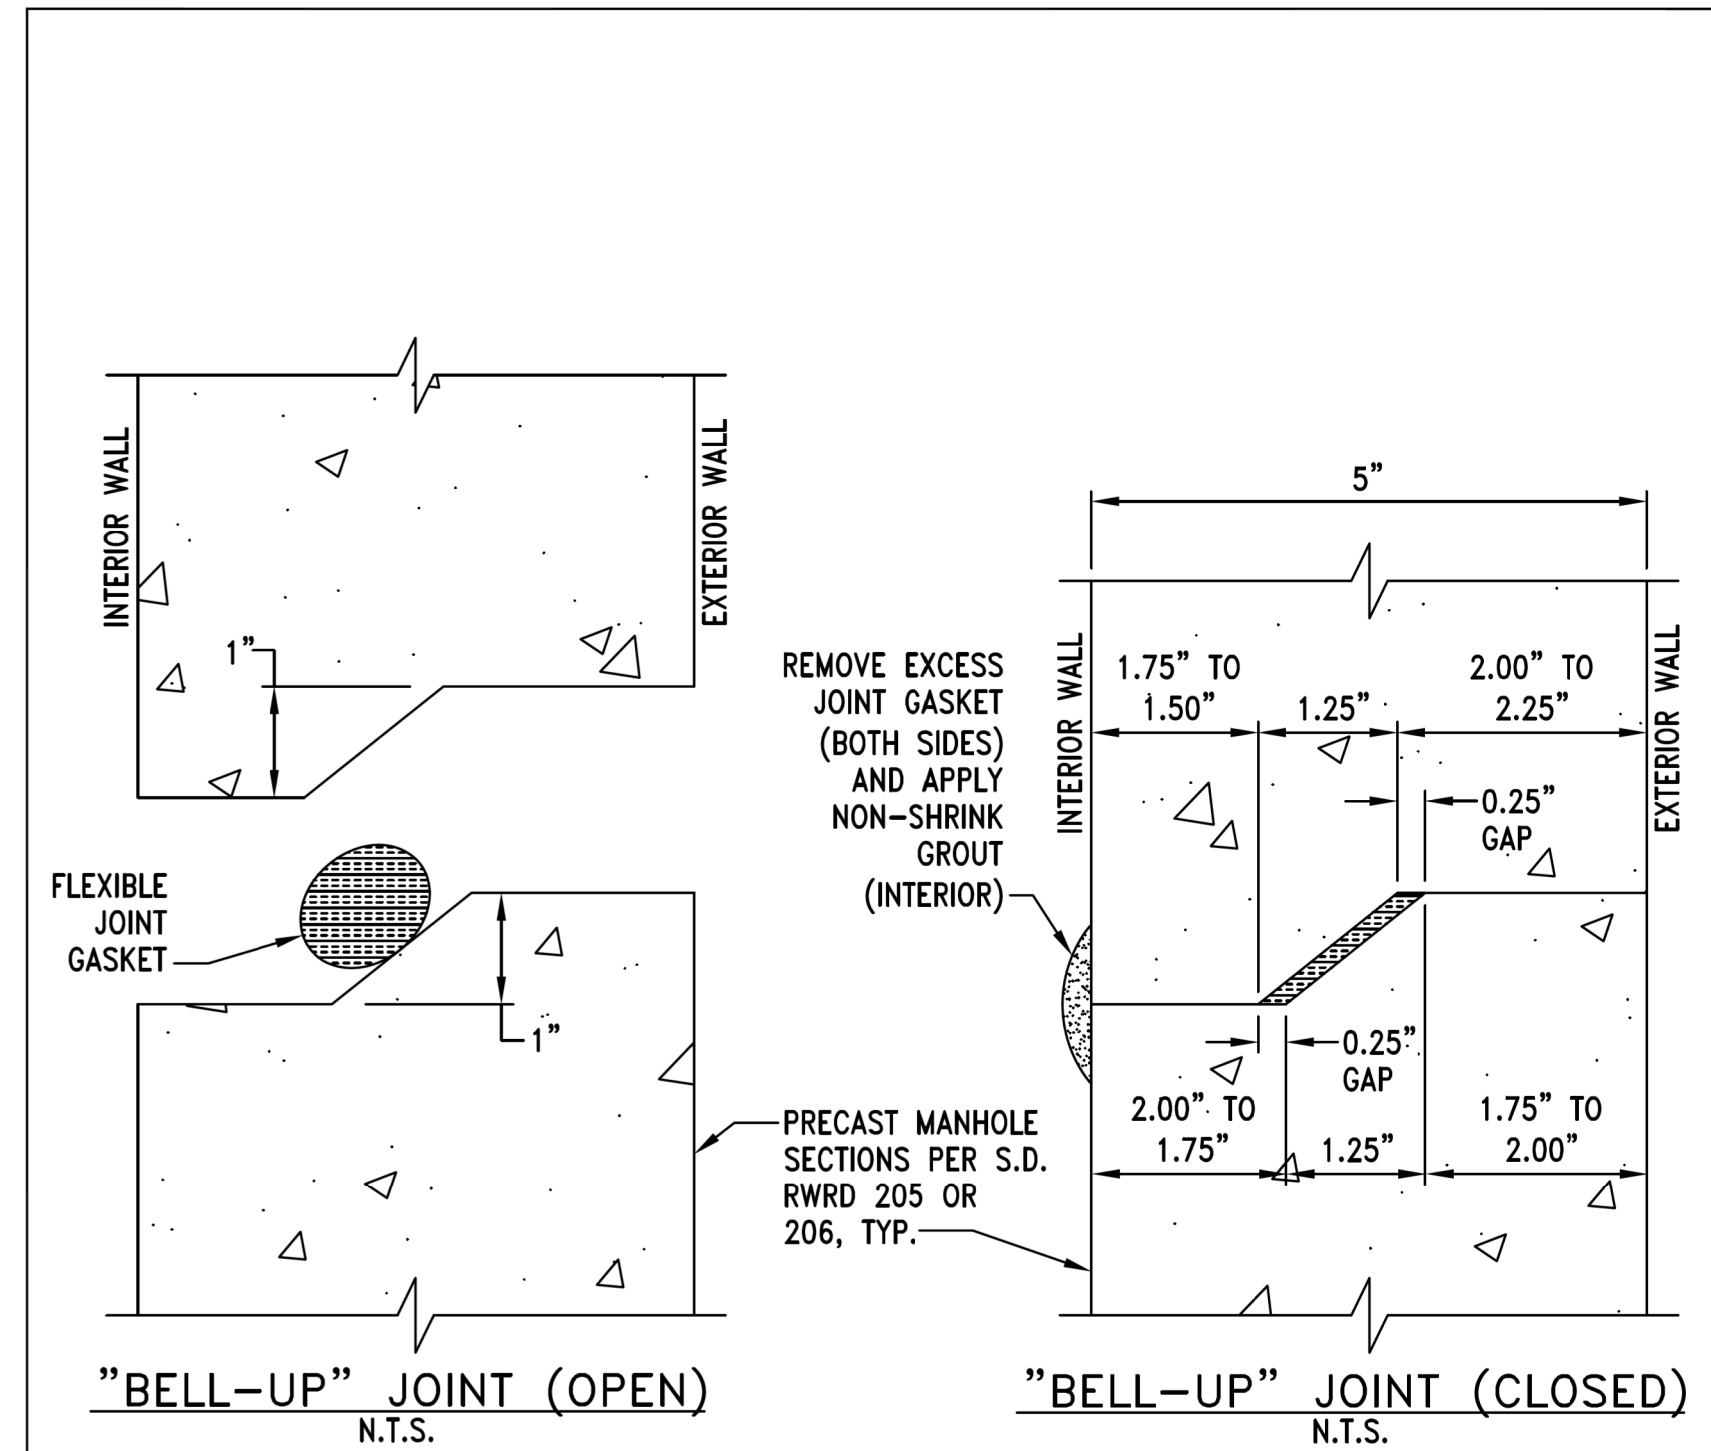


- NOTES:**
1. THIS DETAIL APPLIES TO 4' AND 5' DIAMETER PRECAST MANHOLE SECTIONS. SHOP DRAWINGS AND JOINT DETAILS FOR LARGER MANHOLE DIAMETERS SHALL BE SUBMITTED TO THE FIELD ENGINEER FOR REVIEW AND APPROVAL.
  2. THE MIXING OF JOINTS WITHIN A MANHOLE IS NOT PERMITTED WITHOUT APPROVAL BY THE FIELD ENGINEER.
  3. SEE SUBSECTION 3.3.3(B)(iii) FOR MORE INFORMATION.

ISSUED:	STANDARD DETAIL	DETAIL NO.
8/92 (WWM-226)		RWRD 208
REVISED:		MANHOLE JOINTS
12/12		SHEET 1 OF 1

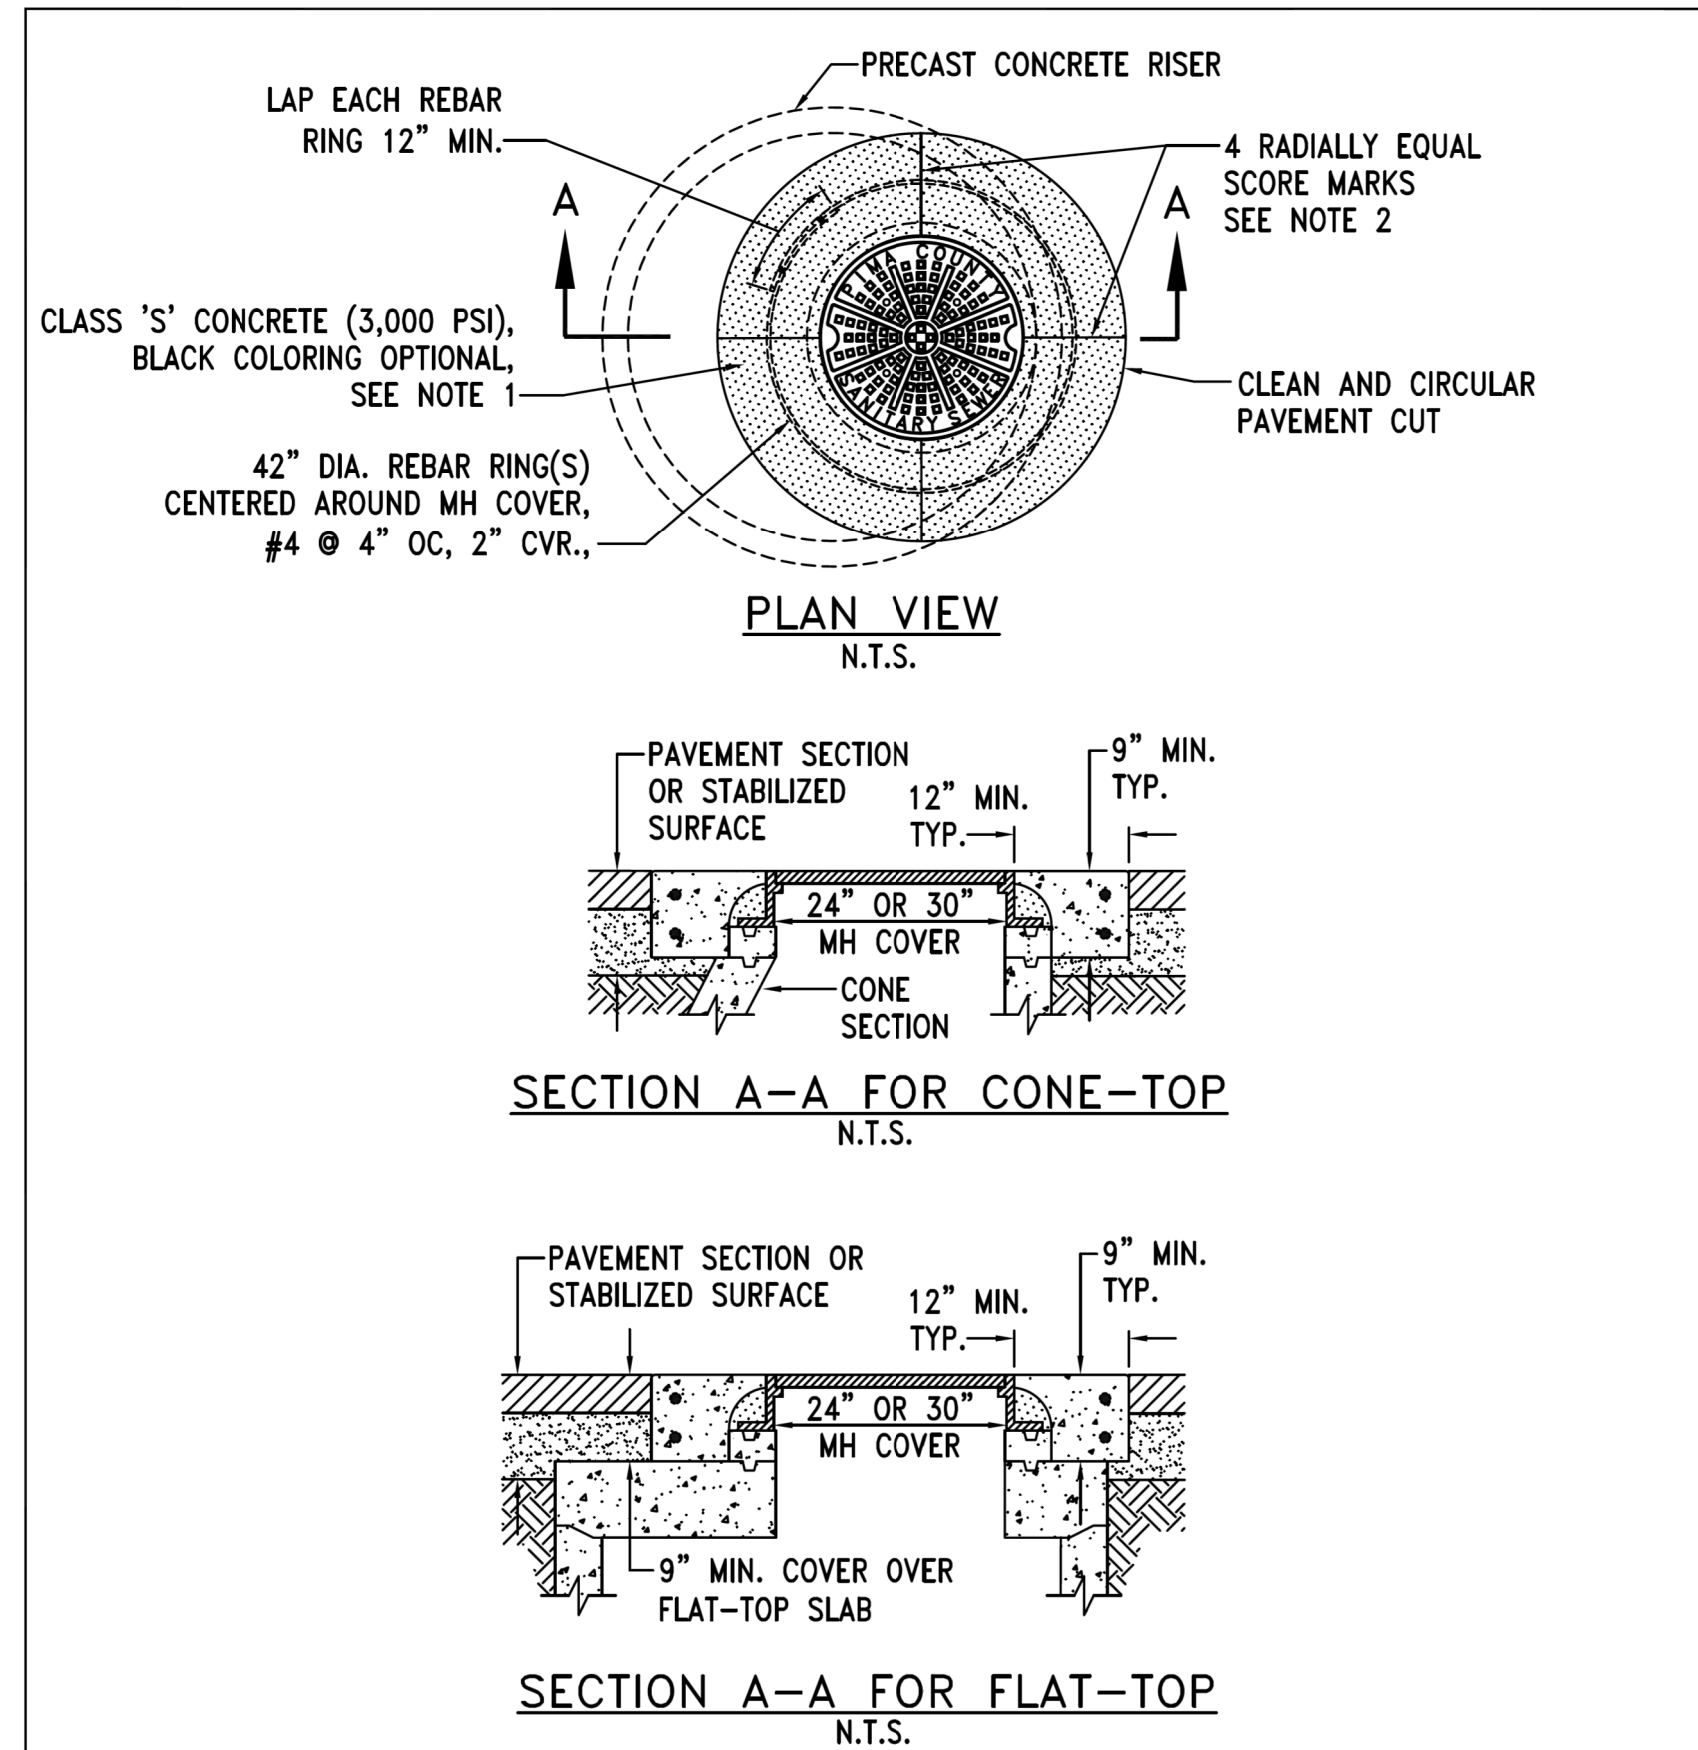

- NOTES:**
1. FOR MANHOLES LOCATED WITHIN RIGHT-OF-WAY, OPTIONS SHOWN (E.G. COLORING AGENTS AND CONCEALED/ REVEALED COLLARS) WILL BE DICTATED BY THE TRANSPORTATION AGENCY HAVING JURISDICTION.
  2. FINISH ALL CONCRETE EDGES AND SCORE MARKS WITH A HAND TROWEL HAVING A 1/4" RADIUS. EXPOSED SURFACES SHALL HAVE A MEDIUM BROOM FINISH.
  3. MINIMUM COLLAR THICKNESS MAY BE REDUCED TO 6" FOR SLAB COVER DEPTHS OF 11" OR LESS.

ISSUED:	STANDARD DETAIL	DETAIL NO.
12/12		RWRD 211
REVISED:		CONCRETE COLLAR FOR PAVED AREAS
		SHEET 1 OF 1

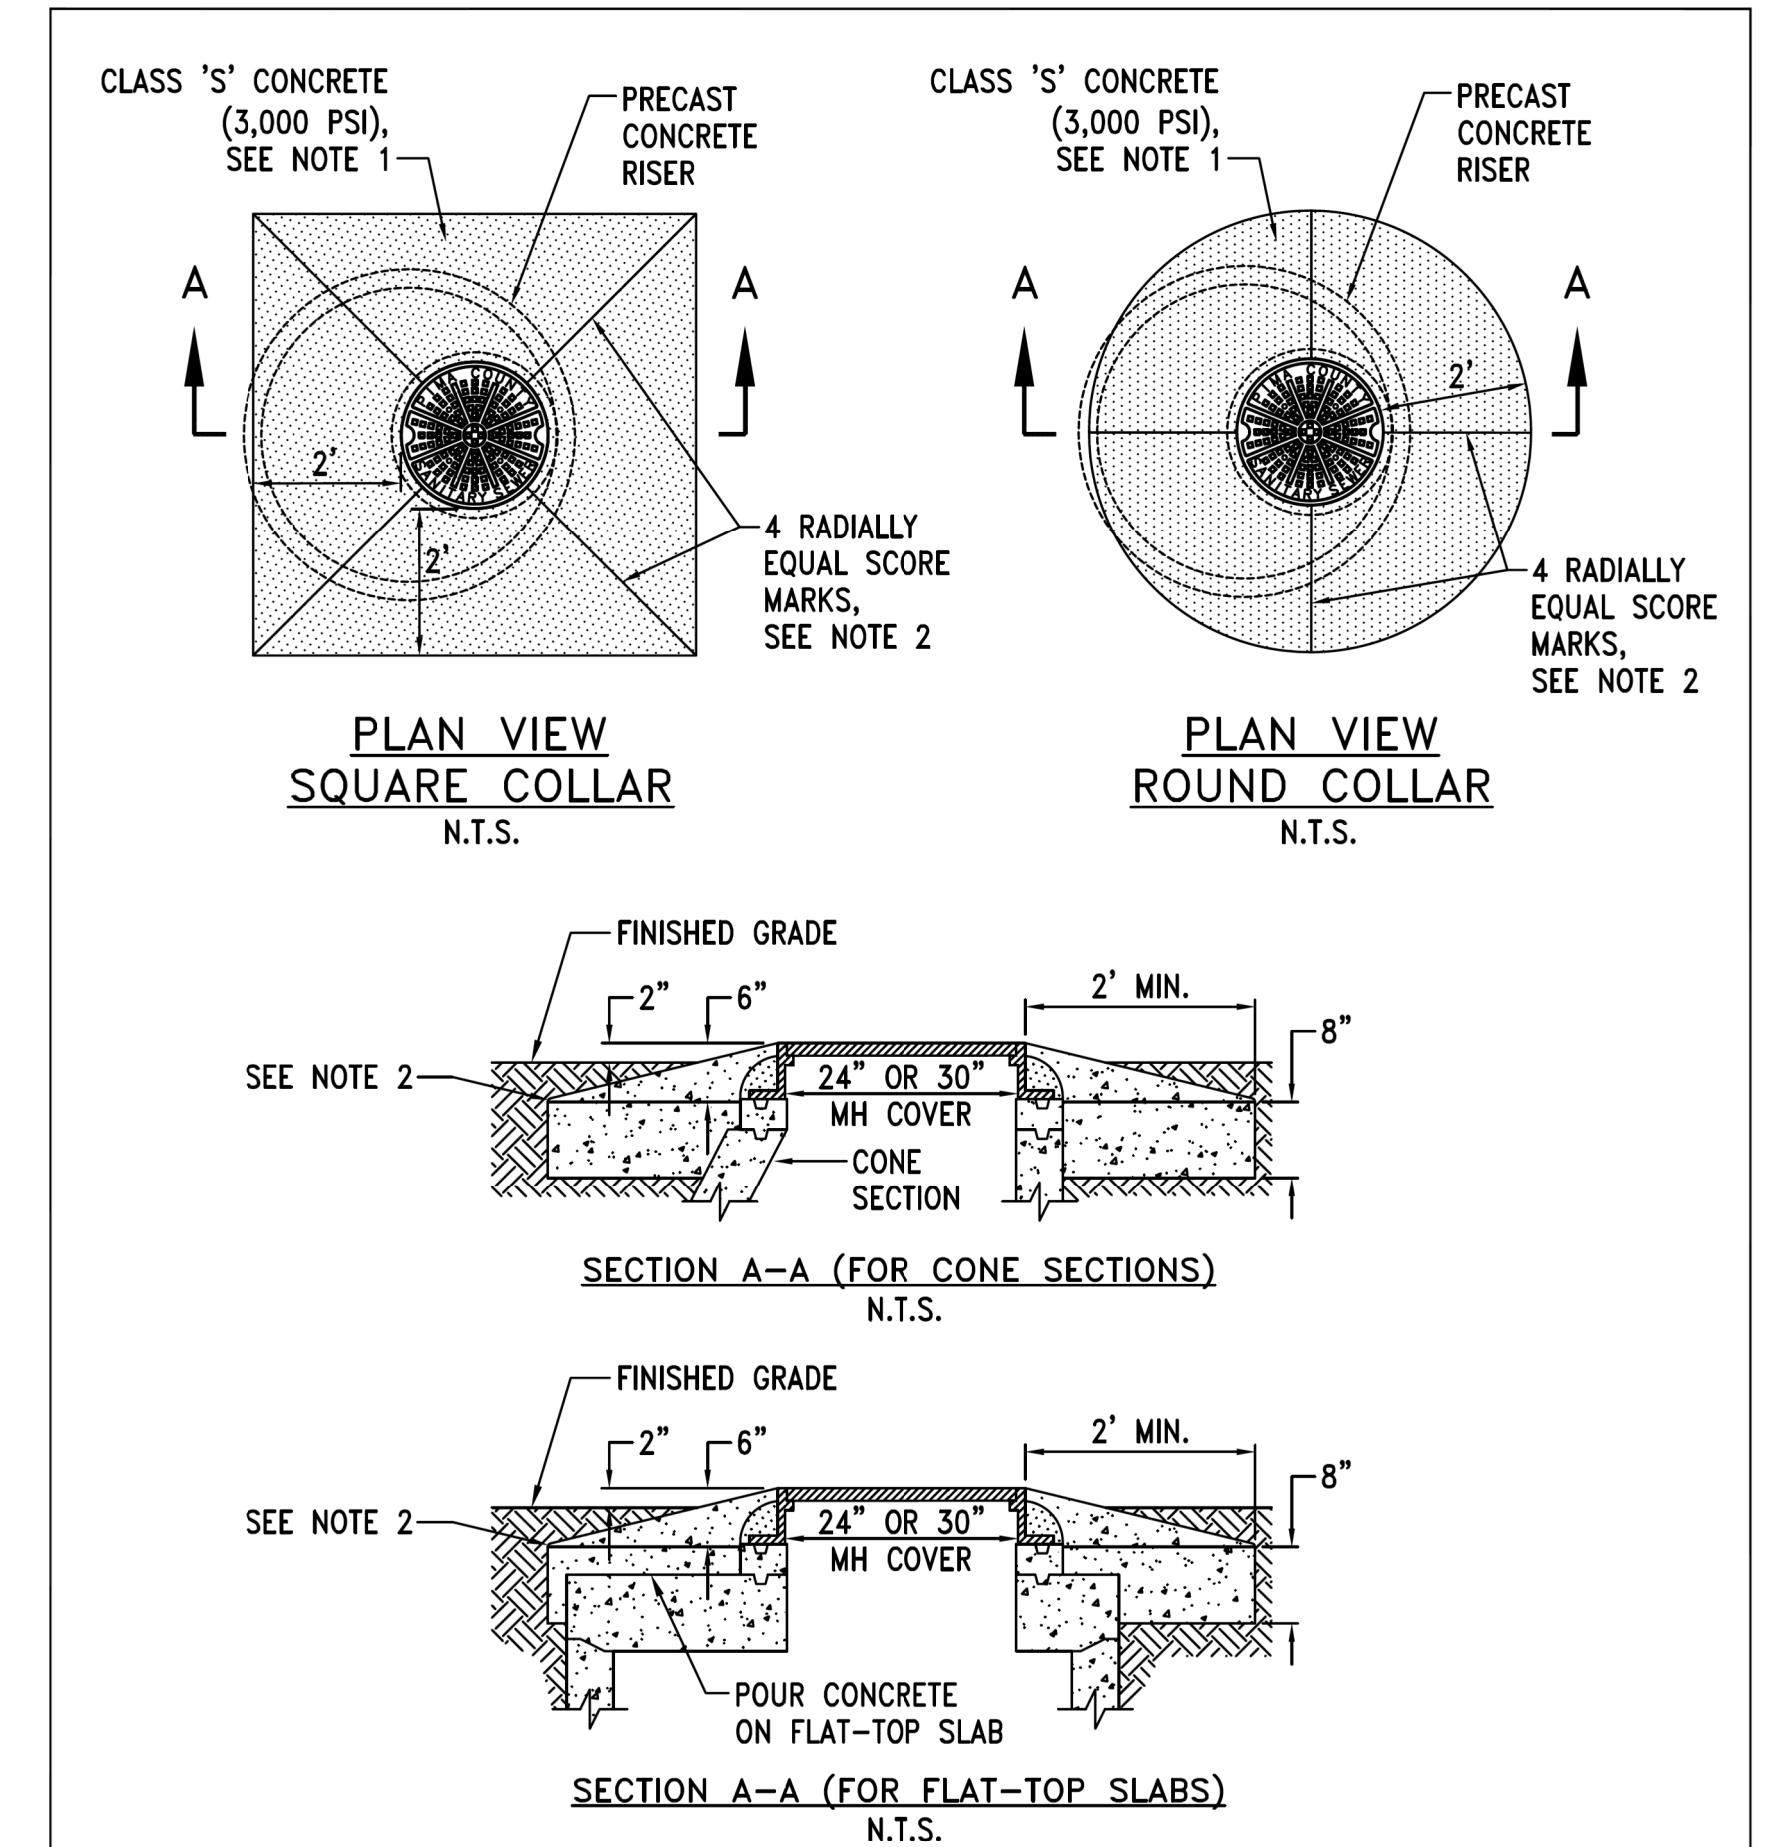

- NOTES:**
1. SQUARE OR ROUND TYPE COLLARS SHOWN ARE CONTRACTOR'S OPTION. ALL COLLARS SHALL BE FORMED.
  2. FINISH ALL CONCRETE EDGES AND SCORE MARKS WITH A HAND TROWEL HAVING A 1/4" RADIUS. EXPOSED CONCRETE SURFACES SHALL HAVE A MEDIUM BROOM FINISH.

ISSUED:	STANDARD DETAIL	DETAIL NO.
9/93		RWRD 212
REVISED:		CONCRETE COLLAR FOR UNPAVED AREAS
12/12		SHEET 1 OF 1

G-2014-085

SHEET SS12 OF SS19


DESIGN	DL	DATE	3-19	ARIZONA DEPARTMENT OF TRANSPORTATION INFRASTRUCTURE DELIVERY AND OPERATIONS DIVISION ROADWAY DESIGN SERVICES
DRAWN	CPG	DATE	3-19	
CHECKED	FF	DATE	3-19	
		WSP USA Inc. 177 N. Church Ave. Suite 1105 Tucson, AZ 85701		
ROUTE	1-10	LOCATION	RUTHRAUFF ROAD T1	
TRACS NO. H 8480 OIC		010-D(213)S		DWG NO. U-3.12



NO.	DATE	REVISION	BY	CHKD.	APPR.


F.H.W.A. REGION	STATE	PROJECT NO.	SHEET NO.	TOTAL SHEETS	RECORD DRAWING
9	ARIZ.	010-D(213)S	843	849	

010 PM 252

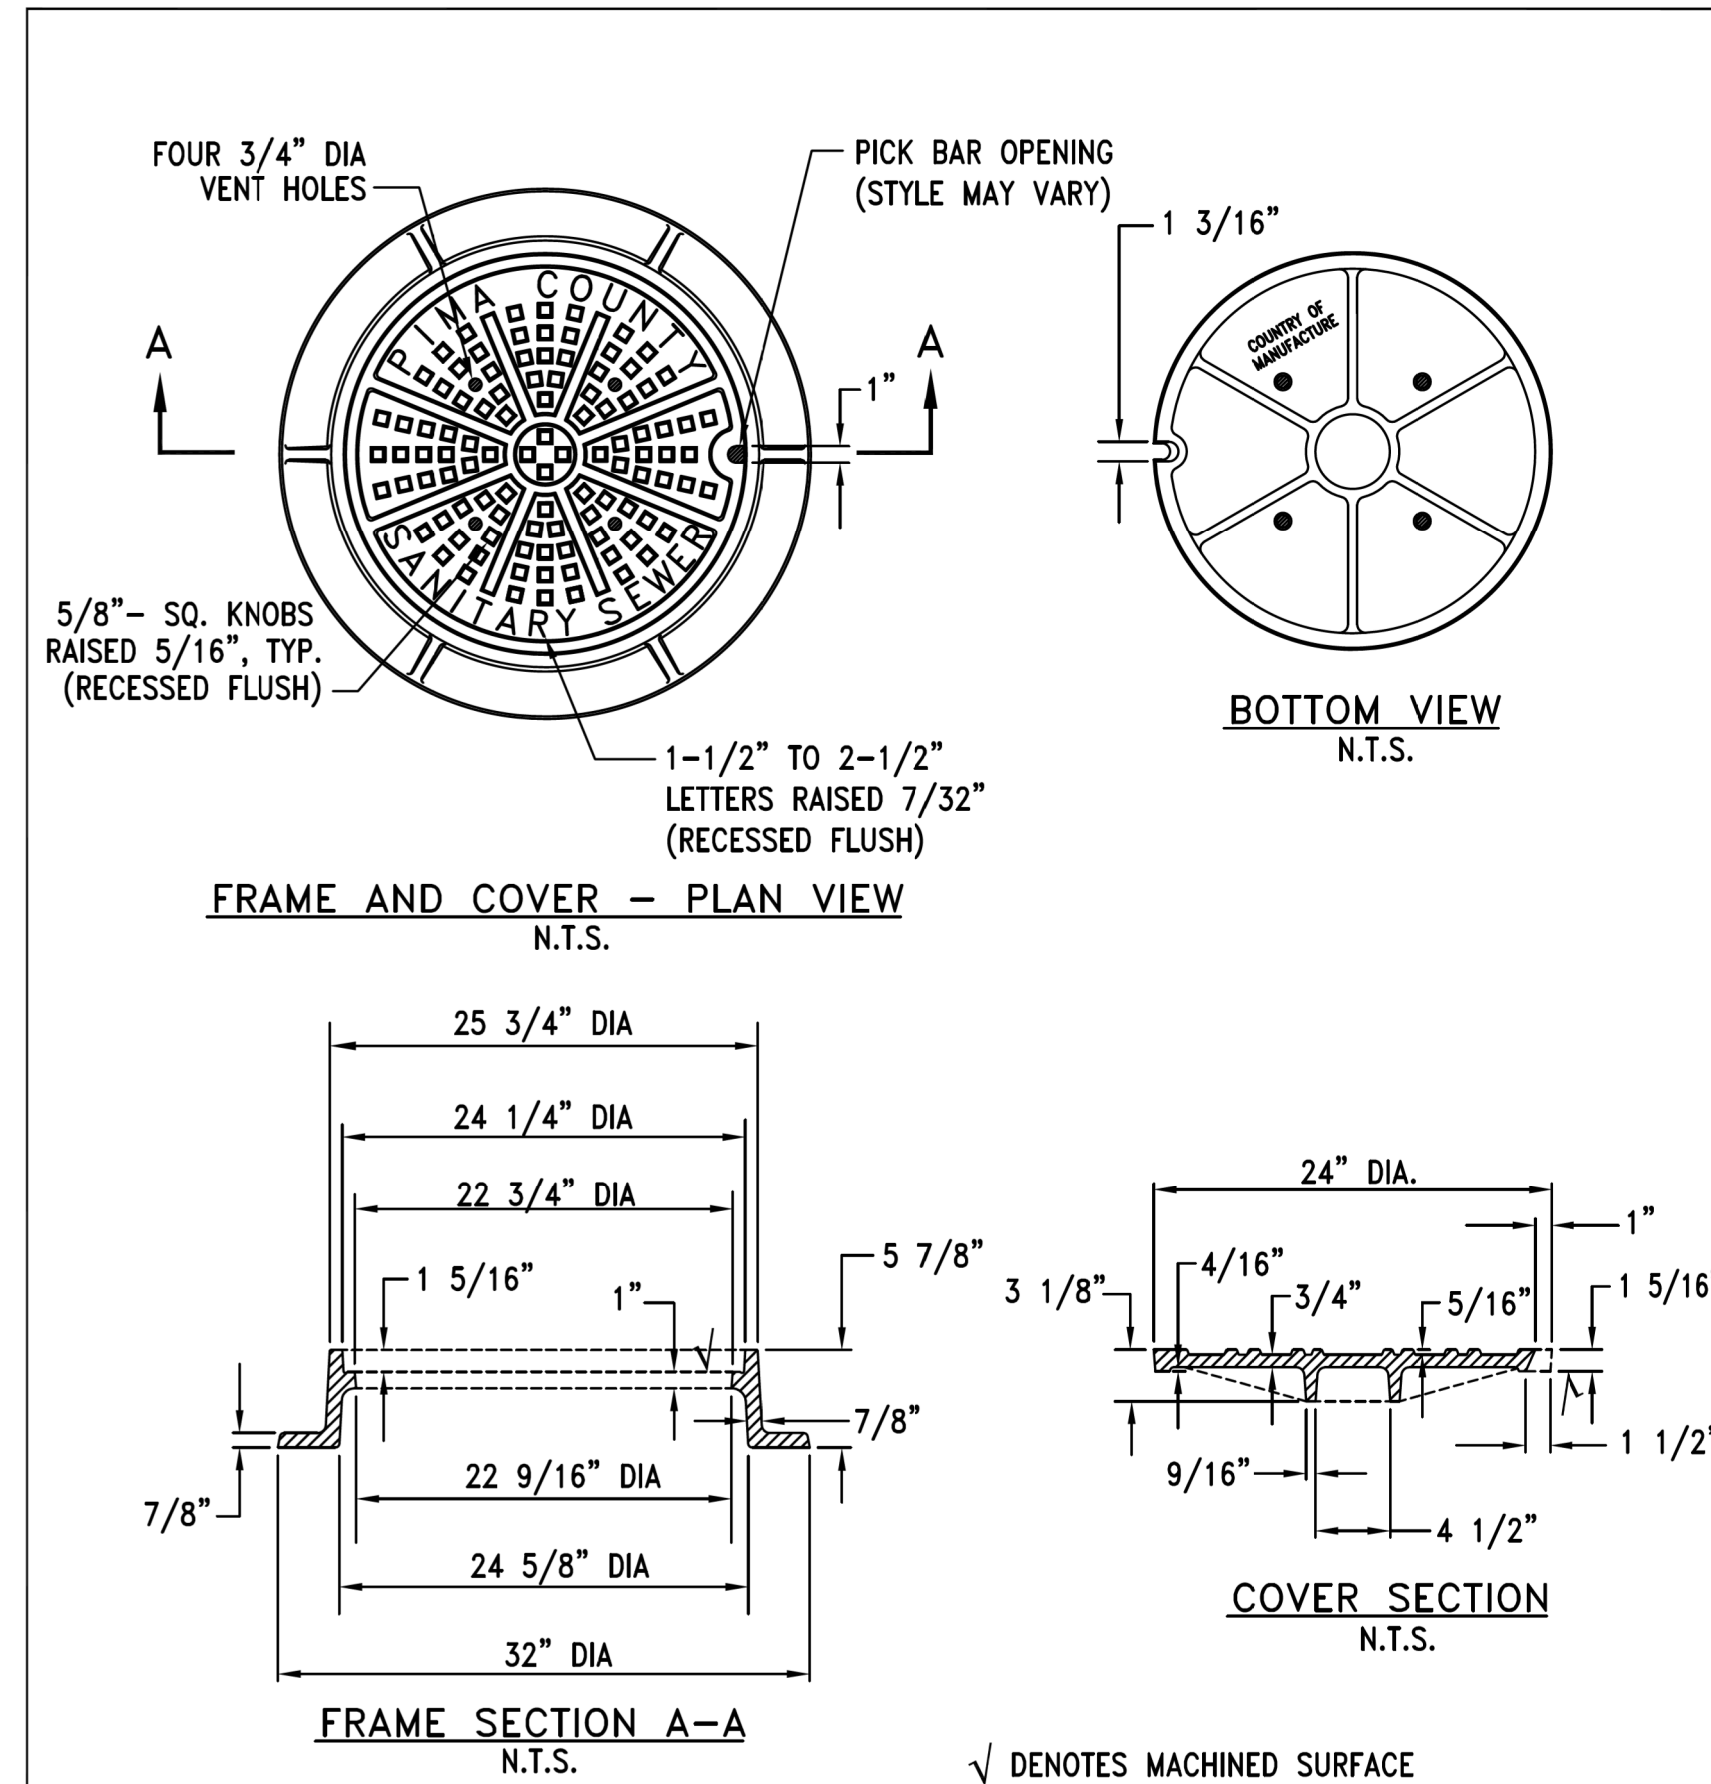


- NOTES:**
- COVER STYLE MAY SLIGHTLY VARY WITH APPROVAL BY THE FIELD ENGINEER.
  - FRAME WEIGHT 180 LBS. (APPROX.) AND COVER WEIGHT 130 LBS. (APPROX.).
  - REFER TO SECTION 3.3.2(H) FOR MORE INFORMATION.

ISSUED:	STANDARD DETAIL	DETAIL NO.
8/92		RWRD 213
REVISED:	24" FRAME AND COVER	
12/12		SHEET 1 OF 1

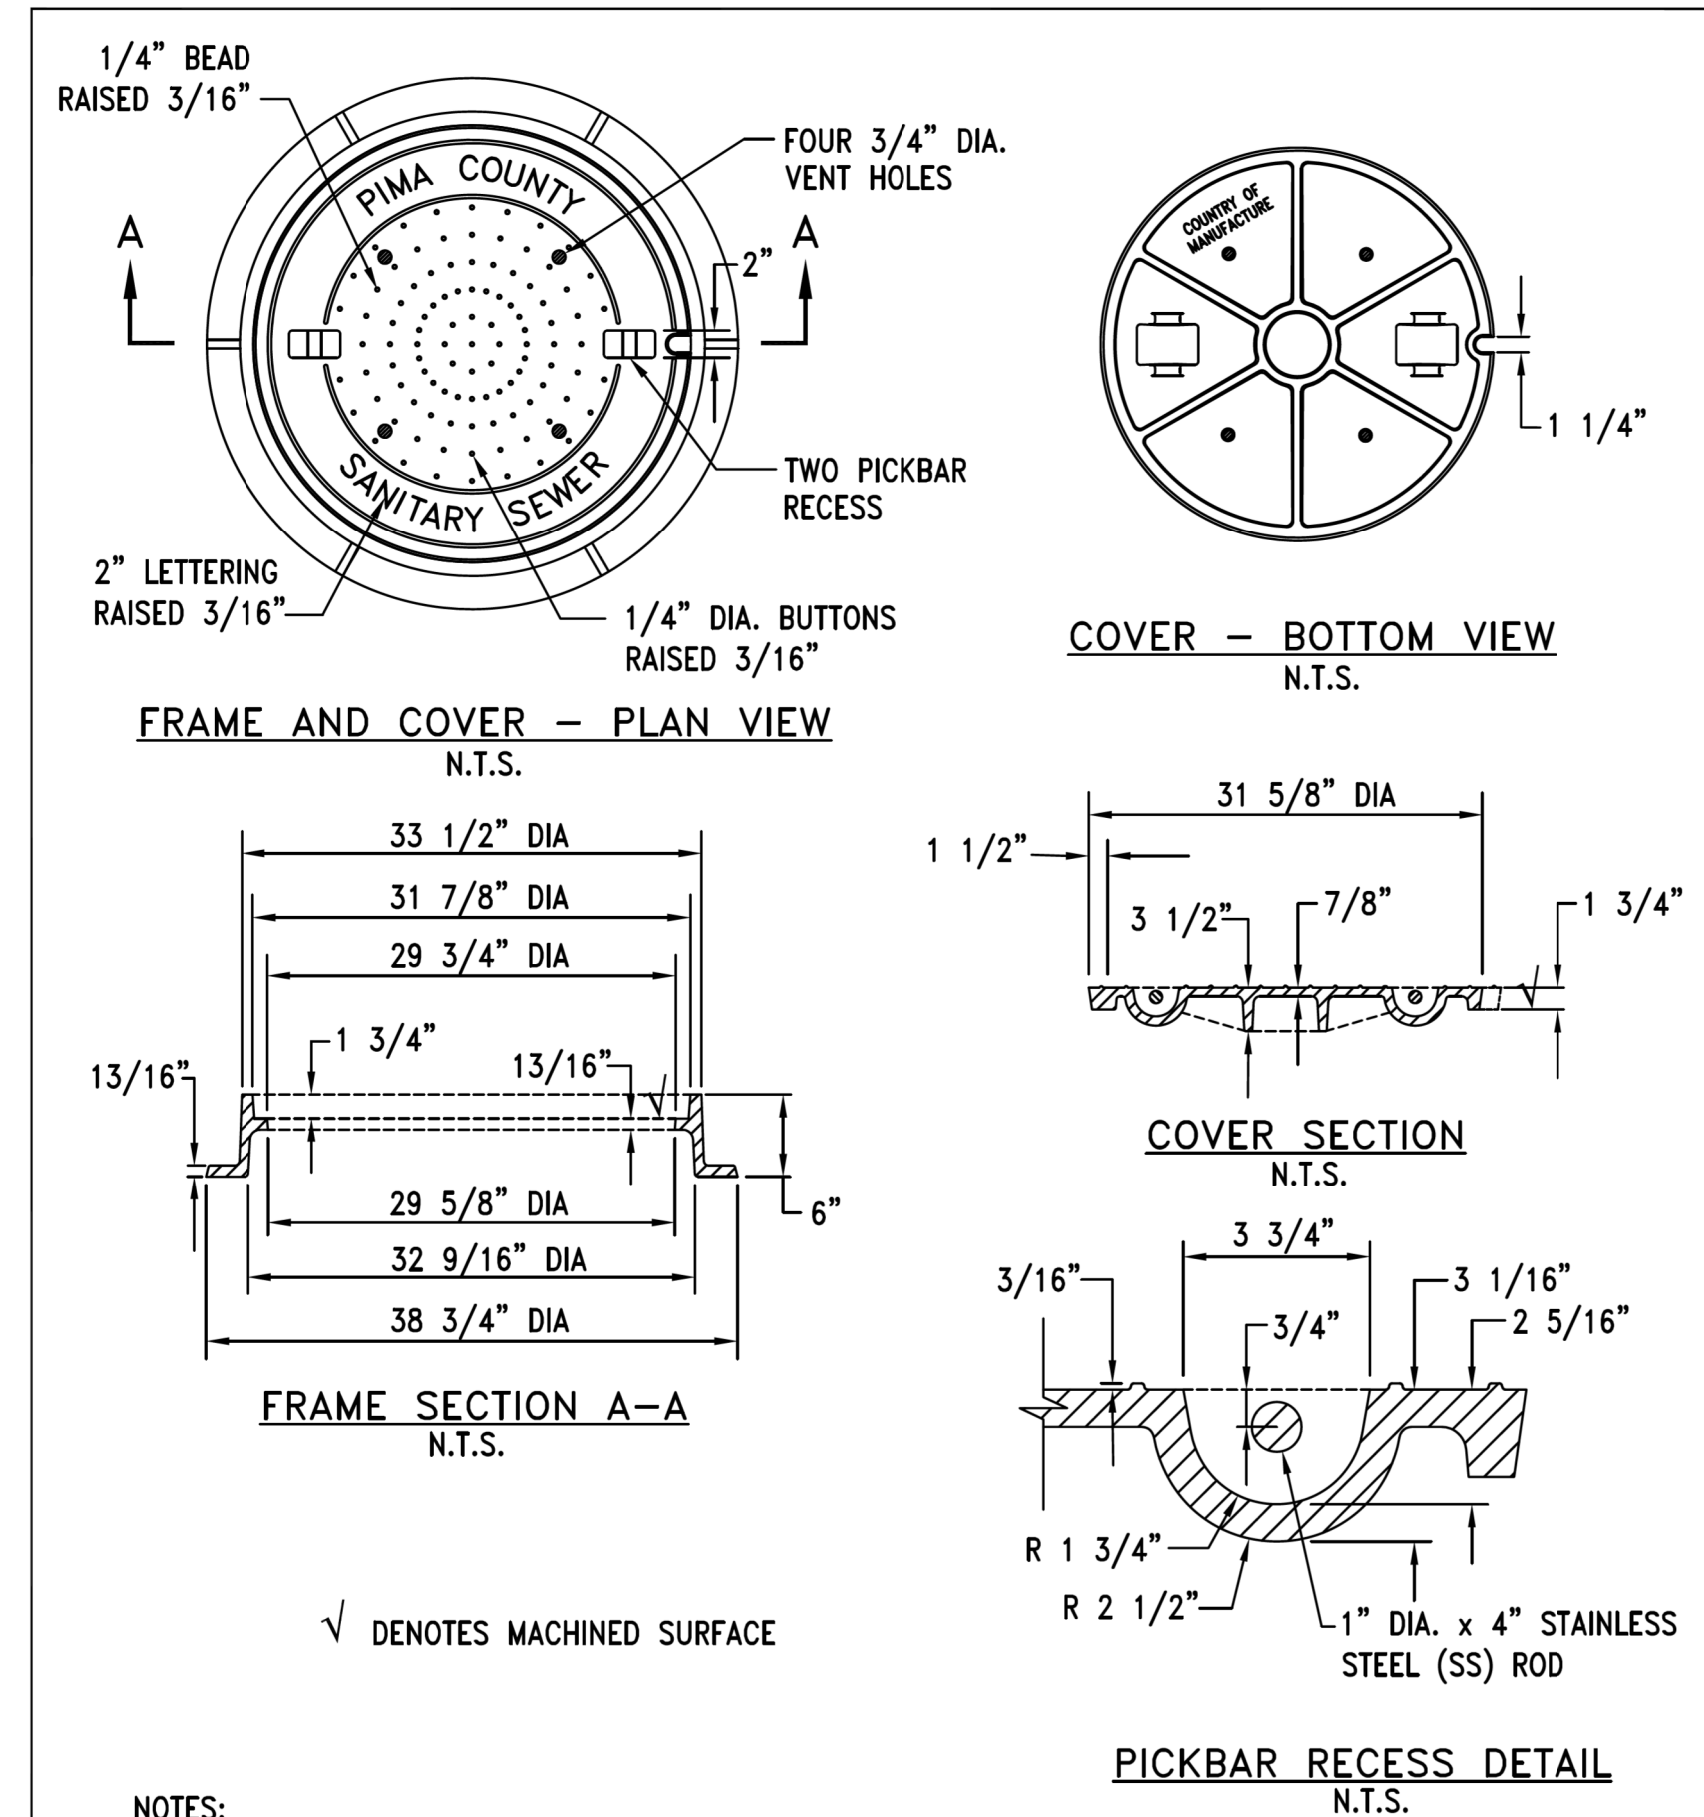

- NOTES:**
- COVER STYLE MAY SLIGHTLY VARY WITH APPROVAL BY THE FIELD ENGINEER.
  - THE COVER SHALL HAVE PICK BAR RECESSES.
  - FRAME WEIGHT 200 LBS. (APPROX.) AND COVER WEIGHT 217 LBS. (APPROX.).
  - REFER TO SECTION 3.3.2(H) FOR MORE INFORMATION.

ISSUED:	STANDARD DETAIL	DETAIL NO.
8/92 (WWM-214.0)		RWRD 216
REVISED:	30" FRAME AND COVER	
12/12		SHEET 1 OF 1

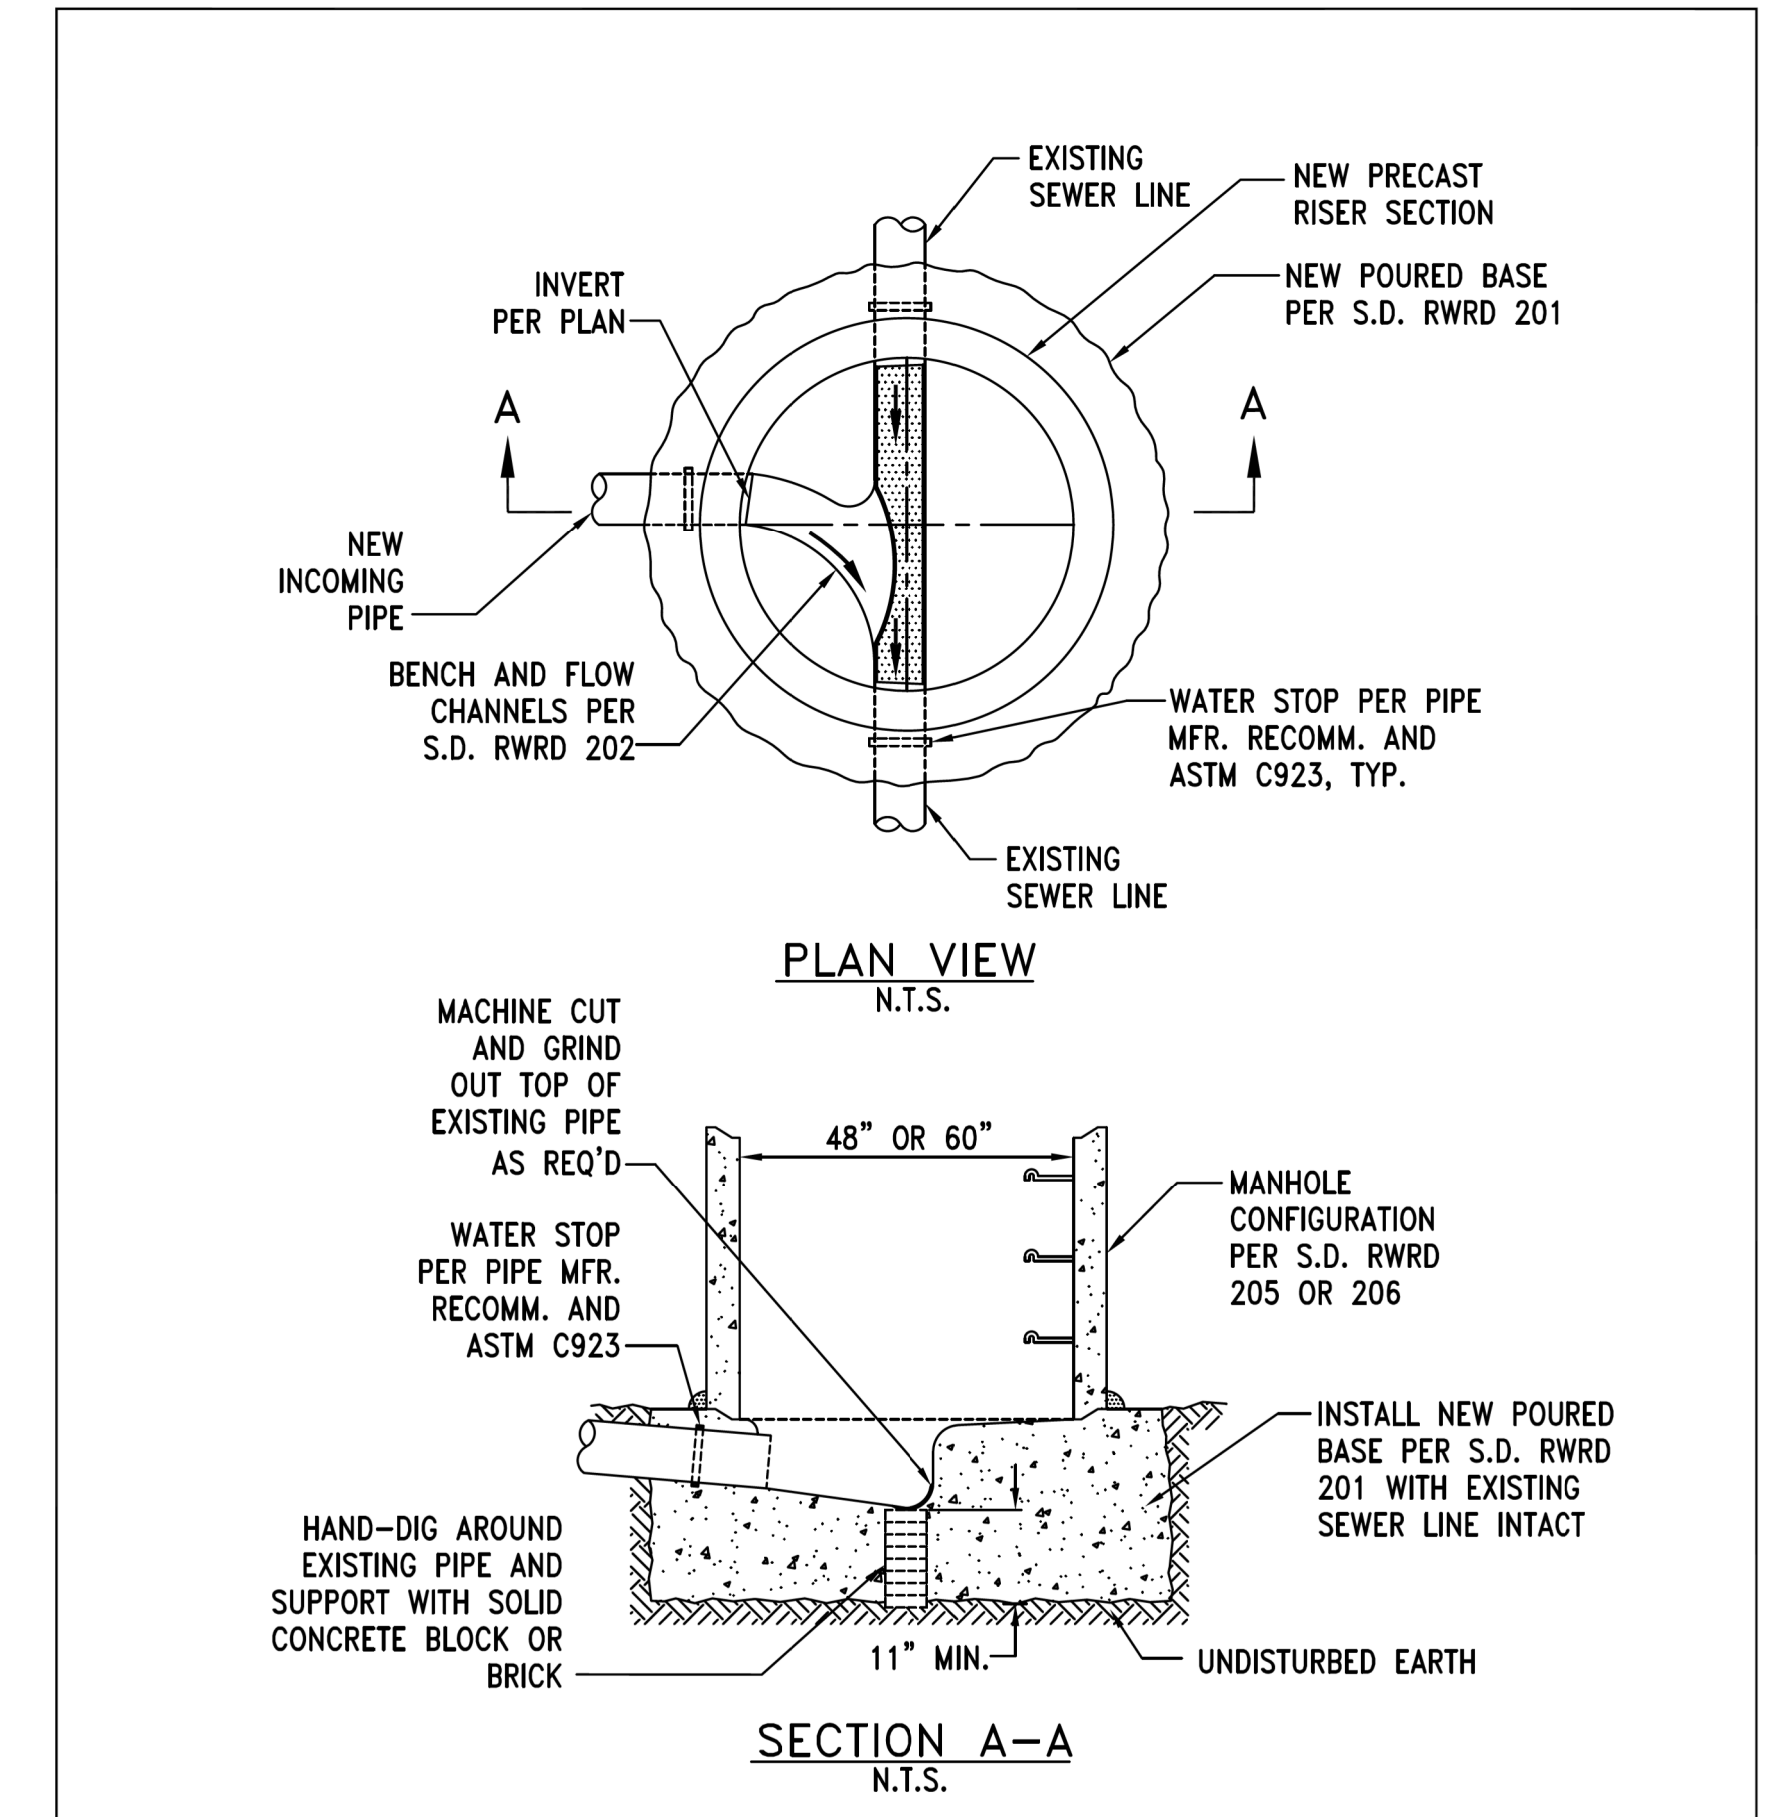

- NOTES:**
- FOUNDATION PER S.D. RWRD 104 TO THE FIRST JOINT BEYOND OPEN TRENCH CONDITIONS MAY BE REQUIRED DEPENDING ON DEPTH OF EXCAVATION AND TYPE OF SOIL.
  - SEE SUBSECTION 3.3.3(D)(v) FOR MORE INFORMATION.

ISSUED:	STANDARD DETAIL	DETAIL NO.
8/92		RWRD 303
REVISED:	NEW MANHOLE OVER EXISTING SEWER LINE	
12/12		SHEET 1 OF 1

G-2014-085

SHEET SS13 OF SS19

DESIGN	DL	DATE	3-19	ARIZONA DEPARTMENT OF TRANSPORTATION INFRASTRUCTURE DELIVERY AND OPERATIONS DIVISION ROADWAY DESIGN SERVICES
DRAWN	CPG	DATE	3-19	
CHECKED	FF	DATE	3-19	
		WSP USA Inc. 177 N. Church Ave. Suite 1105 Tucson, AZ 85701		
ROUTE	LOCATION	RUTHRAUFF ROAD T1		
TRACS NO. H 8480 01C		010-D(213)S		DWG NO. U-3.13





NO.	DATE	REVISION	BY	CHKD.	APPR.



F.H.W.A. REGION	STATE	PROJECT NO.	SHEET NO.	TOTAL SHEETS	RECORD DRAWING
9	ARIZ.	010-D(213)S	844	849	


010 PM 252

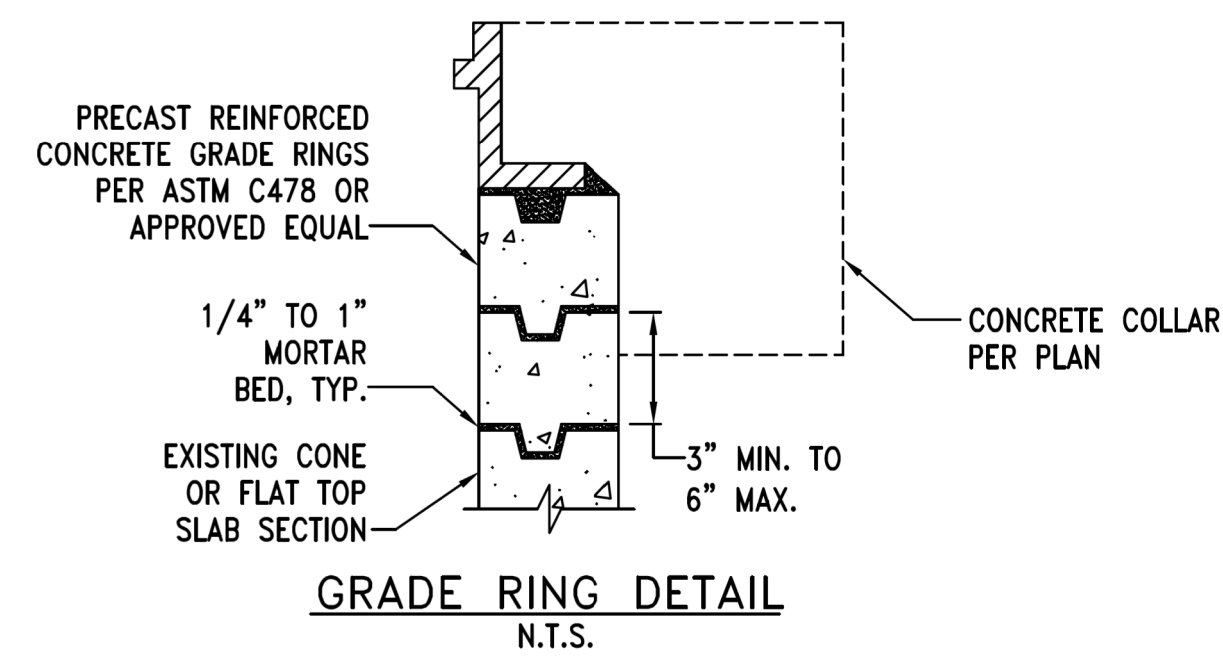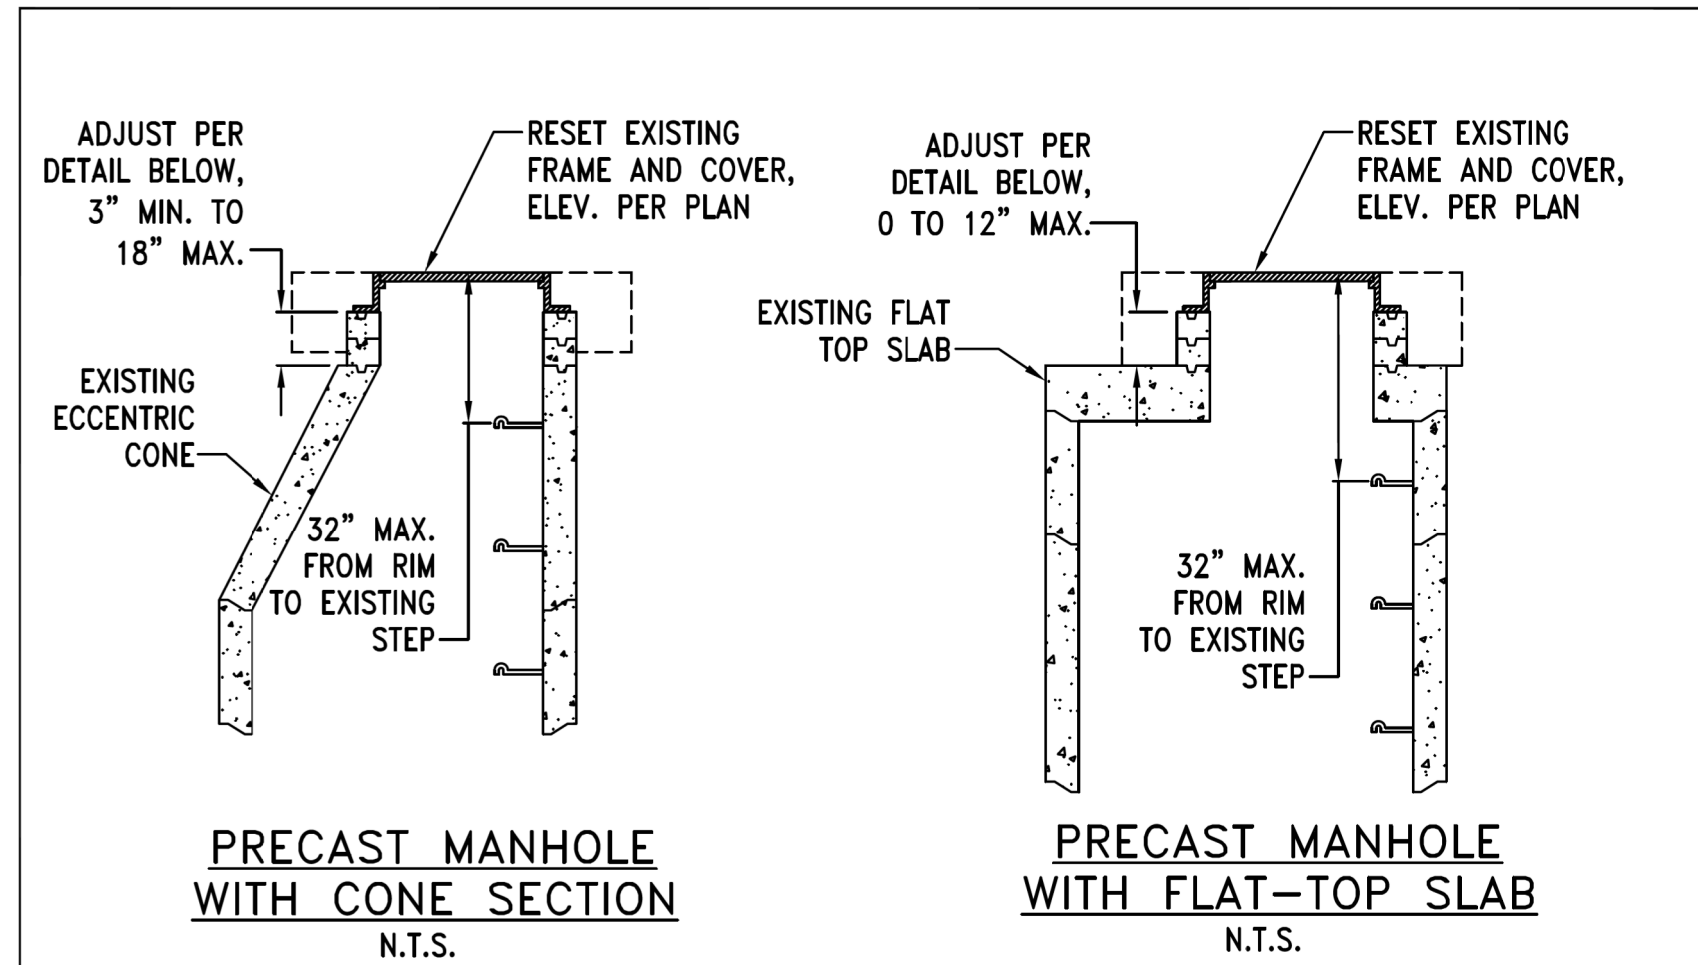

**NOTES:**

1. A SEWER CONSTRUCTION PERMIT FROM PCRWRD IS REQUIRED PRIOR TO REMOVAL OF THE FRAME AND COVER ON EXISTING PUBLIC MANHOLES. GRADE ADJUSTMENT WORK SHALL BE INSPECTED AND APPROVED BY THE FIELD ENGINEER.
2. RECONSTRUCTION OF THE EXISTING PRECAST MANHOLE SHALL BE REQUIRED FOR VIOLATION OF THE DIMENSIONAL RANGES NOTED ABOVE, AGE OF THE EXISTING MANHOLE, CONDITION OR TYPE OF MATERIAL WARRANTING SUCH REPLACEMENT, AS DIRECTED BY THE FIELD ENGINEER.
3. SEE SUBSECTION 3.3.3(D)(I) FOR MORE INFORMATION.


ISSUED:	STANDARD DETAIL	DETAIL NO.
8/92	GRADE ADJUSTMENT FOR EXISTING PRECAST MANHOLE	RWRD 305
REVISED:		
10/15		SHEET 1 OF 1

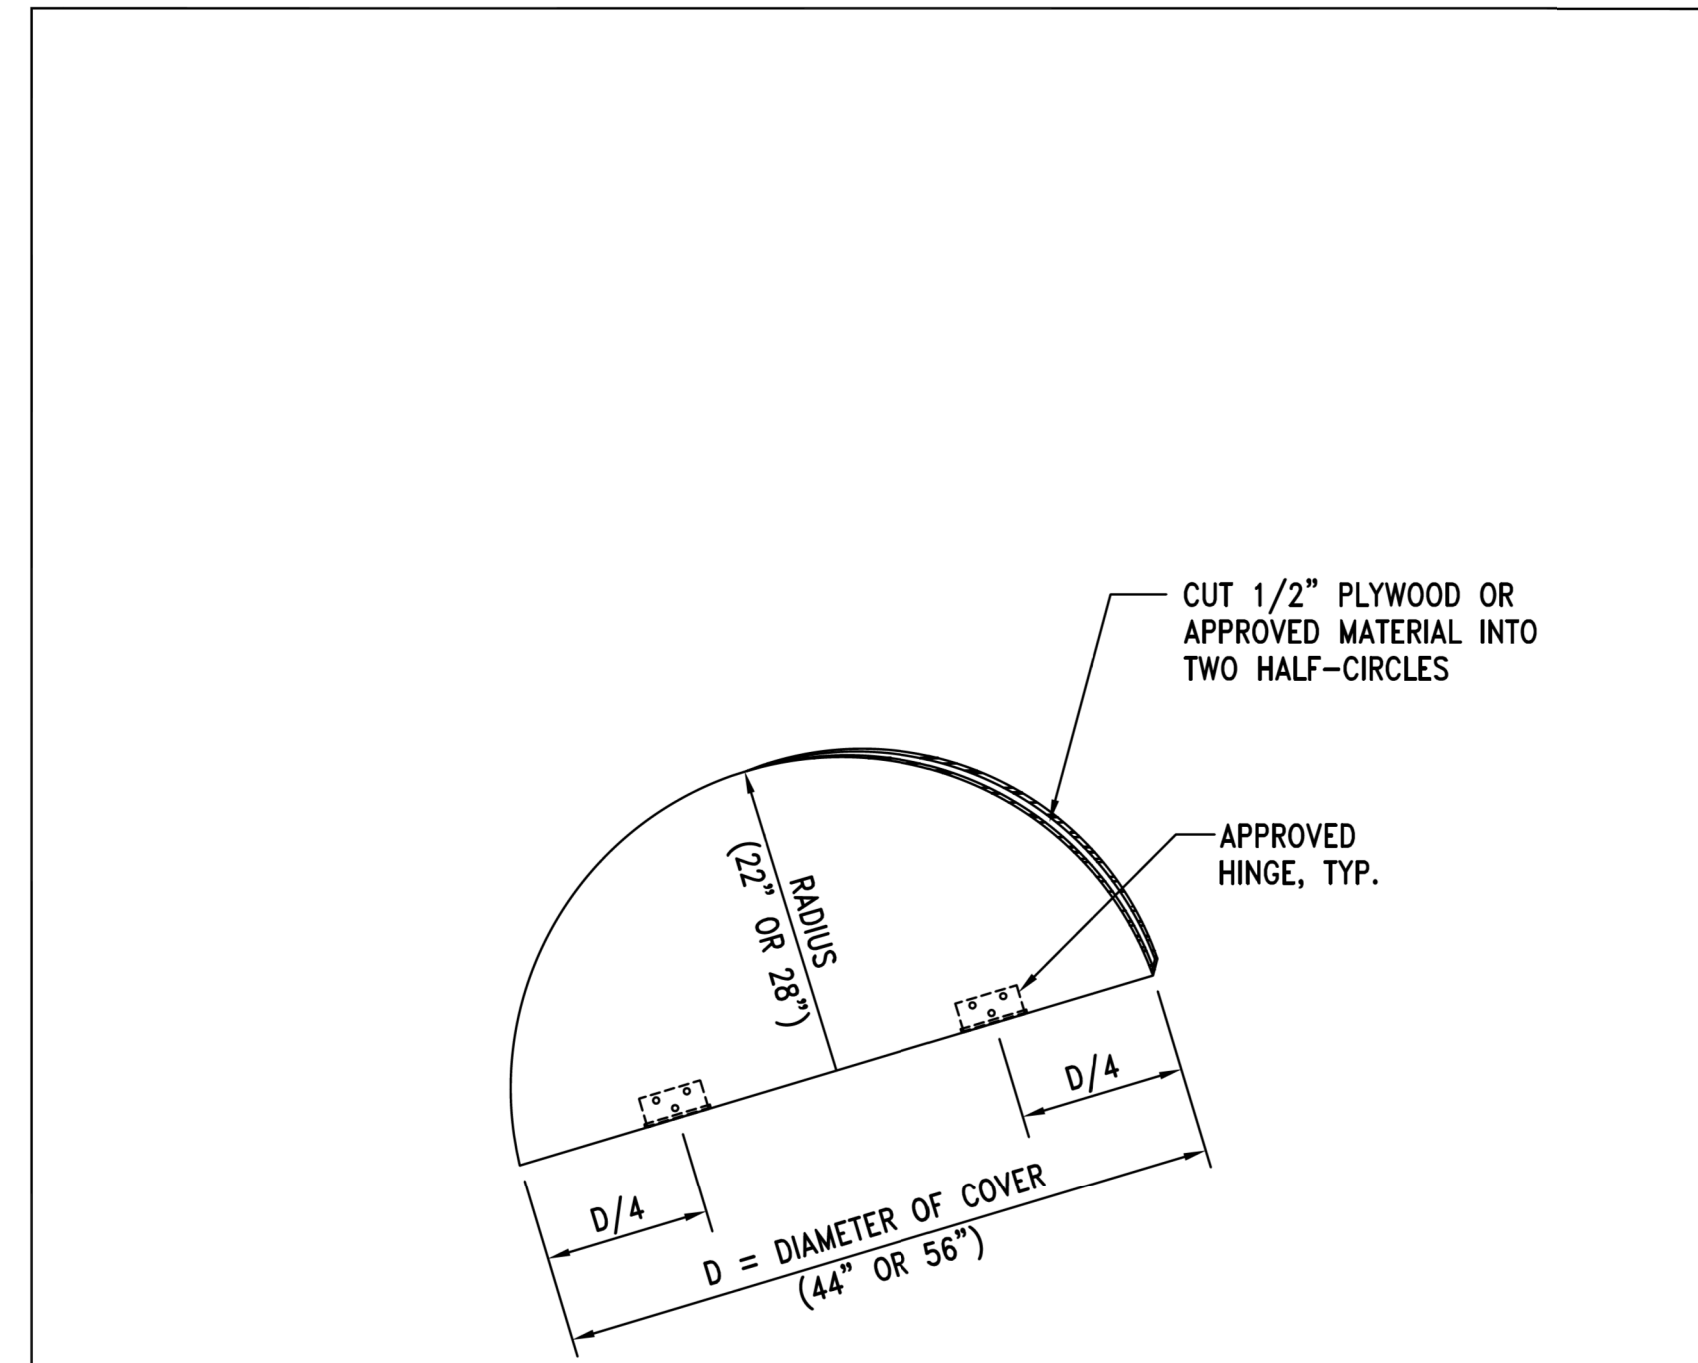

**NOTE:**

FOR CONSTRUCTION DETAILS SEE SUBSECTION 3.3.3(D)(I).

ISSUED:	STANDARD DETAIL	DETAIL NO.
8/92 (WWM-307)	FLOW CHANNEL COVER	RWRD 306
REVISED:		
12/12		SHEET 1 OF 1

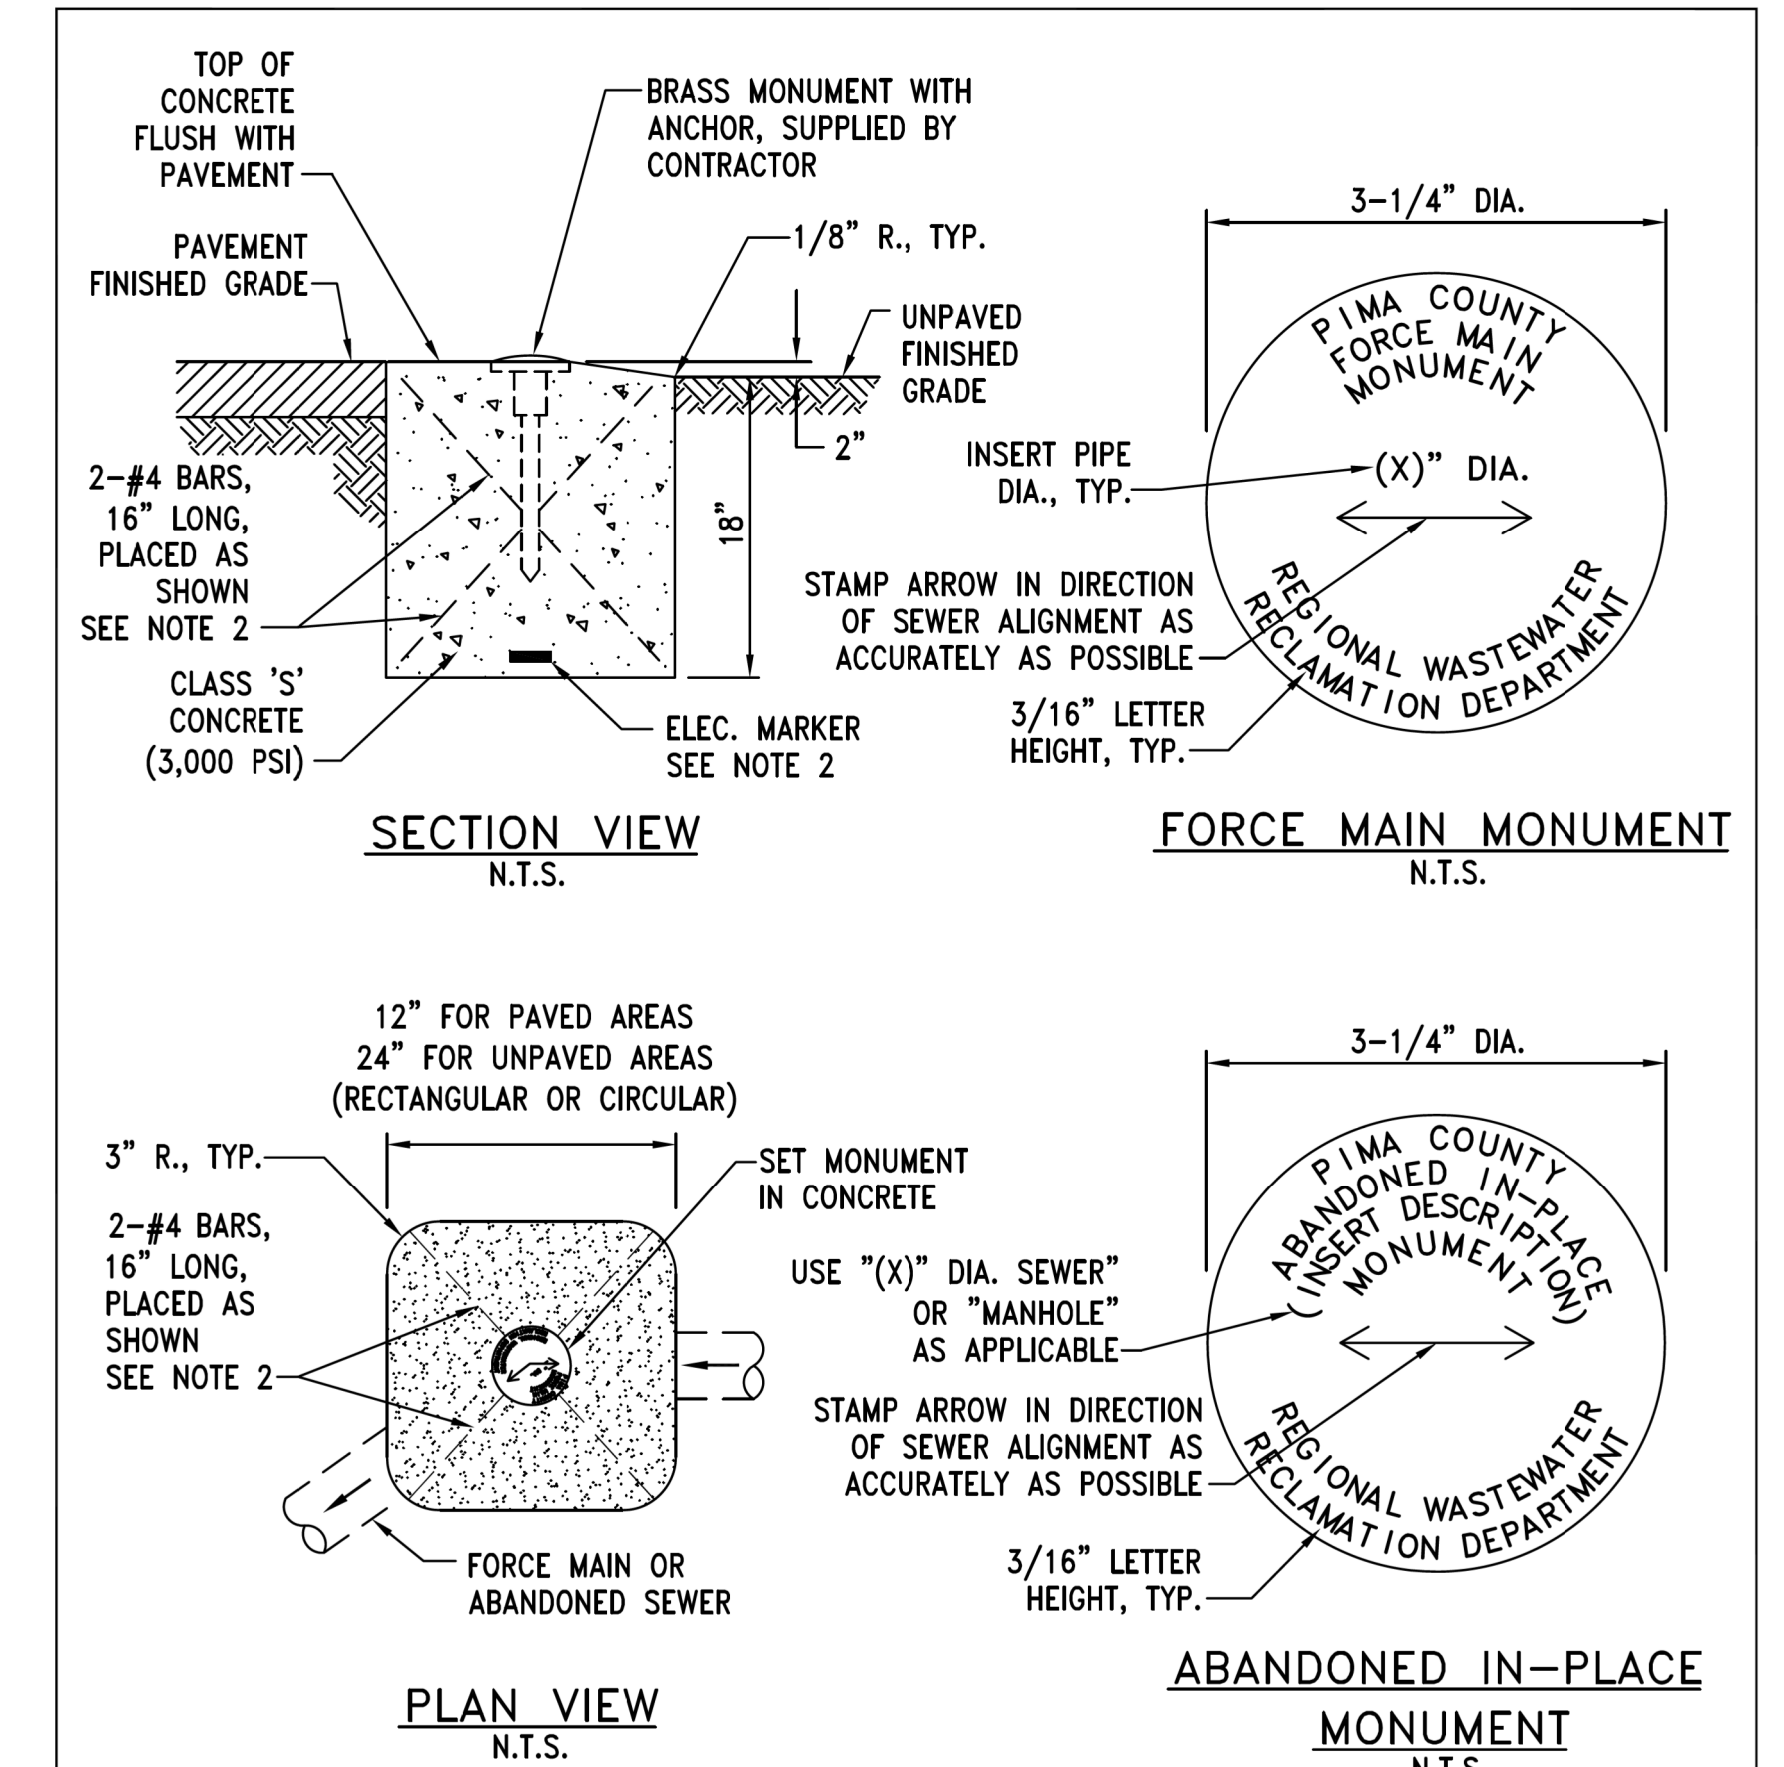

**NOTES:**



1. MONUMENT DATA SHALL BE AS SHOWN, WITH THE EXCEPTION OF THE NOTATION IN PARENTHESIS TO BE MODIFIED AS NOTED.
2. REINFORCING BARS MAY BE DELETED WITH THE INSTALLATION OF AN APPROVED ELECTRONIC MARKER SYSTEM PLACED AT THE BASE OF THE MONUMENT AS SHOWN.
3. ABANDONMENT MONUMENTS SHALL BE PLACED AT THE TERMINAL ENDS OF ABANDONED SEWER LINES/FORCE MAINS WITH A MAXIMUM SPACING OF 250' AND CENTERED ABOVE ABANDONED MANHOLES.

ISSUED:	STANDARD DETAIL	DETAIL NO.
8/92 (WWM-507/508)	FORCE MAIN AND ABANDONMENT MONUMENTS	RWRD 503
REVISED:		
12/12		SHEET 1 OF 1

G-2014-085

SHEET SS14 OF SS19

DESIGN	DL	DATE	3-19	ARIZONA DEPARTMENT OF TRANSPORTATION INFRASTRUCTURE DELIVERY AND OPERATIONS DIVISION ROADWAY DESIGN SERVICES
DRAWN	CPG	DATE	3-19	
CHECKED	FF	DATE	3-19	
ROUTE		LOCATION		RUTHRAUFF ROAD SEWER MODIFICATION PLANS DETAIL SHEET
1-10		RUTHRAUFF ROAD T1		
TRACS NO. H 8480 OIC				010-D(213)S
				DWG NO. U-3.14

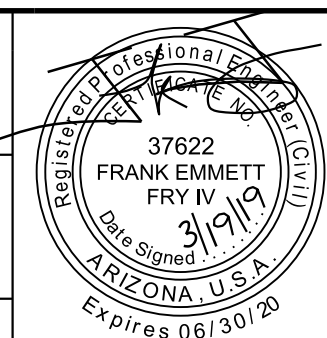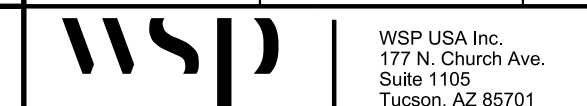


NO.	DATE	REVISION	BY	CHKD.	APPR.



F.H.W.A. REGION	STATE	PROJECT NO.	SHEET NO.	TOTAL SHEETS	RECORD DRAWING
9	ARIZ.	010-D(213)S	845	849	


010 PM 252

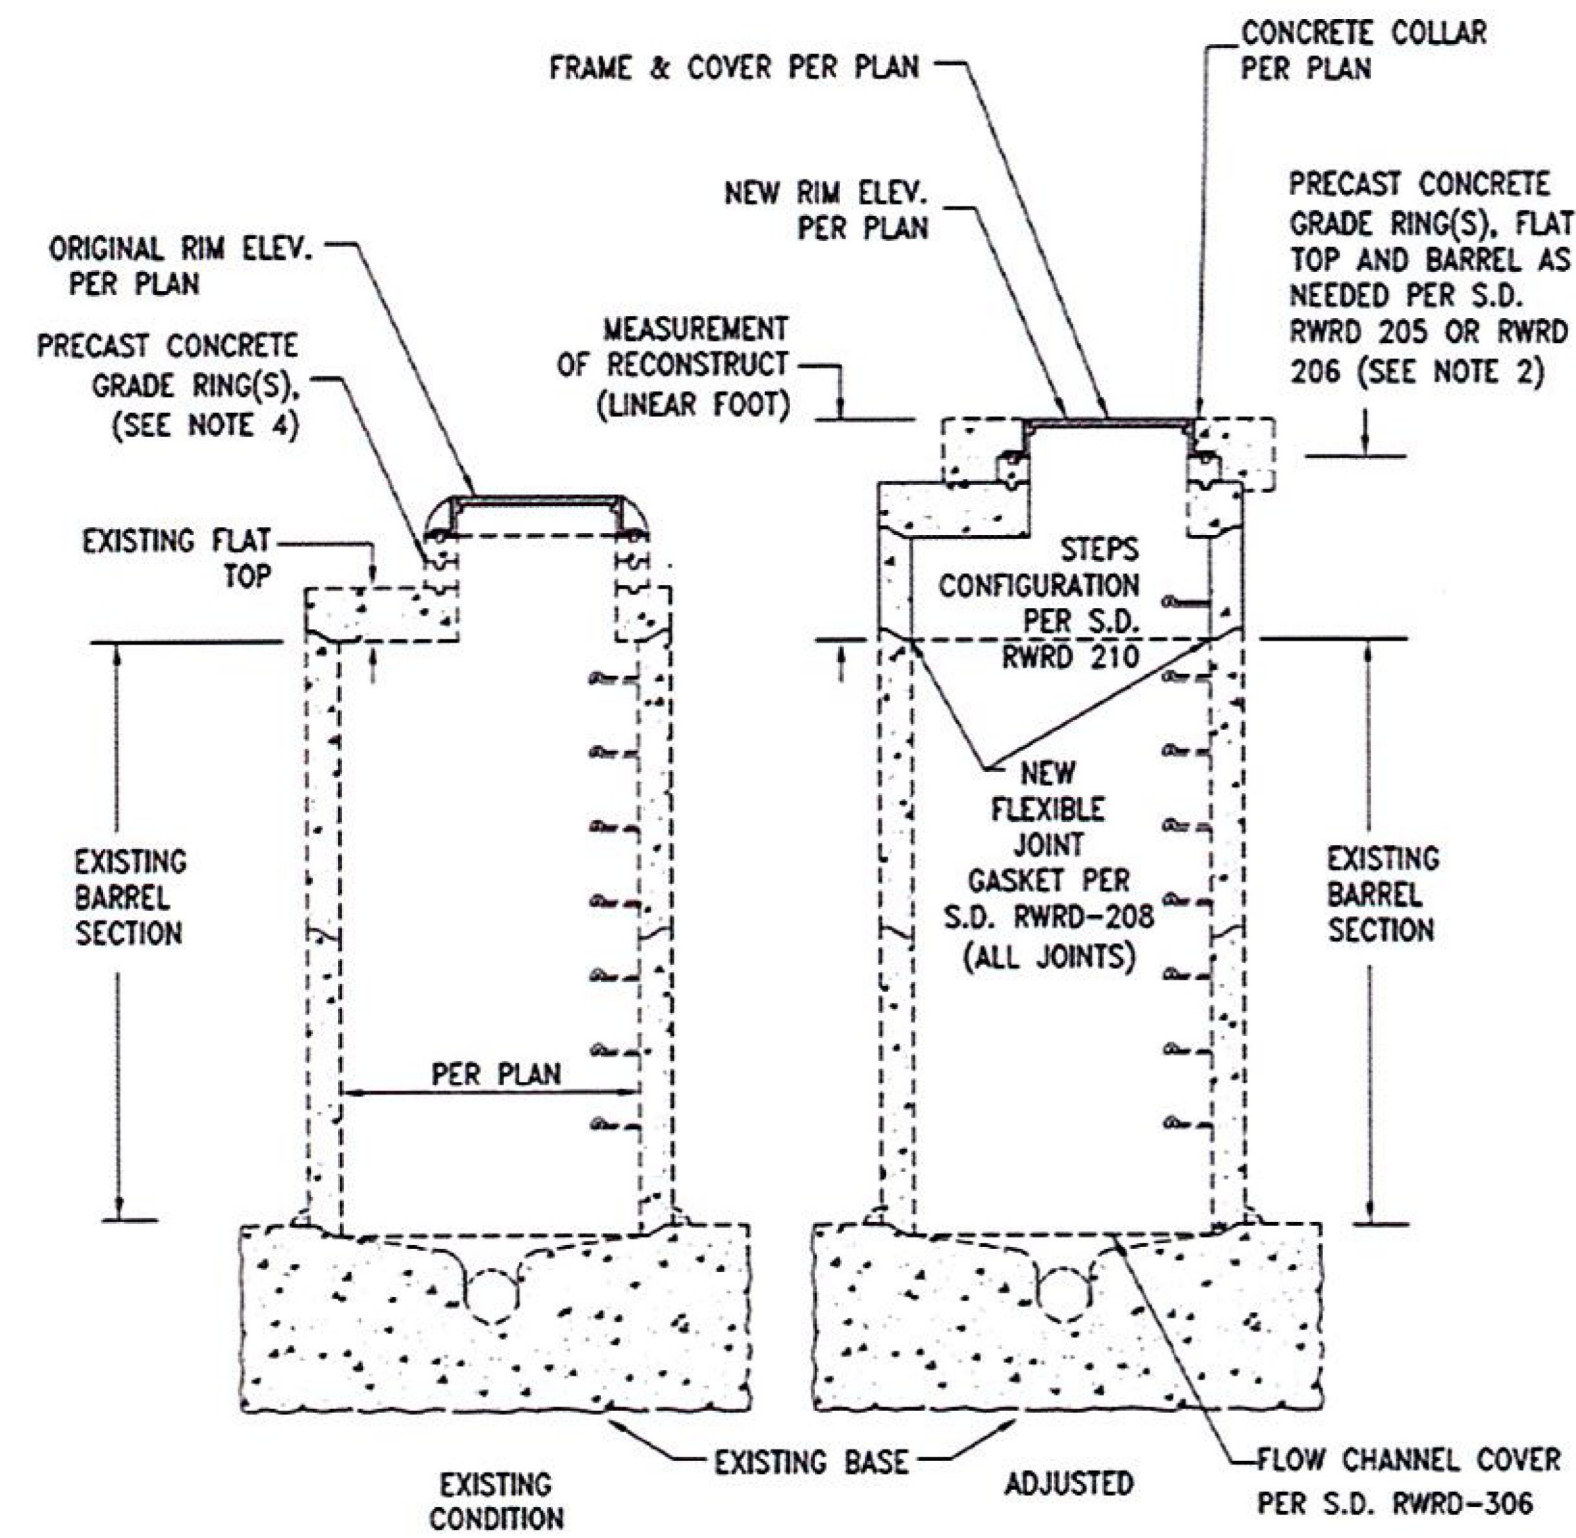

RAISE FRAME & COVER OF FLAT TOP MANHOLE  
N.T.S.

NOTES:

1. PRECAST CONCRETE MANHOLE SECTIONS SHALL CONFORM TO ASTM C478 AND AASHTO M199.
2. ONLY NEW MANHOLE COMPONENTS SHALL BE USED.
3. SEE SUBSECTIONS 3.3.2(E) AND 3.3.3 FOR MORE INFORMATION.
4. RECONSTRUCTION OF AN EXISTING MANHOLE SHALL BE REQUIRED FOR VIOLATION OF THE DIMENSIONAL RANGES NOTED IN STANDARD DETAILS RWRD 304 AND RWRD 305 AND TYPICALLY WHEN THE ADJUSTMENT IN RIM ELEVATION EXCEEDS 12".

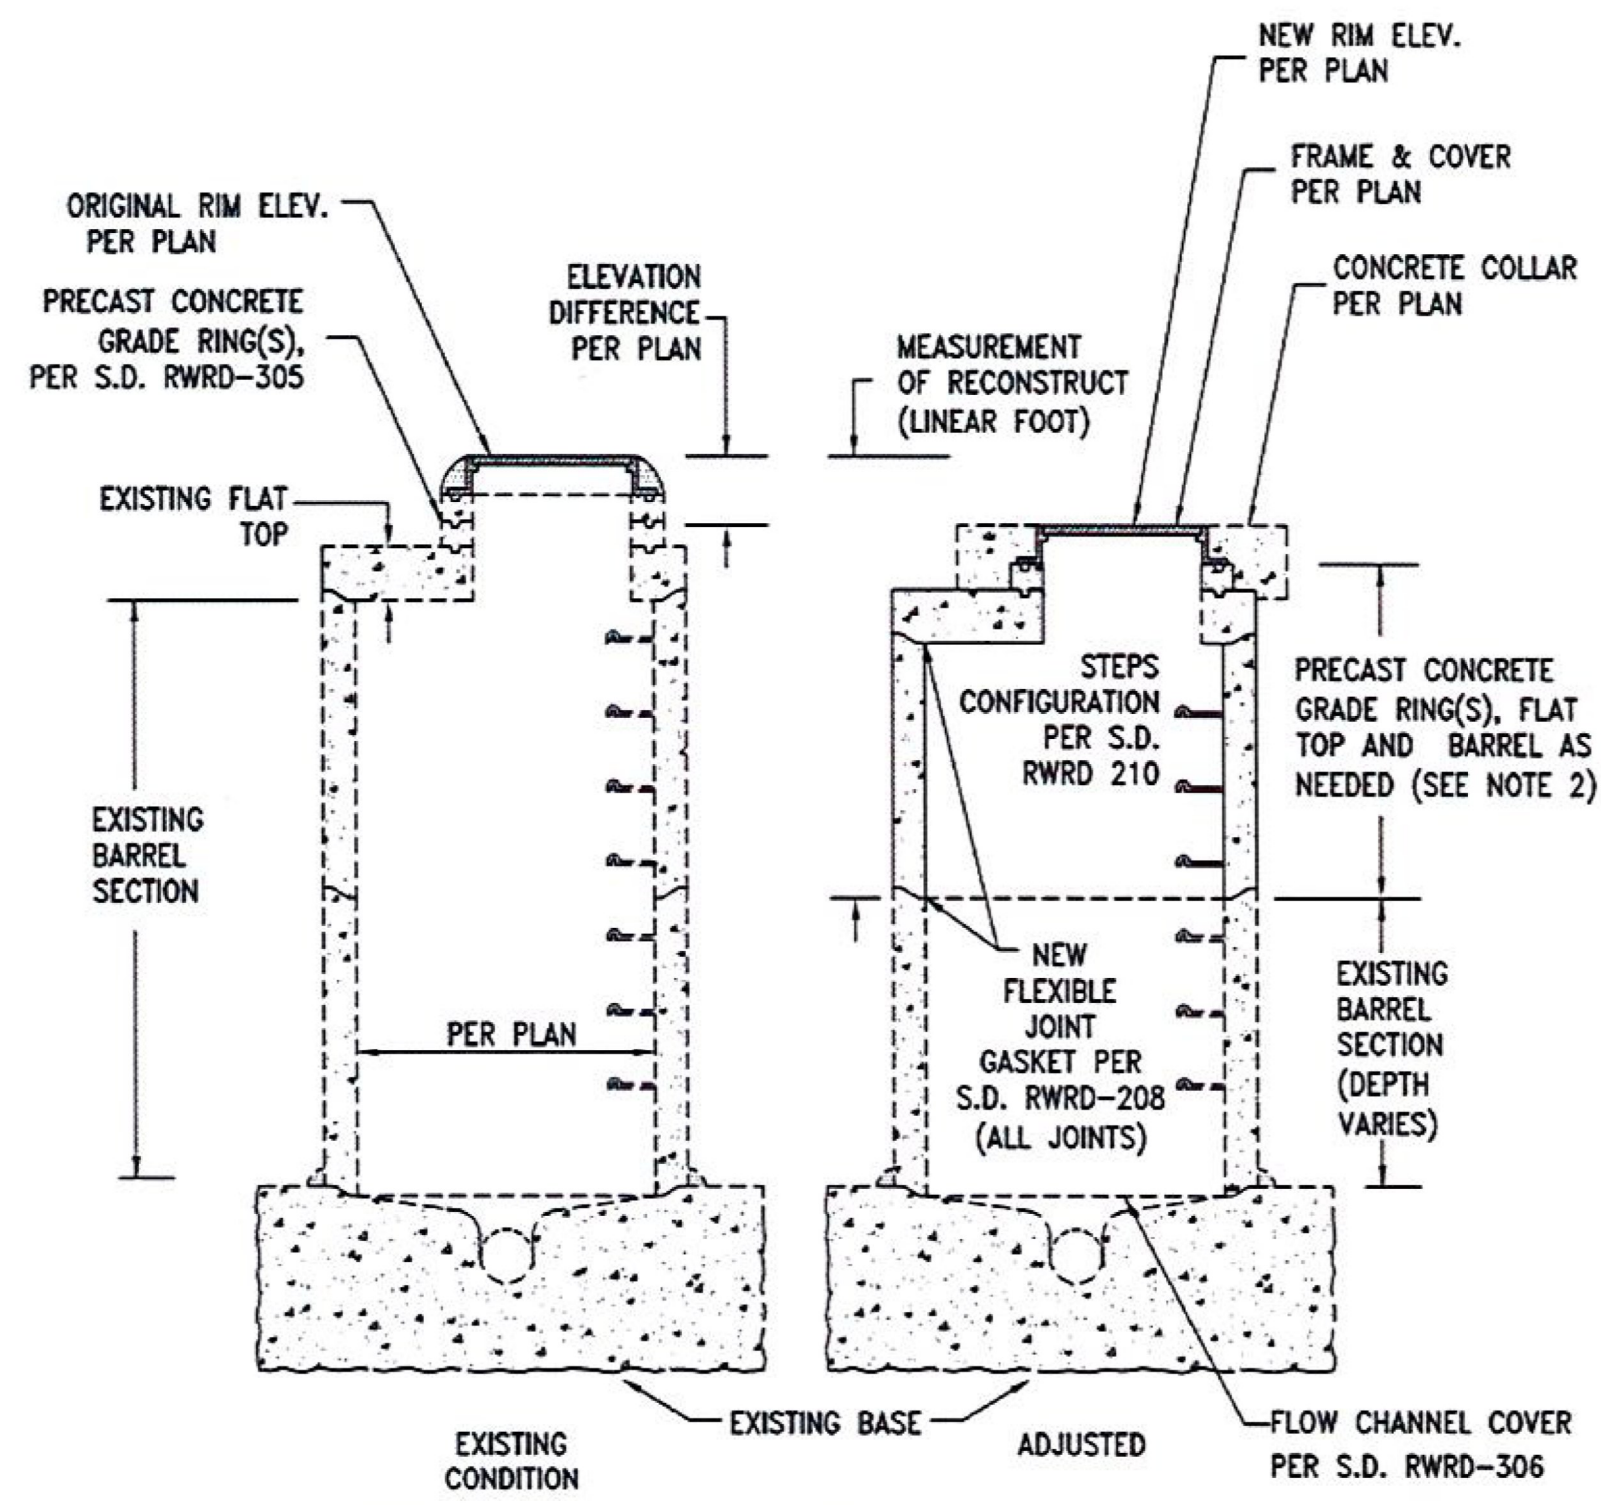

LOWER FRAME & COVER OF FLAT TOP MANHOLE  
N.T.S.

NOTES:


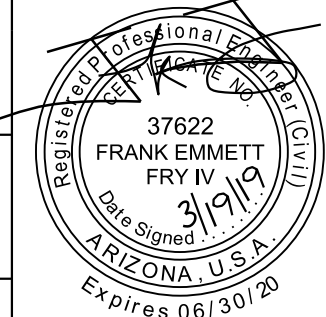
1. PRECAST CONCRETE MANHOLE SECTIONS SHALL CONFORM TO ASTM C478 AND AASHTO M199.
2. ONLY NEW MANHOLE COMPONENTS SHALL BE USED.
3. SEE SUBSECTIONS 3.3.2(E) AND 3.3.3 FOR MORE INFORMATION.
4. RECONSTRUCTION OF AN EXISTING MANHOLE SHALL BE REQUIRED FOR VIOLATION OF THE DIMENSIONAL RANGES NOTED IN STANDARD DETAILS RWRD 304 AND RWRD 305 AND TYPICALLY WHEN THE ADJUSTMENT IN RIM ELEVATION EXCEEDS 12".

MANHOLE RECONSTRUCTION DETAIL

G-2014-085

DATE: REVISIONS: FINISHED PLANS: SURVEY NO. DATE: LOCATION: REVISIONS: FINISHED PLANS: SURVEY NO.

SHEET SS15 OF SS19

DESIGN	DL	DATE	3-19	ARIZONA DEPARTMENT OF TRANSPORTATION INFRASTRUCTURE DELIVERY AND OPERATIONS DIVISION ROADWAY DESIGN SERVICES
DRAWN	CPG	DATE	3-19	
CHECKED	FF	DATE	3-19	
 WSP USA Inc. 177 N. Church Ave. Suite 1105 Tucson, AZ 85701				
ROUTE: I-10 LOCATION: RUTHRAUFF ROAD TI TRACS NO. H 8480 OIC 010-D(213)S				
DWG NO. U-3.15				OF





F.H.W.A. REGION	STATE	PROJECT NO.	SHEET NO.	TOTAL SHEETS	RECORD DRAWING
9	ARIZ.	010-D(213)S	846	849	


010 PM 252

**NOI #1 - Flow Management Plan:**  
(FOR CONSTRUCTION OF PIPES P1-P6 & NEW MH NOS. 1-7)

1. CONSTRUCT NEW MH #1 OVER EXIST. PIPE WITH STUB-OUT FOR NEW SEWER TO THE SOUTHEAST. PLUG STUB-OUT TO SE.
2. CONSTRUCT NEW SEWER PIPE #P1, #P2, #P3, #P4, & #P5 WITH NEW MH #2, #3, #4, & #5 TO THE LOCATION OF NEW MH #6.
3. CONSTRUCT NEW MH #6 & NEW MH #7 OVER EXISTING PIPES WITH NEW SEWER PIPE #6.
4. MH #1, #2, #3, #4, #5, #6, & #7 SHALL BE TESTED & AS-BUILT, AS REQUIRED, TO SUBMIT & RECEIVE ADEO DISCHARGE AUTHORIZATION.
5. OBTAIN ADEO DISCHARGE AUTHORIZATION.
6. PROVIDE MH COATING FOR EXIST. MH #9717-33 & 2903-01. CONTRACTOR SHALL USE FLOW-THROUGH BYPASS PLUGS FOR THE COATING OF THESE TWO MANHOLES (BID ITEM NO. 9240056).
7. INSTALL BYPASS #1 FROM EXIST. MH #6571-01 TO EXIST. MH #9717-30 WITH PLUGS #1 & #1A (BID ITEM NO. 9240054).
8. REMOVE EXISTING 18" PIPE WITHIN NEW MH #1. SHAPE FLOWLINE FROM SOUTH AND SOUTHEAST TO NORTH. RESIZE EXIST. 18" SOUTH INVERT TO ACCOMMODATE PROPOSED 12" CONNECTION. COAT MH & LET CURE. PLUG NEW SOUTH 12" INLET.
9. REMOVE BYPASS #1.
10. INSTALL BYPASS #2A & 2B, FROM EXIST. MH #9717-33 & MH #2903-01 TO EXIST. MH #3887-01 WITH PLUGS #2A, #2B, & #3 (BID ITEM NO. 9240054).
11. REMOVE EXISTING 15" PIPE WITHIN NEW MH #6. SHAPE FLOWLINE FROM EAST AND SOUTHEAST TO NORTHWEST. GROUT SOLID ORIGINAL OUTFALL TO WEST. THICKNESS OF GROUT TO MATCH THICKNESS OF EXIST. MANHOLE.
12. REMOVE EXISTING 10" PIPE WITHIN NEW MH #7. SHAPE FLOWLINE FROM EAST TO NORTHWEST. GROUT SOLID ORIGINAL OUTFALL TO WEST. THICKNESS OF GROUT TO MATCH THICKNESS OF EXIST. MANHOLE.
13. REMOVE BYPASS #2A, & 2B.
14. RELEASE FLOWS FROM EXIST. 10-INCH & 15-INCH SEWERS INTO NEW SEWER.
15. REMOVE EXIST. 10-INCH SEWER & MANHOLES BETWEEN NEW MH #6 & MH #9717-31A. REMOVE EXIST. 15-INCH SEWER & MANHOLES BETWEEN NEW MH #7 & MH #9717-31A. REMOVE EXIST. 18-INCH SEWER & MANHOLES BETWEEN MH #9717-31A & NEW MH #1.

NOTE:  
1. SEE FMP GENERAL NOTES ON SHEET SS2.

G-2014-085

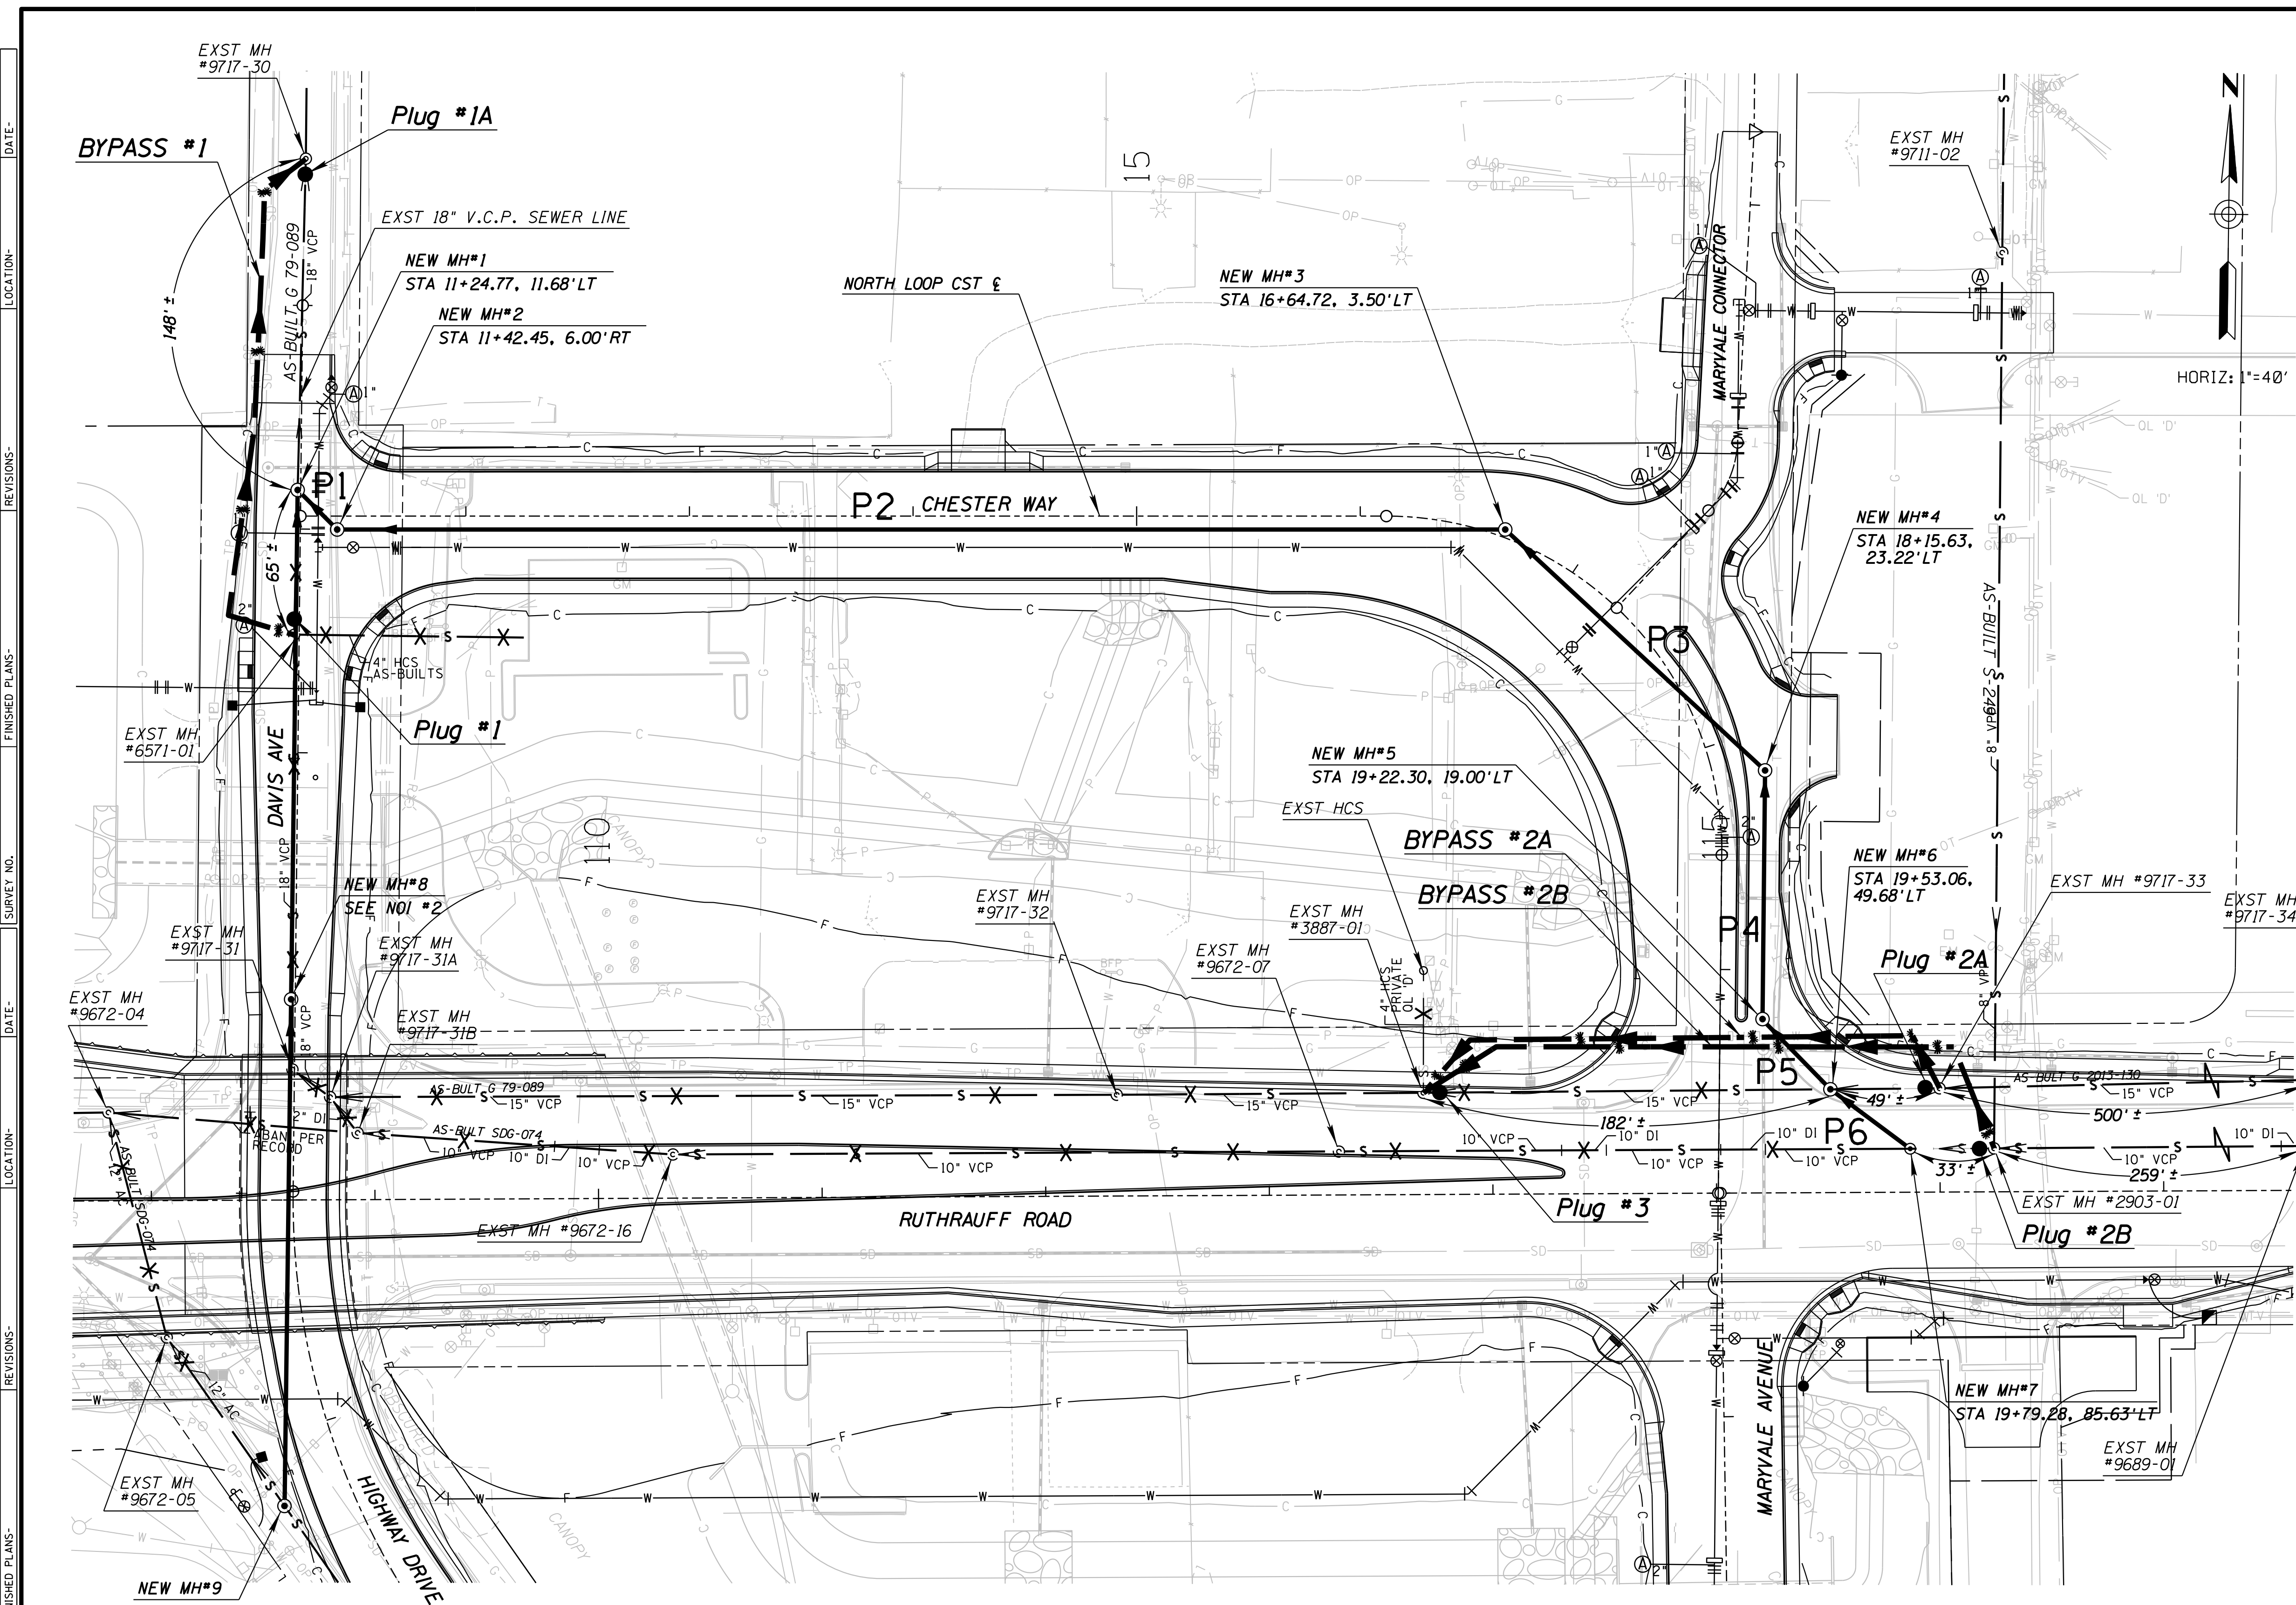

**Flow & Pump Data:**

Location	Exist. Dia.	Plug #	Plug Size	Design Flow	NPSHa	TDH	Size	Number of Pumps	Bypass Length
Bypass #1	18 In.	1 & 1A	18 In.	1400 GPM	19.8 Ft.	24 Ft.	12 In.	2 (Including 1 Backup)	263 Ft.
Bypass #2A	15 In.	2A & 3	15 In.	1100 GPM	19.5 Ft.	24 Ft.	10 In.	2 (Including 1 Backup)	281 Ft.
Bypass #2B	10 In.	2B	10 In.	300 GPM	22.3 Ft.	21 Ft.	6 In.	2 (Including 1 Backup)	343 Ft.

DESIGN	DL	DATE	3-19
DRAWN	CPG	DATE	3-19
CHECKED	FF	DATE	3-19

ARIZONA DEPARTMENT OF TRANSPORTATION  
INFRASTRUCTURE DELIVERY AND OPERATIONS DIVISION  
ROADWAY DESIGN SERVICES

**RUTHRAUFF ROAD  
SEWER MODIFICATION PLANS  
FLOW MANAGEMENT PLAN 1 OF 2**

ROUTE: I-10 LOCATION: RUTHRAUFF ROAD TI

TRACS NO. H 8480 OIC


010-D(213)S

DWG NO. U-3.16

OF



WSP USA INC.  
177 N. Church Ave.  
Suite 1105  
Tucson, AZ 85701

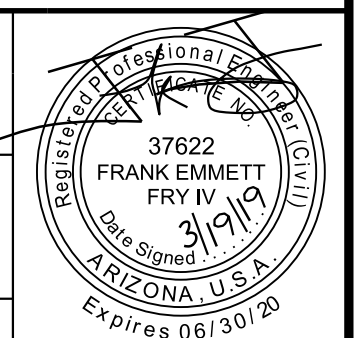

DATE: LOCATION: REVISIONS: FINISHED PLANS: SURVEY NO. DATE: LOCATION: REVISIONS: FINISHED PLANS: SURVEY NO.



F.H.W.A. REGION	STATE	PROJECT NO.	SHEET NO.	TOTAL SHEETS	RECORD DRAWING
9	ARIZ.	010-D(213)S			

010 PM 252


**NOI #2 - Flow Management Plan:**

(FOR CONSTRUCTION OF PIPES P7-P8 & NEW MH NOS. 8-10)

1. FOLLOWING REMOVAL OF EXISTING 18-INCH SEWER BETWEEN EXISTING MH #9717-31A TO NEW MH #1, CONSTRUCT NEW SEWER PIPE #P7 & #P8 WITH NEW MH #8 TO THE LOCATION OF NEW MH #9.
2. CONSTRUCT NEW MH #9 OVER EXISTING PIPE WITH STUB-OUT FOR NEW SEWER TO THE NORTH. PLUG STUB-OUT TO THE NORTH.
3. CONSTRUCT NEW MH #10 OVER EXISTING PIPE.
4. NEW MH #8, #9, & #10 SHALL BE TESTED & AS-BUILT, AS REQUIRED, TO SUBMIT & RECEIVE ADEQ DISCHARGE AUTHORIZATION.
5. OBTAIN ADEQ DISCHARGE AUTHORIZATION.
6. INSTALL BYPASS #3 FROM EXISTING MH #9672-06 TO EXISTING MH #9672-05 WITH PLUGS #4 & 4A (BID ITEM NO. 9240055).
7. REMOVE EXISTING 12-INCH PIPE WITHIN NEW MH #9. SHAPE FLOWLINE FROM SOUTHEAST TO NORTH. GROUT SOLID ORIGINAL OUTFALL TO THE NORTHWEST. THICKNESS OF GROUT TO MATCH THICKNESS OF EXIST. MANHOLE.
8. INSTALL BYPASS #4 FROM NEW MH #2 TO EXISTING MH #9717-30 WITH PLUGS #5 & 5A (BID ITEM NO. 9240055).
9. CONNECT PIPE #P7 TO NEW MH #1.
10. REMOVE BYPASS #3 & #4.
11. RELEASE FLOWS FROM EXISTING 12-INCH SEWER INTO NEW SEWER.
12. REMOVE EXISTING 12-INCH PIPE WITHIN NEW MH #10. SHAPE FLOWLINE FROM SOUTHEAST TO NORTHWEST. GROUT SOLID ORIGINAL INLET TO THE SOUTHEAST. THICKNESS OF GROUT TO MATCH THICKNESS OF EXIST. MANHOLE.
13. REMOVE EXISTING 12-INCH SEWER & MANHOLES BETWEEN NEW MH #9 & NEW MH #10.

NOTE:  
1. SEE FMP GENERAL NOTES ON SHEET SS2.

SHEET SS17 OF SS19

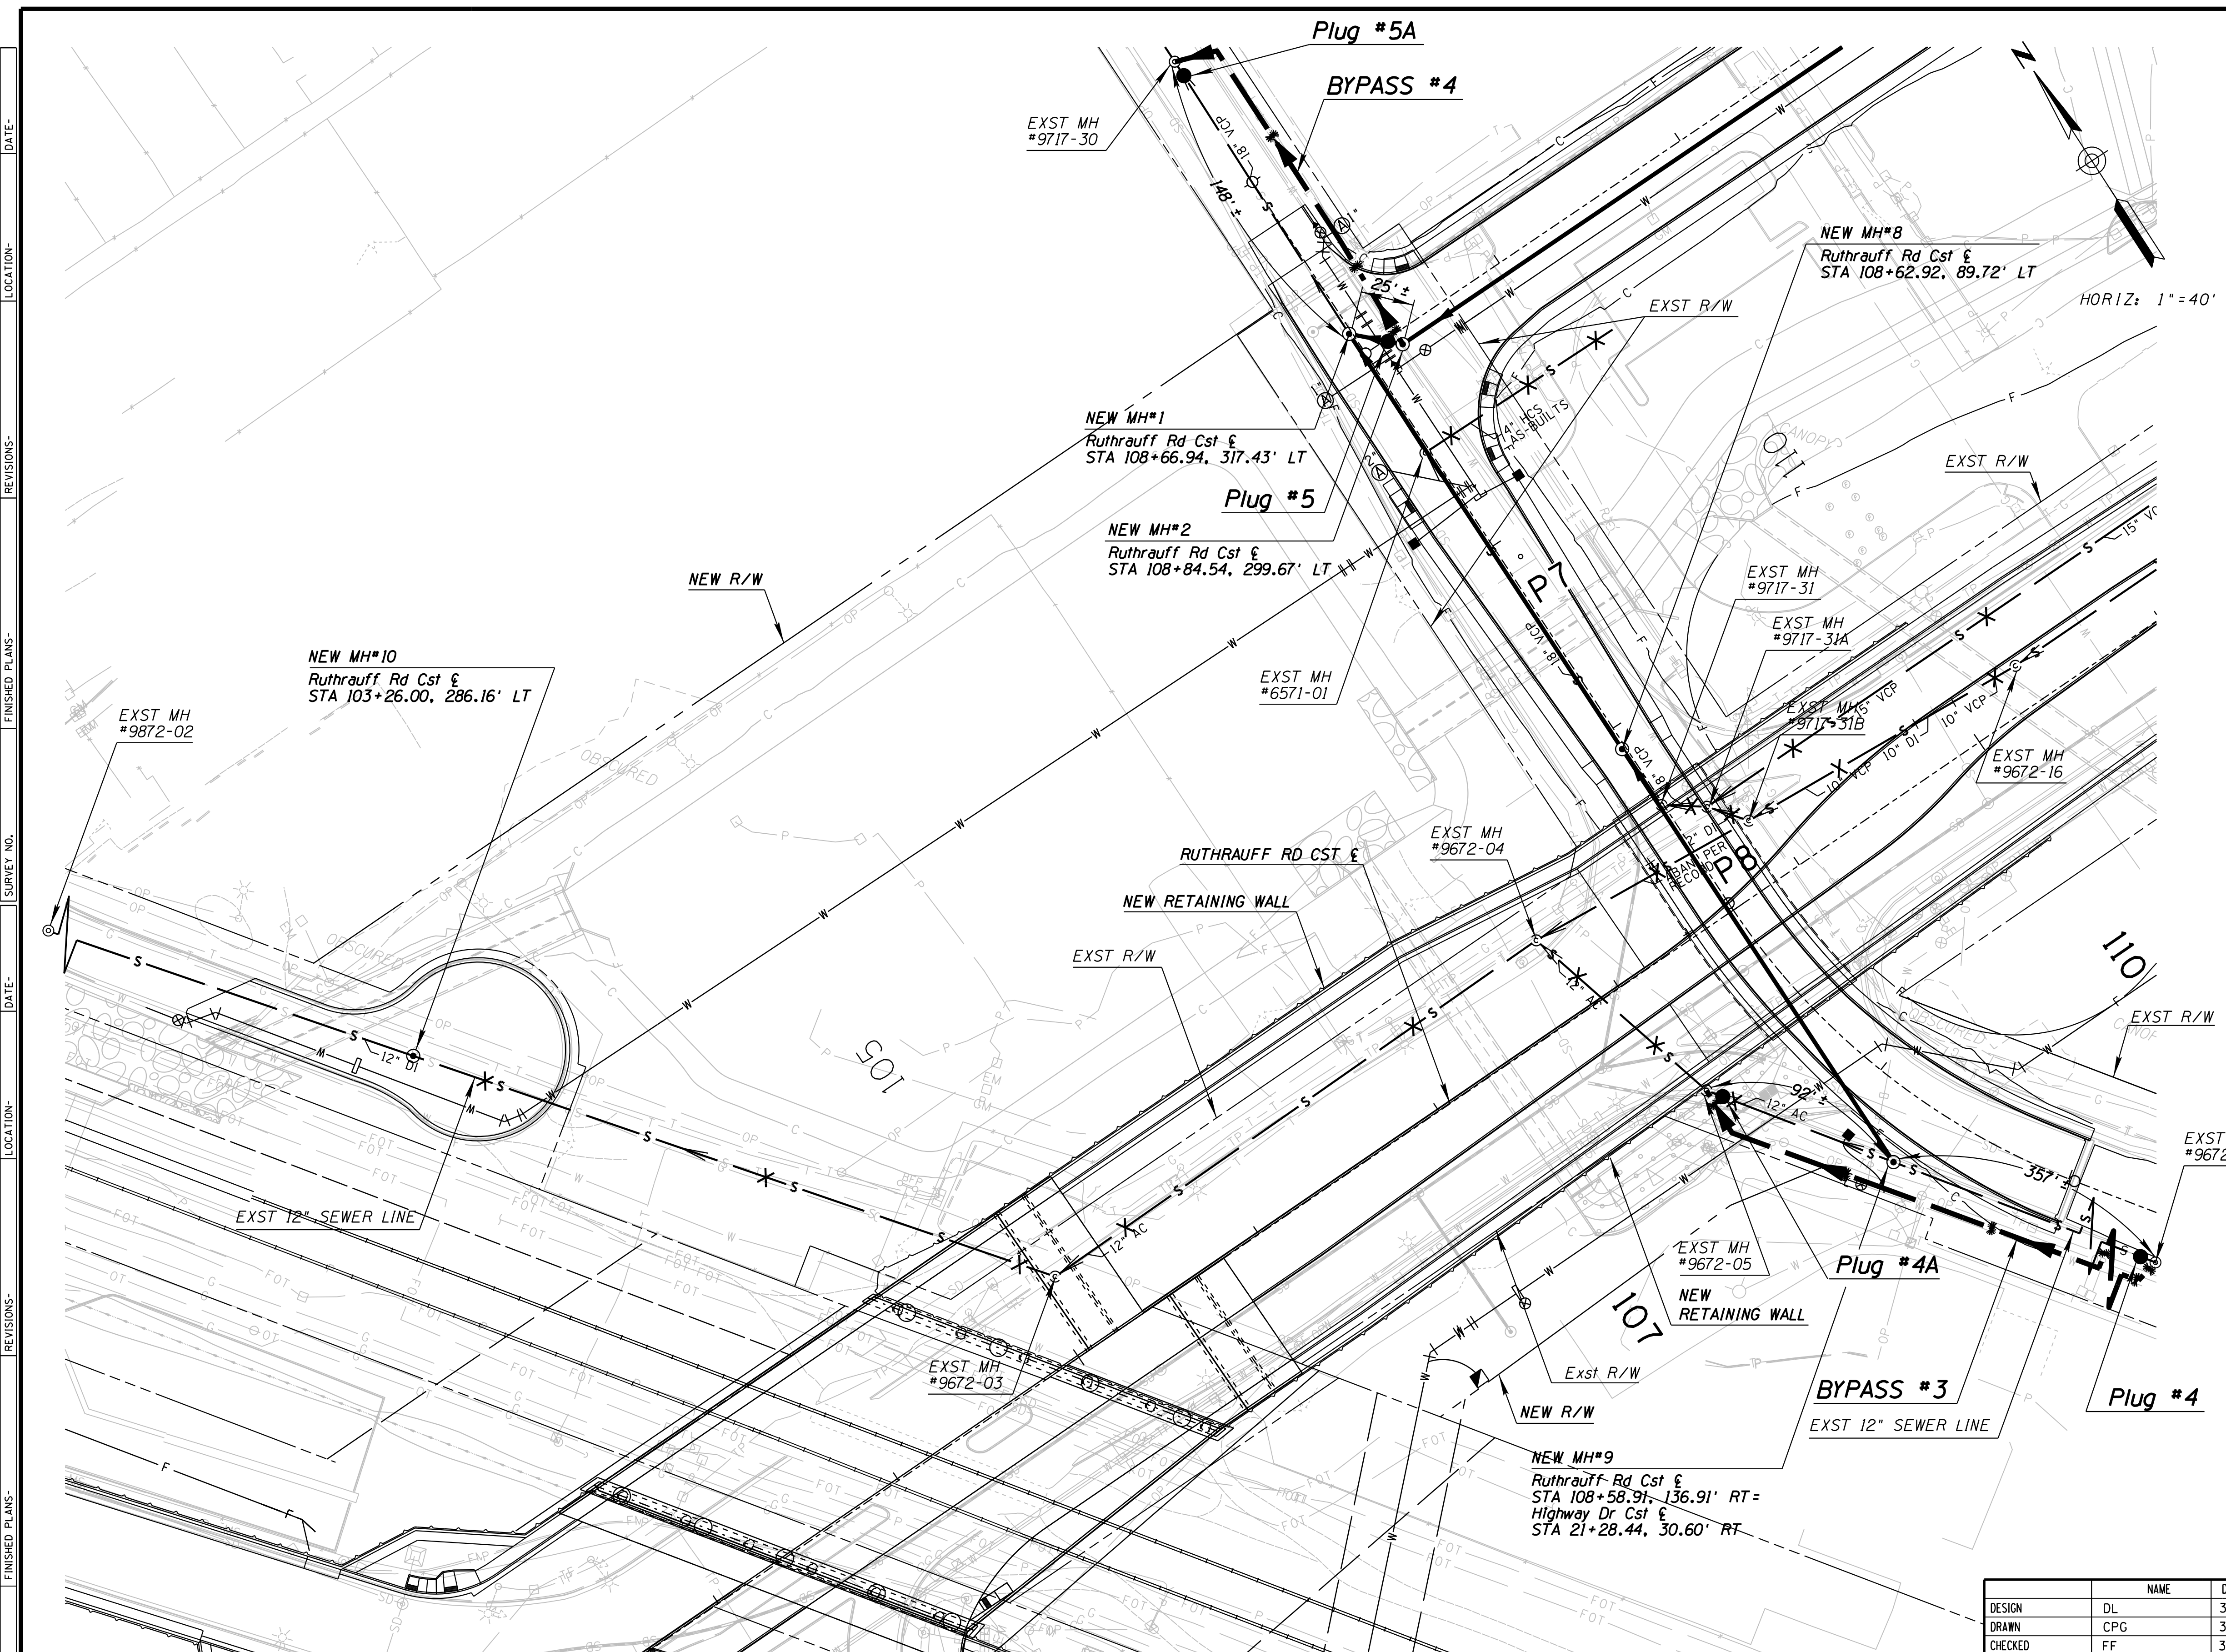


**Flow & Pump Data:**

Location	Exst. Dia.	Plug #	Plug Size	Design Flow	NPSH	TDH	Size	Number of Pumps	Bypass Length
Bypass #3	12 In.	4 & 4A	12 In.	800 GPM	15.5 Ft.	29 Ft.	8 In.	2 (Including 1 Backup)	499 Ft.
Bypass #4	18 In.	5 & 5A	18 In.	1400 GPM	22.3 Ft.	24 Ft.	12 In.	2 (Including 1 Backup)	223 Ft.

DESIGN	NAME	DATE
DL		3-19
CYP		3-19
FF		3-19

ARIZONA DEPARTMENT OF TRANSPORTATION  
INFRASTRUCTURE DELIVERY AND OPERATIONS DIVISION  
ROADWAY DESIGN SERVICES

RUTHRAUFF ROAD  
SEWER MODIFICATION PLANS  
FLOW MANAGEMENT PLAN 2 OF 2

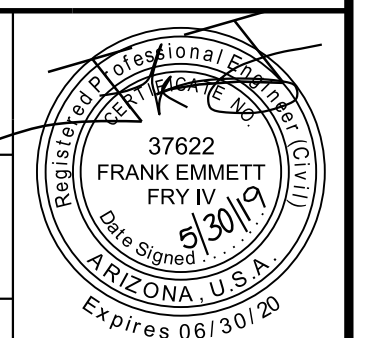

WSP USA Inc.  
177 N. Church Ave.  
Suite 1105  
Tucson, AZ 85701


NO.	DATE	REVISION	BY	CHKD.	APPR.	ROUTE	LOCATION	TRACS NO.	H 8480 OIC	010-D(213)S	DWG NO.	U-3.17
						I-10	RUTHRAUFF ROAD TI					OF

G-2014-085



F.H.W.A. REGION	STATE	PROJECT NO.	SHEET NO.	TOTAL SHEETS	RECORD DRAWING
9	ARIZ.	010-D(213)S	848	849	

010 PM 252

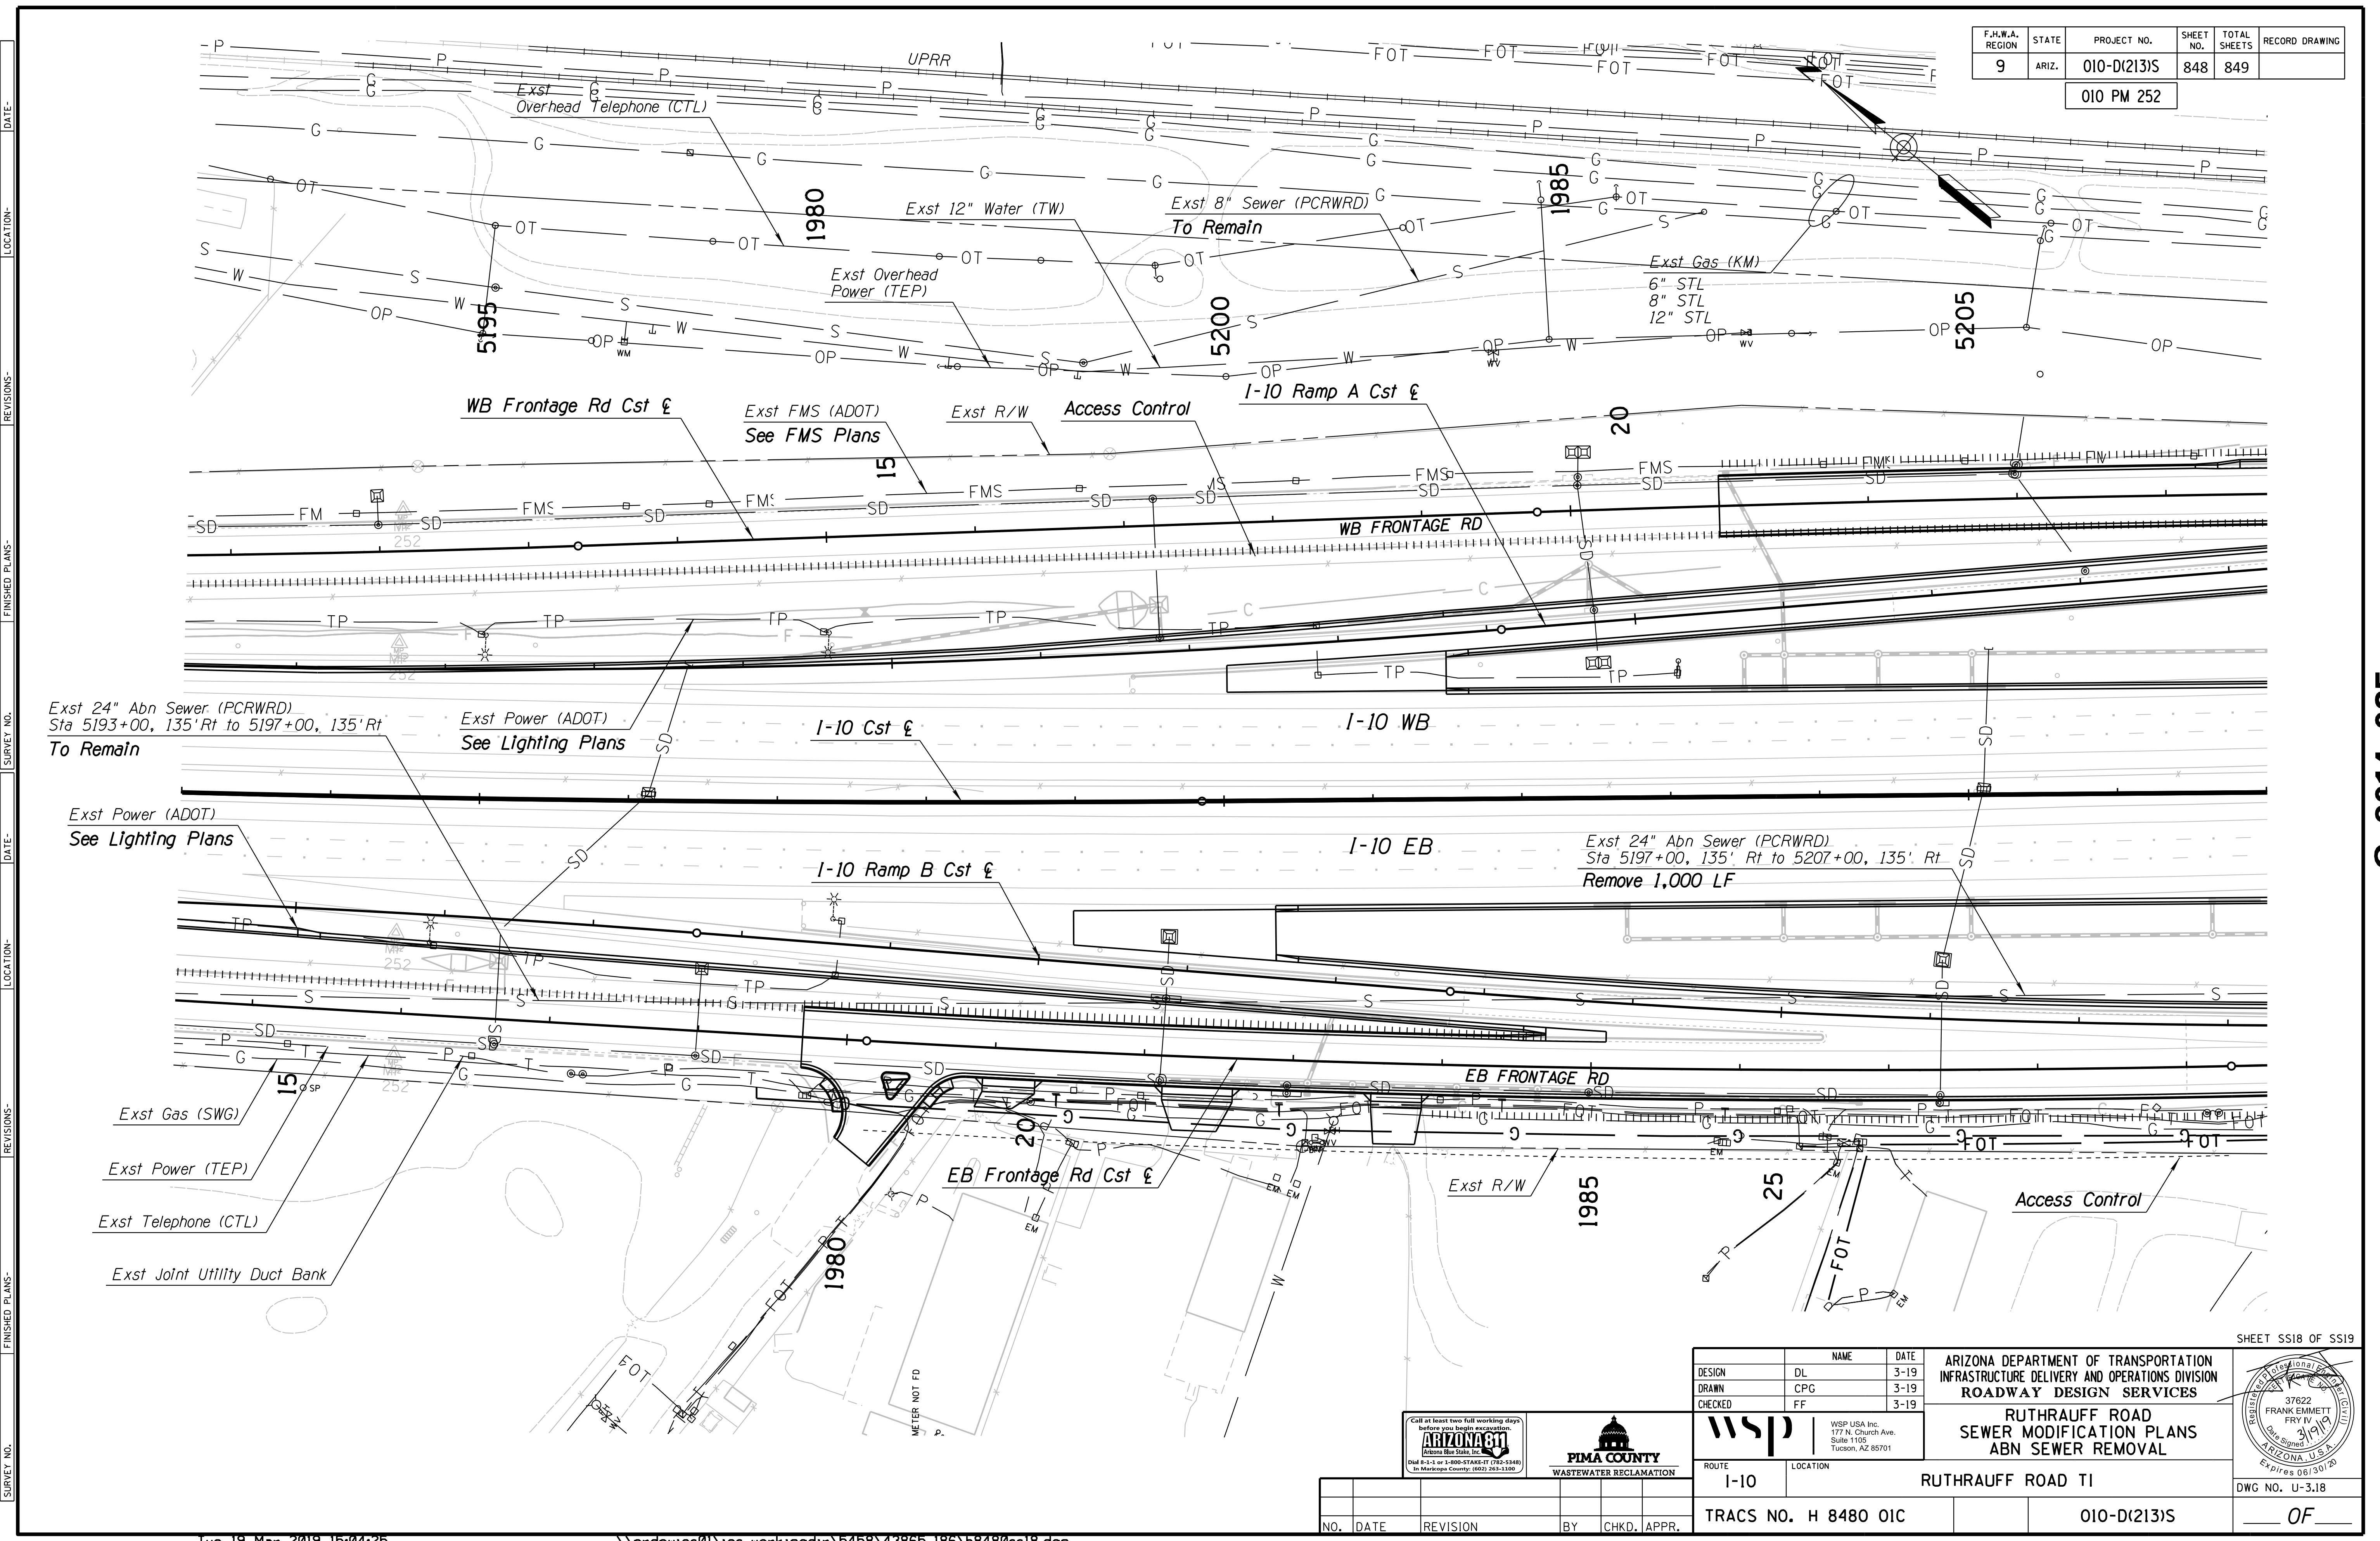

Exst 24" Abn Sewer (PCRWRD)  
Sta 5193+00, 135' Rt to 5197+00, 135' Rt  
To Remain

Exst Power (ADOT)  
See Lighting Plans


Exst 24" Abn Sewer (PCRWRD)  
Sta 5197+00, 135' Rt to 5207+00, 135' Rt  
Remove 1,000 LF

SHEET SS18 OF SS19

DESIGN	NAME	DATE
DL		3-19
DRAWN	CPG	3-19
CHECKED	FF	3-19

ARIZONA DEPARTMENT OF TRANSPORTATION  
INFRASTRUCTURE DELIVERY AND OPERATIONS DIVISION  
ROADWAY DESIGN SERVICES

RUTHRAUFF ROAD  
SEWER MODIFICATION PLANS  
ABN SEWER REMOVAL

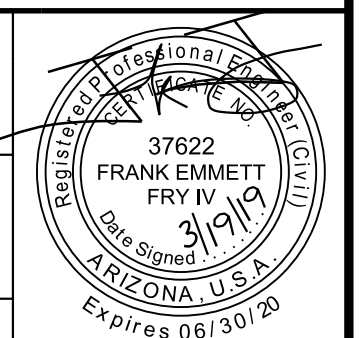

ROUTE	LOCATION	TRACS NO.	DWG NO.
I-10	RUTHRAUFF ROAD TI	H 8480 OIC	U-3.18
		010-D(213)S	OF


NO.	DATE	REVISION	BY	CHKD.	APPR.

G-2014-085

Exst 12" Sewer (PCRWRD)  
 (WB Frontage Rd  $\epsilon$ )  
 Sta 1998+07, 259' Lt  
 to 2002+16, 248' Lt  
 See Sheet SS5

F.H.W.A. REGION	STATE	PROJECT NO.	SHEET NO.	TOTAL SHEETS	RECORD DRAWING
9	ARIZ.	010-D(213)S	849	849	

010 PM 252

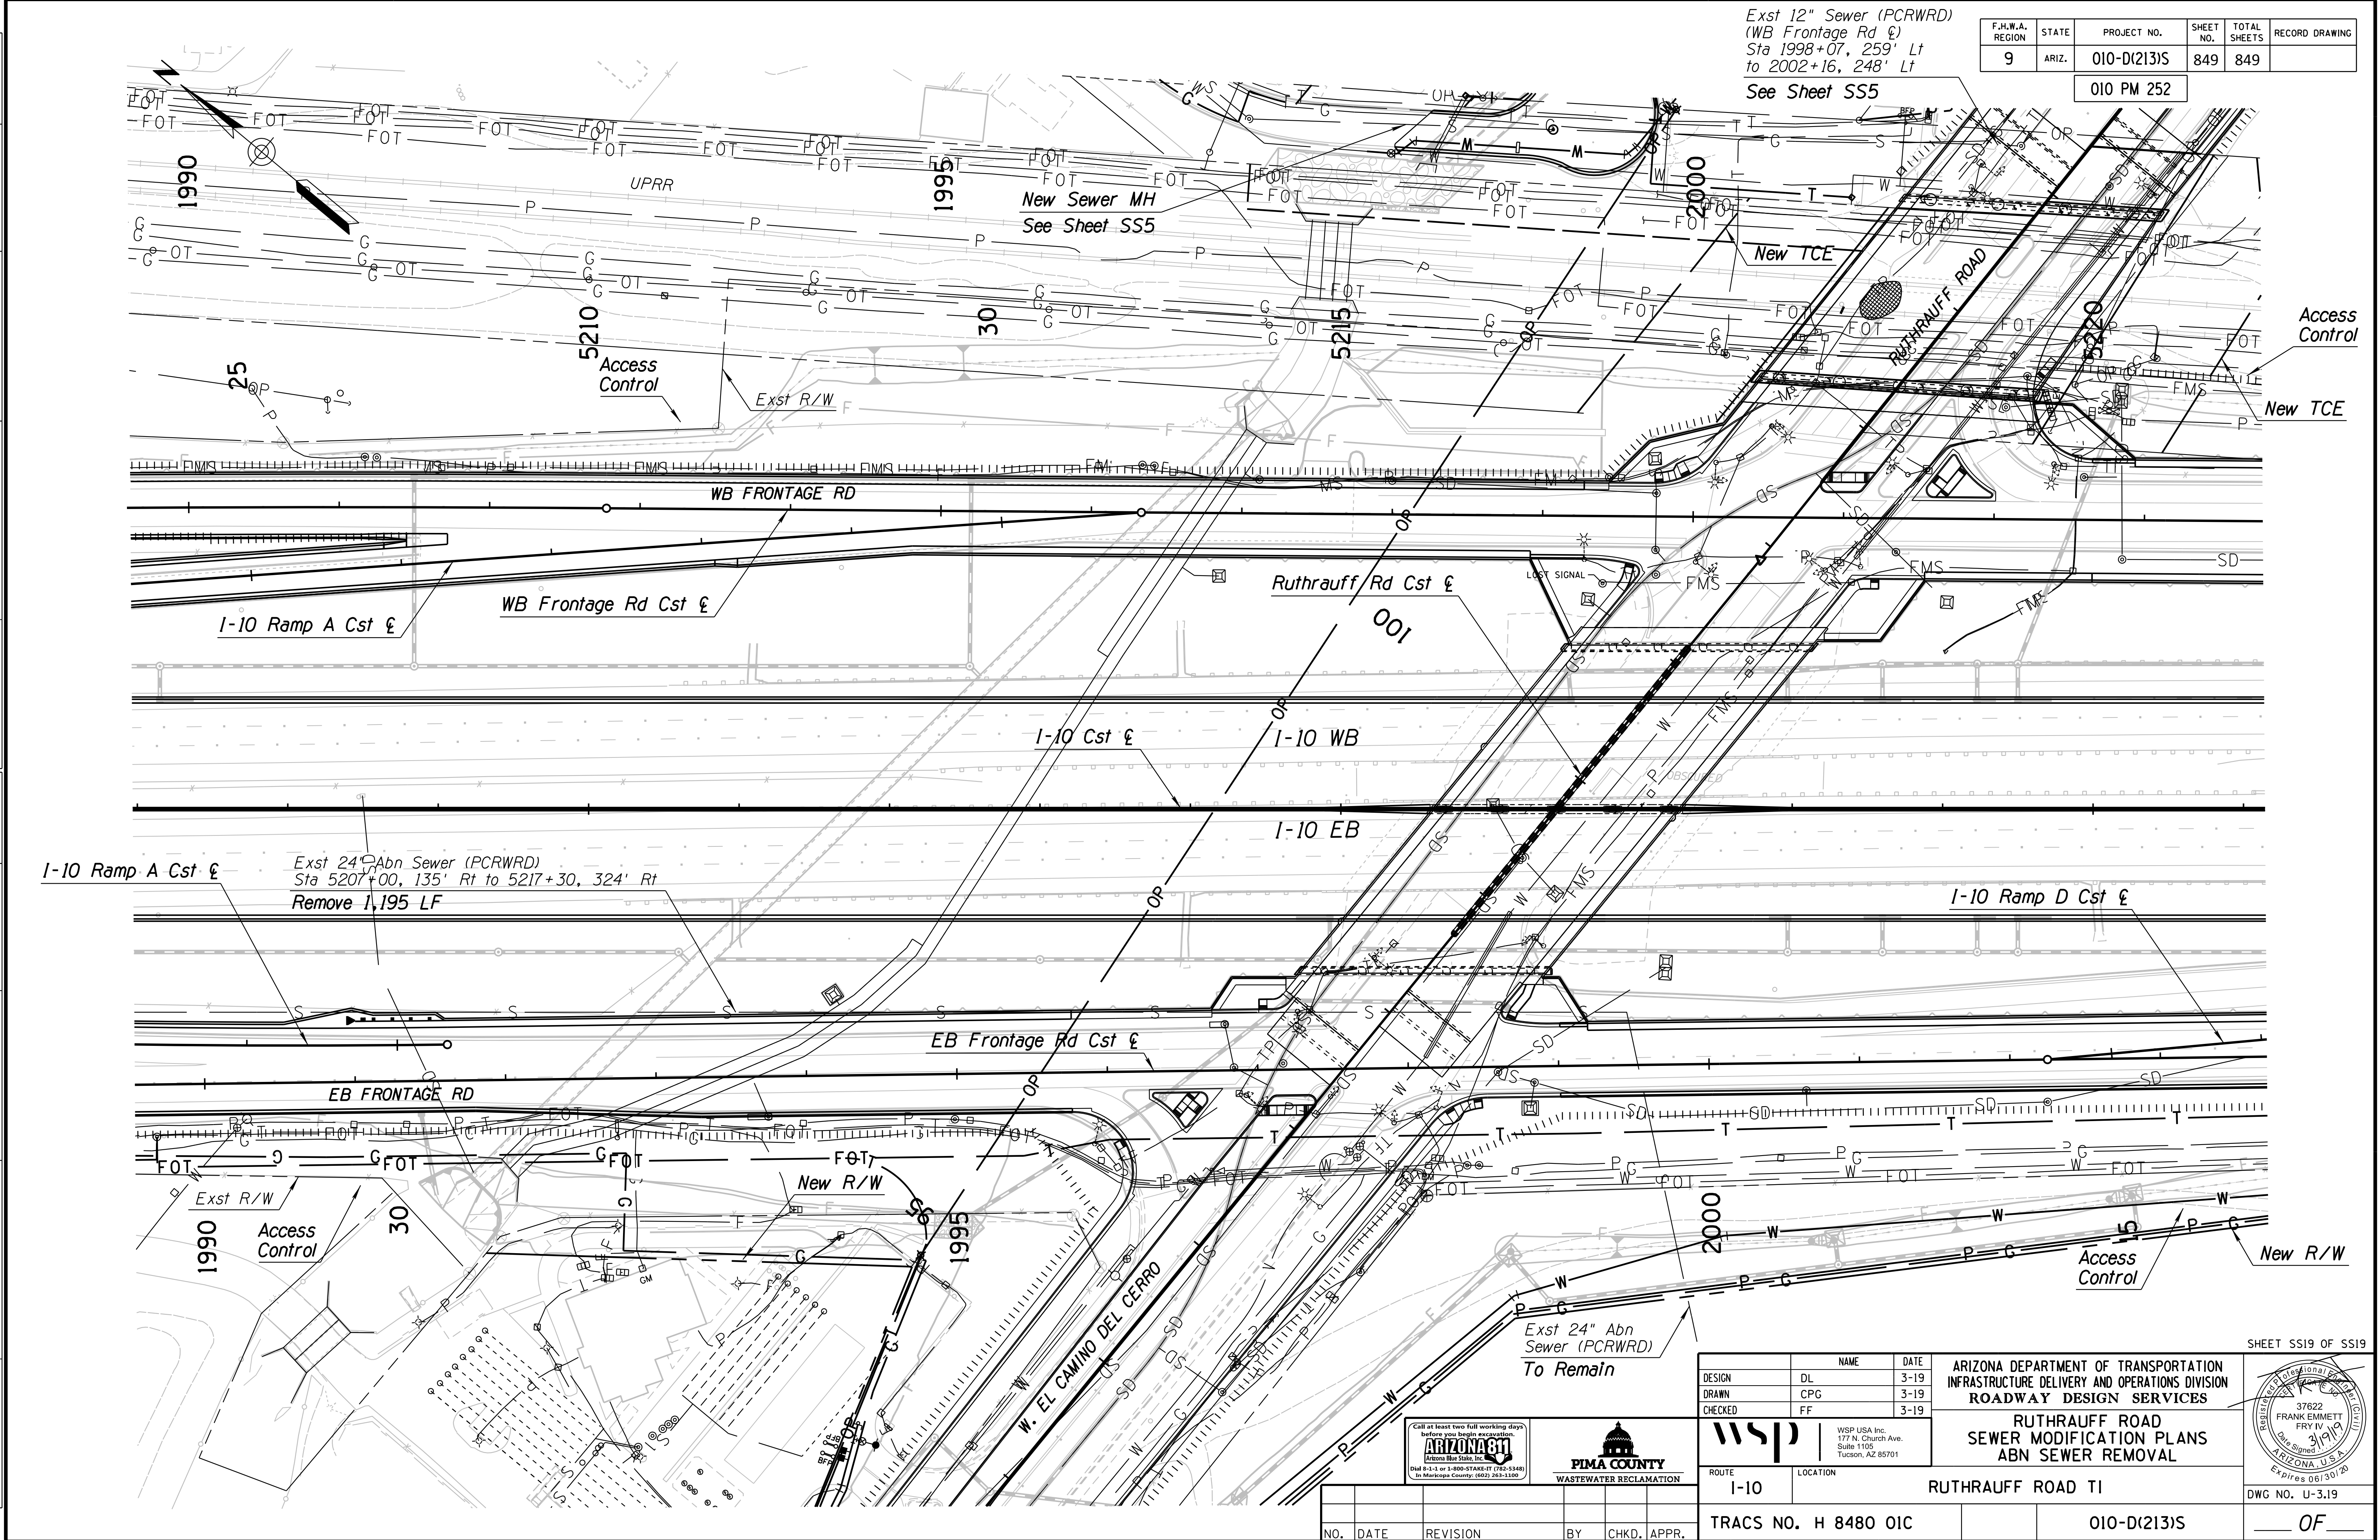

I-10 Ramp A Cst  $\epsilon$   
 Exst 24" Abn Sewer (PCRWRD)  
 Sta 5207+00, 135' Rt to 5217+30, 324' Rt  
 Remove 1,195 LF

Exst 24" Abn Sewer (PCRWRD)  
 To Remain


G-2014-085

SHEET SS19 OF SS19

DESIGN	NAME	DATE
DL		3-19
CYP		3-19
FF		3-19

ARIZONA DEPARTMENT OF TRANSPORTATION  
 INFRASTRUCTURE DELIVERY AND OPERATIONS DIVISION  
 ROADWAY DESIGN SERVICES

**RUTHRAUFF ROAD  
 SEWER MODIFICATION PLANS  
 ABN SEWER REMOVAL**

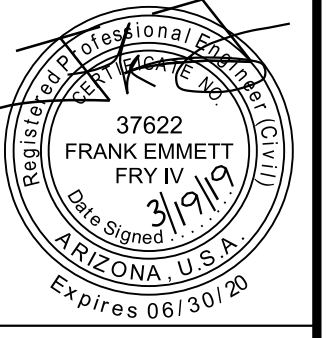

WSP USA Inc.  
 177 N. Church Ave.  
 Suite 1105  
 Tucson, AZ 85701

NO.	DATE	REVISION	BY	CHKD.	APPR.

ROUTE	LOCATION	TRACS NO.	PROJECT NO.
I-10	RUTHRAUFF ROAD TI	H 8480 01C	010-D(213)S
DWG NO. U-3.19		OF	